




FED. ROAD DIST. NO.	STATE	PROJECT NO.	FISCAL YEAR	SHEET NO.	TOTAL SHEETS
HAWAII	HAW.	STP-1500(35)	2008	12	41

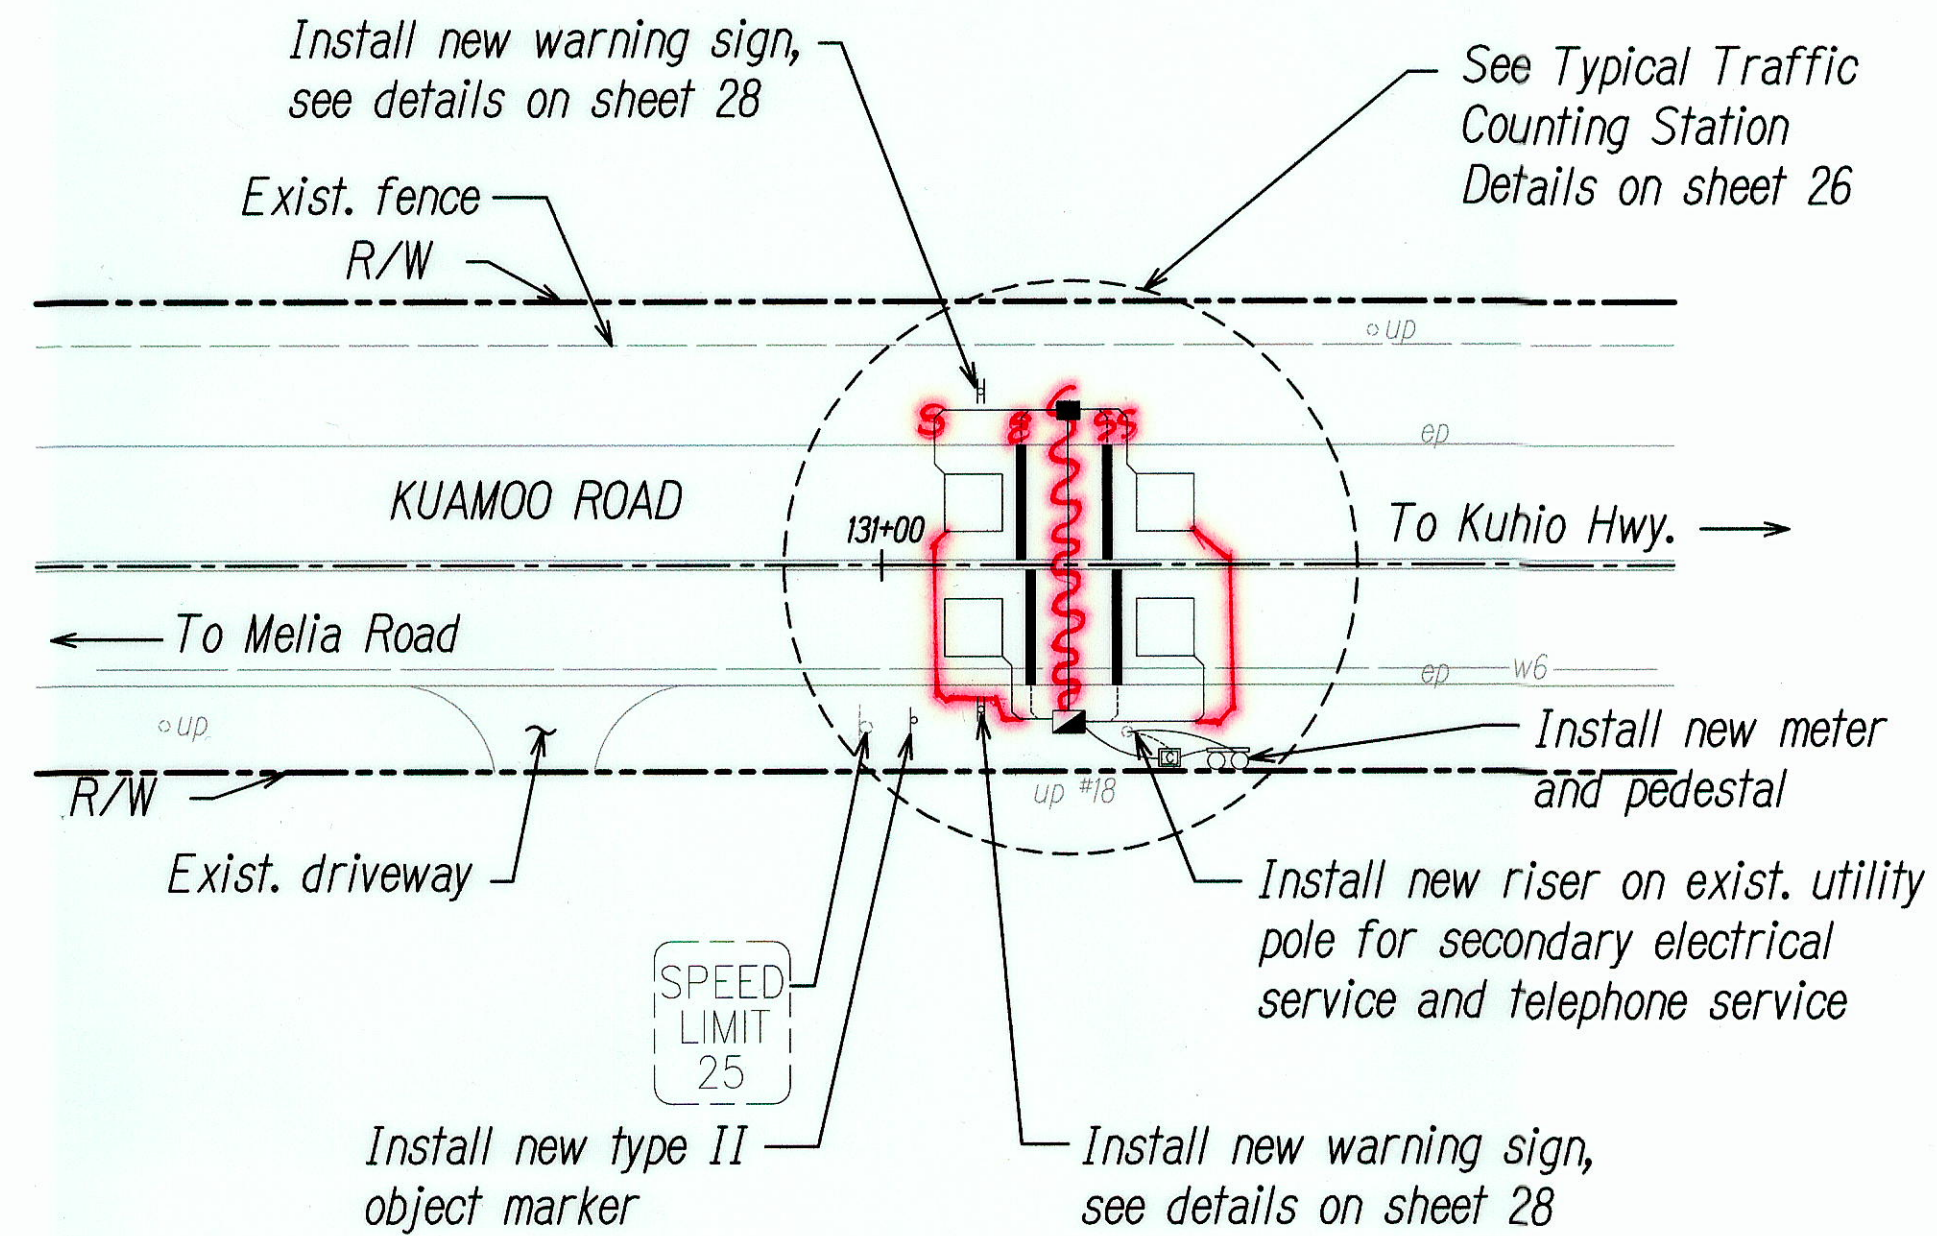


PROPOSED STA. 1 ON KUAMOO ROAD
ROUTE 580, M.P. 2.327, KAUAI
 Scale: 1"=20'

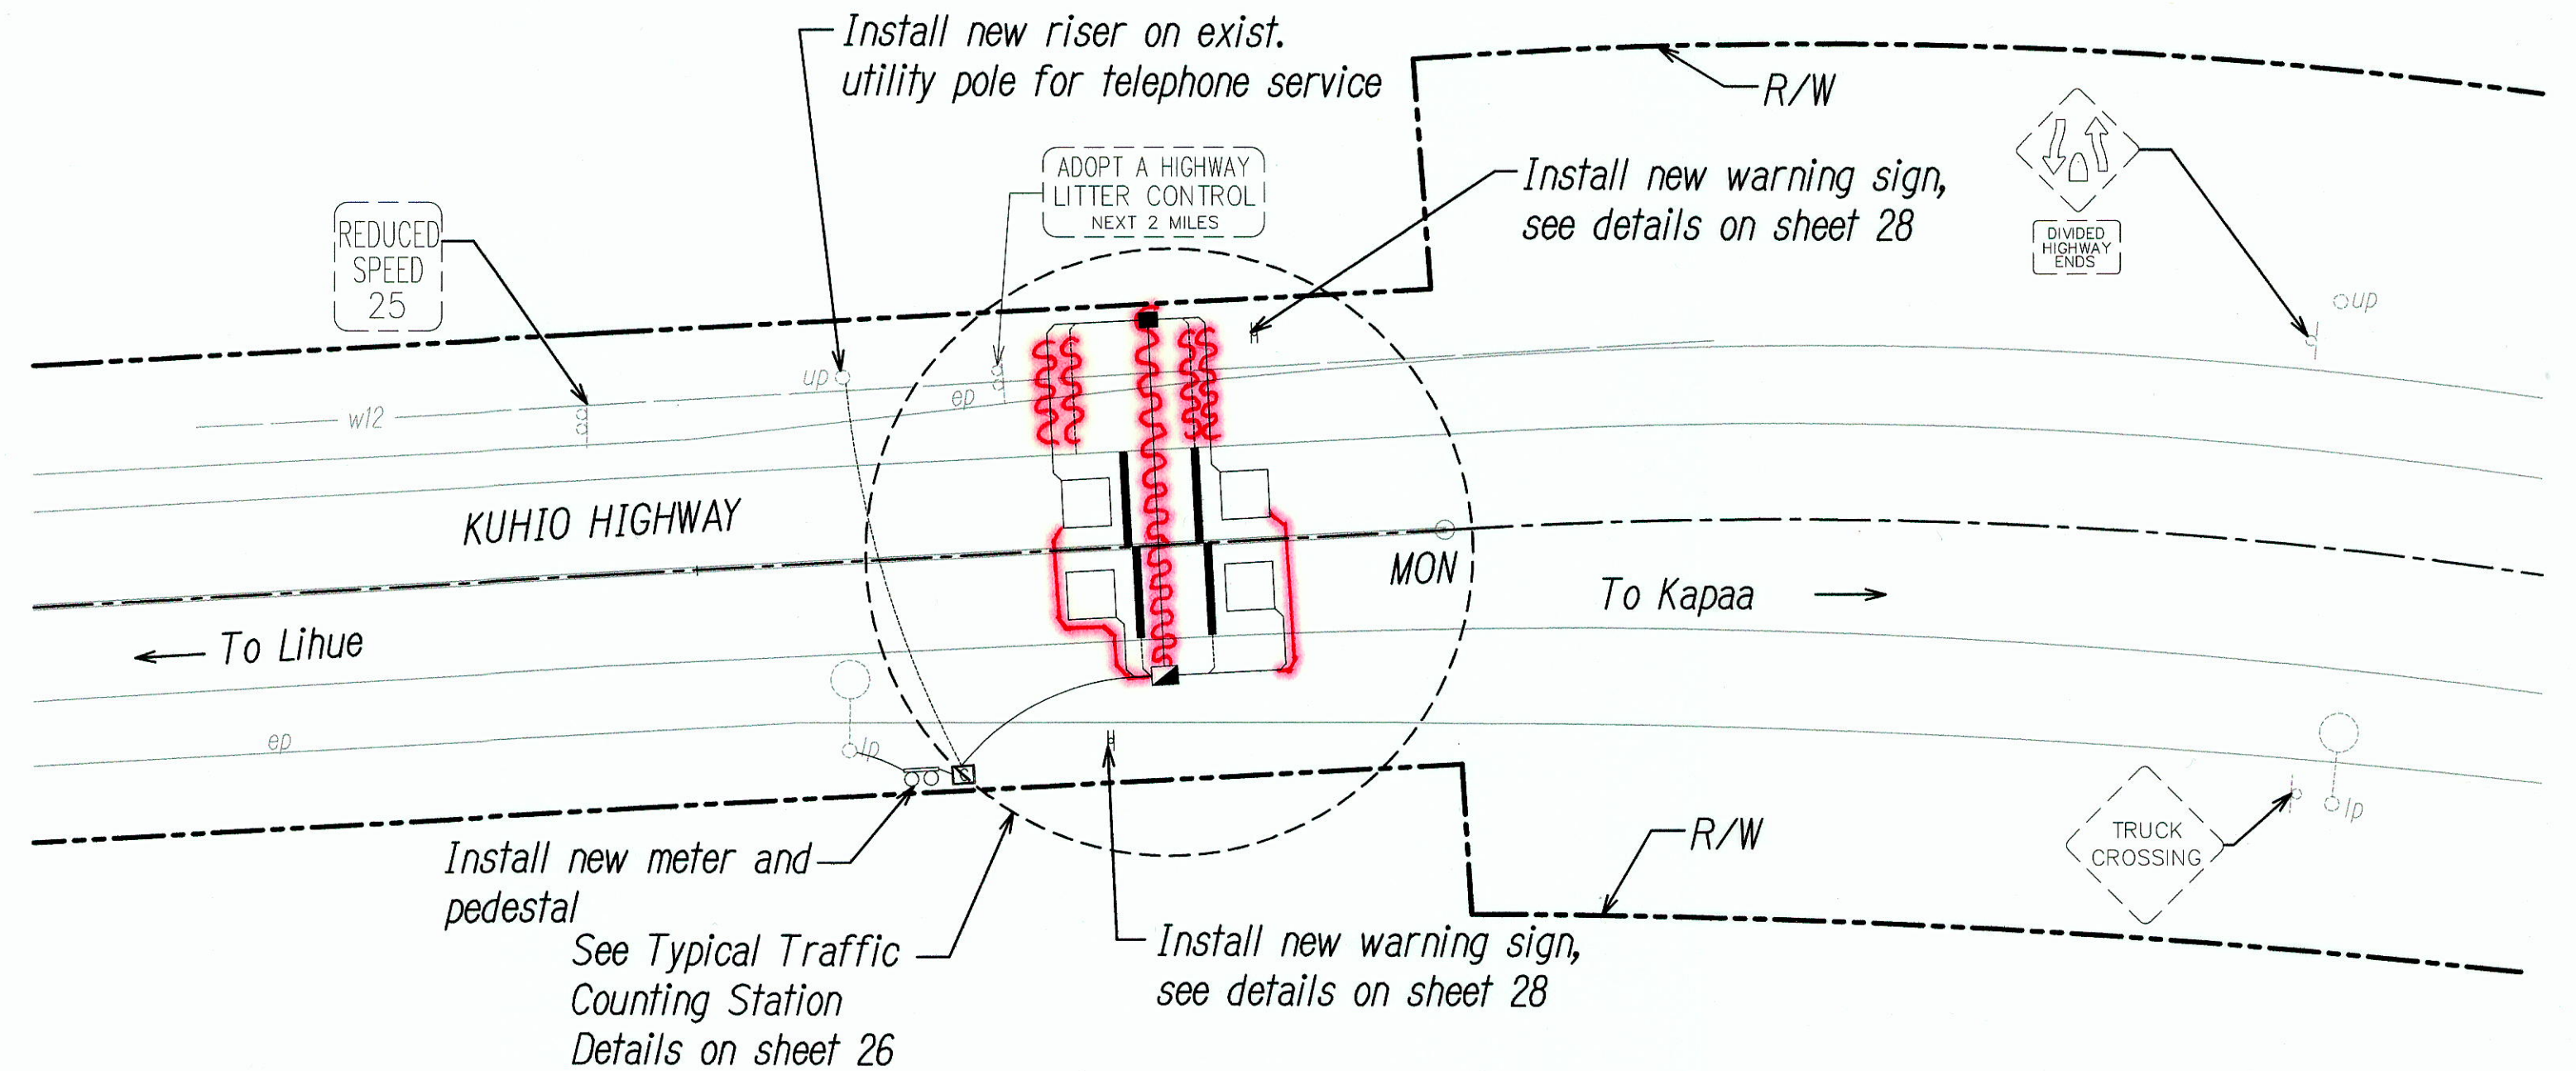

PROPOSED STA. 2 ON KUHIO HIGHWAY
ROUTE 56, M.P. 2.400, KAUAI
 Scale: 1"=20'

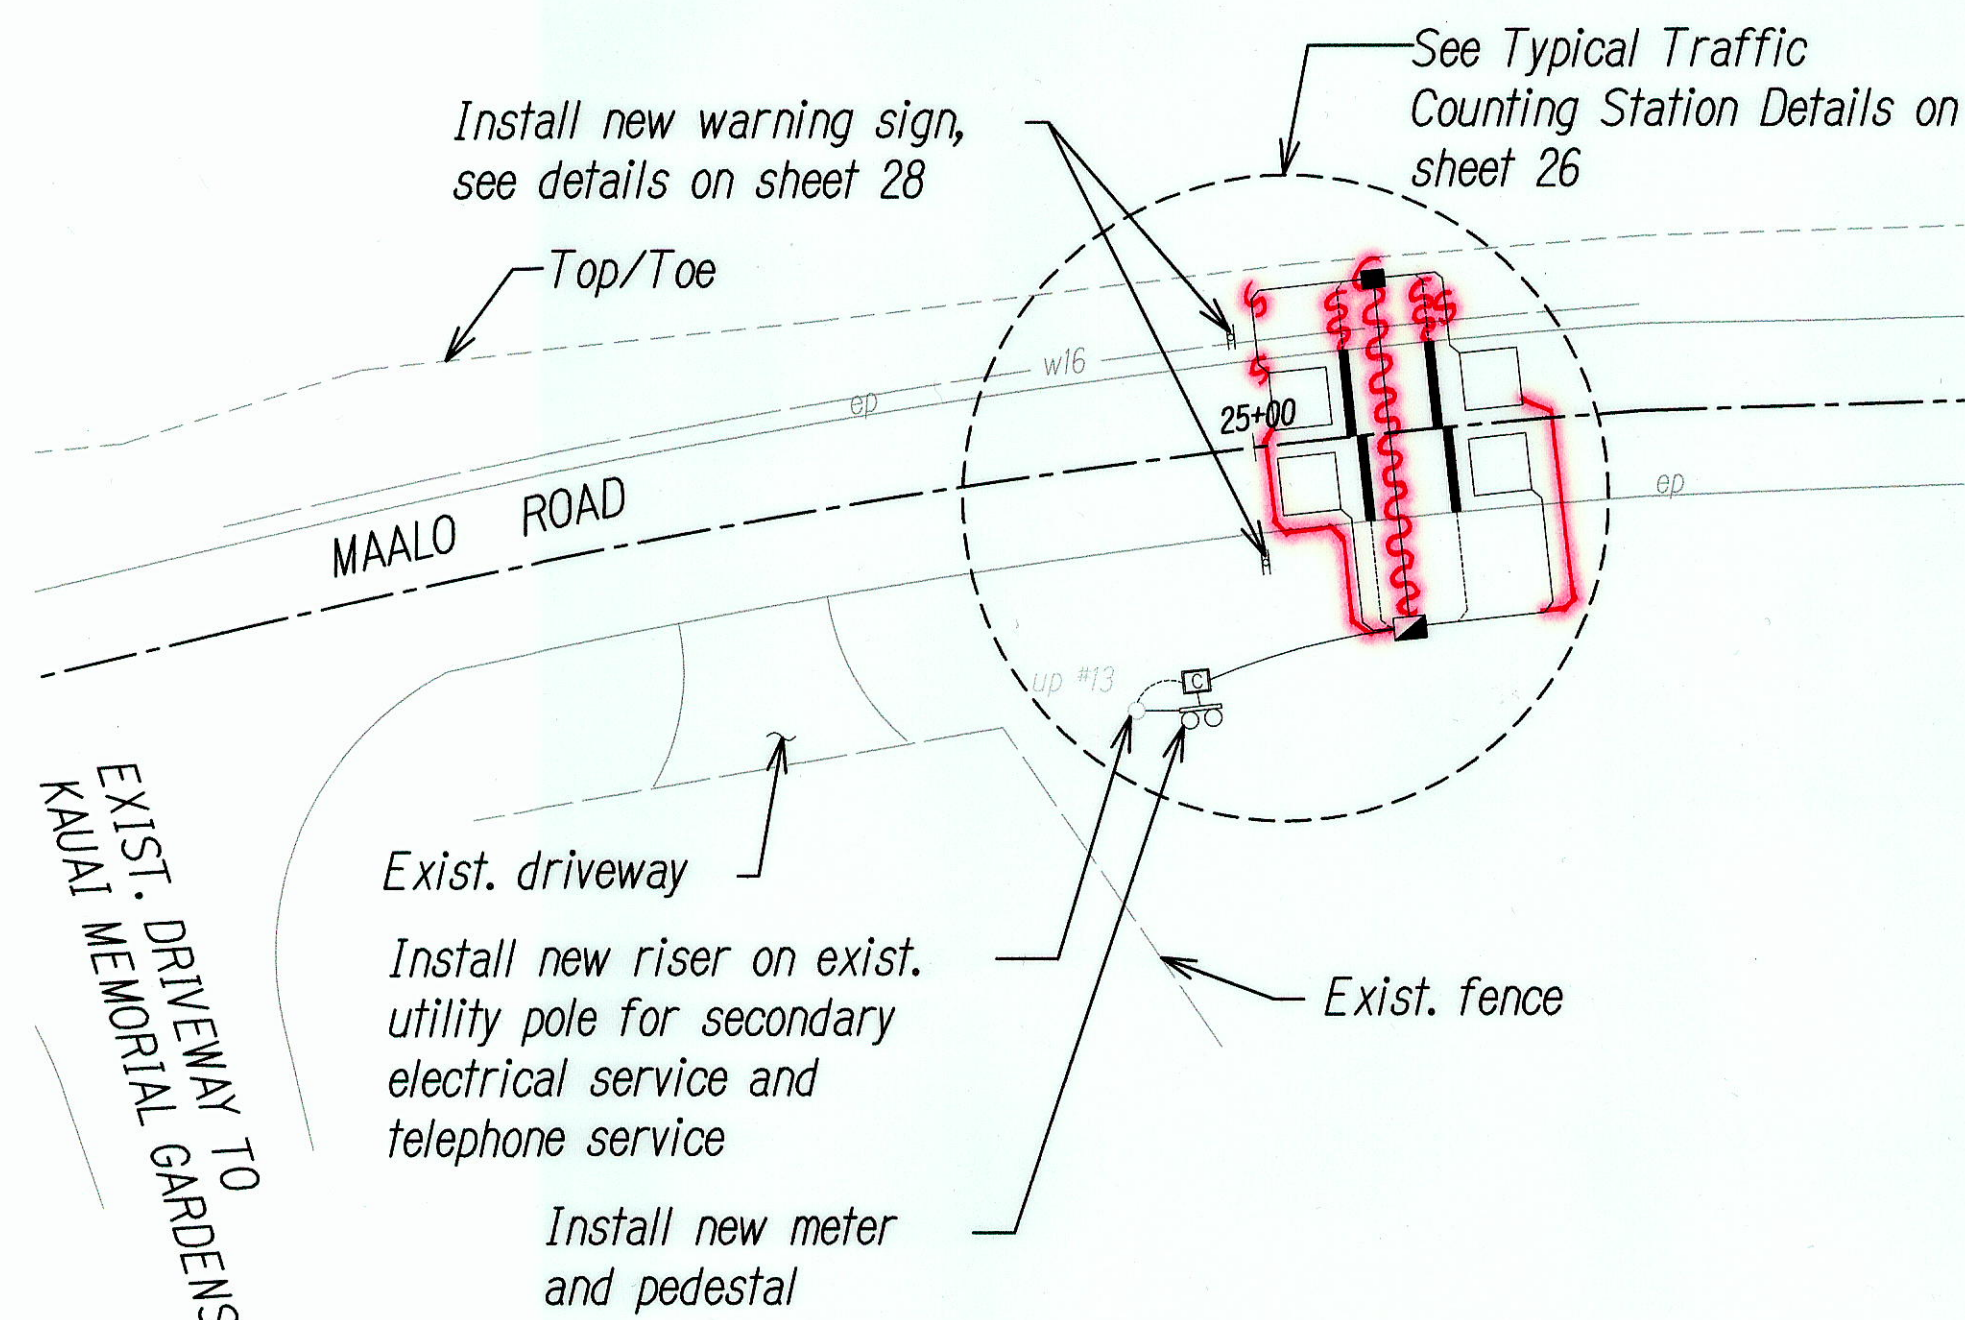


PROPOSED STA. 3 ON MAALO ROAD
ROUTE 583, M.P. 0.470, KAUAI
 Scale: 1"=20'

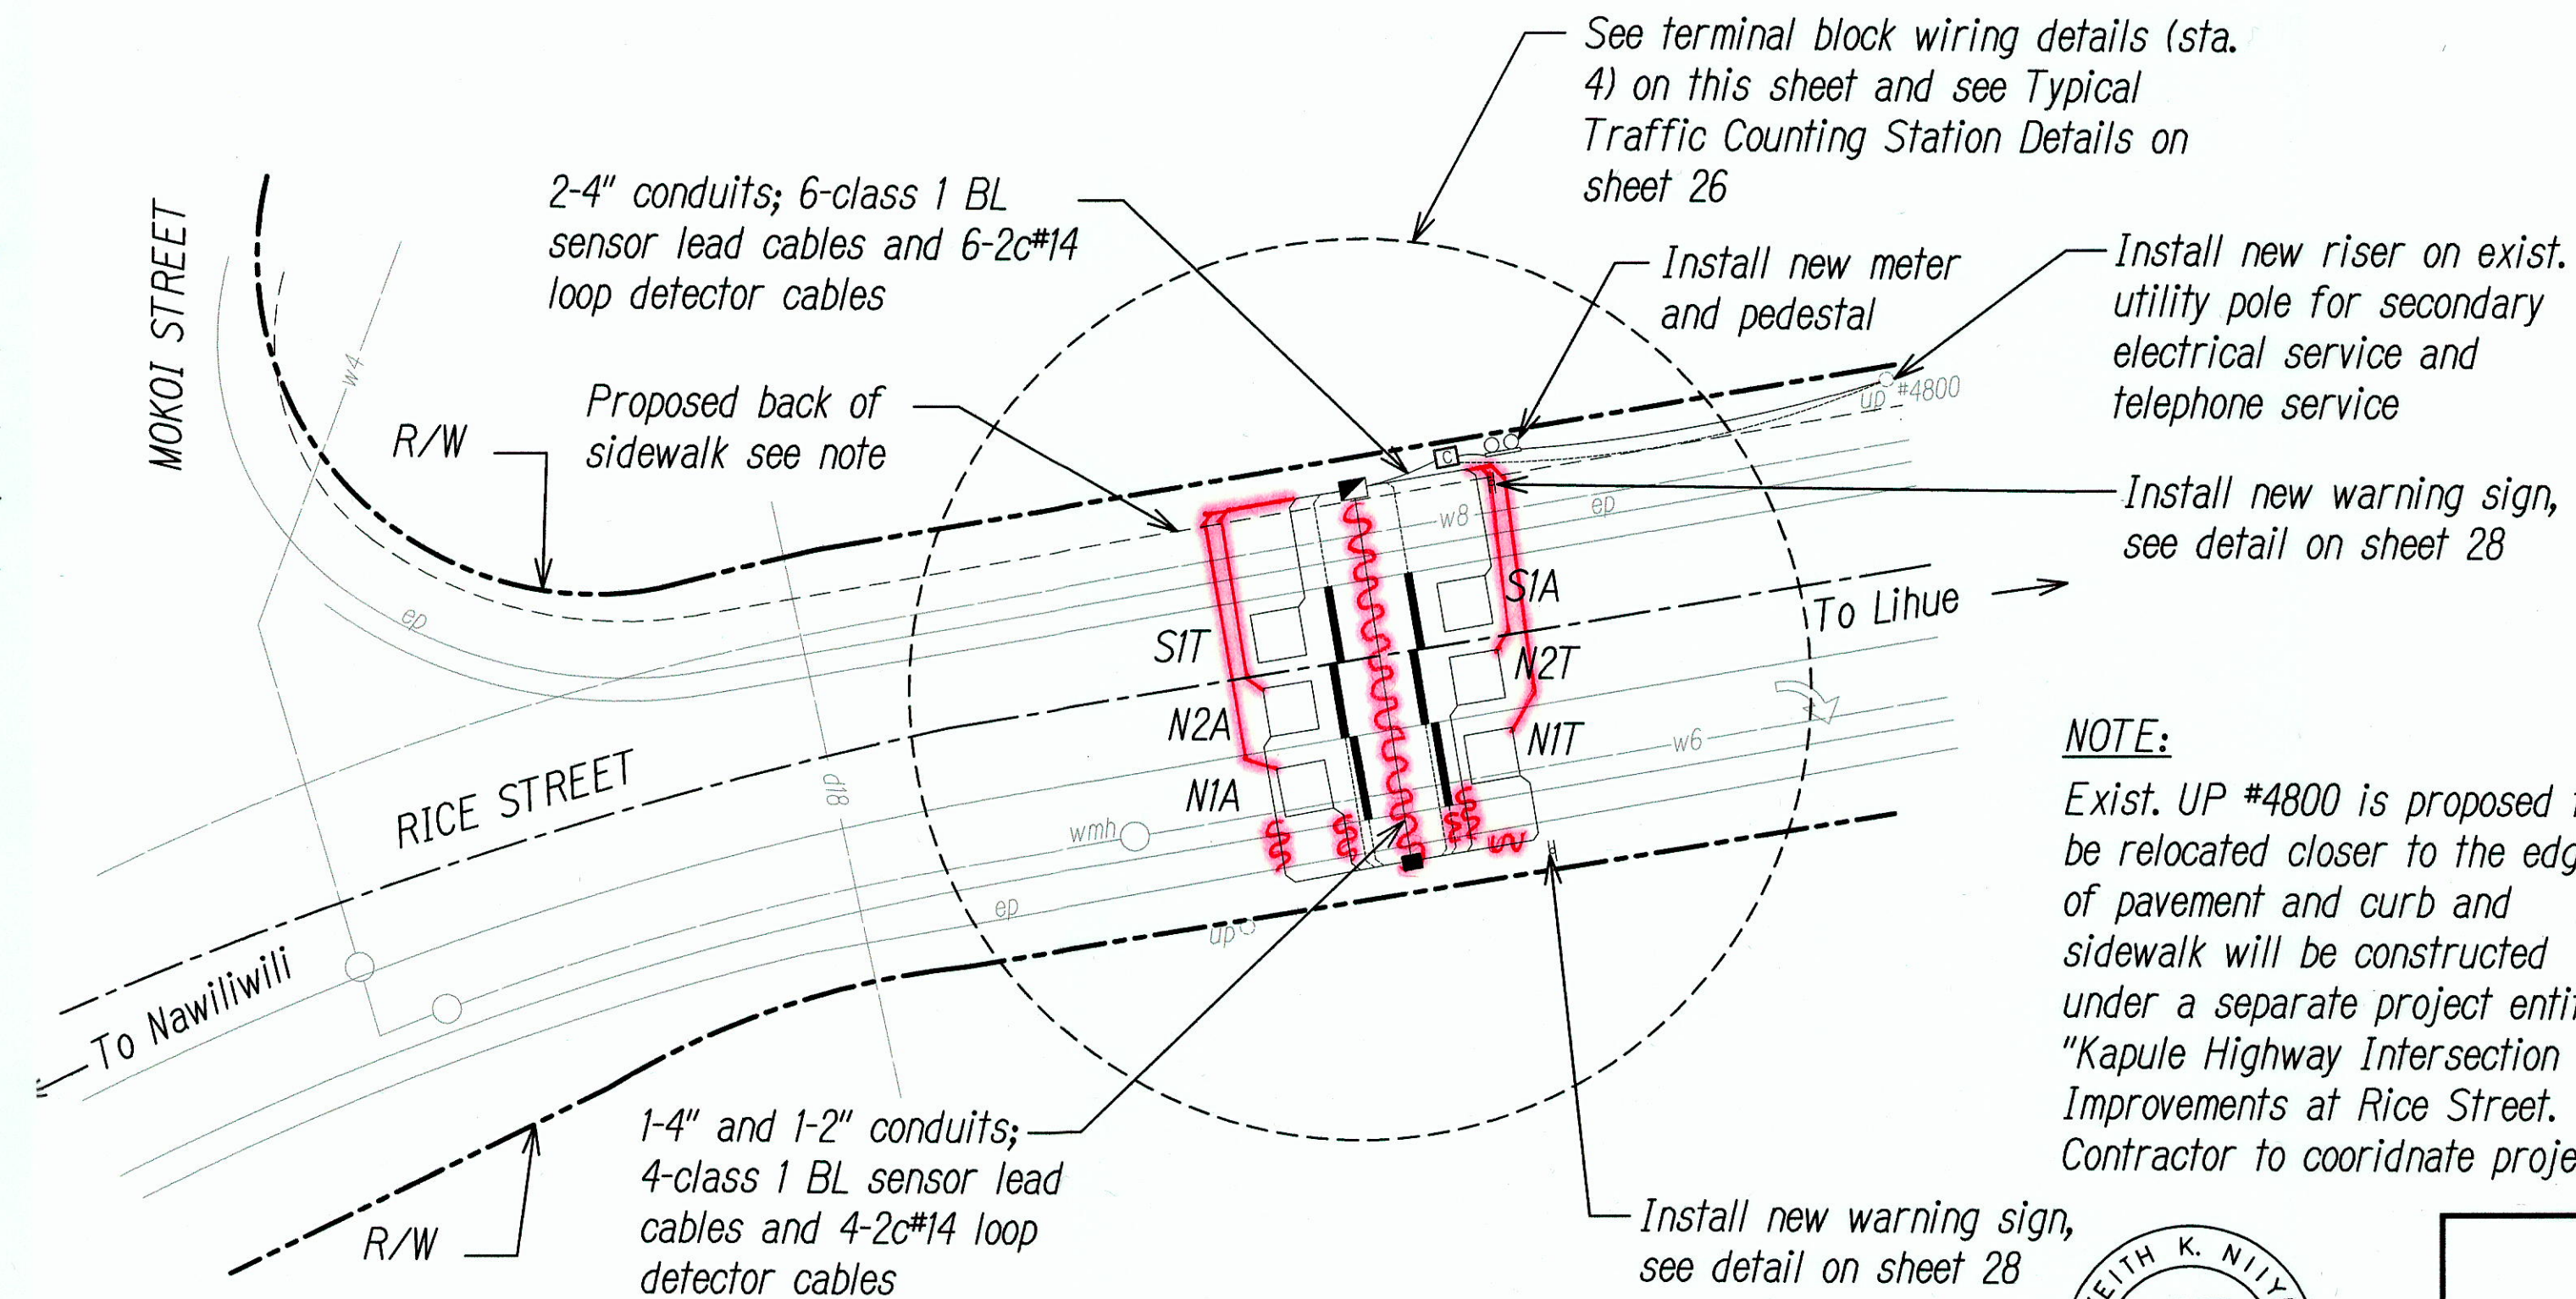

PROPOSED STA. 4 ON RICE STREET
ROUTE 51, M.P. 0.789, KAUAI
 Scale: 1"=20'

Loop label legend:
 N = North
 S = South
 A = Approaching
 T = Trailing

Top of Terminal Block

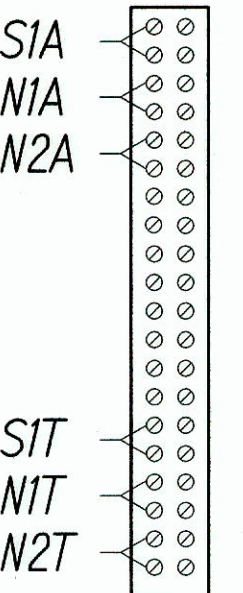


Bottom of Terminal Block

Connecting layout of loop lead-in wires to terminal block inside cabinet.

TERMINAL BLOCK WIRING
DETAILS (STA. 4)
 Not to Scale

NOTE:
 Exist. UP #4800 is proposed to be relocated closer to the edge of pavement and curb and sidewalk will be constructed under a separate project entitled "Kapule Highway Intersection Improvements at Rice Street. Contractor to coordinate projects.

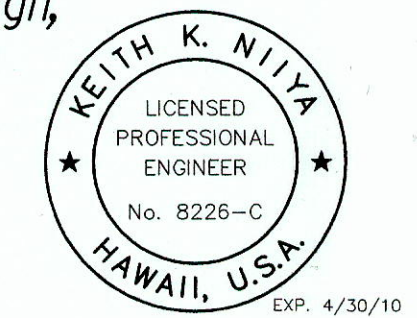

STATE OF HAWAII
DEPARTMENT OF TRANSPORTATION
HIGHWAYS DIVISION

TRAFFIC COUNTING STATION
PLANS - KAUAI - 1
TRAFFIC COUNTING STATIONS
AT VARIOUS LOCATIONS
F.A.P. NO. STP-1500(35)

Scale: 1"=20'
Date: June 2008




DATE	
DESIGNED BY	
CHECKED BY	
QUANTITIES BY	
NOTE BOOK	
ORIGINAL PLAN	

APPROVED:
Bruce Inoué
 Manager and Chief Engineer
 Department of Water, County of Kauai


7/1/08
 Date

"AS-BUILT"

FED. ROAD DIST. NO.	STATE	FEDERAL AID PROJ. NO.	FISCAL YEAR	SHEET NO.	TOTAL SHEETS
HAWAII	HAW.	STP-1500(35)	2008	13	39

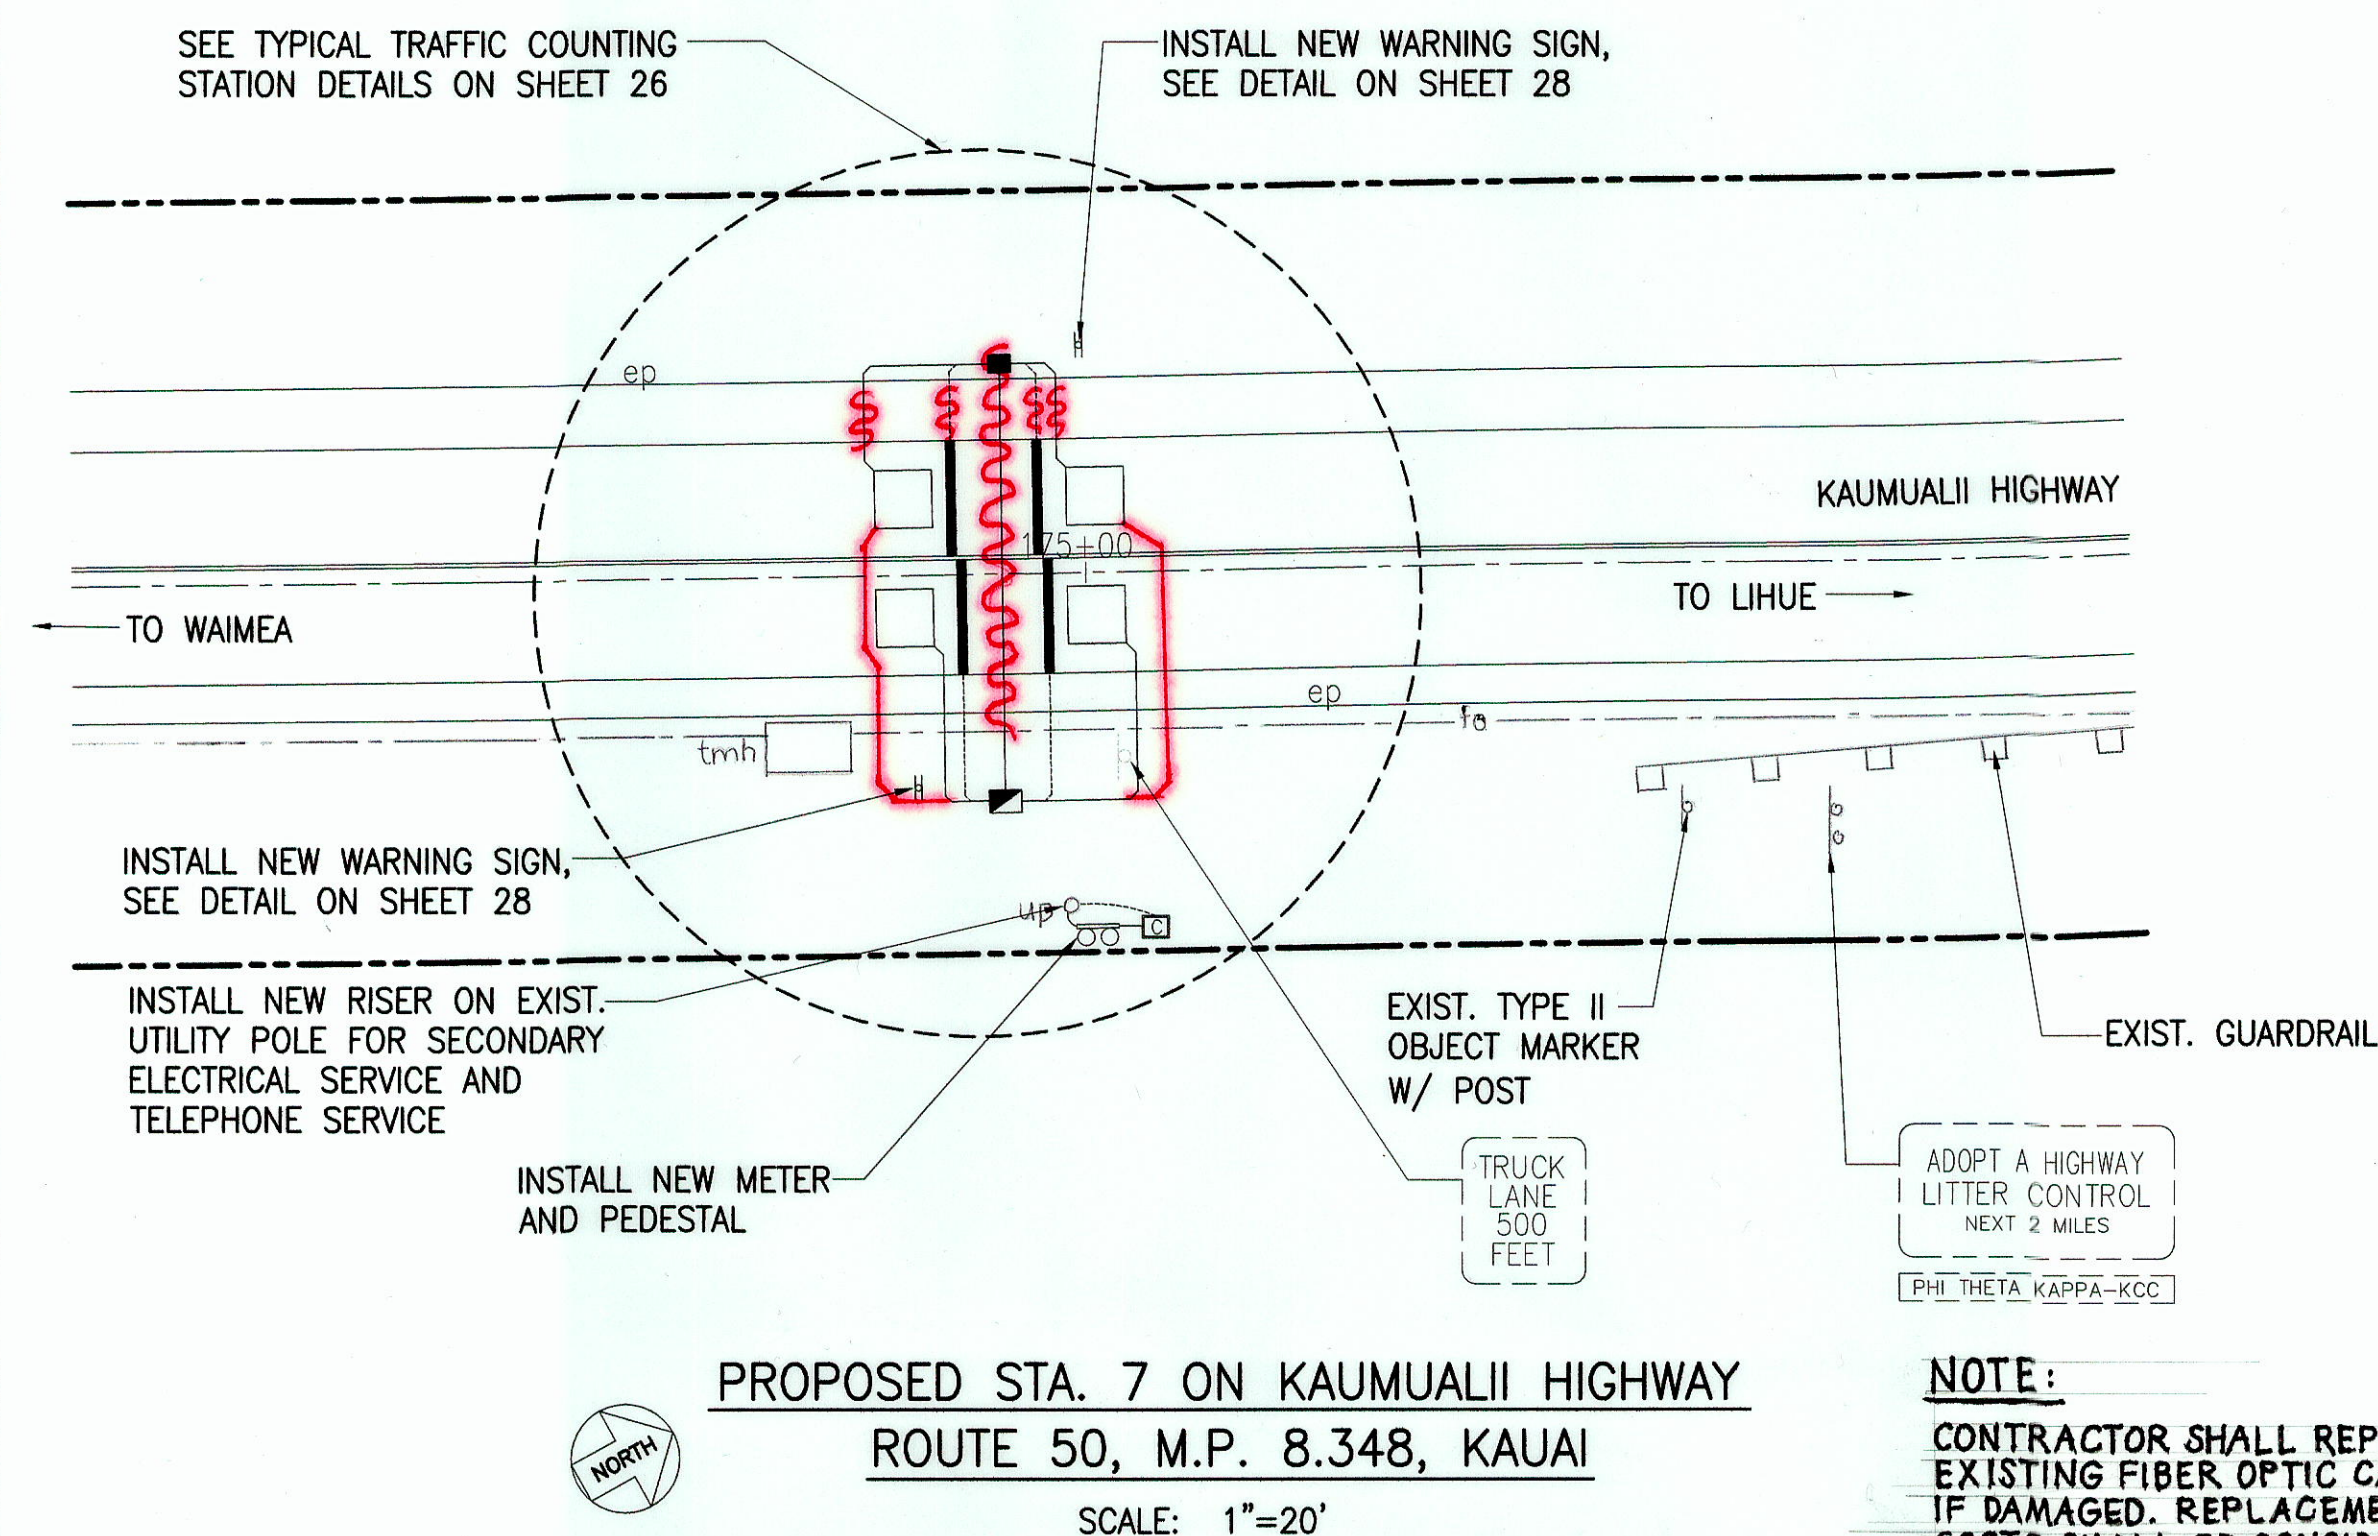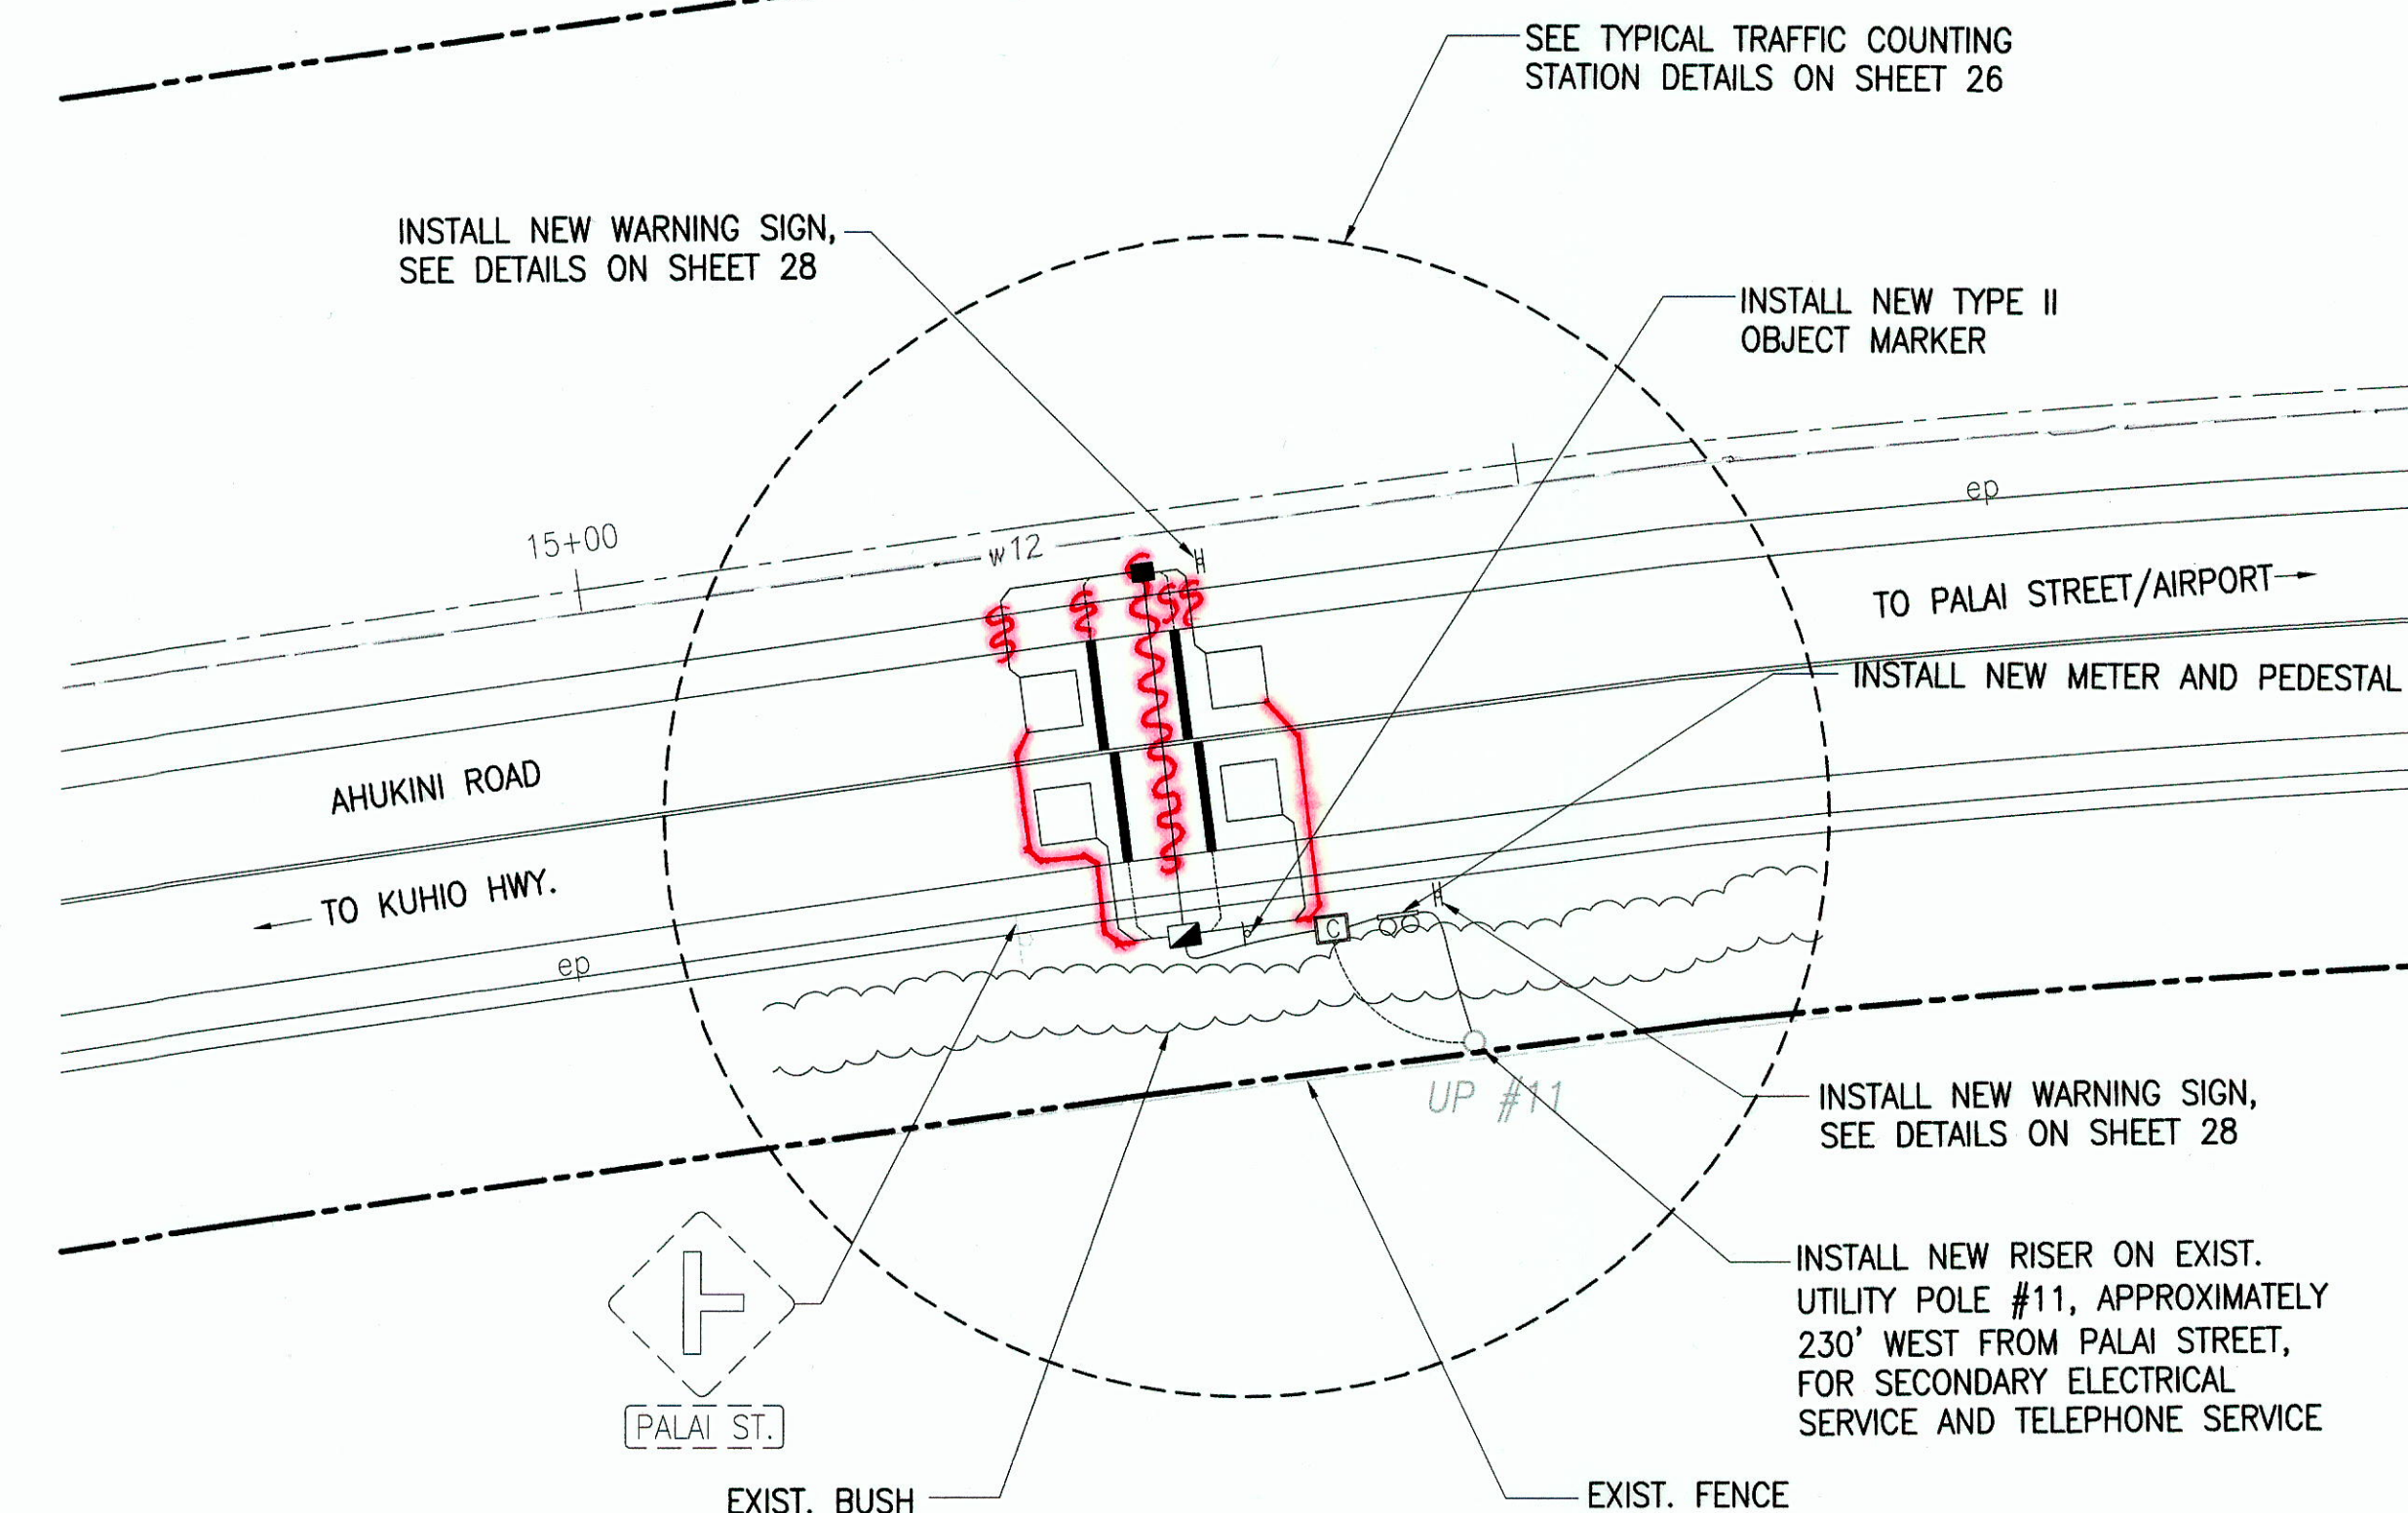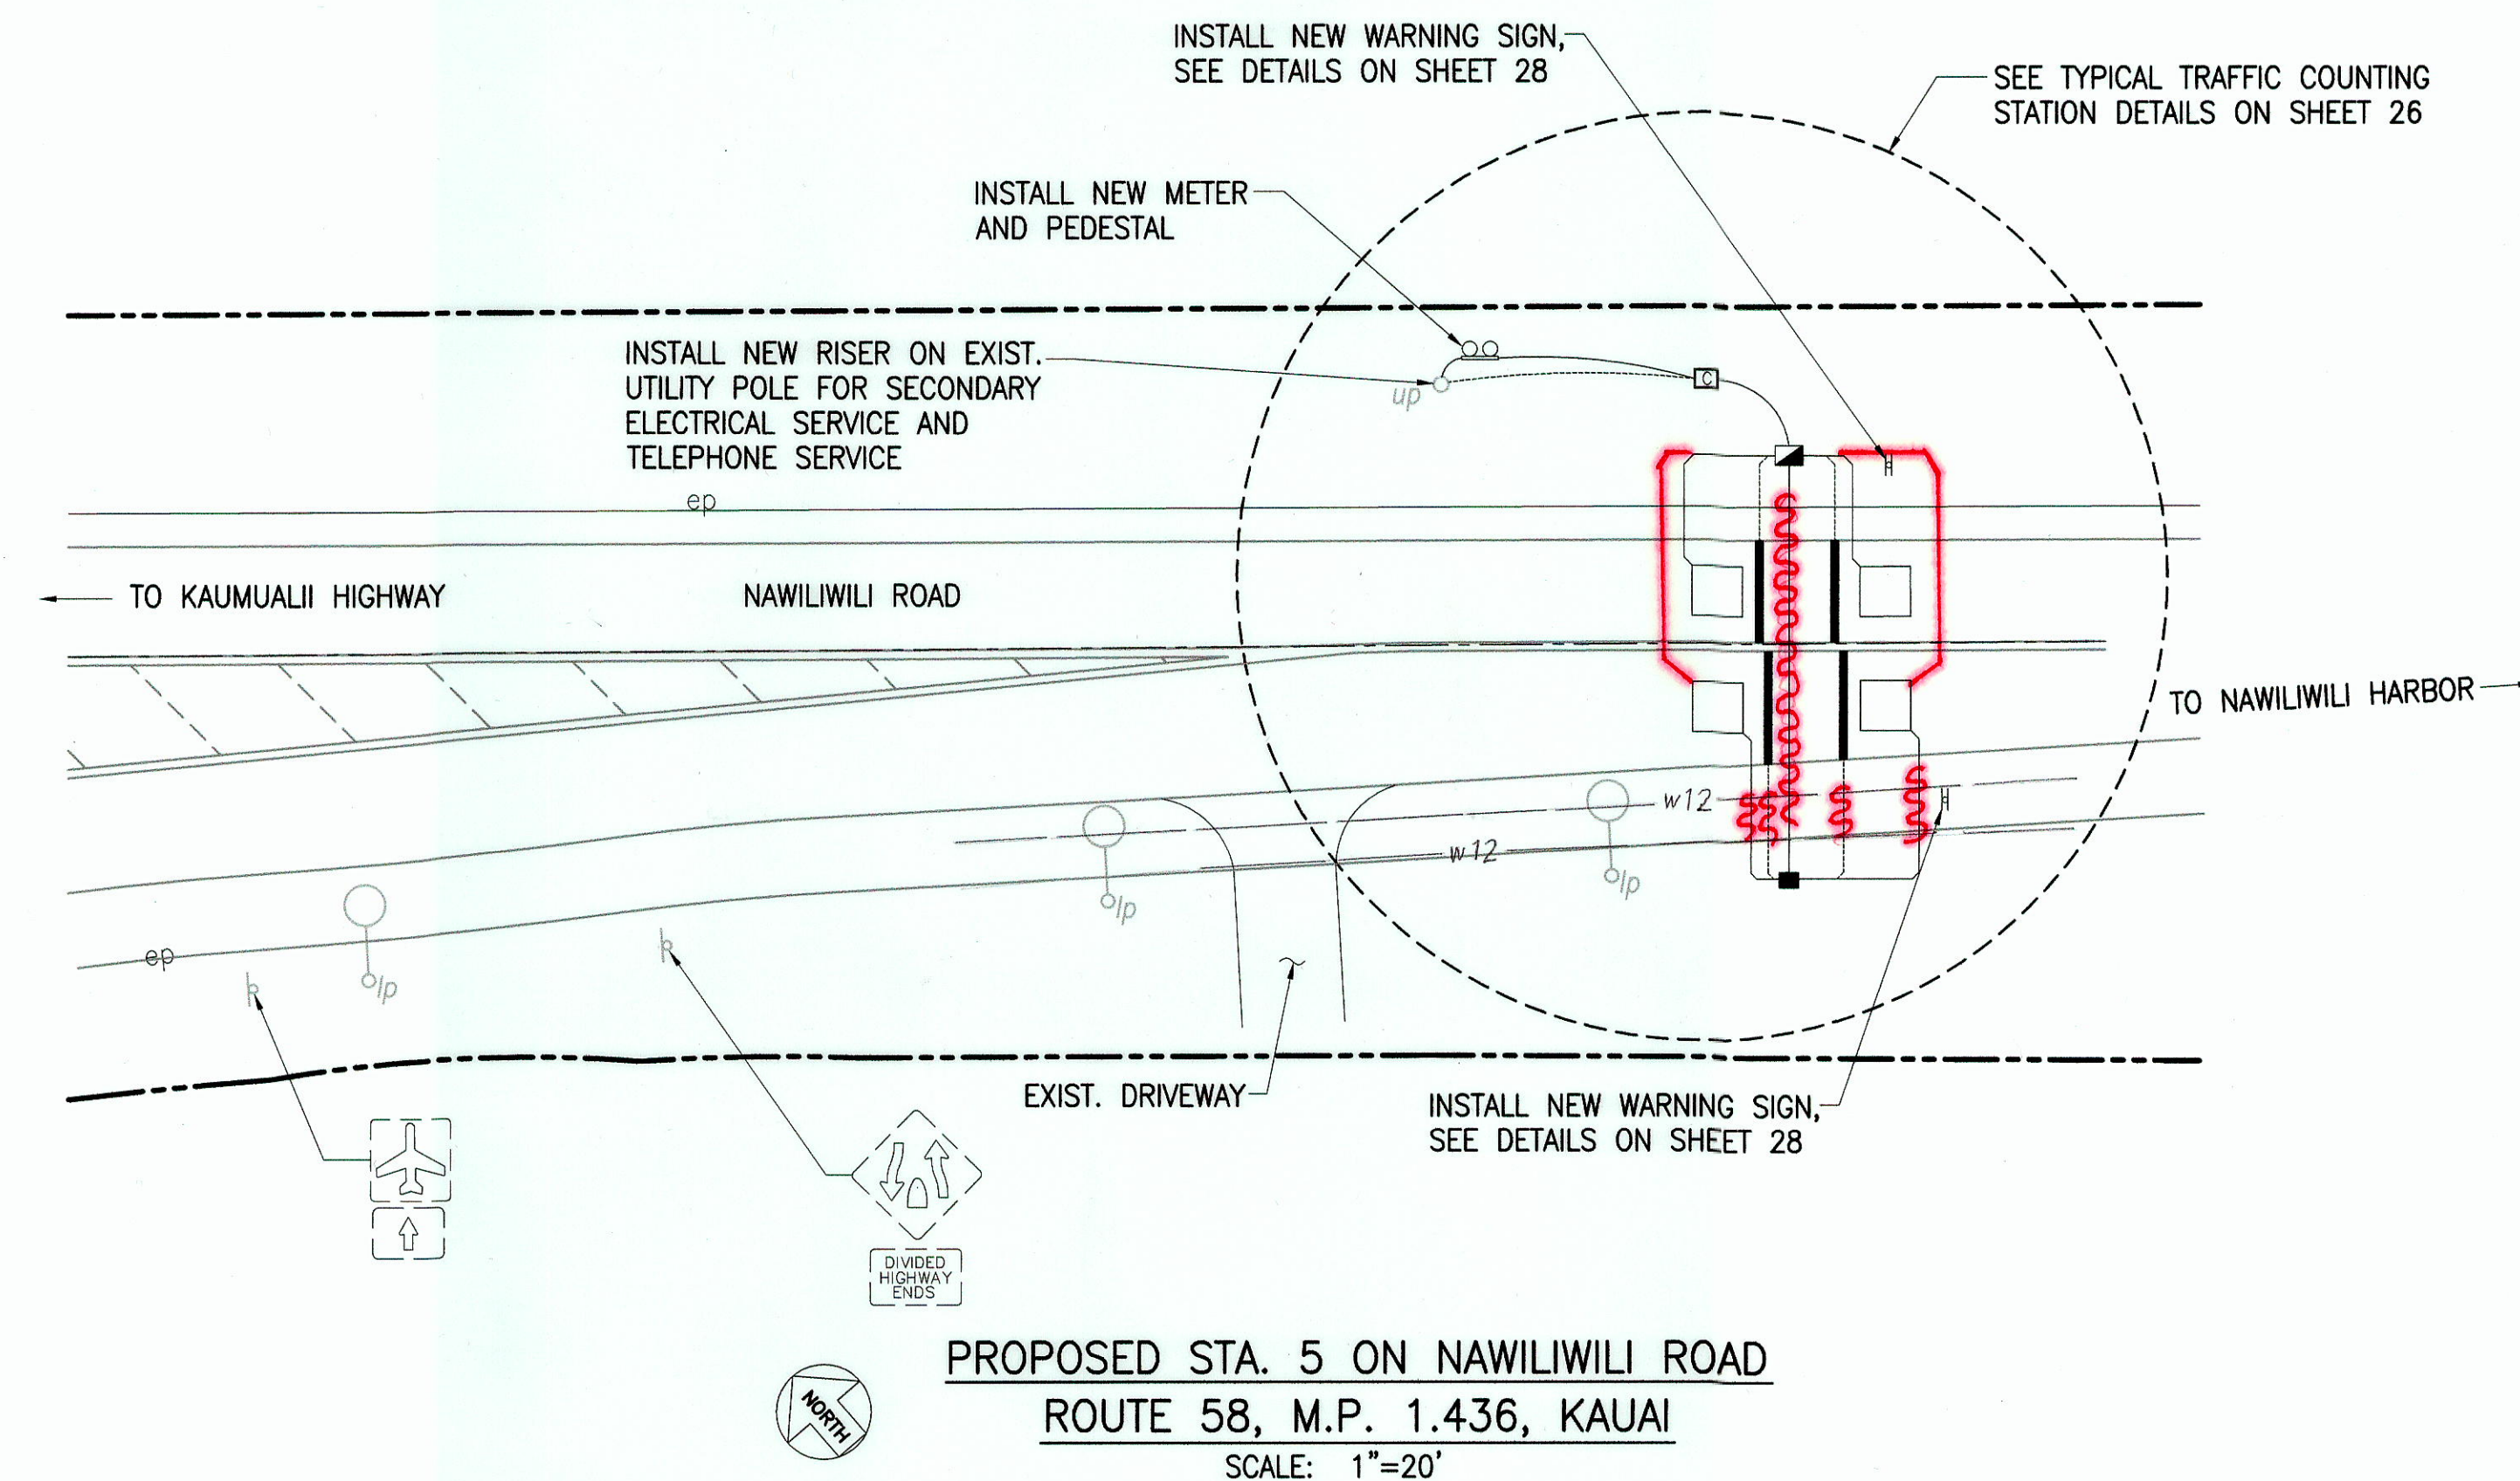

NOTE:
CONTRACTOR SHALL REPLACE EXISTING FIBER OPTIC CABLE IF DAMAGED. REPLACEMENT COSTS SHALL BE CONSIDERED INCIDENTAL.

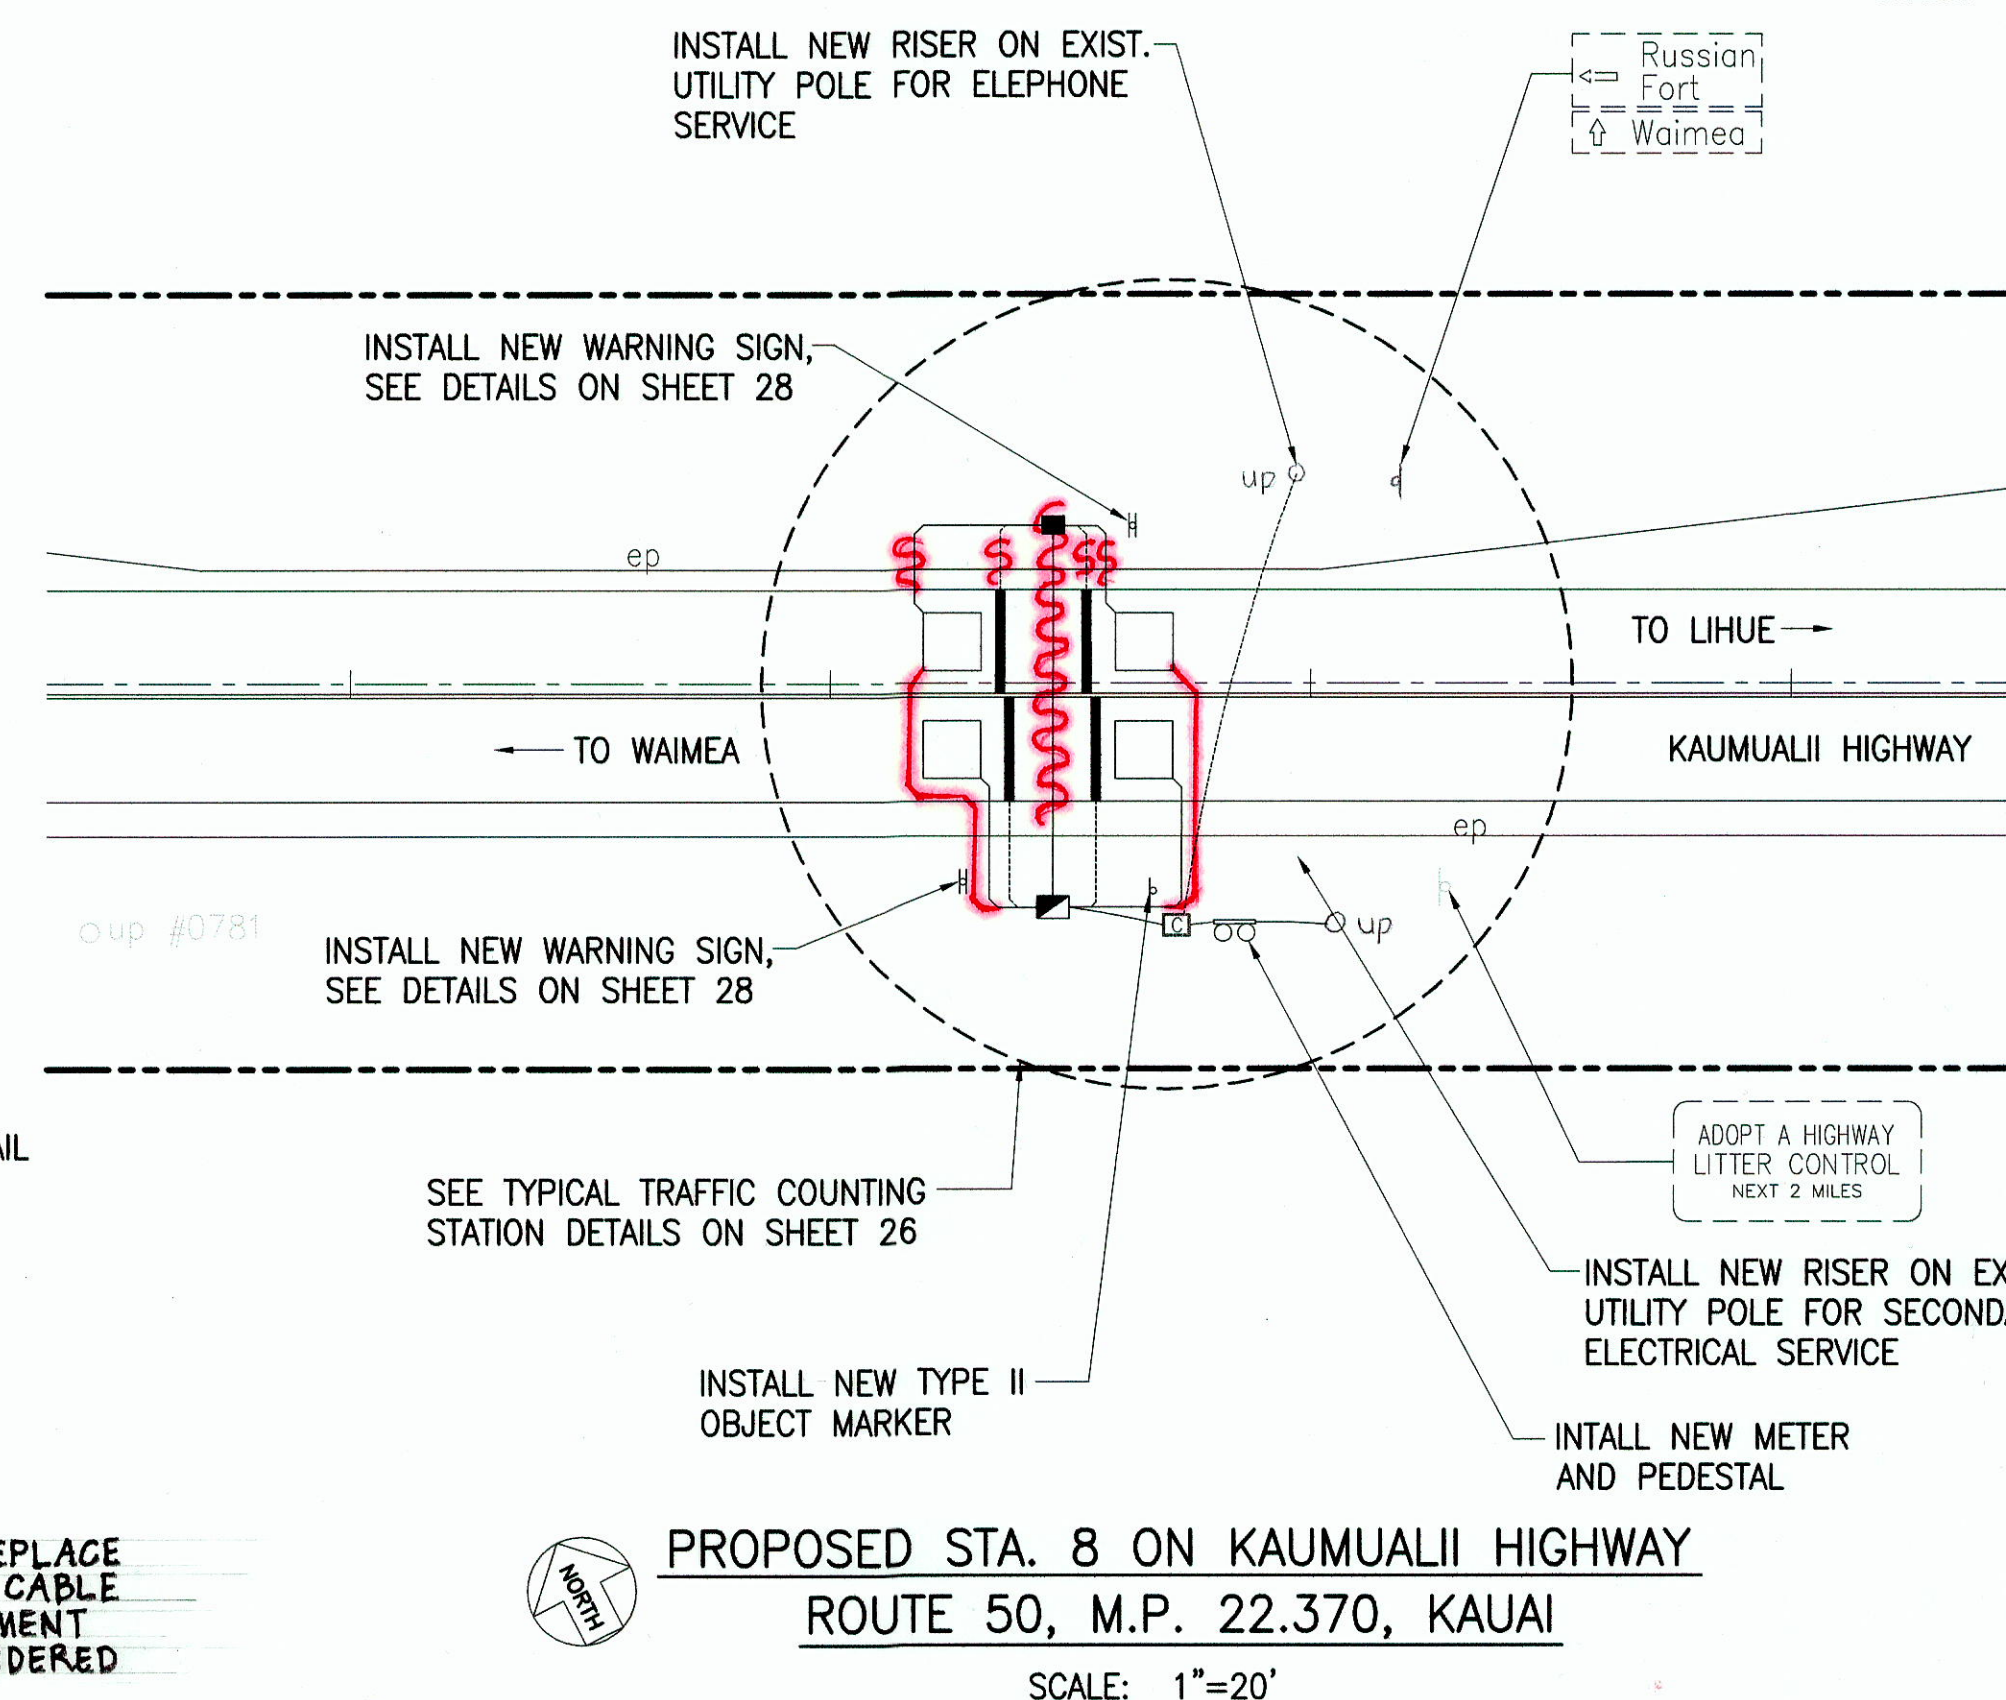

APPROVED:

for *Bruce Inoué*
MANAGER AND CHIEF ENGINEER
DEPARTMENT OF WATER, COUNTY OF KAUAI

5/14/08

DATE



STATE OF HAWAII
DEPARTMENT OF TRANSPORTATION
HIGHWAYS DIVISION
TRAFFIC COUNTING STATION
PLANS - KAUAI - 2
TRAFFIC COUNTING STATIONS
AT VARIOUS LOCATIONS
F.A.P. NO. STP-1500(35)

SCALE: 1"=20' DATE: MAY 2008

SHEET No. C-6 OF 24 SHEETS

"AS-BUILT"