


FED. ROAD DIST. NO.	STATE	PROJ. NO.	FISCAL YEAR	SHEET NO.	TOTAL SHEETS
HAWAII	HAW.	HWY-0-05-09	2009	9	9

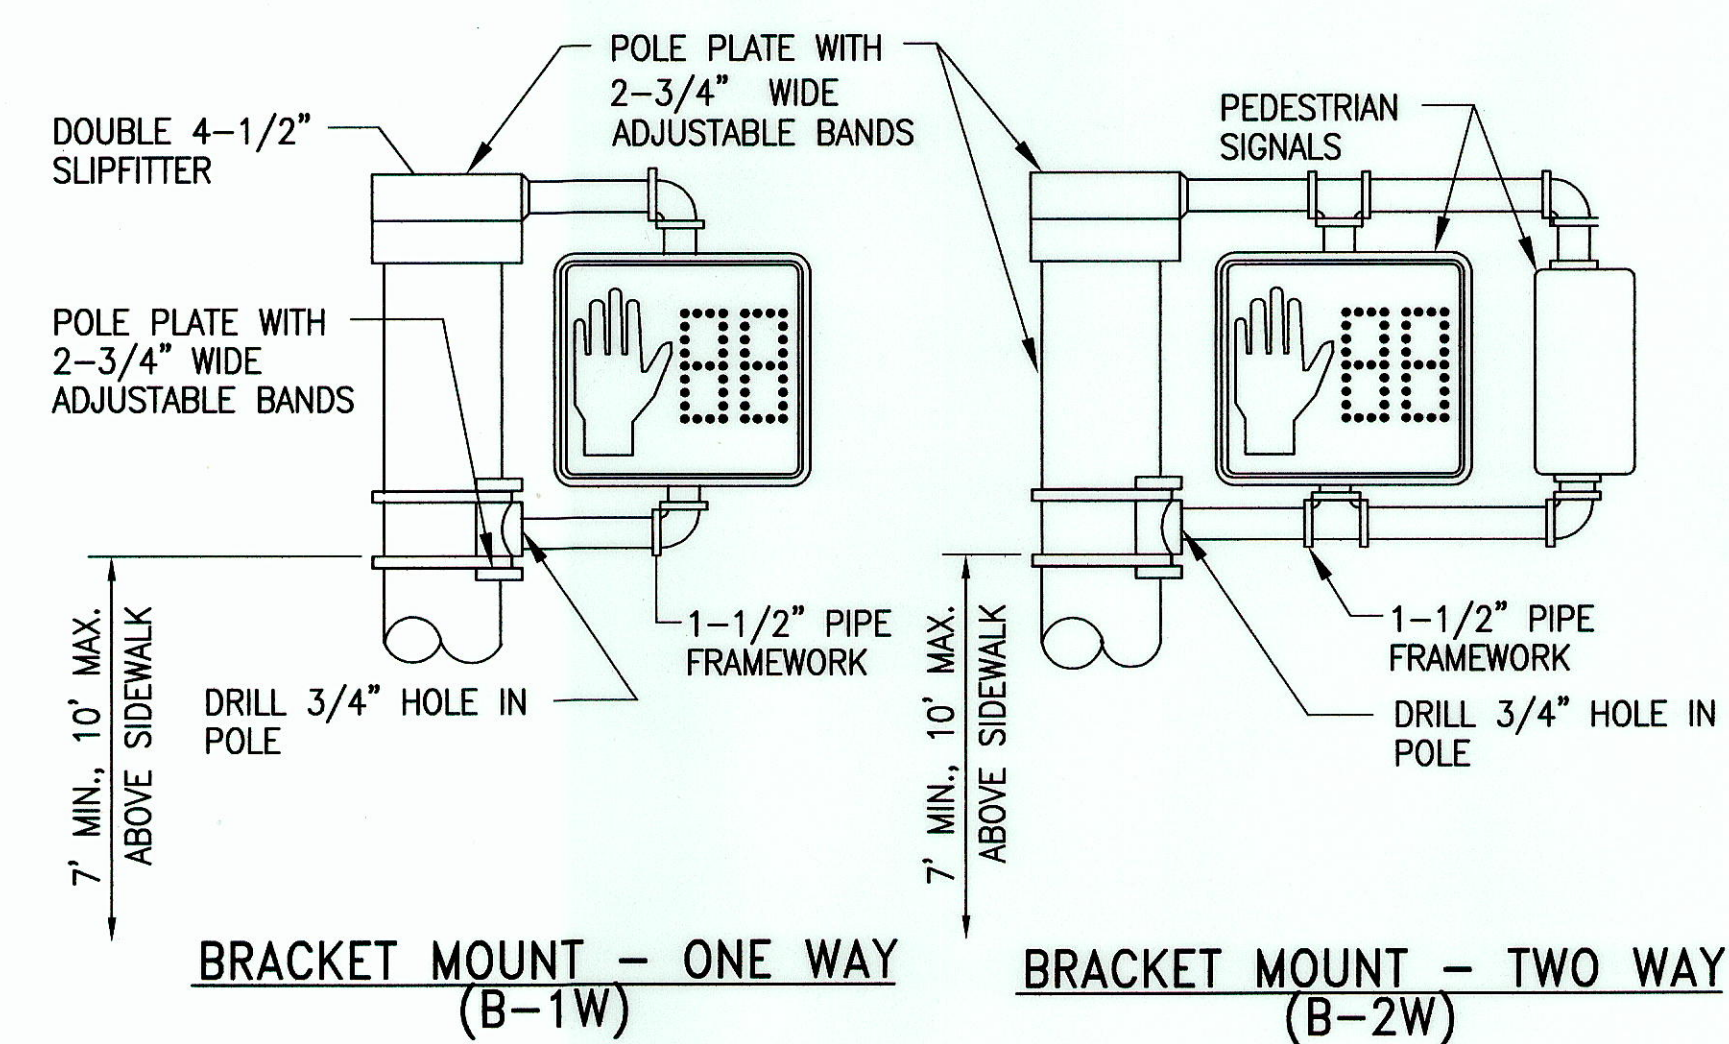

PEDESTRIAN SIGNAL MOUNTINGS DETAIL
SCALE: NOT TO SCALE

ORIGINAL PLAN	SURVEY PLOTTED BY	DATE
NOTE BOOK	DRAWN BY	
	CHECKED BY	
	QUANTITIES BY	
	CHECKED BY	



THIS WORK WAS PREPARED BY ME OR UNDER MY SUPERVISION AND CONSTRUCTION OF THIS PROJECT WILL BE UNDER MY OBSERVATION.

Cathy A. Leong APRIL 30, 2010
WILSON OKAMOTO CORRO LIC. EXP. DATE

STATE OF HAWAII
DEPARTMENT OF TRANSPORTATION
HIGHWAYS DIVISION

DETAIL

PEDESTRIAN COUNTDOWN TIMERS
PHASE 1

Proj. No. HWY-0-05-09

Scale: Not to Scale Date: August 2009

SHEET No. 9 OF 9 SHEETS

DATE	REVISION

"AS-BUILT"