



FED. ROAD DIST. NO.	STATE	PROJ. NO.	FISCAL YEAR	SHEET NO.	TOTAL SHEETS
HAWAII	HAW.	HWY-0-05-09	2009	4	9

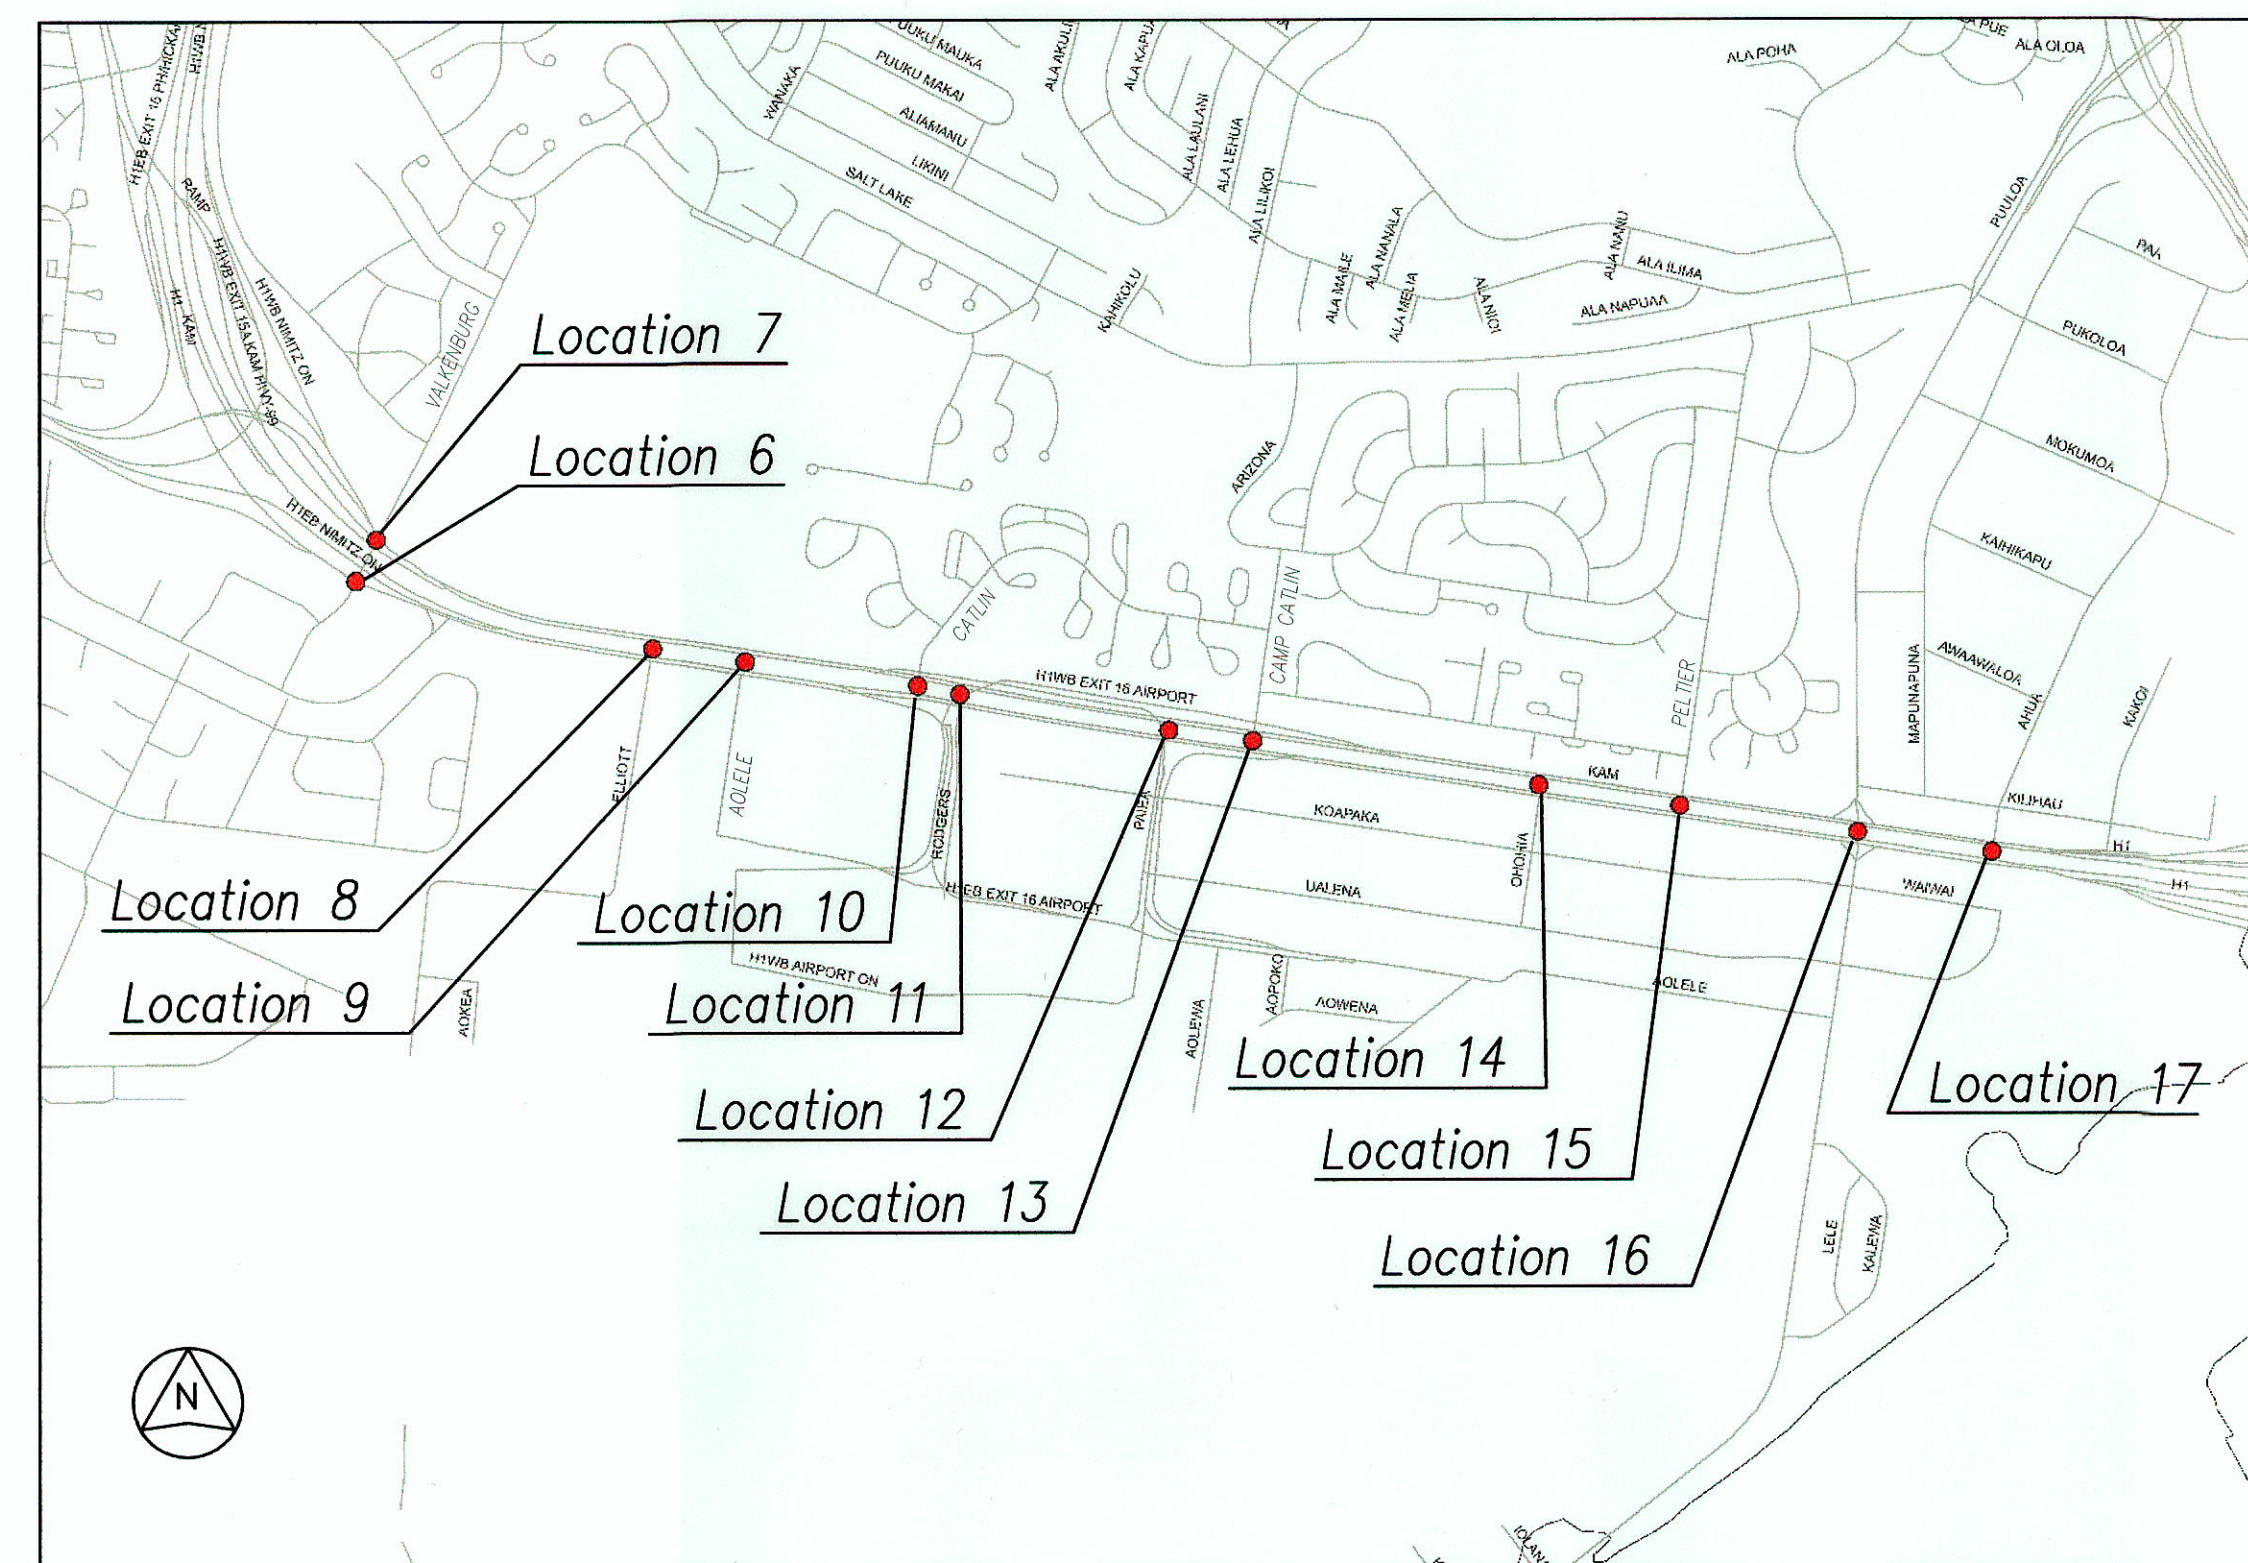


Downtown (Route 92)

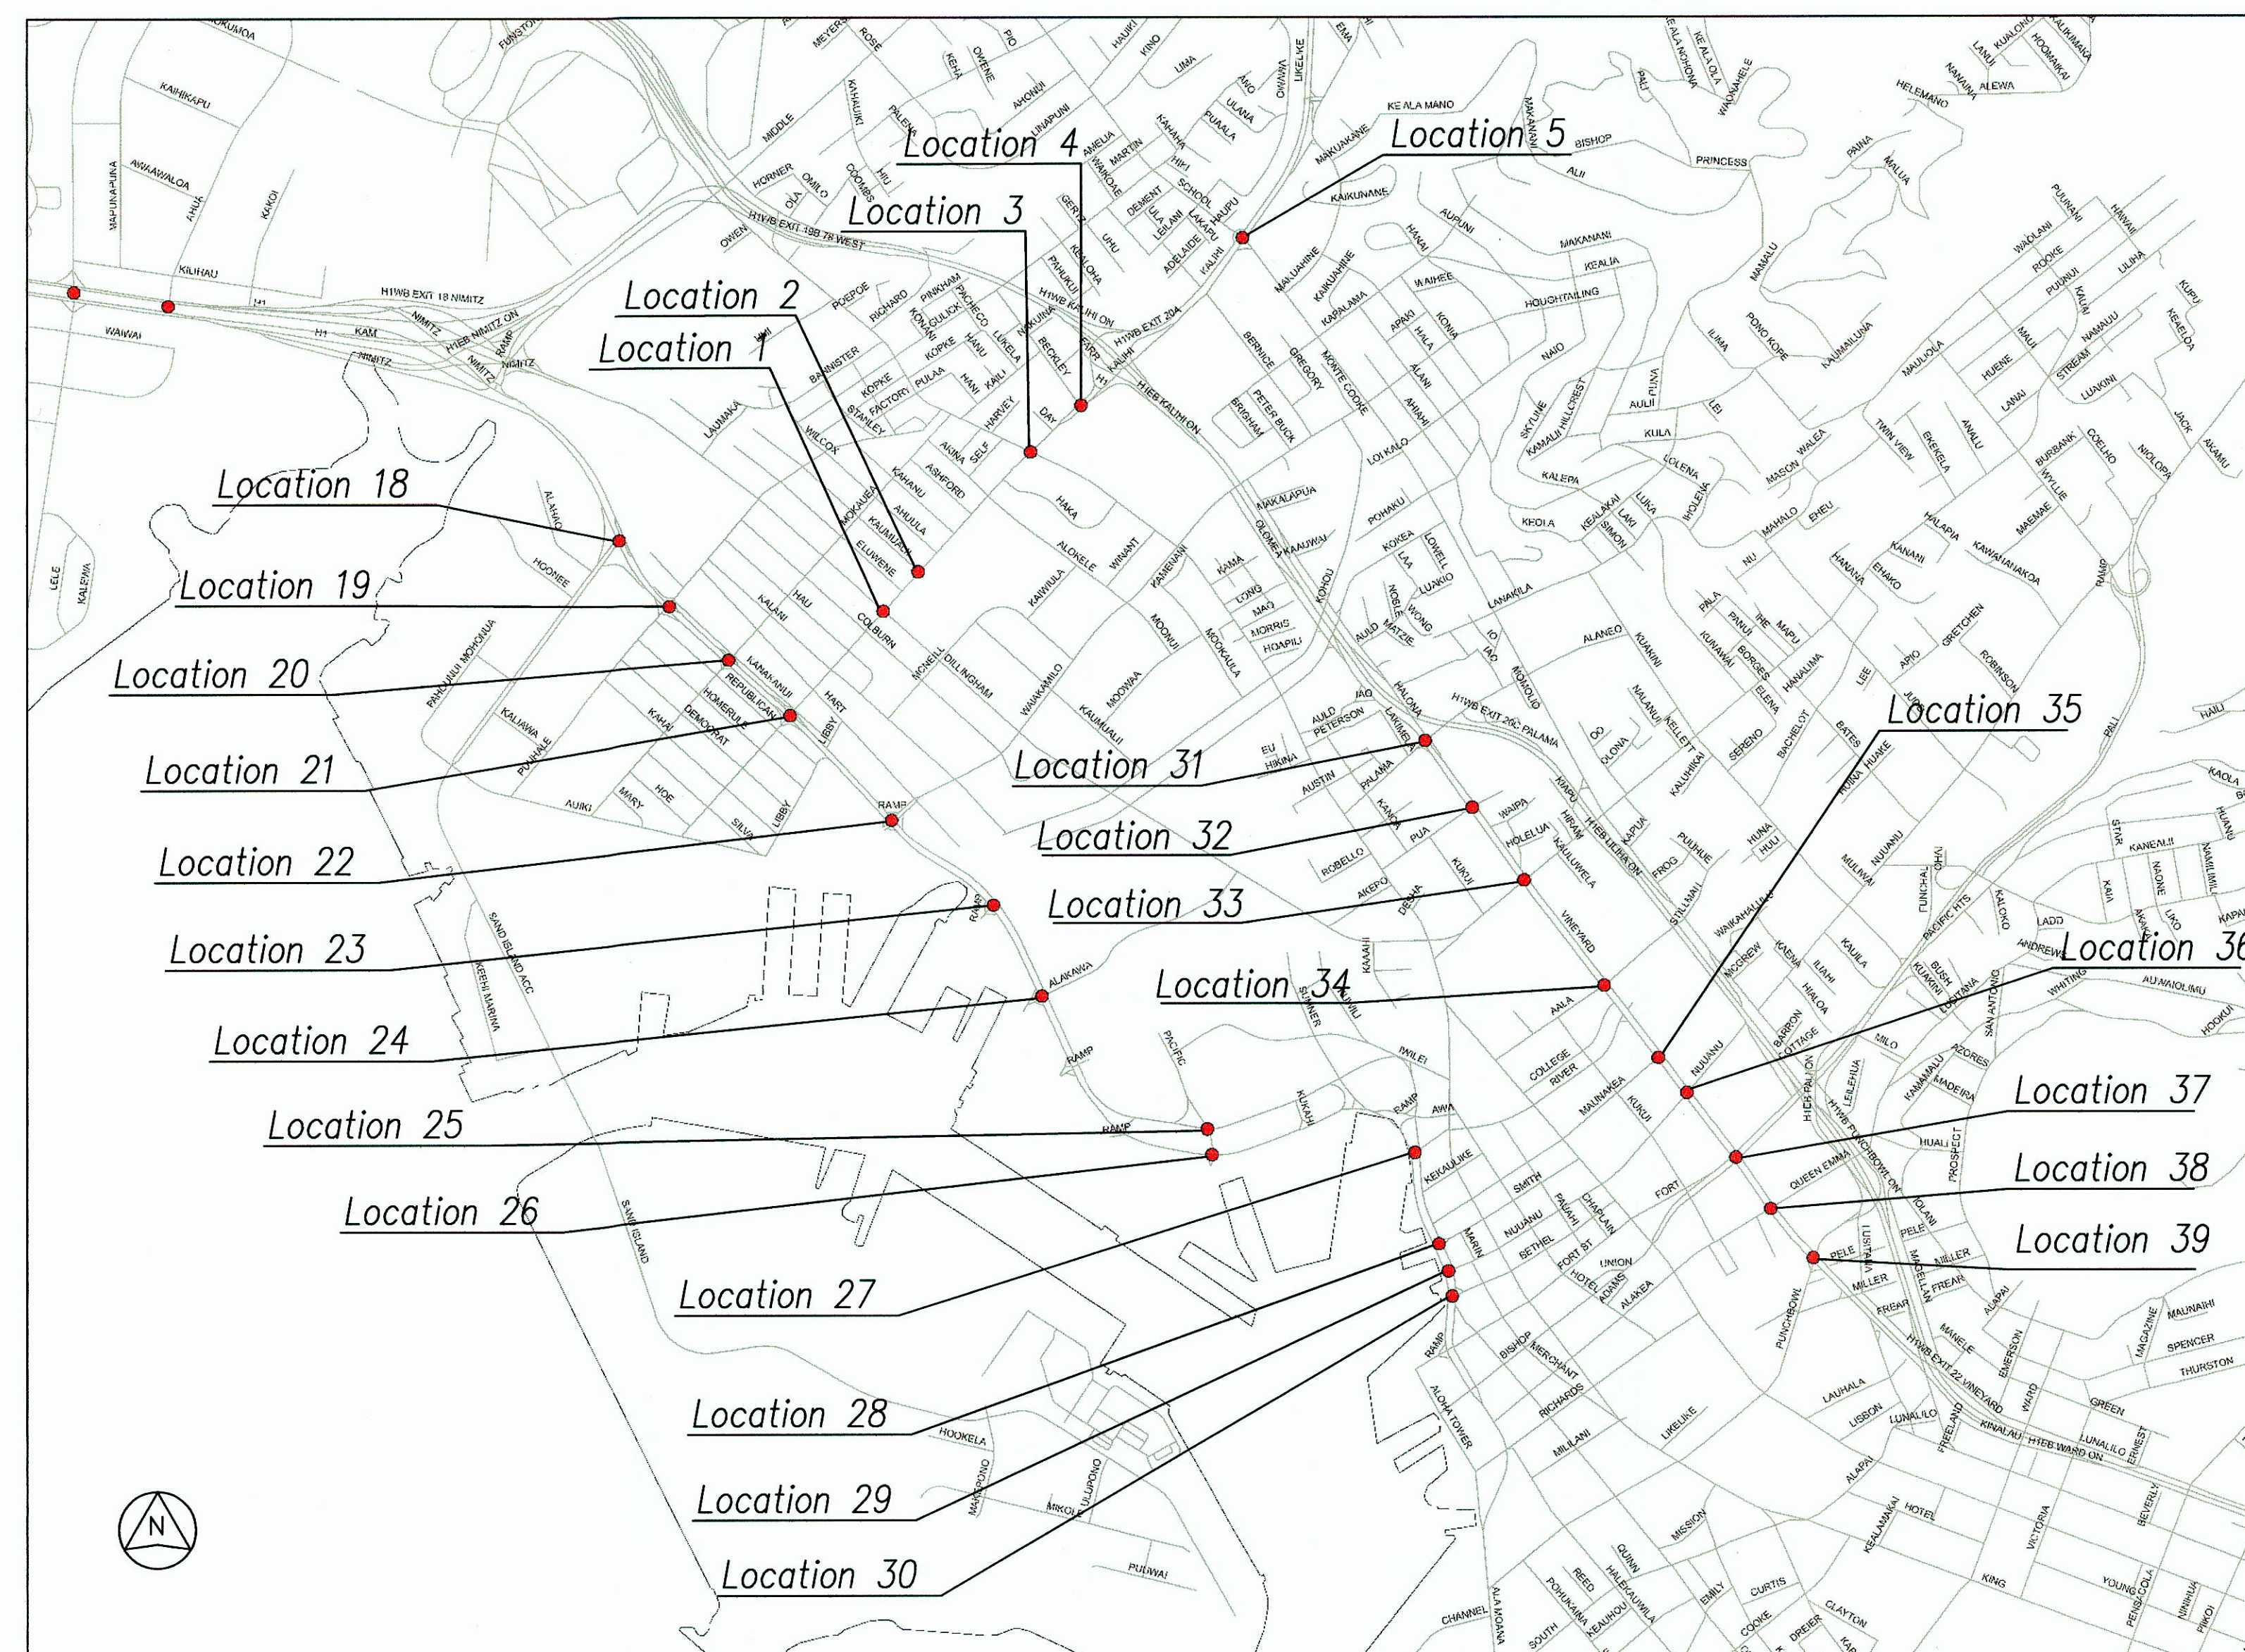


Downtown (Route 63, 92, & 98)

Downtown (Route 63, 92, & 98)

SURVEY PLOTTED BY	DATE
DRAWN BY	
DESIGNED BY	
QUANTITIES BY	
CHECKED BY	
ORIGINAL PLAN	
NOTE BOOK	
No.	

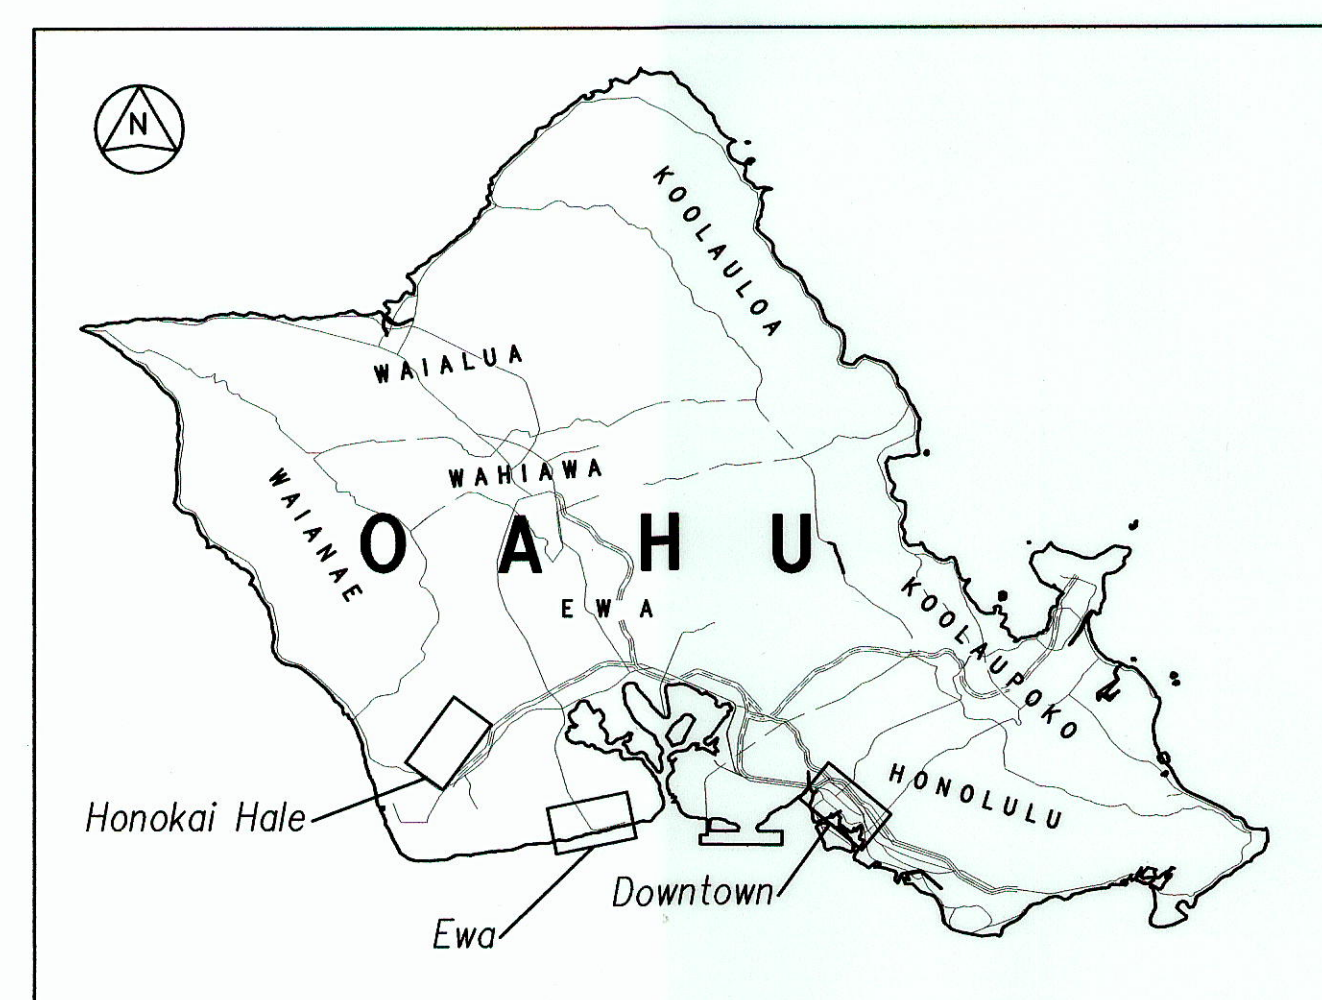

LEGEND FOR AS-BUILT POSTINGS	
	Squiggly line for as-built deletion
	Double line for as-built deletion
	Text for as-built posting

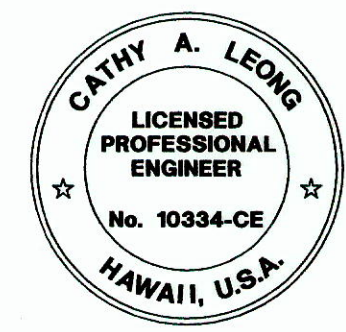

THIS WORK WAS PREPARED BY ME OR UNDER MY SUPERVISION AND CONSTRUCTION OF THIS PROJECT WILL BE UNDER MY OBSERVATION.
 APRIL 30, 2010
 WILSON OKAMOTO CORP. LIC. EXP. DATE

STATE OF HAWAII
 DEPARTMENT OF TRANSPORTATION
 HIGHWAYS DIVISION

LOCATION MAP

PEDESTRIAN COUNTDOWN TIMERS
 PHASE 1


Proj. No. HWY-0-05-09

Scale: Not to Scale Date: August 2009


SHEET No. 4 OF 9 SHEETS

"AS-BUILT"


FED. ROAD DIST. NO.	STATE	PROJ. NO.	FISCAL YEAR	SHEET NO.	TOTAL SHEETS
HAWAII	HAW.	HWY-0-05-09	2009	6S-1	9

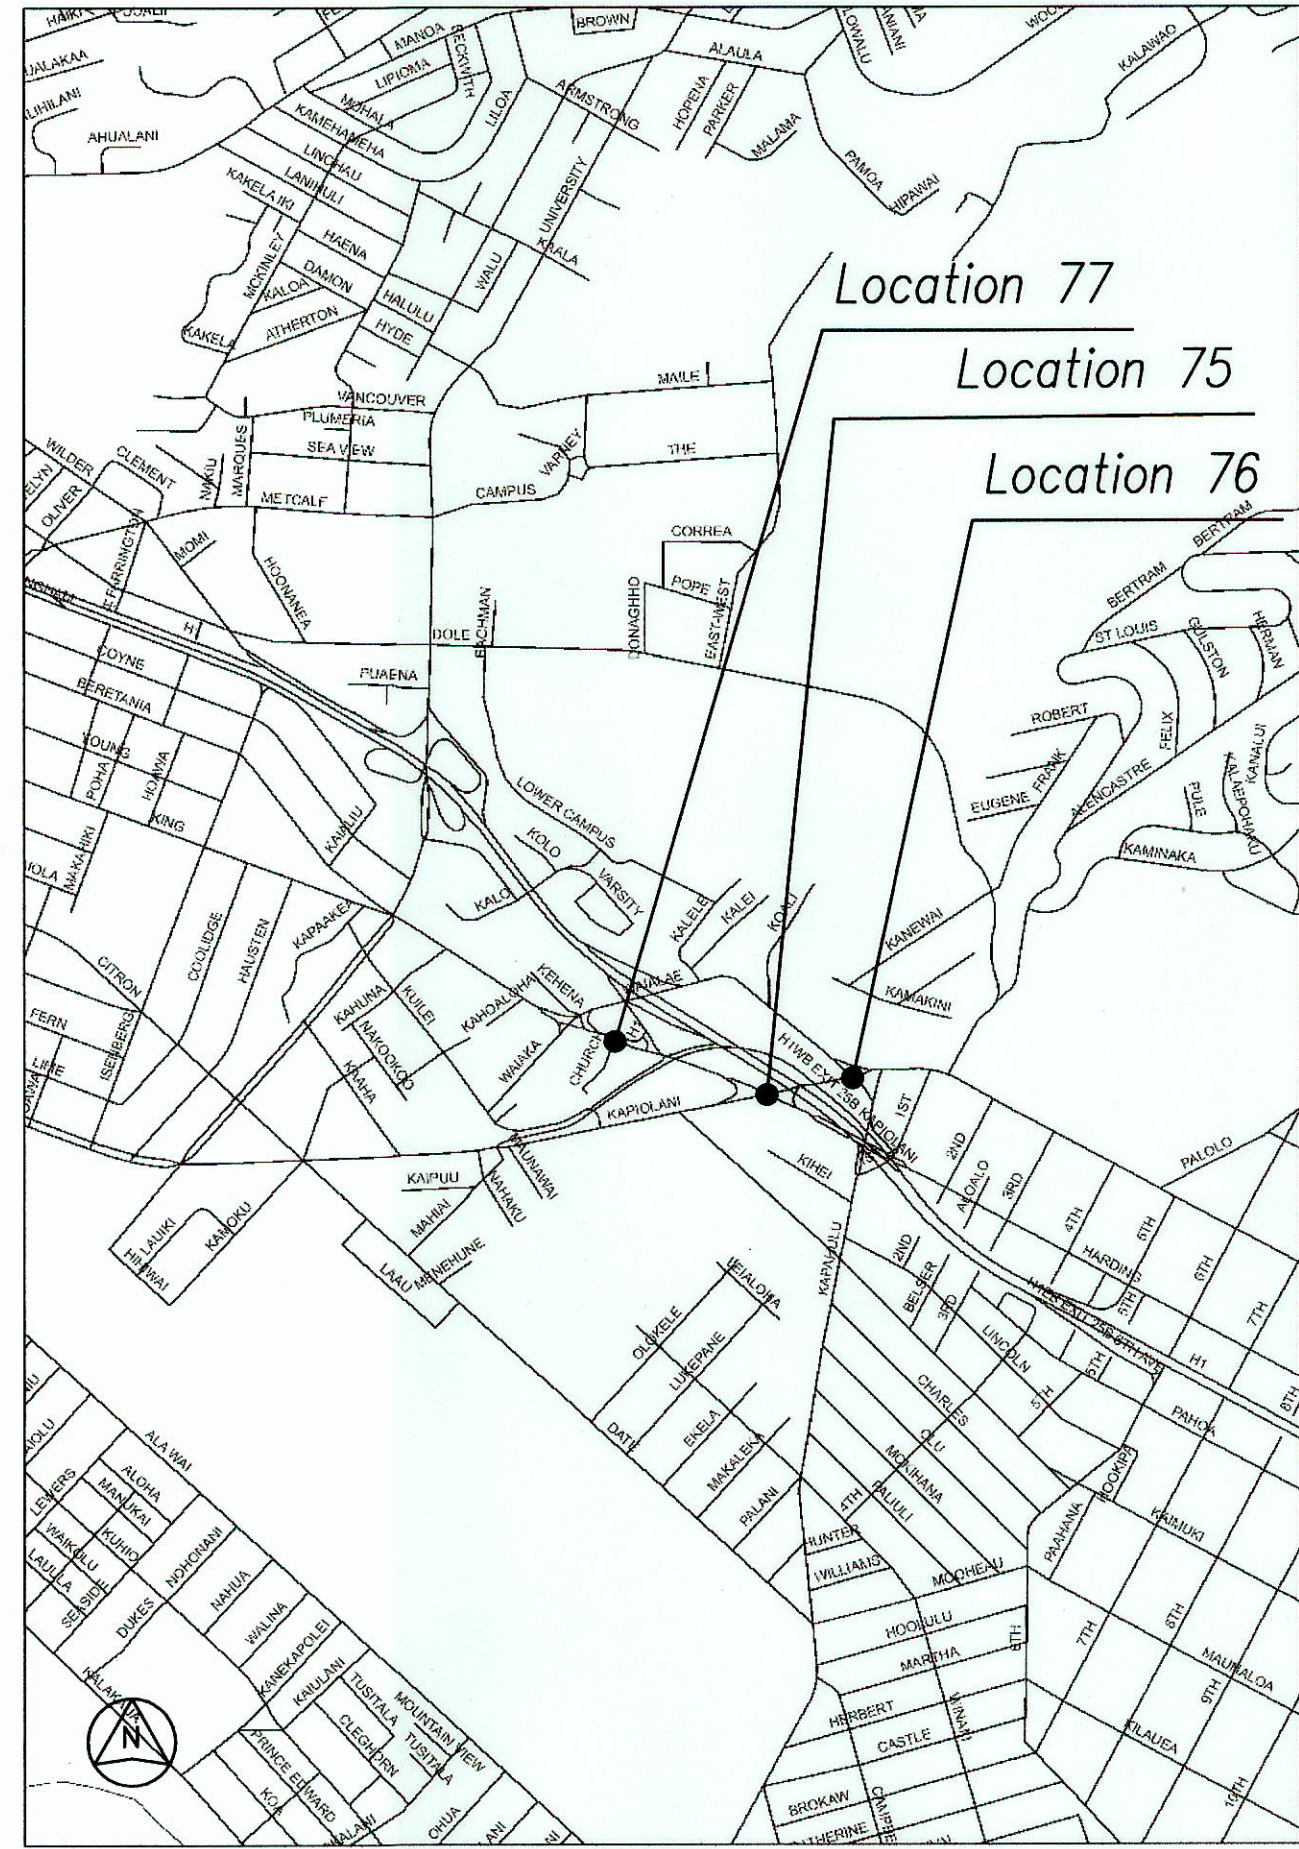

Waialae Loop

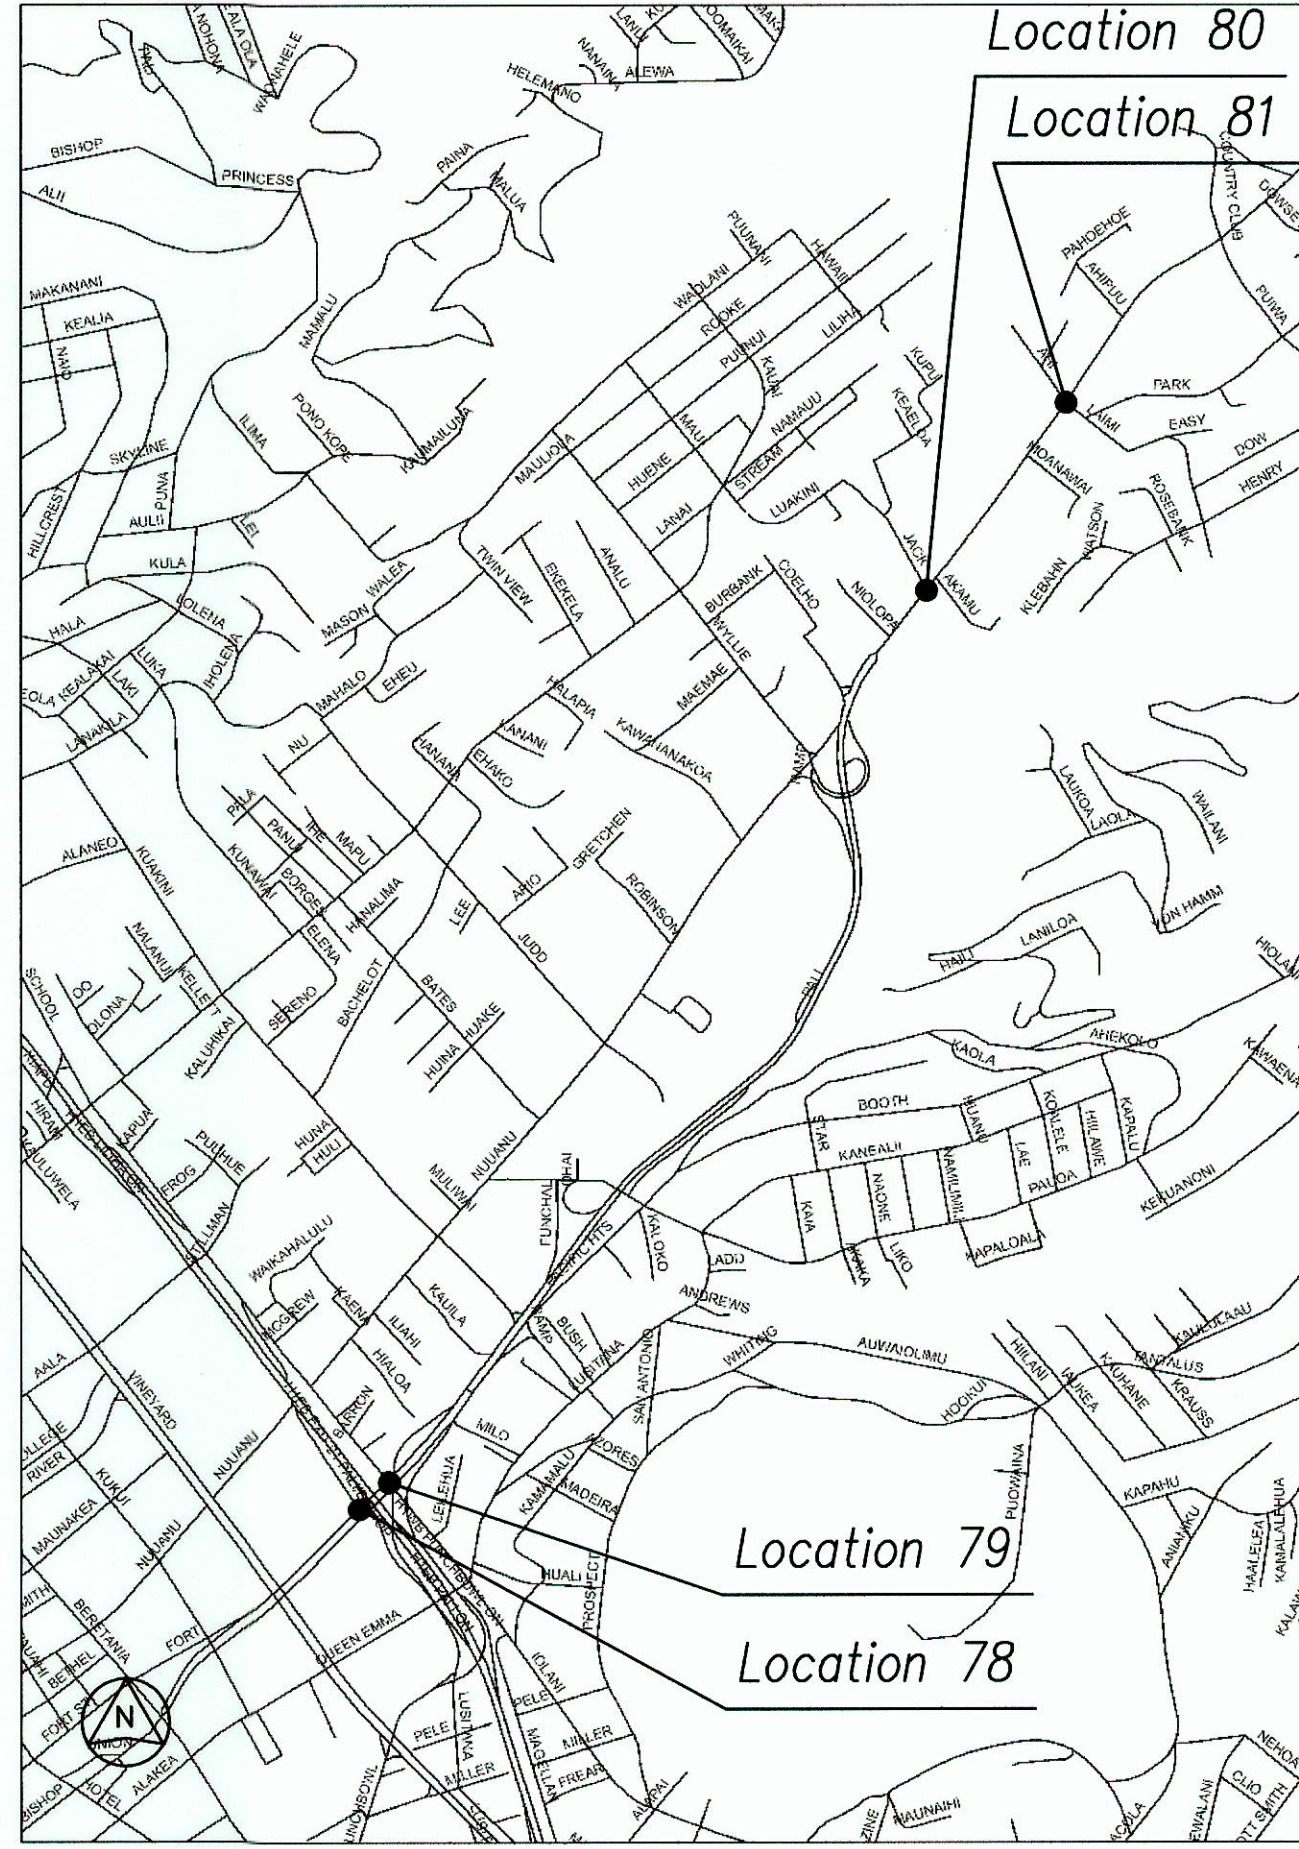


Pali Highway (Route 61)

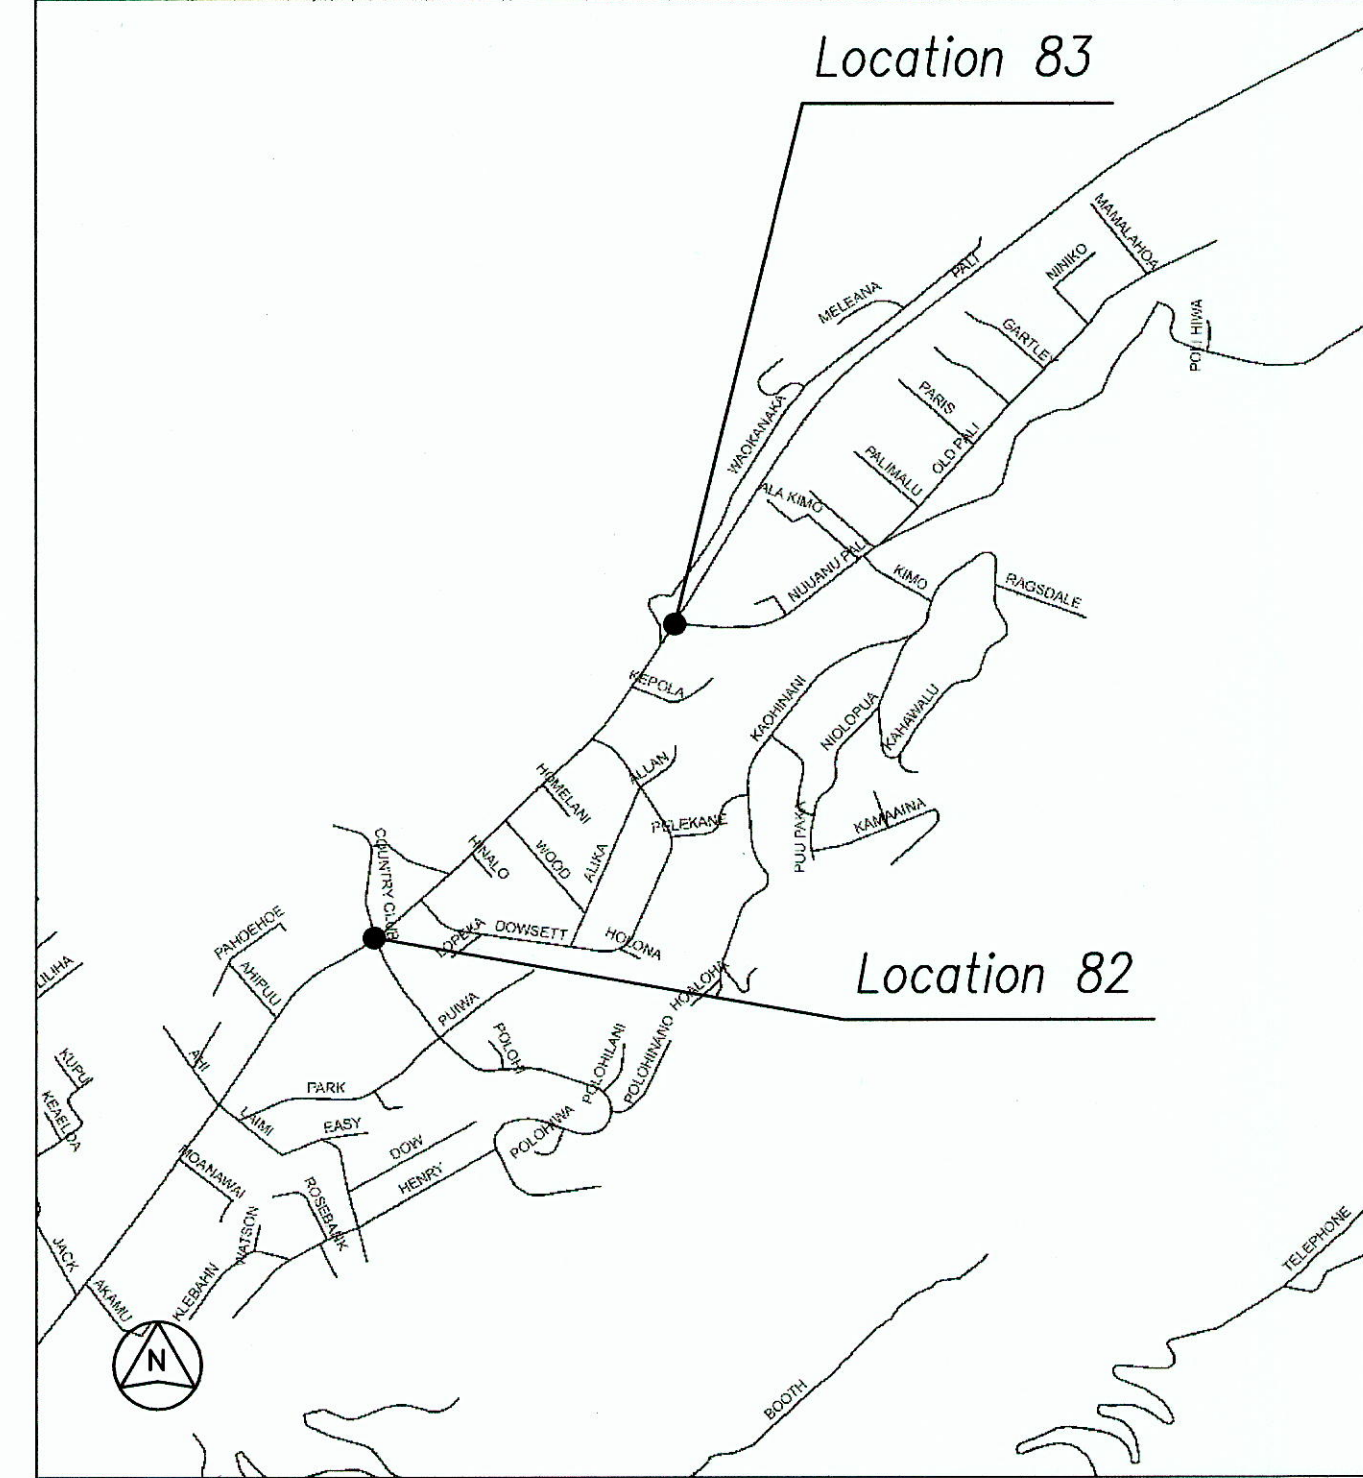


Pali Highway (Route 61)

ORIGINAL PLAN	SURVEY PLOTTED BY	DATE
NOTE BOOK	DRAWN BY	
	DESIGNED BY	
	CHECKED BY	
No.		

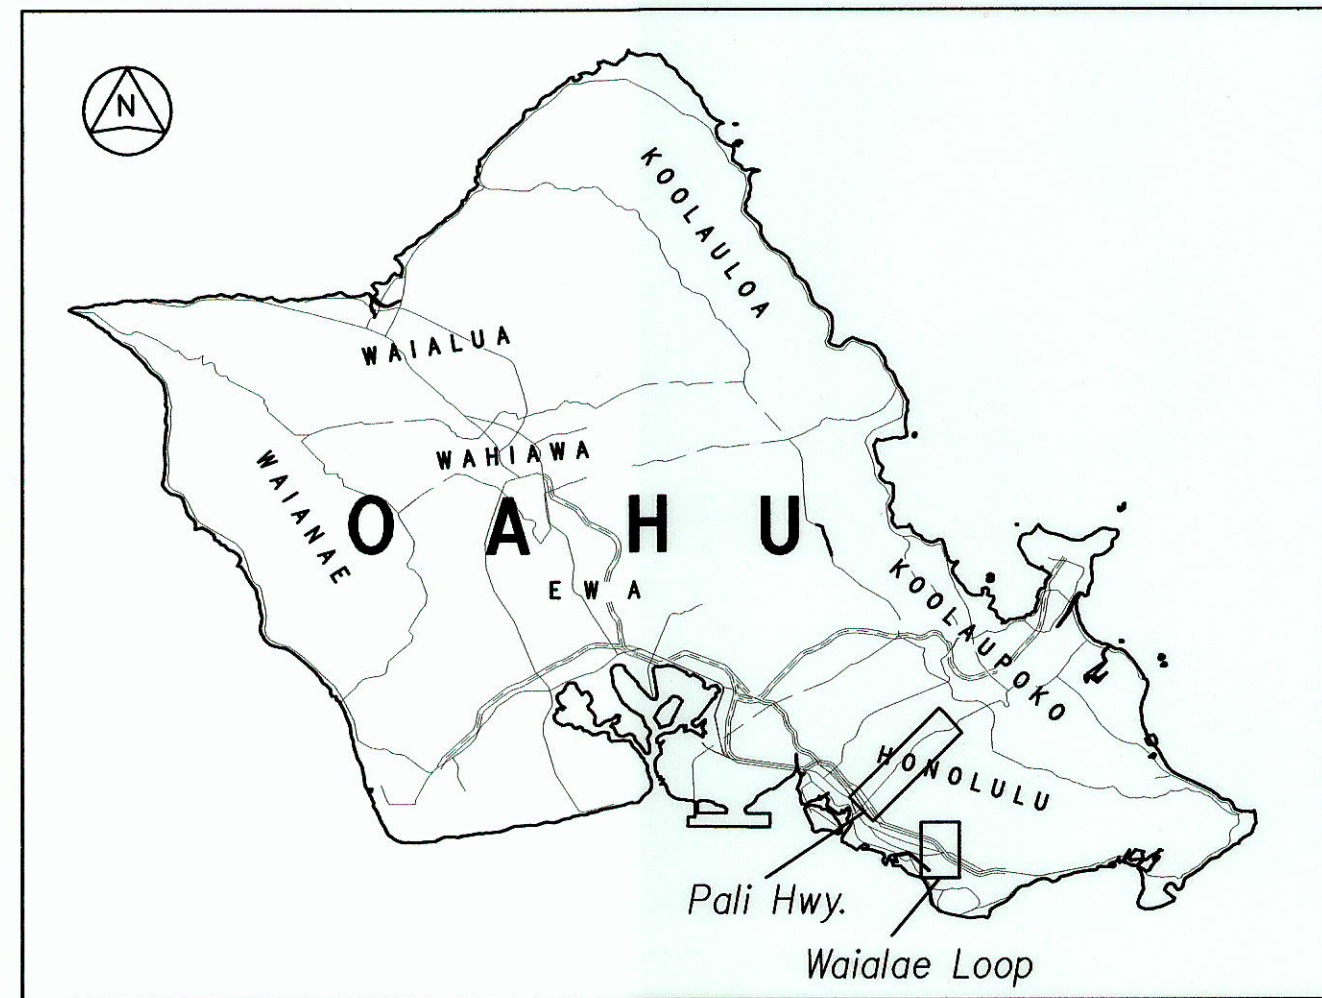

LEGEND FOR AS-BUILT POSTINGS	
	Squiggly line for as-built deletion
	Double line for as-built deletion
Roadway	Text for as-built posting

DATE	REVISION

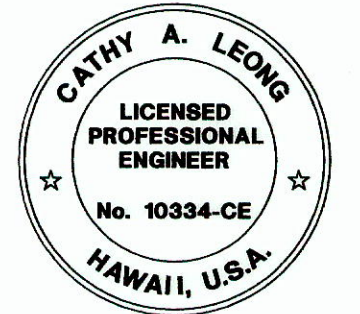

THIS WORK WAS PREPARED BY ME OR UNDER MY SUPERVISION AND CONSTRUCTION OF THIS PROJECT WILL BE UNDER MY OBSERVATION.



Cathy A. Leong
WILSON, KAMOTO CORP. APRIL 30, 2010 LIC. EXP. DATE

STATE OF HAWAII
DEPARTMENT OF TRANSPORTATION
HIGHWAYS DIVISION
LOCATION MAP
PEDESTRIAN COUNTDOWN TIMERS
PHASE 1
Proj. No. HWY-0-05-09
Scale: Not to Scale Date: August 2009
SHEET No. 6S-1 OF 9 SHEETS

"AS-BUILT"

6S-1


FED. ROAD DIST. NO.	STATE	PROJ. NO.	FISCAL YEAR	SHEET NO.	TOTAL SHEETS
HAWAII	HAW.	HWY-0-05-09	2009	6S-2	9

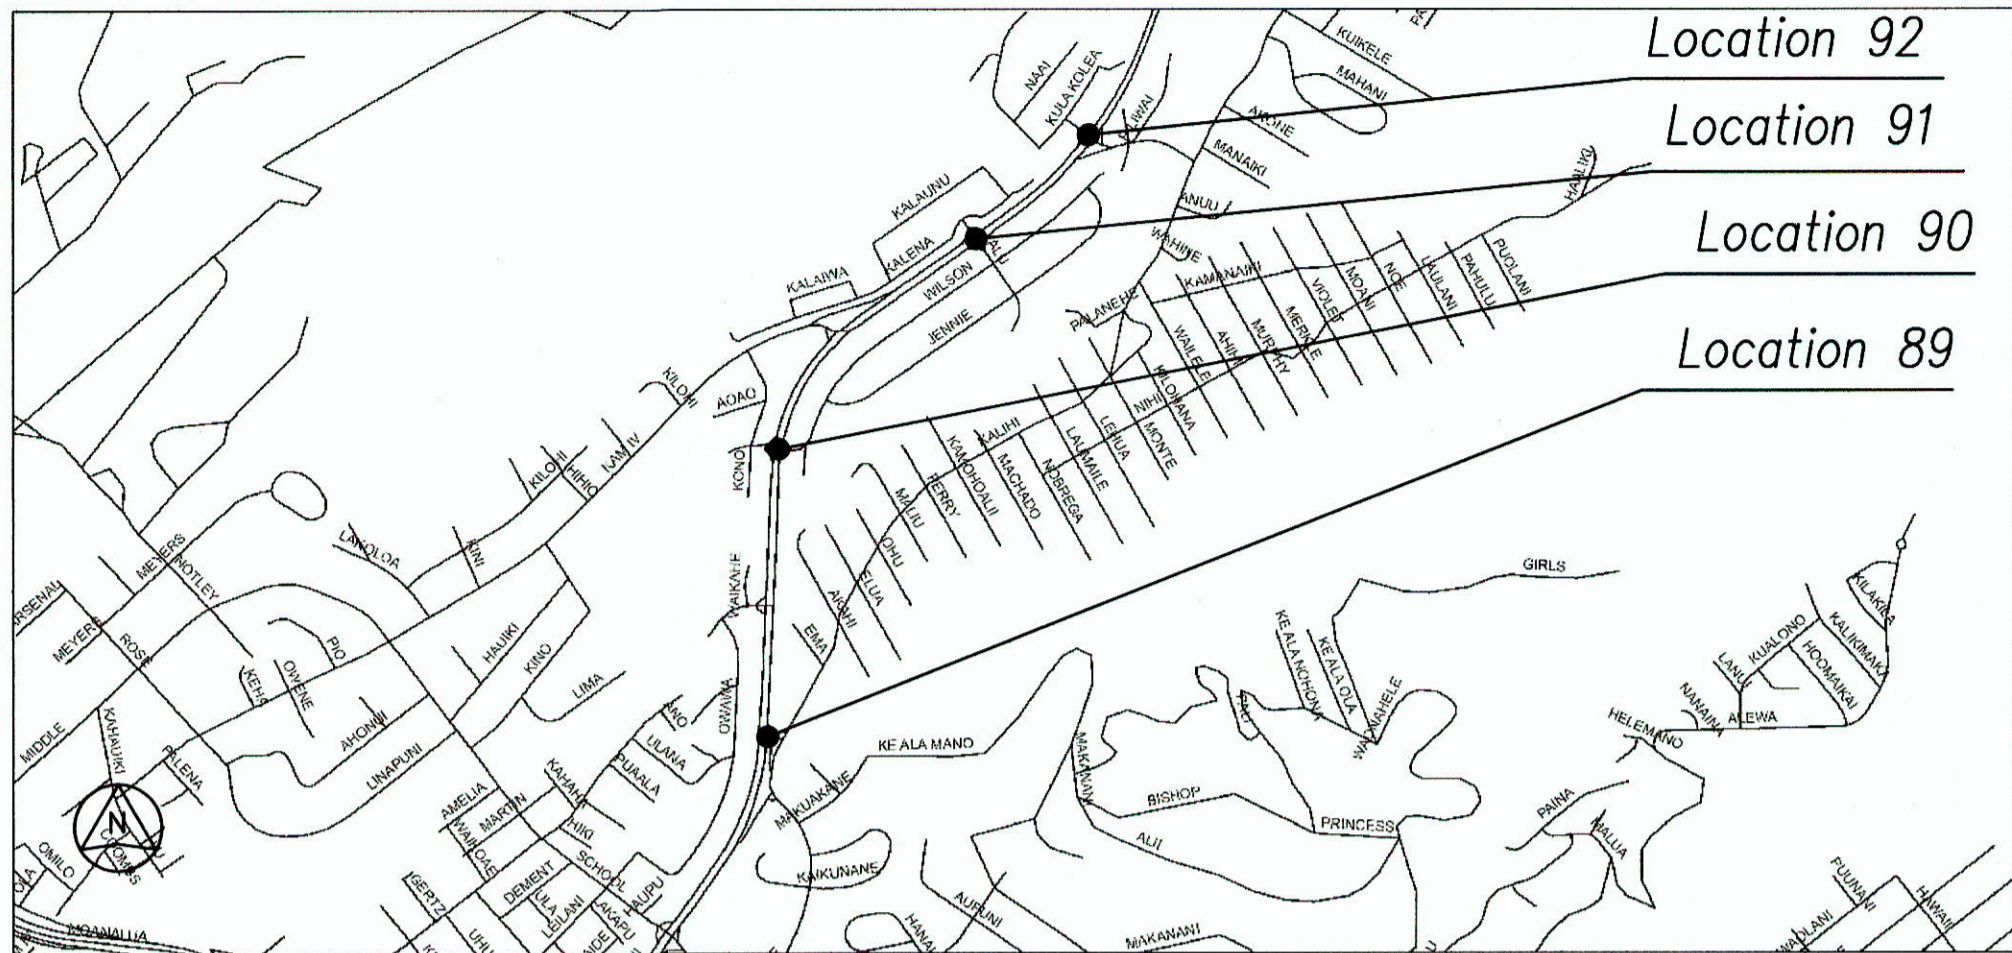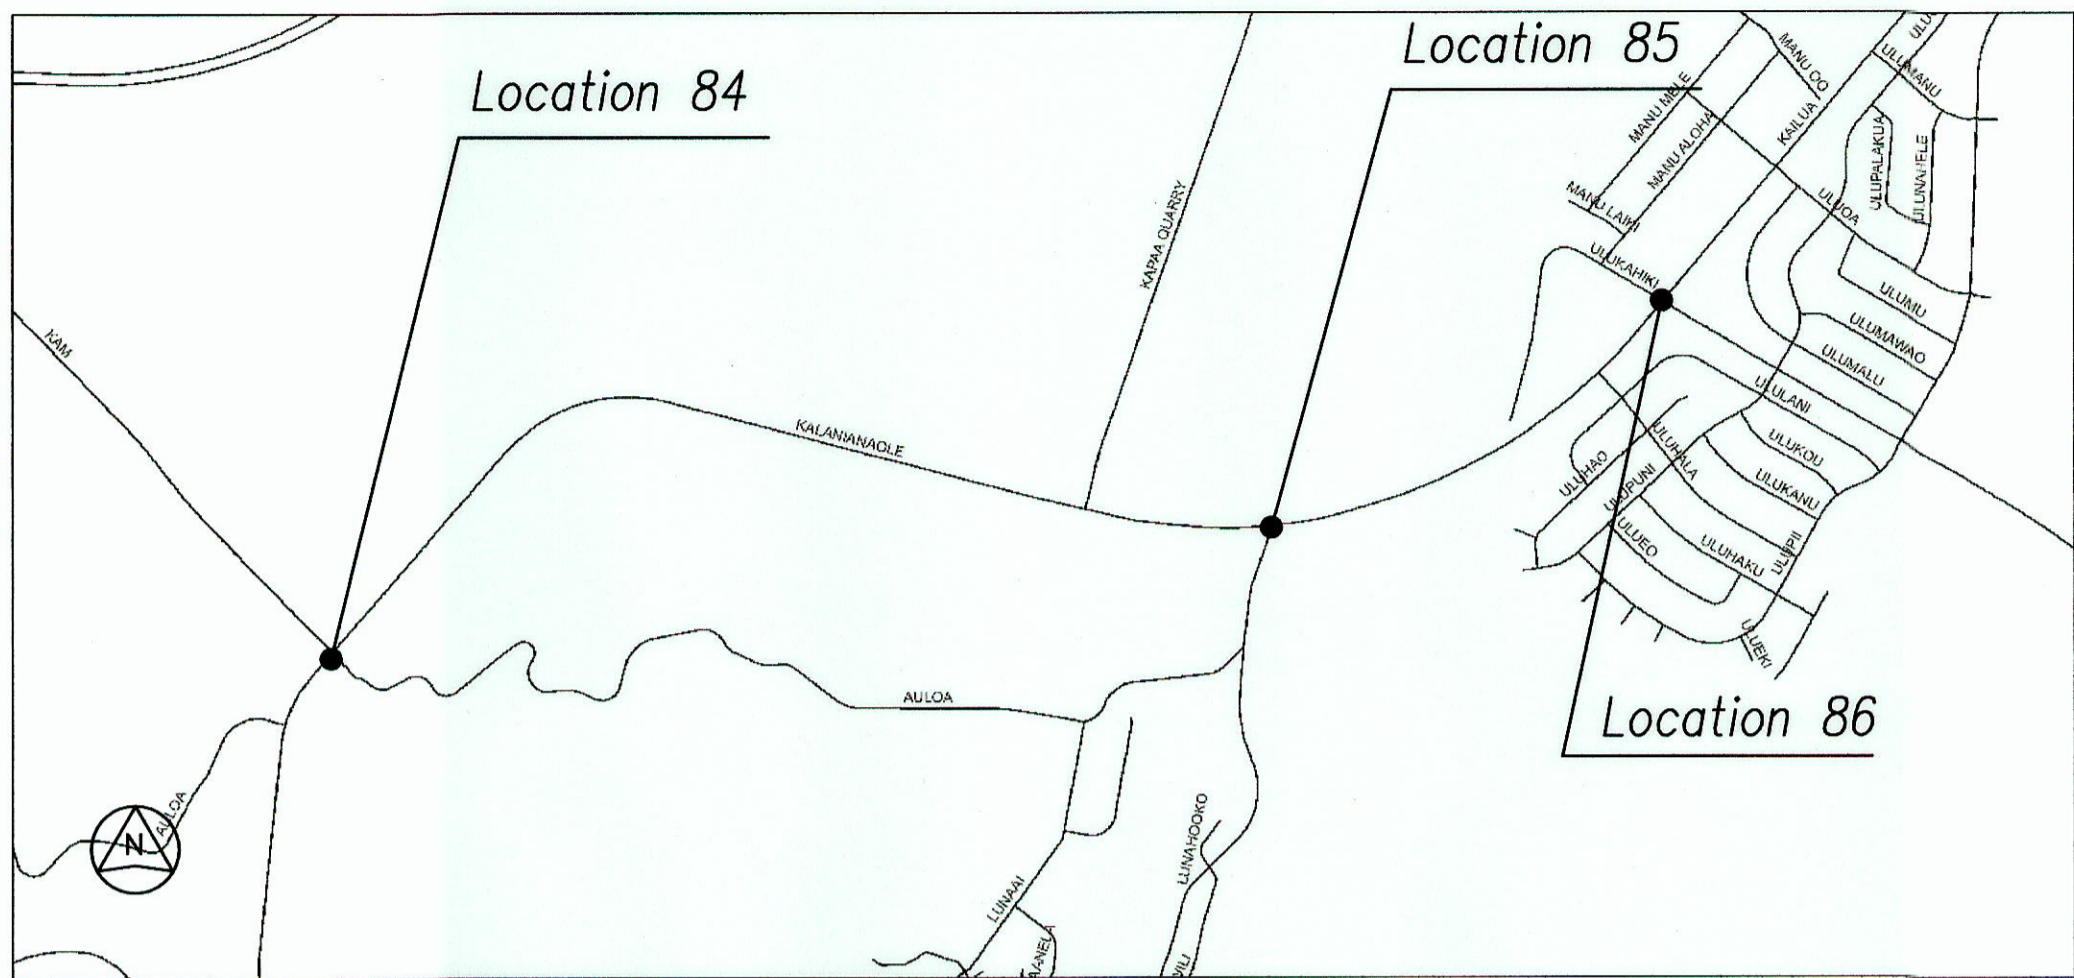

Likeline Hwy. (Route 63)



Kalanianaʻole Hwy. (Route 72)

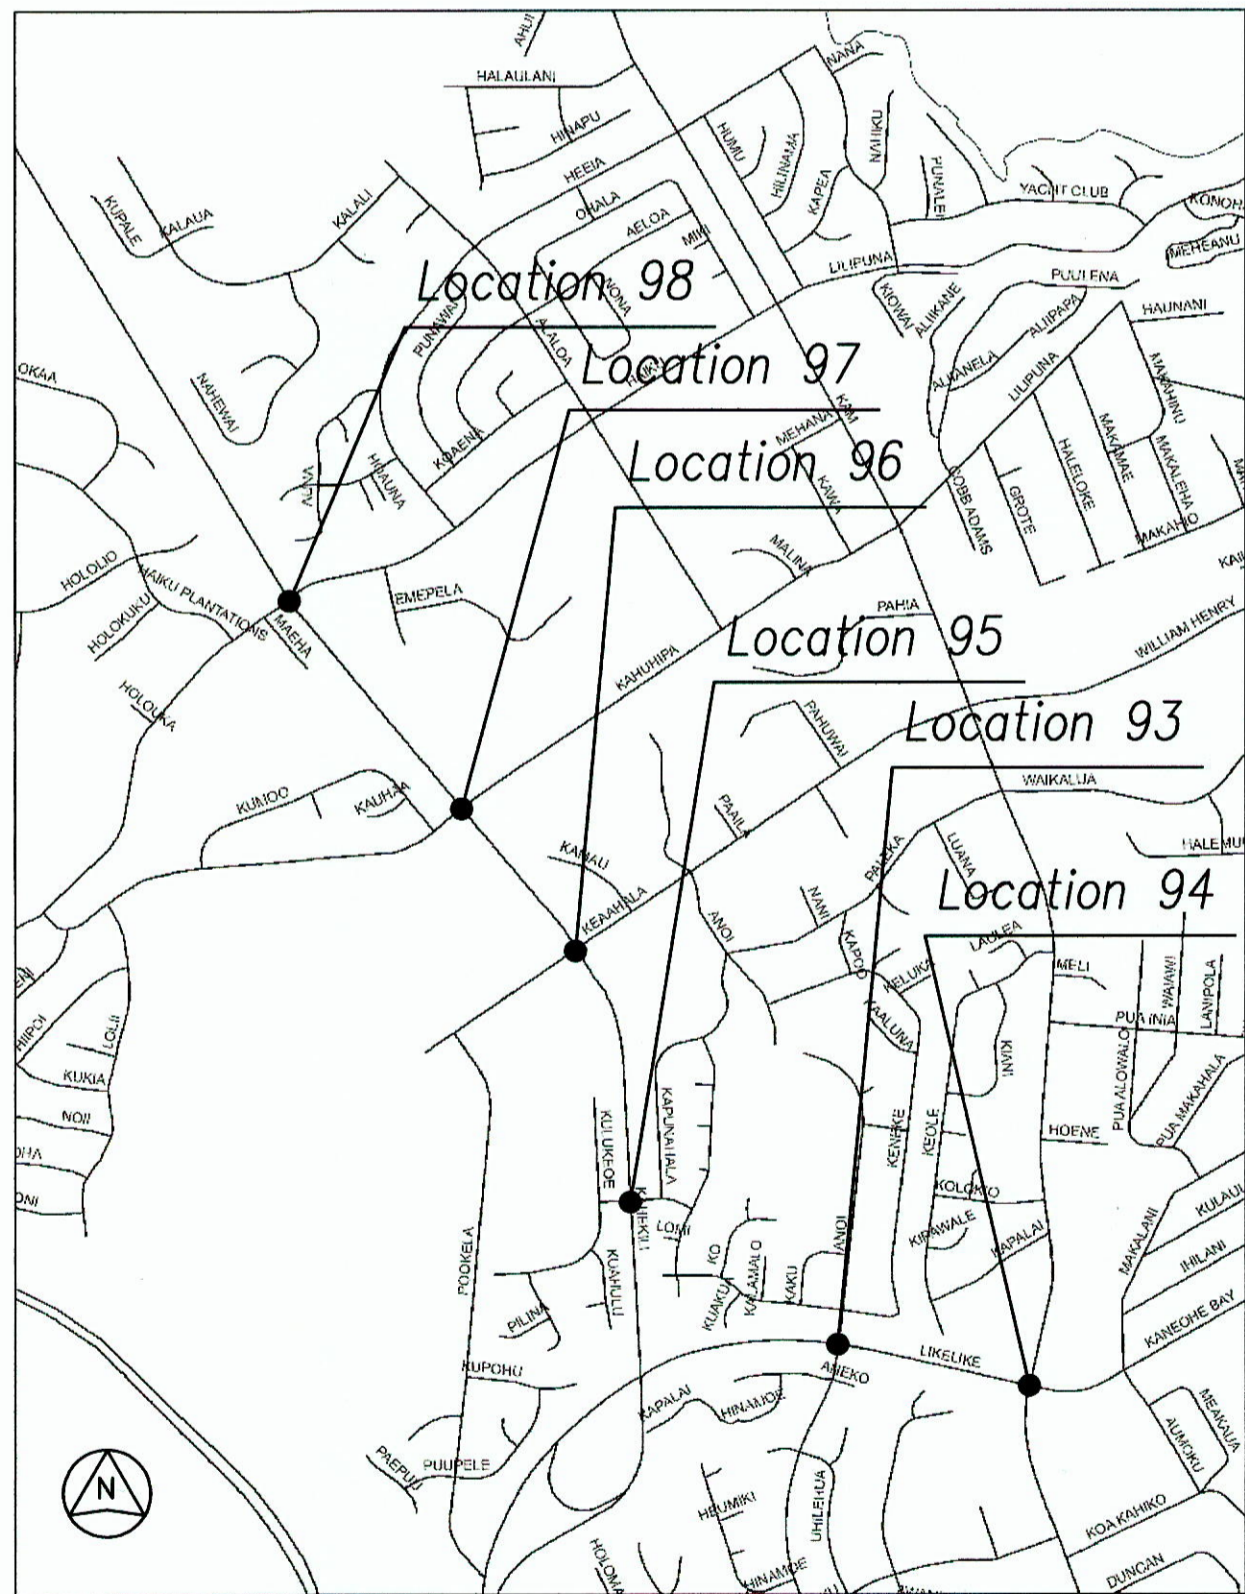


Kahekili Hwy. (Route 83)

LEGEND FOR
AS-BUILT POSTINGS

Squiggly line for as-built deletion

Double line for as-built deletion

Roadway Text for as-built posting

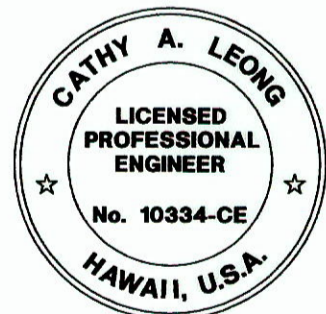

THIS WORK WAS PREPARED BY ME OR UNDER MY SUPERVISION AND CONSTRUCTION OF THIS PROJECT WILL BE UNDER MY OBSERVATION.

Cathy A. Leong APRIL 30, 2010
WILSON OKAMOTO CORP. LIC. EXP. DATE

STATE OF HAWAII
DEPARTMENT OF TRANSPORTATION
HIGHWAYS DIVISION

LOCATION MAP

PEDESTRIAN COUNTDOWN TIMERS
PHASE 1

Proj. No. HWY-0-05-09

Scale: Not to Scale Date: August 2009

SHEET No. 6S-2 OF 9 SHEETS

"AS-BUILT"

6S-2

