




INDEX TO DRAWINGS	
SHT. NO.	DESCRIPTION
1	TITLE SHEET
2-3	NOTES
4-6	LOCATION MAPS
7-8	SCHEDULE
9	DETAIL

PLAN SHEET NOS. 6S-1 TO 6S-3 AND 8S-1 ARE SUPPLEMENT SHEETS TO THE CONTRACT PLANS.
NEW SHEET TOTAL = 13

LEGEND FOR AS-BUILT POSTINGS	
	Squiggly line for as-built deletion
	Double line for as-built deletion
	Text for as-built posting

STATE OF HAWAII

DEPARTMENT OF TRANSPORTATION

HIGHWAYS DIVISION

HONOLULU, HAWAII

"AS-BUILT"

PLANS FOR

PEDESTRIAN COUNTDOWN TIMERS


PHASE 1

PROJECT NO. HWY-O-05-09

DISTRICTS OF HONOLULU, EWA, AND WAIANAE

ISLAND OF OAHU


CHANGES MADE DURING CONSTRUCTION HAVE BEEN MADE INCORPORATED ON THESE PLANS EXCEPT CHANGES MADE IN THE ORIGINAL THEORETICAL QUANTITIES. FOR ACTUAL QUANTITIES, REFER TO PROJECT LEDGER AND/OR COMPUTATION BOOK.

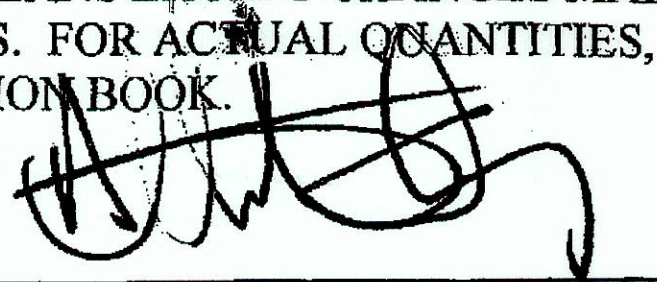


Resident Engineer

10/15/10




Date

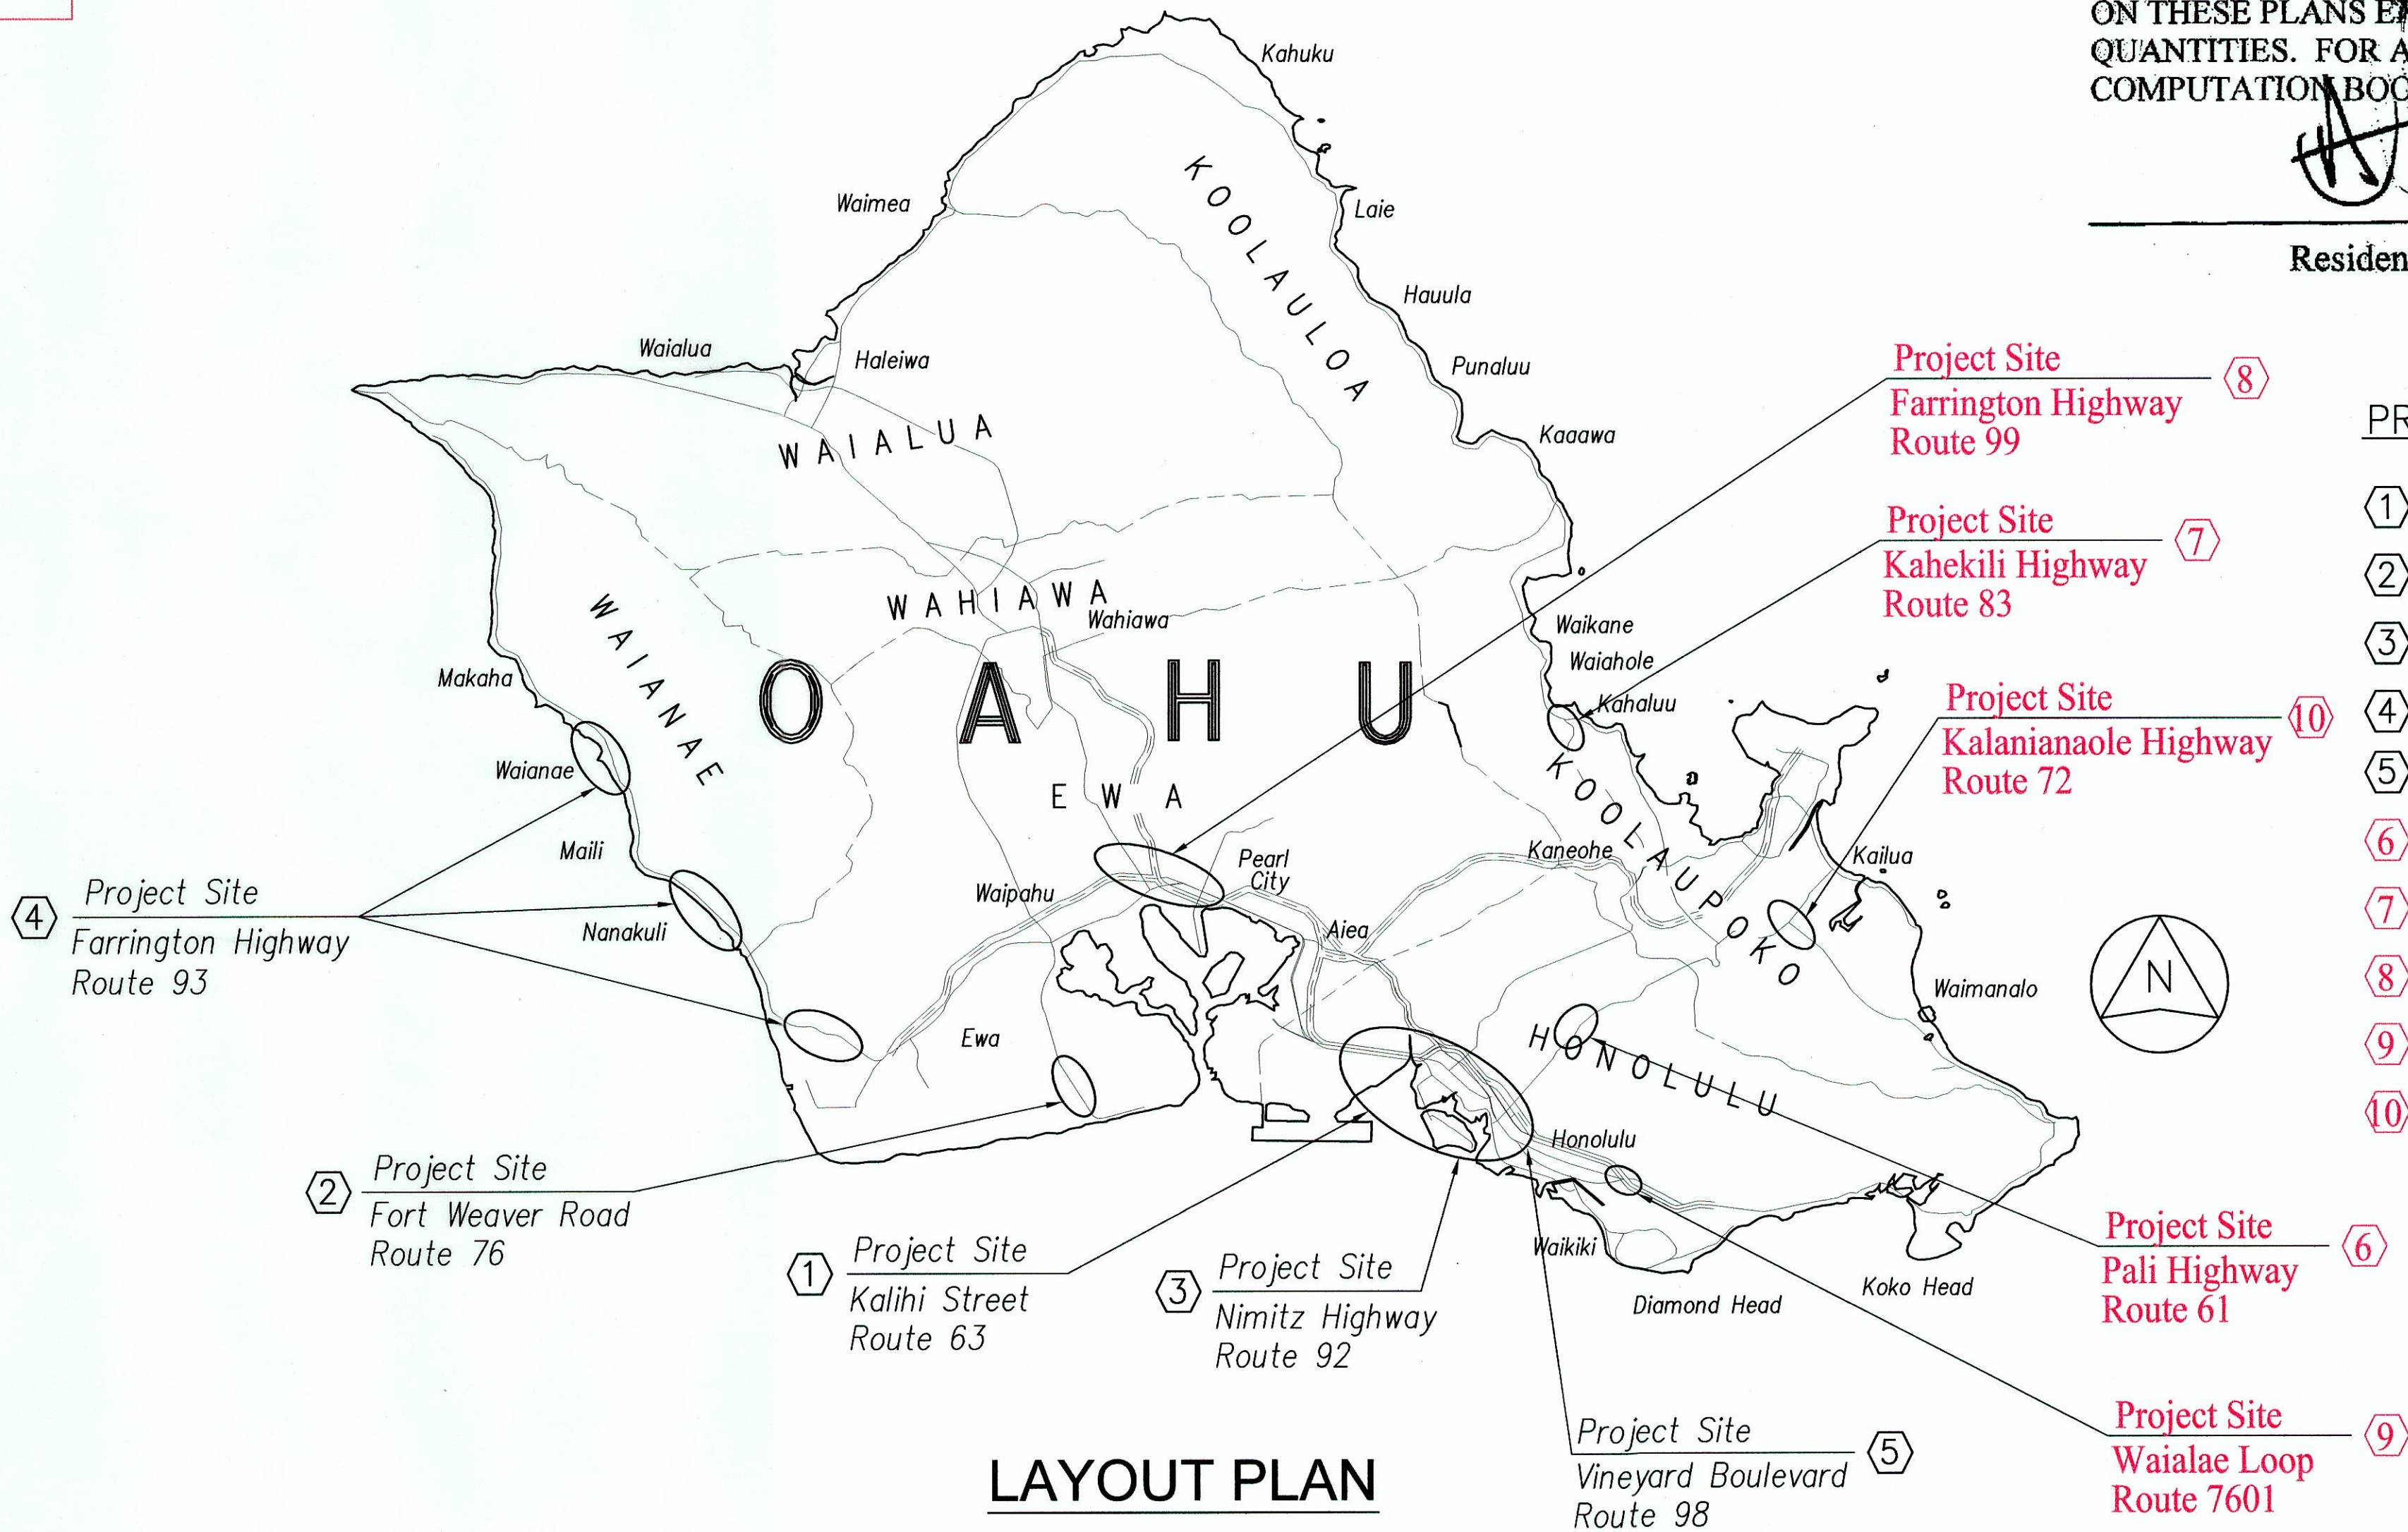

PROJECT SITES				
①	ROUTE 63	MILE POST	<u>0.23</u>	TO MILE POST <u>8.28</u>
②	ROUTE 76	MILE POST	<u>127</u>	TO MILE POST <u>5.56</u>
③	ROUTE 92	MILE POST	<u>0.99</u>	TO MILE POST <u>6.19</u>
④	ROUTE 93	MILE POST	<u>128</u>	TO MILE POST <u>12.63</u>
⑤	ROUTE 98	MILE POST	<u>0.19</u>	TO MILE POST <u>1.34</u>
⑥	ROUTE 61	MILE POST	<u>0.13</u>	TO MILE POST <u>10.60</u>
⑦	ROUTE 83	MILE POST	<u>37.16</u>	TO MILE POST <u>40.46</u>
⑧	ROUTE 99	MILE POST	<u>17.97</u>	TO MILE POST <u>17.97</u>
⑨	ROUTE 7601	MILE POST	<u>0.00</u>	TO MILE POST <u>0.41</u>
⑩	ROUTE 72	MILE POST	<u>0.00</u>	TO MILE POST <u>2.45</u>

DEPARTMENT OF TRANSPORTATION STATE OF HAWAII	
APPROVED:	
	9-28-09
DIR. OF TRANSPORTATION	DATE

FED. ROAD DIST. NO.	STATE	PROJ. NO.	FISCAL YEAR	SHEET NO.	TOTAL SHEETS
HAWAII	HAW.	HWY-0-05-09	2009	1	9

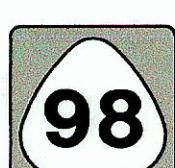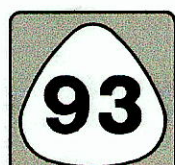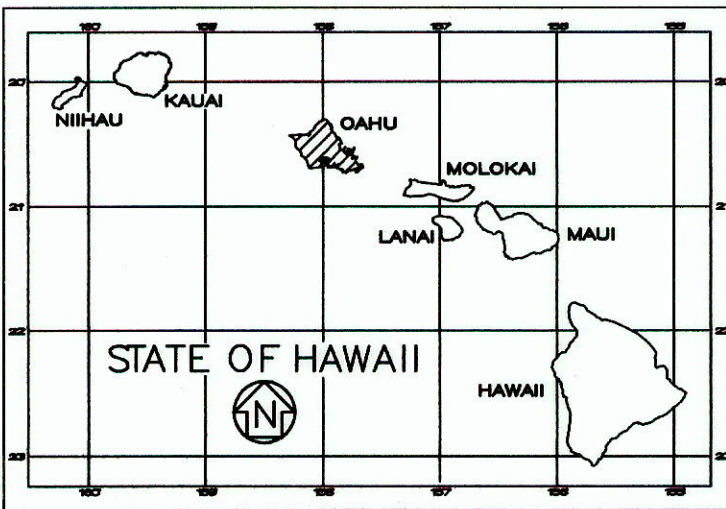

DATE

PHONE

HWY-TO
MANAGED BY

DESIGNED BY
WILSON OKAMOTO CORPORATION

"AS-BUILT"