




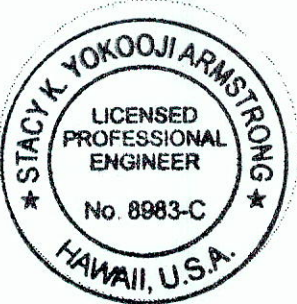
FED. ROAD DIST. NO.	STATE	PROJ. NO.	FISCAL YEAR	SHEET NO.	TOTAL SHEETS
HAWAII	HAW.	HWY-0-04-13	2013	11	12

TRAFFIC SIGNAL LOCATION					DESCRIPTION	QUANTITIES
NO.	RTE	MILE	LEFT APPROACH	THRU ROAD	RIGHT APPROACH	TYPE
1	64	1.80	ROAD NO. 2	SAND ISLAND	ROAD NO. 2	INTERSECTION
2	65	0.11	MAKALANI	KANE OHE BAY	AUMOKU	INTERSECTION
3	65	0.39	PUOHALA	KANE OHE BAY	PUOHALA	INTERSECTION
4	65	0.72	MOKULELE	KANE OHE BAY	MOKULELE	INTERSECTION
5	65	2.95	KALAHEO HS	MOKAPU SADDLE	QUARRY	INTERSECTION
6	72	10.06	-	KALANIANAOLE	KEALAHOU	INTERSECTION
7	72	13.26	LUNALILO HOME	KALANIANAOLE	LUNALILO HOME	INTERSECTION
8	72	14.09	MAUNALUA BAY BEACH PARK	KALANIANAOLE	KEAHOLE	INTERSECTION
9	72	14.27	MAUNALUA BAY BEACH PARK	KALANIANAOLE	HAWAII KAI	INTERSECTION
10	72	14.43	-	KALANIANAOLE	KAWAIIHAE	INTERSECTION
11	72	14.67	KULIOUOU	KALANIANAOLE	KULIOUOU	INTERSECTION
12	72	14.81	PAEOKI	KALANIANAOLE	-	PED CROSSING
13	72	15.21	PAIKO	KALANIANAOLE	-	INTERSECTION
14	72	15.47	-	KALANIANAOLE	EAST HALEMAUMAU	INTERSECTION
15	72	15.53	-	KALANIANAOLE	SHOPPING CENTER	INTERSECTION
16	72	15.57	NIUIKI	KALANIANAOLE	-	INTERSECTION
17	72	15.78	-	KALANIANAOLE	WEST HALEMAUMAU	INTERSECTION
18	72	16.12	PUIIKENA	KALANIANAOLE	PUIIKENA	INTERSECTION
19	72	16.48	-	KALANIANAOLE	EAST HIND	INTERSECTION
20	72	16.60	GRACE CHURCH	KALANIANAOLE	NENUE	INTERSECTION
21	72	16.82	-	KALANIANAOLE	WEST HIND	INTERSECTION
22	72	16.98	WAILUPE	KALANIANAOLE	-	INTERSECTION
23	72	17.94	WAIHOLO	KALANIANAOLE	LAUKAHI	INTERSECTION
24	72	18.21	WAIELI	KALANIANAOLE	KALANIIKI	INTERSECTION
25	72	18.44	AINAKOA	KALANIANAOLE	AINAKOA	INTERSECTION
26	76	6.59	H1 OFF RAMP	FORT WEAVER	H1 ON RAMP	INTERSECTION
27	78	0.40	-	MOANALUA	OFF RAMP (ST. ELIZABETH SCHOOL)	INTERSECTION
28	80	0.00	WILIKINA	KAMEHAMEHA	-	INTERSECTION
29	80	0.12	OHA'I	KAMEHAMEHA	AVOCADO	INTERSECTION
30	80	0.22	OLIVE	KAMEHAMEHA	OLIVE	INTERSECTION
31	80	0.33	CALIFORNIA	KAMEHAMEHA	CALIFORNIA	INTERSECTION
32	80	0.47	KILANI	KAMEHAMEHA	KILANI	INTERSECTION
33	83	6.32	PARK DW	KAMEHAMEHA	PUPUKEA	INTERSECTION
34	83	18.43	ANEMOKU	KAMEHAMEHA	SHOPPING CENTER	INTERSECTION
35	83	41.78	KOA KAHIKO	KAMEHAMEHA	LULUKU	INTERSECTION
36	83	42.26	MOKULELE	KAMEHAMEHA	MOKULELE	INTERSECTION
37	95	1.52	MALAKOLE	KALAELOA	MALAKOLE	INTERSECTION
38	99	4.75	PAALAA UKA PUPUKEA	KAMEHAMEHA	-	INTERSECTION
39	99	8.35	-	WILIKINA	MACOMB (MACOMB GT)	INTERSECTION
40	99	9.09	PRIVATE DRIVEWAY	WILIKINA	KUNIA	INTERSECTION
41	99	9.38	LAKEVIEW CIRCLE	WILIKINA	-	INTERSECTION
42	99	9.86	KAMEHAMEHA (RTE 80)	WILIKINA	KAMEHAMEHA (RTE 99)	INTERSECTION
43	99	10.01	HIGGINS	KAMEHAMEHA	SANTOS DUMONT	INTERSECTION
44	99	10.50	LEILEHUA G.C. RD.	KAMEHAMEHA	-	INTERSECTION
45	99	11.71	WAIKALANI	KAMEHAMEHA	CLOSED ROAD	INTERSECTION
46	99	12.22	KIPAPA	KAMEHAMEHA	KIPAPA	INTERSECTION
47	99	12.72	MEHEULA	KAMEHAMEHA	MEHEULA	INTERSECTION
48	99	13.24	LANIKUHANA	KAMEHAMEHA	LANIKUHANA	INTERSECTION
49	99	15.15	KA UKA	KAMEHAMEHA	KA UKA	INTERSECTION
50	99	15.87	WAIPIO UKA	KAMEHAMEHA	WAIPIO UKA	INTERSECTION
51	99	16.25	LUMIANA	KAMEHAMEHA	LUMIANA	INTERSECTION
52	99	16.53	LUMIAUUAU	KAMEHAMEHA	LUMIAUUAU	INTERSECTION
53	99	16.79	-	KAMEHAMEHA	WAIPAHU	INTERSECTION
46A	99		KUAHELANI	KAMEHAMEHA	KUAHELANI	INTERSECTION


LEGEND FOR AS-BUILT POSTINGS	
	SQUIGGLY LINE FOR AS-BUILT DELETION
	DOUBLE LINE FOR AS-BUILT DELETION
ROADWAY	TEXT FOR AS-BUILT POSTING

NOTE:  
REMOVE ALL EXISTING PEDESTRIAN  
MODULES AND REPLACE WITH NEW  
COUNTDOWN MODULES.

7/10/15  As Built  
DATE REVISION



THIS WORK WAS PREPARED BY ME OR UNDER MY SUPERVISION AND CONSTRUCTION OF THIS PROJECT WILL BE UNDER MY OBSERVATION.

Signature:  DATE: April 30, 2014

"OBSERVATION OF CONSTRUCTION" IS DEFINED IN CHAPTER 16-115, HAWAII ADMINISTRATIVE RULES ENTITLED "PROFESSIONAL ENGINEERS, ARCHITECTS, SURVEYORS AND LANDSCAPE ARCHITECTS".

STATE OF HAWAII  
DEPARTMENT OF TRANSPORTATION  
HIGHWAYS DIVISION

OAHU SCHEDULE - 1

PEDESTRIAN COUNTDOWN TIMERS

PHASE 2

Proj. No. HWY-0-04-13

Scale: N/A

Date: May 2013

SHEET No. C2.7 OF 12 SHEETS

DESIGNED BY	DATE
TRACED BY	
NOTED BY	
QUANTITIES BY	
CHECKED BY	
ORIGINAL PLAN	
NOTE BOOK	
No.	

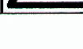



FED. ROAD DIST. NO.	STATE	PROJ. NO.	FISCAL YEAR	SHEET NO.	TOTAL SHEETS
HAWAII	HAW.	HWY-0-04-13	2013	12	12

TRAFFIC SIGNAL LOCATION						DESCRIPTION	QUANTITIES
NO.	RTE	MILE	LEFT APPROACH	THRU ROAD	RIGHT APPROACH	TYPE	
54	750	0.33	KUPUNA N	KUNIA	KUPUNA N	INTERSECTION	<del>≠</del> 2
55	750	0.95	–	KUNIA	ANONUI	INTERSECTION	<del>≠</del> 0
56	750	7.61	LYMAN (LYMAN GATE)	KUNIA	WHEELER	INTERSECTION	<del>≠</del> 1
57	750	7.64	FOOTE (FOOTE GATE)	KUNIA	–	INTERSECTION	<del>≠</del> 3
58	901	1.24	FARRINGTON	FT BARRETT	FARRINGTON	INTERSECTION	0
59	7241	0.00	SALT LAKE	KAHUAPAANI	SALT LAKE	INTERSECTION	<del>≠</del> 7
60	7241	0.27	MANANAI	KAHUAPAANI	ALA ALII	INTERSECTION	<del>≠</del> 5
61	7241	0.74	RTE 78 ON RAMP EB	KAHUAPAANI	–	INTERSECTION	<del>≠</del> 0
62	7241	0.88	ULUNE	KAHUAPAANI	ULUNE EXTENSION	INTERSECTION	<del>≠</del> 0
63	7241	0.89	HALAWA VALLEY	ULUNE EXTENSION	H1 ON RAMP WB	INTERSECTION	<del>≠</del> 1
64	7310	0.69	SALT LAKE	PUULOA	PUKOLOA	INTERSECTION	<del>≠</del> 1
65	7345	0.20	MAHIOLE	JARRETT WHITE	MAHIOLE	INTERSECTION	<del>≠</del> 0
66	7345	0.38	ALA MAHAMOE	JARRETT WHITE	ALA MAHAMOE	INTERSECTION	<del>≠</del> 0
67	7350	0.00	RADFORD	BOUGAINVILLE	RADFORD	INTERSECTION	<del>≠</del> 7
68	7350	0.58	SALT LAKE	BOUGAINVILLE	SALT LAKE	INTERSECTION	<del>≠</del> 0
69	7413	0.00	KING	LILIHA	KING	INTERSECTION	<del>≠</del> 0
70	7413	0.34	SCHOOL STREET ACCESS	LILIHA	H1 ON RAMP	INTERSECTION	<del>≠</del> 0
71	7415	0.00	KAUA	MIDDLE	KAUA	INTERSECTION	<del>≠</del> 0
72	7415	0.06	KING	MIDDLE	H201 OFF RAMP	INTERSECTION	<del>≠</del> 2
73	7415	0.52	DILLINGHAM/KAMEHAMEHA	MIDDLE	H1/NIMITZ INTERSECTION	INTERSECTION	<del>≠</del> 5
74	H1	1.11	MAKAKILO	OFF RAMP WB	MAKAKILO	INTERSECTION	<del>≠</del> 1
75	H1	7.08	PAIWA	ON & OFF RAMPS EB	PAIWA	INTERSECTION	<del>≠</del> 2
76	H1	7.08	PAIWA	ON & OFF RAMPS WB	PAIWA	INTERSECTION	<del>≠</del> 0
77	H1	13.80	LUAPELE	SALT LAKE	LUAPELE	INTERSECTION	<del>≠</del> 0
78	H1	19.88	HOUGHTAILING	HALONA	HOUGHTAILING	INTERSECTION	0
79	H1	21.03	SCHOOL	AALA	SCHOOL	INTERSECTION	<del>≠</del> 4
80	H1	21.55	SCHOOL	QUEEN EMMA	IOLANI	INTERSECTION	<del>≠</del> 0
81	H1	22.13	LUNALILO	WARD	LUNALILO	INTERSECTION	8
82	H1	22.50	LUNALILO	PENSACOLA	LUNALILO	INTERSECTION	<del>≠</del> 0
83	H1	22.60	PIIKOI	LUNALILO	PIIKOI	INTERSECTION	<del>≠</del> 0
84	H1	23.15	PUNAHOU	OFF RAMP EB	PUNAHOU	INTERSECTION	<del>≠</del> 1
85	H1	24.59	H1 ON RAMP EB	KAPIOLANI	–	INTERSECTION	3
86	H1	24.82	HARDING	KAPAHULU	HARDING	INTERSECTION	<del>≠</del> 5
87	H1	25.87	KOKO HEAD	OFF EB	KOKO HEAD	INTERSECTION	1
88	H1	25.87	HARDING	KOKO HEAD	HARDING	INTERSECTION	5
89*	H1	26.53	21ST	OFF RAMP EB	21ST	INTERSECTION	0
90*	H1	26.60	HUNAKAI	WAIALAE	HUNAKAI	INTERSECTION	0
91*	H1	26.82	KILAUEA	WAIALAE	KILAUEA	INTERSECTION	0
92	H2	2.46	KA UKA	OFF RAMP SB	KA UKA	INTERSECTION	2
93	H2	5.51	MEHEULA	ON & OFF RAMP NB	MEHEULA	INTERSECTION	4
94	H2	5.51	MEHEULA	ON & OFF RAMP SB	MEHEULA	INTERSECTION	<del>≠</del> 1
95	H201	3.00	–	ON RAMP WB	–	PED CROSSING	<del>≠</del> 1
96	H201	3.46	–	KAUA	ALA MAHAMOE	INTERSECTION	2
97	H201	3.57	FUNSTON	KAUA	FUNSTON (BUCKNER GT)	INTERSECTION	3

**NOTE:**  
**REMOVE ALL EXISTING PEDESTRIAN  
MODULES AND REPLACE WITH NEW  
COUNTDOWN MODULES.**

\* INTERSECTIONS WITH COUNTDOWN TIMERS  
ALREADY INSTALLED: 89, 90, 91

7/10/15		As Built
DATE	REVISION	
<p><b>STATE OF HAWAII</b></p> <p><b>DEPARTMENT OF TRANSPORTATION</b></p> <p><b>HIGHWAYS DIVISION</b></p>		
<p><u><b>OAHU SCHEDULE - 2</b></u></p> <p><u><b>PEDESTRIAN COUNTDOWN TIMERS</b></u></p> <p><u><b>PHASE 2</b></u></p> <p><u><b>Proj. No. HWY-0-04-13</b></u></p>		
Scale: N/A	Date: May 2013	
<p><b>SHEET No. C2.8 OF 12 SHEETS</b></p>		



THIS WORK WAS PREPARED BY ME OR UNDER  
MY SUPERVISION AND CONSTRUCTION OF THIS  
PROJECT WILL BE UNDER MY OBSERVATION.

As K ylori 25 April 30, 2014  
SIGNATURE DATE

"OBSERVATION OF CONSTRUCTION" IS DEFINED IN CHAPTER 16-115, HAWAII ADMINISTRATIVE RULES ENTITLED "PROFESSIONAL ENGINEERS, ARCHITECTS, SURVEYORS AND LANDSCAPE ARCHITECTS".

"AS-BUILT"	12
------------	----

ORIGINAL PLAN	SURVEY PLOTTED BY _____ DATE _____
	DRAWN BY _____
	TRACED BY _____
	DESIGNED BY _____
	QUANTITIES BY _____
NOTE BOOK	CHECKED BY _____
	No. _____

<u>LEGEND FOR</u> <u>AS-BUILT POSTINGS</u>	
<del>~~~~~</del>	SQUIGGLY LINE FOR AS-BUILT DELETION
<del>==</del>	DOUBLE LINE FOR AS-BUILT DELETION
ROADWAY	TEXT FOR AS-BUILT POSTING