

INDEX TO DRAWINGS	
SHEET NO.	DESCRIPTION
1	TITLE SHEET
2-3	NOTES
4	DETAIL
5-10	LOCATION MAPS
11-12	SCHEDULE

STATE OF HAWAII
DEPARTMENT OF TRANSPORTATION
HIGHWAYS DIVISION
HONOLULU, HAWAII

"AS-BUILT"


PLANS FOR

PEDESTRIAN COUNTDOWN TIMERS
PHASE II

PROJECT NO. HWY-O-04-13



DISTRICTS OF HONOLULU, EWA, WAHIAWA, WAIALUA, KOOLAULO, & KOOLAUPOKO
ISLAND OF OAHU

FED. ROAD DIST. NO.	STATE	PROJ. NO.	FISCAL YEAR	SHEET NO.	TOTAL SHEETS
HAWAII	HAW.	HWY-O-04-13	2014	1	12

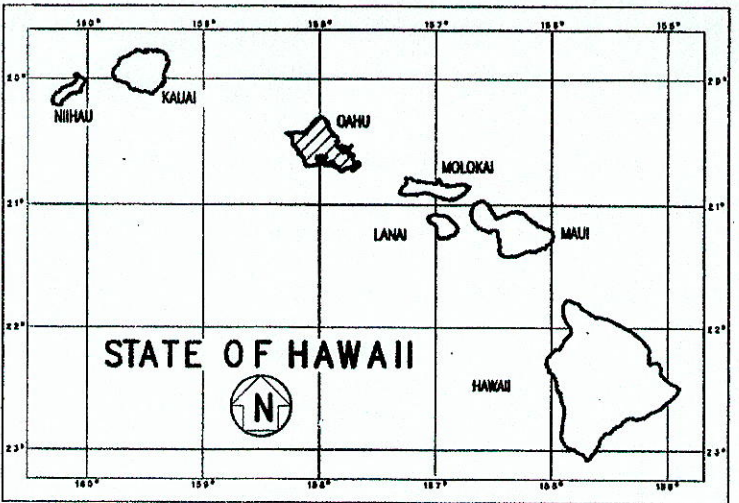

CHANGES MADE DURING CONSTRUCTION HAVE BEEN INCORPORATED ON THESE PLANS EXCEPT CHANGES IN THE ORIGINAL THEORETICAL QUANTITIES. FOR ACTUAL QUANTITIES, REFER TO PROJECT LEDGER AND/OR COMPUTATION BOOK.

[Signature] 9/2/15
RESIDENT ENGINEER DATE

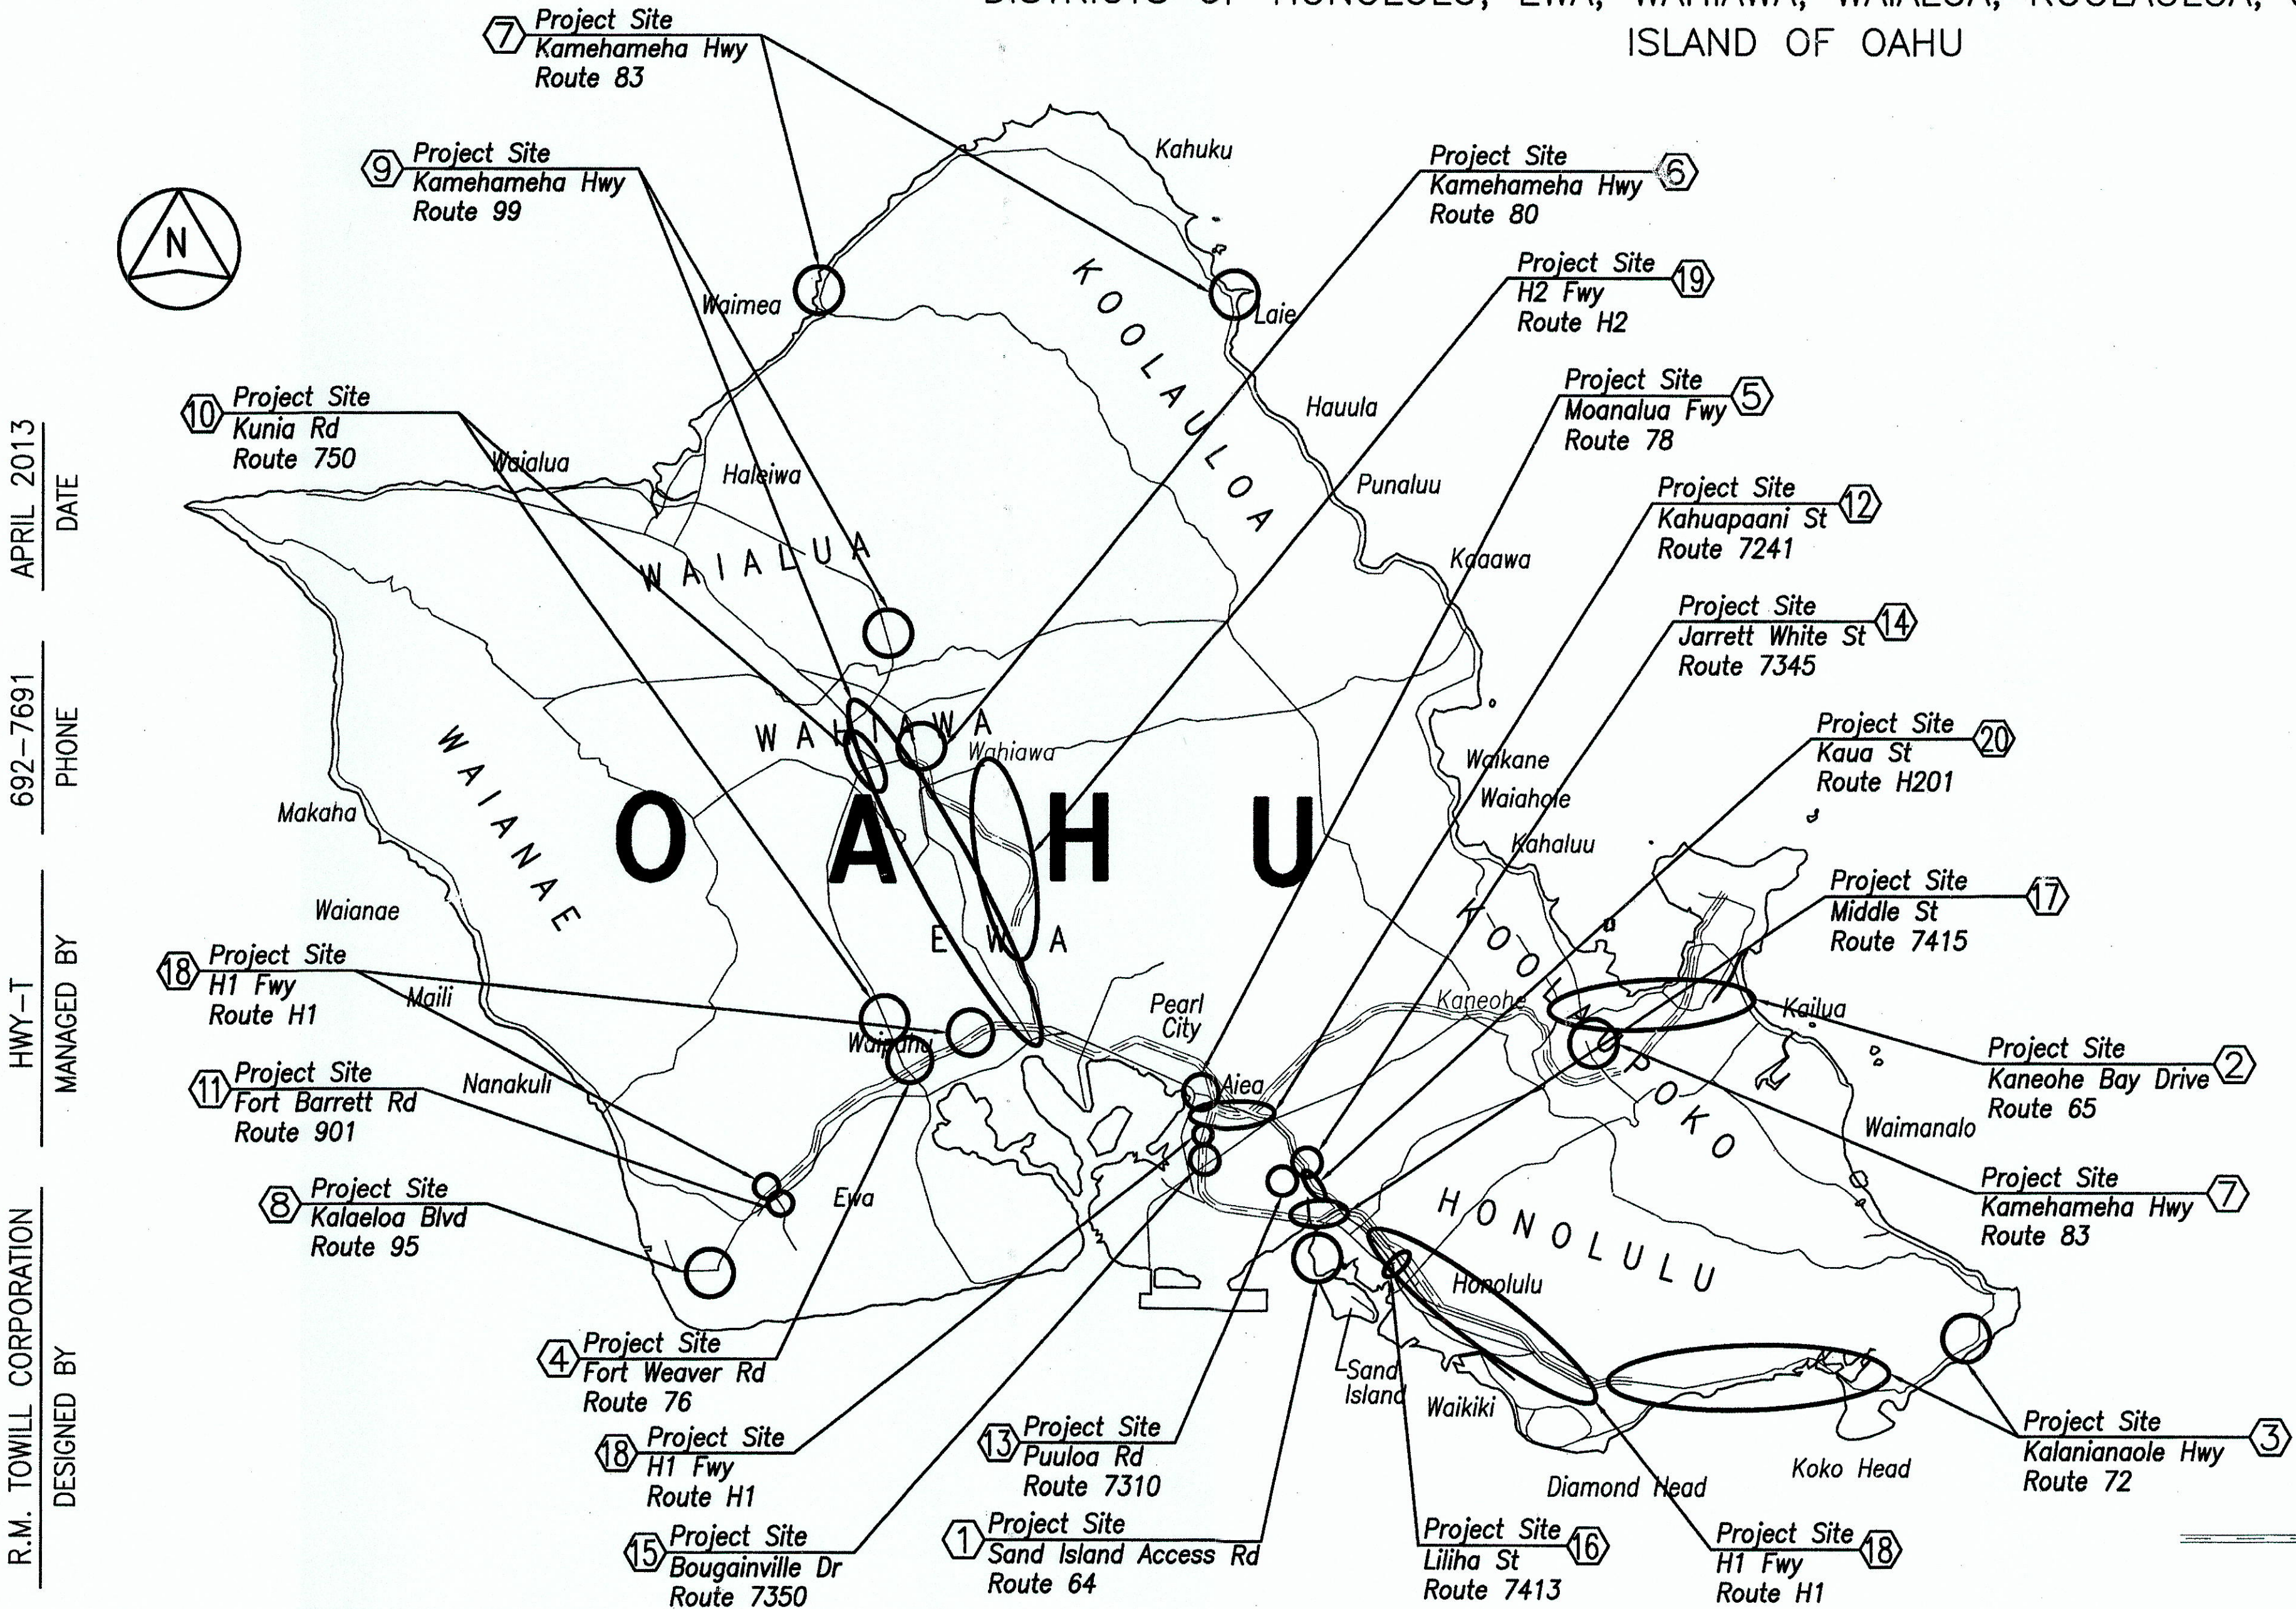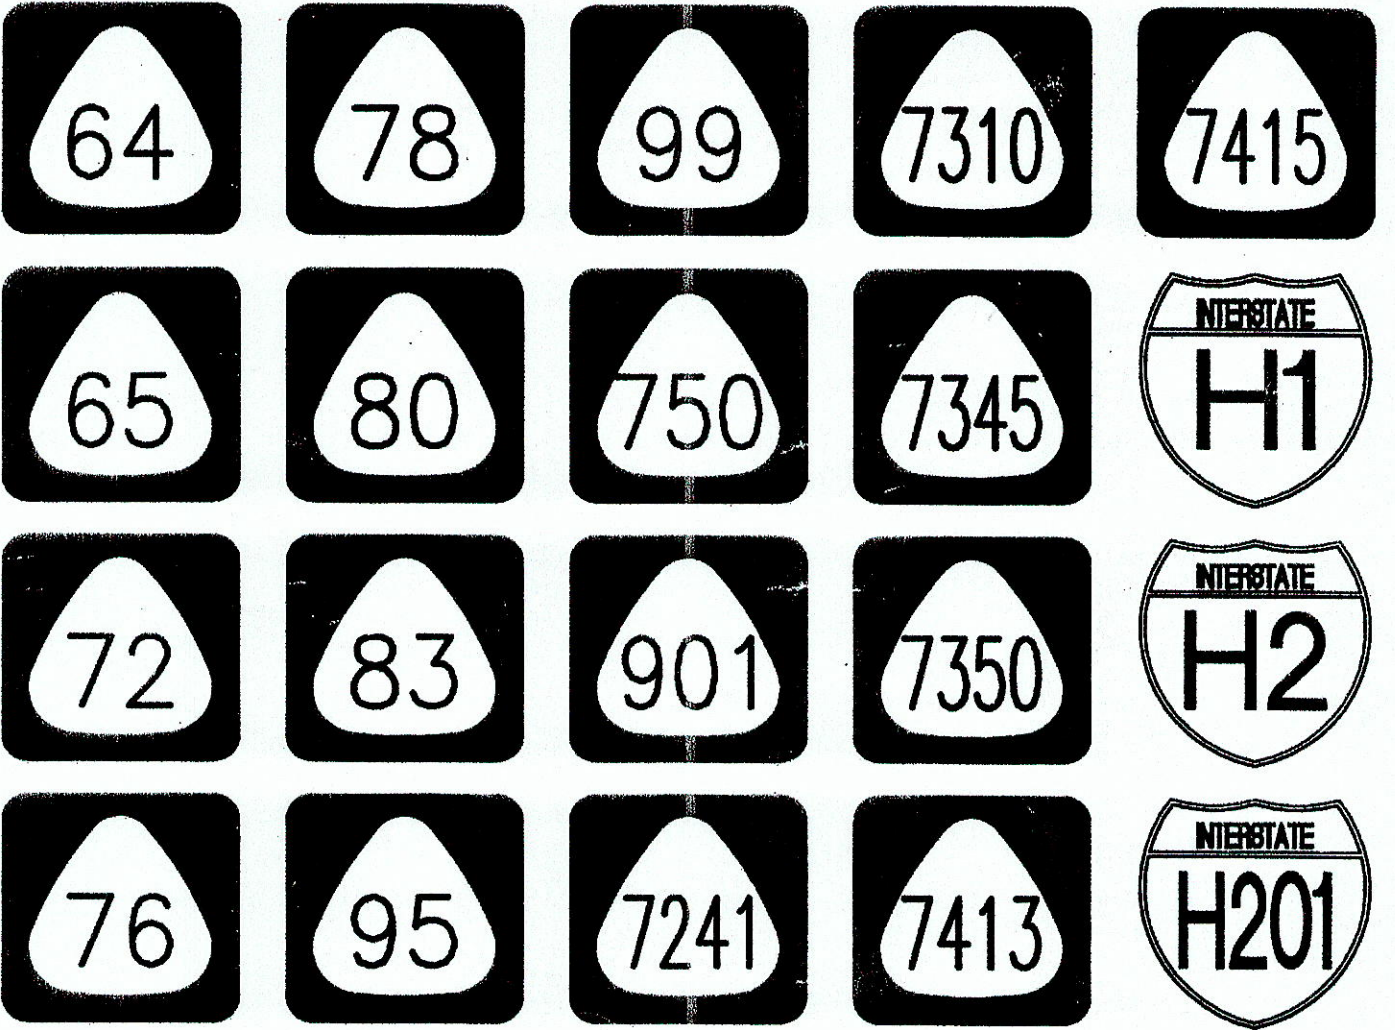

PROJECTS SITES

① ROUTE 64	MILE POST 1.80	TO MILE POST 1.80
② ROUTE 65	MILE POST 0.11	TO MILE POST 2.95
③ ROUTE 72	MILE POST 10.06	TO MILE POST 18.84
④ ROUTE 76	MILE POST 6.59	TO MILE POST 6.59
⑤ ROUTE 78	MILE POST 0.40	TO MILE POST 0.40
⑥ ROUTE 80	MILE POST 0.00	TO MILE POST 0.47
⑦ ROUTE 83	MILE POST 6.32	TO MILE POST 42.26
⑧ ROUTE 95	MILE POST 1.52	TO MILE POST 1.52
⑨ ROUTE 99	MILE POST 4.75	TO MILE POST 16.79
⑩ ROUTE 750	MILE POST 0.33	TO MILE POST 7.64
⑪ ROUTE 901	MILE POST 1.24	TO MILE POST 1.24
⑫ ROUTE 7241	MILE POST 0.00	TO MILE POST 0.89
⑬ ROUTE 7310	MILE POST 0.69	TO MILE POST 0.69
⑭ ROUTE 7345	MILE POST 0.20	TO MILE POST 0.38
⑮ ROUTE 7350	MILE POST 0.00	TO MILE POST 0.58
⑯ ROUTE 7413	MILE POST 0.00	TO MILE POST 0.34
⑰ ROUTE 7415	MILE POST 0.00	TO MILE POST 0.52
⑱ ROUTE H1	MILE POST 1.11	TO MILE POST 26.82
⑲ ROUTE H2	MILE POST 2.46	TO MILE POST 5.51
⑳ ROUTE H201	MILE POST 3.00	TO MILE POST 3.57

DESIGNED BY	DATE
TRACED BY	
NOTED BY	
QUANTITIES BY	
CHECKED BY	

APRIL 2013 DATE
692-7691 PHONE
HWY-T MANAGED BY
R.M. TOWILL CORPORATION DESIGNED BY

FEDERAL AID INTERSTATE PROJECTS PREVIOUSLY
CONSTRUCTED OR UNDER CONSTRUCTION

DEPARTMENT OF TRANSPORTATION
STATE OF HAWAII
APPROVED: *[Signature]* 10/21/13
DIR. OF TRANSPORTATION DATE
SHEET No. T-1 OF 12 SHEETS