
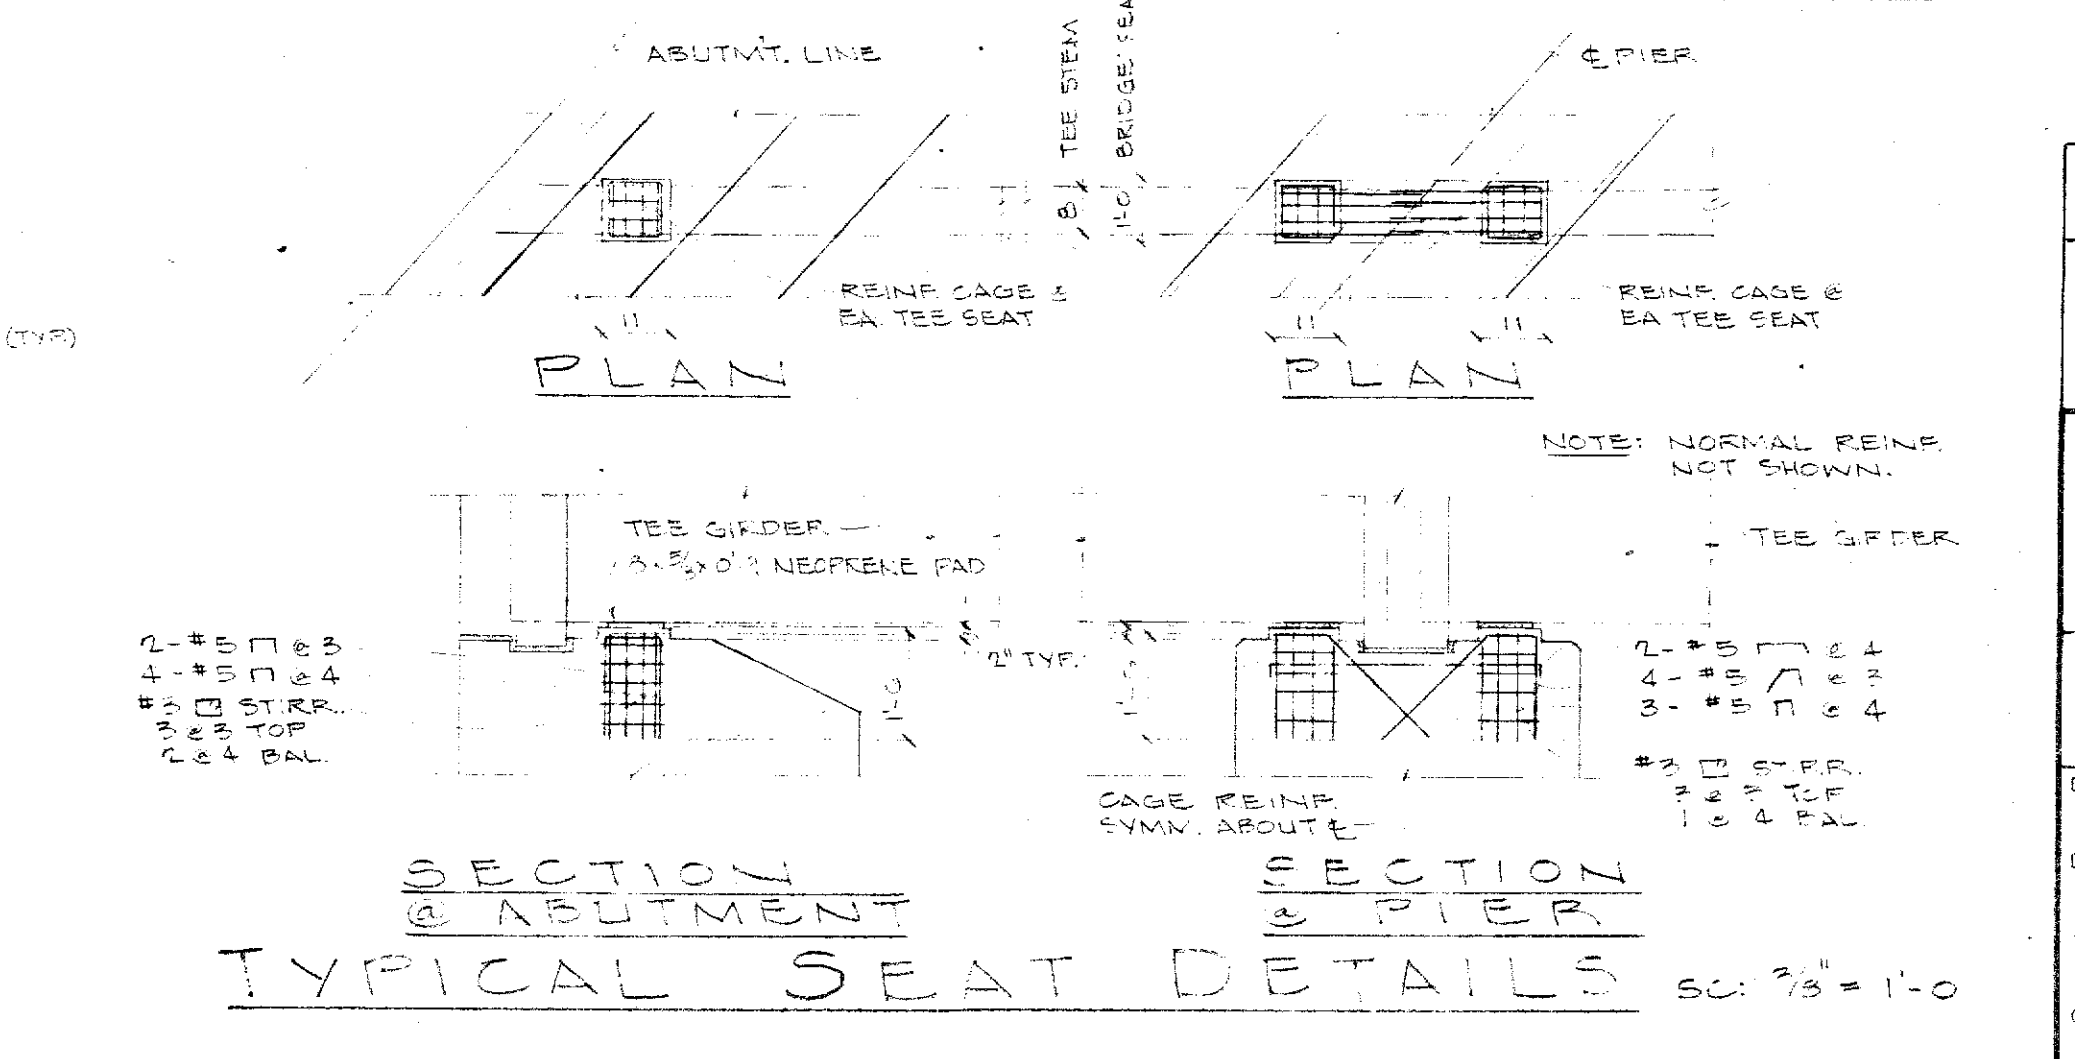
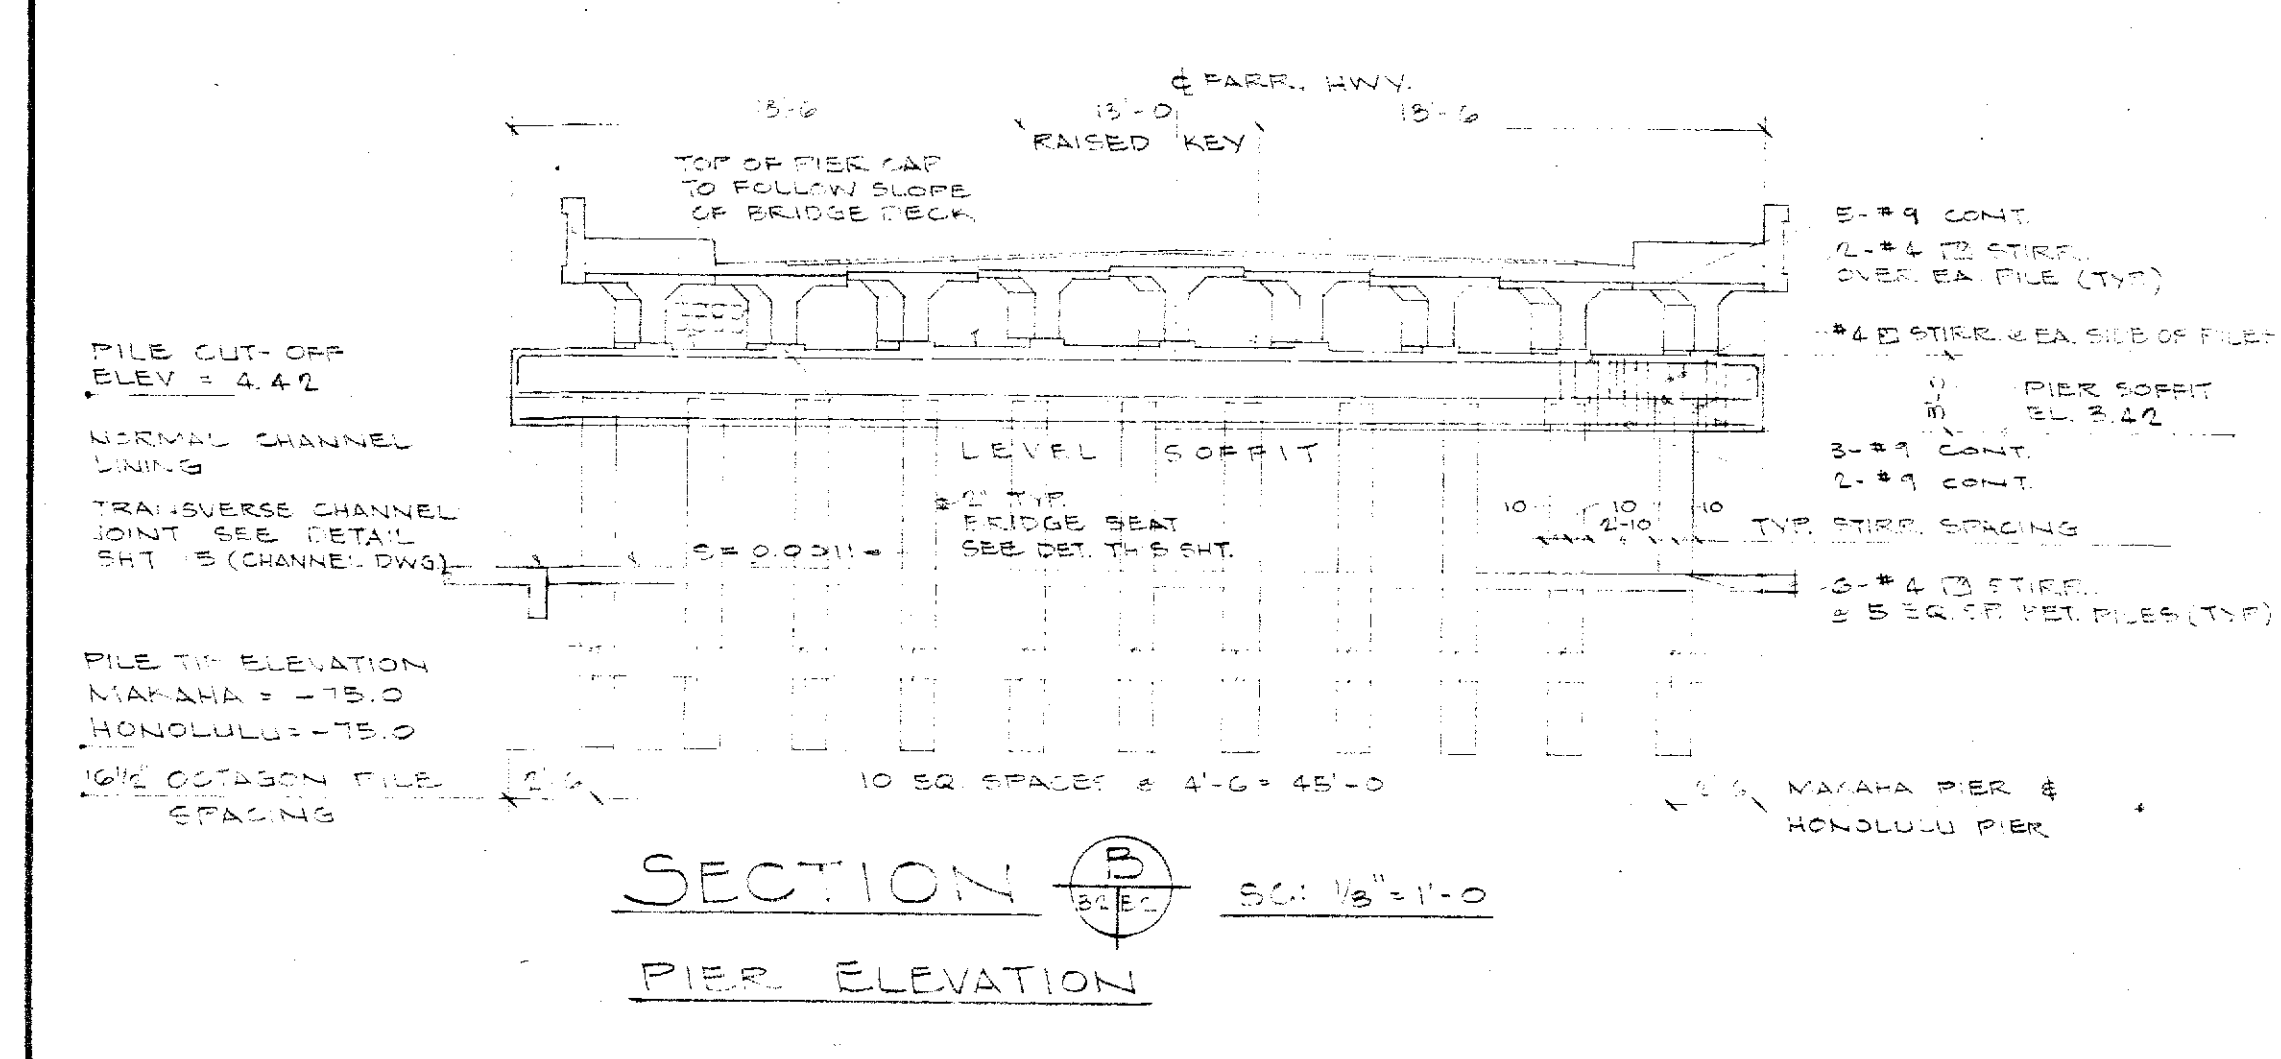
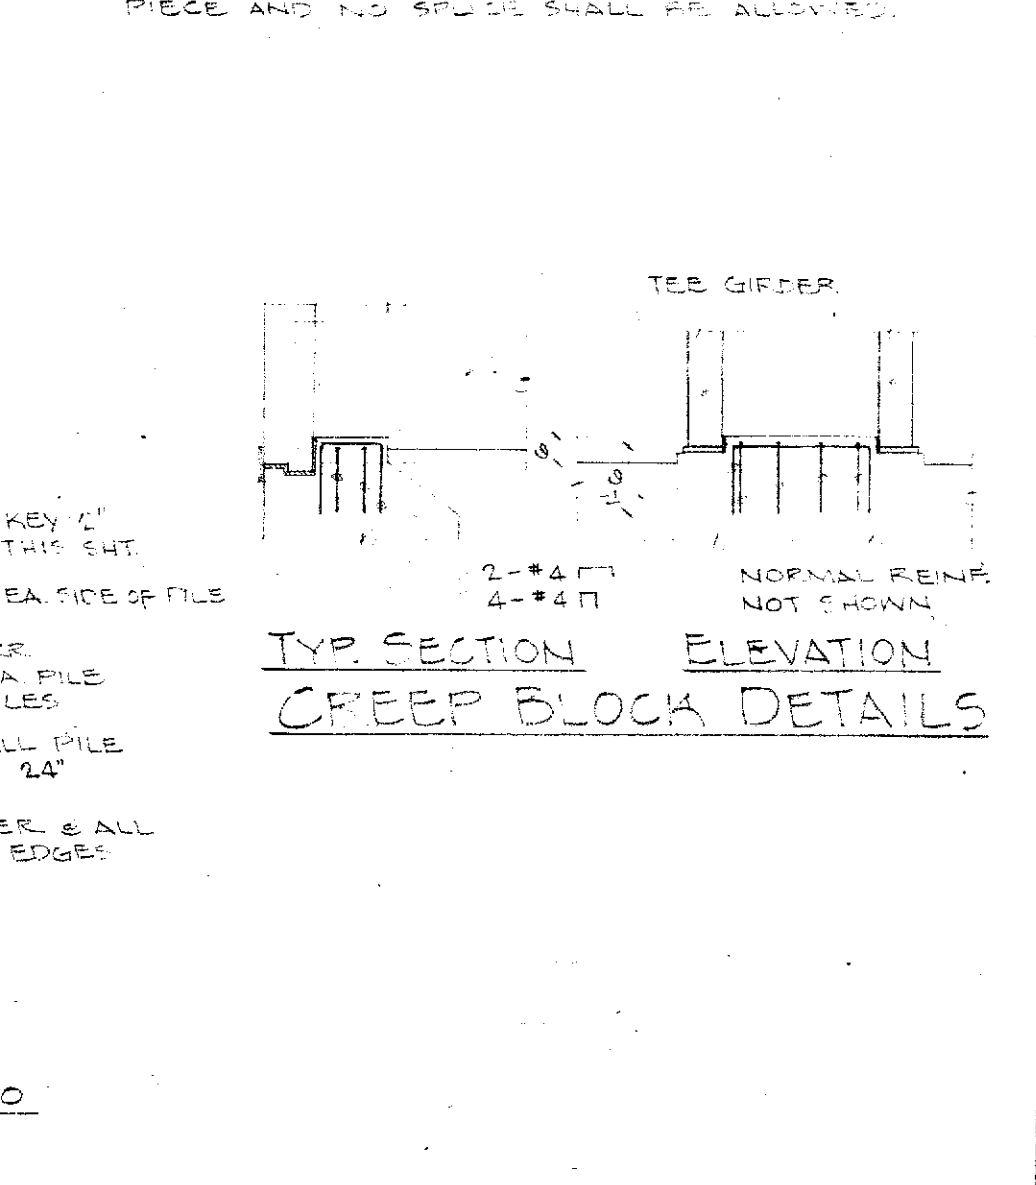
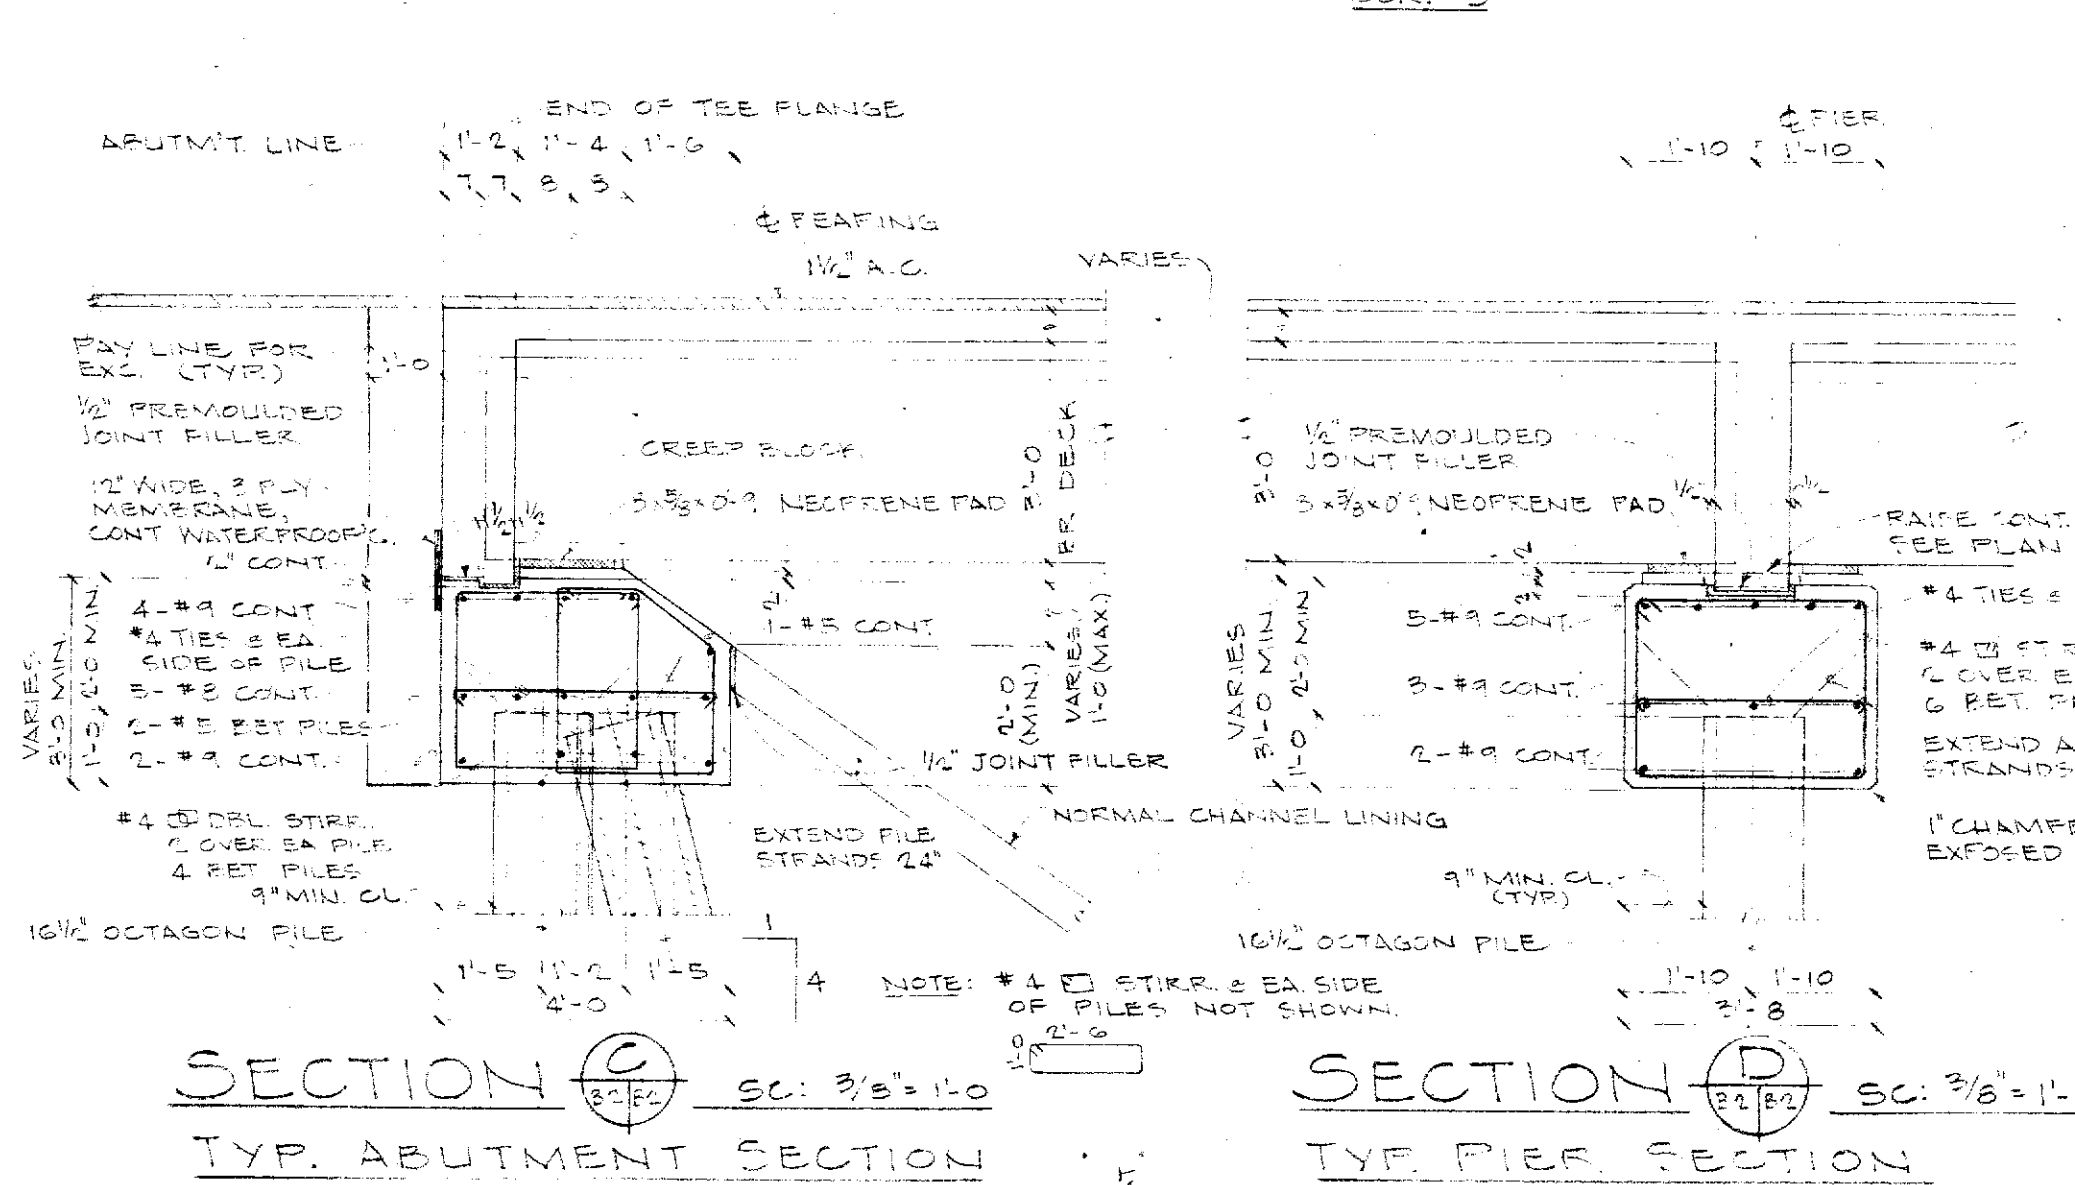
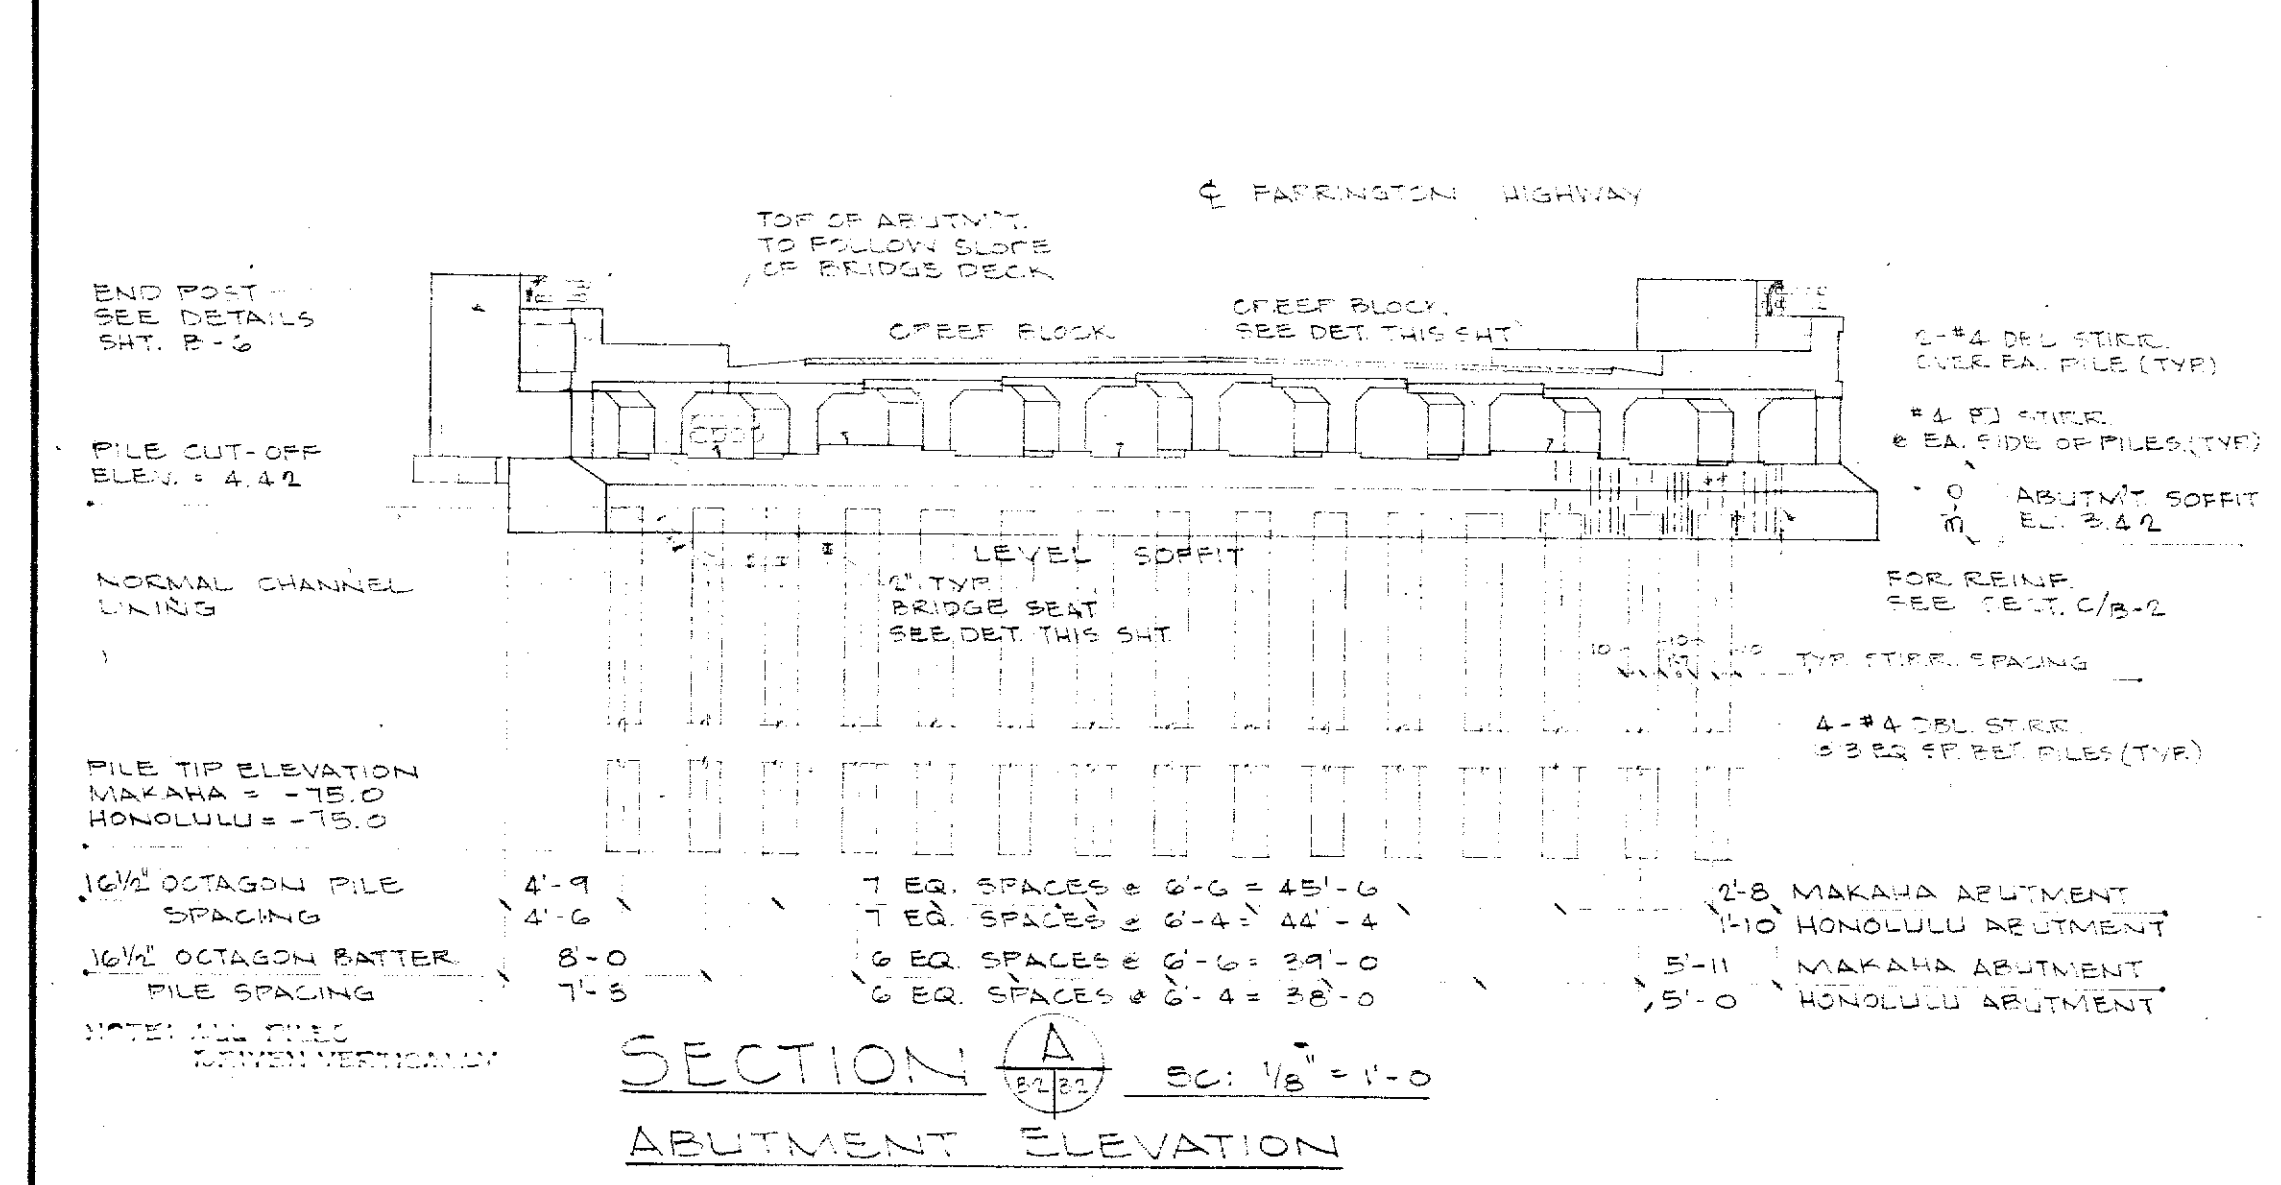


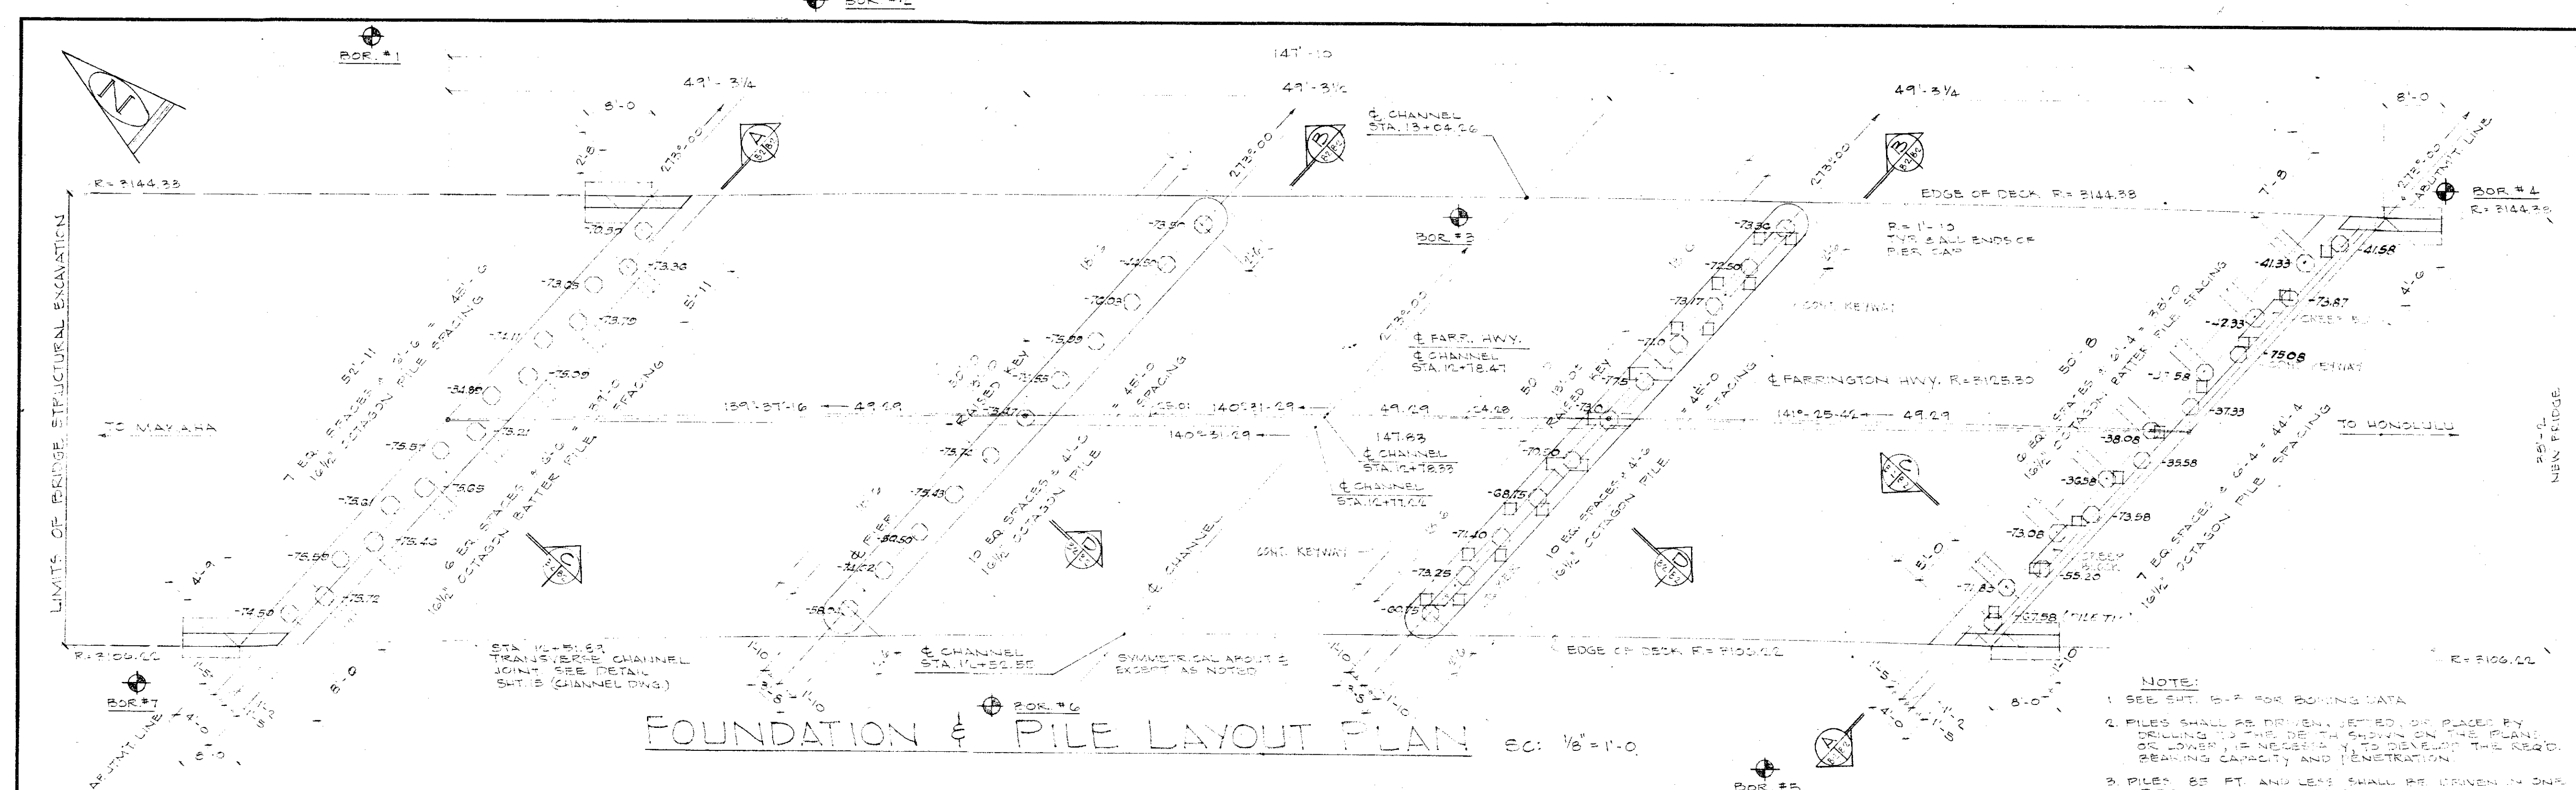

FOUNDATION PLAN, PILE LAYOUT, ABUTMENT, PIER, SEAT & MISS. DETAILS			
BRIDGE DETAILS			
KAUPUNI CHANNEL K-1			
WAIANAE IKI WATERSHED			
WAIANAE OAHU HAWAII			
DEPARTMENT OF PUBLIC WORKS			
CITY AND COUNTY OF HONOLULU			
DIVISION OF ENGINEERING			
AND			
U.S. DEPARTMENT OF AGRICULTURE			
SOIL CONSERVATION SERVICE			
Designed	W.T. AM.	Date	
Drawn	AM.	Traced	AM.
Checked	BT	Approved	Director, Div. of Engng.
		Title	Chief Engineer, D.P.W.
		Sheet	7-5-1-10
		of 25	
FILE	7	1	54