


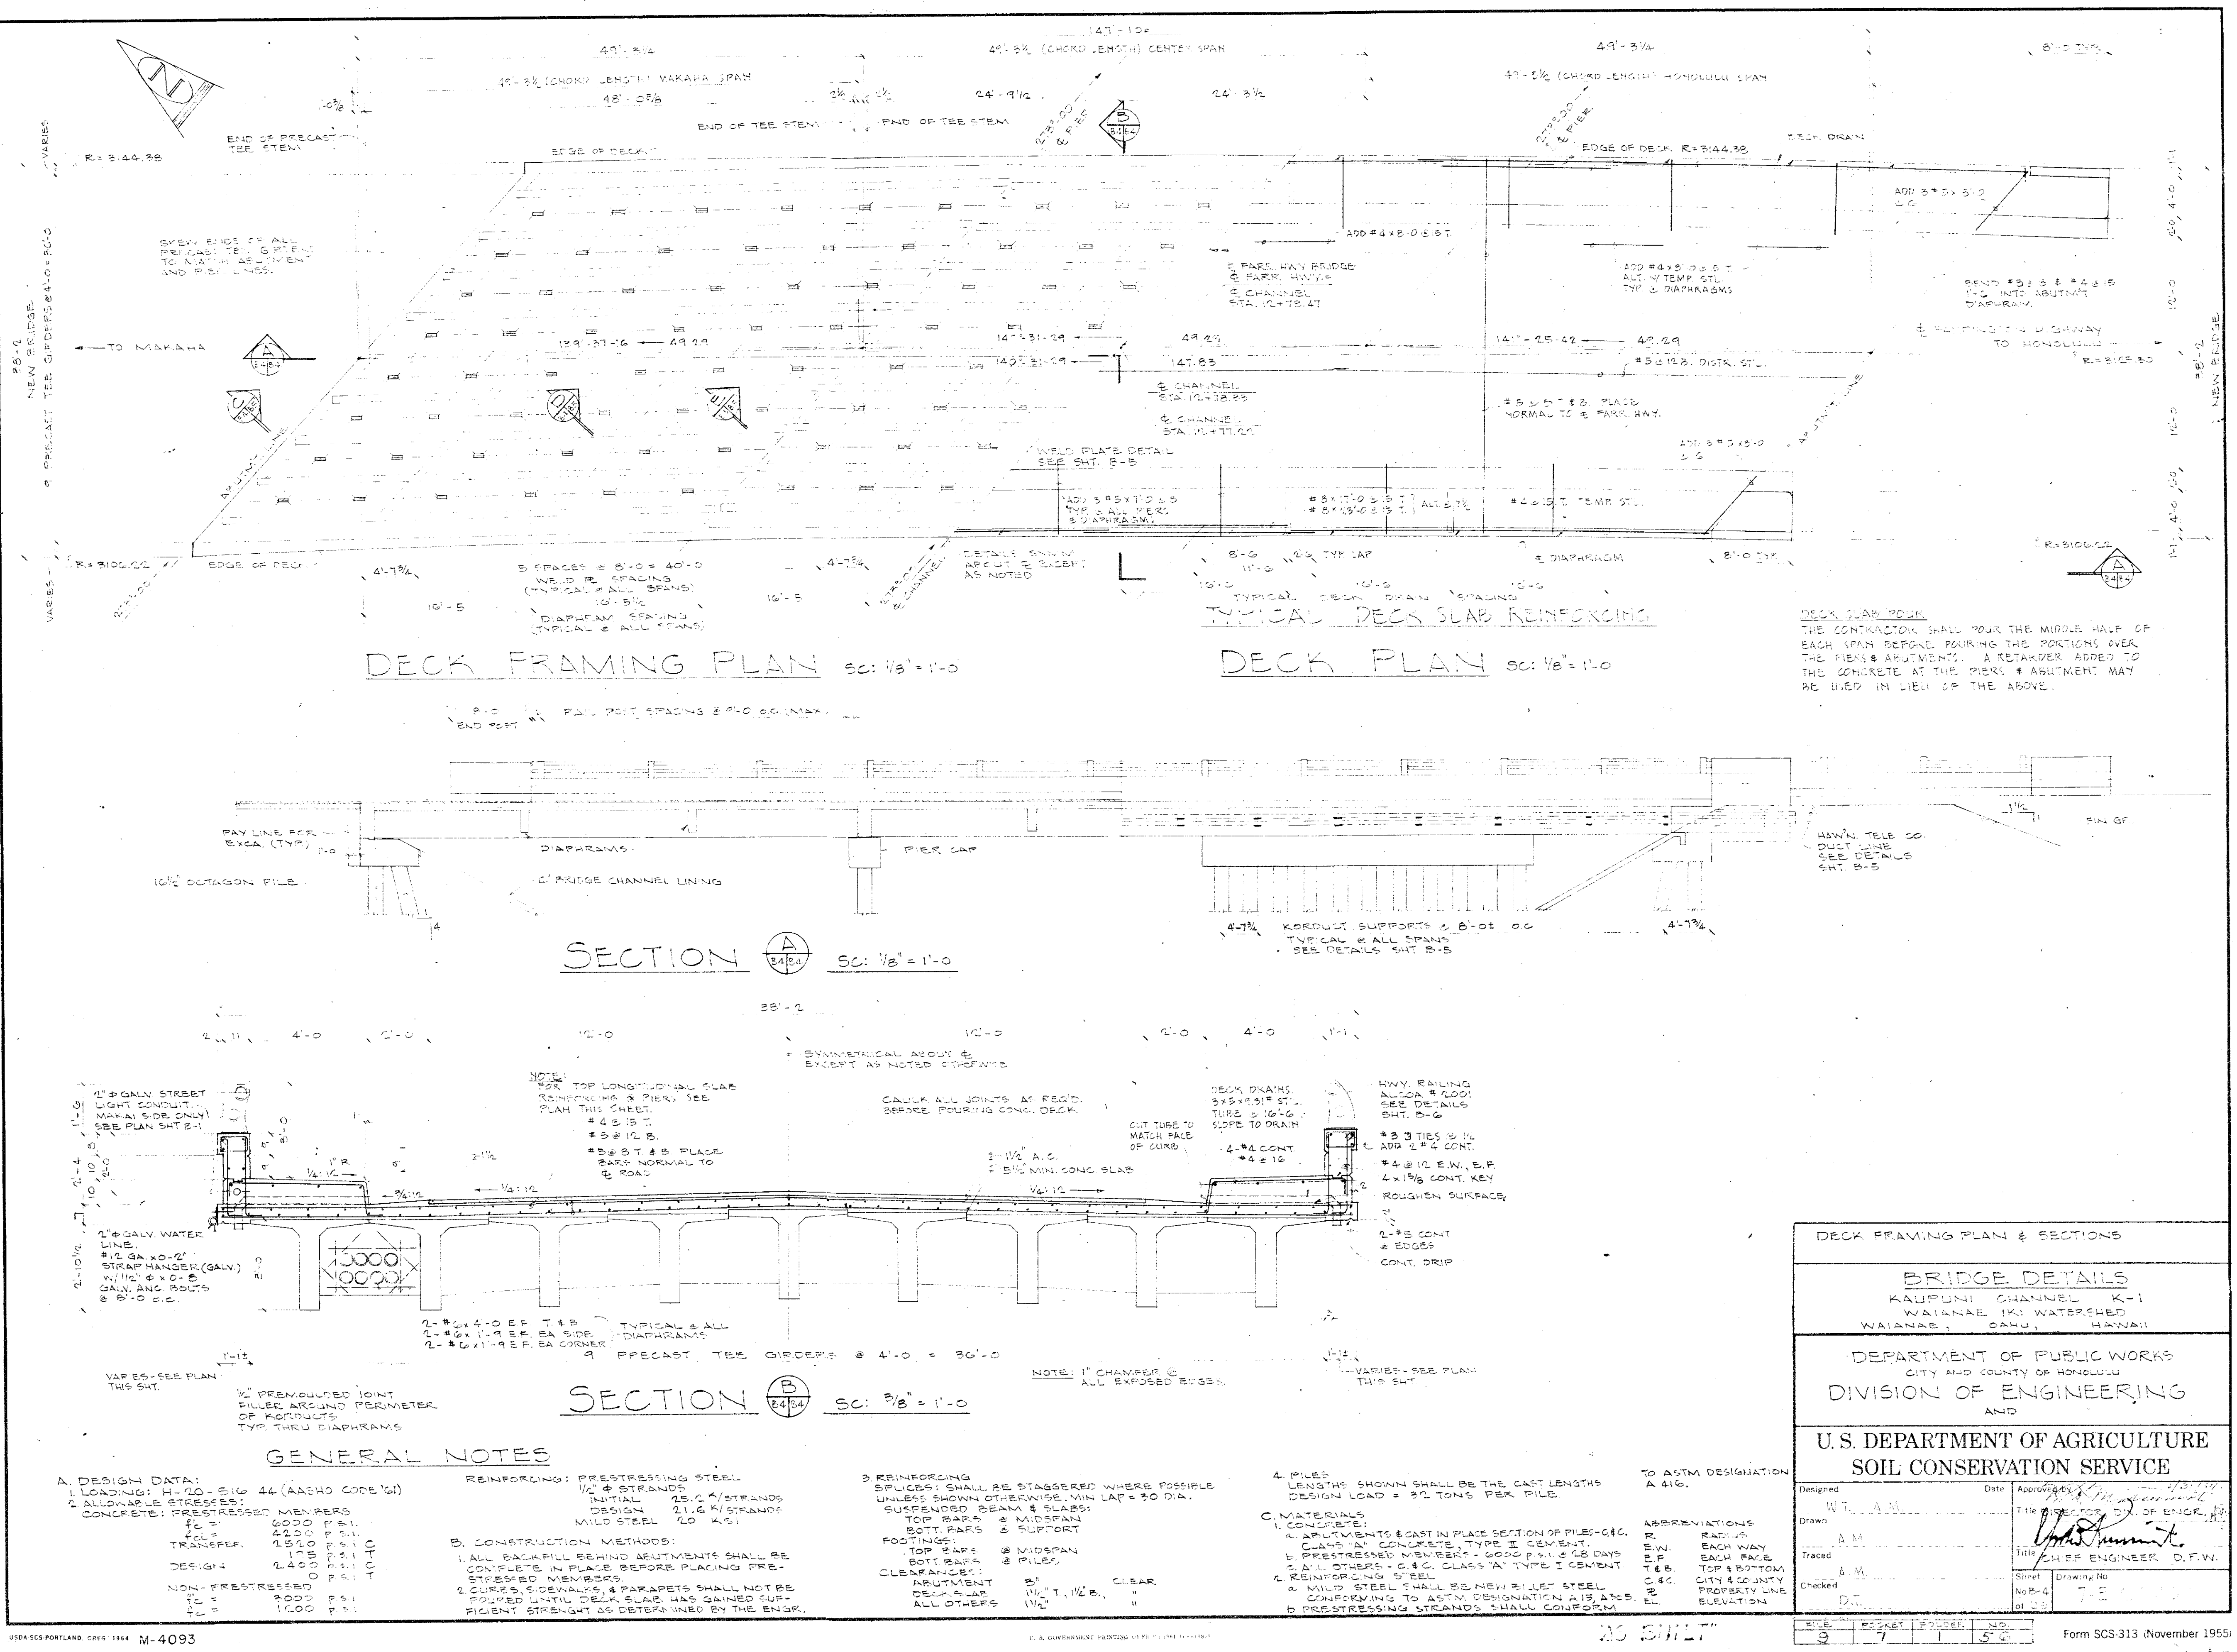

DECK FRAMING PLAN & SECTIONS	
BRIDGE DETAILS KAUPUNI CHANNEL K-1 WAIANAE, KAUAI, HAWAII	
DEPARTMENT OF PUBLIC WORKS CITY AND COUNTY OF HONOLULU DIVISION OF ENGINEERING AND U.S. DEPARTMENT OF AGRICULTURE SOIL CONSERVATION SERVICE	
Designed W.L.A.M. Drawn A.M. Traced A.M. Checked D.M.	Date 11/1/54 Title DIRECTOR, D.V. OF ENGR. Title CHIEF ENGINEER, D.F.W. Sheet No. 4 of 25 Drawing No. 7-1-1-1
FILE 3	REVISION 1 50