




PLAN SC: 1/8" = 1'-0"

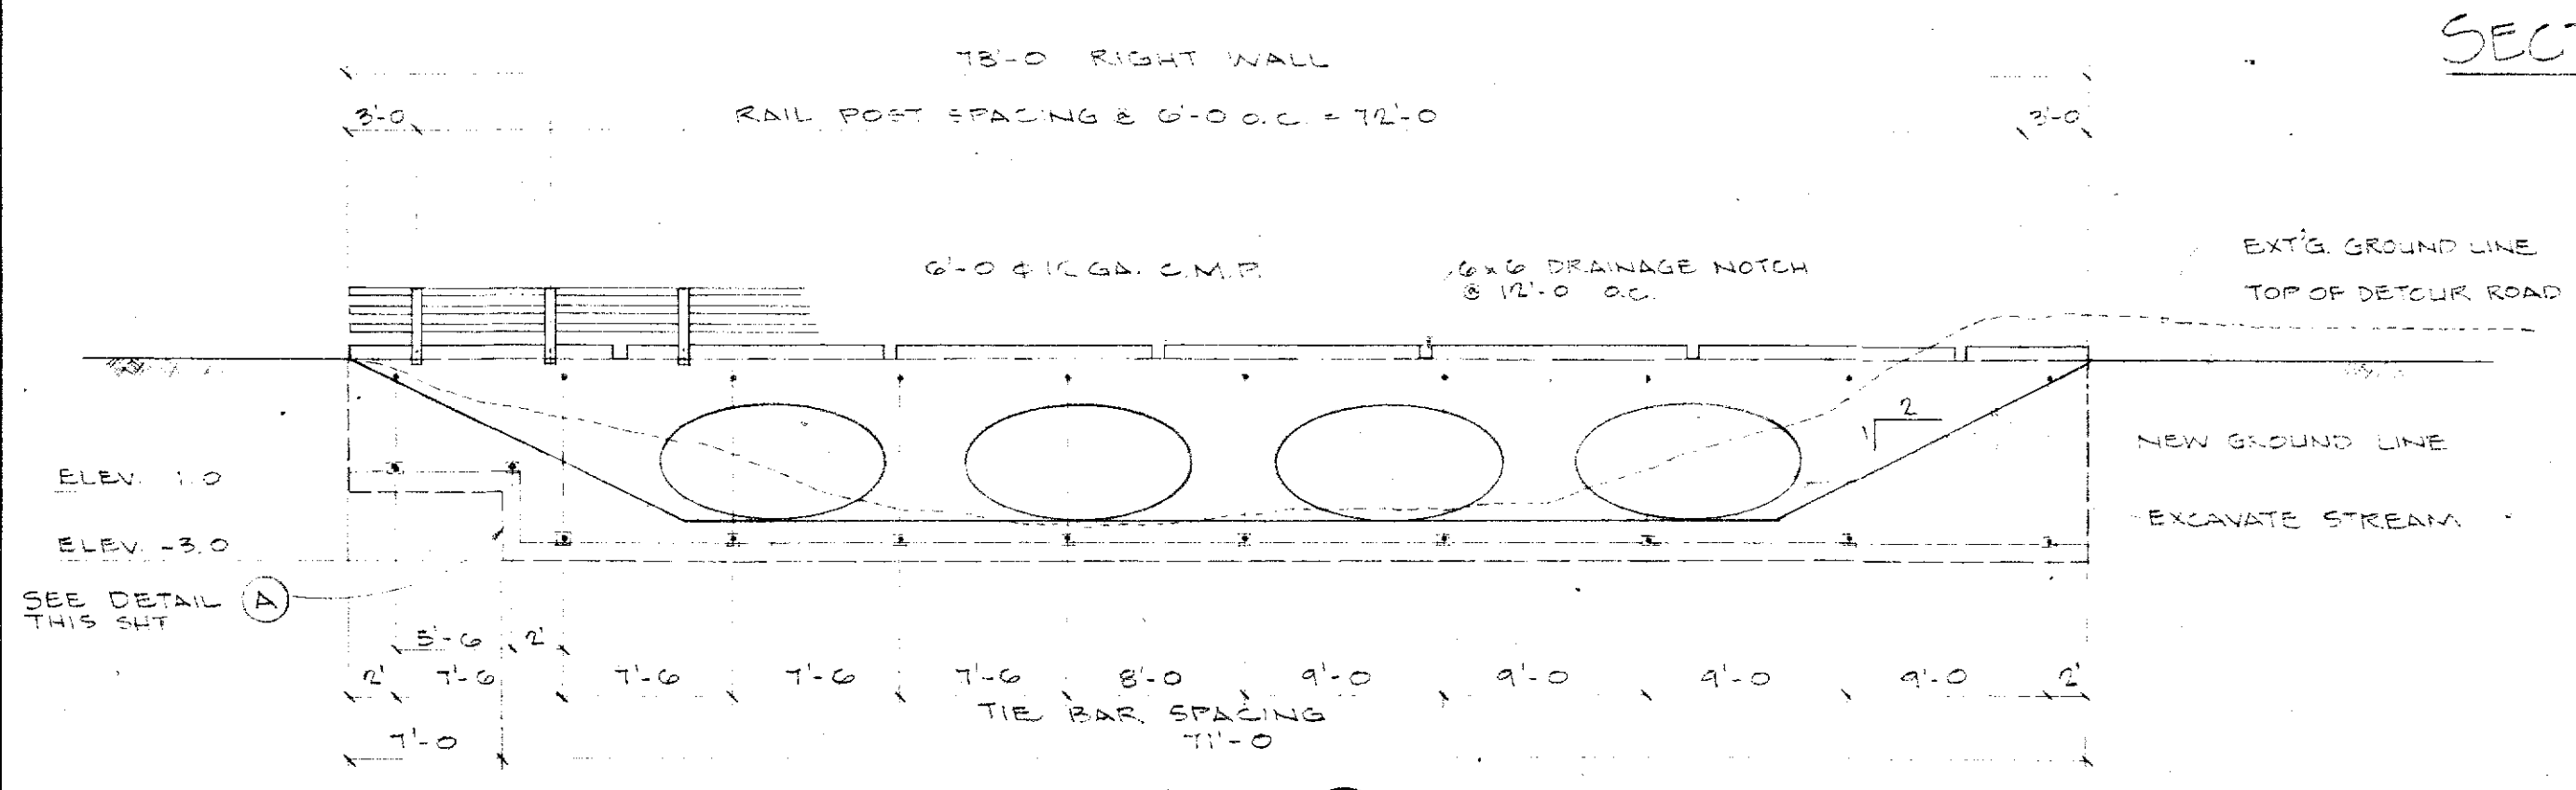


SECTION A SC: 1/8" = 1'-0"

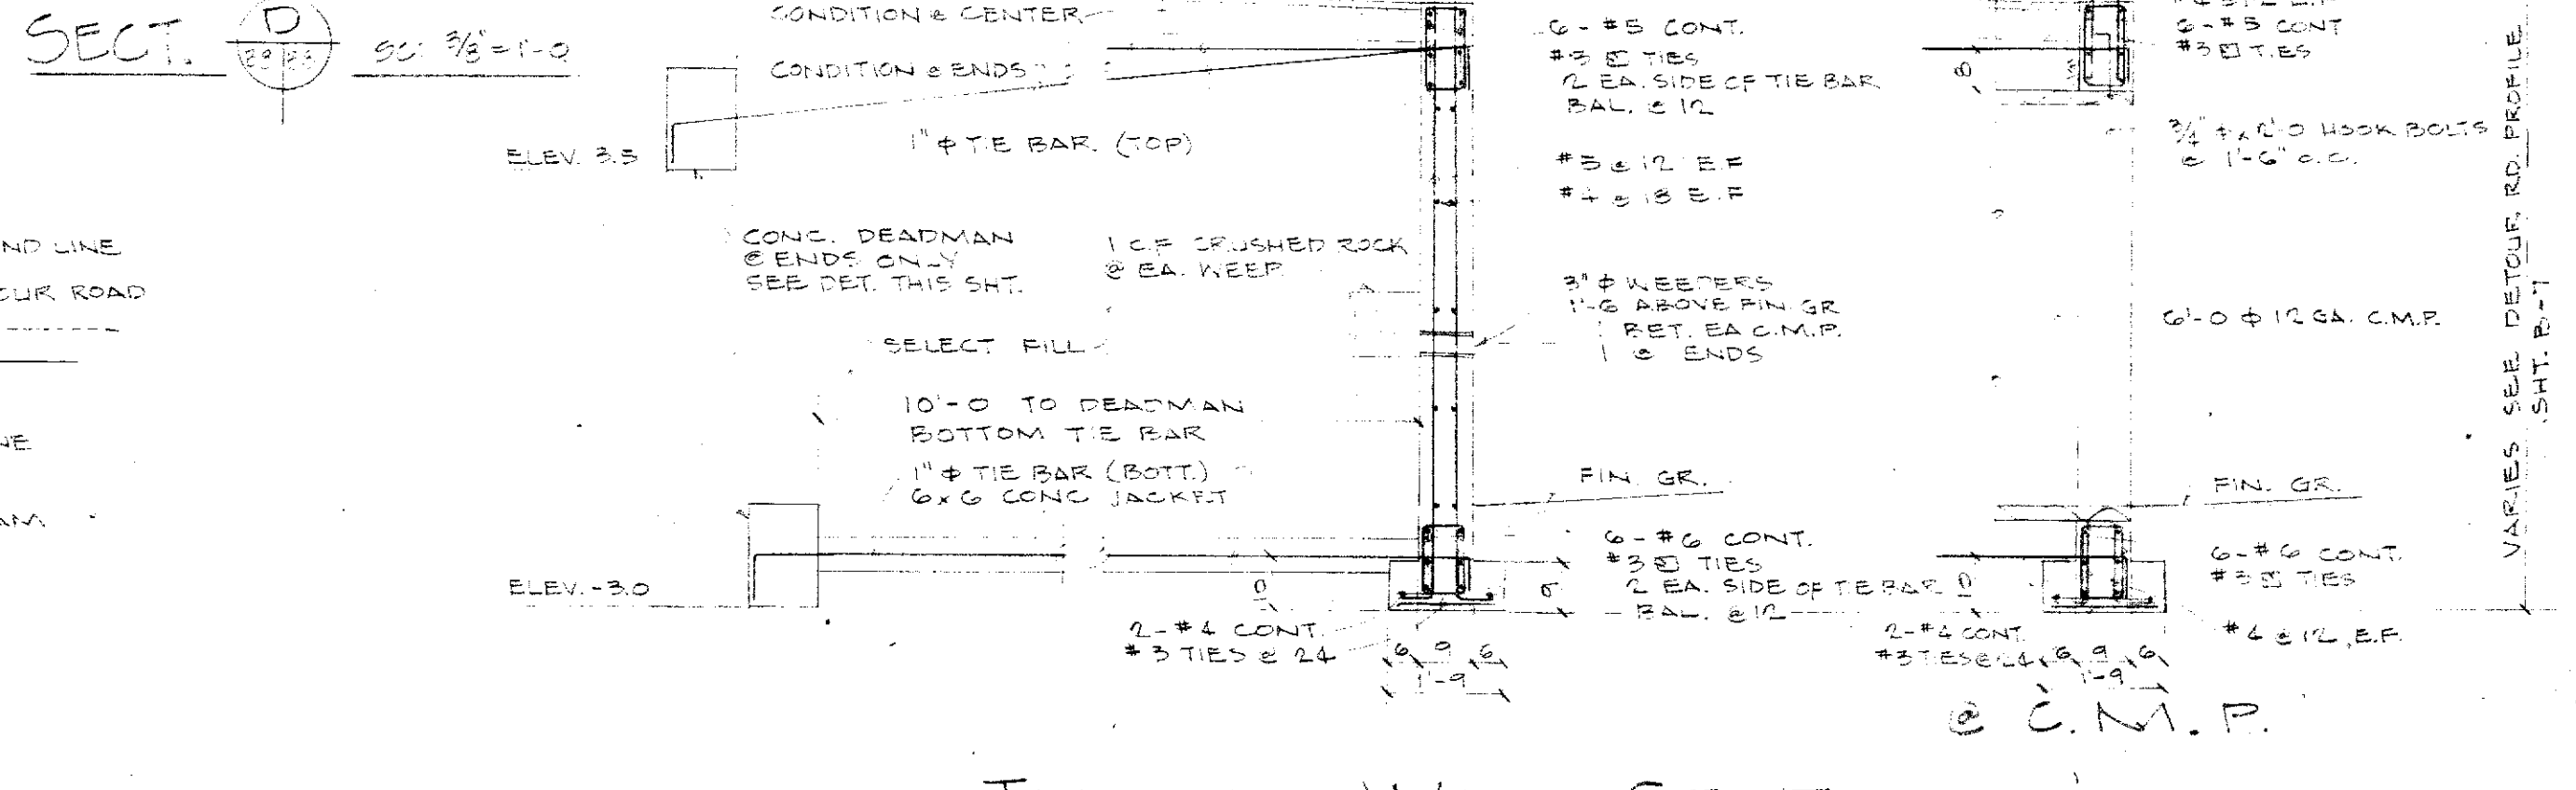


TYPICAL WALL SECTION SC: 3/8" = 1'-0"

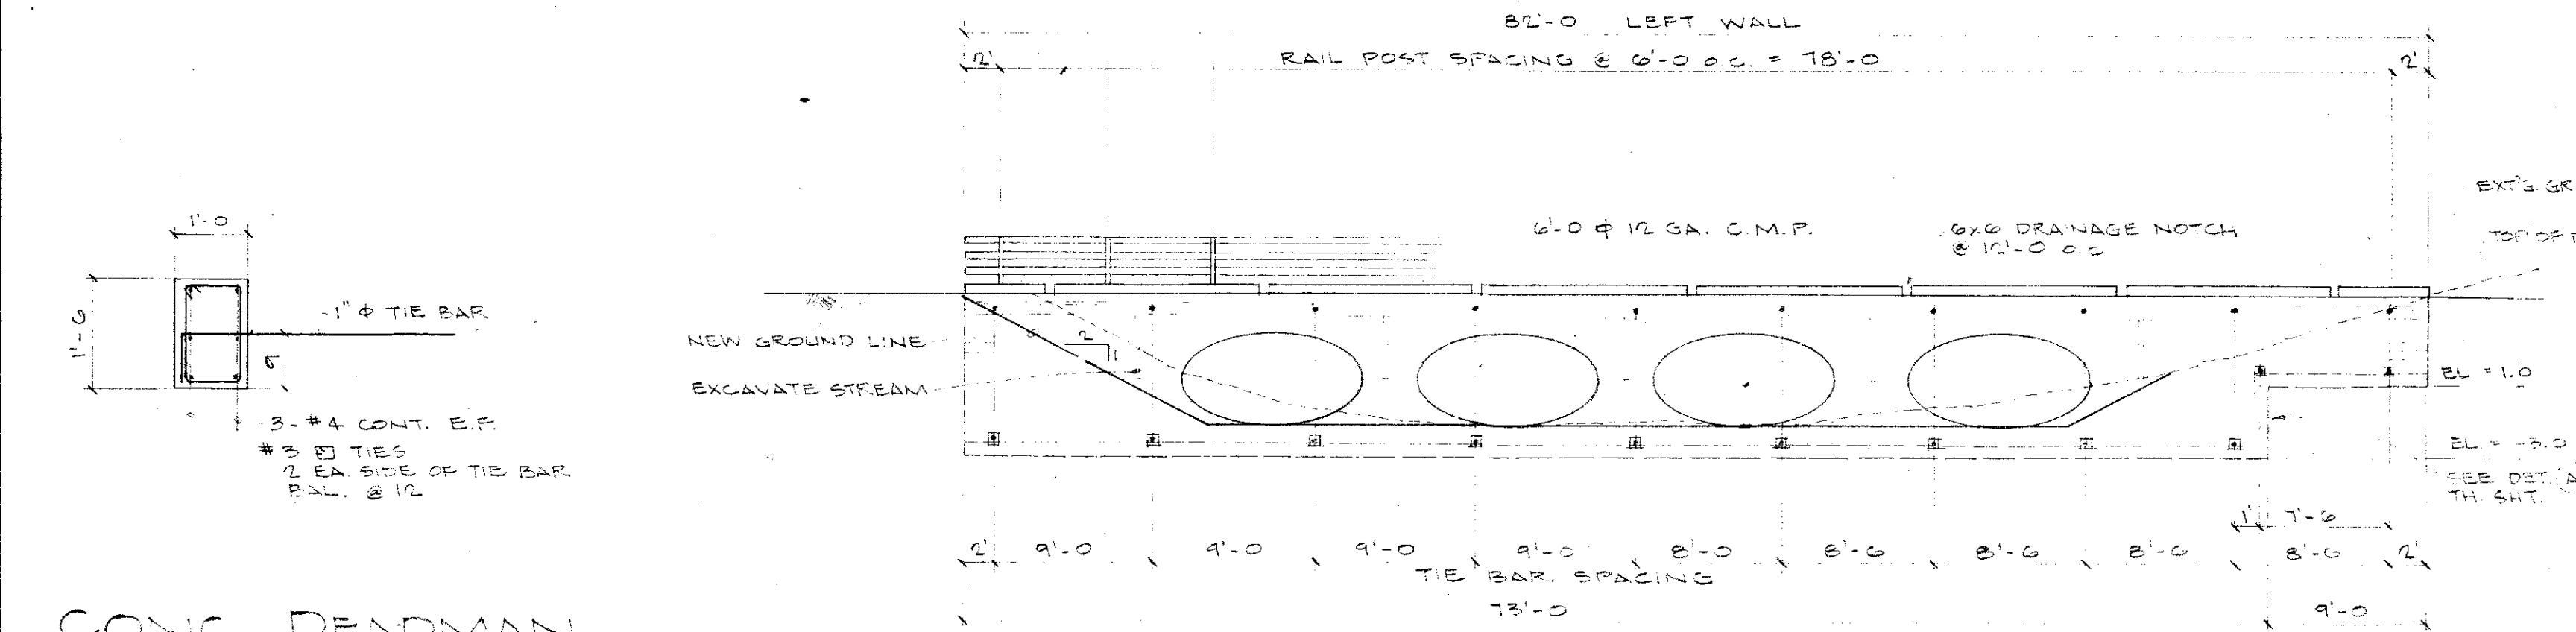

SECTION B SC: 1/8" = 1'-0"

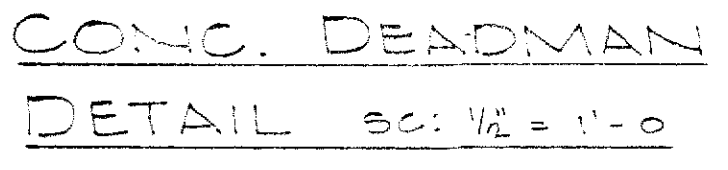

CONC. DEADMAN DETAIL SC: 1/2" = 1'-0"

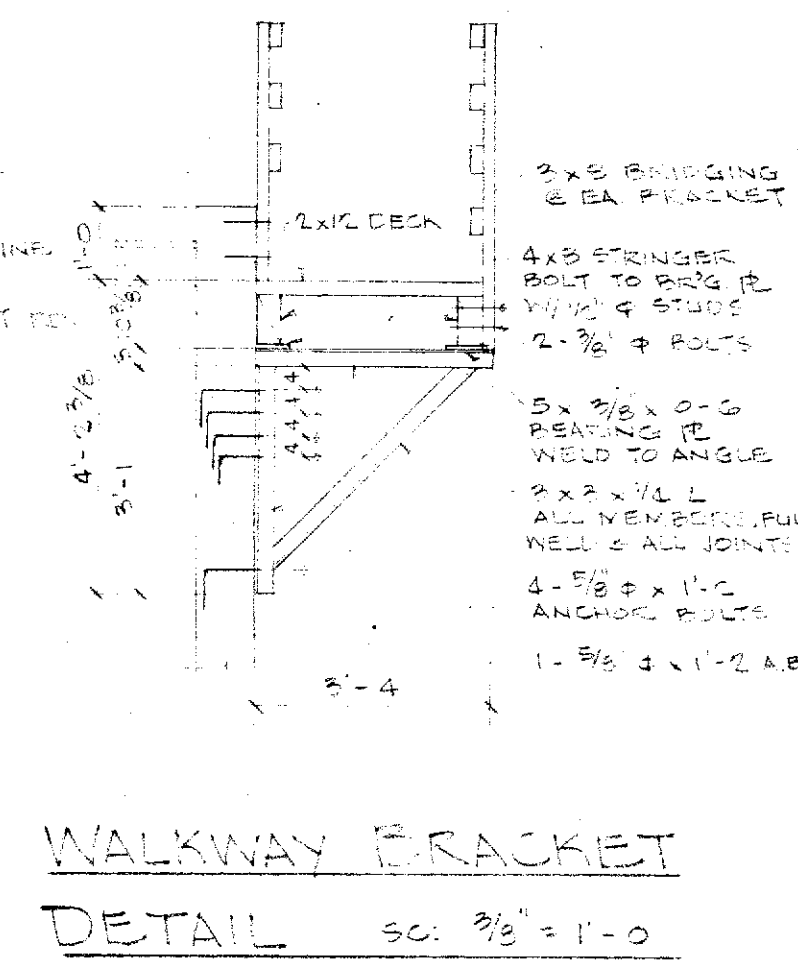

WALKWAY FRACKET DETAIL SC: 3/8" = 1'-0"

ALTERNATE NO. 1 USED.

TEMPORARY DETOUR DETAILS	
BRIDGE DETAILS KALIPUNI CHANNEL K-1 WAIANAE WATERSHED WAIANAE, CAHUI, HAWAII	
DEPARTMENT OF PUBLIC WORKS CITY AND COUNTY OF HONOLULU DIVISION OF ENGINEERING AND	
U.S. DEPARTMENT OF AGRICULTURE SOIL CONSERVATION SERVICE	
Designed	Date
Drawn	Approved
Traced	Title
Checked	Chief Engineer, D.P.W.
Sheet No. B-8	Drawing No.
of 23	7