




FED. ROAD DIST. NO.	STATE	FED. AID PROJ. NO.	FISCAL YEAR	SHEET NO.	TOTAL SHEETS
HAWAII	HAW.	STP-0300(122)	2010	ADD. 10	32

Notes:

1. Inclometers and surface settlement points, hereinafter referred to as instrumentation devices, were installed by the Engineer along the perimeter of the project. Baseline data and measurements were collected by the Engineer from these instrumentation devices prior to the start of construction. The Engineer will continue to collect data and take measurements from these instrumentation devices during and after construction.
2. The locations of the instrumentation devices shown on the drawing are approximately only. The Contractor shall verify the location of the instrumentation devices in the field.
3. The Contractor shall exercise caution when working around and near the existing instrumentation devices.
4. The Contractor shall protect the instrumentation devices from damage. Any damaged instrumentation devices resulting from the contractor's work, activities and/or actions, as determined by the Engineer, shall be replaced at no additional cost to the State and to the satisfaction of the Engineer.
5. See Section 670 - Construction Surveys of the Special Provisions for additional requirement.

Legend:

-  I-1 Exist. Inclinometer No. 1
-  P-1 Exist. Surface Settlement Point No. 1

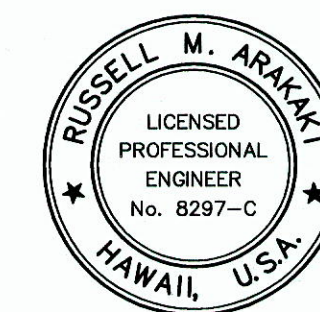

THIS WORK WAS PREPARED BY ME OR UNDER MY SUPERVISION.

Russell M. Araki
Professional Engineer
No. 8297-C
HAWAII, U.S.A.
APRIL 30, 2016
LIC. EXP. DATE


STATE OF HAWAII
DEPARTMENT OF TRANSPORTATION
HIGHWAYS DIVISION

EXISTING CONDITIONS

CASTLE HILLS ACCESS ROAD
Drainage Improvements, Phase 1
FEDERAL-AID PROJECT NO. STP-0300(122)


Scale: As Shown Date: December 2010
SHEET No. 1 OF 1 SHEETS


BENCH MARK
C&C STREET MONUMENT
(TOP OF BRASS PIN)
ELEVATION=172.73

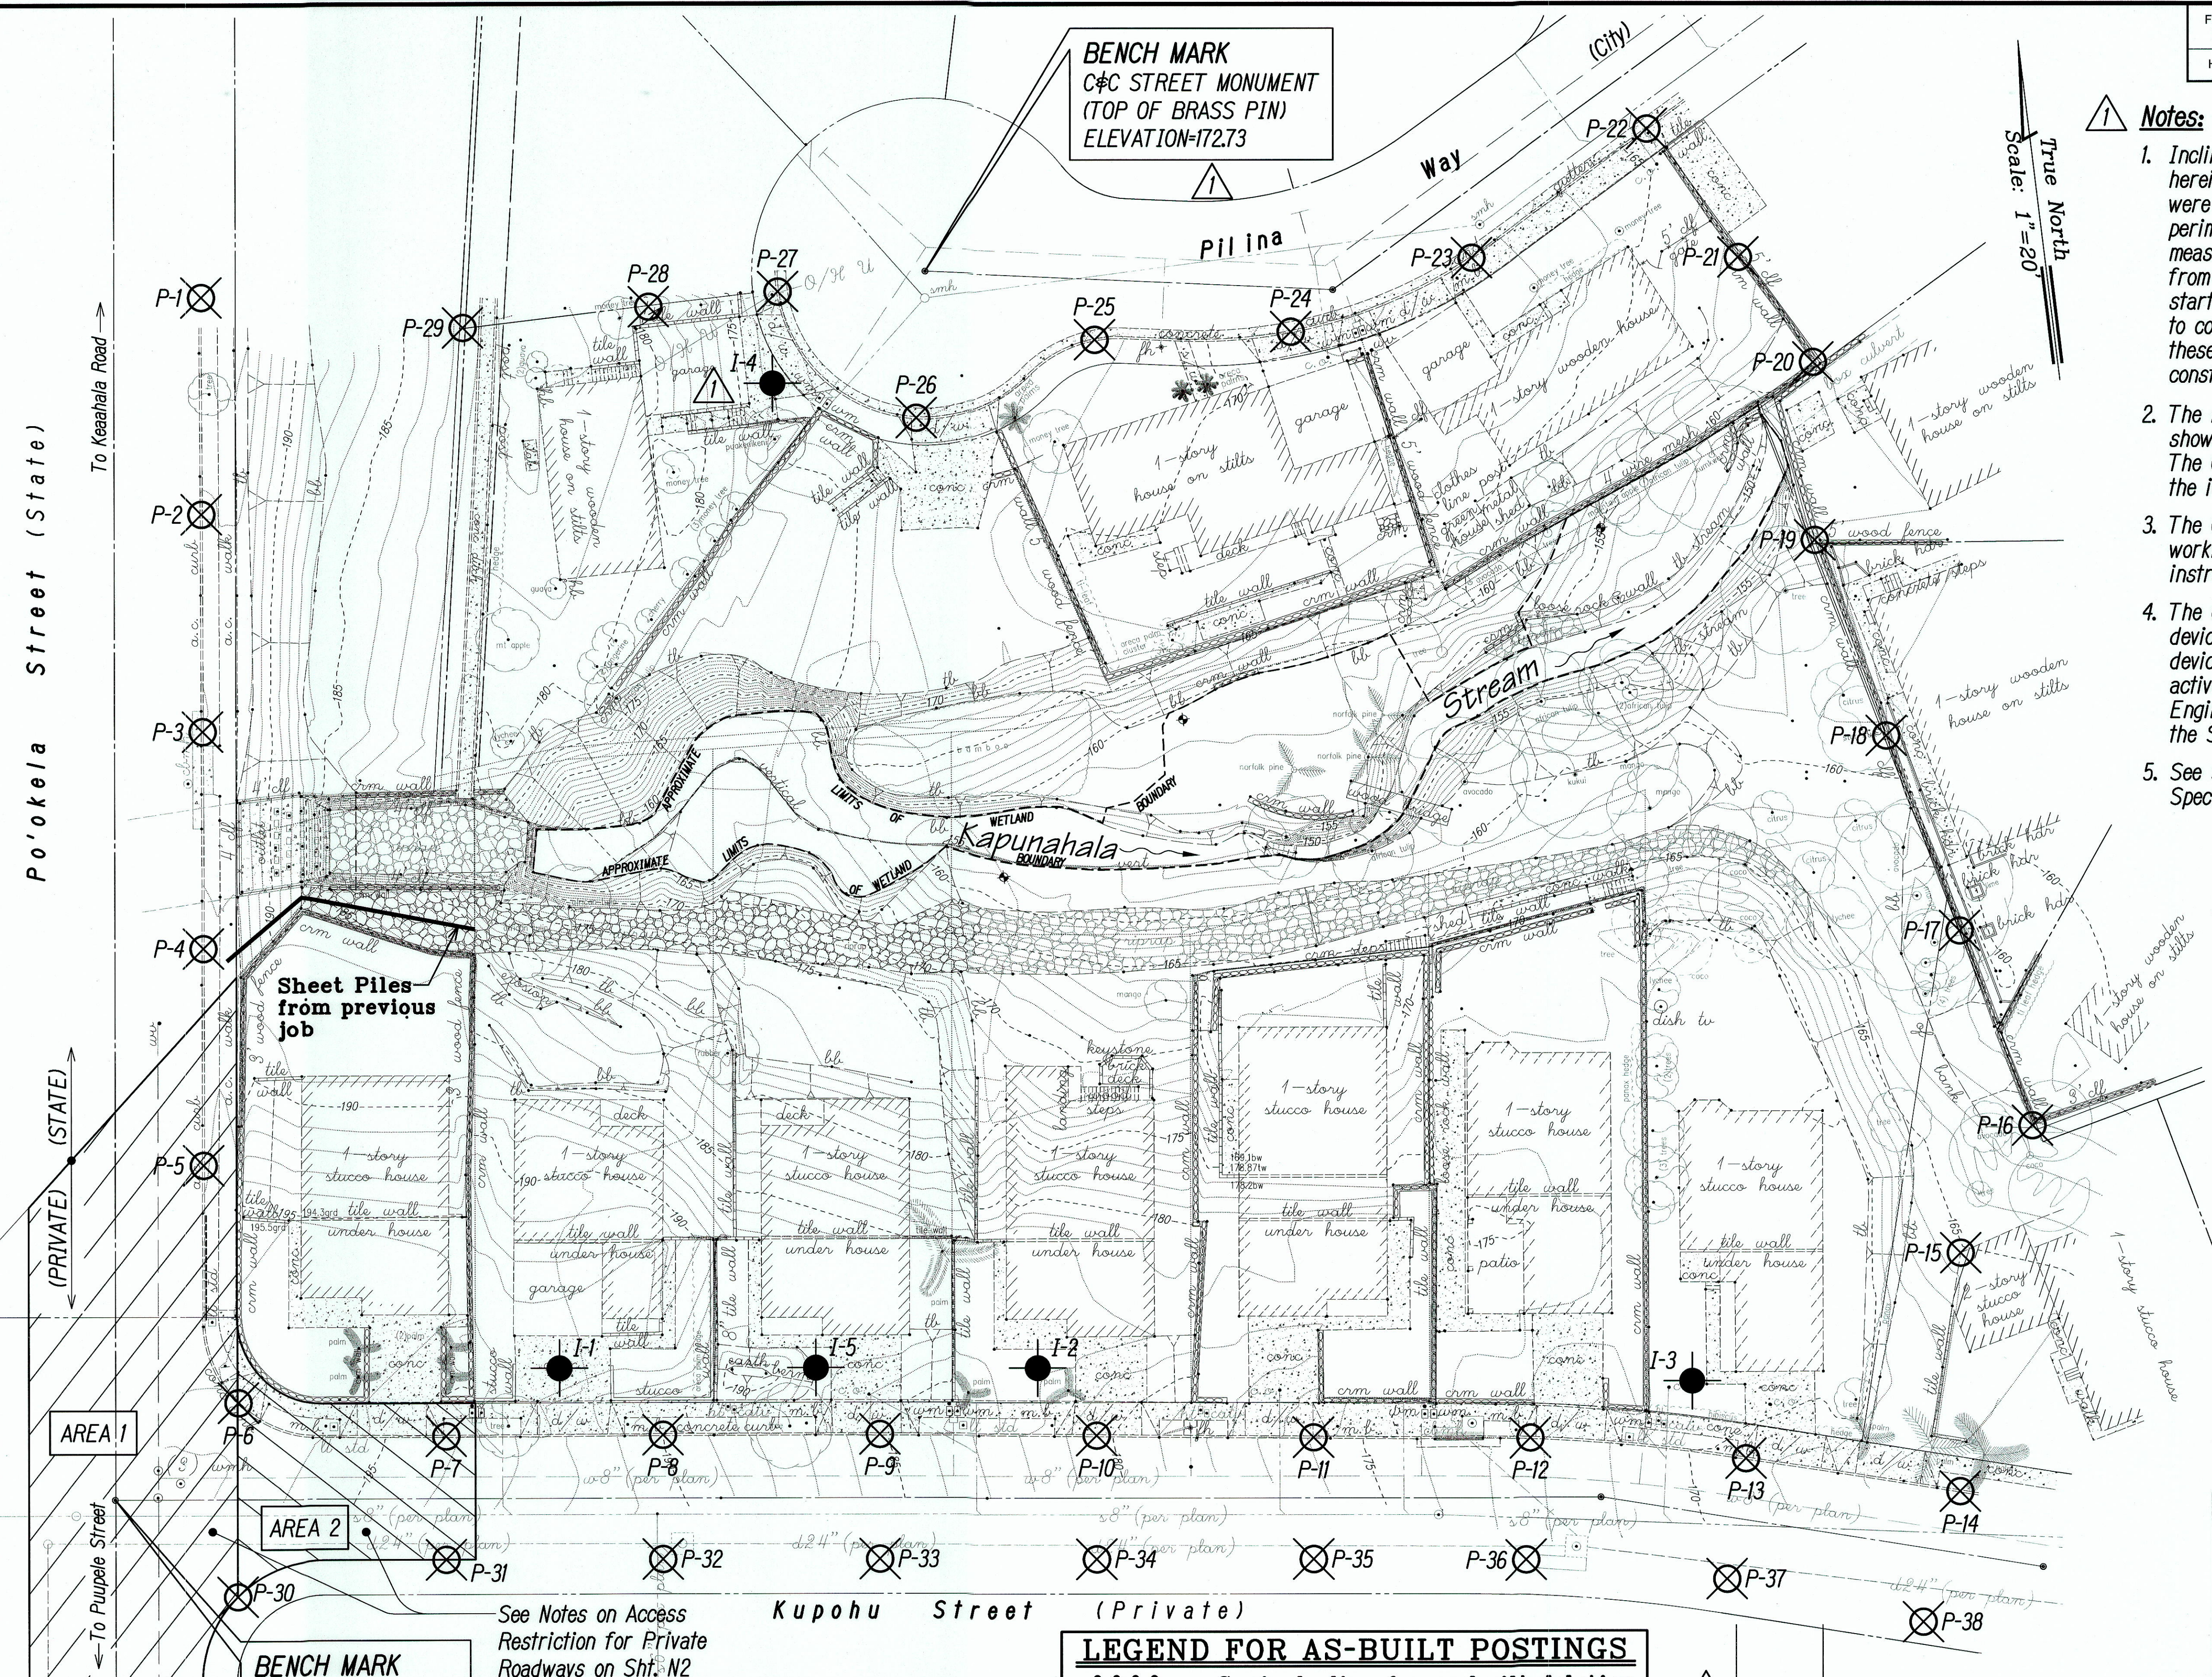

BENCH MARK
STREET MONUMENT
(TOP OF BRASS PIN)
ELEVATION=197.48

LEGEND FOR AS-BUILT POSTINGS

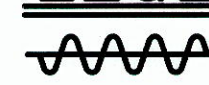 Squiggly line for as-built deletion

 Double line for as-built deletion

Roadway Text for as-built posting

DATE	REVISION
2/7/11	Revised Bench Mark and Legend. Added I-4 and Notes.

"AS-BUILT"

ADD. 10

DATE	SURVEY PLOTTED BY
DATE	DRAWN BY
DATE	DESIGNED BY
DATE	CHECKED BY