



FED. ROAD DIST. NO.	STATE	FED. AID PROJ. NO.	FISCAL YEAR	SHEET NO.	TOTAL SHEETS
HAWAII	HAW.	STP-0300(122)	2010	ADD. 14	32

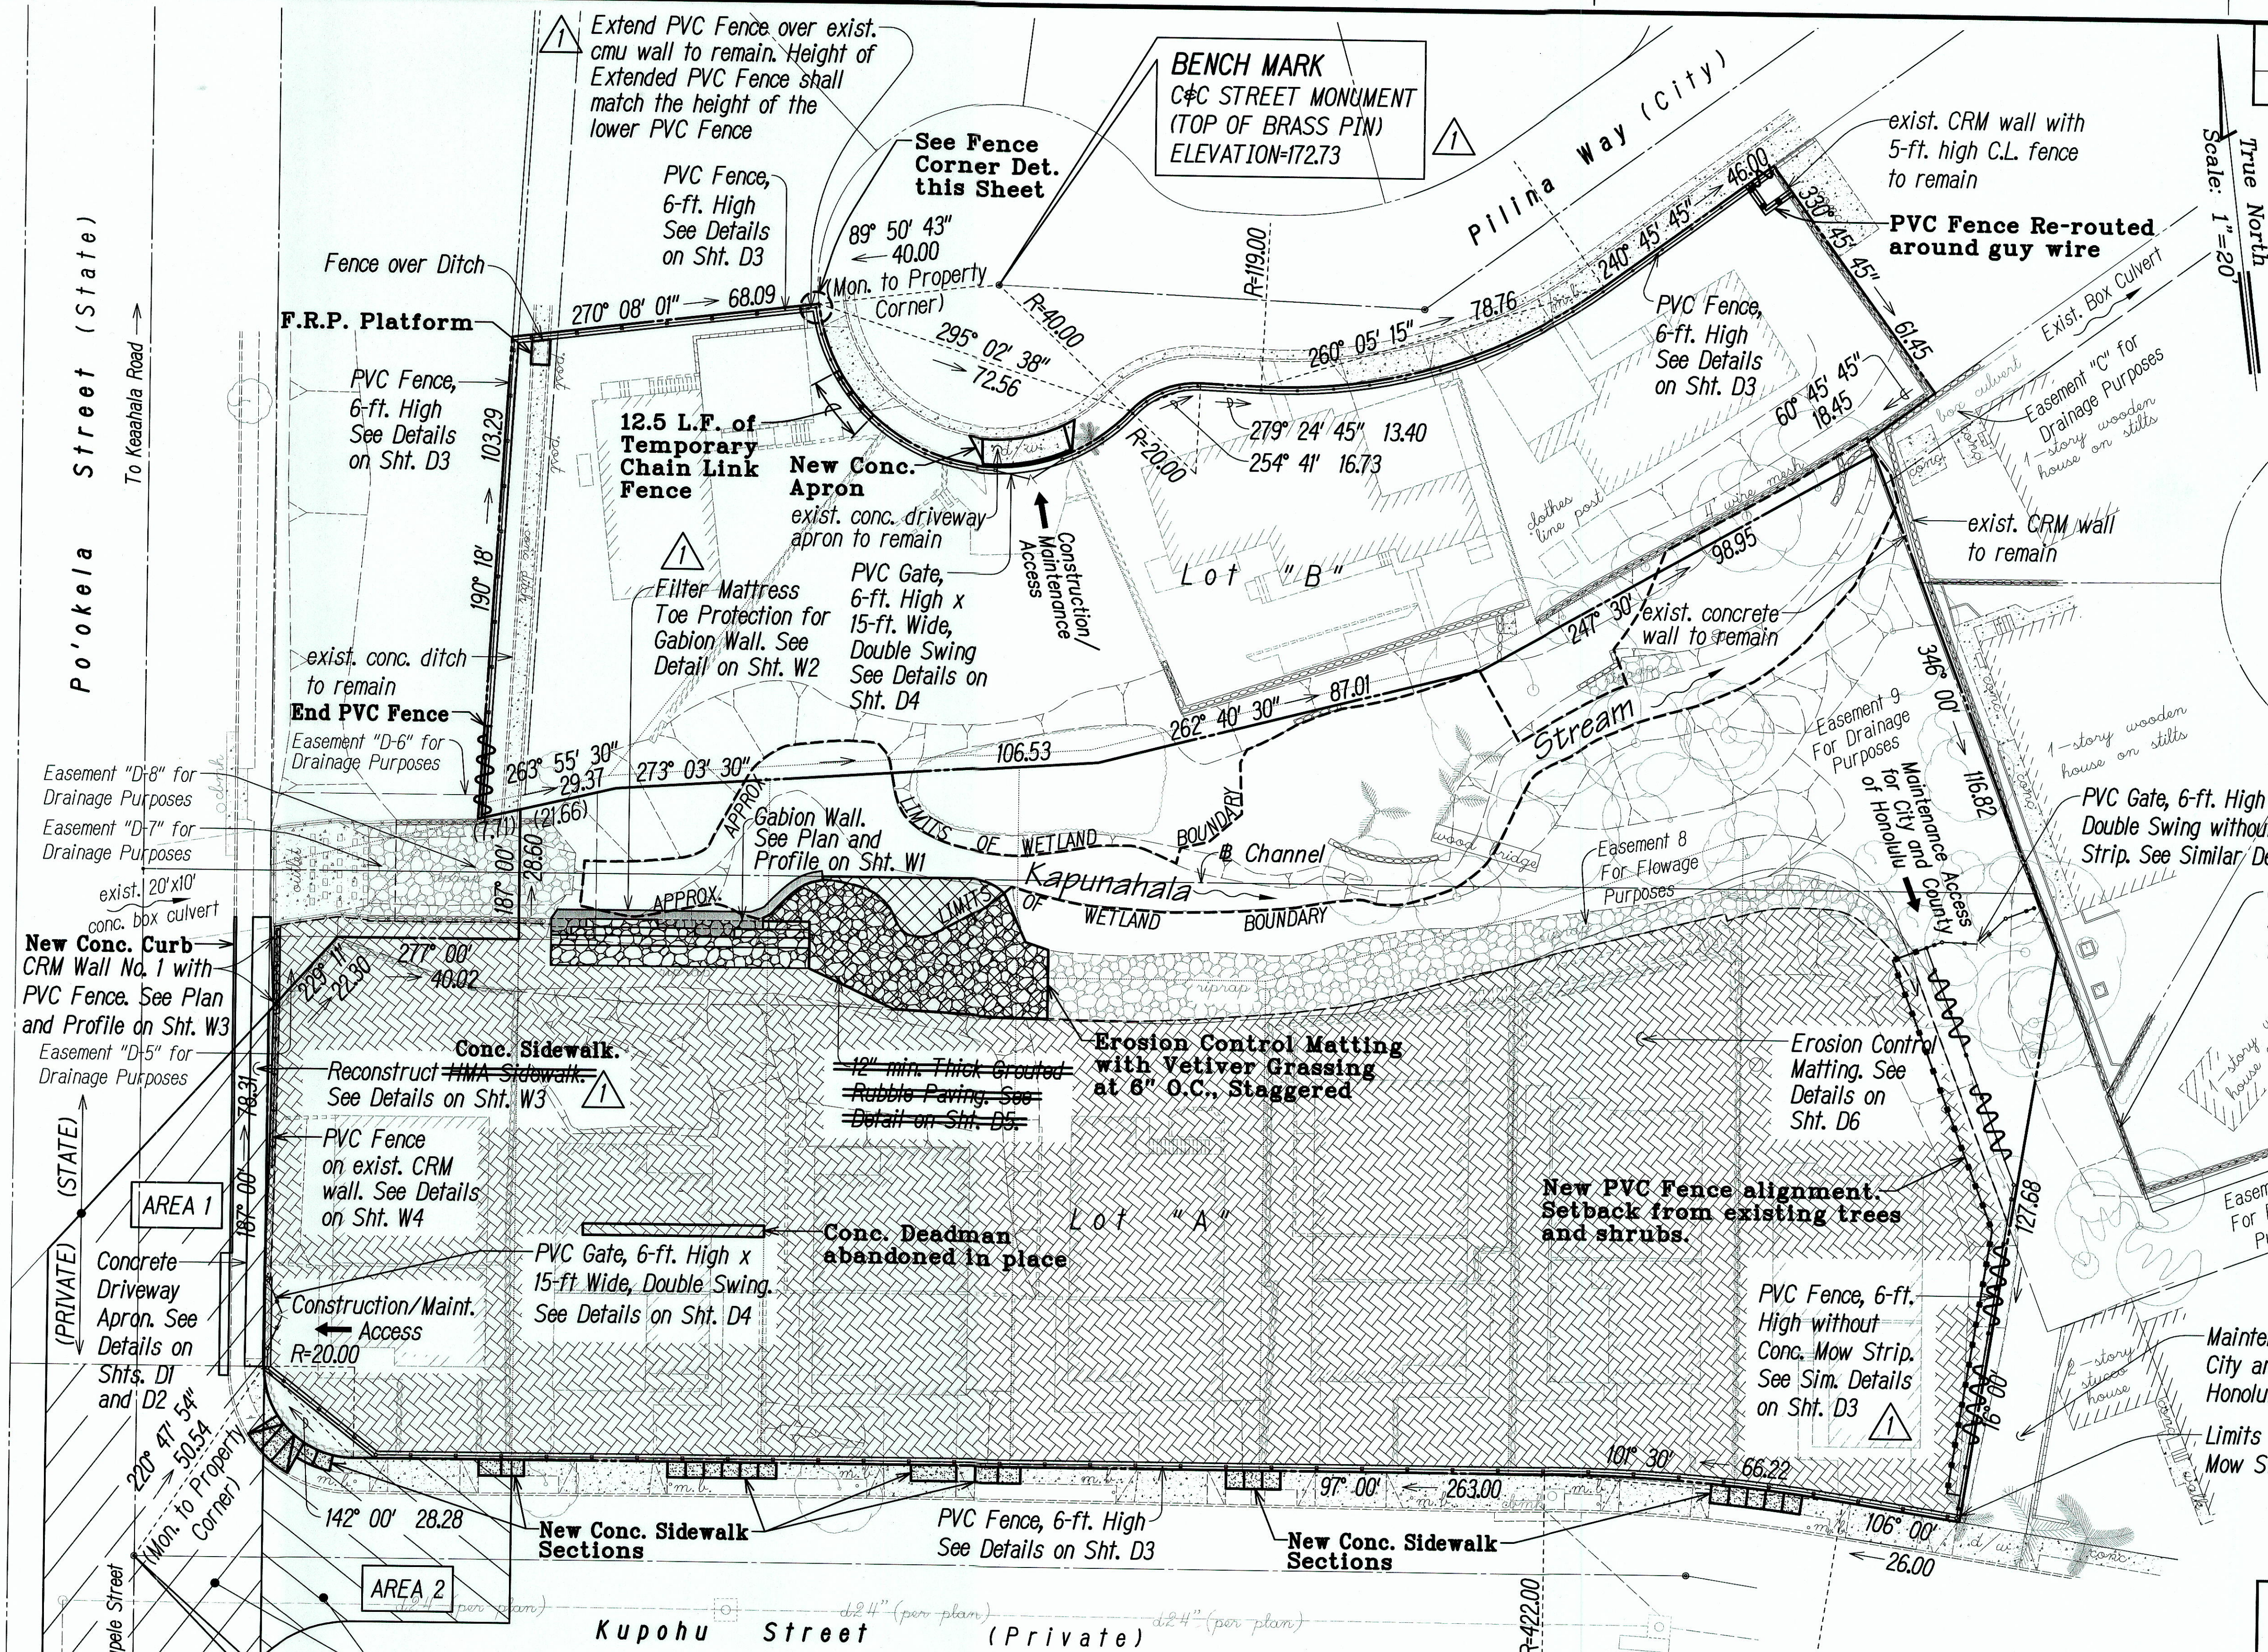

- Legend:**
- Gabion Wall
 - PVC Fence, 6-ft. High w/ Conc. Mow Strip
 - PVC Gate, 6-ft. High x 15-ft Wide, Double Swing with Conc. Mow Strip
 - Erosion Control Matting

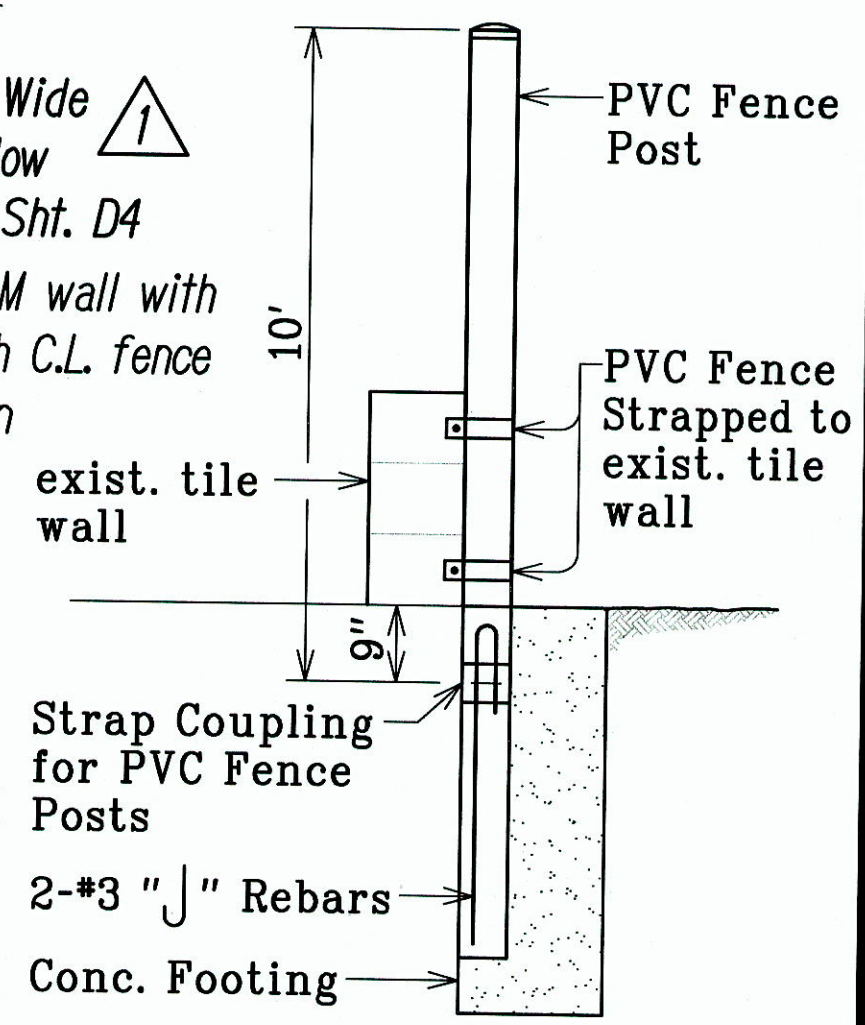

FENCE CORNER DET.
Not to Scale



THIS WORK WAS PREPARED BY ME OR UNDER MY SUPERVISION.
Russell M. Arakawa
 APRIL 30, 2016
 Lic. Exp. Date

STATE OF HAWAII
DEPARTMENT OF TRANSPORTATION
HIGHWAYS DIVISION
GENERAL PLAN
CASTLE HILLS ACCESS ROAD
Drainage Improvements, Phase 1
FEDERAL-AID PROJECT NO. STP-0300(122)
Scale: As Shown
Date: December 2010
SHEET No. *CI* OF *CI* SHEETS

2/7/11
DATE
Revised Sheet.
REVISION

LEGEND FOR AS-BUILT POSTINGS
 Squiggly line for as-built deletion
 Double line for as-built deletion
Roadway Text for as-built posting

BENCH MARK
STREET MONUMENT
(TOP OF BRASS PIN)
ELEVATION=197.48

See Notes on Access
Restriction for Private
Roadways on Sht. N2

GENERAL PLAN
SCALE: 1"=20'

"AS-BUILT"

ADD. 14

Thu, 03 Sep 2015 - 9:19am
D:\Projects\STATE\DOT\CASHILL\DESIGN\PHASE 1\RECORD DWGS\ADD2\14-Cashills-rhi-GeneralLayout.dwg

ORIGINAL PLAN	SURVEY PLOTTED BY	DATE
NO. 1	DRAWN BY	
NO. 2	CHECKED BY	
NO. 3	DESIGNED BY	
NO. 4	QUANTITIES BY	
NO. 5	CHECKED BY	