


Tue, 03 Sep 2015 - 9:12am
D:\Projects\STATE\DOT\CASHILL\DESIGN\PHASE 1\RECORD DWGS\ADD2127-Cashill-Ph1-LandscapePlan.dwg

SURVEY PLOTTED BY	DATE
DRAWN BY	
DESIGNED BY	
QUANTITIES BY	
CHECKED BY	
ORIGINAL PLAN	
NOTE BOOK	
No.	

PLANT SCHEDULE				
QUANTITY	COMMON NAME	SCIENTIFIC NAME	SIZE	COMMENTS
1,030	Sunshine Vetiver Grass	Chrysopogon zizanioides "Sunshine"	Sprigs/Slips	Do not import. Use locally grown. Perforate erosion control matting then plant. See Detail on Sheet W2.

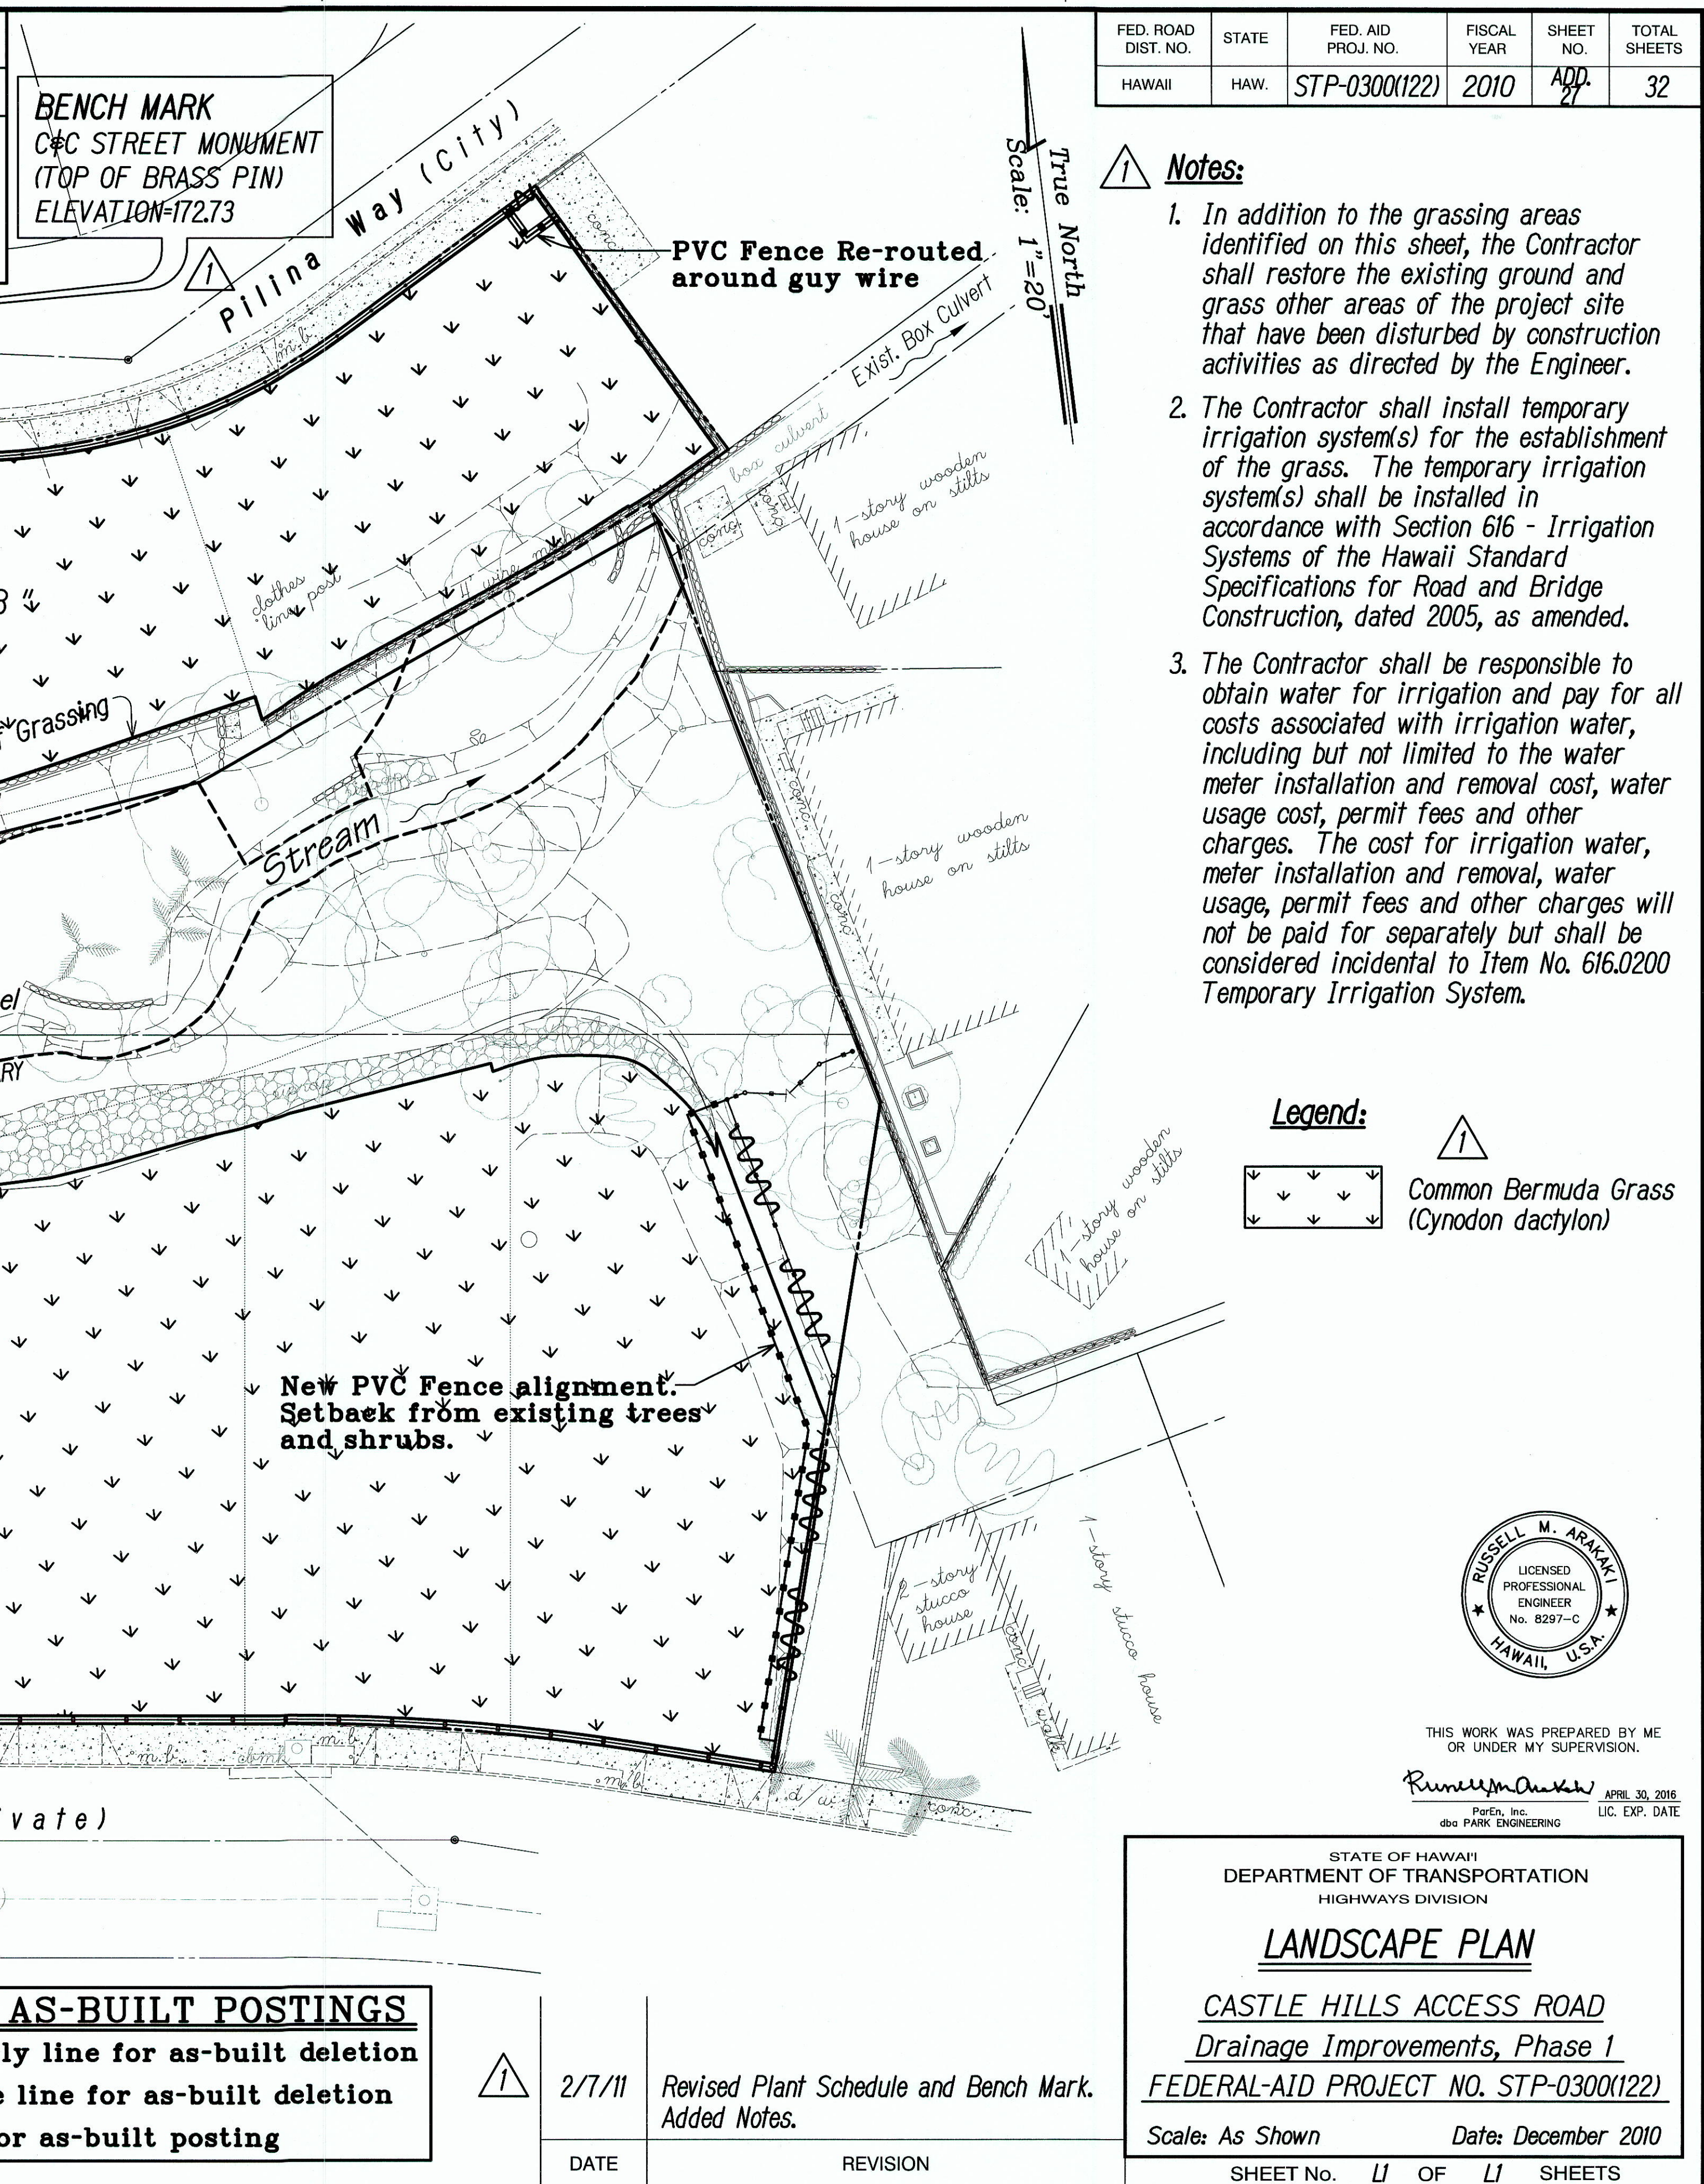

"AS-BUILT"

ADD. 27