

Wed, 07 Dec 2011 - 2:04pm
D:\Projects\STATE DOT\CASHILL\DESIGN\PHASE 2\01-Cashills-ph2-TITLE.dwg


ORIGINAL PLAN	SURVEY PLOTTED BY	DATE
NOTE BOOK	DESIGNED BY	
No.	QUANTITIES BY	
	CHECKED BY	

PAREN, INC. HWY-DS 692-7544 DEC. 2011
DESIGNED BY MANAGED BY PHONE DATE



INDEX TO DRAWINGS	
SHEET NO.	DESCRIPTION
1	TITLE SHEET
2	STANDARD PLANS SUMMARY
3-4	GENERAL NOTES
5	LEGEND & ABBREVIATIONS
6-9	WATER POLLUTION, EROSION CONTROL AND BMP NOTES AND DETAILS
10	GENERAL PLAN
11	EXISTING CONDITIONS
12	EROSION CONTROL PLAN
13	TEMPORARY STREAM DIVERSION PLAN
14	DEMOLITION PLAN
15	GRADING PLAN
16-18	GABION WALL PLAN AND DETAILS
19-20	MARINE MATTRESS DETAILS
21-23	CONC. DITCH PLAN, PROFILE AND SECTIONS
24-26	PVC AND CHAIN LINK FENCE DETAILS
27	DETAILS
28-31	BORING LOGS
32	STRUCTURAL NOTES
33	TYPICAL DETAILS
34	MICROPILE LAYOUT PLAN
35-37	DROP STRUCTURE PLAN, SECTIONS AND NOTES
38-39	WALL SECTIONS
40-41	DROP STRUCTURE PLAN, SECTIONS AND DETAILS
42-44	MICROPILE DETAILS, SECTIONS AND NOTES
45	TEMPORARY DIVERSION WALL PLAN, SECTIONS AND DETAILS
46-47	EXISTING CONCRETE STRUCTURE THICKENED WALL PLAN, ELEVATIONS AND SECTIONS
48	DIVERSION DRAIN PIPE OPENING REPAIR SECTION
49	LANDSCAPE PLAN
50-55	CROSS SECTIONS

STATE OF HAWAII
DEPARTMENT OF TRANSPORTATION
HIGHWAYS DIVISION
HONOLULU, HAWAII
"AS-BUILT"
PLANS FOR
**CASTLE HILLS ACCESS ROAD
DRAINAGE IMPROVEMENTS, PHASE 2**
FEDERAL AID PROJECT NO. STP-0300(125)

DISTRICT OF KOOLAUPOKO
ISLAND OF OAHU

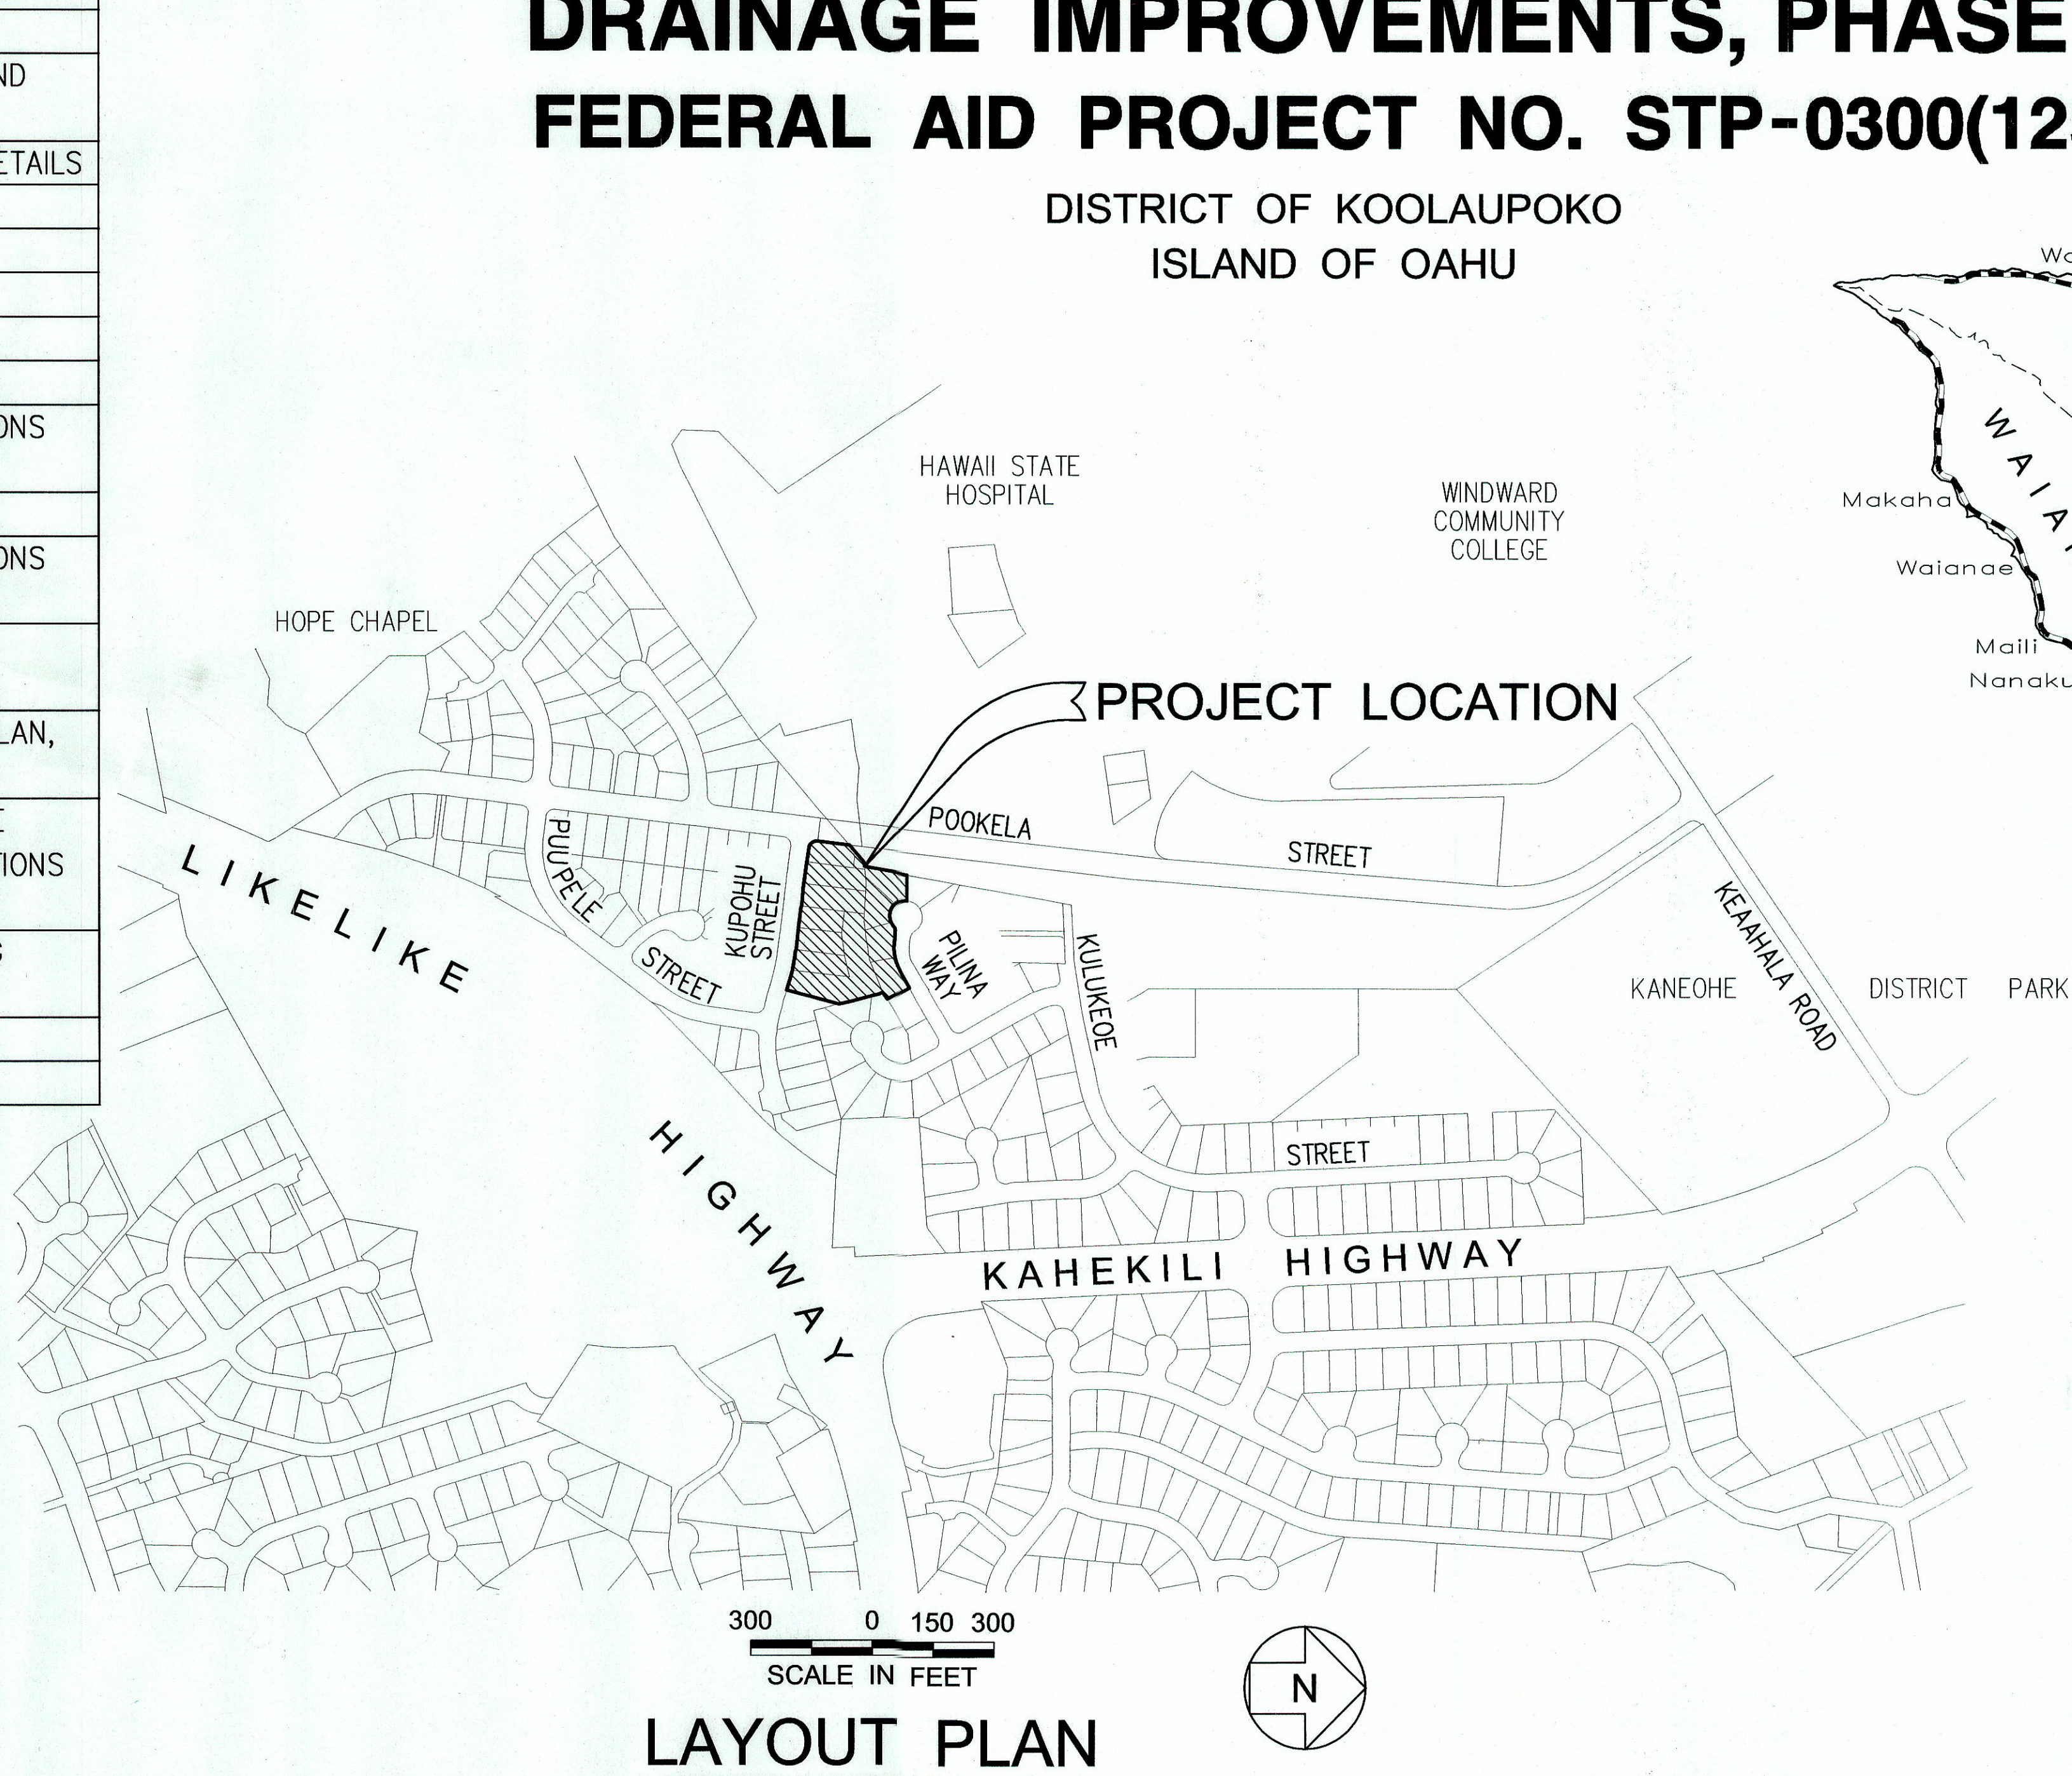

FED. ROAD DIST. NO.	STATE	FED. AID PROJ. NO.	FISCAL YEAR	SHEET NO.	TOTAL SHEETS
HAWAII	HAW.	STP-0300(125)	2011	1	55

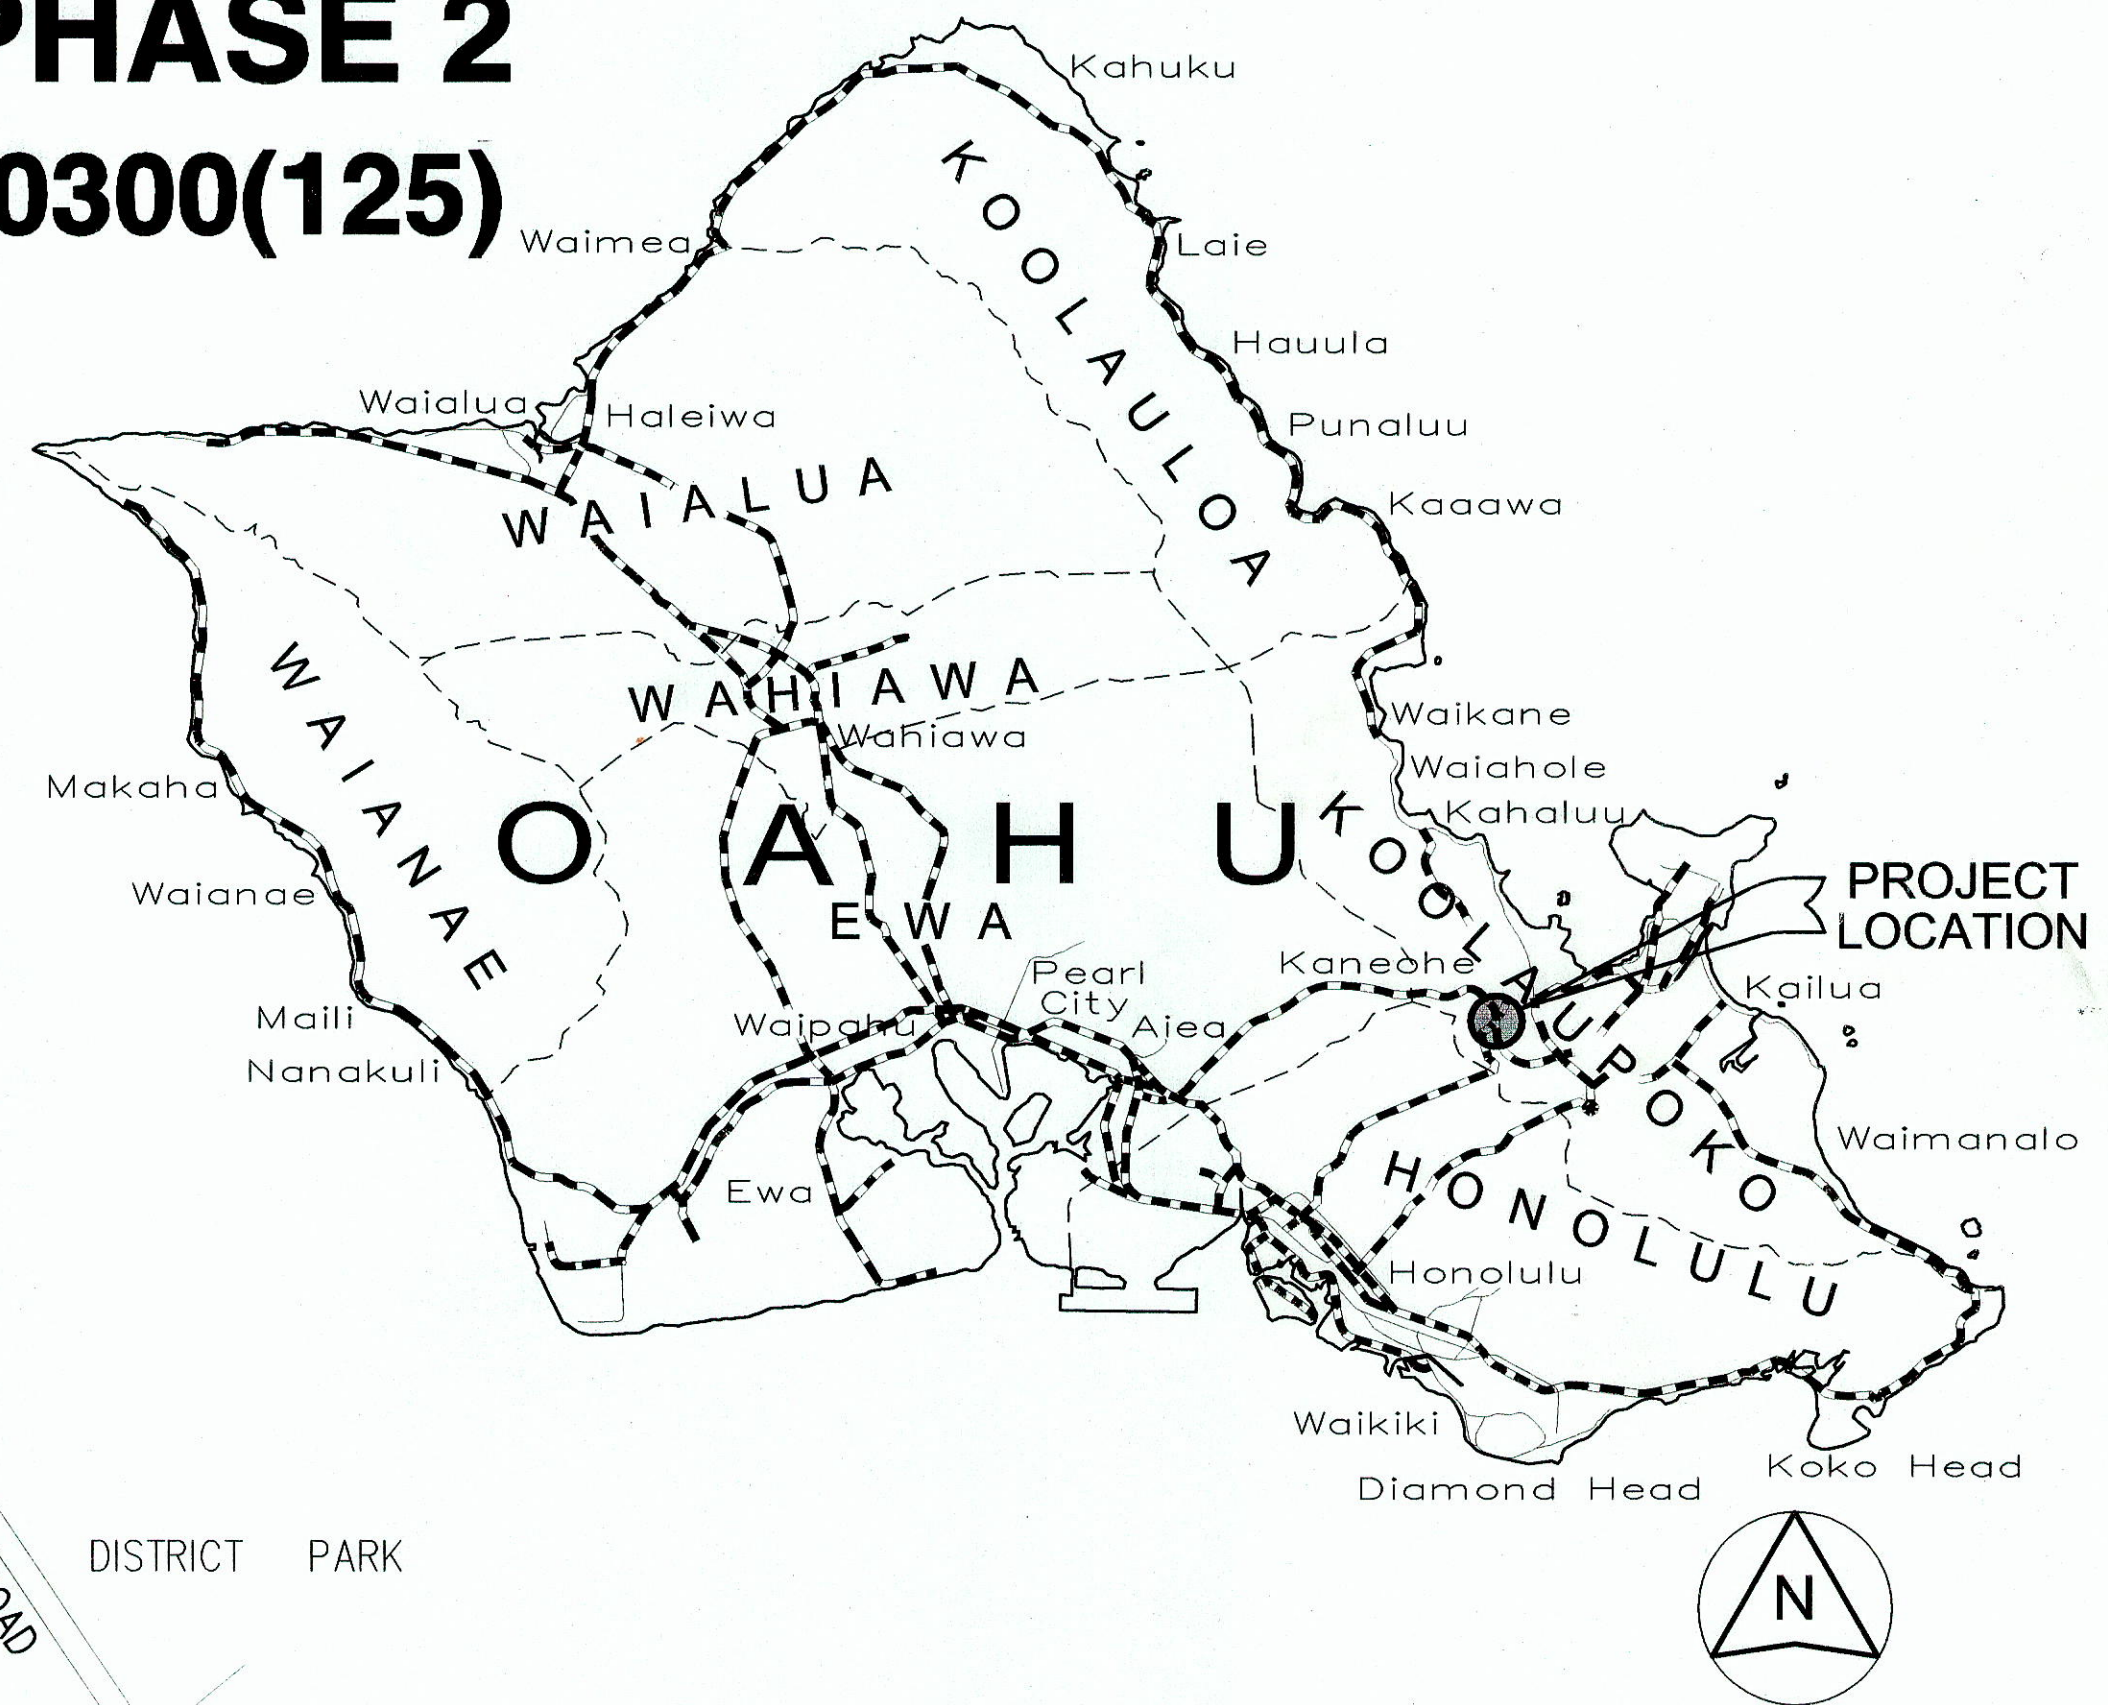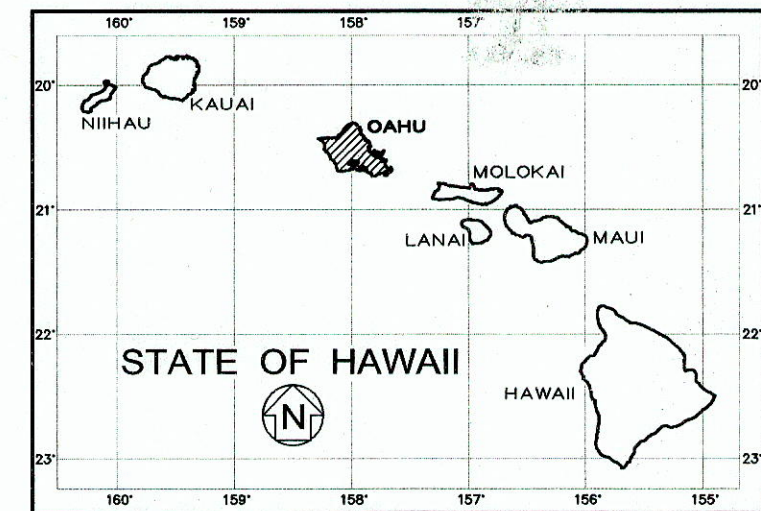

--- FEDERAL AID INTERSTATE PROJECTS PREVIOUSLY
CONSTRUCTED OR UNDER CONSTRUCTION

CHANGES MADE DURING CONSTRUCTION HAVE BEEN
INCORPORATED ON THESE PLANS EXCEPT CHANGES
IN THE ORIGINAL THEORETICAL QUANTITIES. FOR
ACTUAL QUANTITIES, REFER TO PROJECT LEDGER
AND/OR COMPUTATION BOOK.

Matthew Mont 4/12/18
RESIDENT ENGINEER DATE

DEPARTMENT OF TRANSPORTATION
STATE OF HAWAII
APPROVED:
David A. J. J. J. 12/21/11
DIR. OF TRANSPORTATION DATE