


FED. ROAD DIST. NO.	STATE	FED. AID PROJECT NO.	FISCAL YEAR	SHEET NO.	TOTAL SHEETS
HAWAII	HAW.	STP-0300(125)	2011	C.O. ADD. 39	55

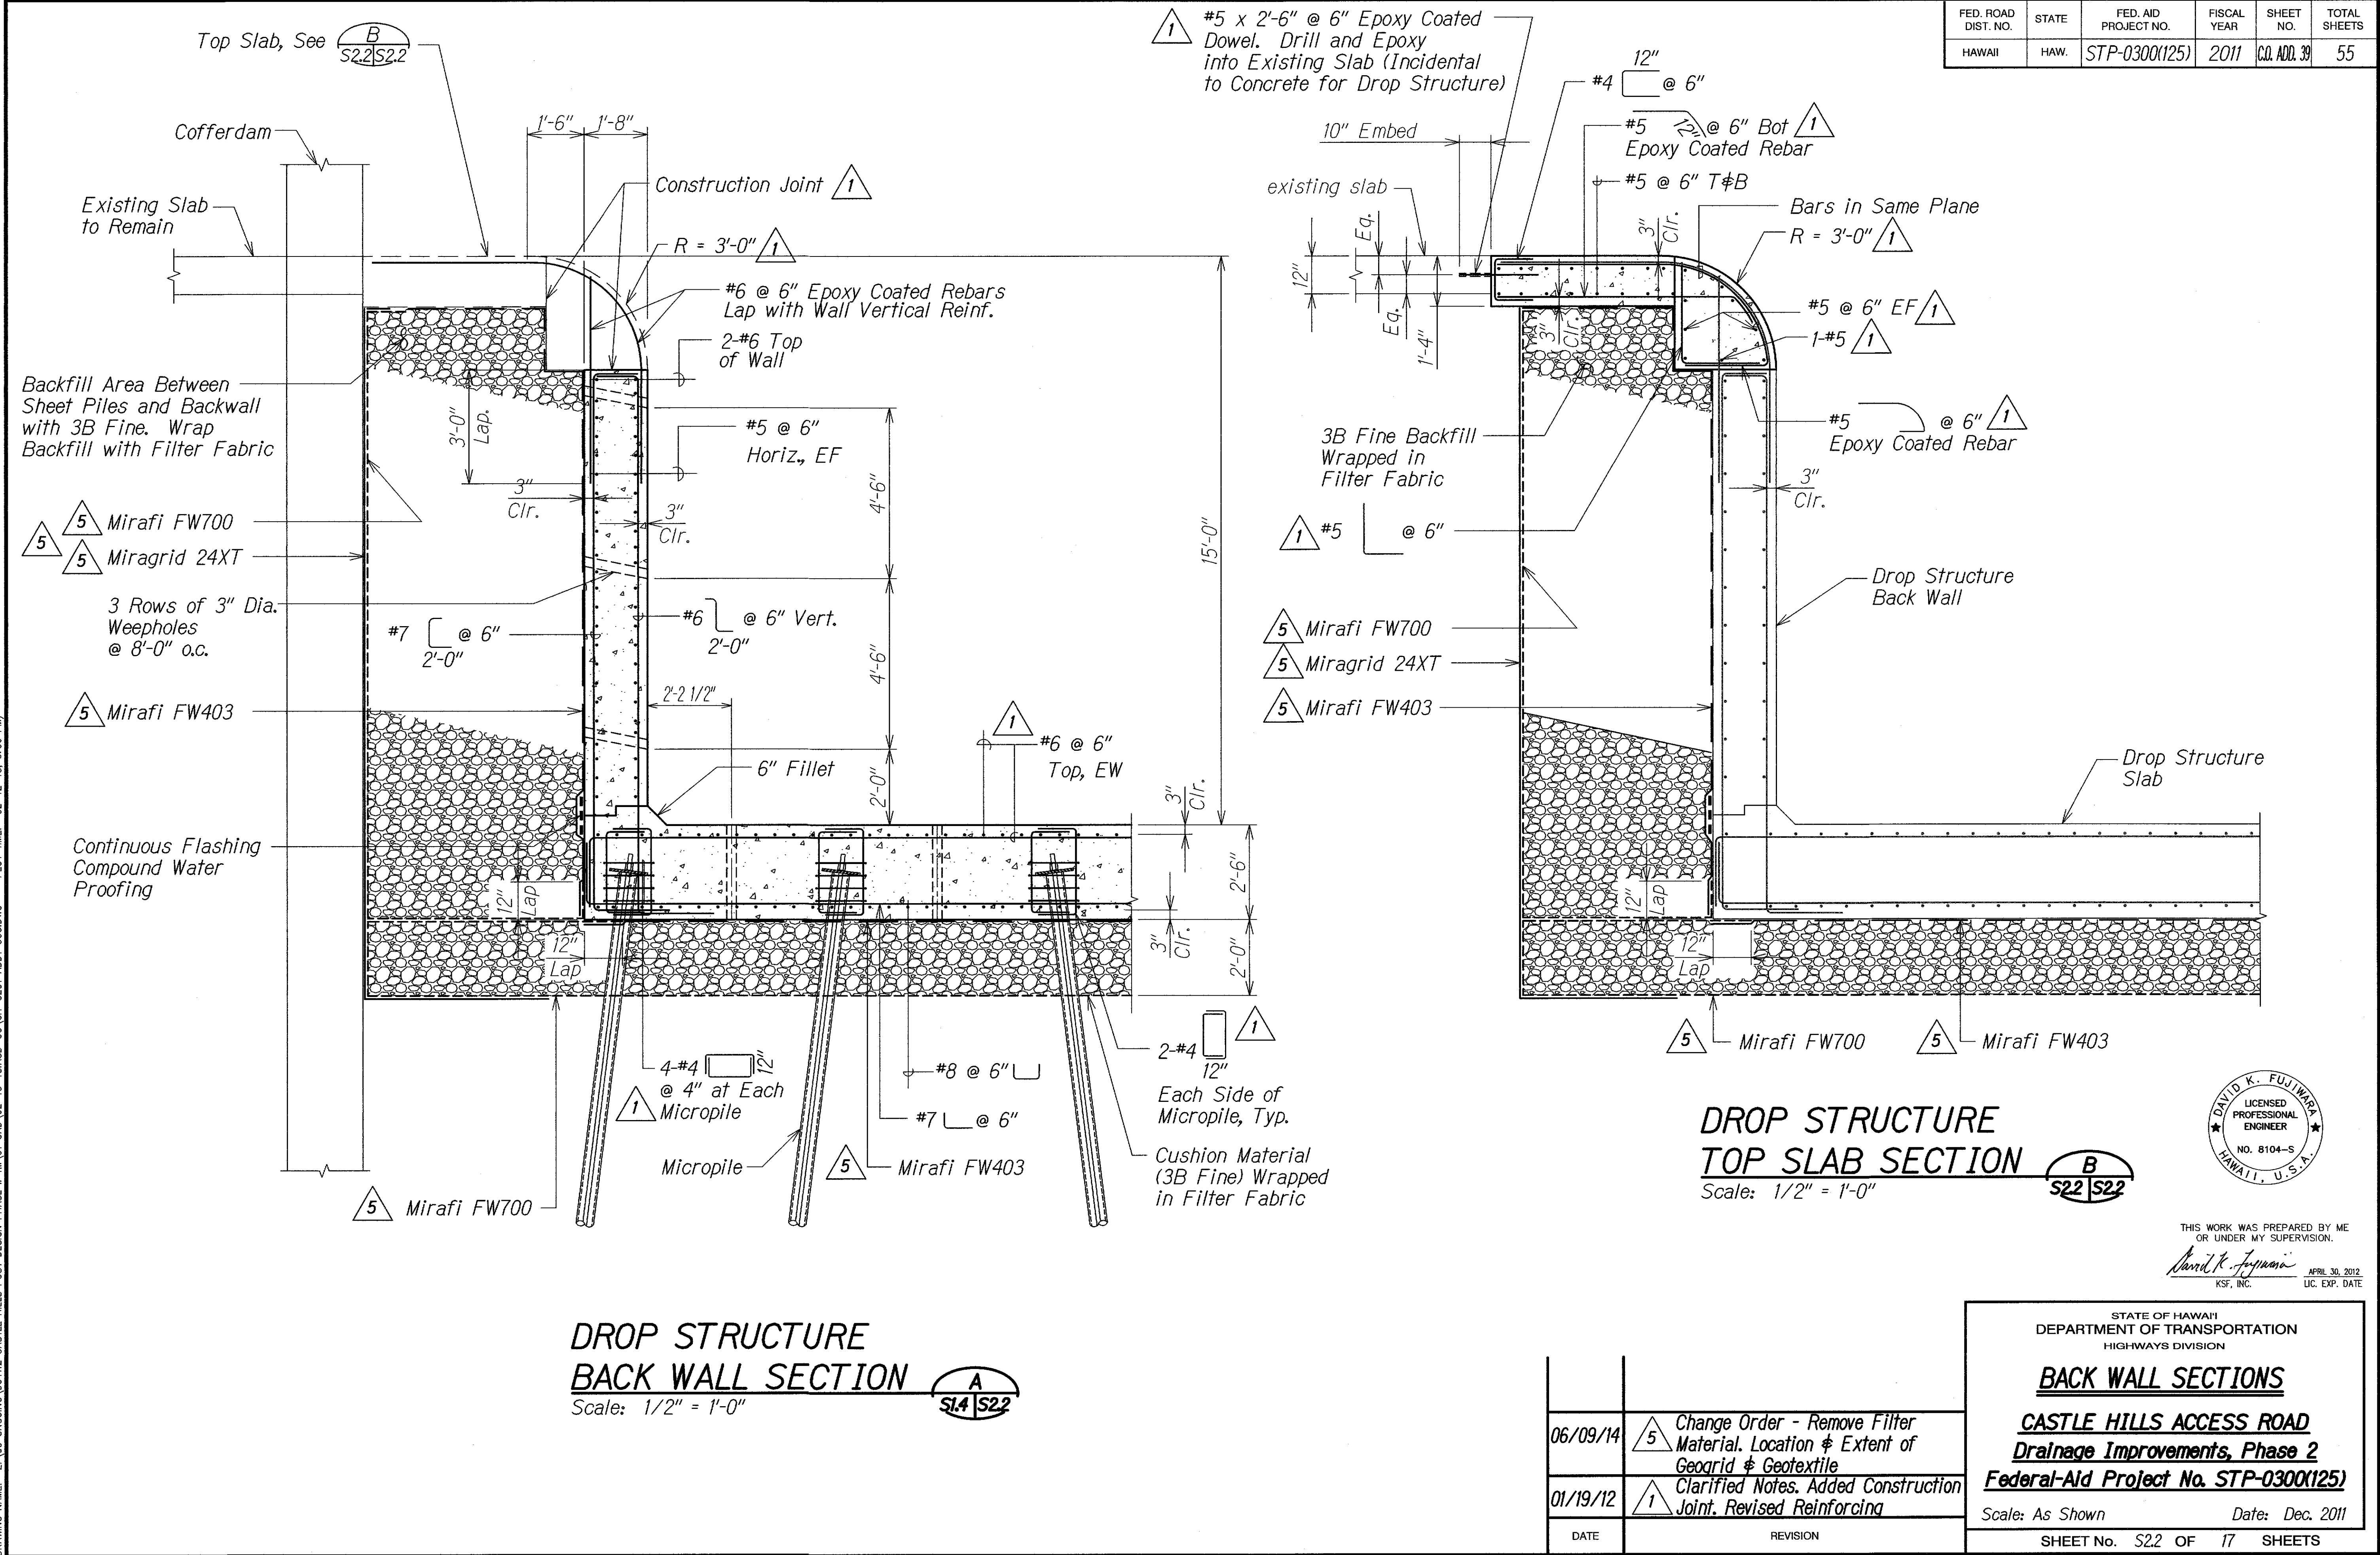

SURVEY PLOTTED BY	DATE
DESIGNED BY	
TRACED BY	
QUANTITIES BY	
CHECKED BY	
ORIGINAL PLAN	
NOTE BOOK	
No.	

DRAWING NAME: Z:\00 ONGOING\9041.2 CASTLE HILLS POST DESIGN PHASE II\TWO\1 CAD\02-13-18.ASB-CO\CH-S22\A001.C05.DWG PLOT TIME: 02-12-18, 5:06 PM