WATER POLLUTION AND EROSION CONTROL NOTES: &

A. GENERAL:

- See Special Provision Section 209 Water Pollution and Erosion Control. Section 209 describes but is not limited to: submittal requirements; scheduling of a water pollution and erosion control conference with the Engineer; construction requirements; method of measurement; and basis of payment. In addition, Appendix A lists potential pollutant sources and corresponding BMPs used to mitigate the pollutants.
- 2. Follow the guidelines in the current HDOT Construction Best Management Practices Field Manual in developing, installing and maintaining the Best Management Practices (BMP) for the project. For any conflicting requirements between the Manual and applicable bid documents, the applicable bid documents will govern. Should a requirement not be clearly described within the applicable bid documents, the Contractor shall notify the Engineer immediately for interpretation. For the purposes of clarification under Note A.2, "applicable bid documents" include the construction plans, standard specifications, Special Provisions, Permits, and the Storm Water Pollution Prevention Plan (SWPPP) when applicable.
- 3. Follow the quidelines in the Honolulu's City & County "Rules Relating to Soil Erosion" Standards and Guidelines" along with applicable Soil Erosion Guidelines for projects on Maui, Molokai, Kauai, and Hawaii.
- 4. The Engineer may assess liquidated damages of up to \$27,500 for non-compliance of each BMP requirement and each requirement stated in Section 209 and special provisions, for every day of non-compliance. There is no maximum limit on the amount assessed per
- 5. The Engineer will deduct the cost from the progress payment for all citations received by the Department for non-compliance, or the Contractor shall reimburse the State for the full amount of the outstanding cost incurred by the State.
- 6. If necessary, install a rain gage prior to any field work including the installation of any site-specific best management practices. The rain gage shall have a tolerance of at least 0.05 inches of rainfall. Install the rain gage on the project site in an area that will not deter rainfall from entering the gage opening. Do not install in a location where rain water may splash into rain gage. The rain gage installation shall be stable and plumbed. Do not begin field work until the rain gage is installed and site-specific best management practices are in-place.
- 7. Submit Site-Specific BMP Plan to the Engineer along with a completed Site-Specific BMP Review Checklist within 30 calendar days of contract execution. The Site-Specific BMP Review Checklist may be obtained from http://www.stormwaterhawaii.com.
- B. WASTE DISPOSAL:

Waste Materials

Collect and store all waste materials in a securely lidded metal dumpster or roll off container with cover to keep rain out or loss of waste during windy conditions. The dumpster shall meet all local and State solid waste management regulations. Deposit all trash and construction debris from the site in the dumpster. Empty the dumpster weekly or when the container is two-thirds full, whichever is sooner. Do not bury construction waste materials onsite. The Contractor's supervisory personnel shall be instructed regarding the correct procedure for waste disposal. Post notices stating these practices in the office trailer, on a weatherproof bulletin board, or other accessible location acceptable to the Engineer. The Contractor shall be responsible for seeing that these procedures are followed. Submit the Solid Waste Disclosure Form for Construction Sites to the Engineer within 30 calendar days of contract execution. Provide a copy of all the disposal receipts from the facility permitted by the Department of Health to receive solid waste to the Engineer monthly. This should also include documentation from any intermediary facility where solid waste is handled or processed.

2. Hazardous Waste

Dispose all hazardous waste materials in the manner specified by local or State regulations and by the manufacturer. The Contractor's site personnel shall be instructed in these practices and shall be responsible for seeing that these practices are followed.

3. Sanitary Waste

Collect all sanitary waste from the portable units a minimum of once per week, or as required. Position sanitary facilities where they are secure and will not be tipped over or knocked down.

C. EROSION AND SEDIMENT CONTROL INSPECTION AND MAINTENANCE PRACTICES:

- 1. For projects with an NPDES Permit for Construction Activities, inspect at the following intervals. For construction areas discharging to nutrient or sediment impaired waters, inspect all control measures at least once each week and within 24 hours of any rainfall event of 0.25 inches or greater within a 24 hour period. For construction areas discharging to waters not impaired for nutrient or sediments, inspect all control measures weekly. Inspections are only required during the project's normal working hours. The discharge point water classification may be found in the SWPPP.
- 2. For projects without an NPDES Permit for Construction Activities, inspect all control measures weekly.
- Maintain all erosion and sediment control measures in good working order. If repair is necessary, initiate repair immediately and complete by the close of the next work day if the problem does not require significant repair or replacement, or if the problem can be corrected through routine maintenance. When installation of a new erosion or sediment control or a significant repair is needed, install the new or modified control or complete the repair no later than 7 calendar days from the time of discovery. "Immediately" means the Contractor shall take all reasonable measures to minimize or prevent discharge of pollutants until a permanent solution is installed and made operational. If a problem is identified at a time in the day in which it is too late to initiate repair, initiation of repair shall begin on the following work day.
- Remove built-up sediment from silt fence when it has reached one-third the height of the fence. Remove sediment from other perimeter sediment control devices when it has reached one-half the height of the device.
- 5. Inspect silt screen or fence for depth of sediment, tears, to verify that the fabric is securely attached to the fence posts or concrete slab and to verify that the fence posts are firmly in the ground. Inspect and verify the bottom of the silt screen is buried a minimum of 6 inches below the existing ground.
- 6. Inspect temporary and permanent seeding and planting for bare spots, washouts and healthy growth.
- 7. Complete and submit to the Engineer a maintenance inspection report within 24 hours after each inspection.
- 8. Provide a stabilized construction entrance at all points of exit onto paved roads to reduce vehicle tracking of sediments. Include stabilized construction entrance in the Water Pollution, Dust, and Erosion Control submittals. Minimum length should be 50 feet. Minimum width should be 30 feet. Minimum depth should be 12 inches or as recommended by the soils engineer and underlain with geo-textile fabric. If minimum dimensions cannot be met, provide other stabilization techniques that remove sediment prior to exit. Clean the paved street adjacent to the site entrance daily or as required to remove any excess mud, cold-planed materials, dirt or rock tracked from the site. Do not hose down the street without containing or vacuuming wash water. Cover dump trucks hauling material from the construction site with a tarpaulin. Remove sediment tracked onto the street, sidewalk, or other paved area by the end of the day in which the track-out occurs.

- FISCAL SHEET TOTAL YEAR NO. SHEETS FED. ROAD DIST. NO. HAW. | HWY-0-02-08 | 2014 | ADD.3 | 57
- 9. Include designated Concrete Washout Area(s) in the Water Pollution, Dust, and Erosion Control submittals.
- 10. Submit the name of a specific individual designated responsible for inspections, maintenance and repair activities and filling out the inspection and maintenance report.
- 11. Personnel selected for the inspection and maintenance responsibilities shall receive training from the Contractor. They shall be trained in all the inspection and maintenance practices necessary for keeping the erosion and sediment controls used onsite in good working order.
- 12. Contain, remove, and dispose slurry generated from saw cutting of pavement in accordance with approved BMP practices. Do not allow discharge into the drainage system or State waters.
- D. GOOD HOUSEKEEPING BEST MANAGEMENT PRACTICES:

1. Materials Pollution Prevention Plan

Adhesives

a. Applicable materials or substances listed below are expected to be present onsite during construction. Other materials and substances not listed below shall be added to the inventory.

Detergents Concrete Metal Studs Paints (enamel and latex) Fertilizers Cleaning Solvents Petroleum Based Products Masonry Block Curing Compounds Herbicides and Pesticides

> REGISTERED PROFESSIONAL ARCHITECT

Reullen

6/5/2014 A Revised Notes REVISION STATE OF HAWAII DEPARTMENT OF TRANSPORTATION WATER POLLUTION AND EROSION CONTROL NOTES MOTOR VEHICLE SAFETY OFFICE RENOVATION Project No. HWY-0-02-08 APPRATION DATE OF THE LICENSE 4/30/2016
THIS WORK WAS PREPARED BY
ME OR UNDER MY SUPERVISION Scale: As Noted Date: APRIL, 2014

SHEET No. G1.2 OF 61 SHEETS

WATER POLLUTION AND EROSION CONTROL NOTES: CONT. A

- b. Use Material Management Practices to reduce the risk of spills or other accidental exposure of materials and substances to storm water runoff. Make an effort to store only enough product as is required to do the job.
- c. Store all materials stored onsite in a neat, orderly manner in their appropriate containers and if possible under a roof or other enclosure.
- d. Keep products in their original containers with the original manufacturer's label.
- e. Do not mix substances with one another unless recommended by the manufacturer.
- f. Whenever possible, use a product up completely before disposing of the container.
- g. Follow manufacturer's recommendations for proper use and disposal.
- h. Conduct a daily inspection to ensure proper use and disposal of materials onsite.
- 2. Hazardous Material Pollution Prevention Plan
 - a. Keep products in original containers unless they are not resealable.
 - b. Retain original labels and Safety Data Sheets (SDS) formerly Material Safety Data Sheets (MSDS).
 - c. Dispose of surplus products according to manufacturers' instructions and local and State regulations.
- 3. Onsite and Offsite Product Specific Plan The following product specific practices shall be followed onsite:
 - a. Petroleum Based Products:

Monitor all onsite vehicles for leaks and perform regular preventive maintenance to reduce the chance of leakage. Store petroleum products in tightly sealed containers which are clearly labeled. Apply asphalt substances used onsite according to the manufacturer's recommendation.

b. Fertilizers:

Apply fertilizers used only in the minimum amounts recommended by the manufacturer and federal, state, and local requirements. Avoid applying just before a heavy rain event. Apply at the appropriate time of year for the location, and preferably timed to coincide as closely as possible to the period of maximum vegetation uptake and growth. Once applied, work fertilizer into the soil to limit exposure to storm water. Do not apply to storm conveyance channels with flowing water. Storage shall be in a covered shed or in an area where fertilizer will not come into contact with precipitation or stormwater. Transfer the contents of any partially used bags of fertilizer to a sealable plastic bin to avoid spills.

c. Paints:

Seal and store all containers when not required for use. Do not discharge excess paint to the drainage system, sanitary sewer system, or State waters. Dispose properly according to manufacturers' instructions and State and local regulations.

d. Concrete Trucks:

Washout or discharge concrete truck drum wash water only at a designated site as far as practicable from storm drain inlets or State waters. Do not discharge water in the drainage system or State waters. Disposal by percolation is prohibited. Clean disposal site as required or as requested by the Engineer.

- 4. Spill Control Plan
- a. Post a spill prevention plan to include measures to prevent and clean up each

- b. The Contractor shall be the spill prevention and cleanup coordinator. Designate at least three site personnel who shall receive spill prevention and cleanup training. These individuals shall each become responsible for a particular phase of prevention and cleanup. Post the names of responsible spill personnel in the material storage area on a weatherproof bulletin board or other accessible location acceptable to the Engineer and in the office trailer onsite.
- c. Clearly post manufacturers' recommended methods for spill cleanup. Make site personnel aware of the procedures and the location of the information and cleanup
- d. Keep ample materials and equipment necessary for spill cleanup in the material storage area onsite.
- e. Clean up all spills immediately after discovery.
- f. Keep the spill area well ventilated. Personnel shall wear appropriate protective clothing to prevent injury from contact with a hazardous substance.
- g. Report spills of toxic hazardous material to the appropriate State or local government agency, regardless of the size. Where a leak, spill, or other release containing a hazardous substance or oil in an amount equal to or in excess of a reportable quantity established under either 40 CFR Part 110, 40 CFR Part 117, or 40 CFR Part 302 occurs during a 24-hour period, the Contractor shall notify the Engineer as soon as the Contractor has knowledge of the discharge. The Engineer will notify the National Response Center (NRC) at (800) 424-8802, the Clean Water Branch during regular business hours at 586-4309, and the Hawaii State Hospital Operator at 247-2191 and the Clean Water Branch (DOH-CWB) via email at cleanwaterbranch@doh.hawaii.gov during non-business hours immediately. The Contractor shall also provide to the Engineer, within 7 calendar days of knowledge of the release, a description of the release, the circumstances leading to the release, and the date of the release. The Engineer will provide this information to the DOH-CWB. The Engineer will provide information to the NRC if requested.

E. PERMIT REQUIREMENTS:

- 1. The calculated land disturbance area for this project based on the construction plans is 0.25 acres not including Contractor Staging and Storage areas. If the total of the disturbed area and the Contractor Staging and Storage area is one acre or greater, the Contractor shall obtain the NPDES Construction Activities Permit using HDOT's latest SWPPP template. See Hawaii Administrative Rules Chapter 11-55, Appendix C for the definition of land disturbance. The Contractor shall be responsible for obtaining the required NPDES Construction Activities Permit and complying with the requirements of HAR 11-55 including but not limited to:
 - a. Deadlines for initiating and completing initial stabilization
 - b. Increased inspection frequency and installation of rain gage if applicable
 - c. Deadlines to initiate and complete repairs to BMPs
- d. Reporting requirements and corrective action reports

F. SITE-SPECIFIC BMP REQUIREMENTS

Each BMP below is referenced to the corresponding section of the current HDOT Construction Best Management Practices Field Manual and appropriate Supplemental Sheets. The Manual may be obtained from the HDOT Statewide Stormwater Management Program Website at http://www.stormwaterhawaii.com/resources under Construction Best Management Practices Field Manual. Supplemental BMP sheets are located at http://stormwaterhawaii.com/contractors/contractors_BMPmanual.aspx under Concrete Curing and Irrigation Water.

FED. ROAD DIST. NO.

FISCAL YEAR

HAW. | HWY-0-02-08 | 2014 | ADD.4 | 57


PROJ. NO.

The requirements for Water Pollution, Dust, and Erosion Control submittals are included in Section 209 of the Hawaii Standard Specifications for Road and Bridge Construction dated 2005 and applicable Special Provisions. A list of pollutant sources and corresponding BMP used to mitigate the pollutants are included in Section 209 of the Special Provisions under Appendix A.

Follow the requirements below:

- 1. Protect all Drainage Inlets receiving runoff from disturbed areas (SC-2).
- 2. Contain on-site runoff using Perimeter Sediment Controls
 - a. SC-1 Silt Fence
- b. SC-5 Vegetated Filter Strips and Buffers
- c. SC-8 Compost Filter Berm
- d. SC-13 Sandbag Barrier
- e. SC-14 Brush or Rock Filter
- 3. Control offsite runoff from entering construction area
- a. EC-8 Run-On Diversion
- b. SC-6 Earth Dike
- c. SC-7 Temporary Drains and Swales
- 4. Incorporate applicable Site Management BMP
 - a. SM-1 Employee Training
- b. SM-2 Material Delivery and Storage
- c. SM-3 Material Use
- d. SM-4 Protection of Stockpiles
- e. SM-6 Solid Waste Management
- f. SM-7 Sanitary/Septic Waste Management
- g. SM-9 Hazardous Waste Management h. SM-10 Spill Prevention and Control
- i. SM-11 Vehicle and Equipment Cleaning
- j. SM-12 Vehicle and Equipment Maintenance
- k. SM-13 Vehicle and Equipment Refueling
- I. SM-14 Scheduling
- m. SM-15 Location of Potential Sources of Sediment
- n. SM-16 Preservation of Existing Vegetation
- o. SM-18 Dust Control



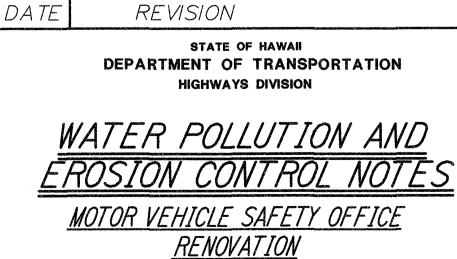

A Revised Notes

hullun PIRATION DATE OF THE LICENSE 4/30/2016 THIS WORK WAS PREPARED BY ME OR UNDER MY SUPERVISION

Project No. HWY-0-02-08 Date: APRIL, 2014 Scale: As Noted SHEET No. G1.3 OF 61 SHEETS

WATER POLLUTION AND EROSION CONTROL NOTES: CONT. A

- 5. Contain pollutants within the Construction Staging/Storage Area BMP with applicable Perimeter Sediment Controls and Site Management BMP. Include a Stabilized Construction Entrance/Exit (EC-2) for all areas which exit onto a paved street. Restrict vehicle access to these points.
- 6. Manage Concrete Waste including installing a Concrete Washout Area (SM-5) and properly disposing of Concrete Curing Water (California Stormwater BMP Handbook NS-12 Concrete Curing).
- 7. Remove saw cut slurry and hydrodemolition water from the site by vacuuming.

 Provide storm drain protection and/or perimeter sediment controls during saw cutting and hydrodemolition work.

TEMPORARY UTILITY INSTALLATION & REQUIREMENTS:

- A. General: Engage Appropriate Local Utility Company To Install Temporary Service Or Connect To Existing Service Where Directed By The Engineer. Where Utility Company Provides Only Part Of The Service, Provide The Remainder With Matching, Compatible Materials And Equipment. Comply With Utility Company Recommendations.
 - 1. Arrange With Utility Company, The Department, And Existing Users For Time When Service Can Be Interrupted, If Necessary, To Make Connections For Temporary Services.
 - 2. Provide Adequate Capacity At Each Stage Of Construction. Before Temporary Utility Is Available, Provide Trucked In Services.
- B. Utility Service Costs During Construction: The Contractor Shall Be Responsible For Paying The Costs For Electric, Water, And Sewer Utility Services From The Project's Construction Notice To Proceed Date Through The Project Acceptance Date. In Lieu Of Arranging With The Utility Company, For The Metering Of The Contractor's Usage Of Utility Services, Etc. As Noted In The Following Paragraphs Of This Section, The Contractor May Choose To Pay The State's Electric, Water, And Sewer Utility Bills For The Facility During The Period From Construction Notice To Proceed Date Through The Project Acceptance Date
- C. Water Service: Make Arrangements With The Utility Company For Temporary Use Of Water, And Pay For All Expenses. However, At The Option Of The Contractor, A Temporary Tap Into The Facility's Existing Water System Is Allowed, Subject To The Following Conditions:
 - 1. Comply With The Department Of Health's And County Water Provider's Requirements When Tapping Into The Existing Water System.
 - 2. Meter The Tapped Line And Prior To Water Use. Notify The Engineer To Observe An Initial Meter Reading.
 - 3. Take Monthly Meter Readings. Pay The State, On A Monthly Basis, For Water Used At The Current Rate Per 1,000 Gallons.
 - 4. Payments Are To Be By Check, Made Payable To The "Director Of Finance, State Of Hawaii" And Mailed As Directed By The Engineer.
 - 5. Checks Shall Be Accompanied By The Following Information:
 - i. Name Of Facility, Project Name And Title And Job No.

 - iii. Initial Meter Reading For The Month And Final Meter Reading For The Month.
 - iv. Volume Of Water Used And The Amount Due In Payment For That Water.
 - 6. Upon Completion Of The Project And Just Prior To Removal Of The Water Meter, Notify The Engineer To Observe A Final Meter Reading.
 - 7. Should The Contractor At Any Time Fail To Comply With Any Or All Of The Above Conditions, The Department May Terminate The Use Of Water. The Contractor Shall Remove The Hookup Within 48 Hours Of Notification Of Such Termination.
- D. Electric Power Service: Provide Weatherproof, Grounded Electric Power Service And Distribution System Of Sufficient Size, Capacity, And Power Characteristics During Construction Period. Include Meters, Transformers, Overload Protected Disconnecting Means, Automatic Ground Fault Interrupters, And Main Distribution Switchgear. Make Arrangements With Utility Companies For Temporary Use Of Electricity For Construction Use. Pay For All Expenses Pertaining Thereto.
- E. Electric Distribution: Provide Receptacle Outlets Adequate For Connection Of Power Tools And Equipment. Protect Wiring, In Conduits Or Other, Measures When Exposed To Possible Damage Or Traffic Areas.

FED. ROAD DIST. NO.	STATE	PROJ. NO.	FISCAL YEAR	SHEET NO.	TOTAL SHEETS
HAWAII	HAW.	HWY-0-02-08	2014	ADD.4S-1	<i>57</i>



EXPIRATION DATE OF THE LICENSE 4/30/2016
THIS WORK WAS PREPARED BY
ME OR UNDER MY SUPERVISION

6/5/2014 A Revised And Added Notes

DATE REVISION


STATE OF HAWAII
DEPARTMENT OF TRANSPORTATION
HIGHWAYS DIVISION


<u>WATER POLLUTION AND</u> <u>EROSION CONTROL NOTES</u>


<u>MOTOR VEHICLE SAFETY OFFICE</u> <u>RENOVATION</u> <u>Project No. HWY-0-02-08</u>


Scale: As Noted Date: APRIL, 2014


SHEET No. G1.4 OF 61 SHEETS

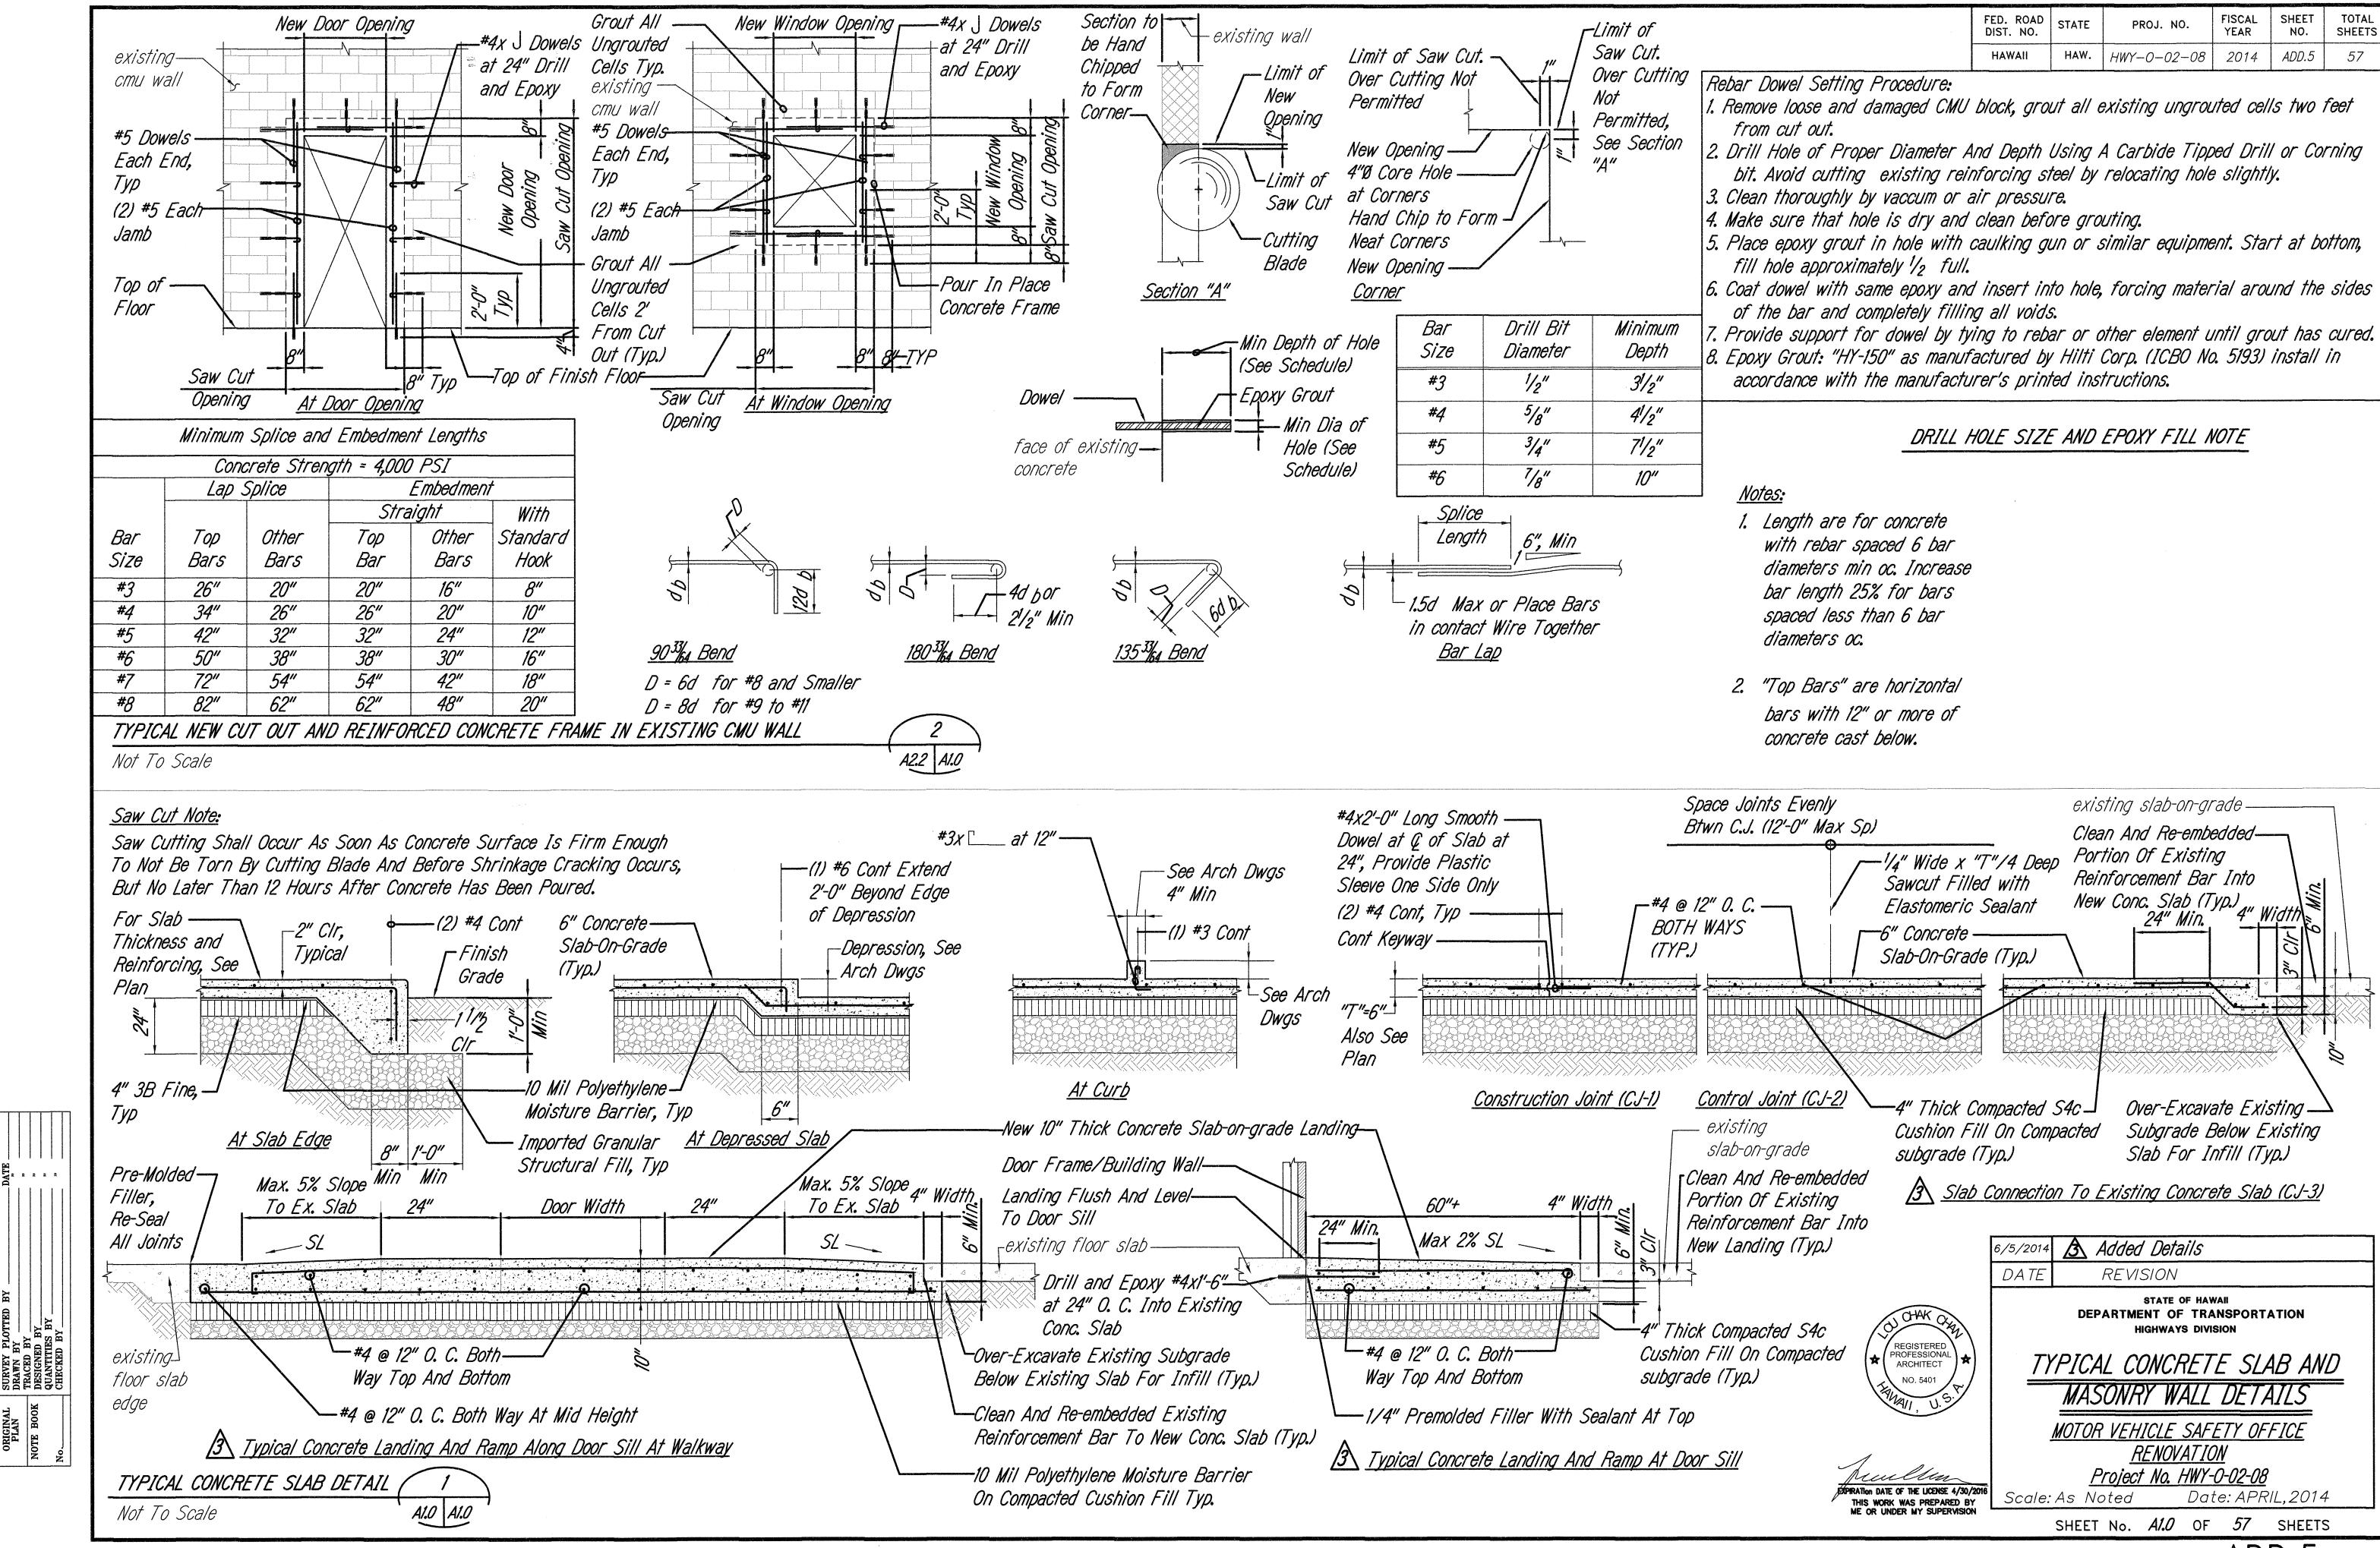


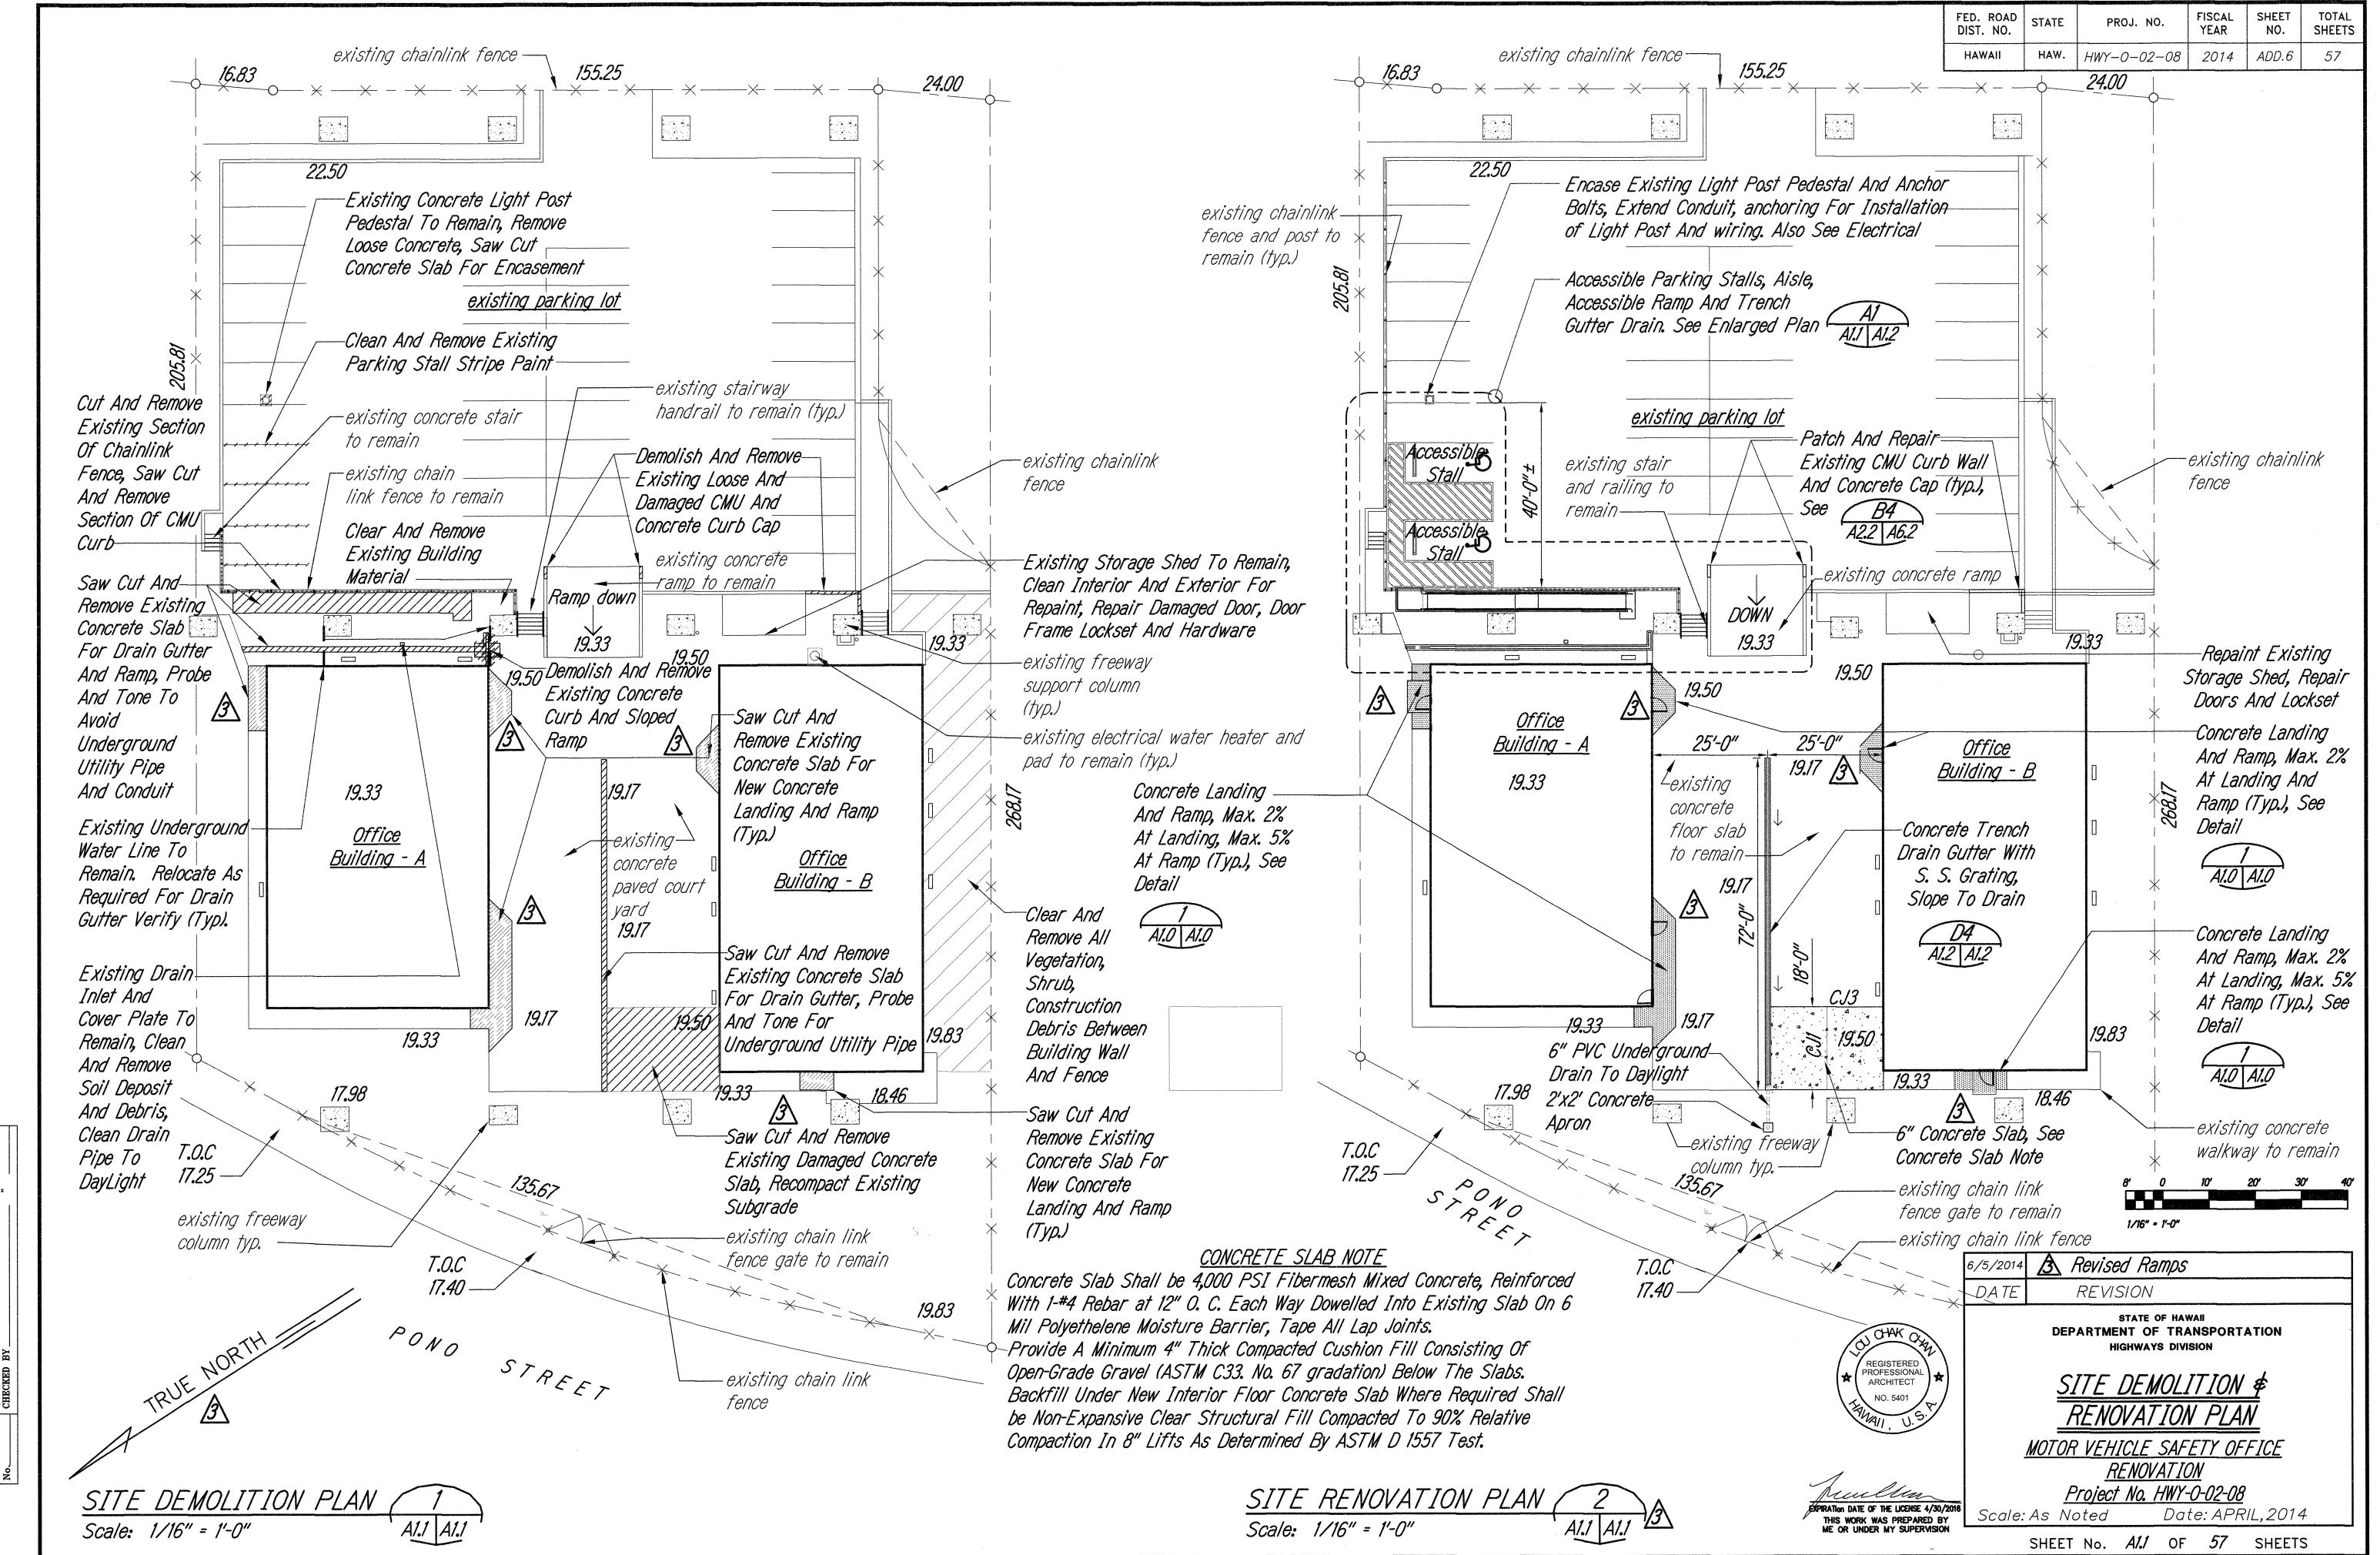


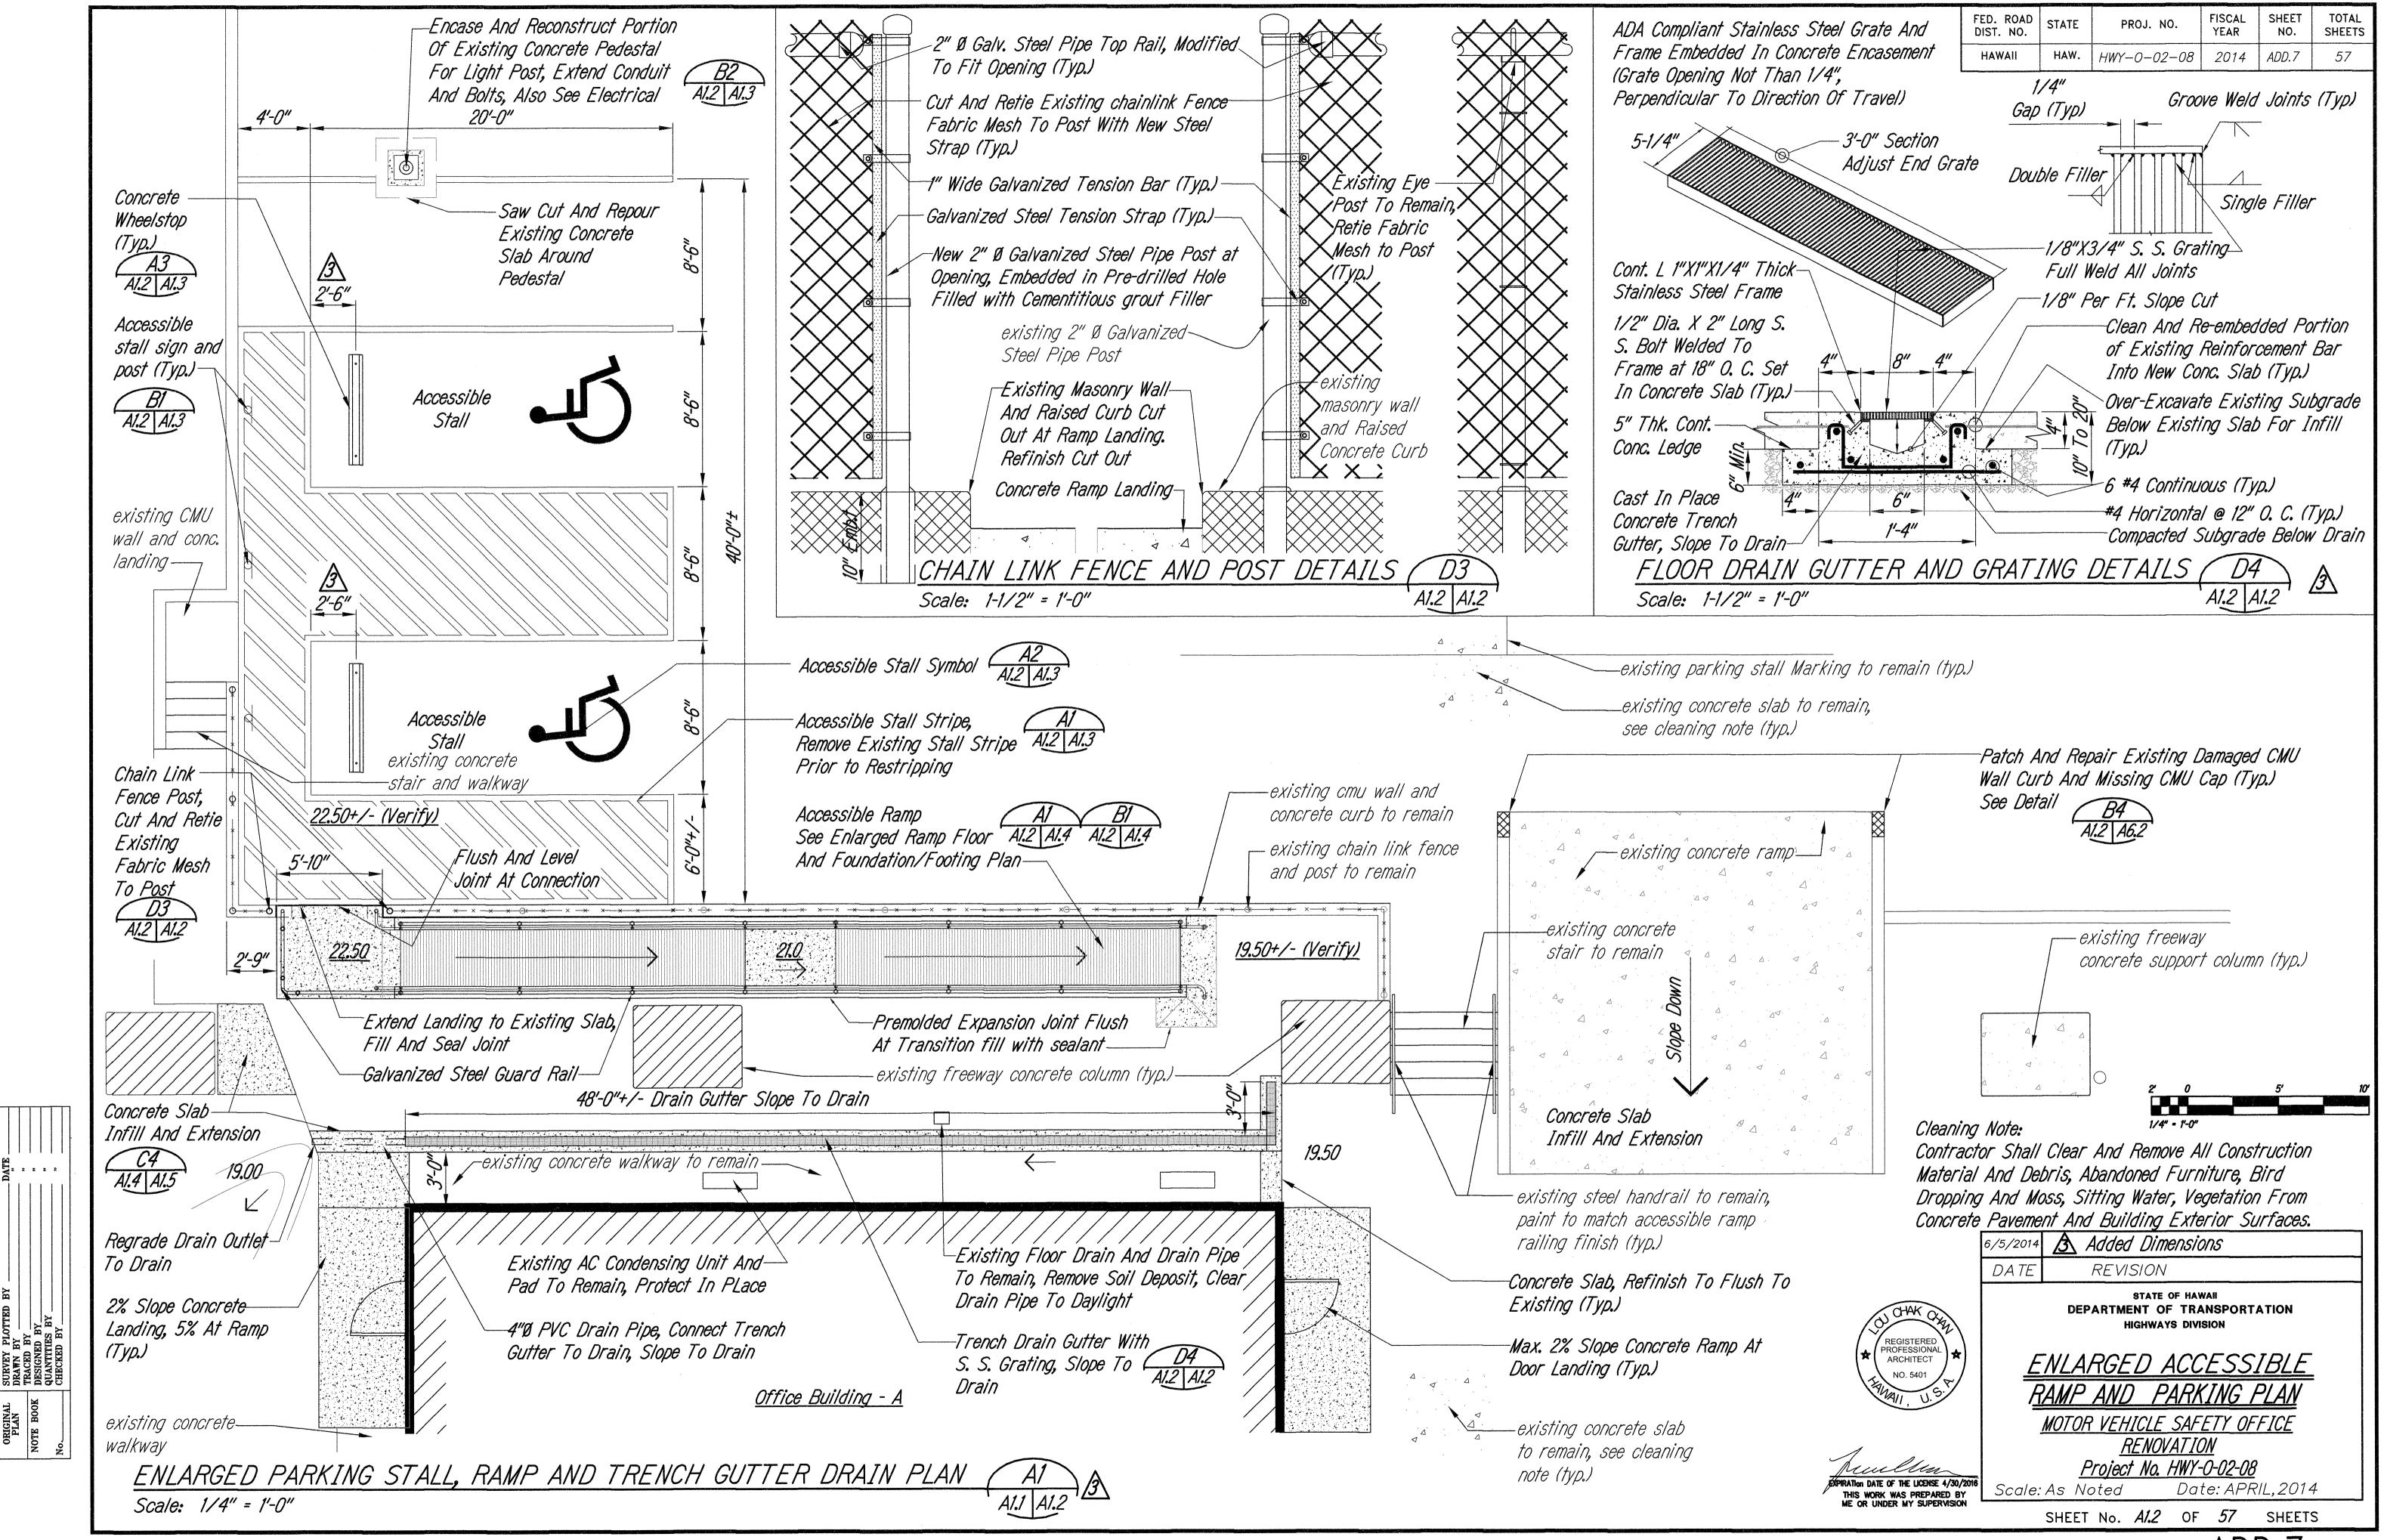


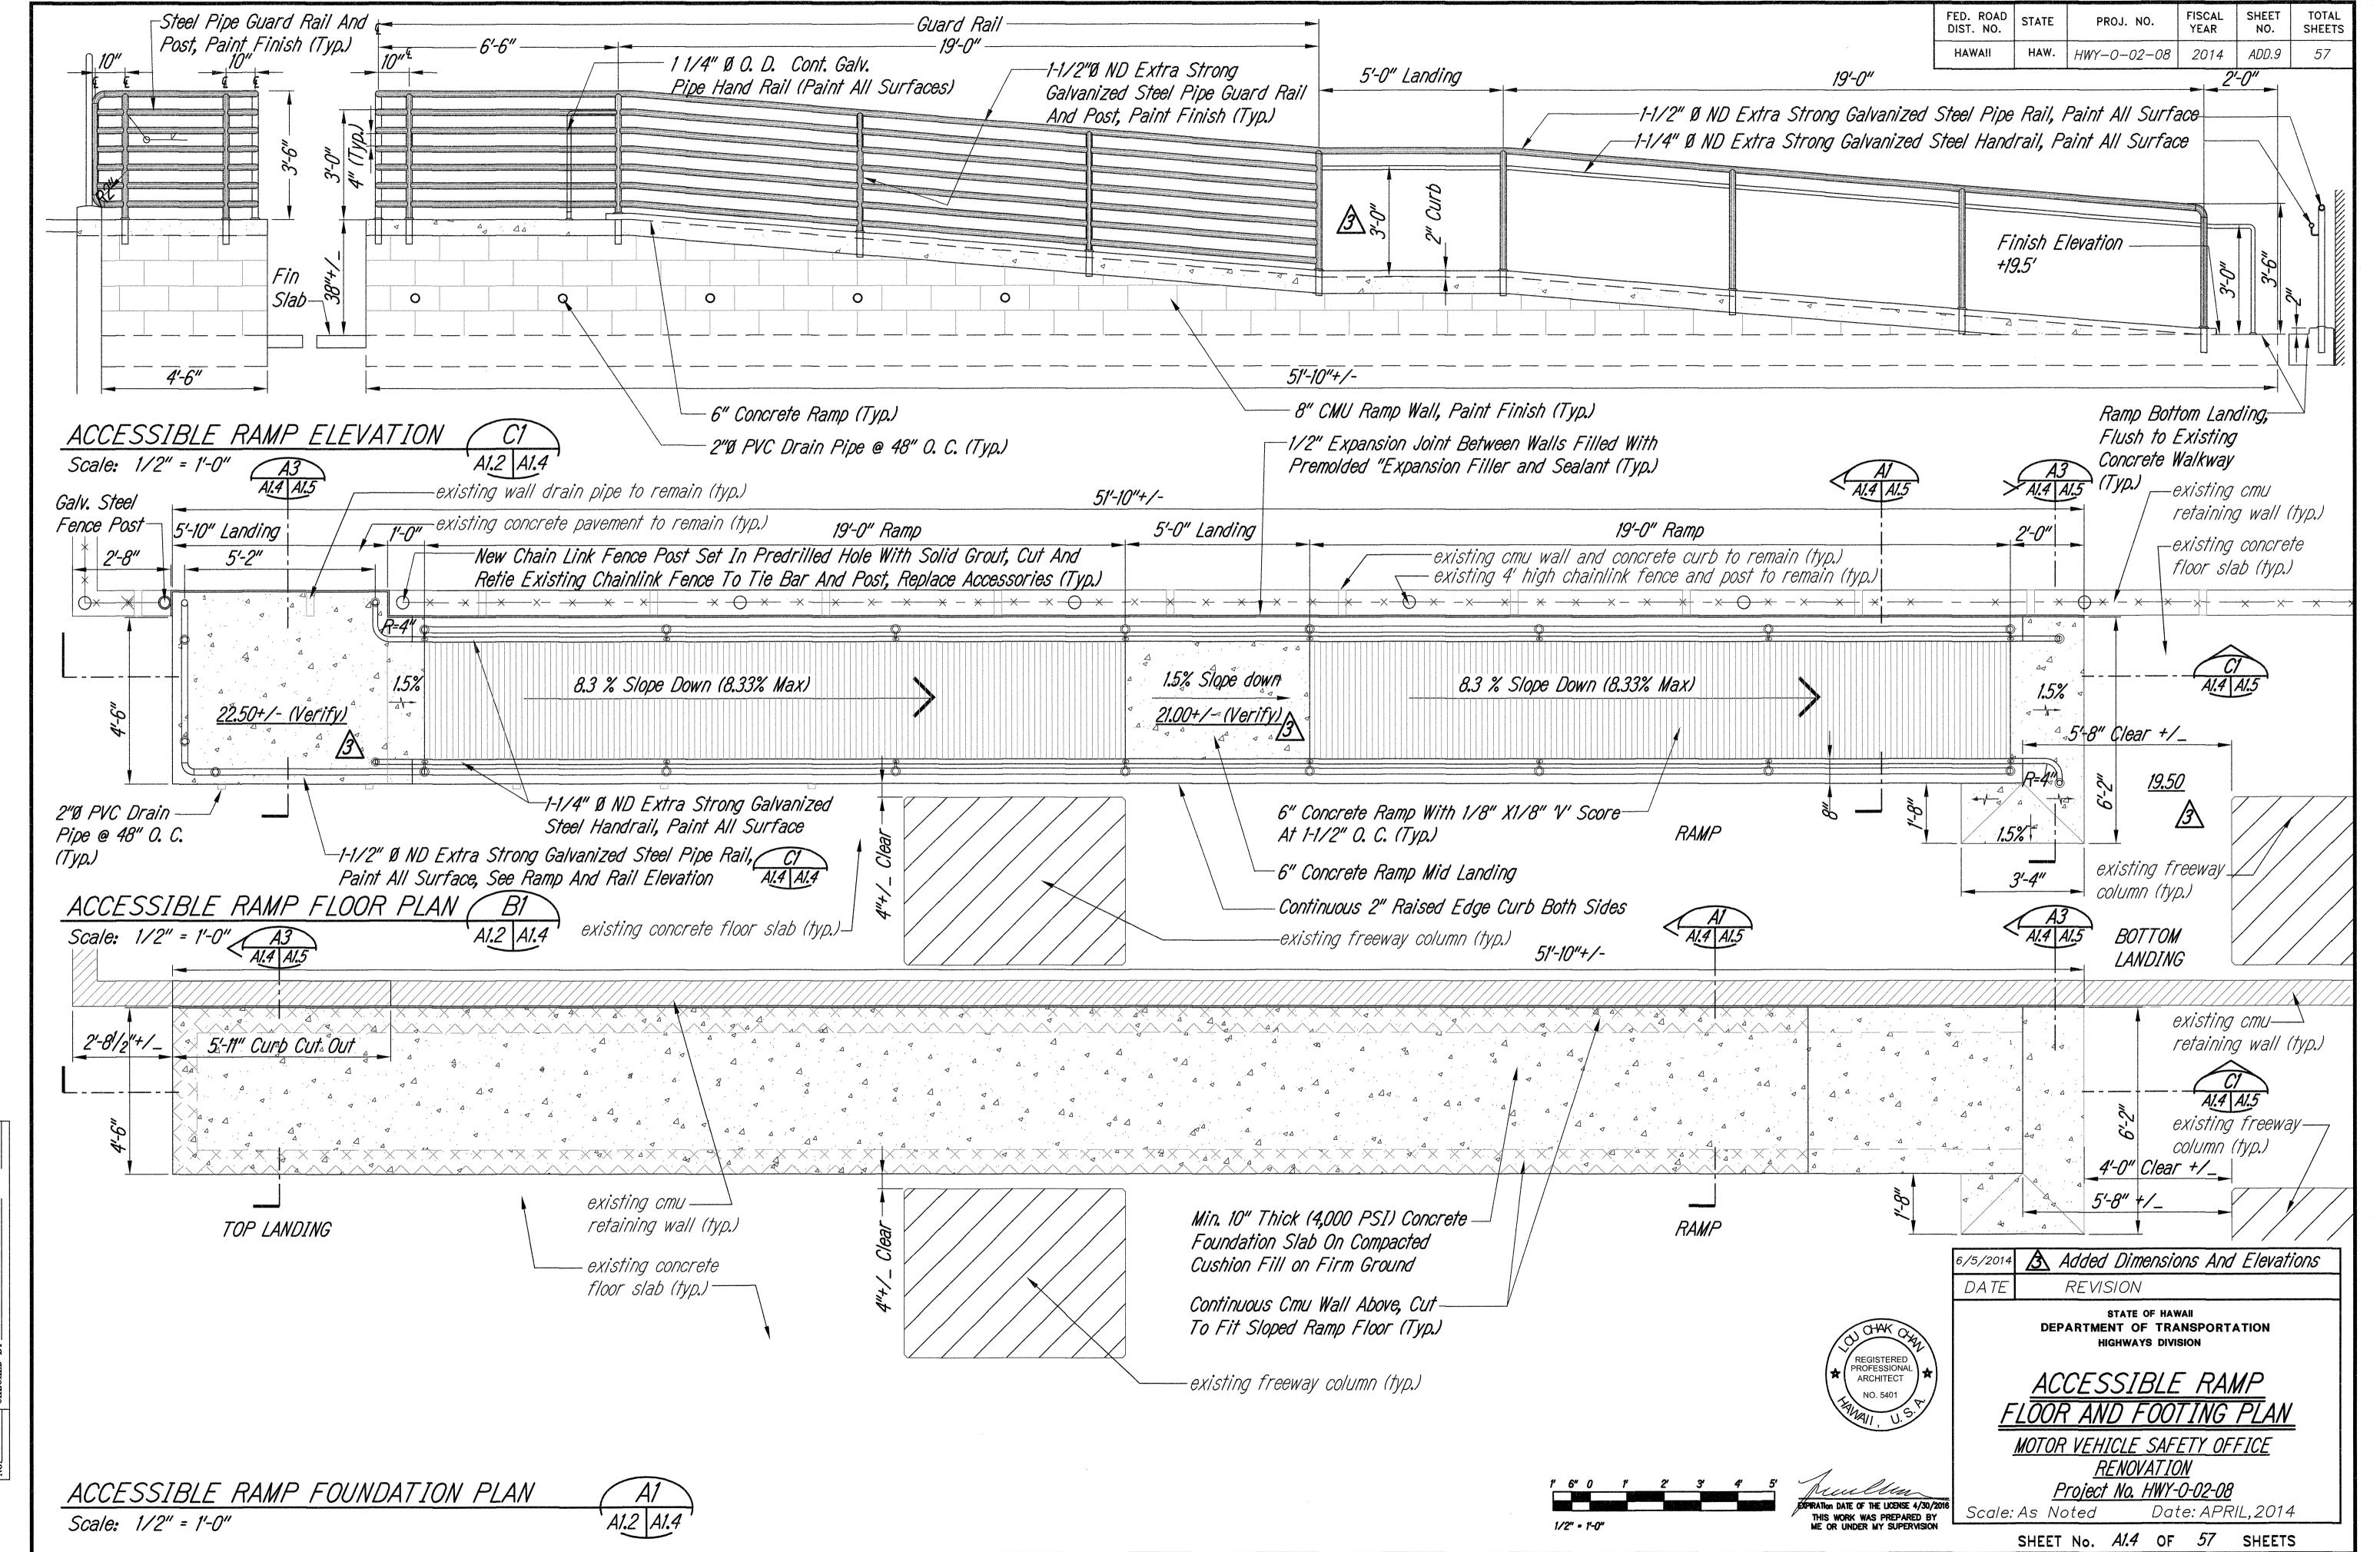


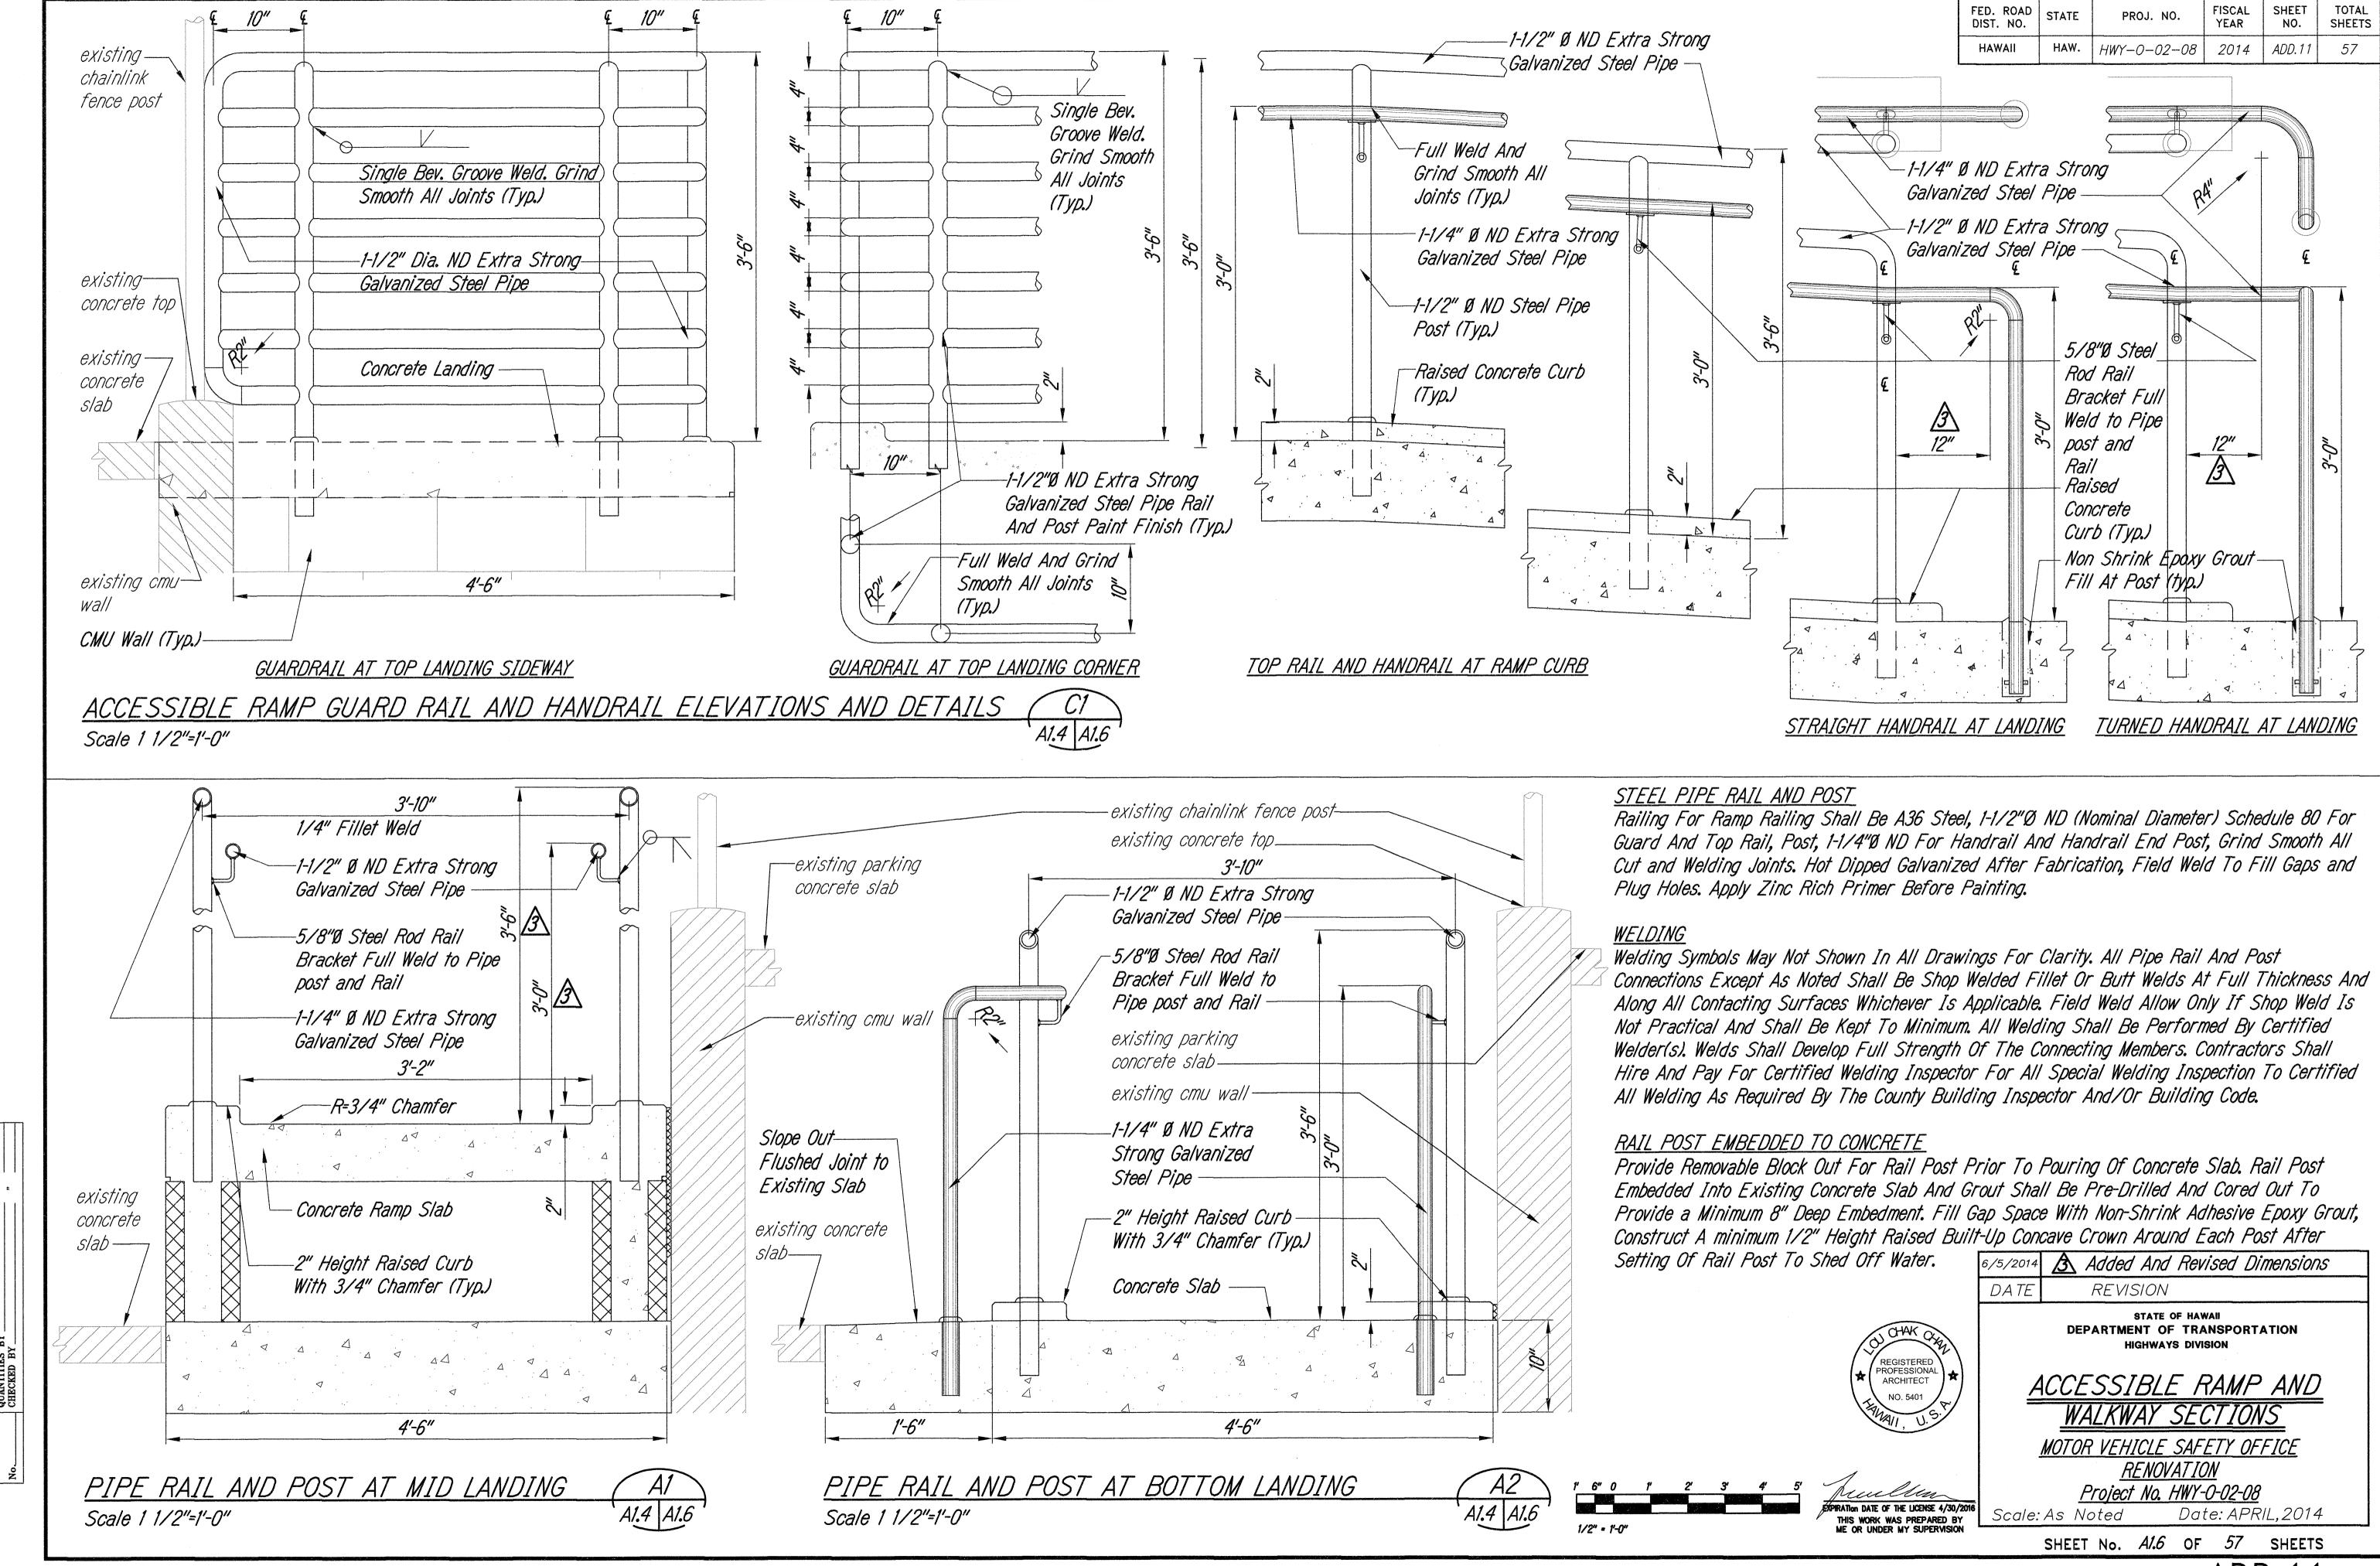


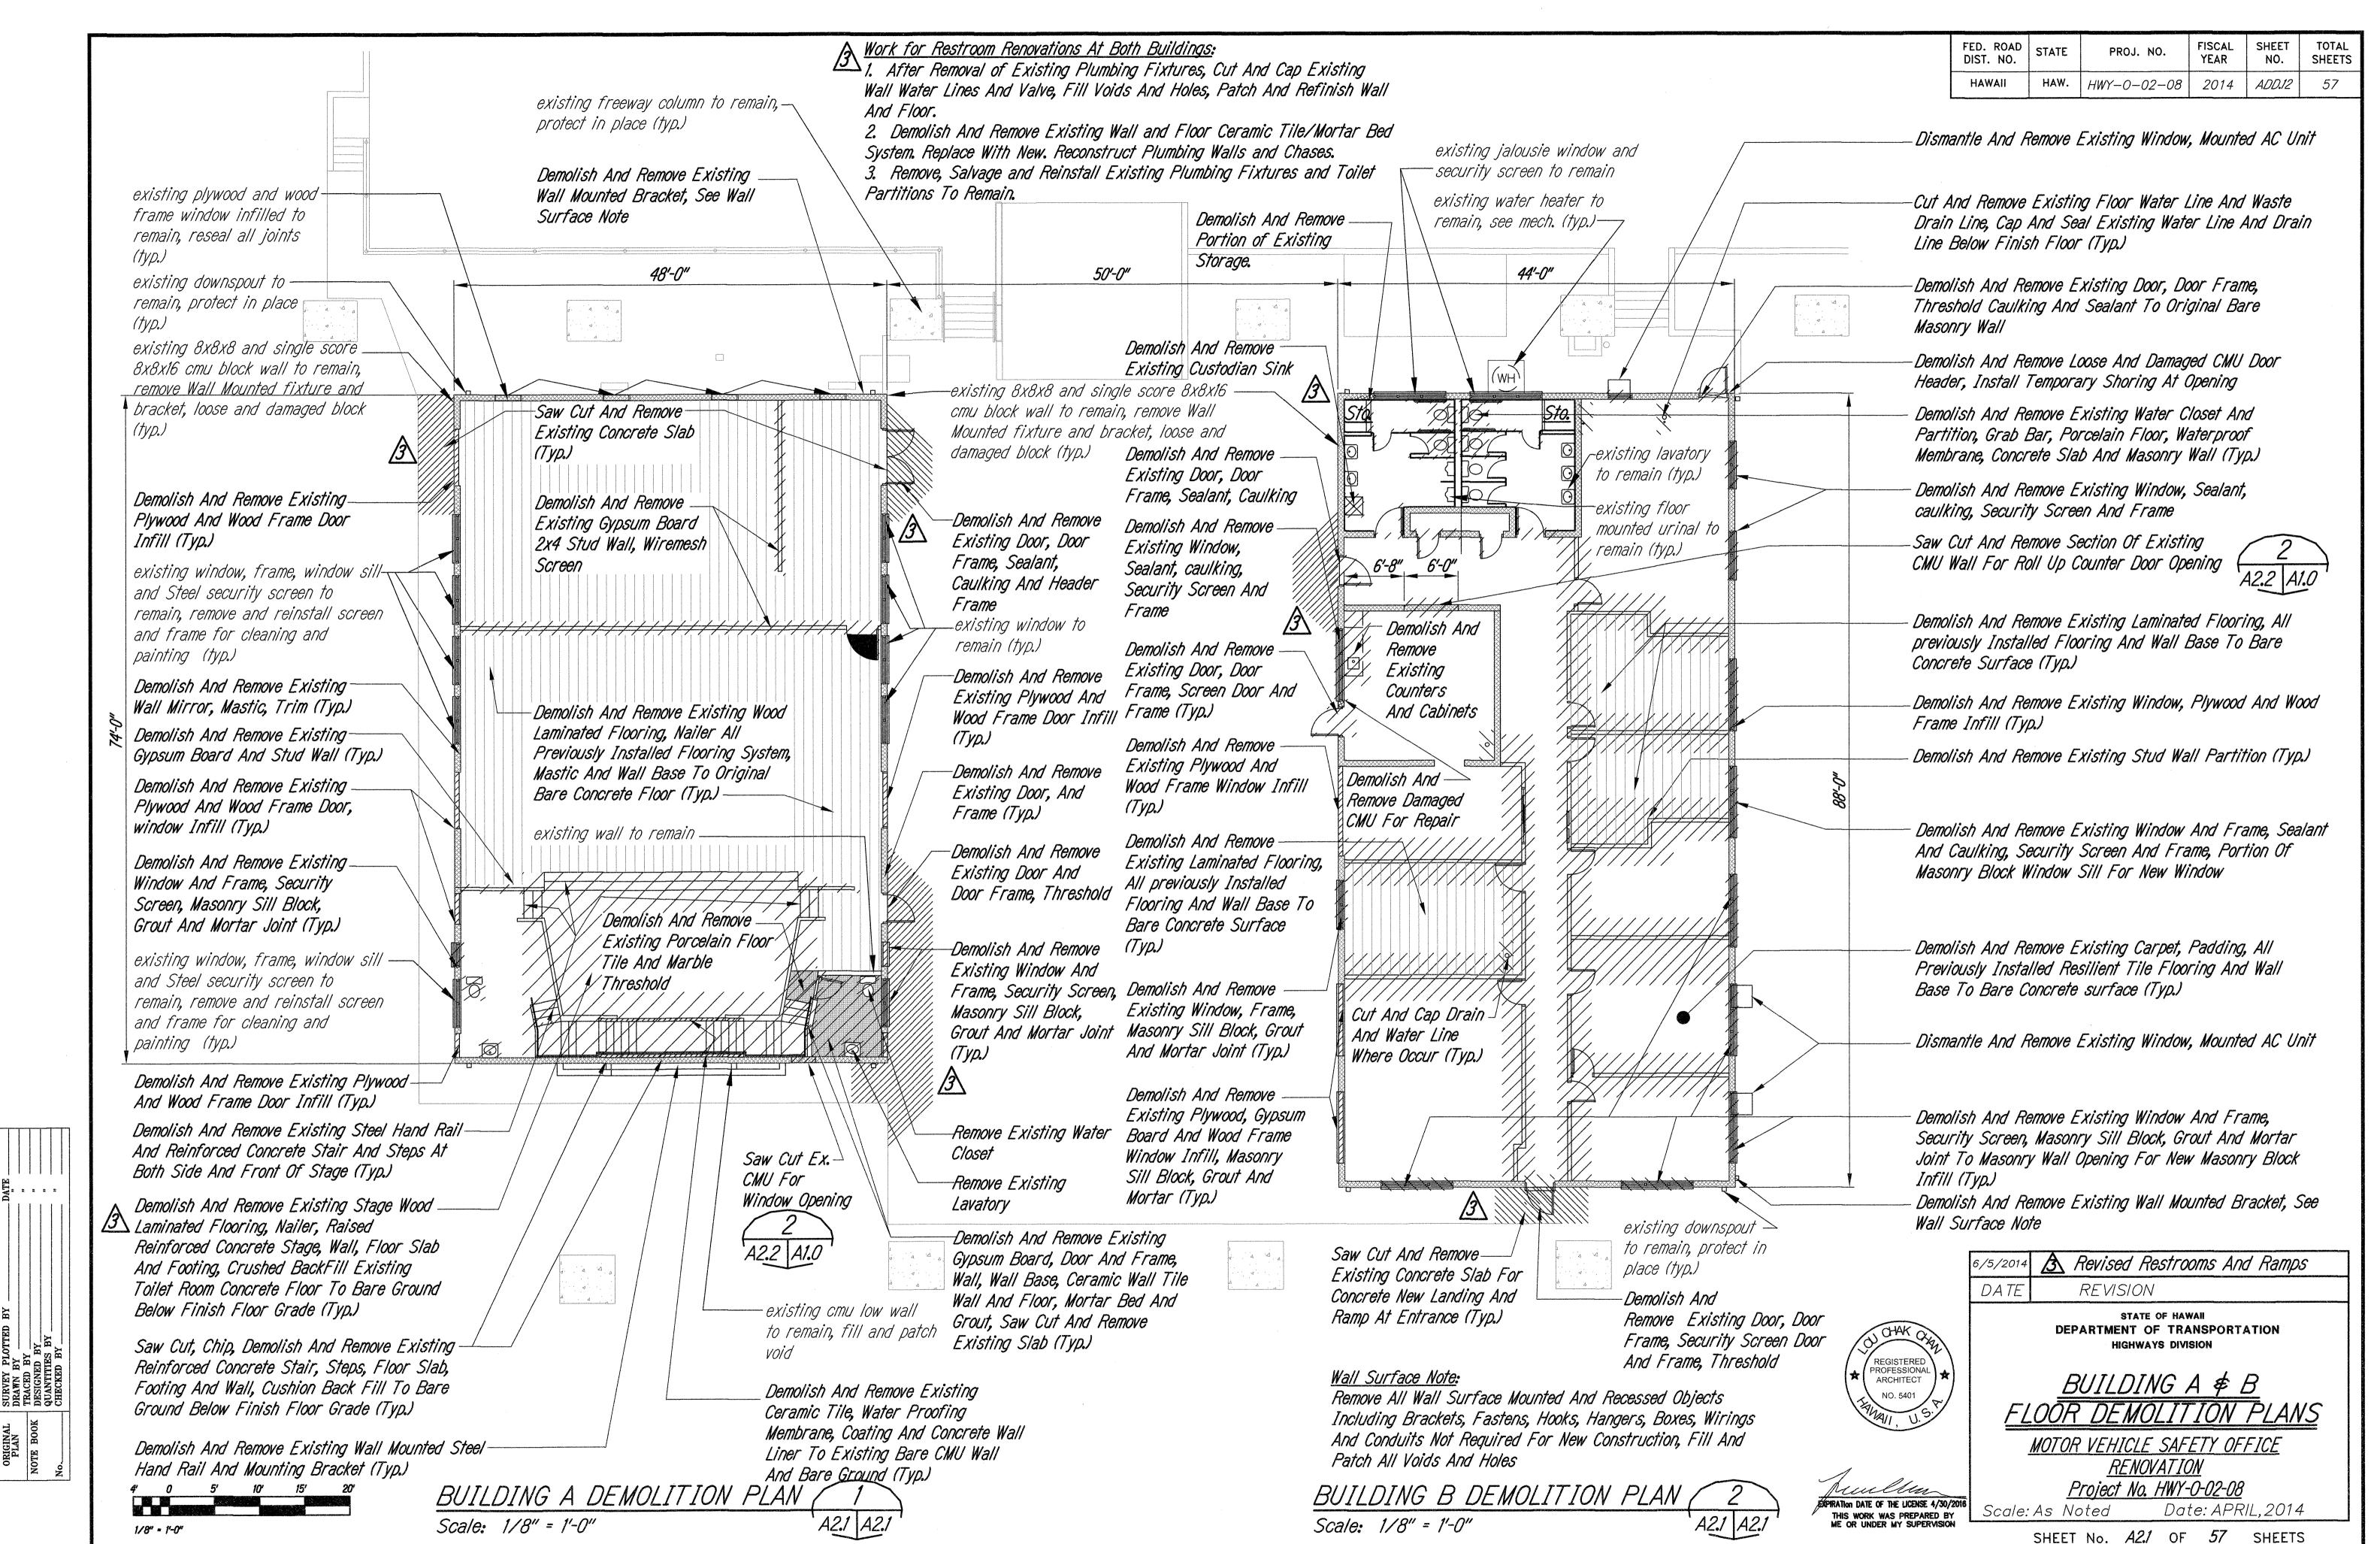


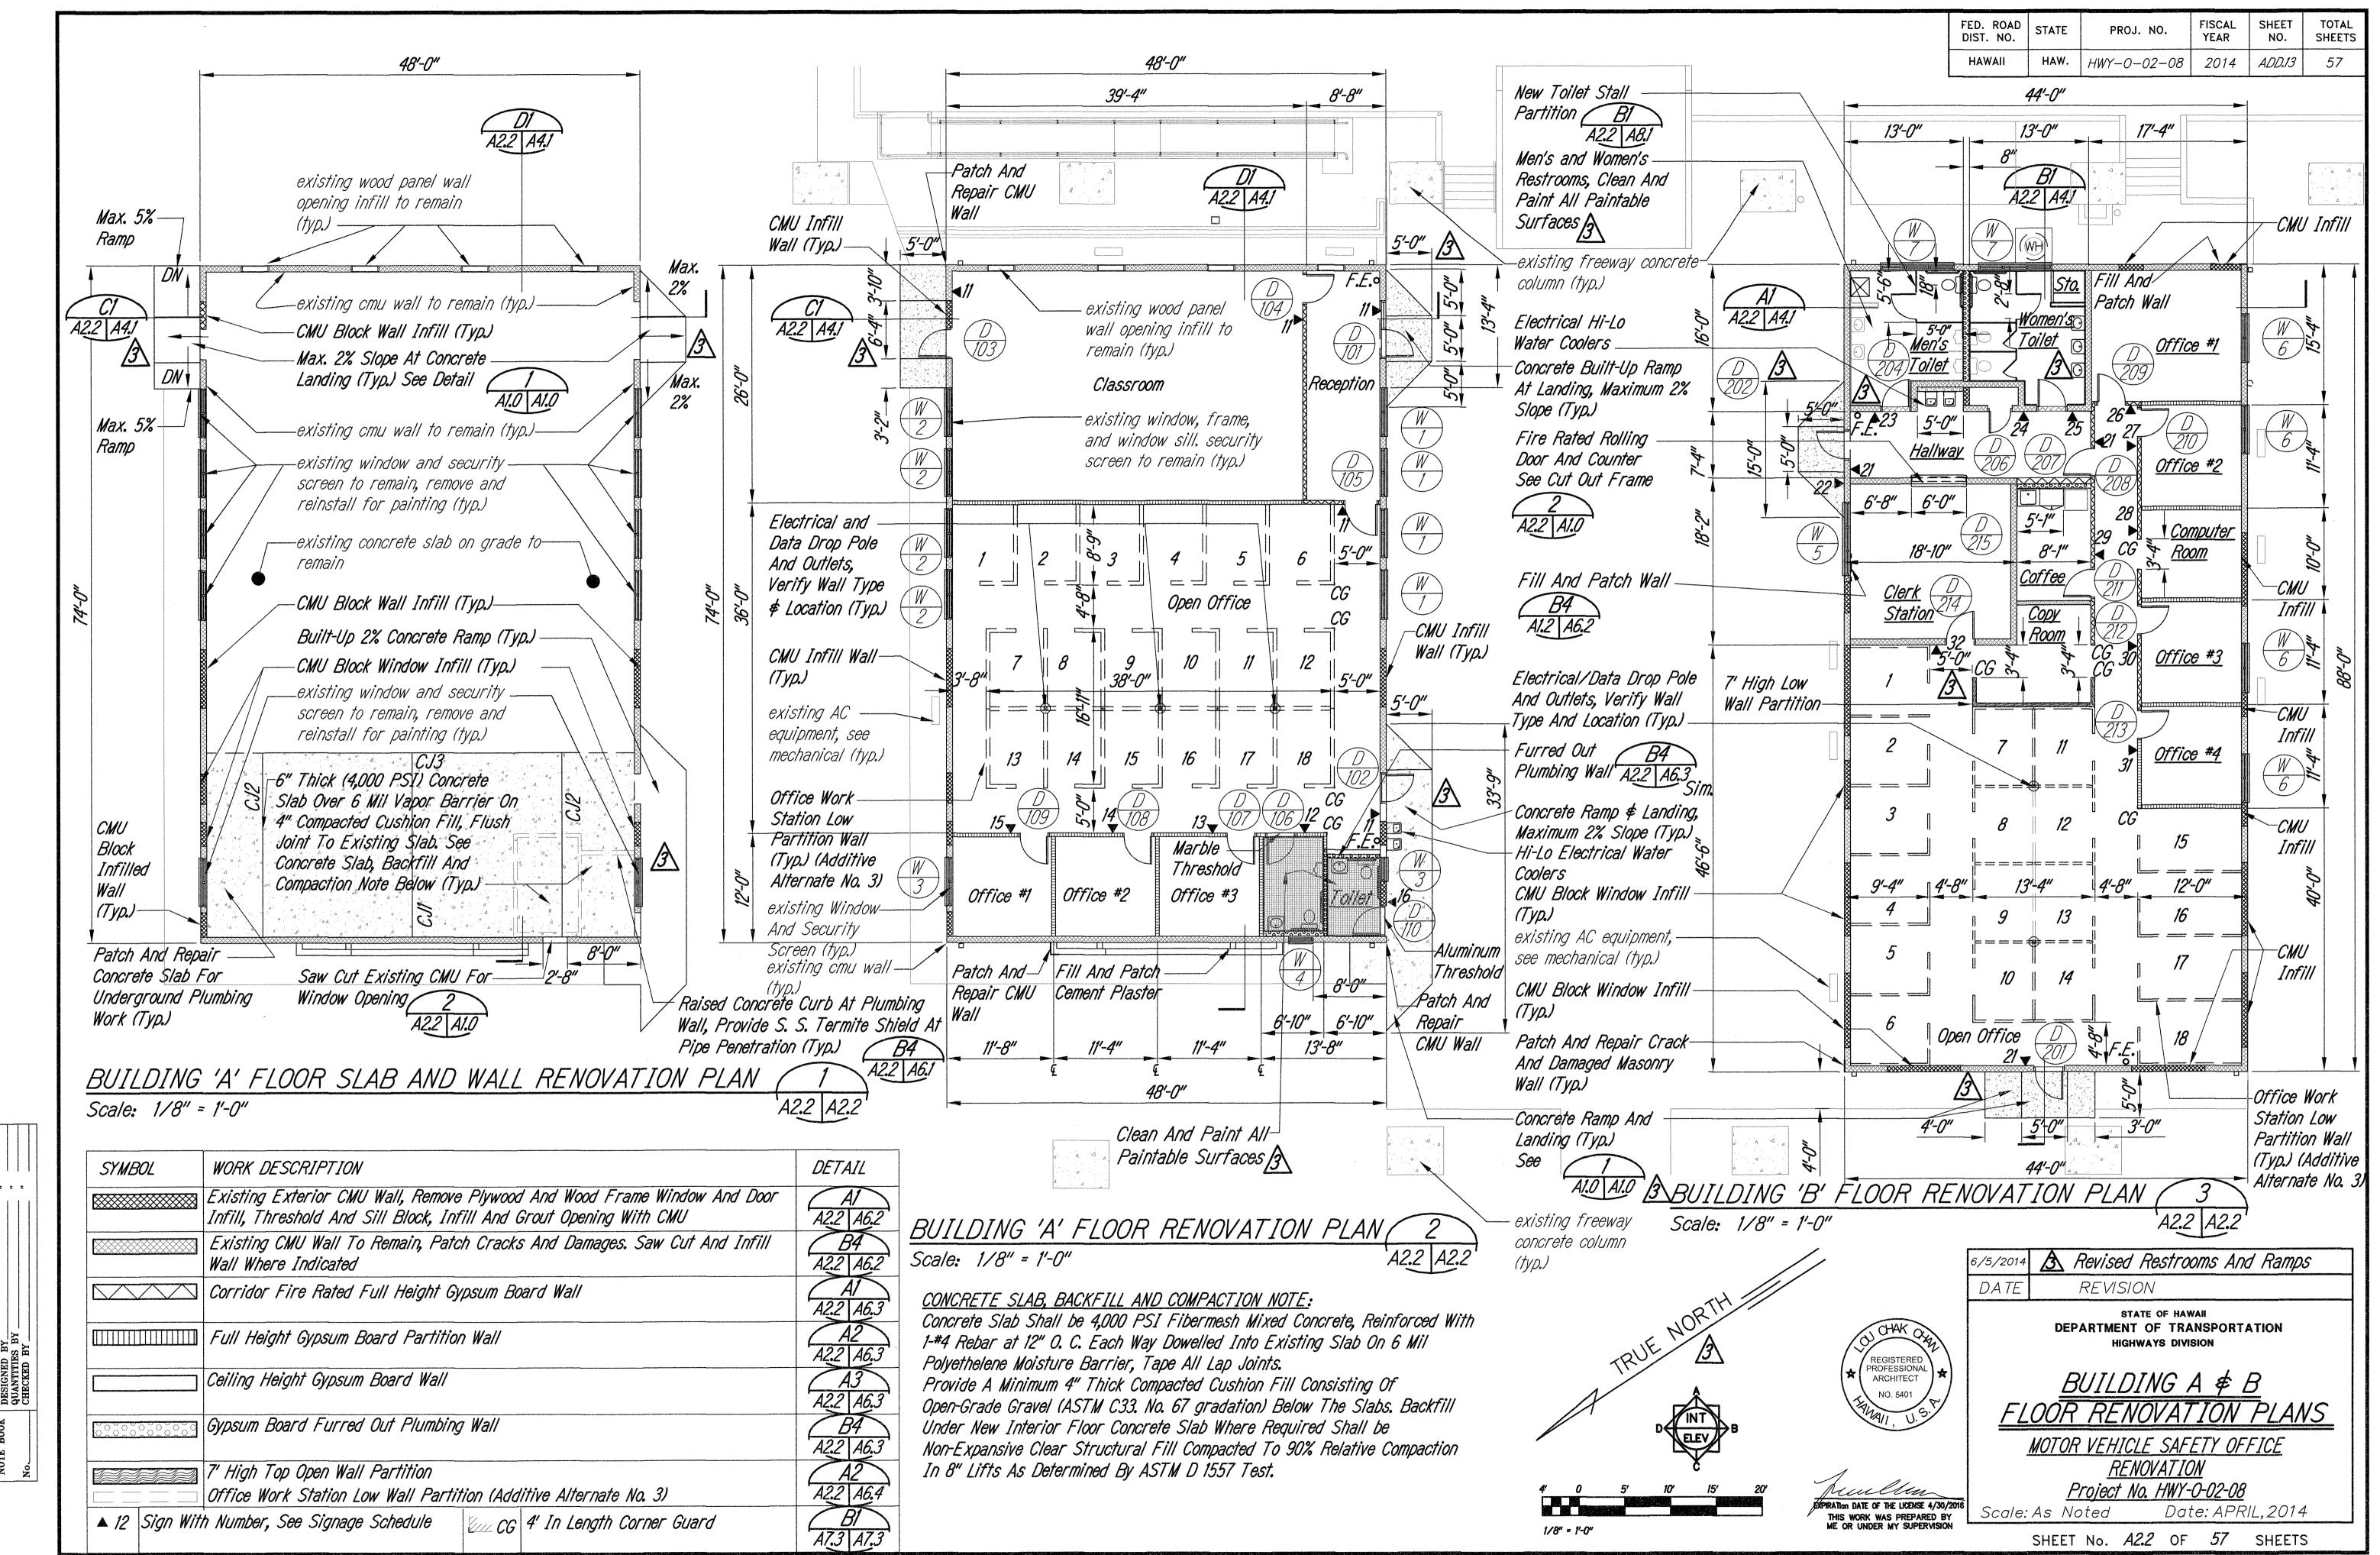


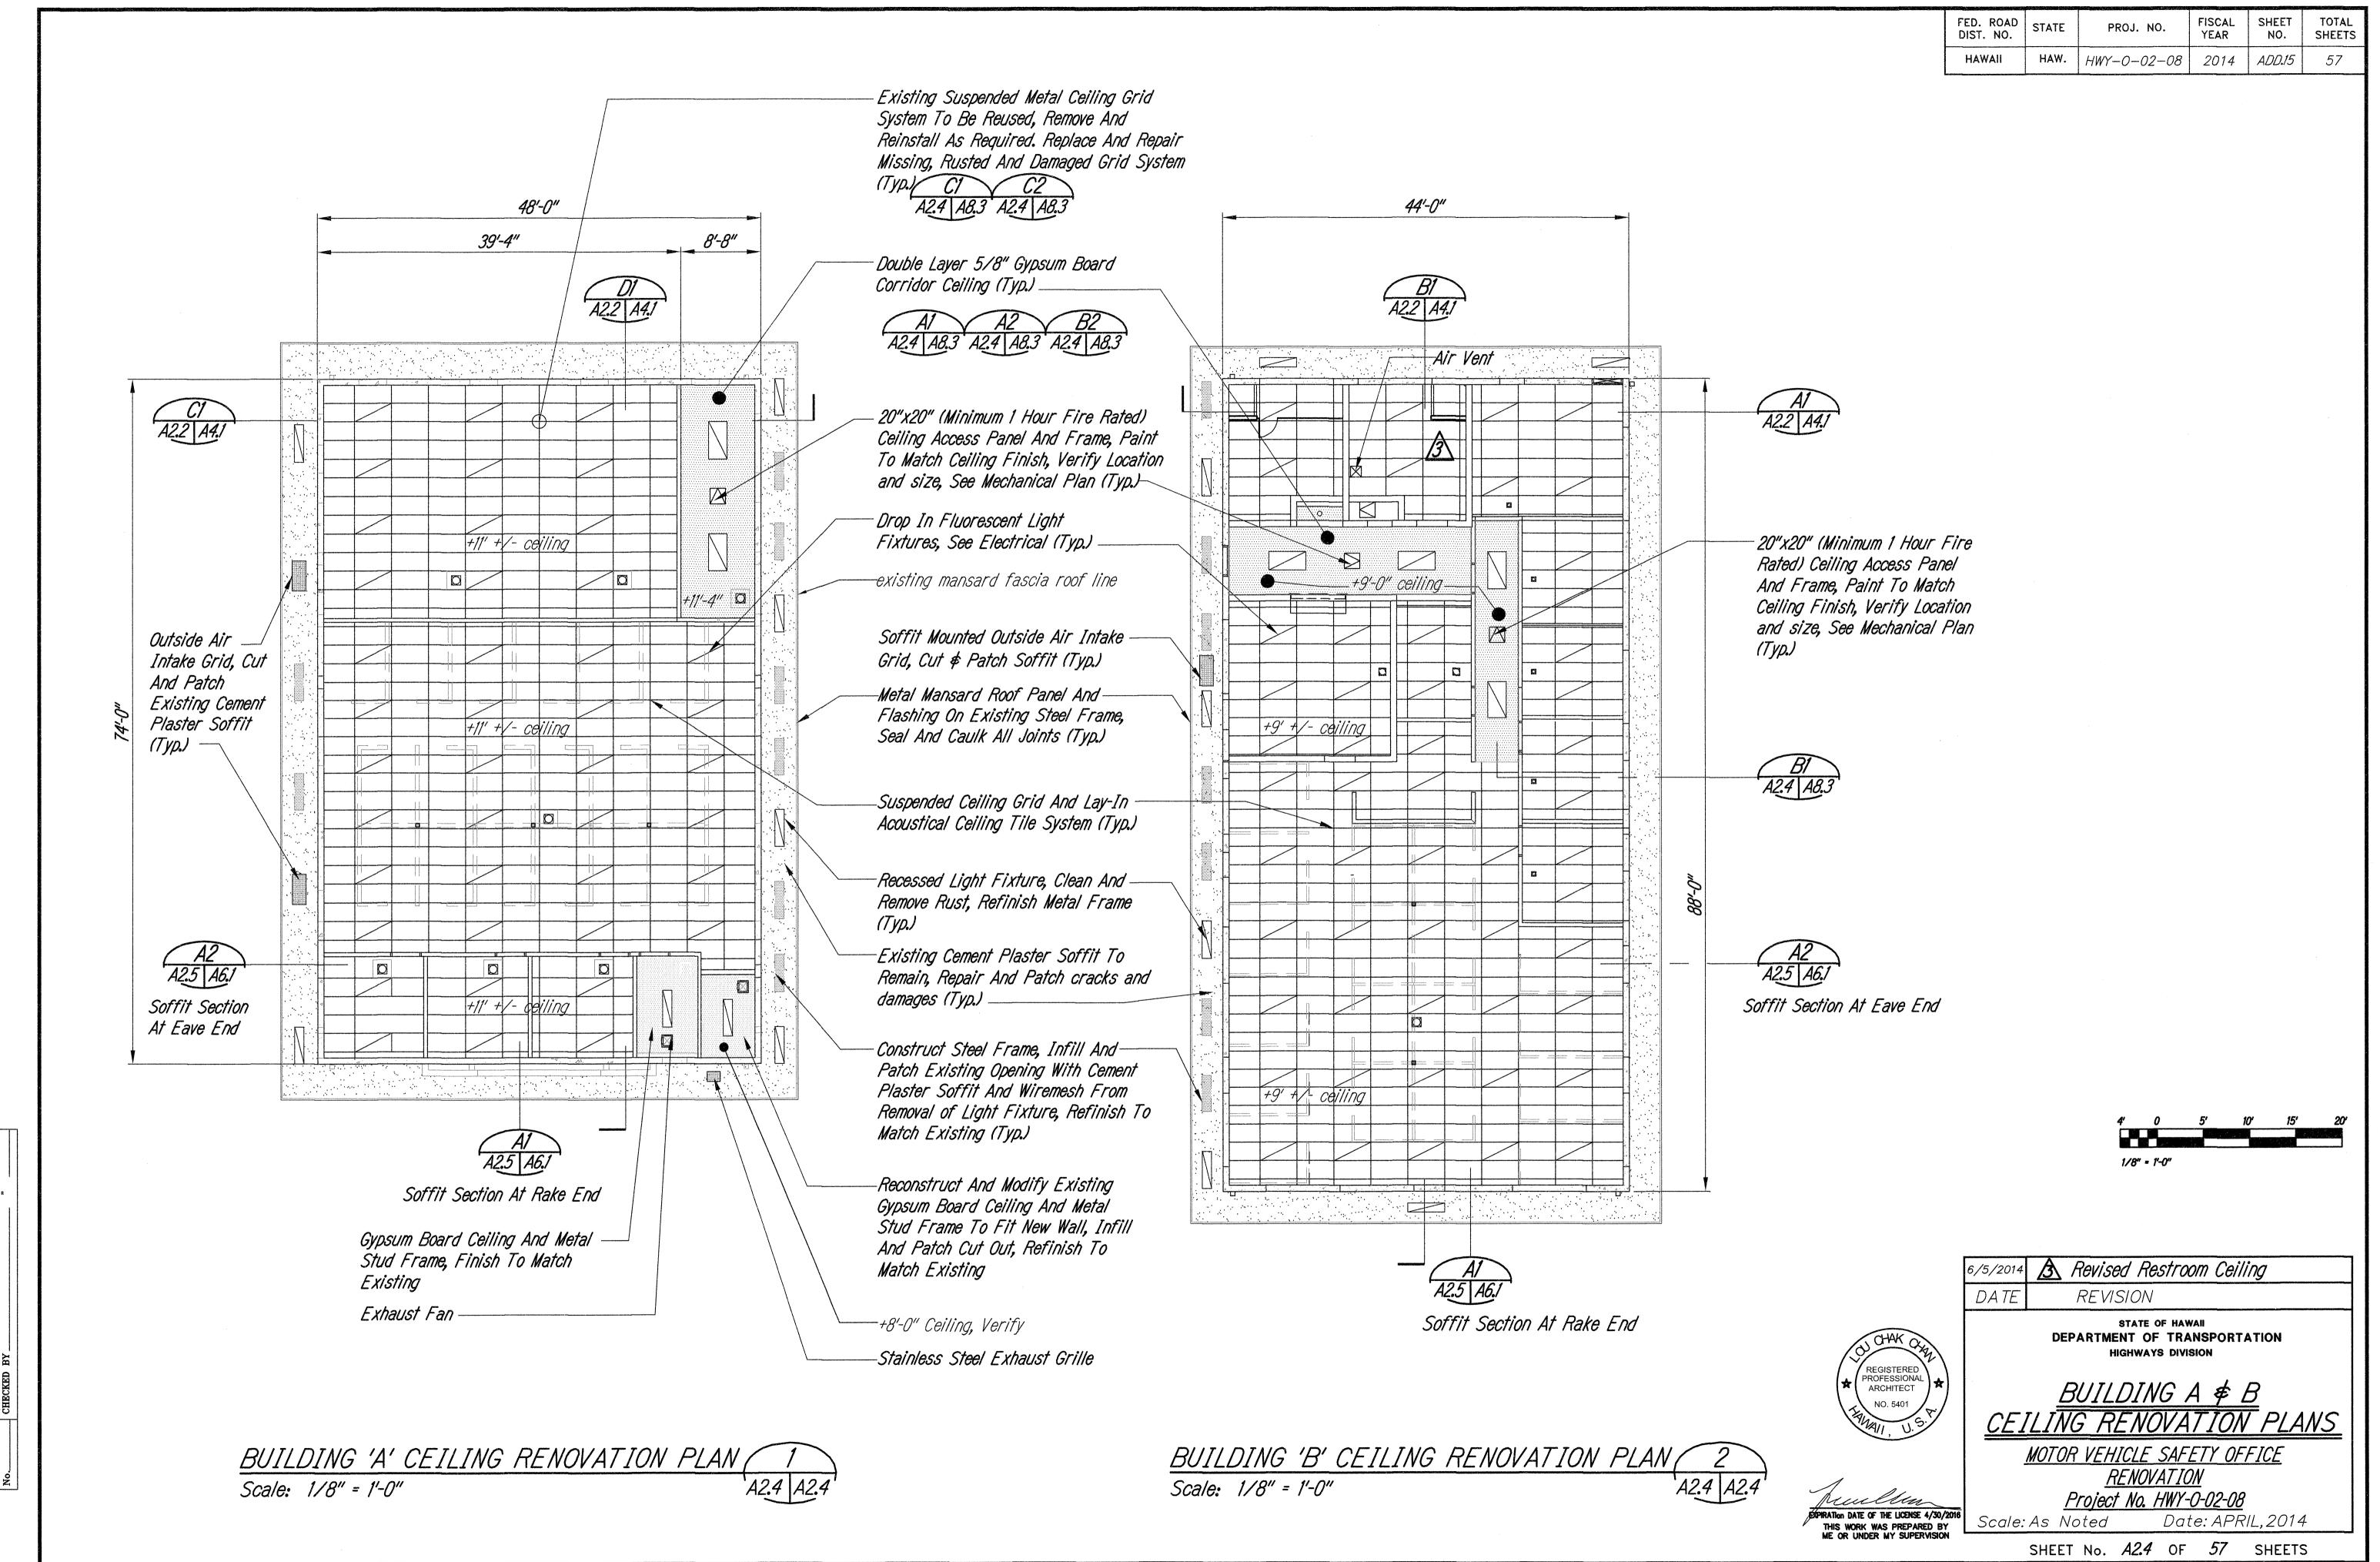


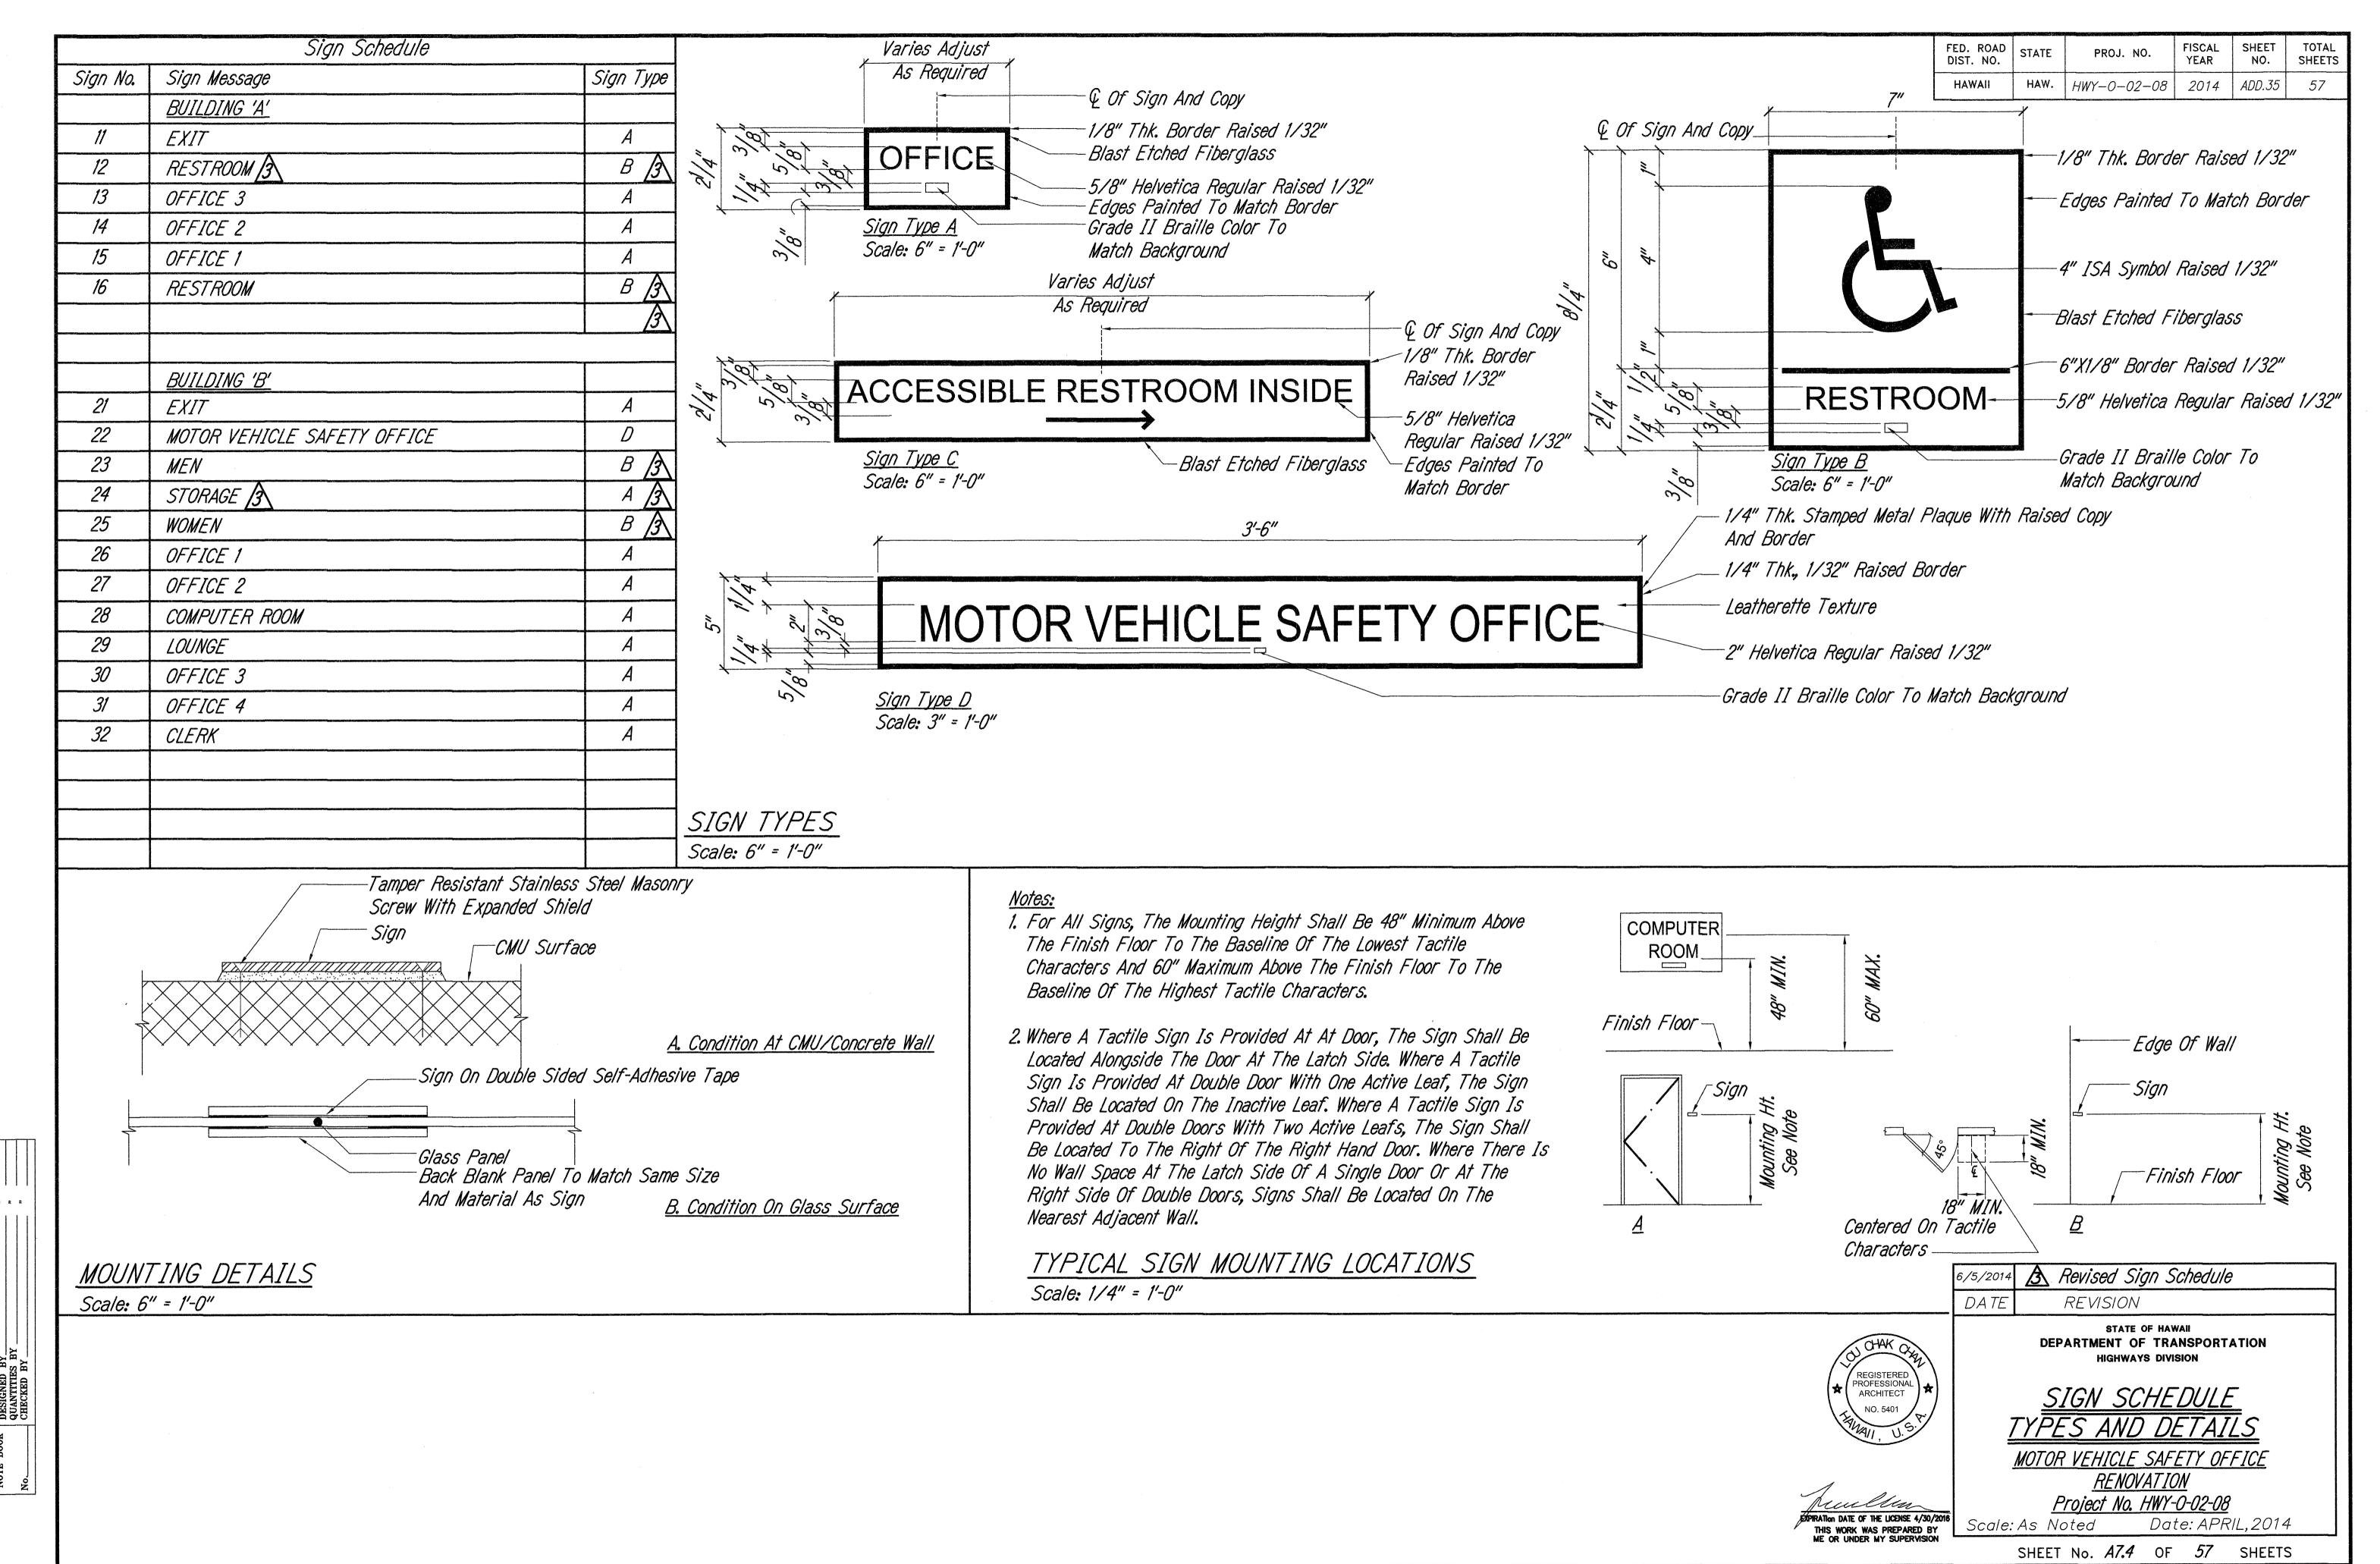


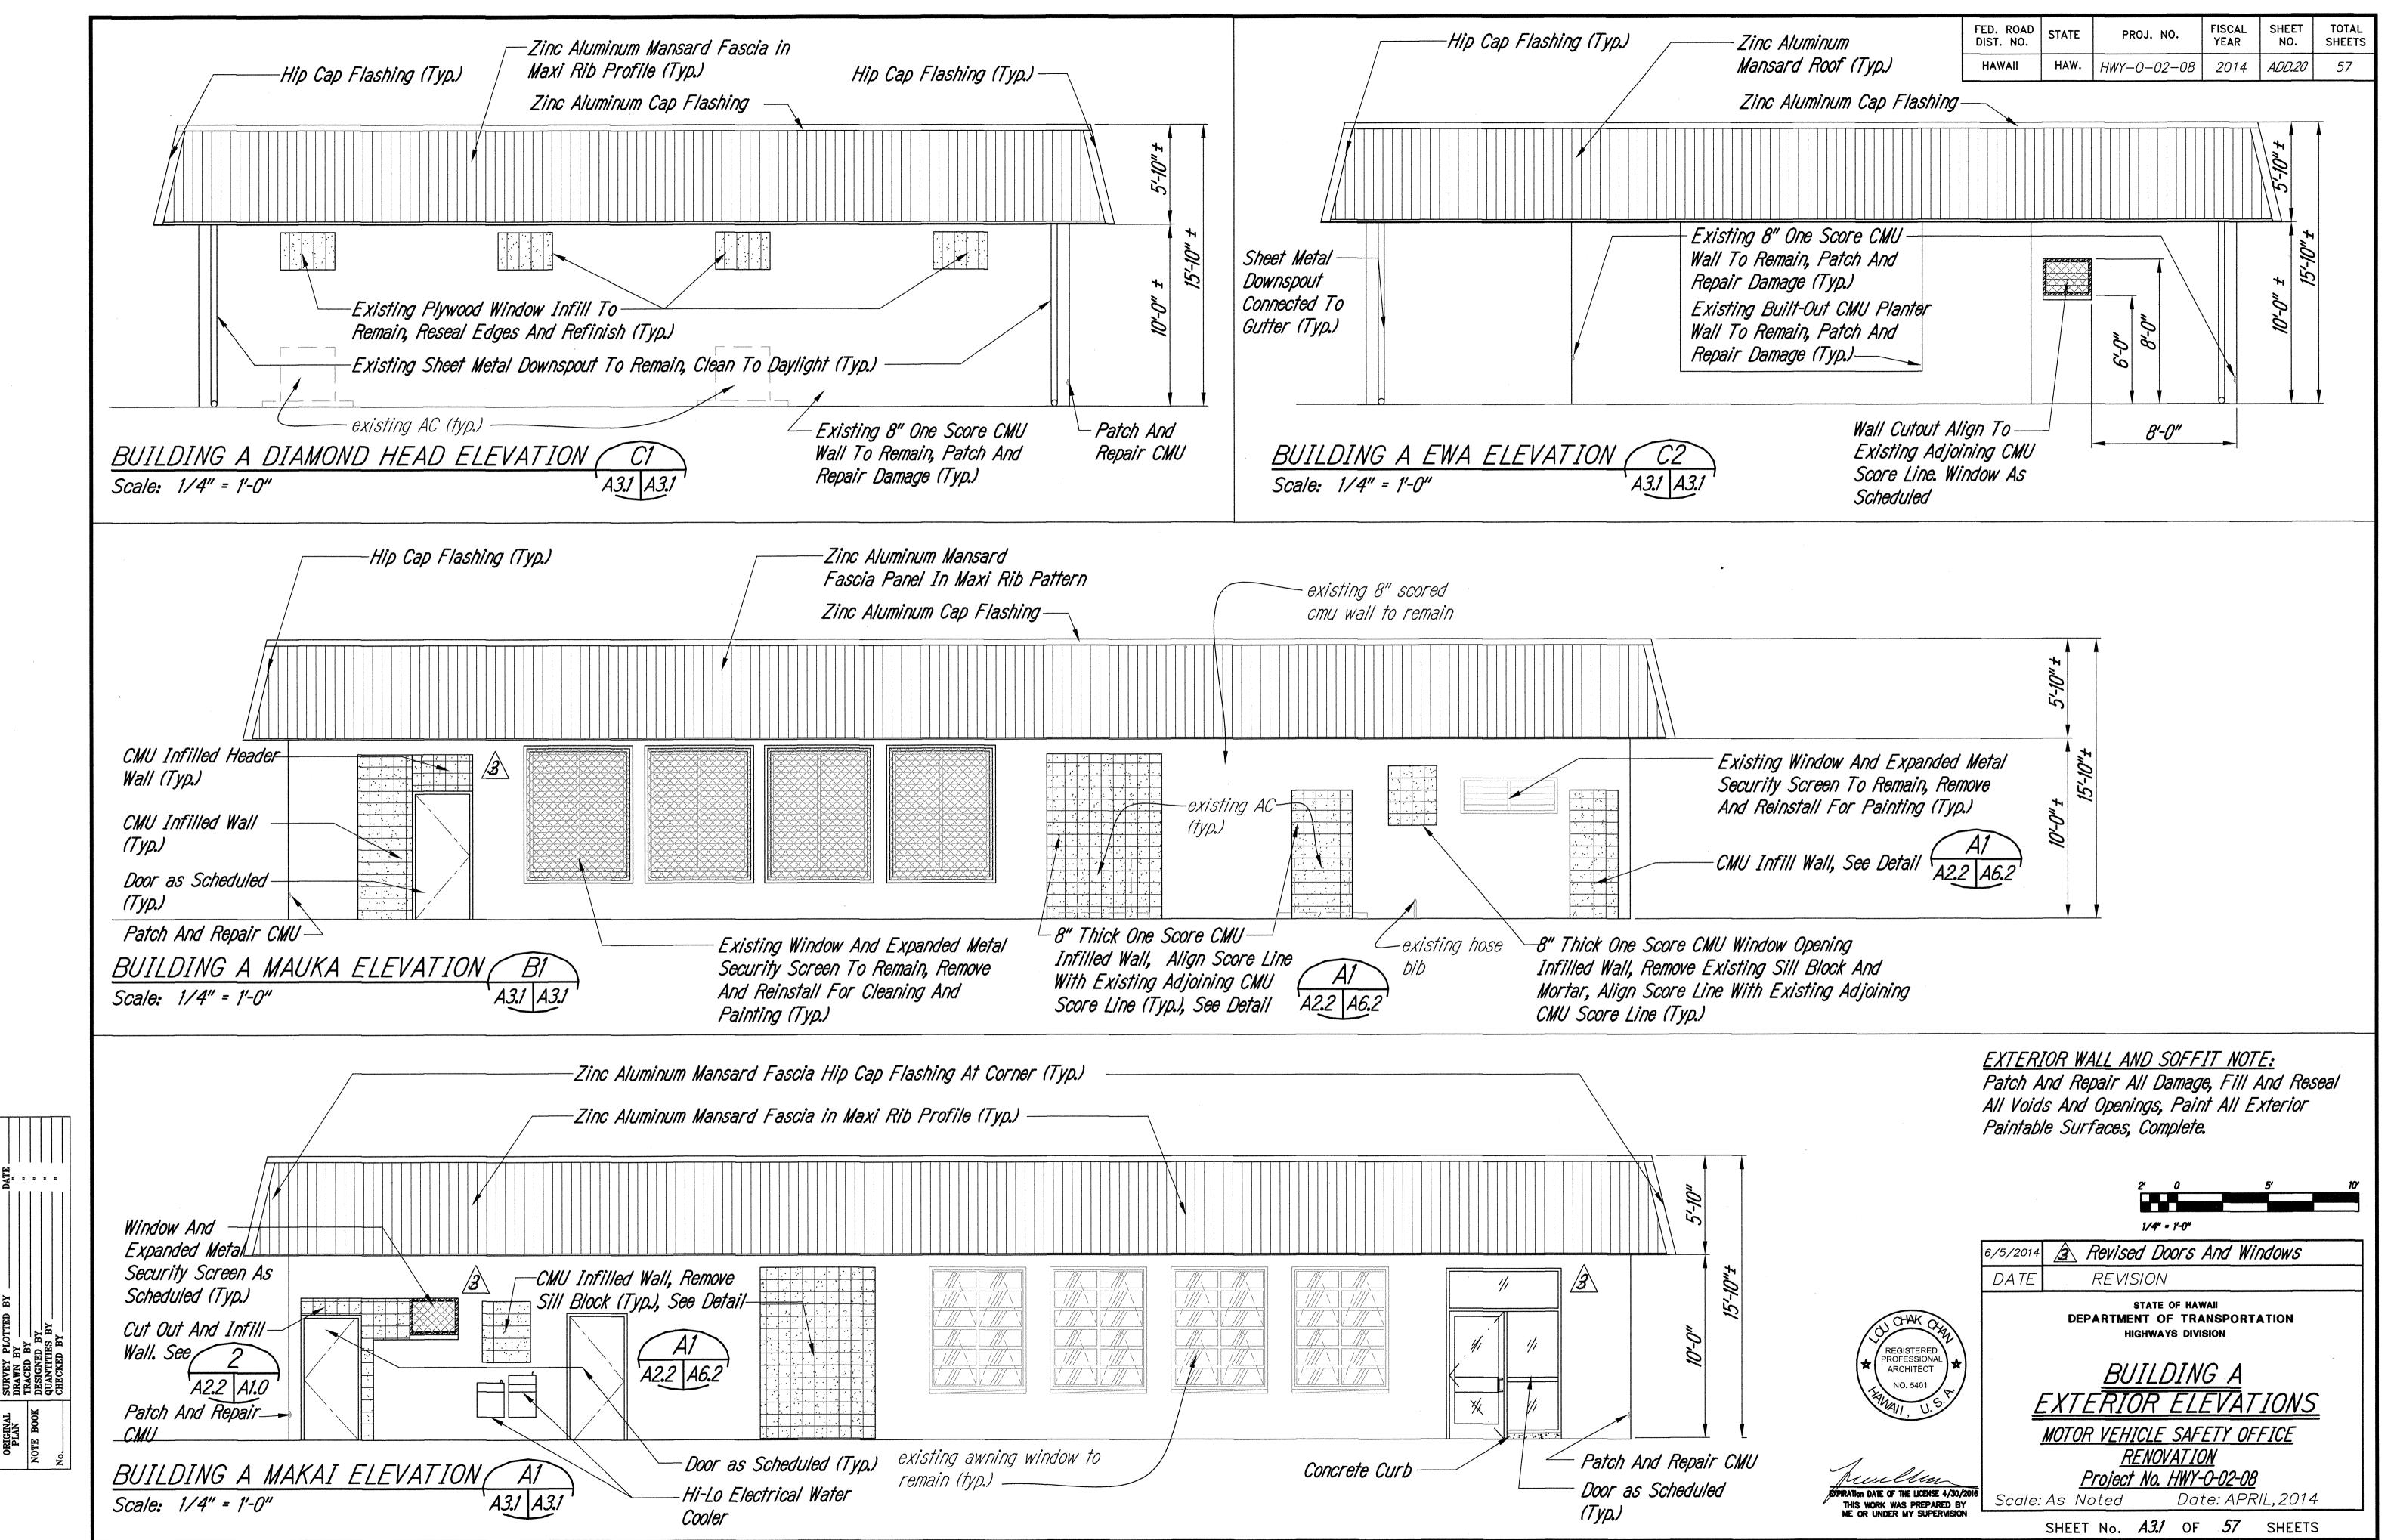

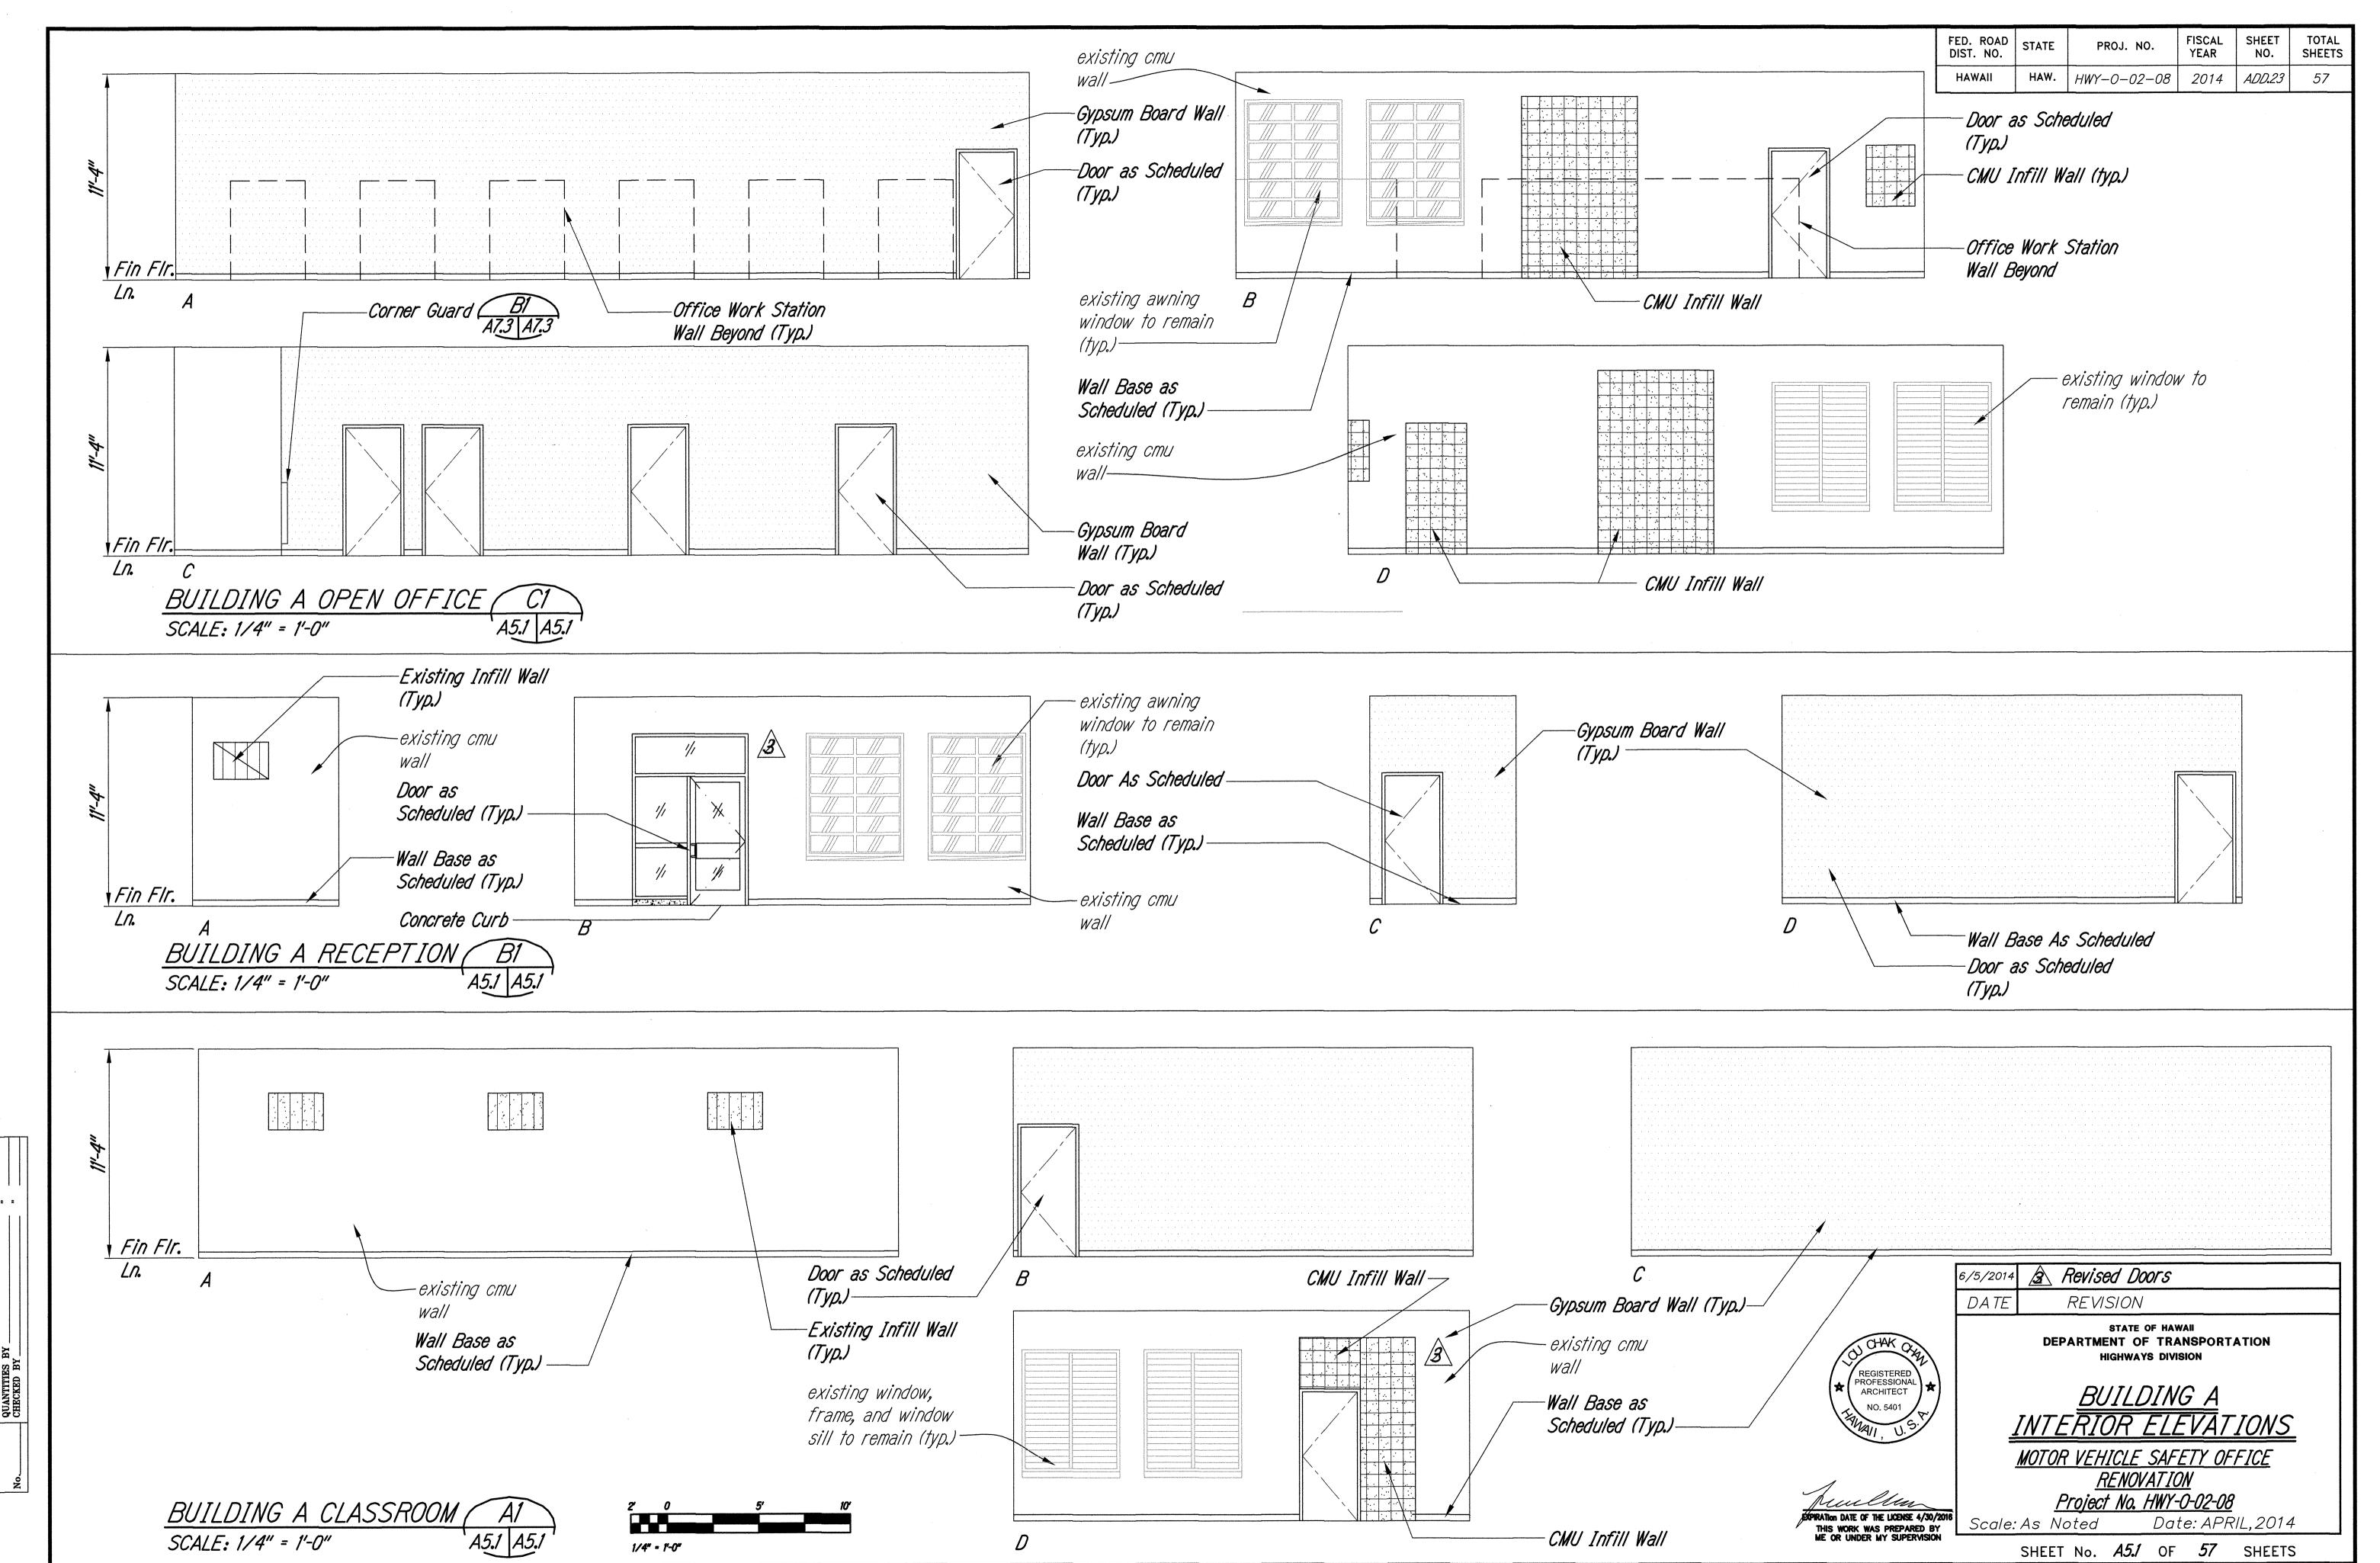

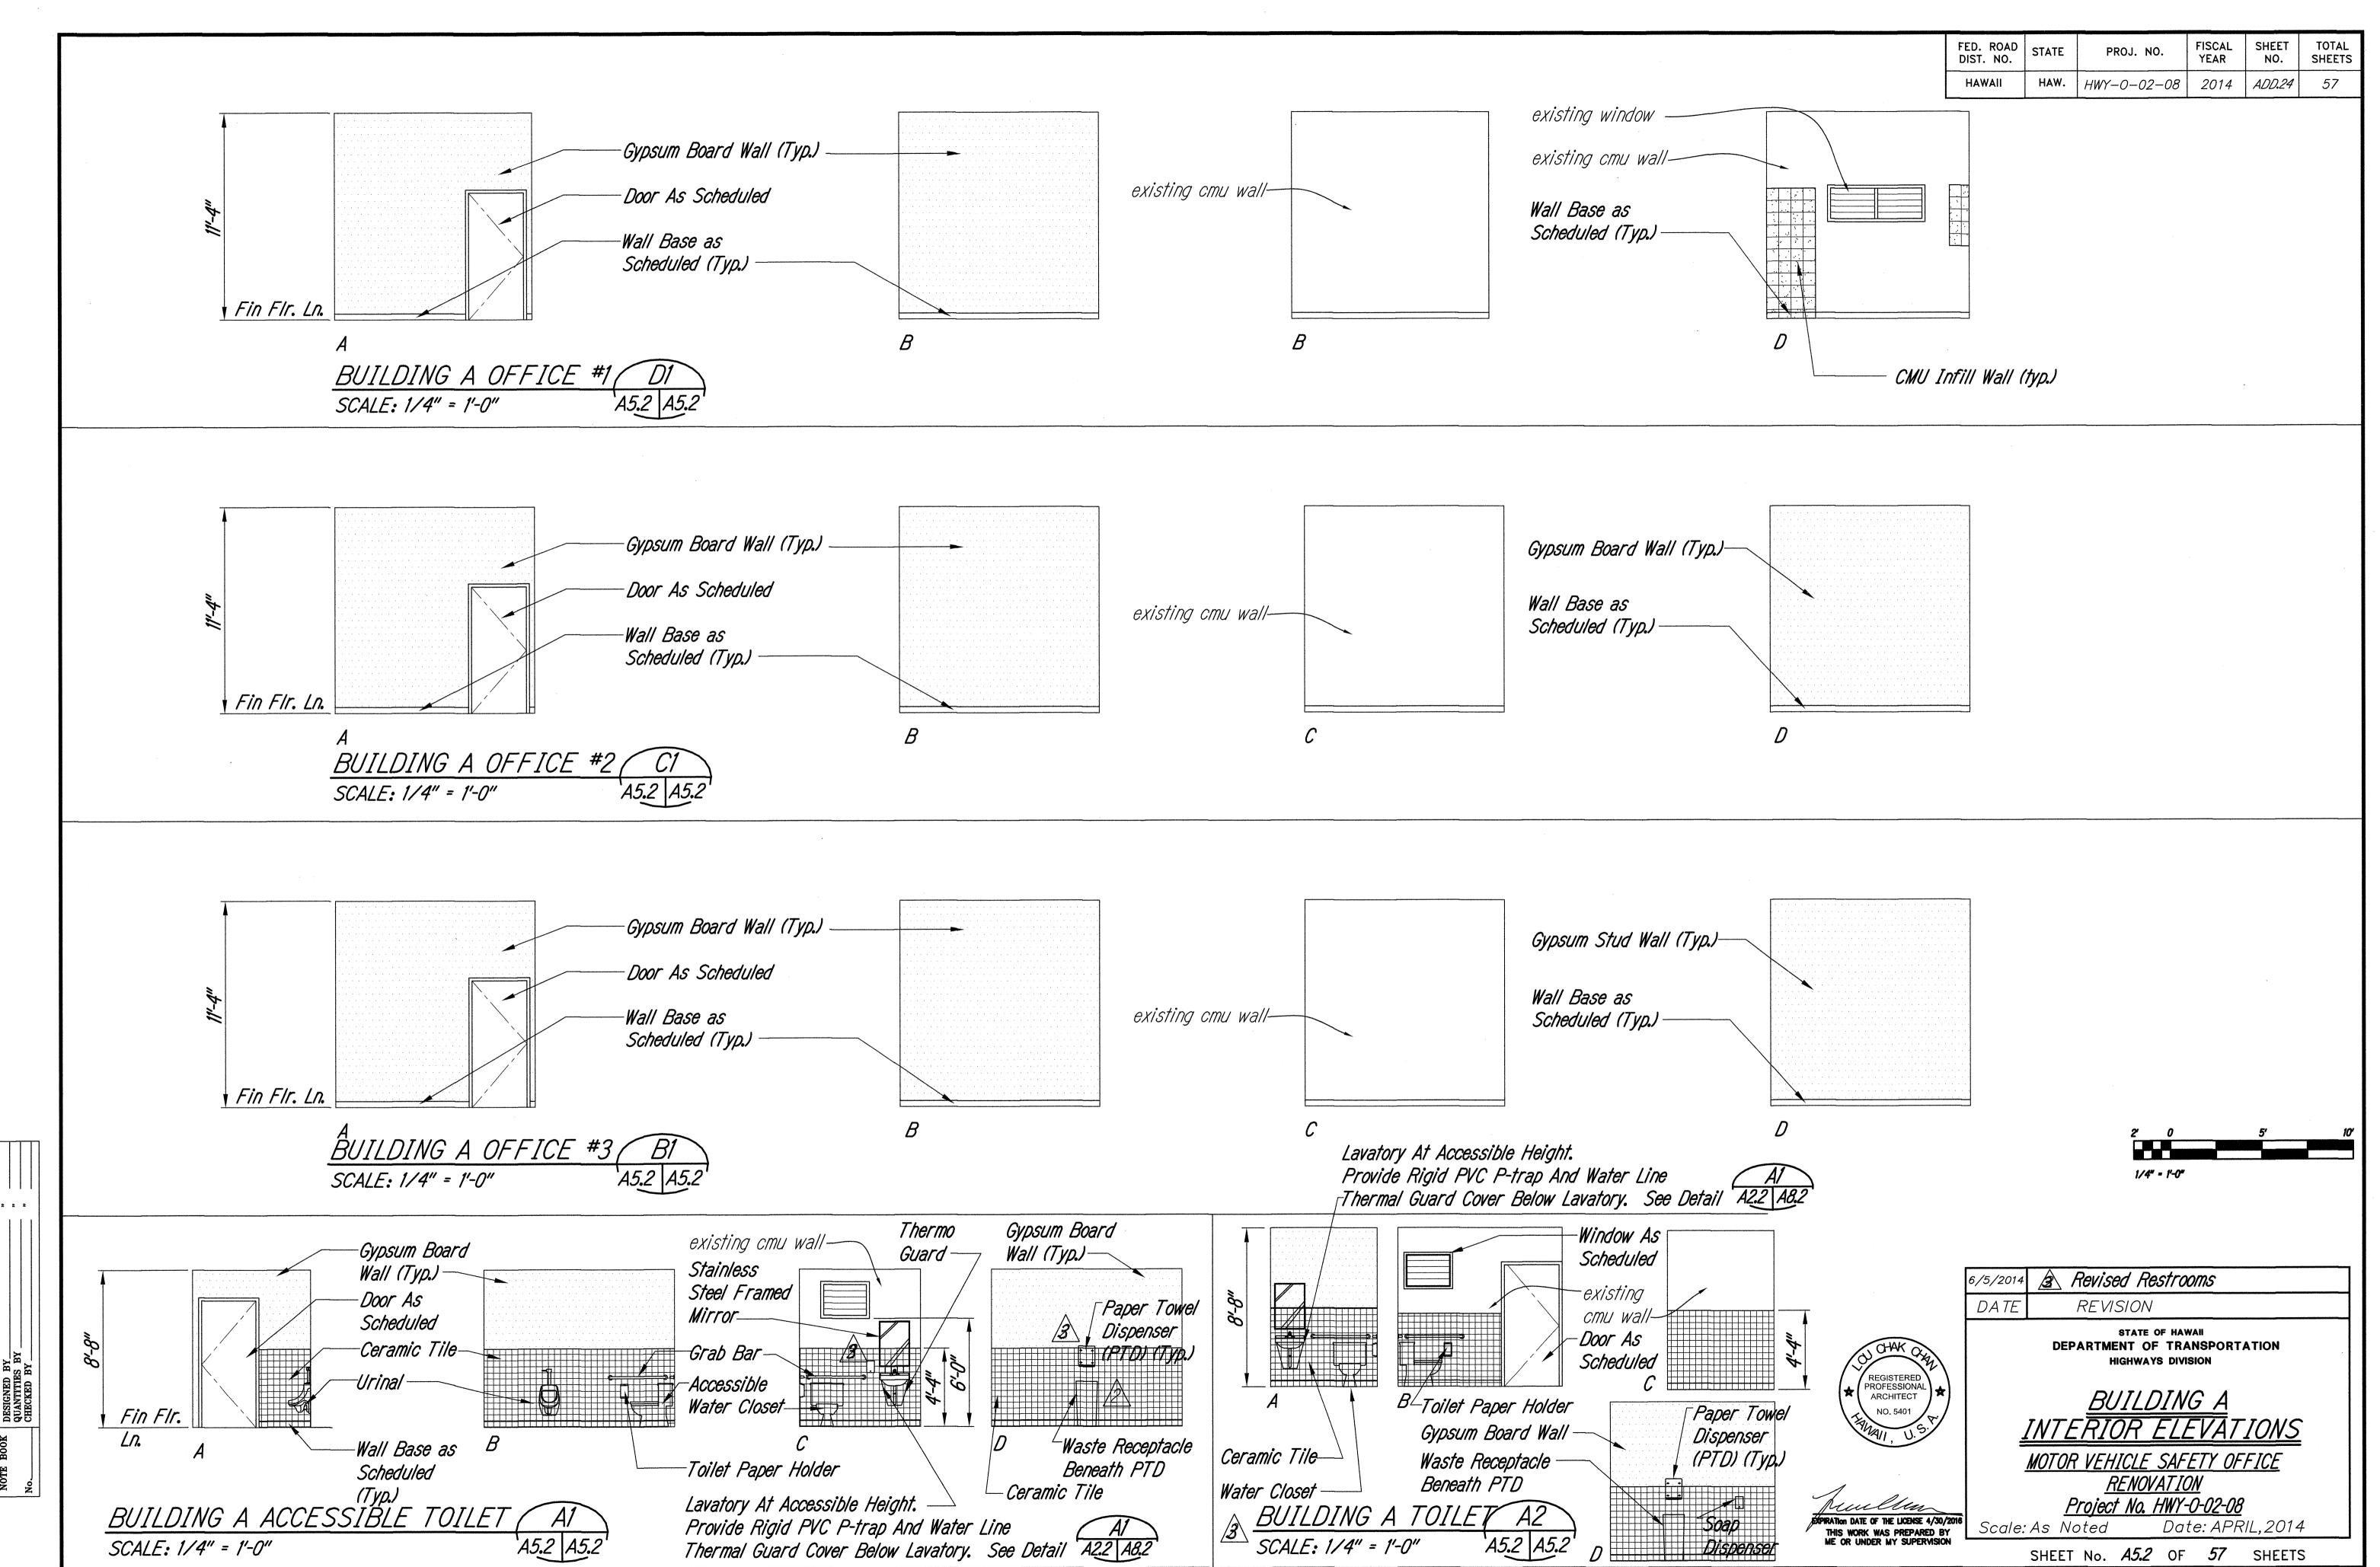

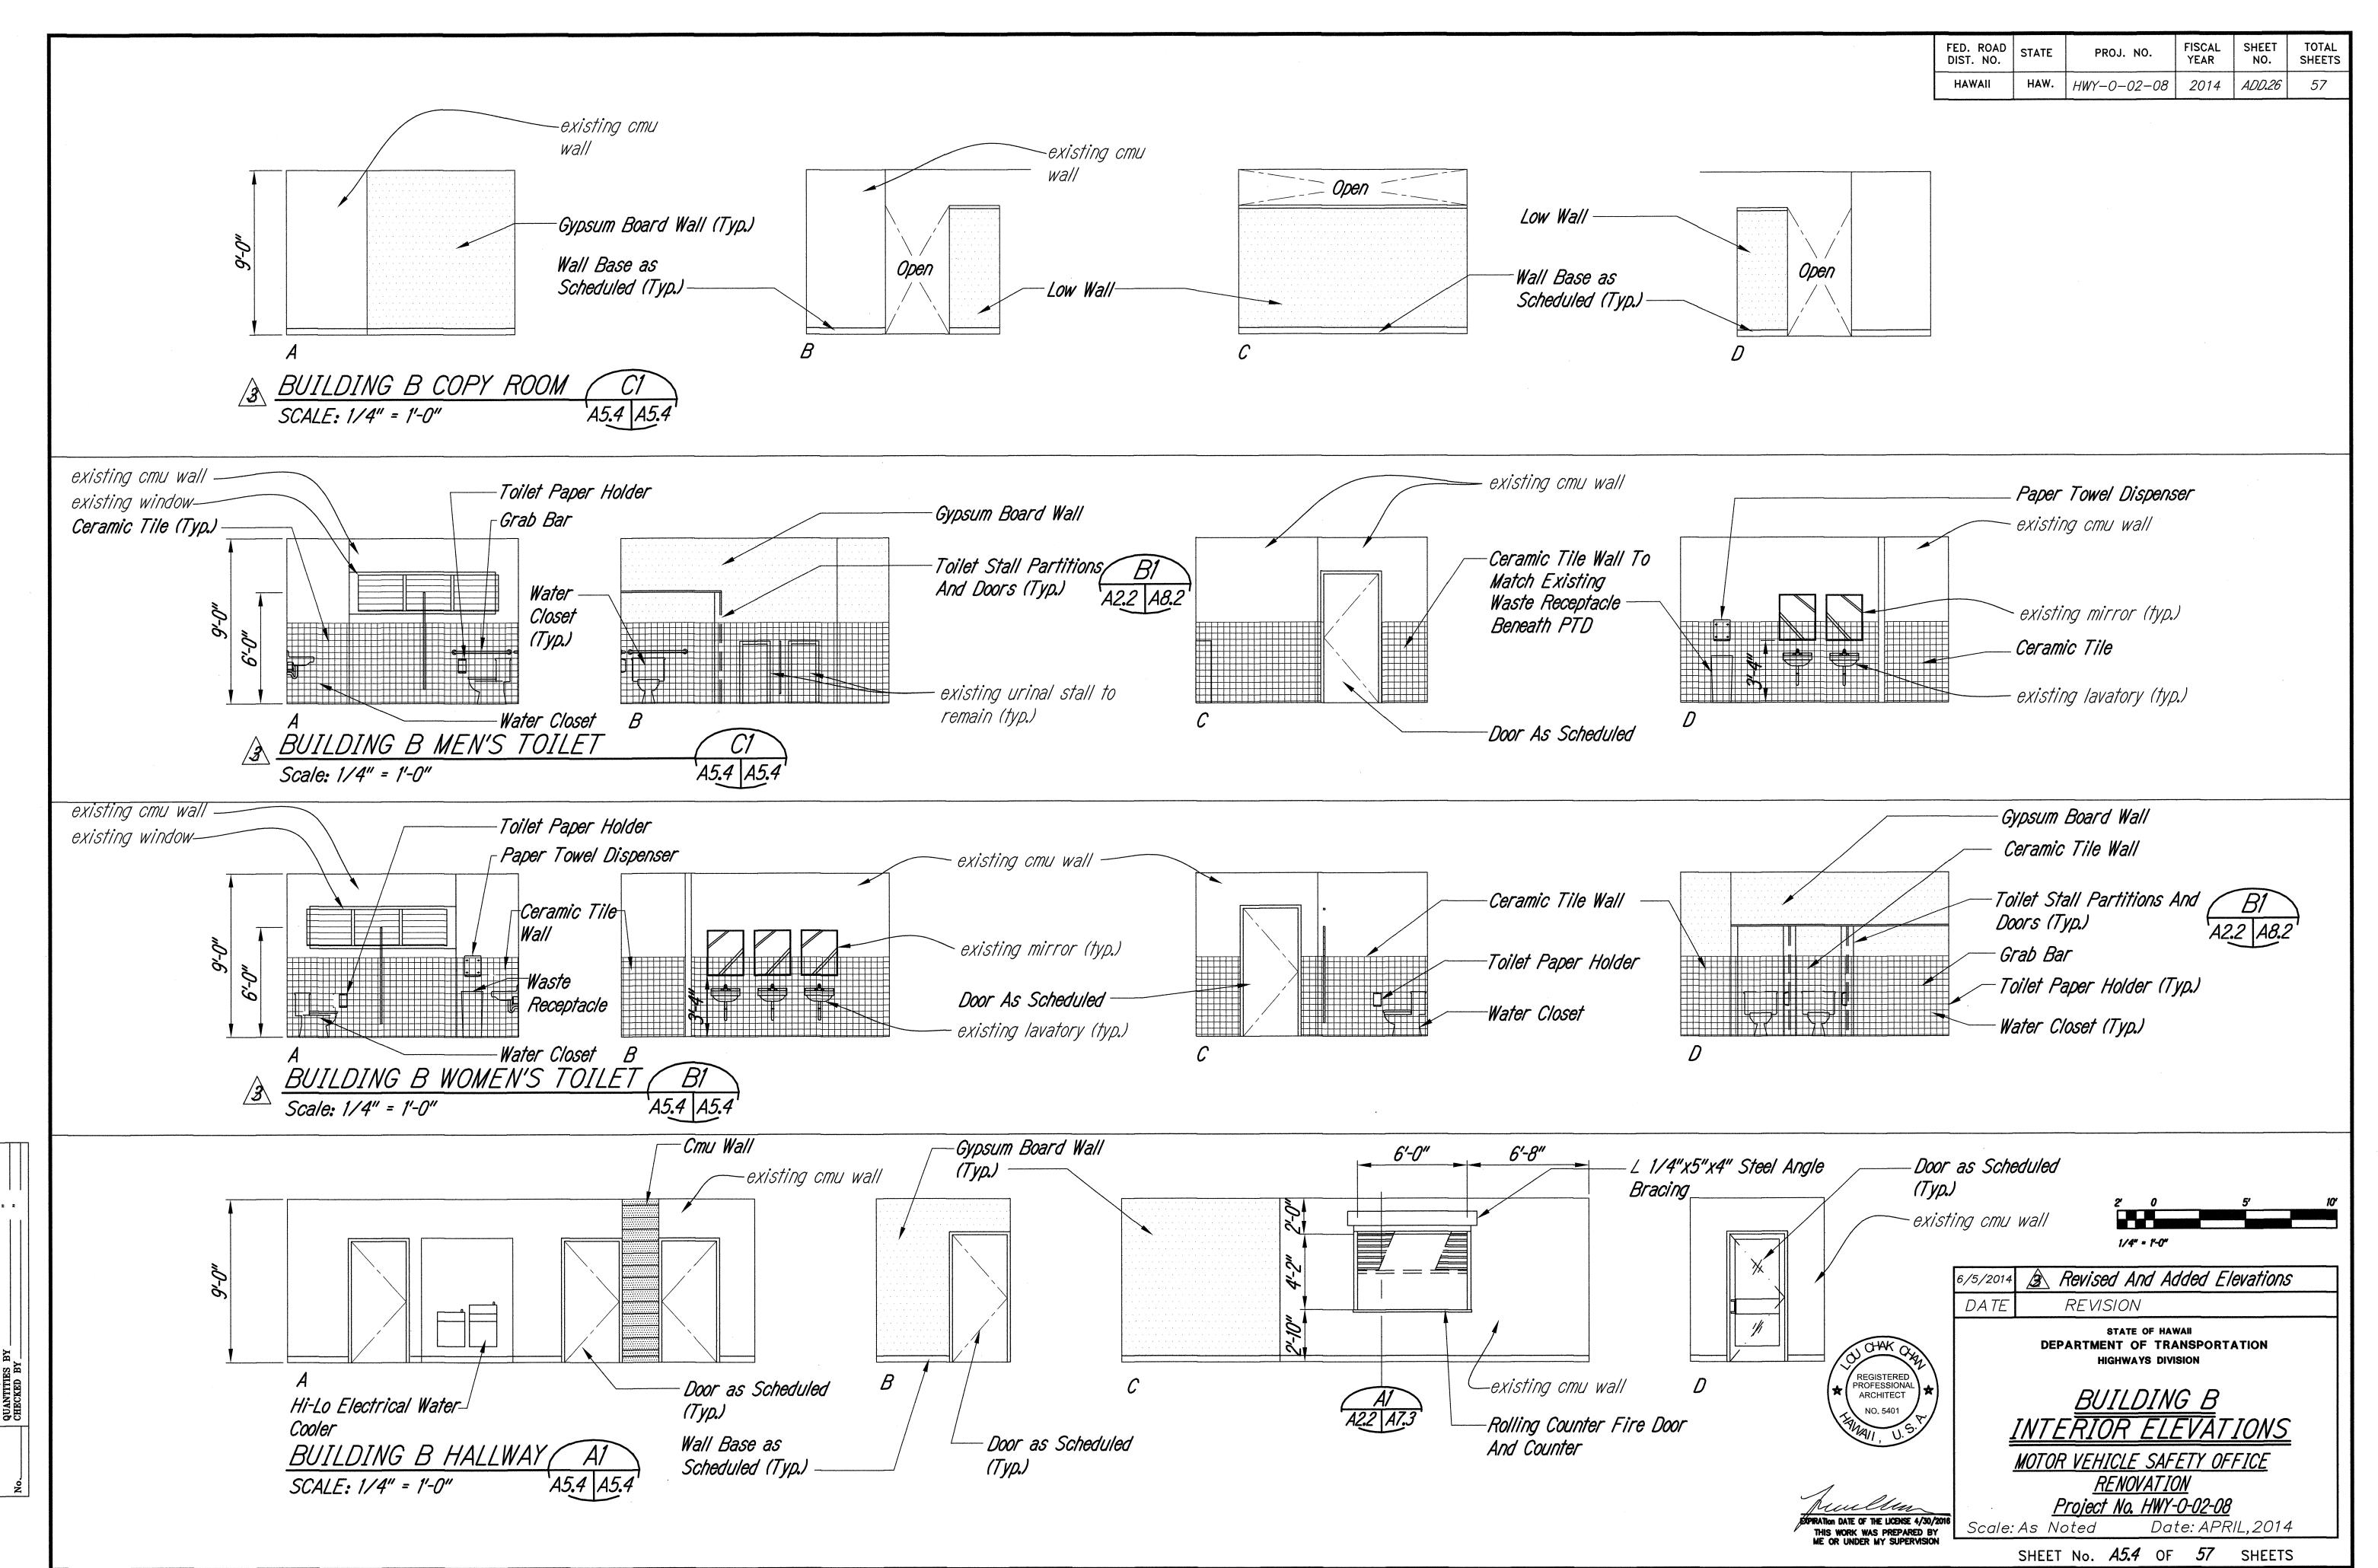

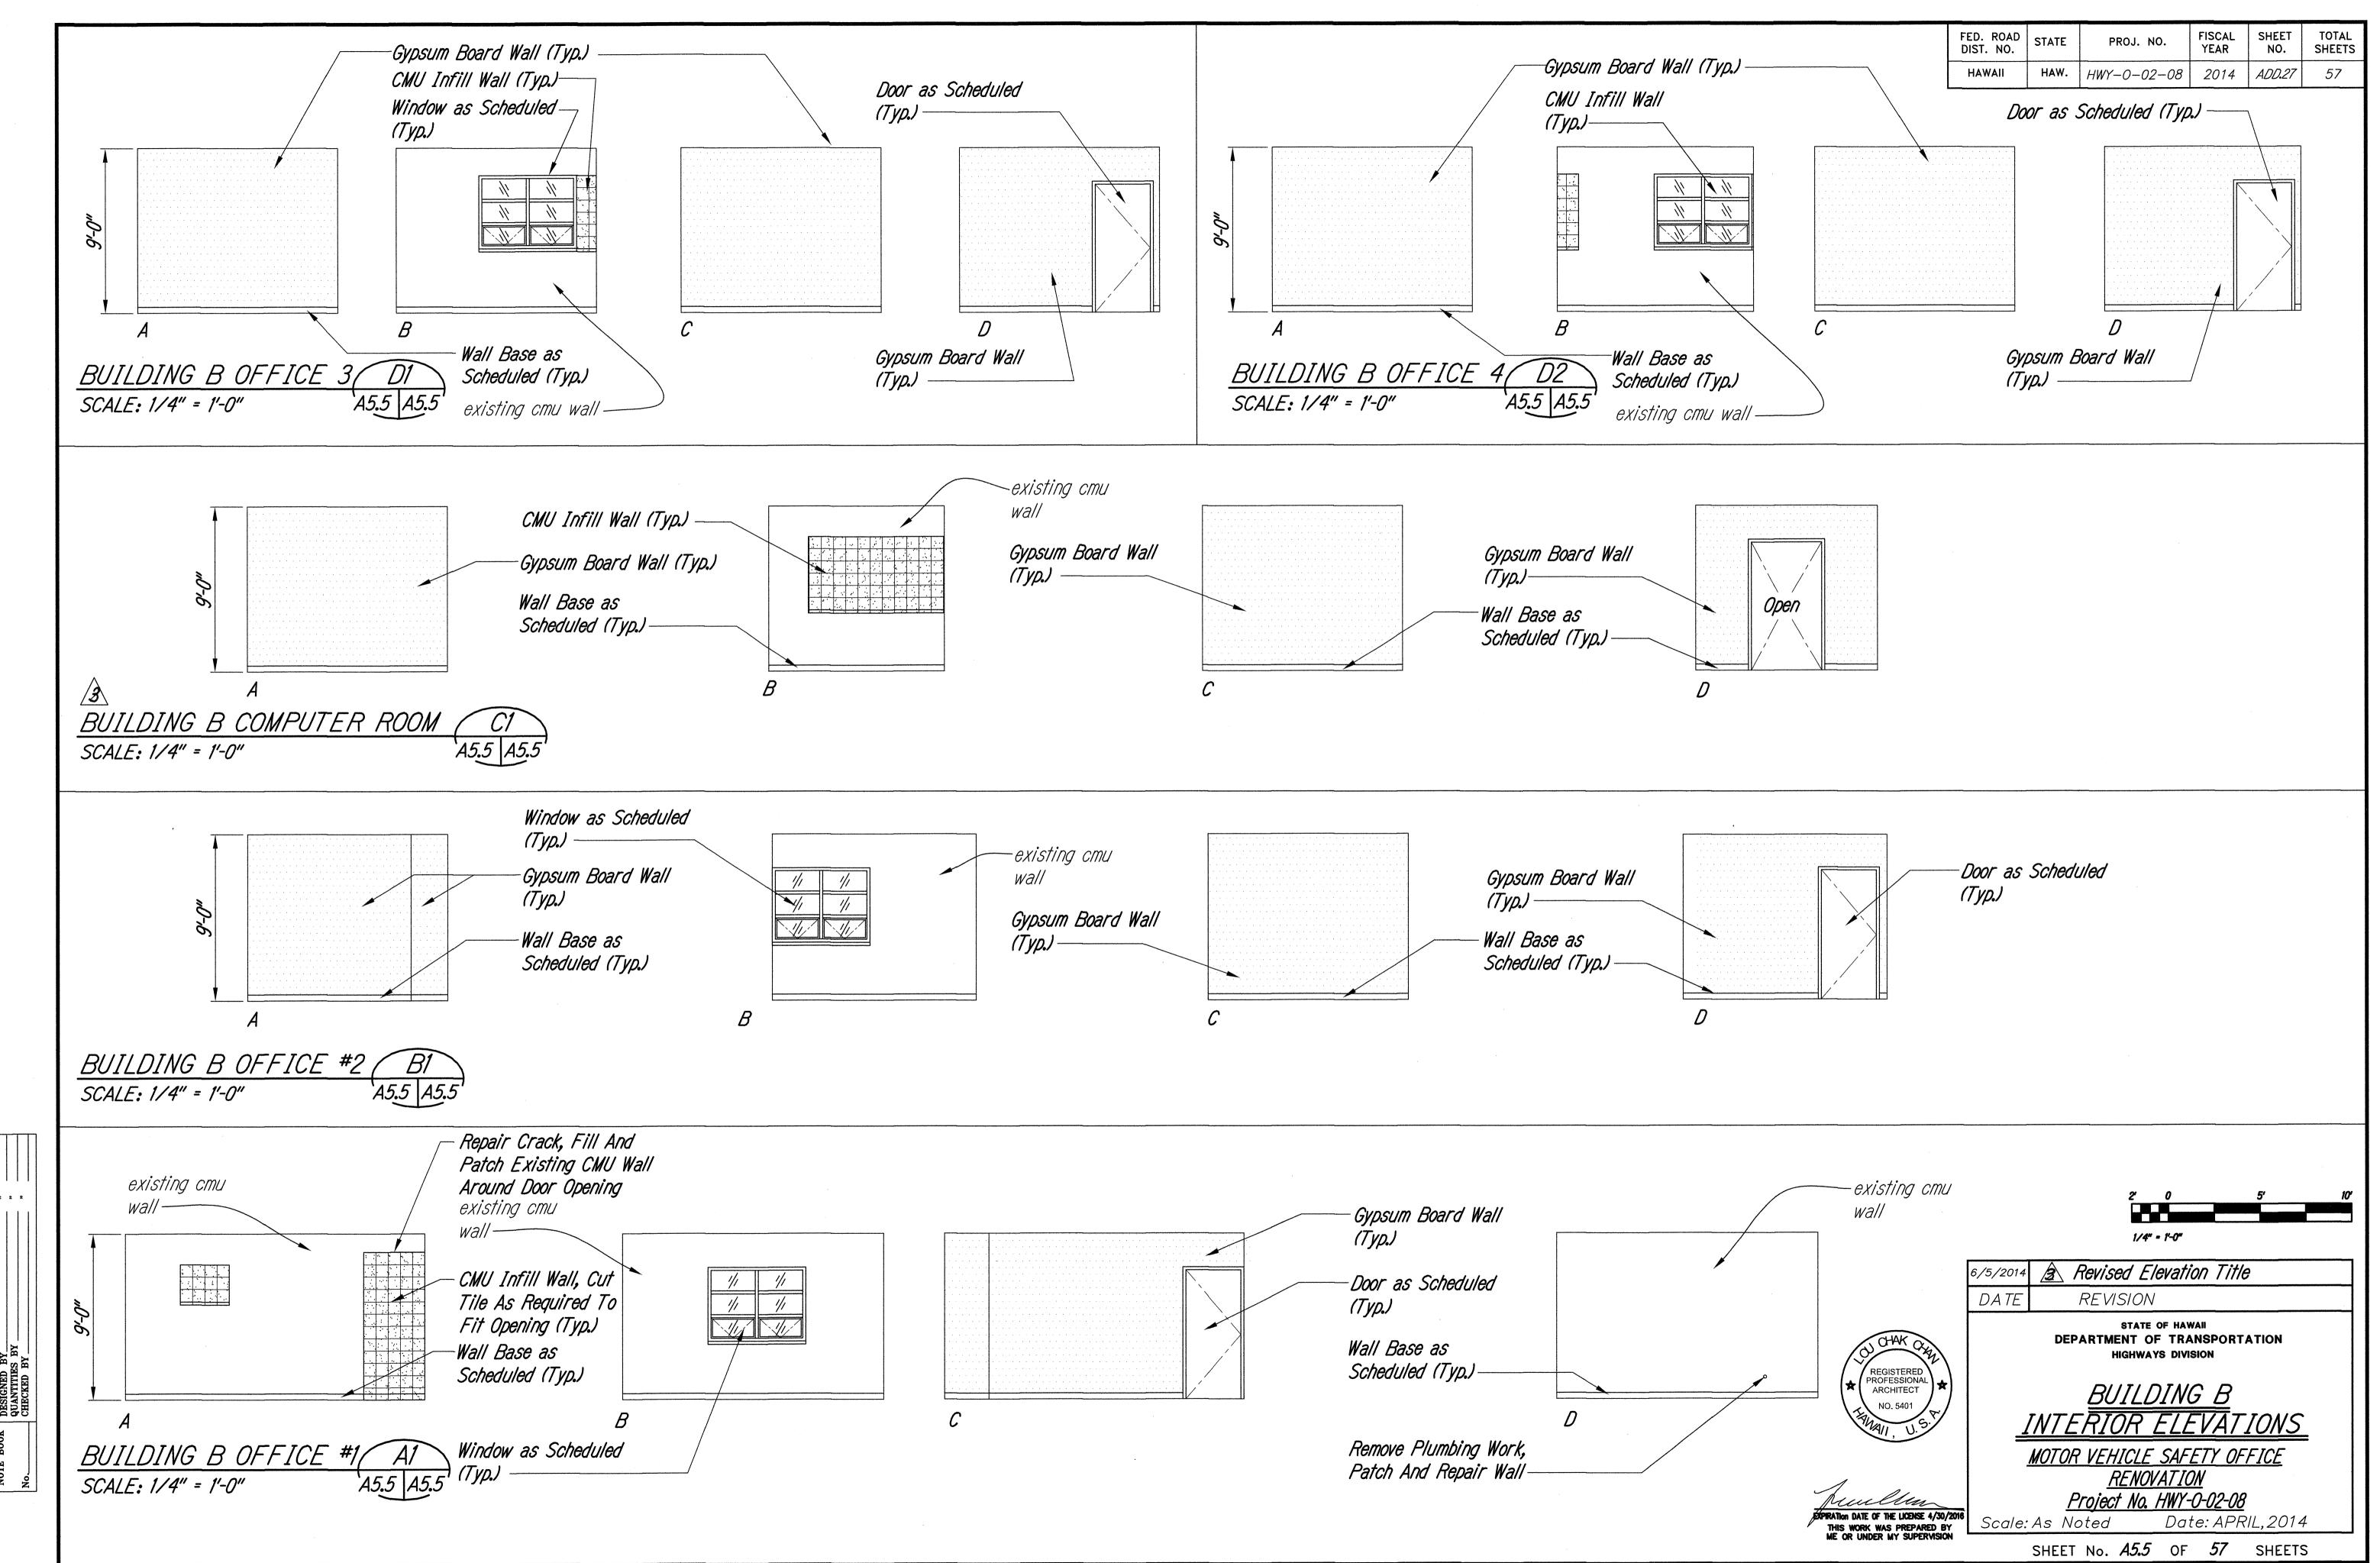

					Door Sched	<i>lule</i>								
Door 101 Number	Location	New/ Existing	Type	Matel Door Panel		Finish	Vision Panel	Door Width	Door Height	Thk.	Fire Rating	Detail	Hardware Group	Remarks
Hamboi	Building A							Antigoria de la constanta de l					***************************************	
101	Reception	New	C	Aluminum / Glass	Aluminum	Clear Anodized	9/16" Tinted Laminated	3'-0"	7'-0"	See Specs		A3,A4/A7.2	001	Alum. Threshold
102	Open Office	New	A	Galvanized Steel	Galvanized Steel	Paint		3'-0"Verify	6'-8"Verify	1-3/4"		A2/A7.2	002	Alum. Threshold
103	Classroom	New	Α	Galvanized Steel	Galvanized Steel	Paint		3'-0"	6'-8"	1-3/4"		A2/A7.2	002	Alum. Threshold
104	Classroom	New	A	Wood	Galvanized Steel	Paint		3'-0"	7'-0"	1-3/4"		A1/A7.2	003	
105	Reception	New	A	Wood	Galvanized Steel	Paint		3'-0"	7'-0"	1-3/4"		A1/A7.2	004	
106	Accessible Toilet	New	A	Wood	Galvanized Steel	Paint		3'-0"	7'-0"	1-3/4"		A1/A7.2	005	Marble Threshold
107	Office #3	New	A	Wood	Galvanized Steel	Paint		3 3'-0"	7'-0"	1-3/4"	***	A1/A7.2	006	
108	Office #2	New	A	Wood	Galvanized Steel	Paint		3'-0"	7'-0"	1-3/4"		A1/A7.2	006	
109	Office #1	New	A	Wood	Galvanized Steel	Paint		3'-0"	7'-0"	1-3/4"		A1/A7.2	006	
110	Toilet	New	A	Galvanized Steel	Galvanized Steel	Paint		\begin{aligned} 3'-0"	6'-8"Verify	1-3/4"		A2/A7.2	014	Alum. Threshold
	Building B											·		
201	Open Office	New	A		Galvanized Steel			3'-0"Verify	6'-8"Verify	1-3/4"		A2/A7.2	013	Alum. Threshold
202	Hallway	New	D	Aluminum / Glass	Aluminum	Clear Anodized	9/16" Tinted Laminated	3'-0"Verify	6'-8"Verify	See Specs	***	A4/A7.2	001	Alum. Threshold
204	Men's Toilet	New	Α	Wood	Galvanized Steel	Paint		3'-0"	6'-8"	1-3/4"	20 Min.	A2/A7.2	010	Marble Threshold
206	Accessible Toilet	New	A	Wood	Galvanized Steel	Paint		3'-0"	6'-8"	1-3/4"	20 Min.	A2/A7.2	011	Marble Threshold
207	Women's Toilet	New	Α	Wood	Galvanized Steel	Paint		3'-0"	6'-8"	1-3/4"	20 Min.	A2/A7.2	010	Marble Threshold
208	Hallway	New	A	Wood	Galvanized Steel	Paint		3'-0"	7'-0"	1-3/4"		A1/A7.2	008	
209	Office #1	New	Α	Wood	Galvanized Steel	Paint		3'-0"	7'-0"	1-3/4"	20 Min.	A1/A7.2	012	
210	Office #2	New	A	Wood	Galvanized Steel	Paint		3'-0"	7'-0"	1-3/4"	20 Min.	A1/A7.2	012	
211	Lounge	New	A	Wood	Galvanized Steel	Paint		3'-0"	7'-0"	1-3/4"	20 Min.	A1/A7.2	007	
212	Office #3	New	A	Wood	Galvanized Steel	Paint		3'-0"	7'-0"	1-3/4"		A1/A7.2	006	
213	Office #4	New	A	Wood	Galvanized Steel	Paint		3'-0"	7'-0"	1-3/4"		A1/A7.2	006	
214	Clerk's Station	New	A	Wood	Galvanized Steel	Paint		3'-0"	6'-8" Verify	1-3/4"		A2/A7.2	006	
215	Clerk's Station	New	В	Stainless Steel	Stainless Steel	See Specs		6'-0"	4'-2"	See Specs	1 1/2 Hr.	A1/A7.3	-	

Notes:


1. Door Dimensions And Conditions Shown In Door Schedule And Details Are Only Approximate, Contractor Shall Be Fully Responsible For Measurement And Verification Of All Door Openings, Sizes, Conditions Of Wall And Threshold, Submit Shop Drawing Based On Actual Dimensions And Conditions Per Contractor's Field Measurement, Obtain Approval Prior To Any Ordering Of Materials.

2. All Locksets, Unless Specified Otherwise, Shall Be Mounted At 3'-0" Height Above Finish Floor. All Pre-Existing Cutouts, Notches, Corings In Existing Door, If Not Used By New Hardware, Shall Be Filled, Patched, Refinished, Provide Offset Cover Plate For Mounting Of New Lockset.

					Window	Schedule					1
Window	Location	New/	Туре	Frame	Frame	Glazing	Window	Opening	Screen 🛊 Frame	Remarks	
W 1 Number		Existing		Material	Finish		Width (W)	Height (H)			(7)
1	Building A Reception And Open Office	Existing	A	Aluminum	Clear Anodized	Existing	5'-4" ±	6'-8" ±			
2	Building A Classroom And Open Office	Existing	В	Aluminum		Existing		6'-8" ±	Security Screen and Frame	Repaint Security Screen and Frame]
3	Building A Existing Toilet, Office #1	New 3	3 G	Aluminum		3 Obscure	2'-8"	2'-0"		Paint Security Screen and Frame	
4	Building A Existing Toilet, Office #1	New	G	Aluminum	Clear Anodized	Obscure	2'-8"	2'-0"	Galvanized Metal L1/4"x2"x2" Steel Frame And Expanded Metal Screen	Paint Security Screen and Frame	- Si
5	Building B Clerk's Station	New	D	Aluminum	Clear Anodized	9/16" Tinted Laminated	8'-0" ±	4'-0" ±	Insect Screen and Frame		1
6	Building B Office #1, #2, #3 And #4	New	E	Aluminum	Clear Anodized	9/16" Tinted Laminated	5'-4" ±	4'-0" ±	Insect Screen and Frame		
7	Building B Men's And Women's Toilet	Existing	F	Aluminum	Clear Anodized	Existing	8'-0" ±	2'-0" ±	Security Screen and Frame	Repaint Security Screen and Frame	-
											-

Notes:

1. Dimensions And Conditions Shown Are Only For Reference. Contractor Shall Field Measure And Verify Dimensions Of All Window Openings To Ensure Fitting Of The Windows. Contractor Shall Be Solely Responsible For Any Replacement Or Retro-Fit Work. Contractor To Submit Shop Drawings Based On Actual Window Opening Sizes And Obtain Approval Prior To Any Fabrication.

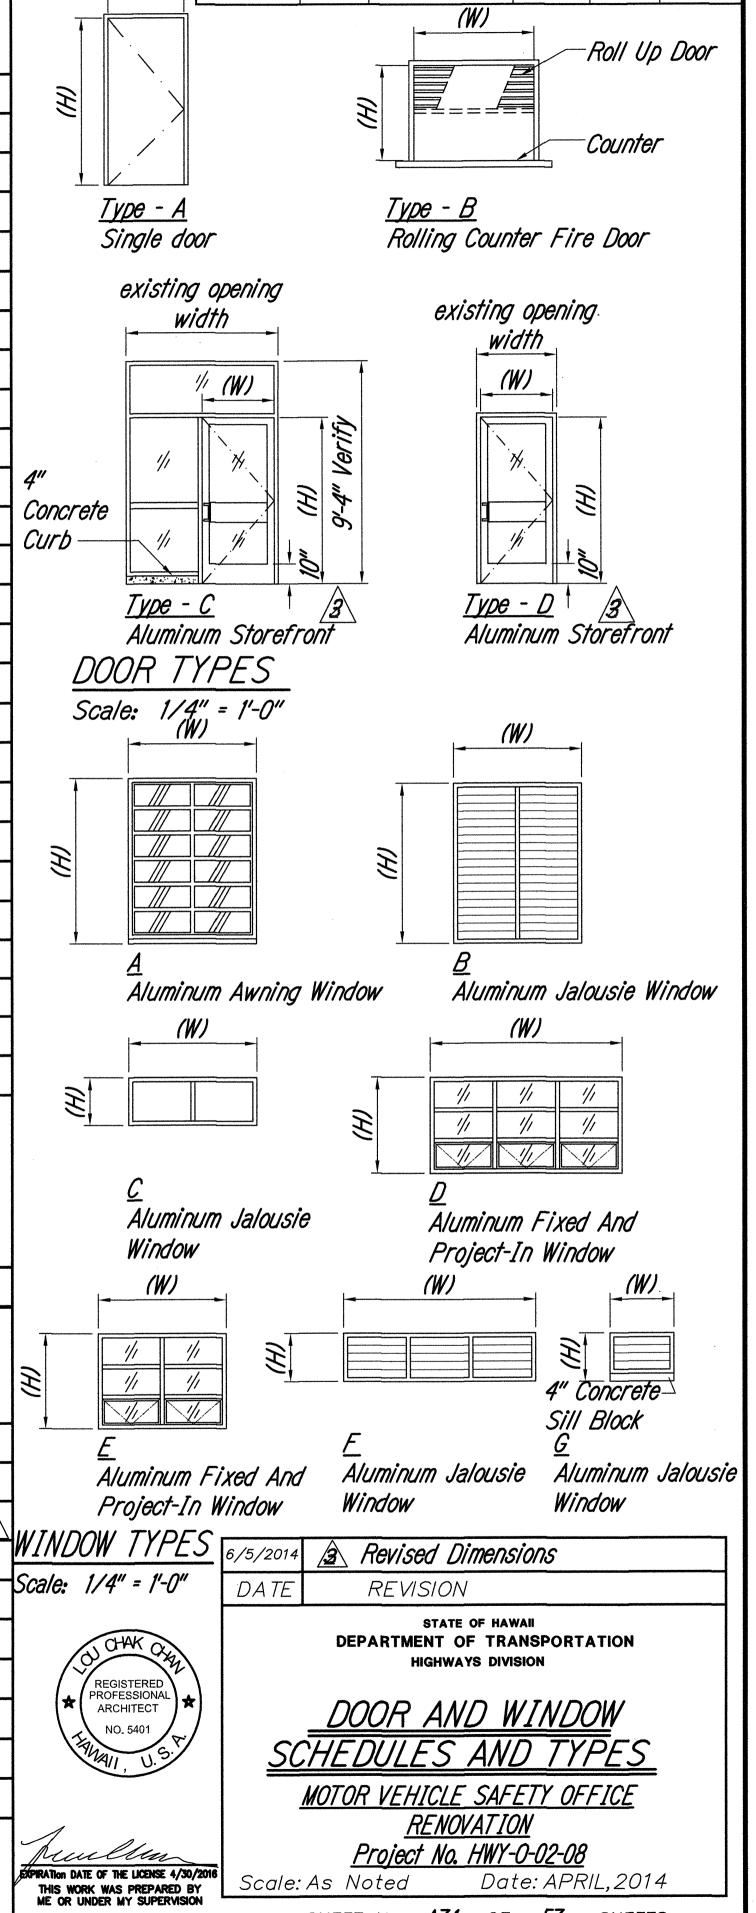



FISCAL YEAR


2014

FED. ROAD STATE

SHEET No. A7.1 OF 57 SHEETS

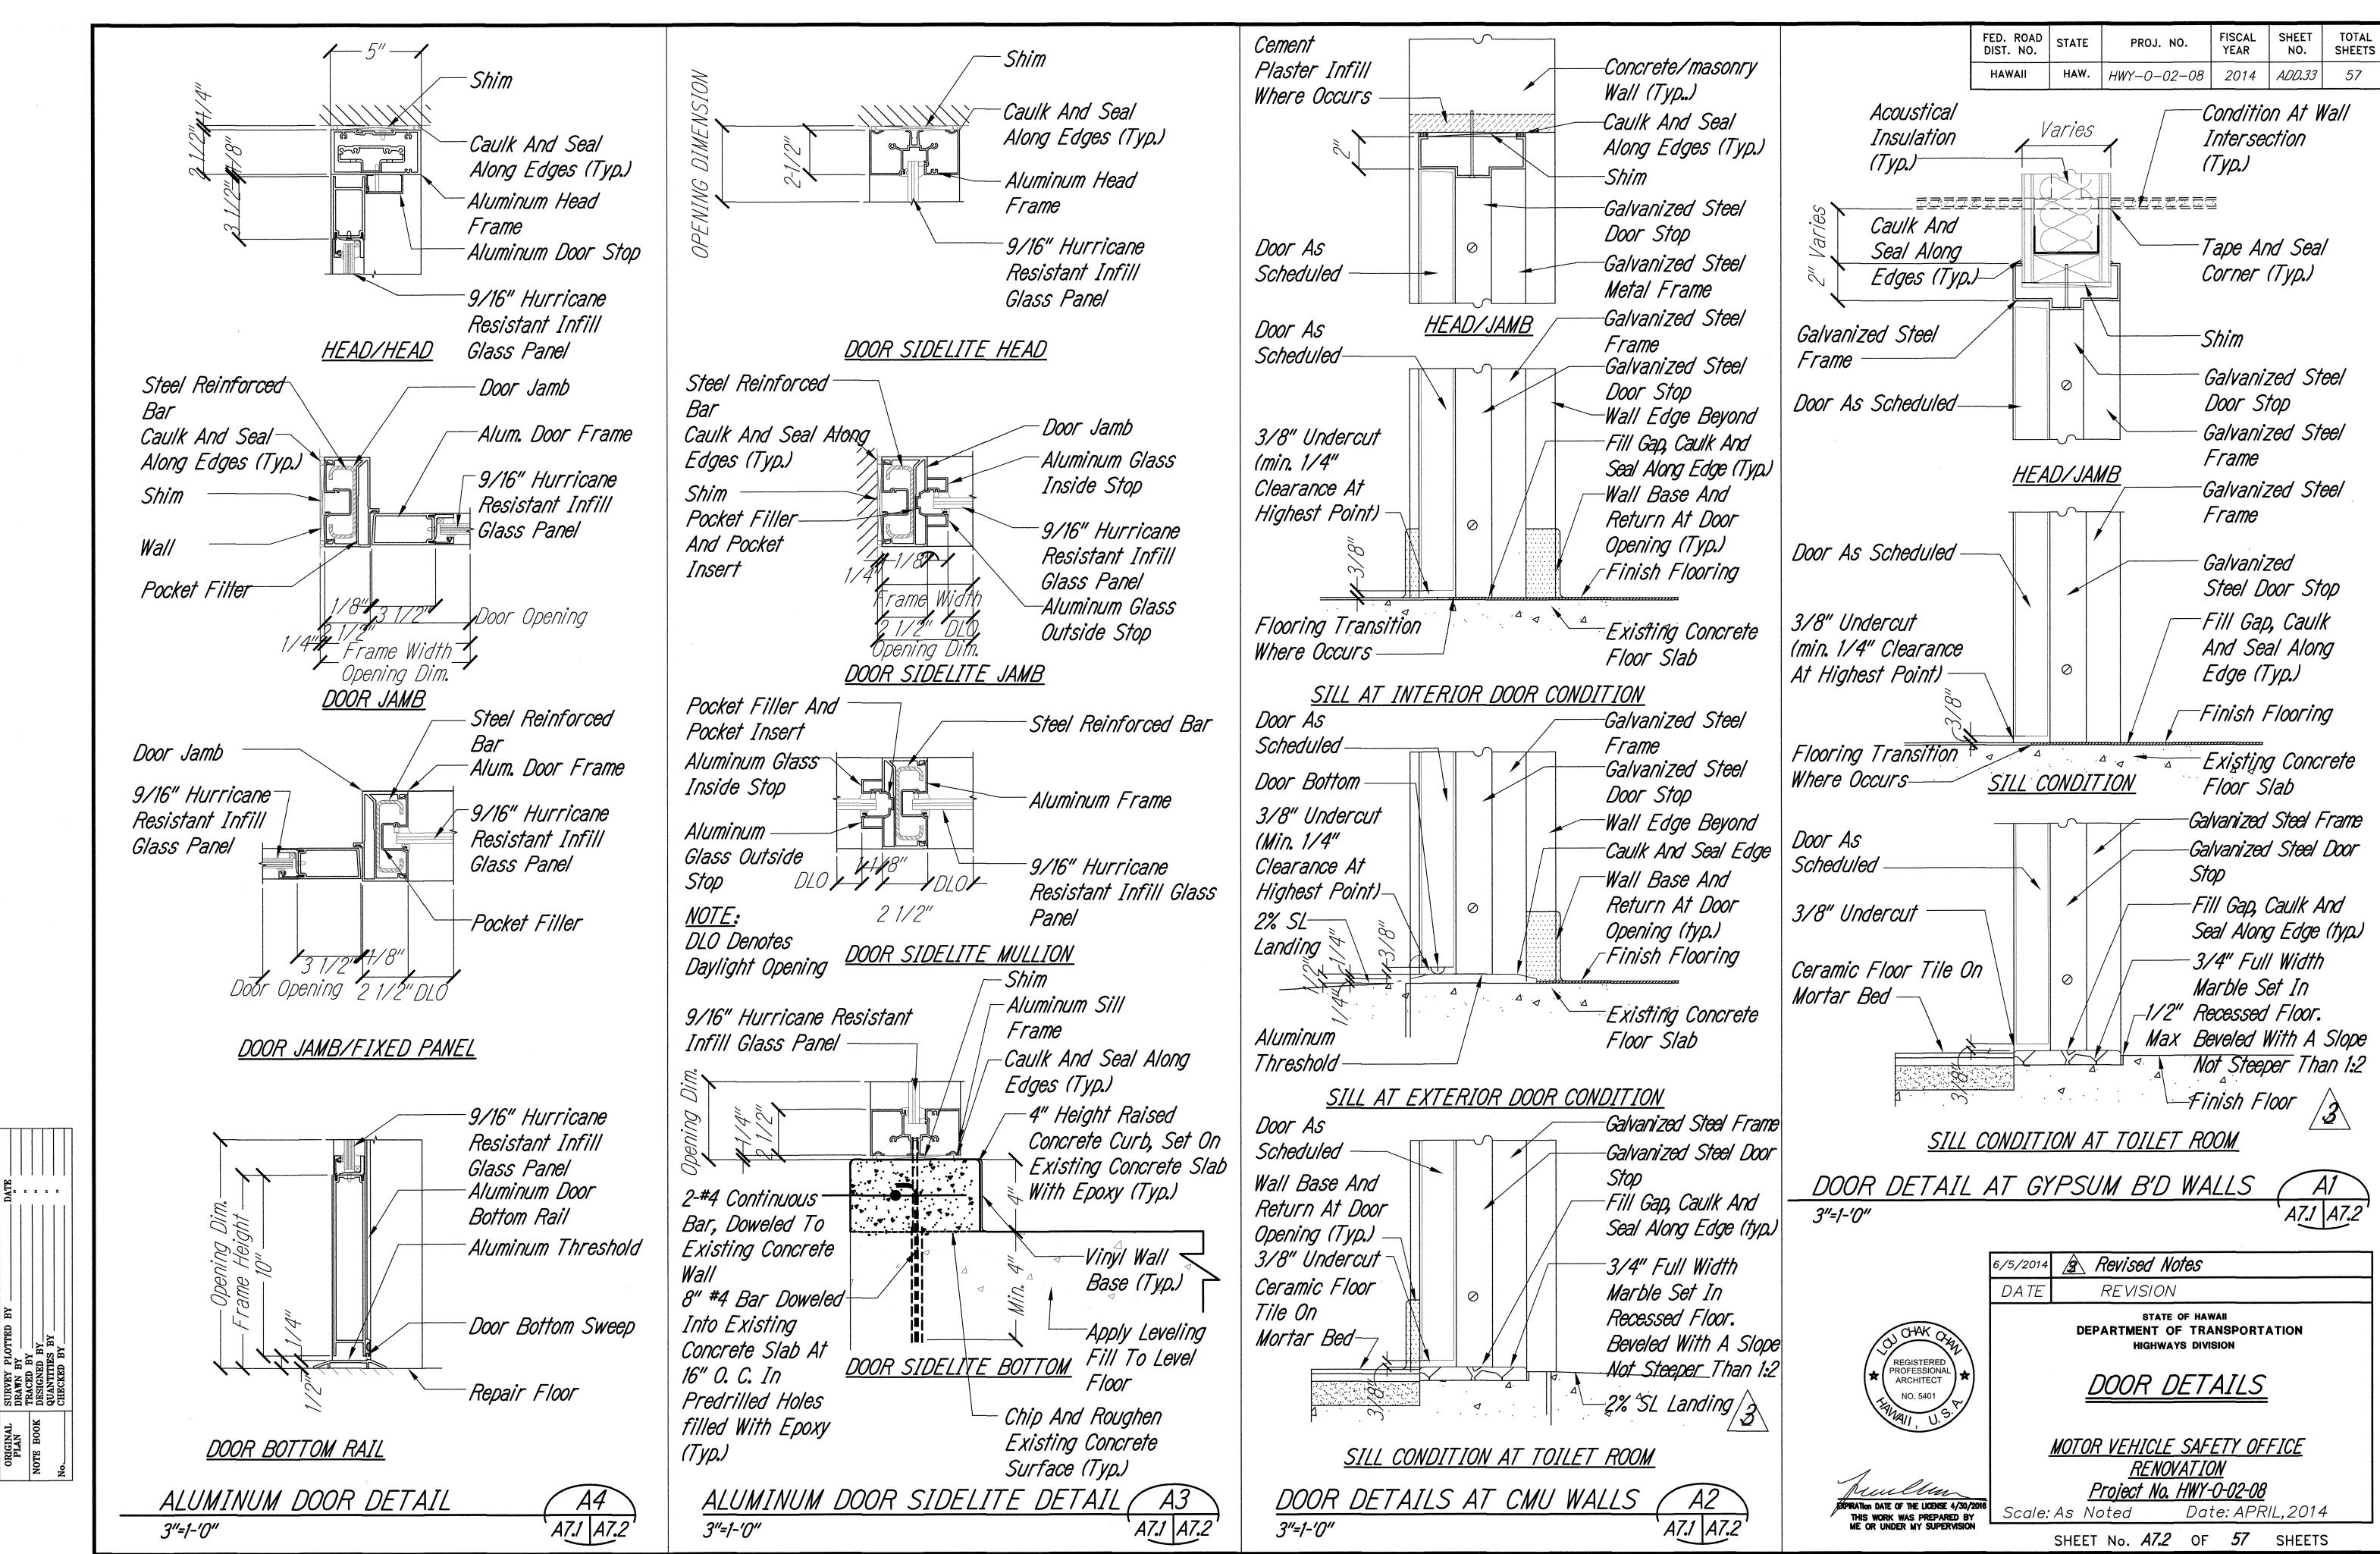

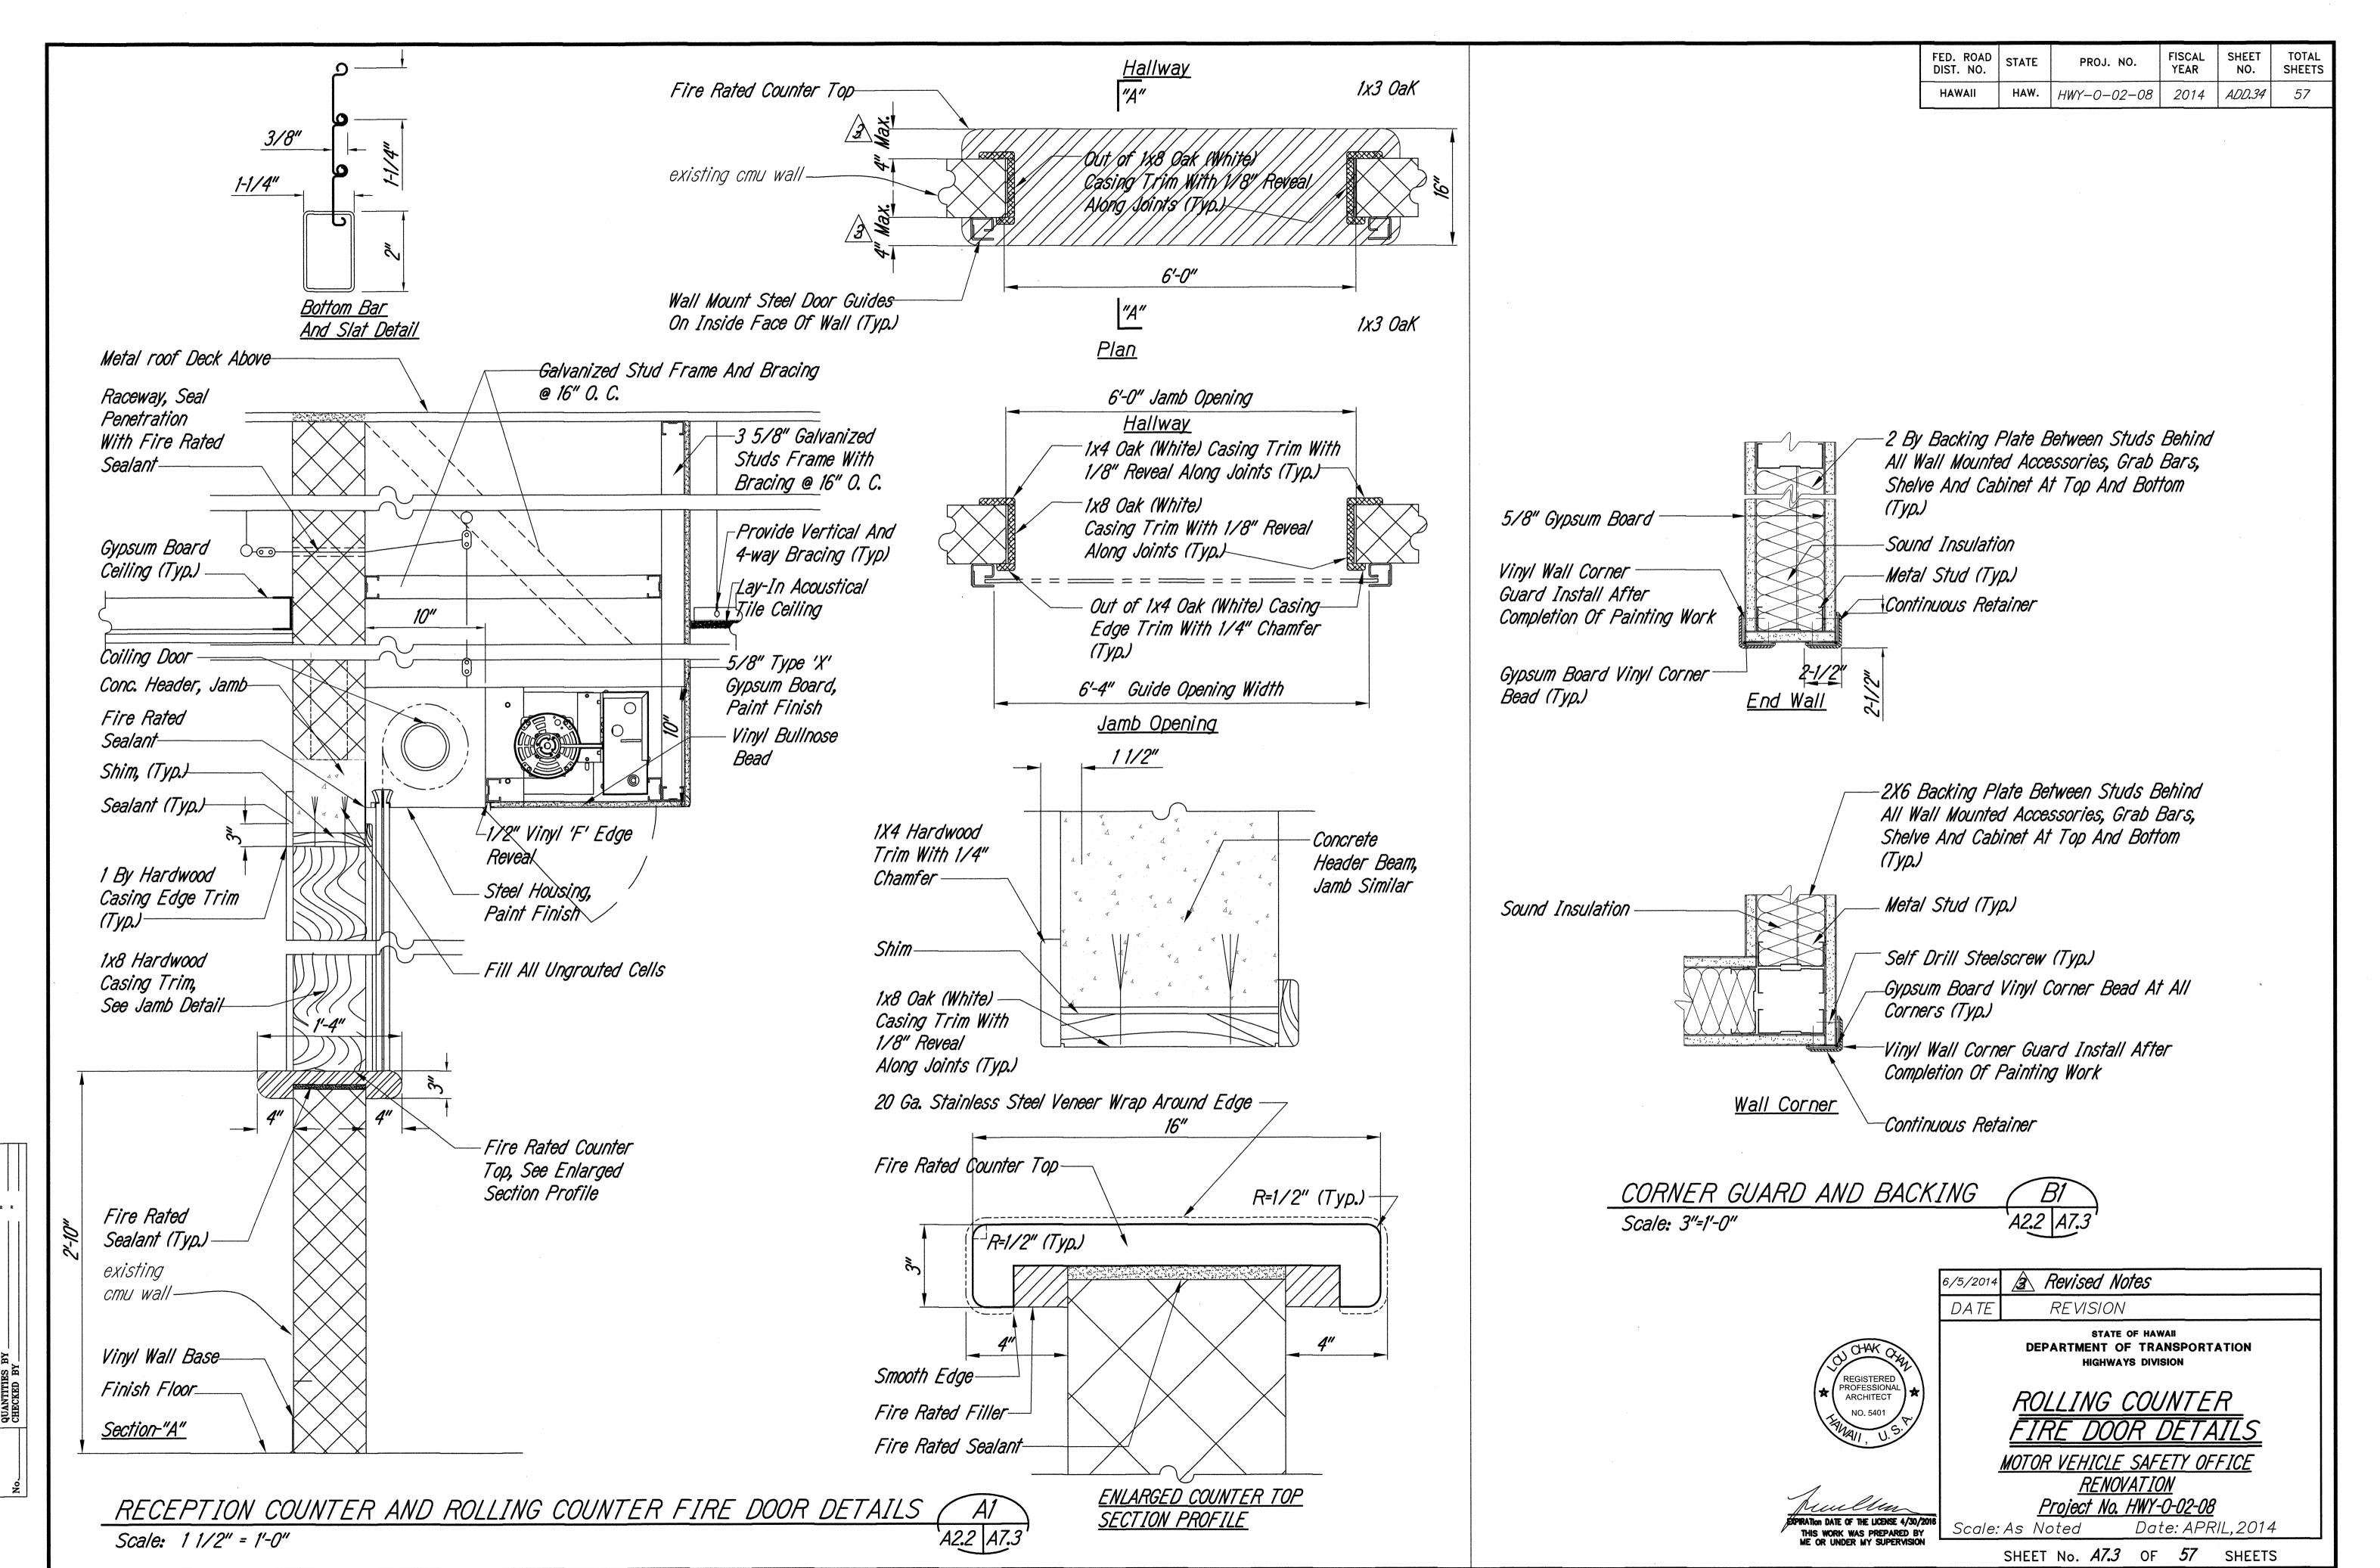

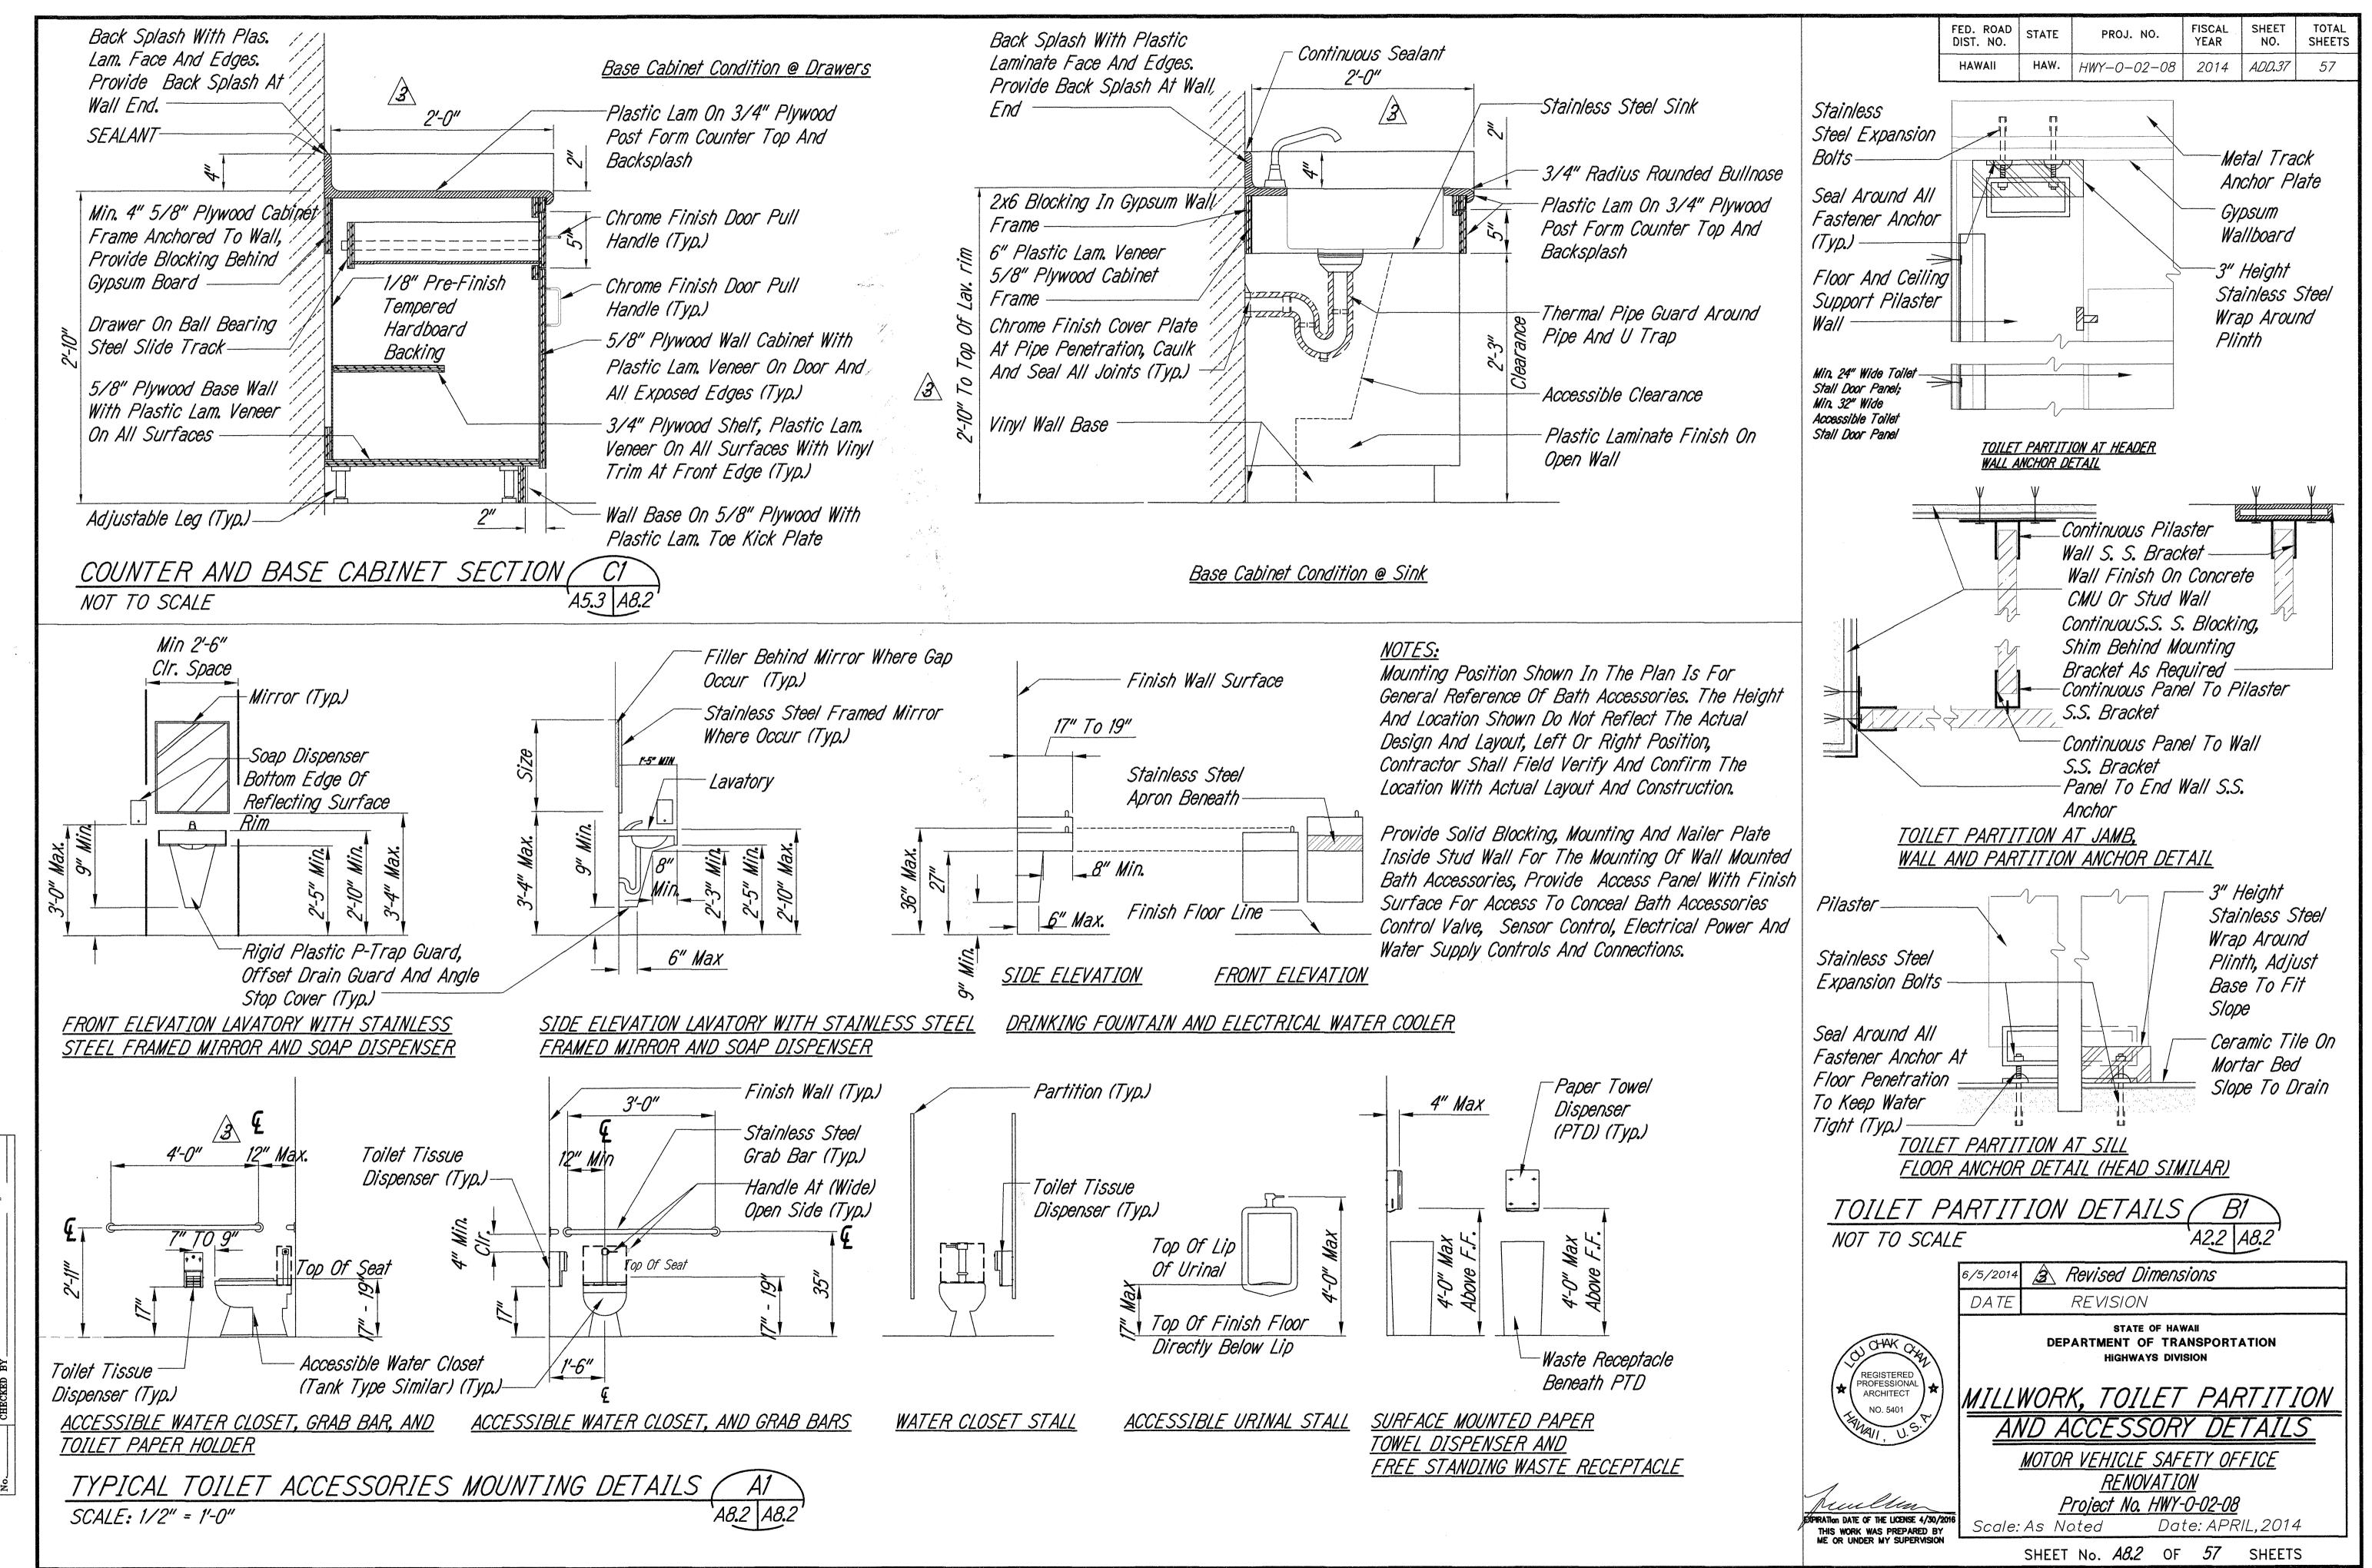

EQUIPMENT SCHEDULE

Inverter Air Conditioning System

Fan Coil Unit: Horizontal Ceiling Concealed

Factory Assembled Ceiling Concealed Horizontal Ducted Unit, Direct Expansion Type With Anti-Corrosion Cooling Coil Of Copper Coils and Aluminum Fins, Corrosion Protected Casing with Finish, Microprocessor Control With Self Diagnosing and 24-Hour Timer, Mounting Brackets, Built-in Condensate, Anti-Microbial Filter, Auto Restart, Motor, 3-Speed Centrifugal Fans, and Wired Standard Thermostat. See Specifications For Additional Requirements.

Fan Coil UNit: Wall Mounted


Factory Assembled Unit, Wall Mounted Direct Expansion Type With Anti-Corrosion Cooling Coil Of Copper Coils and Aluminum Fins, Corrosion Protected Casing with Finish, Microprocessor Control With Self-Diagnosing and 24-Hour Timer, Mounting Brackets, Built-in Condensate Pump, Anti-Microbial Filter, Auto Restart Air Sweep and Louver Control, 5-Speed Centrifugal Fans, and Wired Standard Thermostat. See Specifications For Additional Requirements.

Condensing Units:

Air Cooled Condensing Unit Complete With Variable Speed DC Inverter Scroll Compressors, Galvanized Steel With Powder Coated Cabinet, Direct Driven Propeller Horizontal Discharge Condenser Fan, PVC Coated Wire Guard, Copper Tube With Aluminum Fins Condenser Coil, Puron R410A Refrigerant, Internal Overloads, TXV Valve, And Support Feet With Isolation Pads. See Specifications For Additional Requirements. Provide Corrosion Protection For Condenser Coil. Protect Finned Tubes With Blygold Poulal Coating, Cabinet Surfaces For Air Condtioning Unit Shall Be Coated With Ameron PSX 700. Replace All Hardware With Stainless Steel Hardware.

Note: Fan Coil Units Power From Respective Condensing Units; Disconnects Required At Fan Coil Unit.

Fcu No.	Tbtuh	Sbtuh	Sa Cfm	Oa Cfm	Ent Fdb	Air Fwb	Amb Air F	Sy. Fla	stem Ui Watts	nits MOCP	Volt/Ph/Cyc	Fcu/Cu Model or Approved Equal	Remarks
1	17,100	dividures da	650		80	67	95	7.5	1650	20	208-230/1/60	Panasonic CS-S18NKU-1 Panasonic CU-S18NKU-1	New, 26.0/115.0 Lbs, 17.5 Seer
2	11,900	6.0F-000-700-	425		80	67	95	<i>5.1</i>	1000	15	208-230/1/60	Panasonic CS-S12NKUW-1 Panasonic CU-S12NKUW-1	New, 20.0/82.0 Lbs, 17.5 Seer
3	18,000	******	425		80	67	95	9.0		20	208-230/1/60	Fujitsu ASU18CL Fujitsu AOU18CL	(E), 20.0/88.0 Lbs, 19.0 SEER
4a	12,000	on the same	330		80	67	95	0.19	22		208-230/1/60	Fujitsu ASU12RLF	(E), 21.0 Lbs
4b	12,000	**********	330		80	67	95	0.19	22		208-230/1/60	Fujitsu ASU12RLF	(E), 21.0 Lbs
5	24,000		650	100 div 100	80	67	95	10.4	00.00.00	20	208-230/1/60	Fujitsu ASU24CL Fujitsu AOU24CL1	(E), 31.0/88.0 Lbs, 17.5 Seer
6	24,000	MP MP AND MIN	650		80	67	95	11.9	2840	25	208-230/1/60	Panasonic CS-S24NKUA Panasonic CU-S24NKUA	New, 26.0/132.0 Lbs, 17.5 Seer
7	24,000		650		80	67	95	10.4		20	208-230/1/60	Fujitsu ASU24CL Fujitsu AOU24CL1	(E), 31.0/88.0 Lbs, 17.5 Seer
8	9,000		330	-	80	67	95	6.2	an name	15	208-230/1/60	Mitsubishi MSYGE09NA Mitsubishi MUYGE09NA	(E), 22.0/66.0 Lbs, 21.0 Seer
9	12,000	100 (All 1914 PM	330		80	67	95		, 	400 100	208-230/1/60	Fujitsu ASU12CL Fujitsu AOU12CL	Existing, 21.0 Lbs
10	17,100	*****	650		80	67	95	7.5	1650	20	208-230/1/60	Panasonic CS-S18NKU-1 Panasonic CU-S18NKU-1	New, 26.0/115.0 Lbs, 17.5 Seer
11	33,000	*********	700		80	67	95	17.3		30	208-230/1/60	Fujitsu ASU36CLX1 Fujitsu AOU36CLX1	(E), 31.0/150 Lbs, 15.5 Seer
12	33,000	\$	700		80	67	95	17.3		30	208-230/1/60	Fujitsu ASU36CLX1 Fujitsu AOU36CLX1	(E), 31.0/150 Lbs, 15.5 Seer
13	33,000	<u> </u>	700		80	67	95	17.3		30	208-230/1/60	Fujitsu ASU36CLX1 Fujitsu AOU36CLX1	(E), 31.0/150 Lbs, 15.5 Seer
14	34,000	ette quis ette	630		80	67	95	21.9	4000	45	208-230/1/60	Panasonic CS-KS36NKU Panasonic CU-KS36NKU	New, 32.0/183.0 Lbs, 16.0 Seer
15	34,000	****	630		80	67	95	21.9	4000	45	208-230/1/60	Panasonic CS-KS36NKU Panasonic CU-KS36NKU	New, 32.0/183.0 Lbs, 16.0 Seer
16a	12,000	A11-A11-A11-A11-A11-A11-A11-A11-A11-A11	280		80	67	95	0.17	35		208-230/1/60	Panasonic CS-MKS12NKU	New, 19.8 Lbs
16b	12,000	400 and 6100	280		80	67	95	<i>0.</i> 17	35	400 604 400	208-230/1/60	Panasonic CS-MKS12NKU	New, 19.8 Lbs
16c	12,000		280		80	67	95	0.17	35		208-230/1/60	Panasonic CS-MKS12NKU	New, 19.8 Lbs
OA-A1	24,000		670		80	67	95	15.0	2600	F cu-15 Cu-30	208-230/1/60	Panasonic S-26PF1U6 Panasonic U-26PF1U6	New, 71.0/128.0 Lbs, 14.0 Seer
OA-A1	24,000		670		80	67	95	15.0	2600	F cu-15 Cu-30	208-230/1/60	Panasonic S-26PF1U6 Panasonic U-26PF1U6	New, 71.0/128.0 Lbs, 14.0 Seer
OA-A1	24,000		670		80	67	95	15.0	2600	F cu-15 Cu-30	208-230/1/60	Panasonic S-26PF1U6 Panasonic U-26PF1U6	New, 71.0/128.0 Lbs, 14.0 Seer

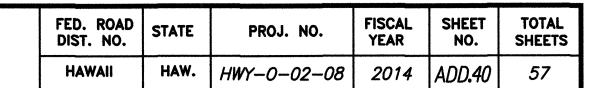

<u>EQUIPMENT SCHEDULE - CONTINUE</u>

Condensing Units:

CU NO.	TBTUH	ENT	AIR	AMB	CO	MP	PW	R SU	P	VOLT/PH/CYC	CU MODEL	REMARKS
	101011	FDB	FWB	AIR F	RLA	LRA	RLA	Watt	MUCP	VOLITITITOTO	OR APPROVED EQUAL	
Cu-4	24,000	80	67	95		4	13.7	1760	25	208-230/1/60	Fujitsu AOU24RL	17.0 Seer, 124 LBS.
Cu-16	28,600	80	67	95			12.6	2600	20	208-230/1/60	Panasonic CU-4KS31NBU	17.6 Seer, 175 LBS.

Exhaust Fan:

Ceiling Fan Shall Be Direct Driven Centrigugal Type With Galvanized Steel Housing With Acoustic Insulation, Motor Vibration Isolators, Integral Wiring Box, Disconnect Receptacle, Convertible Discharge, Backdraft Damper, Mounting Bracket, Speed Controller, NonOverloading Open Drip Motor With Built-In Thermal Protection And Non-yellowing High Impact Styrene Molded Grille.

EF NO.	CFM	SP	RPM	Watts	VOLT/PH/CYC	WT., LBS	Remarks
1	150	0. 25	1365	75	120-1-60	275	Loren Cook GC-320 Or Approved Equal
		,					





THIS WORK WAS PREPARED BY

ME OR UNDER MY SUPERVISION

Revised Fcu Cfm & Delete Ef-2 REVISIONS


> STATE OF HAWAII DEPARTMENT OF TRANSPORTATION HIGHWAYS DIVISION


MOTOR VEHICLE SAFETY OFFICE <u>RENOVATION</u> Project No. HWY-0-02-08


Scale:As Noted


Date: April 2014


SHEET No. M1.2 OF 57 SHEETS

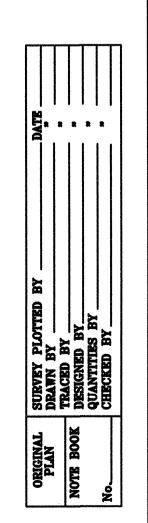

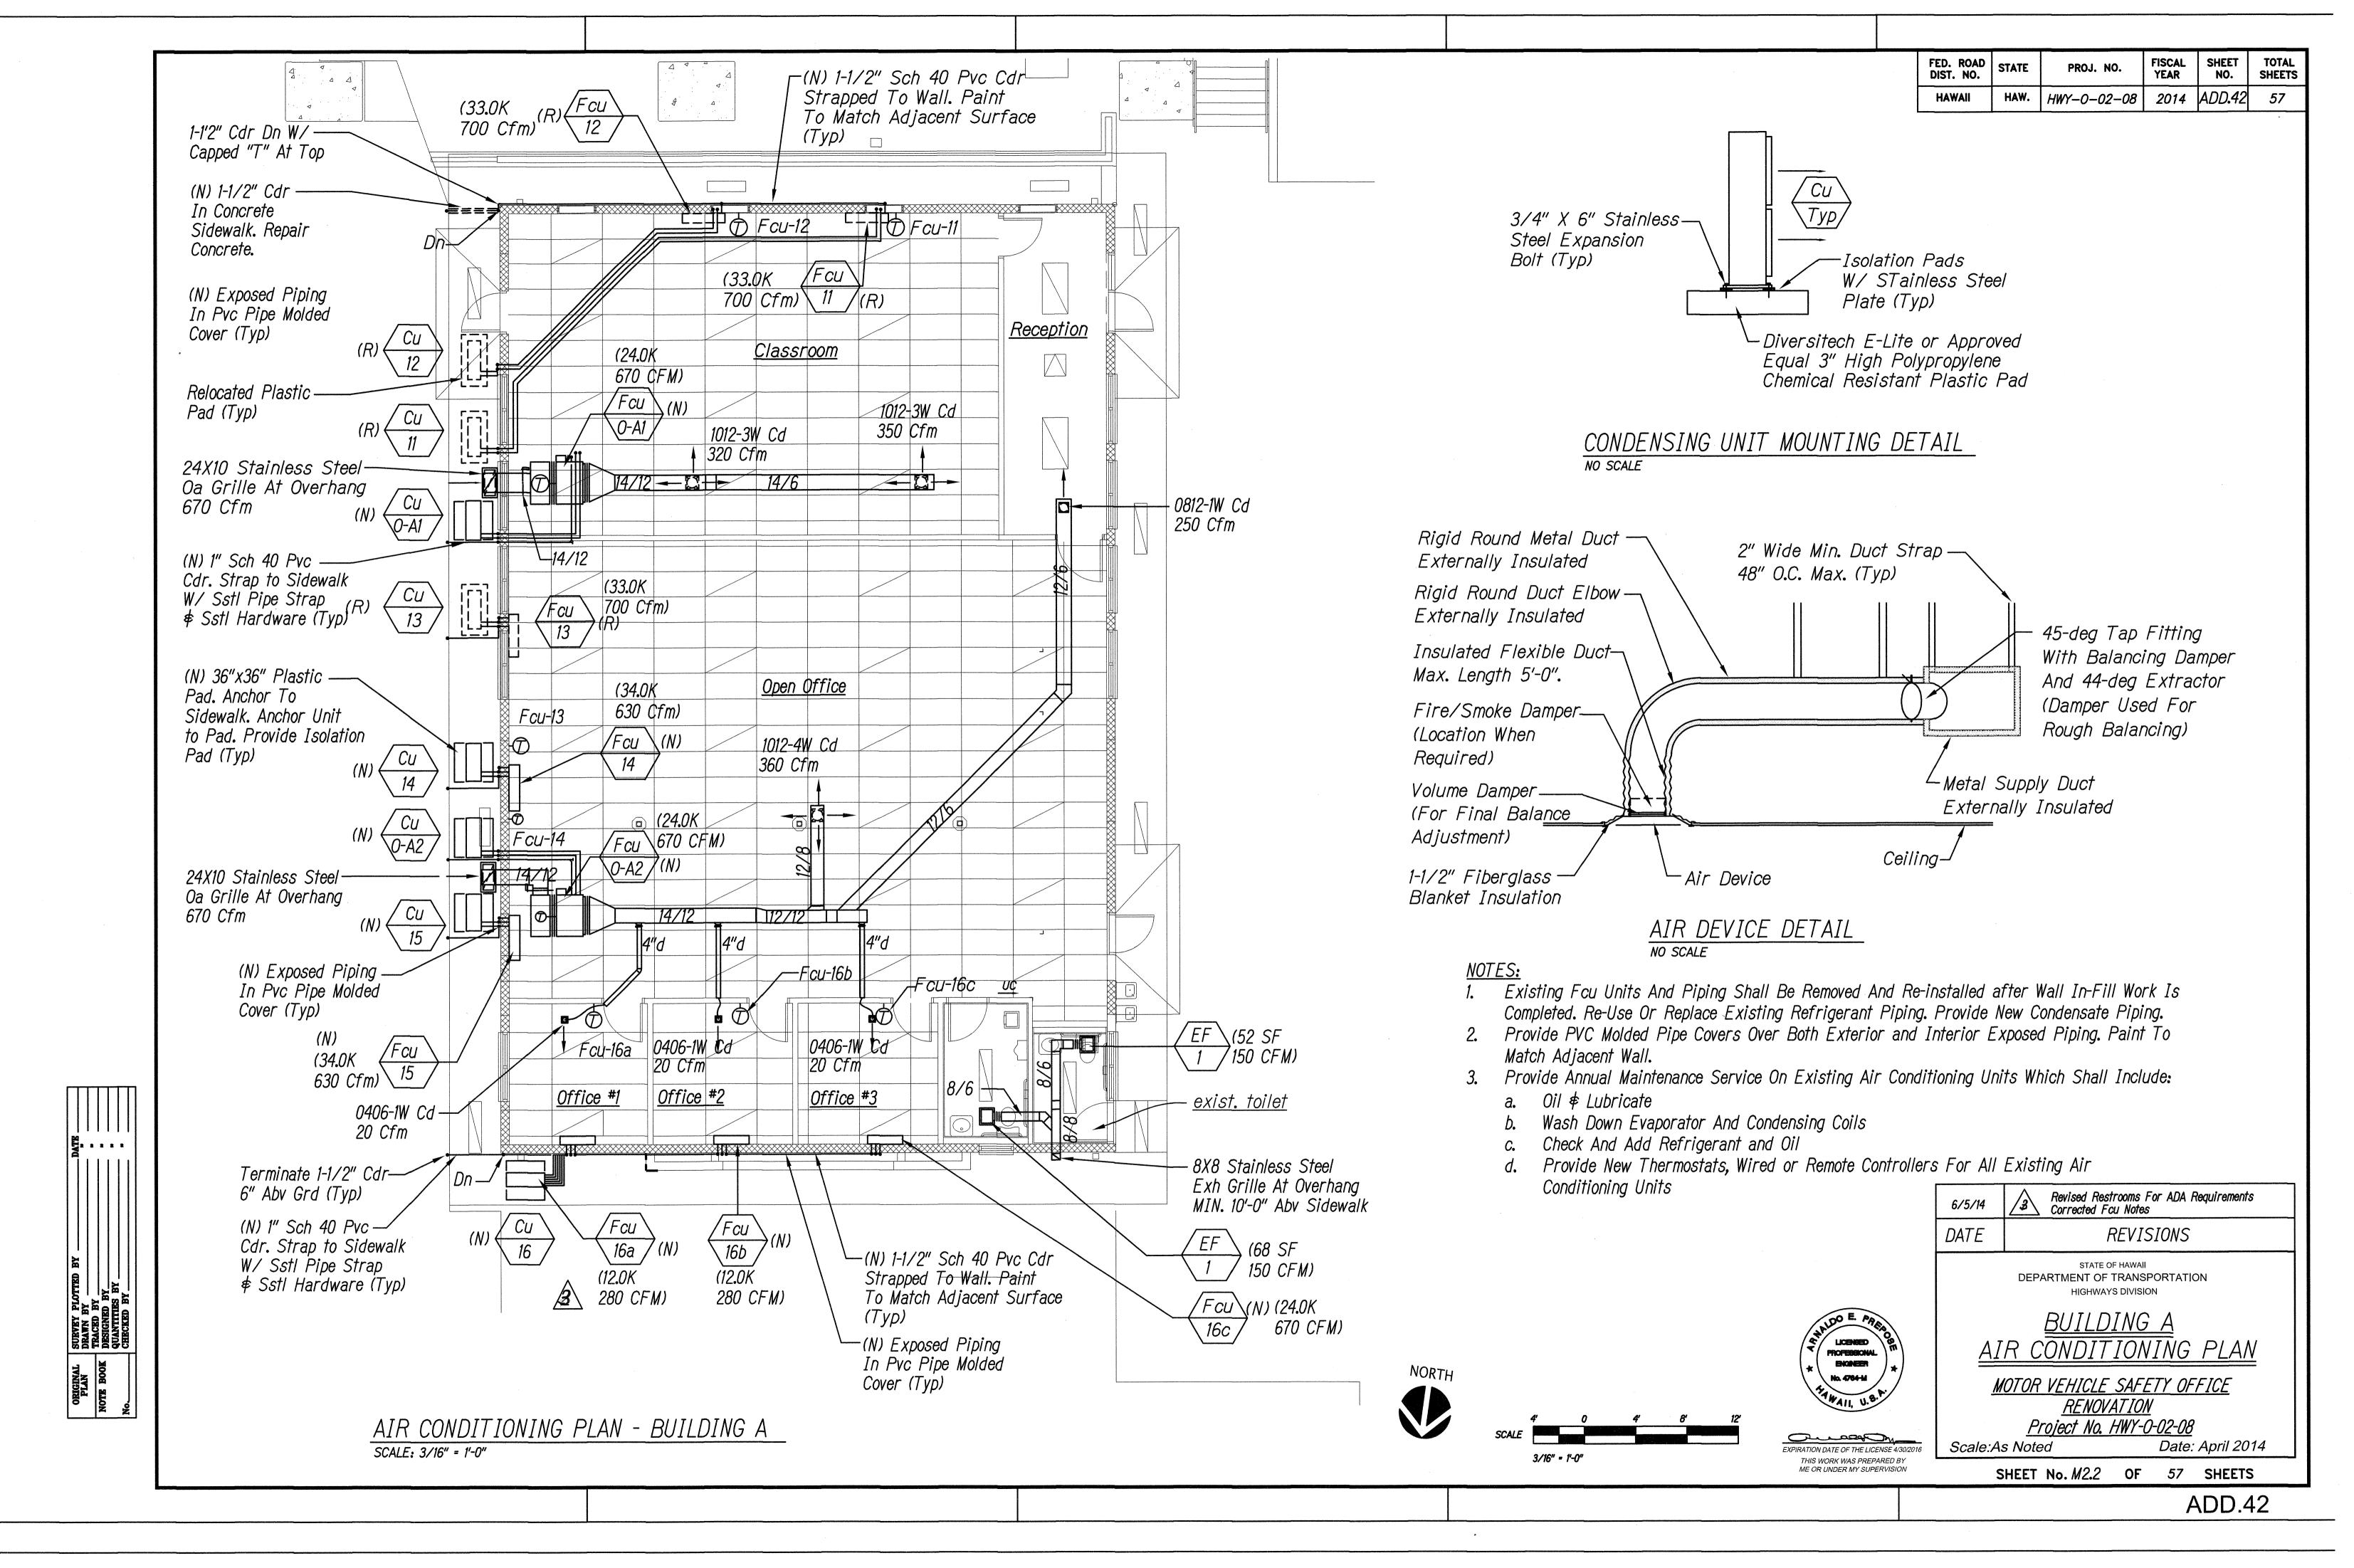

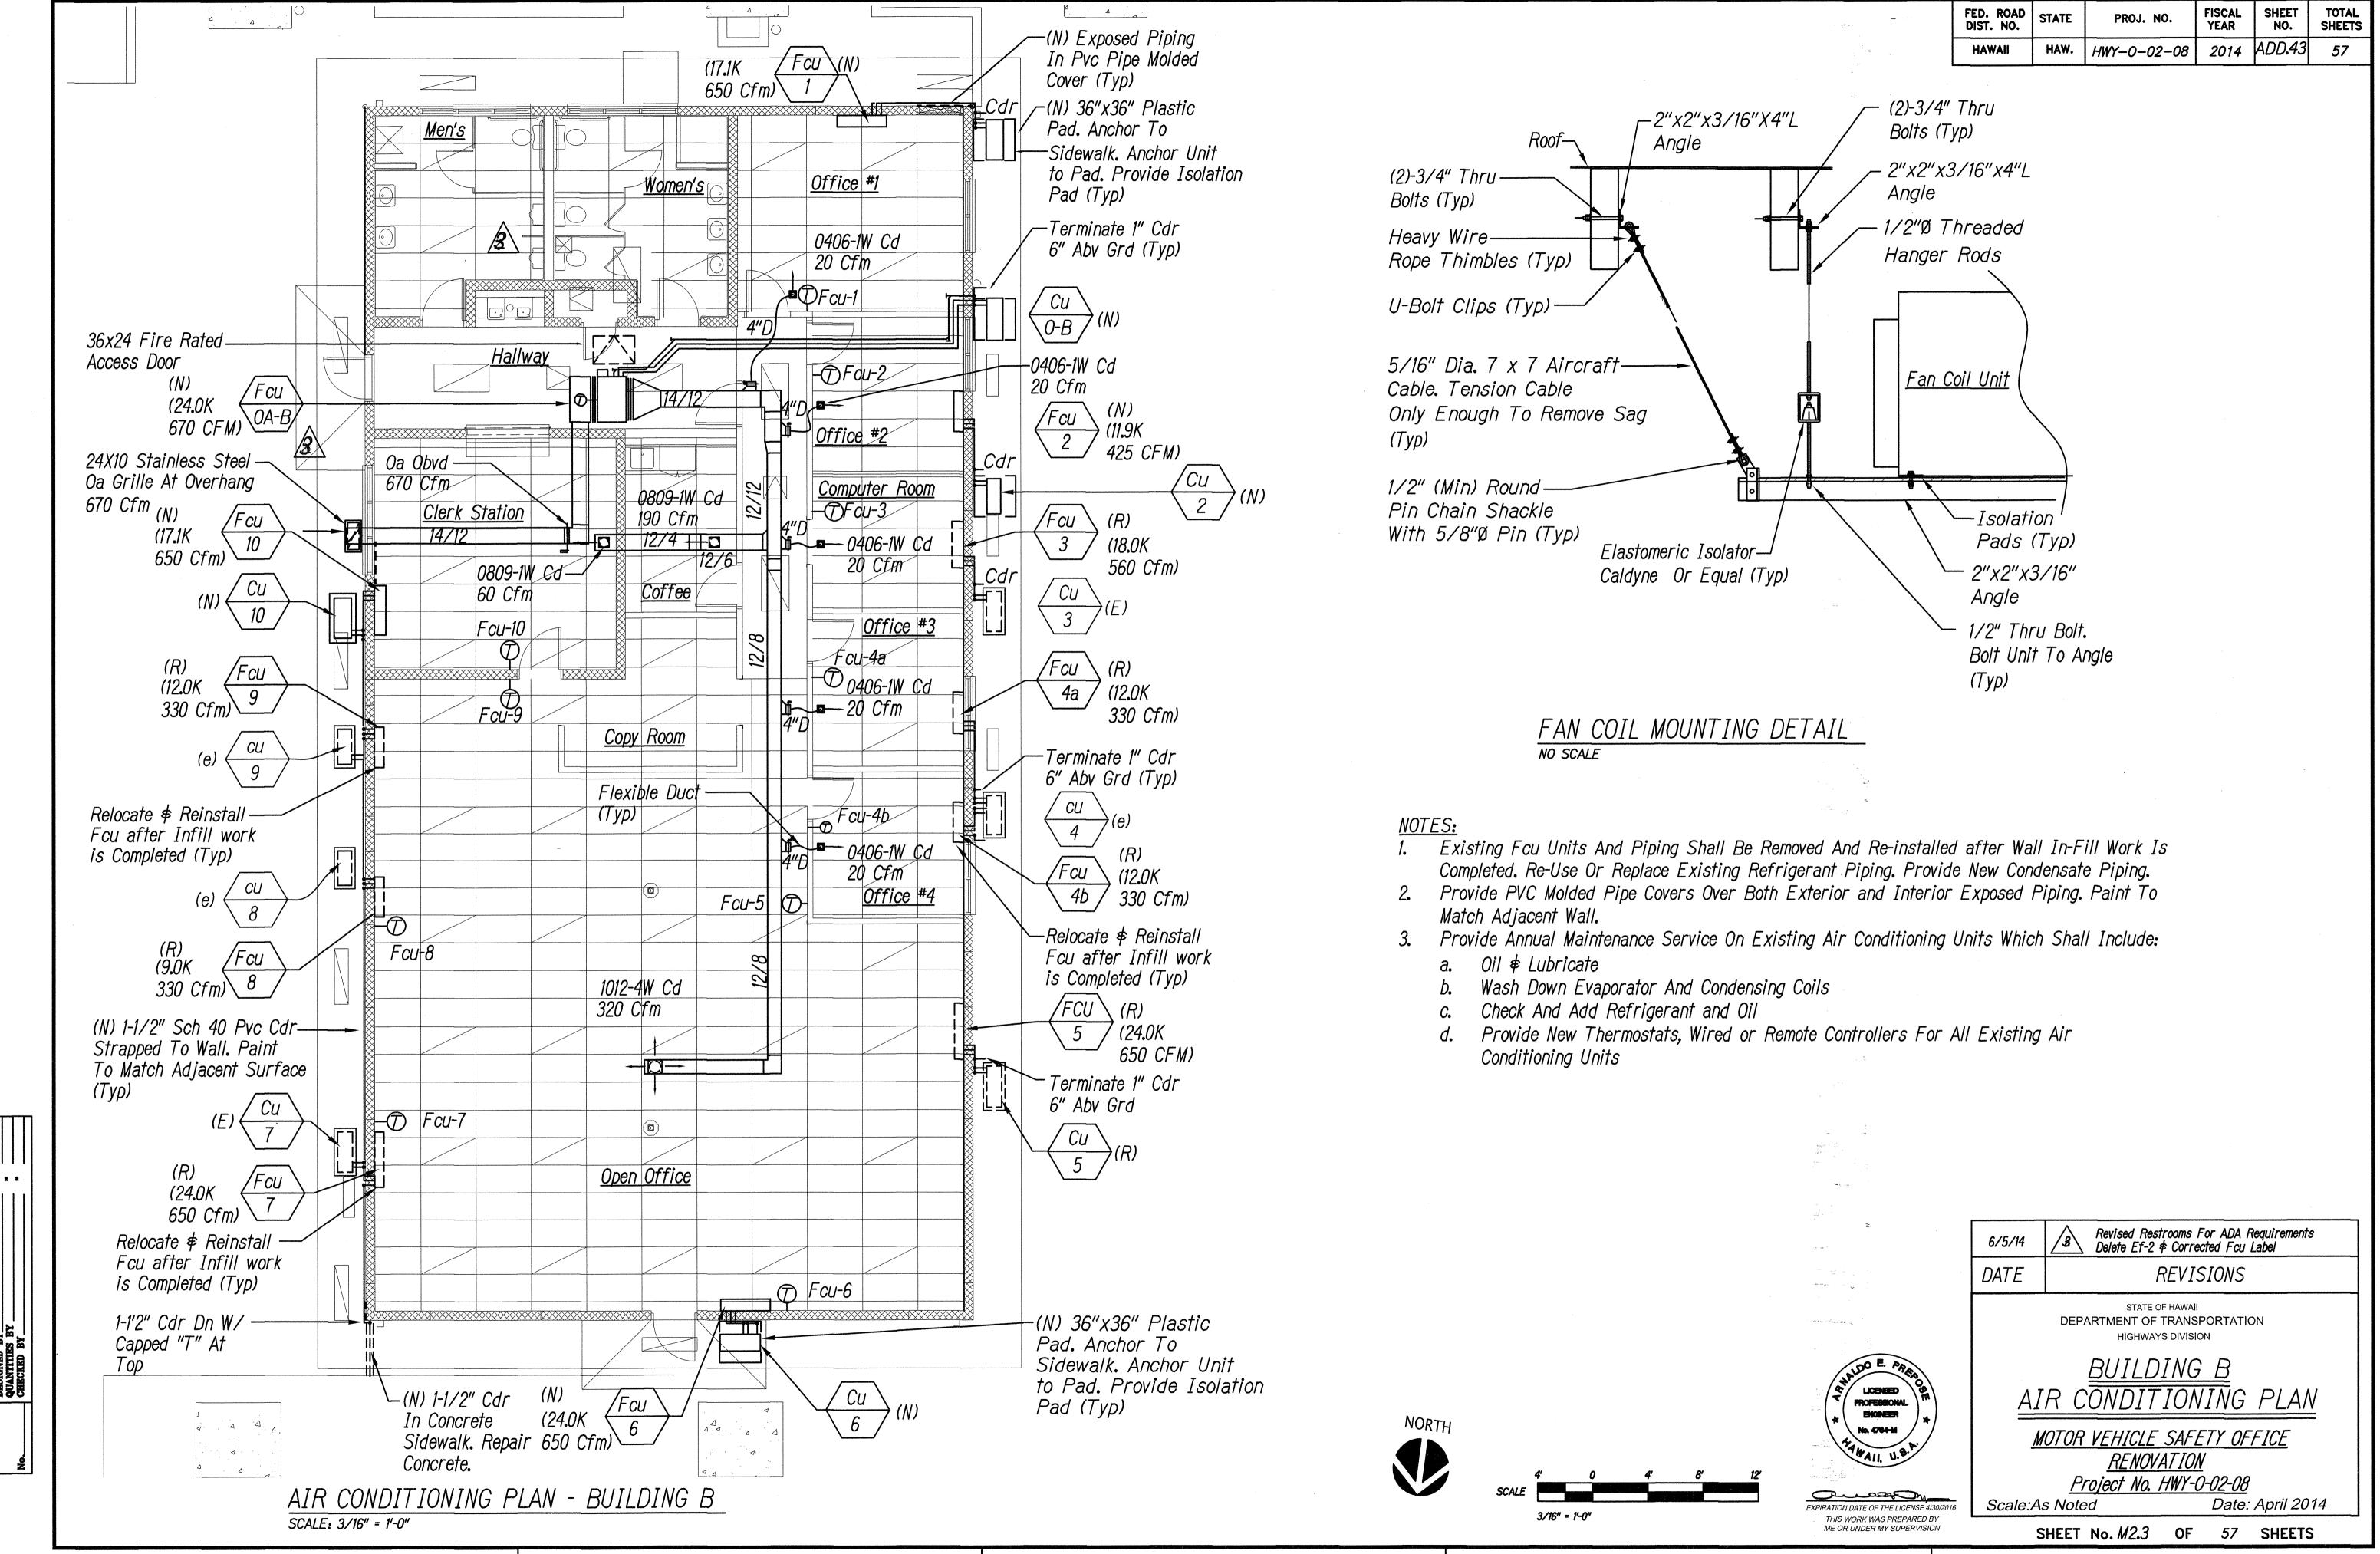

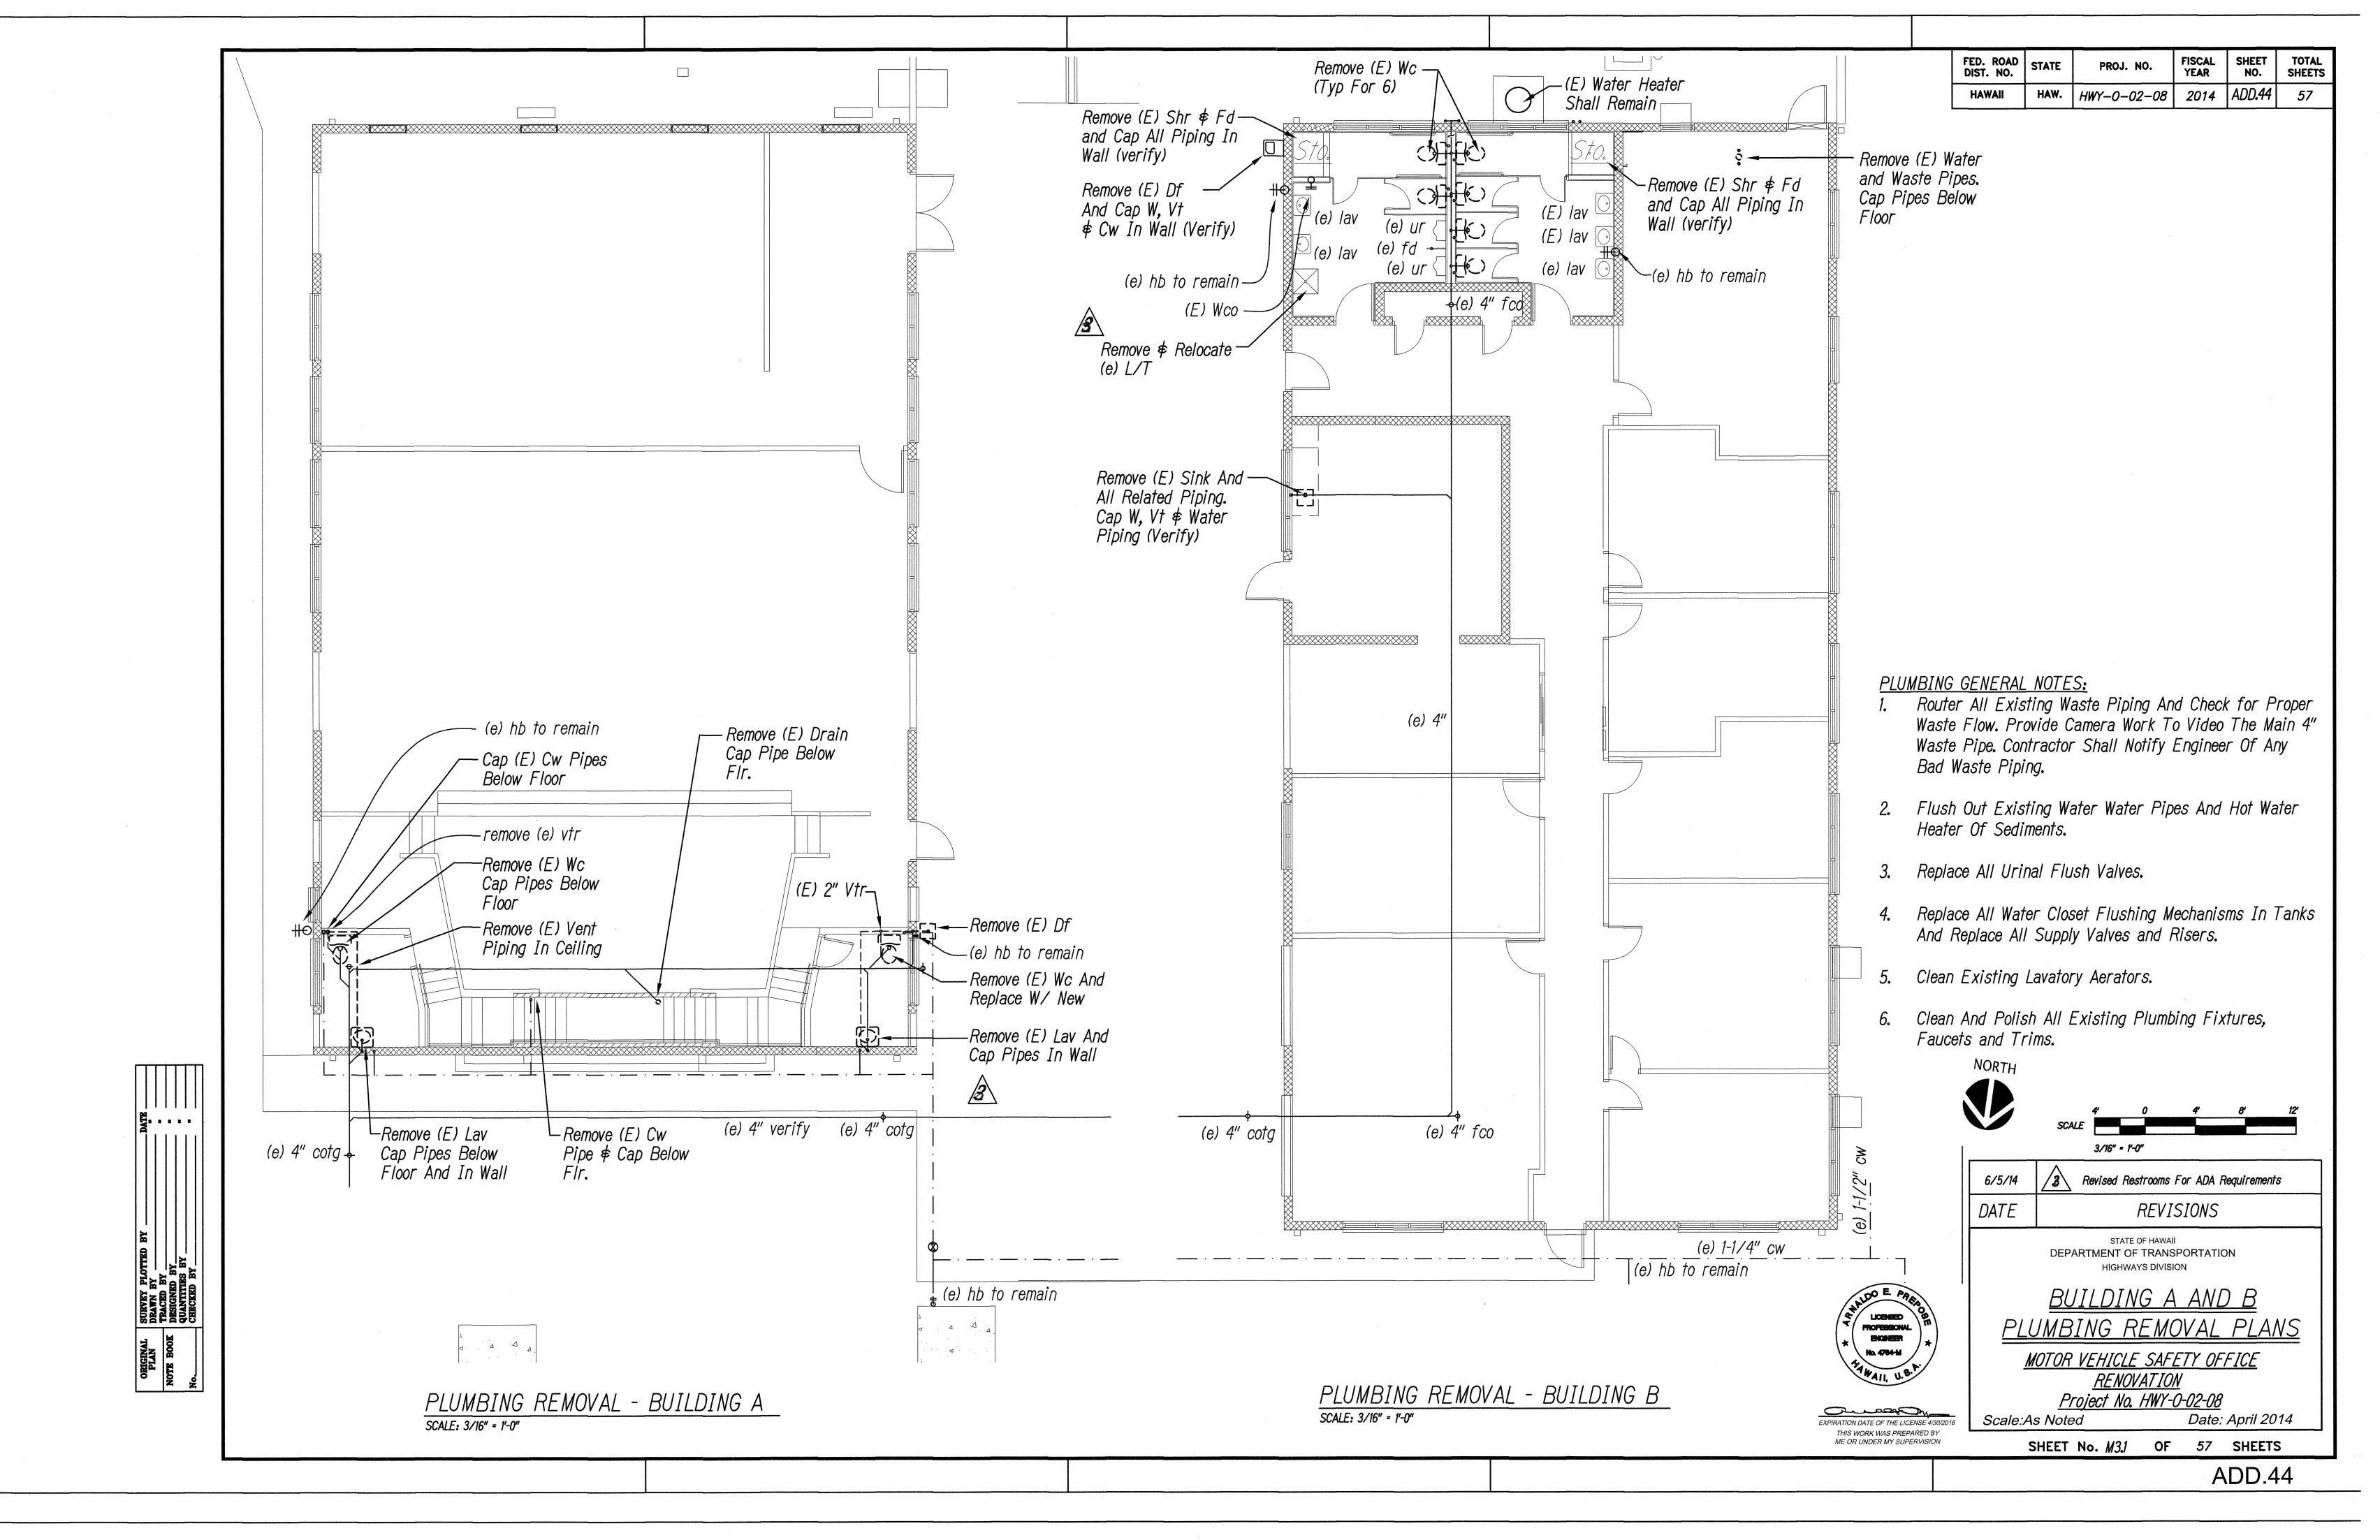

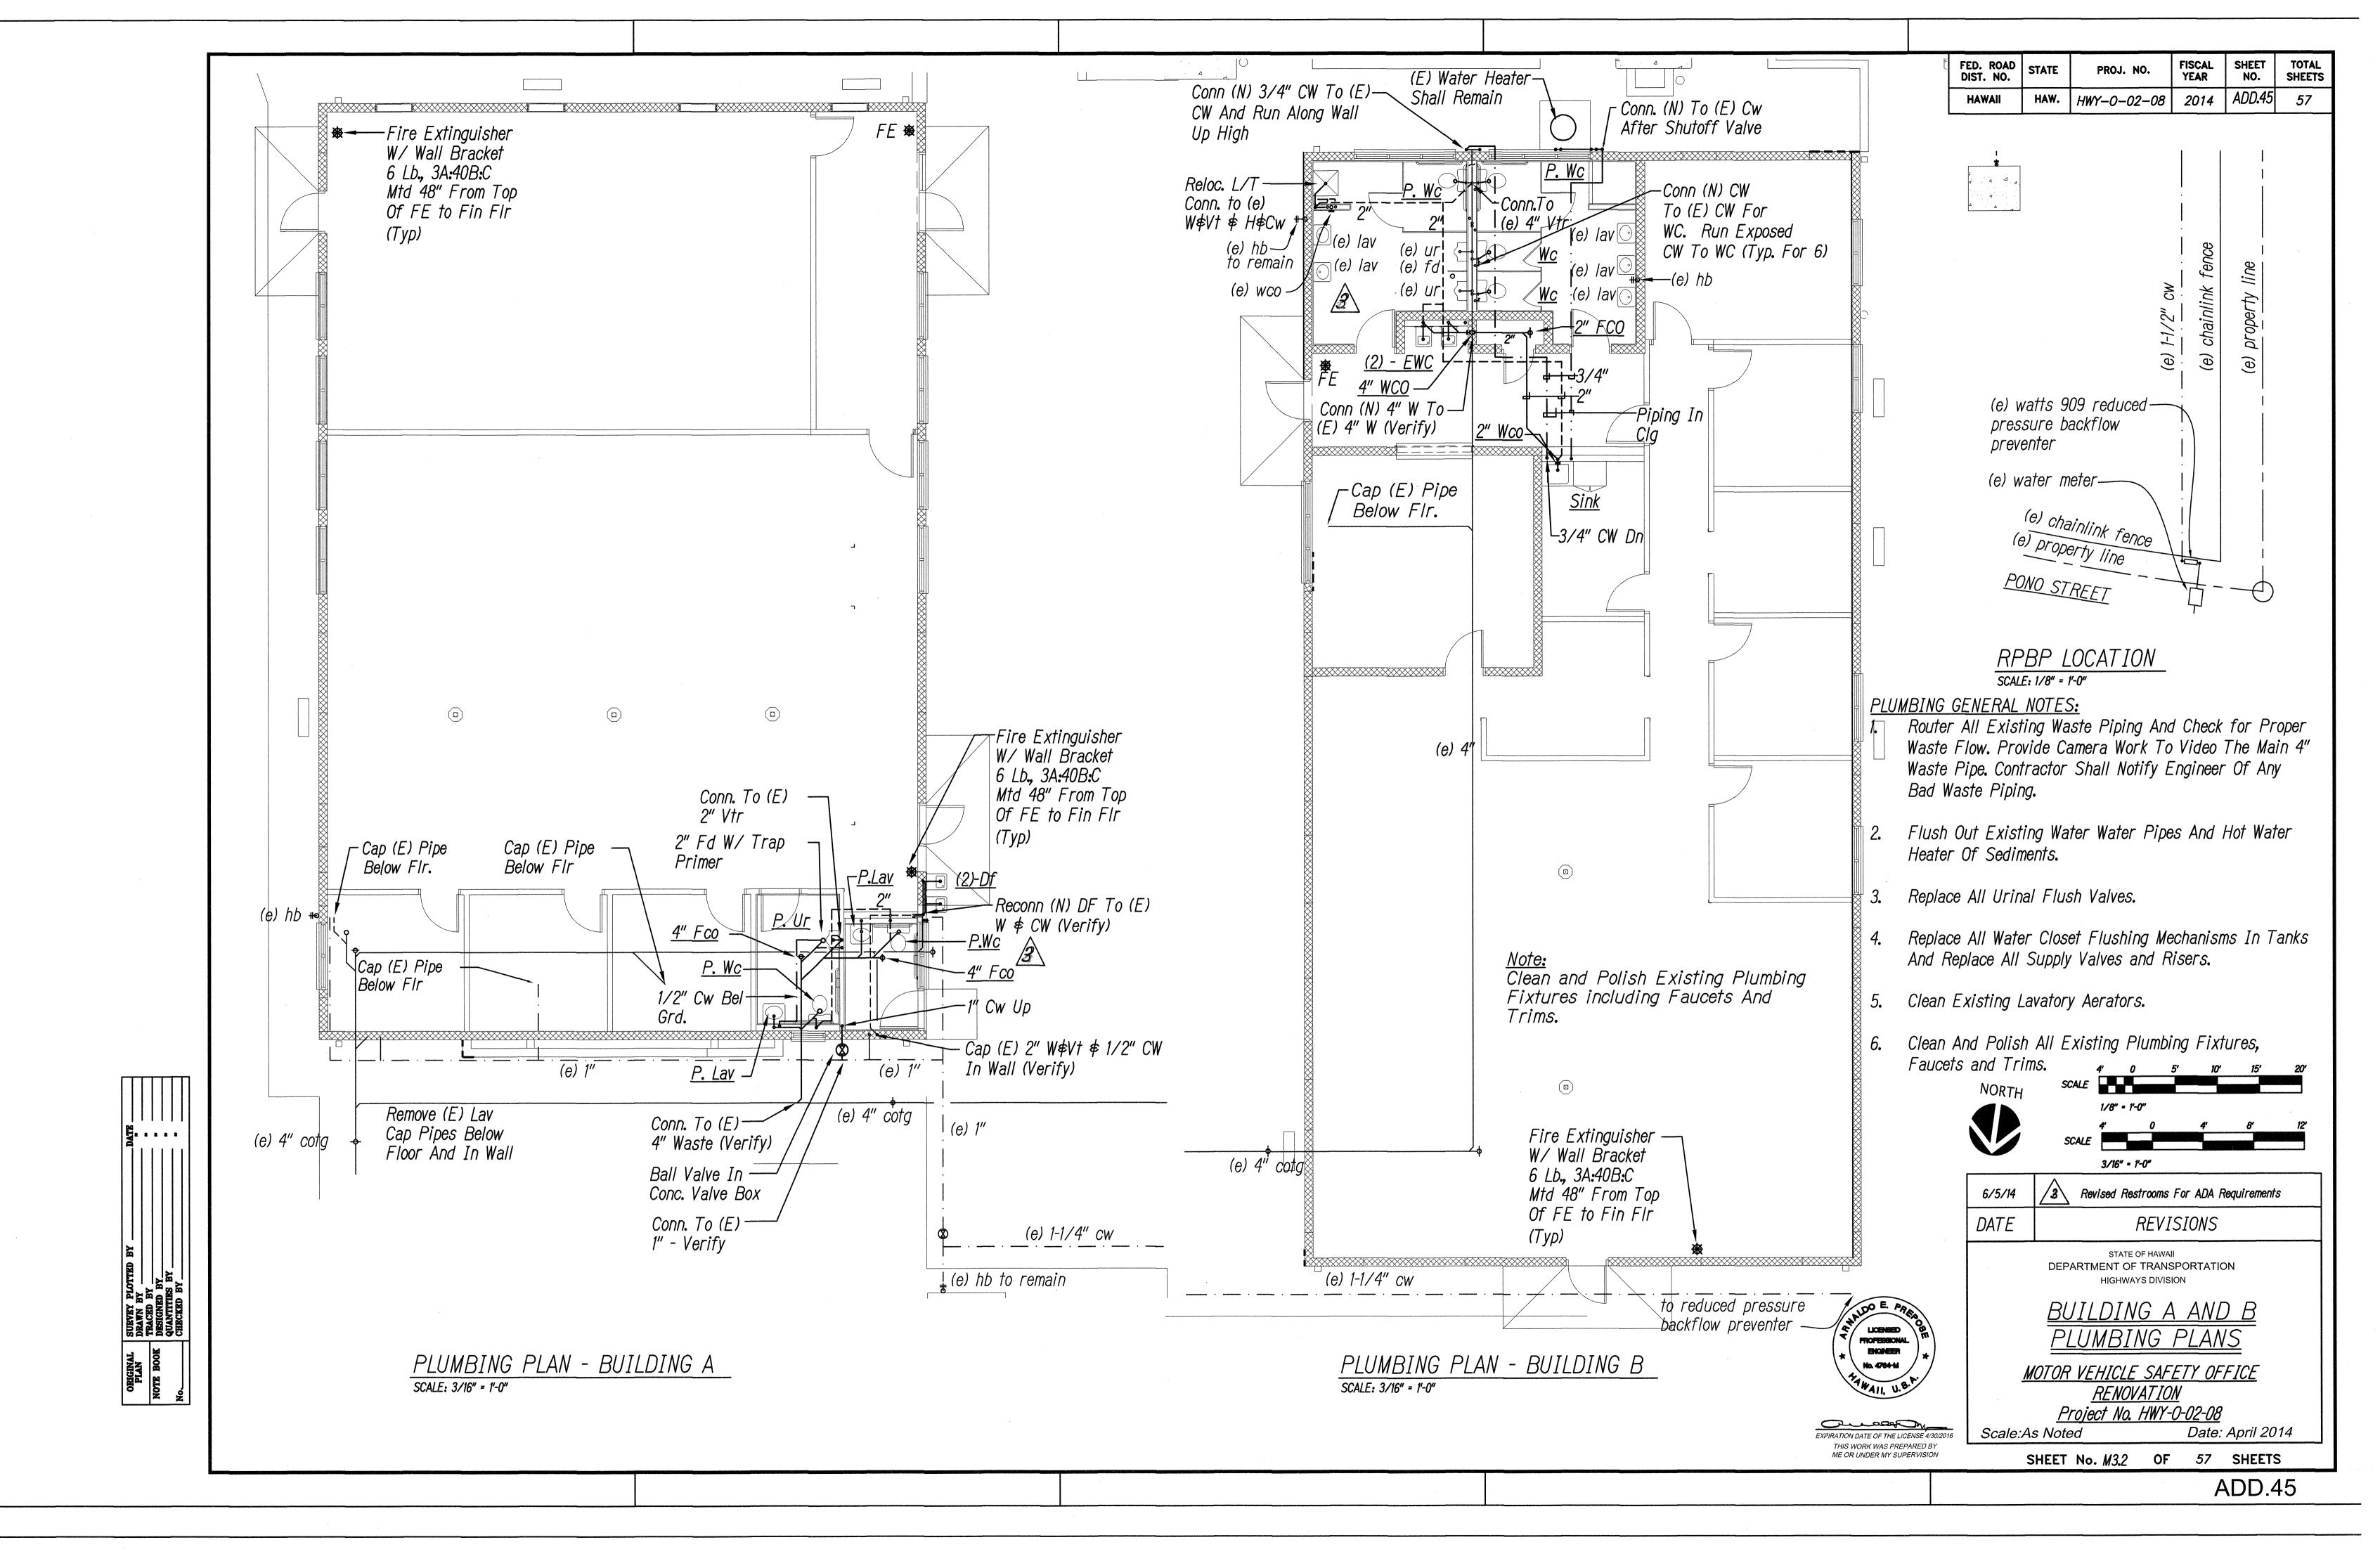


	D. ROAD ST. NO.	STATE	PROJ. NO.	FISCAL YEAR	SHEET NO.	TOTAL SHEETS
H	IAWAII	HAW.	HWY-0-02-08	2014	ADD.46	<i>57</i>

98-339 Pono St. (e) 4" vtr Aiea, HI 96821 TMK: 9-8-026:064 (e) vt to wc Premise Number: Meter Number: 1162310412 <u>GPD</u> <u>GPM</u> *350* A. Proposed Domestic Total B. Irrigation* N/A *P. WC* <u>4" FCO</u> C. Other N/A *350* 17.0 D. Total Proposed > (e) 4" wco E. Removed Fixtures 15.9 *320* F. Net Change (D - E) 20 G. Existing To Remain *345* (2)-EWC

Conn (N) 3/4" CW P. Wc To (E) CW And Run CW Along Wall Up High Reconn (N) 3/4" CW P. Wc To (E) 3/4" CW (Verify) Reconn (N) 3/4" CW To (E) 3/4" CW (Verify) Reconn (N) 3/4" CW To (E) 3/4" CW (Verify) (2)-EWC WATER PIPING	Conn (N) 3/4" CW To (E) CW And Run CW Along Wall Up High Reconn (N) 3/4" CW (Verify) P. WC To (E) 3/4" CW (Verify) 3/4" Reconn (N) 3/4" CW Reconn (N) 3/4" CW To (E) 3/4" CW (Verify)	I.J. Sink
---	---	-----------

PLUMBING DIAGRAMS - BUILDING B (A2) NO SCALE

2" Poc To (E)
2 2" Vt (Verify)
1 1-1/2"_1
P. Lav 2" 2" 9 P. Wc 3
$\frac{1. Lav}{2''} = \frac{2''}{2''} = \frac{P. WC}{3}$
1 \ \ \ \ \ \ \ \ \ \ \ \ \ \ \ \ \ \
$P. Ur \downarrow 2'' $
$4'' Fco \longrightarrow 2''$
P. WC 1-1/2" 2"
1/2" CW From—
Trap Primer 4"
V_{OU}
(e) 4"
Conn. To (E)
<u>SANITARY PIPING</u> 4" Waste (Verify)
1
P. lav 1 P. Wc 3
P. Ur Removable Vacuum Breaker
3/4" 1 1
$P. WC \nearrow I''$
$\frac{P. Lav}{1}$ 1 3/4" 1
Trap Primer (N) 1"
to Fd.
Ball Valve In————————————————————————————————————
Clonc. Valve Box — Conn. To (E)
WATER PIPING 1" - Verify
PLUMBING DIAGRAMS - BUILDING A D2
I LUNDING DIAGNAMS BUILDING A (DZ)

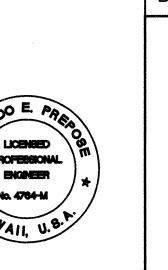

Revised Restrooms For ADA Requirements **REVISIONS** STATE OF HAWAII DEPARTMENT OF TRANSPORTATION HIGHWAYS DIVISION BUILDING A AND B

PLUMBING DIAGRAMS

MOTOR VEHICLE SAFETY OFFICE

RENOVATION

Project No. HWY-0-02-08

Date: April 2014 Scale:As Noted SHEET No. M3.3 OF 57 SHEETS

ADD.46

П	П				
DATE	2	a			.
À		ı			
A					
B		-			
OTTE		١	BY	BY	,
P	BY	BY	8	TIES	E
SURVEY PLOTTED BY	DRAWN BY	TRACED BY	DESIGNED BY	QUANTITIES BY	CHECKED BY
F .	 		OK OK		
GINAL	IAN		BOOK		

H. Grand Total (D + G) *34.3* 22.5 695 2" WCO *Notes:* Conn (N) 4" W To— (E) 4" W (Verify) 1. There Is No Irrigation For ThisProject. 2. A/C Work Will Not Affect Water Demand. SANITARY PIPING 3. There Is No Fire Sprinkler System In This Project. TOTAL F.U. <u>New Fixtures</u> Water Closet *8.5* Lavatory

1.6 4.0 1.6 17.0 FU, 12.5 GPM TOTAL F.U. 2.0 3.2 15.9 FU, 12.0 GPM TOTAL F.U. *3.4* 3.0 3.4 2.5 *5.0* 17.3 FU, 12.5 GPM

Urinal

Sink

Drinking Fountain

Drinking Fountain

<u>Fixtures to be Remain</u>

Water Closet

Water Closet

Lavatory

Hose Bibb

Hose Bibb

Urinal

Lavatory

Shower

Sink

Fixtures to be Removed

BWS FLOW REQUIREMENTS

LICENSED PROFESSIONAL EXPIRATION DATE OF THE LICENSE 4/30/2016 THIS WORK WAS PREPARED BY ME OR UNDER MY SUPERVISION

| Sink 2" WCO