

INDEX TO DRAWINGS		
SHEET NO.	DESCRIPTION	
1	TITLE	SHEET
2	TYPICAL SECTION	
3	PLAN & PROFILE	
4	STD. DETAILS	
5-6	CROSS SECTIONS	


CONVENTIONAL SIGNS	
Centerline.....	125
Boundary Lines.....	Or
Fences (Named).....	
Existing Roadways.....	
Circular Culvert.....	
Box Culvert.....	
Bridge.....	
Telephone Pole.....	T.P.
Electric Power Pole.....	E.P.P.
Water Main.....	W ₂ (W ₄ , 8, 12, Etc.)
Storm Drain.....	SD ₁₂ (SD ₁₈ , 24, Etc.)
Concrete Drop Intake.....	C.D.I.
Standard Catch Basin.....	S.C.B.
Standard Manhole.....	M.H.S.
Sewer Manhole.....	S.M.H.
Telephone Manhole.....	T.M.H.
Fire Hydrant.....	F.H.
Tree (Large, named).....	Mango, Coco
Railroad.....	

NOTE:
 ALL CHANGES MADE DURING
 CONSTRUCTION HAVE BEEN
 NOTED IN RED ON THESE
 TRACINGS AND CHECKED.
 BY: *[Signature]*
 RESIDENT ENGINEER
 DATE: *JUNE 7, 1950*

TERRITORY OF HAWAII
 TERRITORIAL HIGHWAY DEPARTMENT
 HONOLULU, OAHU, T. H.


PLANS OF
LEHUA AVE WIDENING
 FEDERAL AID SECONDARY PROJECT NO. S 226 (2)
 DISTRICT OF EWA
 ISLAND OF OAHU

SCALES	
PLAN	1 INCH = 50 FEET
PROFILE	HOR. 1 INCH = 50 FEET VERT. 1 INCH = 10 FEET
GROSS SECTION	HOR. 1 INCH = 10 FEET VERT. 1 INCH = 10 FEET

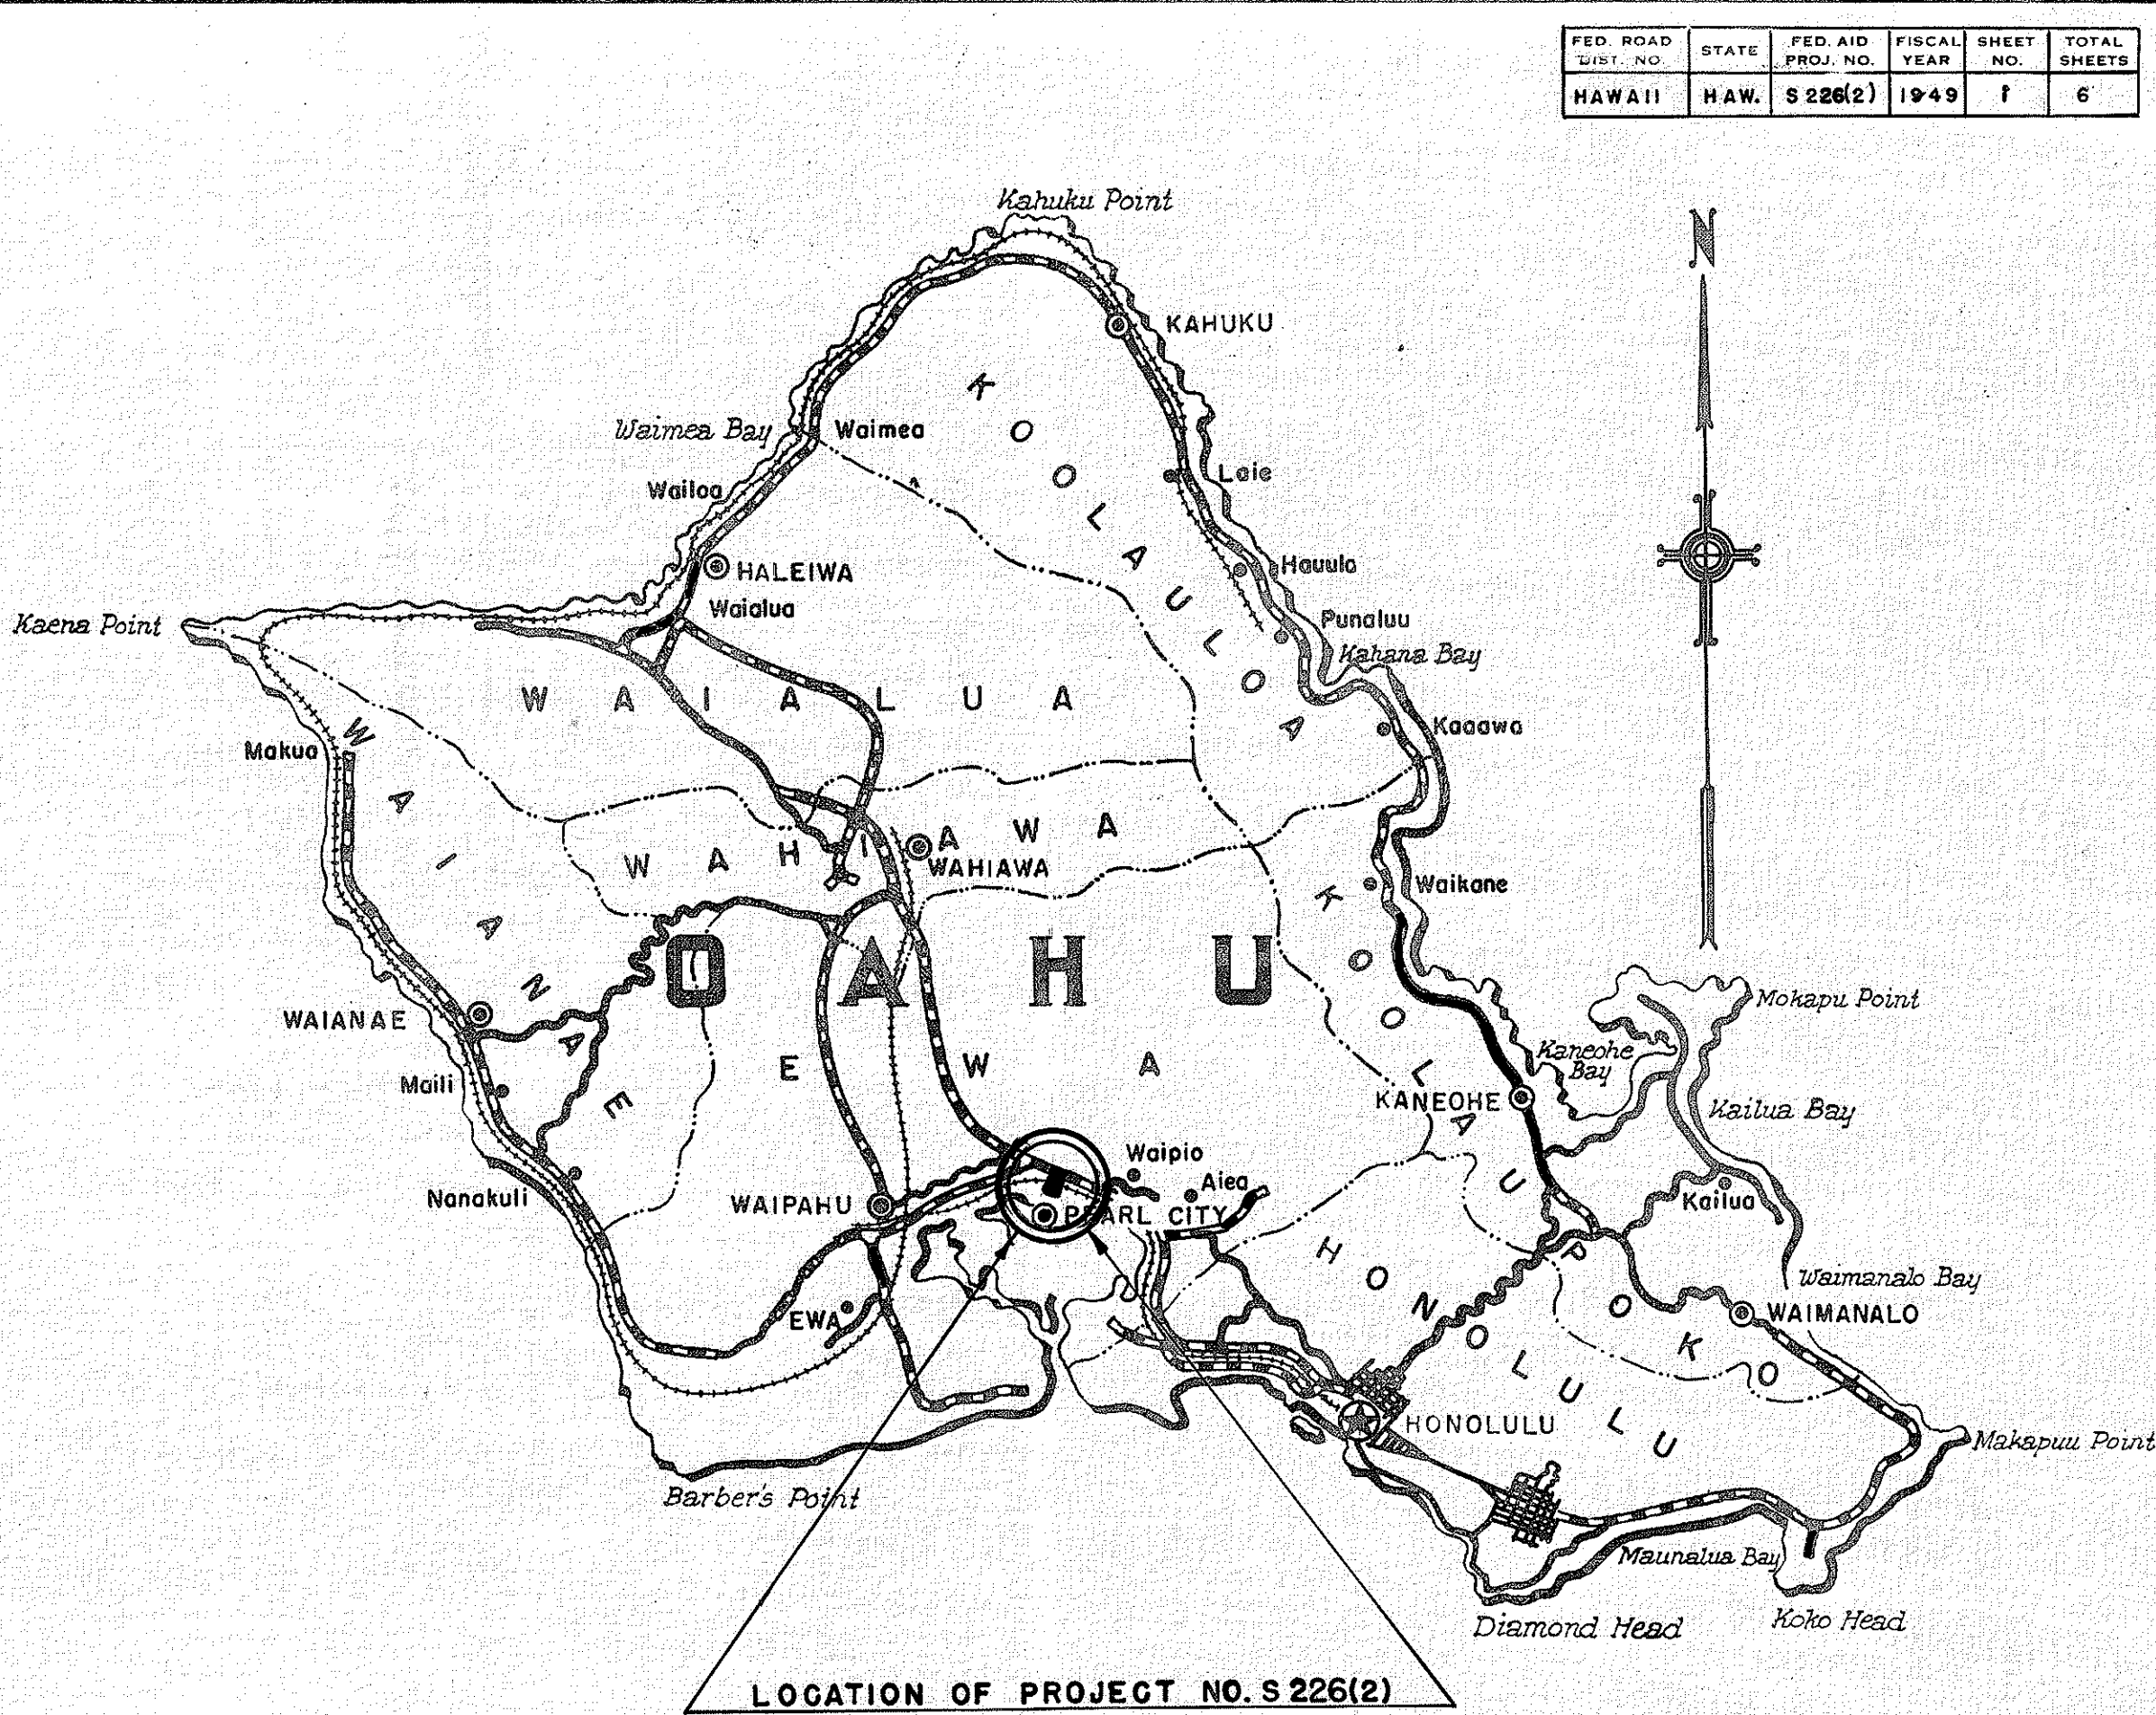

Federal Aid Projects Previously Constructed Or Under Construction

LAYOUT OF PROJECT

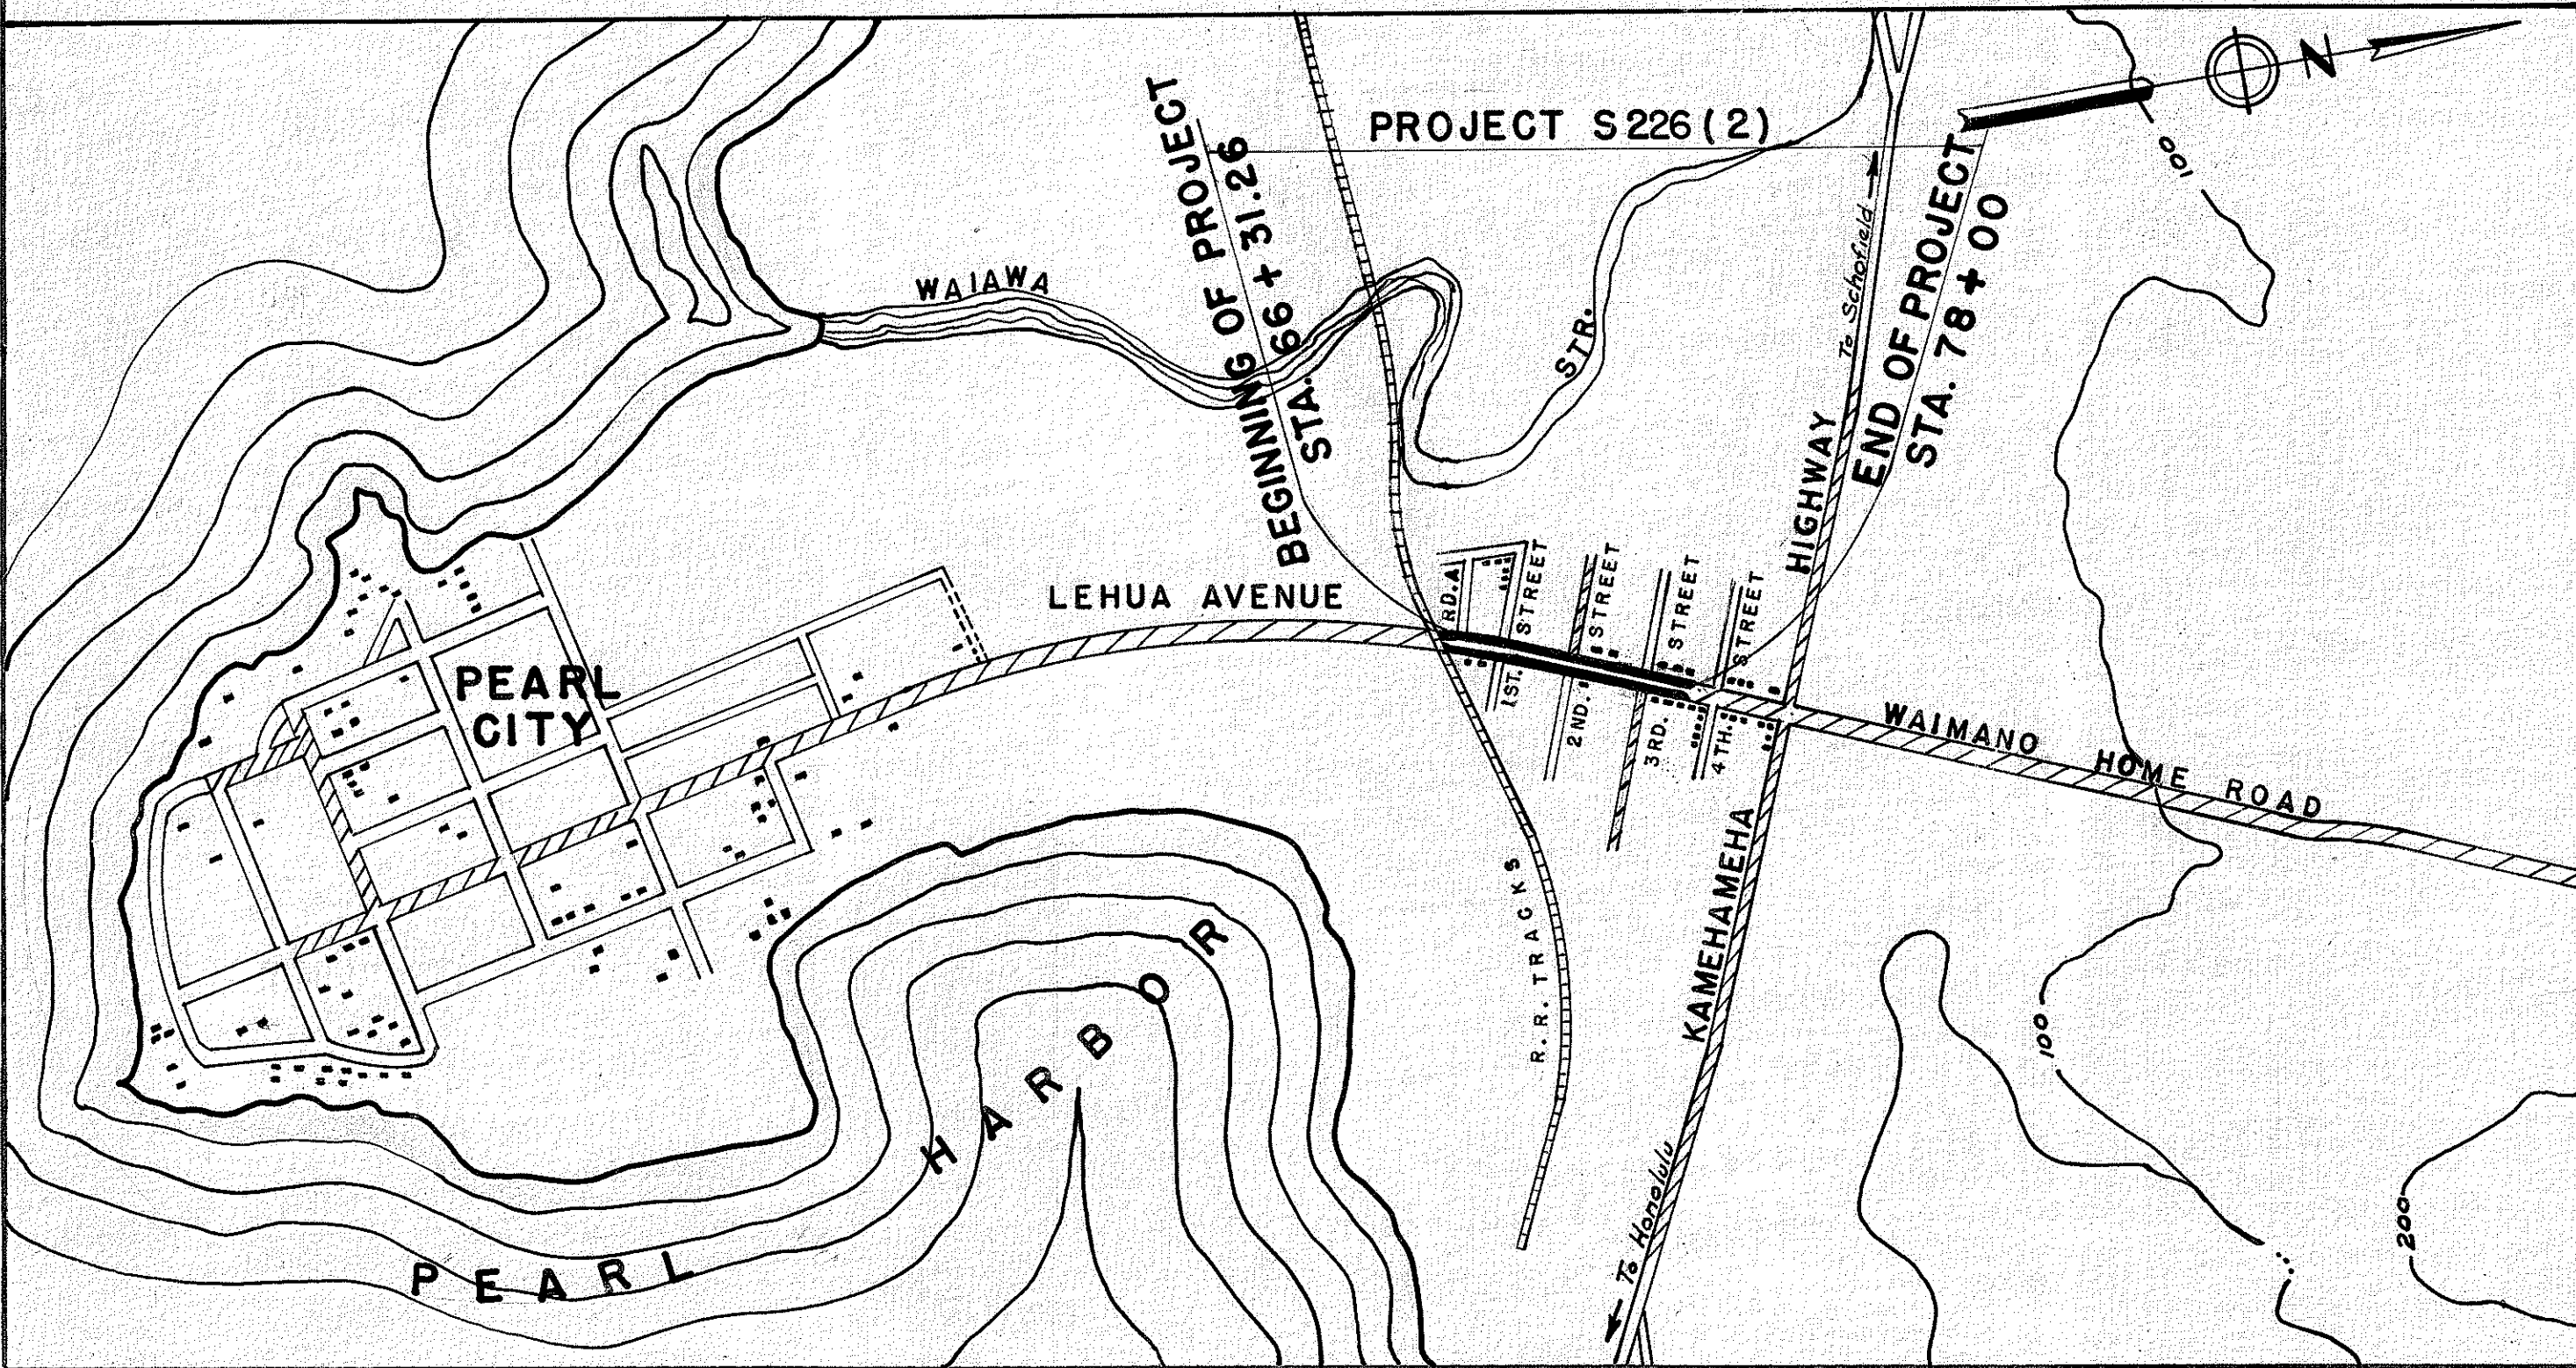

GROSS & NET LENGTH OF PROJECT = 0.221 MILE.

APPROVED *[Signature]* DATE *9-8-49*
 TERRITORIAL HIGHWAY ENGINEER

RECOMMENDED FOR APPROVAL DATE *9-8-49*
 DISTRICT ENGINEER
 PUBLIC ROADS ADMINISTRATION
 FEDERAL WORKS AGENCY
 APPROVED DATE *9-8-49*
 DIVISION ENGINEER
 PUBLIC ROADS ADMINISTRATION
 FEDERAL WORKS AGENCY