
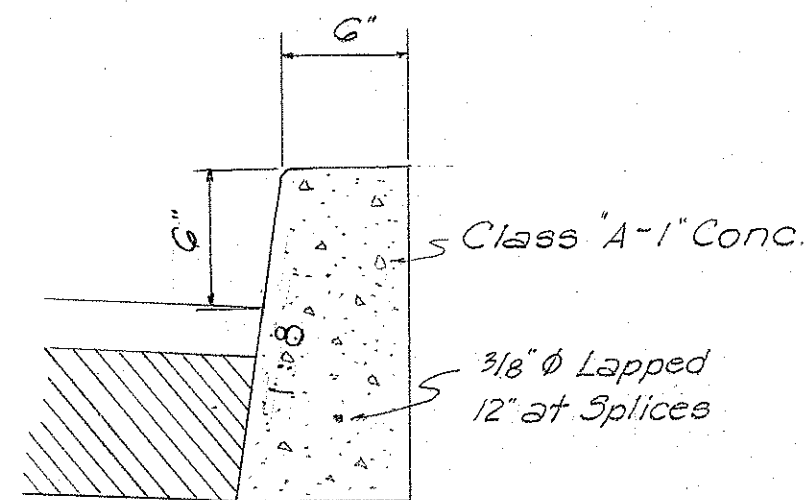
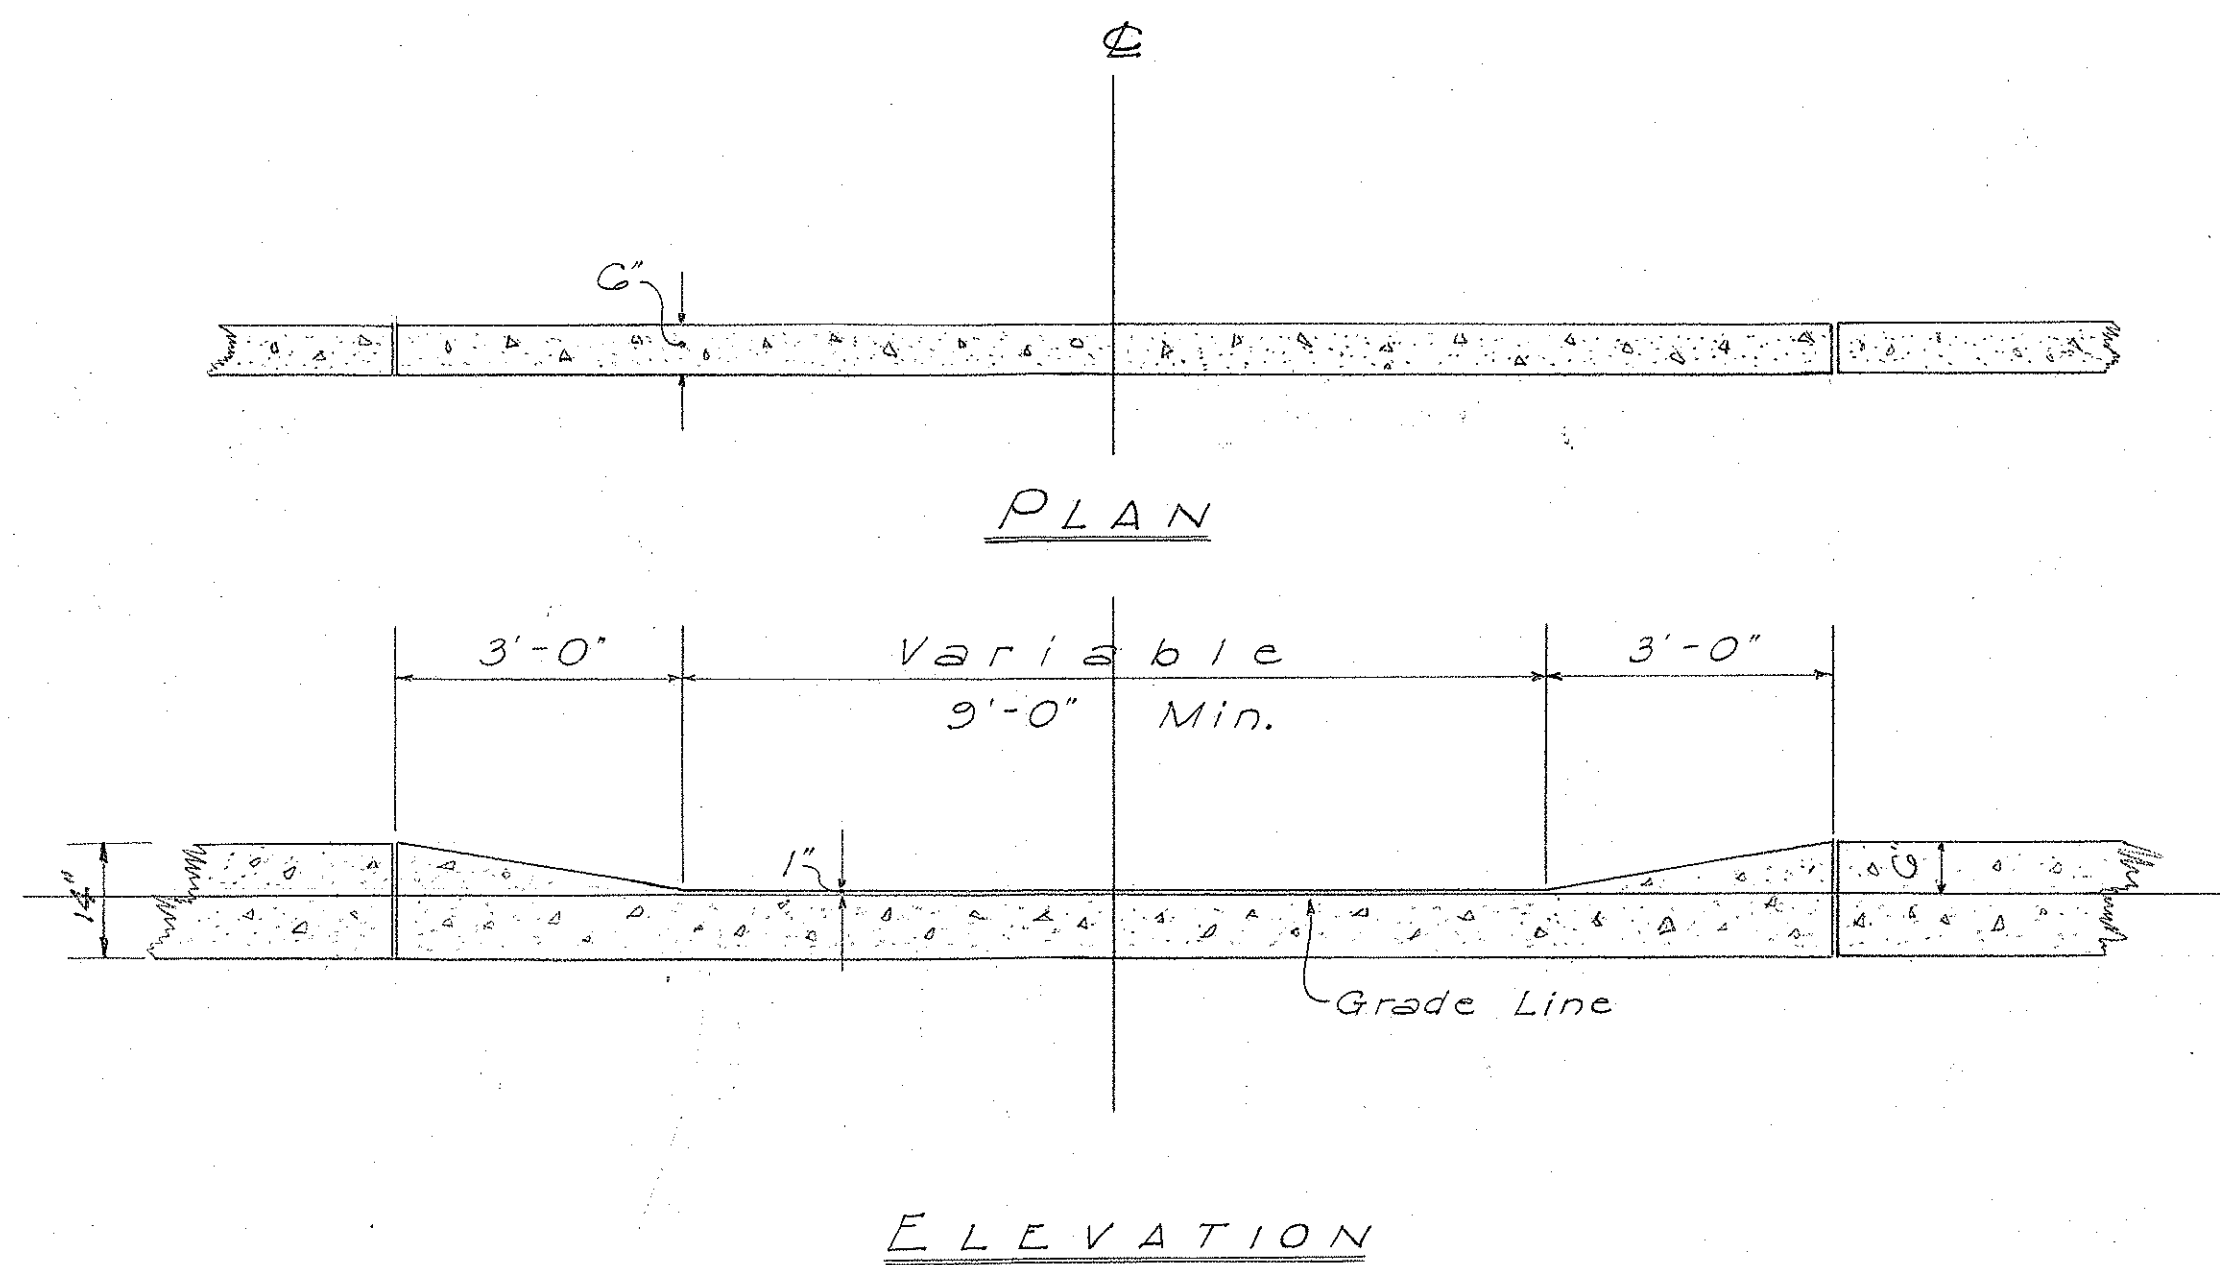


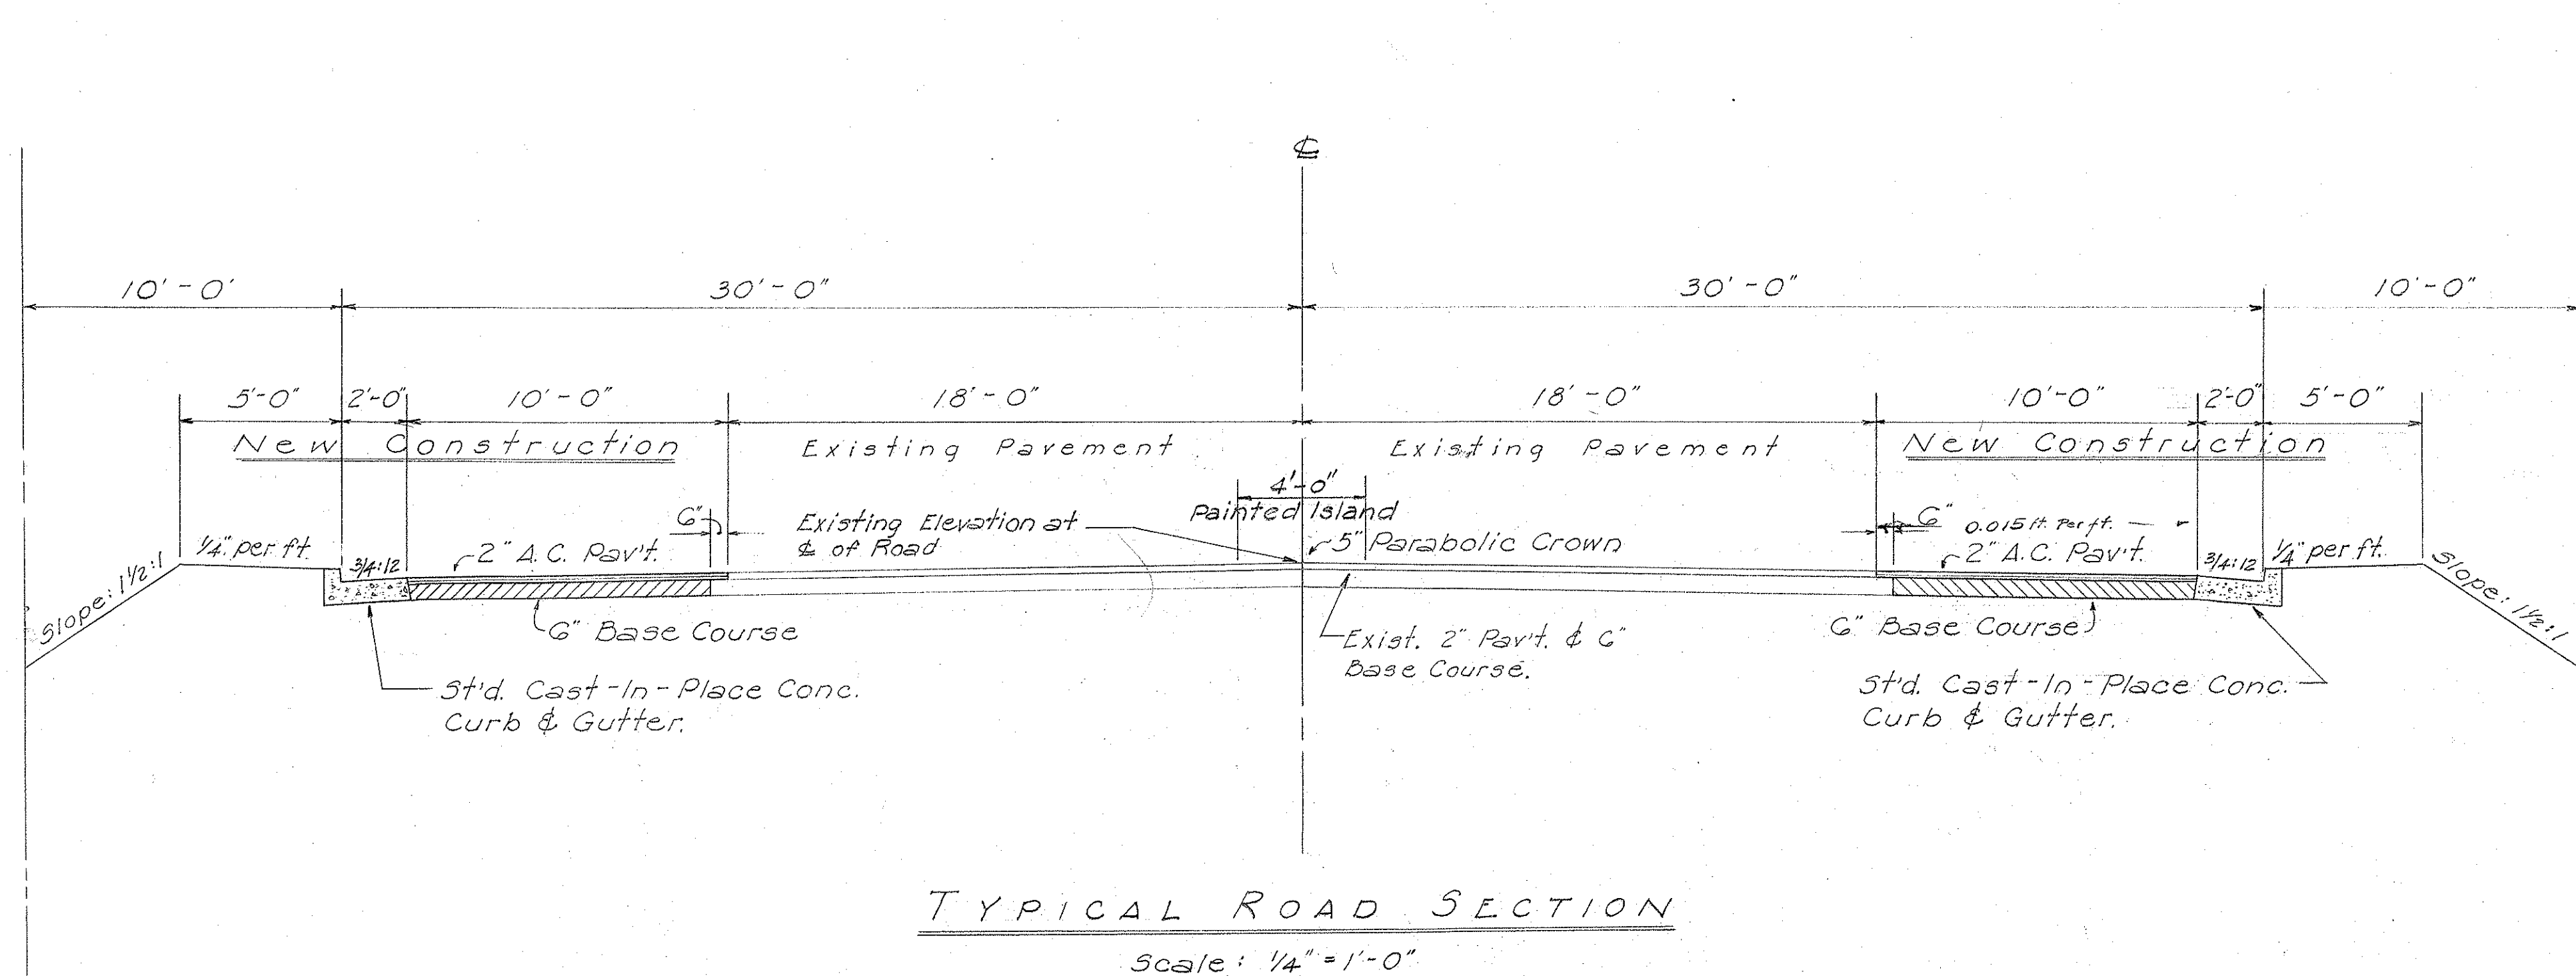


GENERAL NOTES

PAVEMENT: Pavement shall be Asphalt Concrete Surface Course 2" thick when fully compacted. Use Mix No. III.

BASE COURSE: Base Course shall be 6" thick Waterbound Macadam Base Course placed in two layers each of 3" compacted thickness and consisting of Mineral Aggregate (Coarse Rock No. 2 [2 1/2" - 3/4"] filled with Filler [1/2" - #100]).

PRIMER: A prime coat of liquid asphaltic primer shall be applied to the surface of the base course at the rate of 0.35 gal. per sq. yd. before placing the 2" Surface Course. Both above courses are subject to Specifications and Special Provisions.

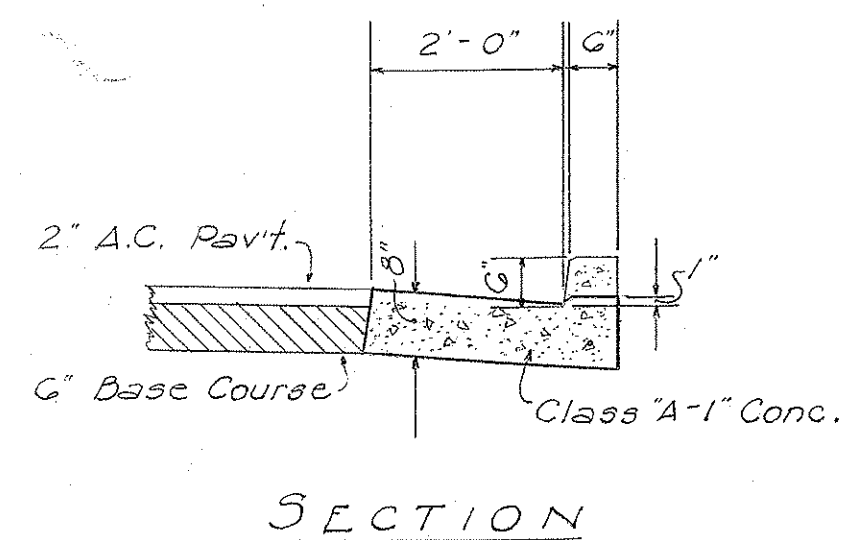

DETAIL OF DROP CURB
Scale: 1/2" = 1'-0"

