



FED. ROAD DIST. NO.	STATE	FED. AID PROJ. NO.	FISCAL YEAR	SHEET NO.	TOTAL SHEETS
HAWAII	HAWAII	DA-WR-3	1944	7	10

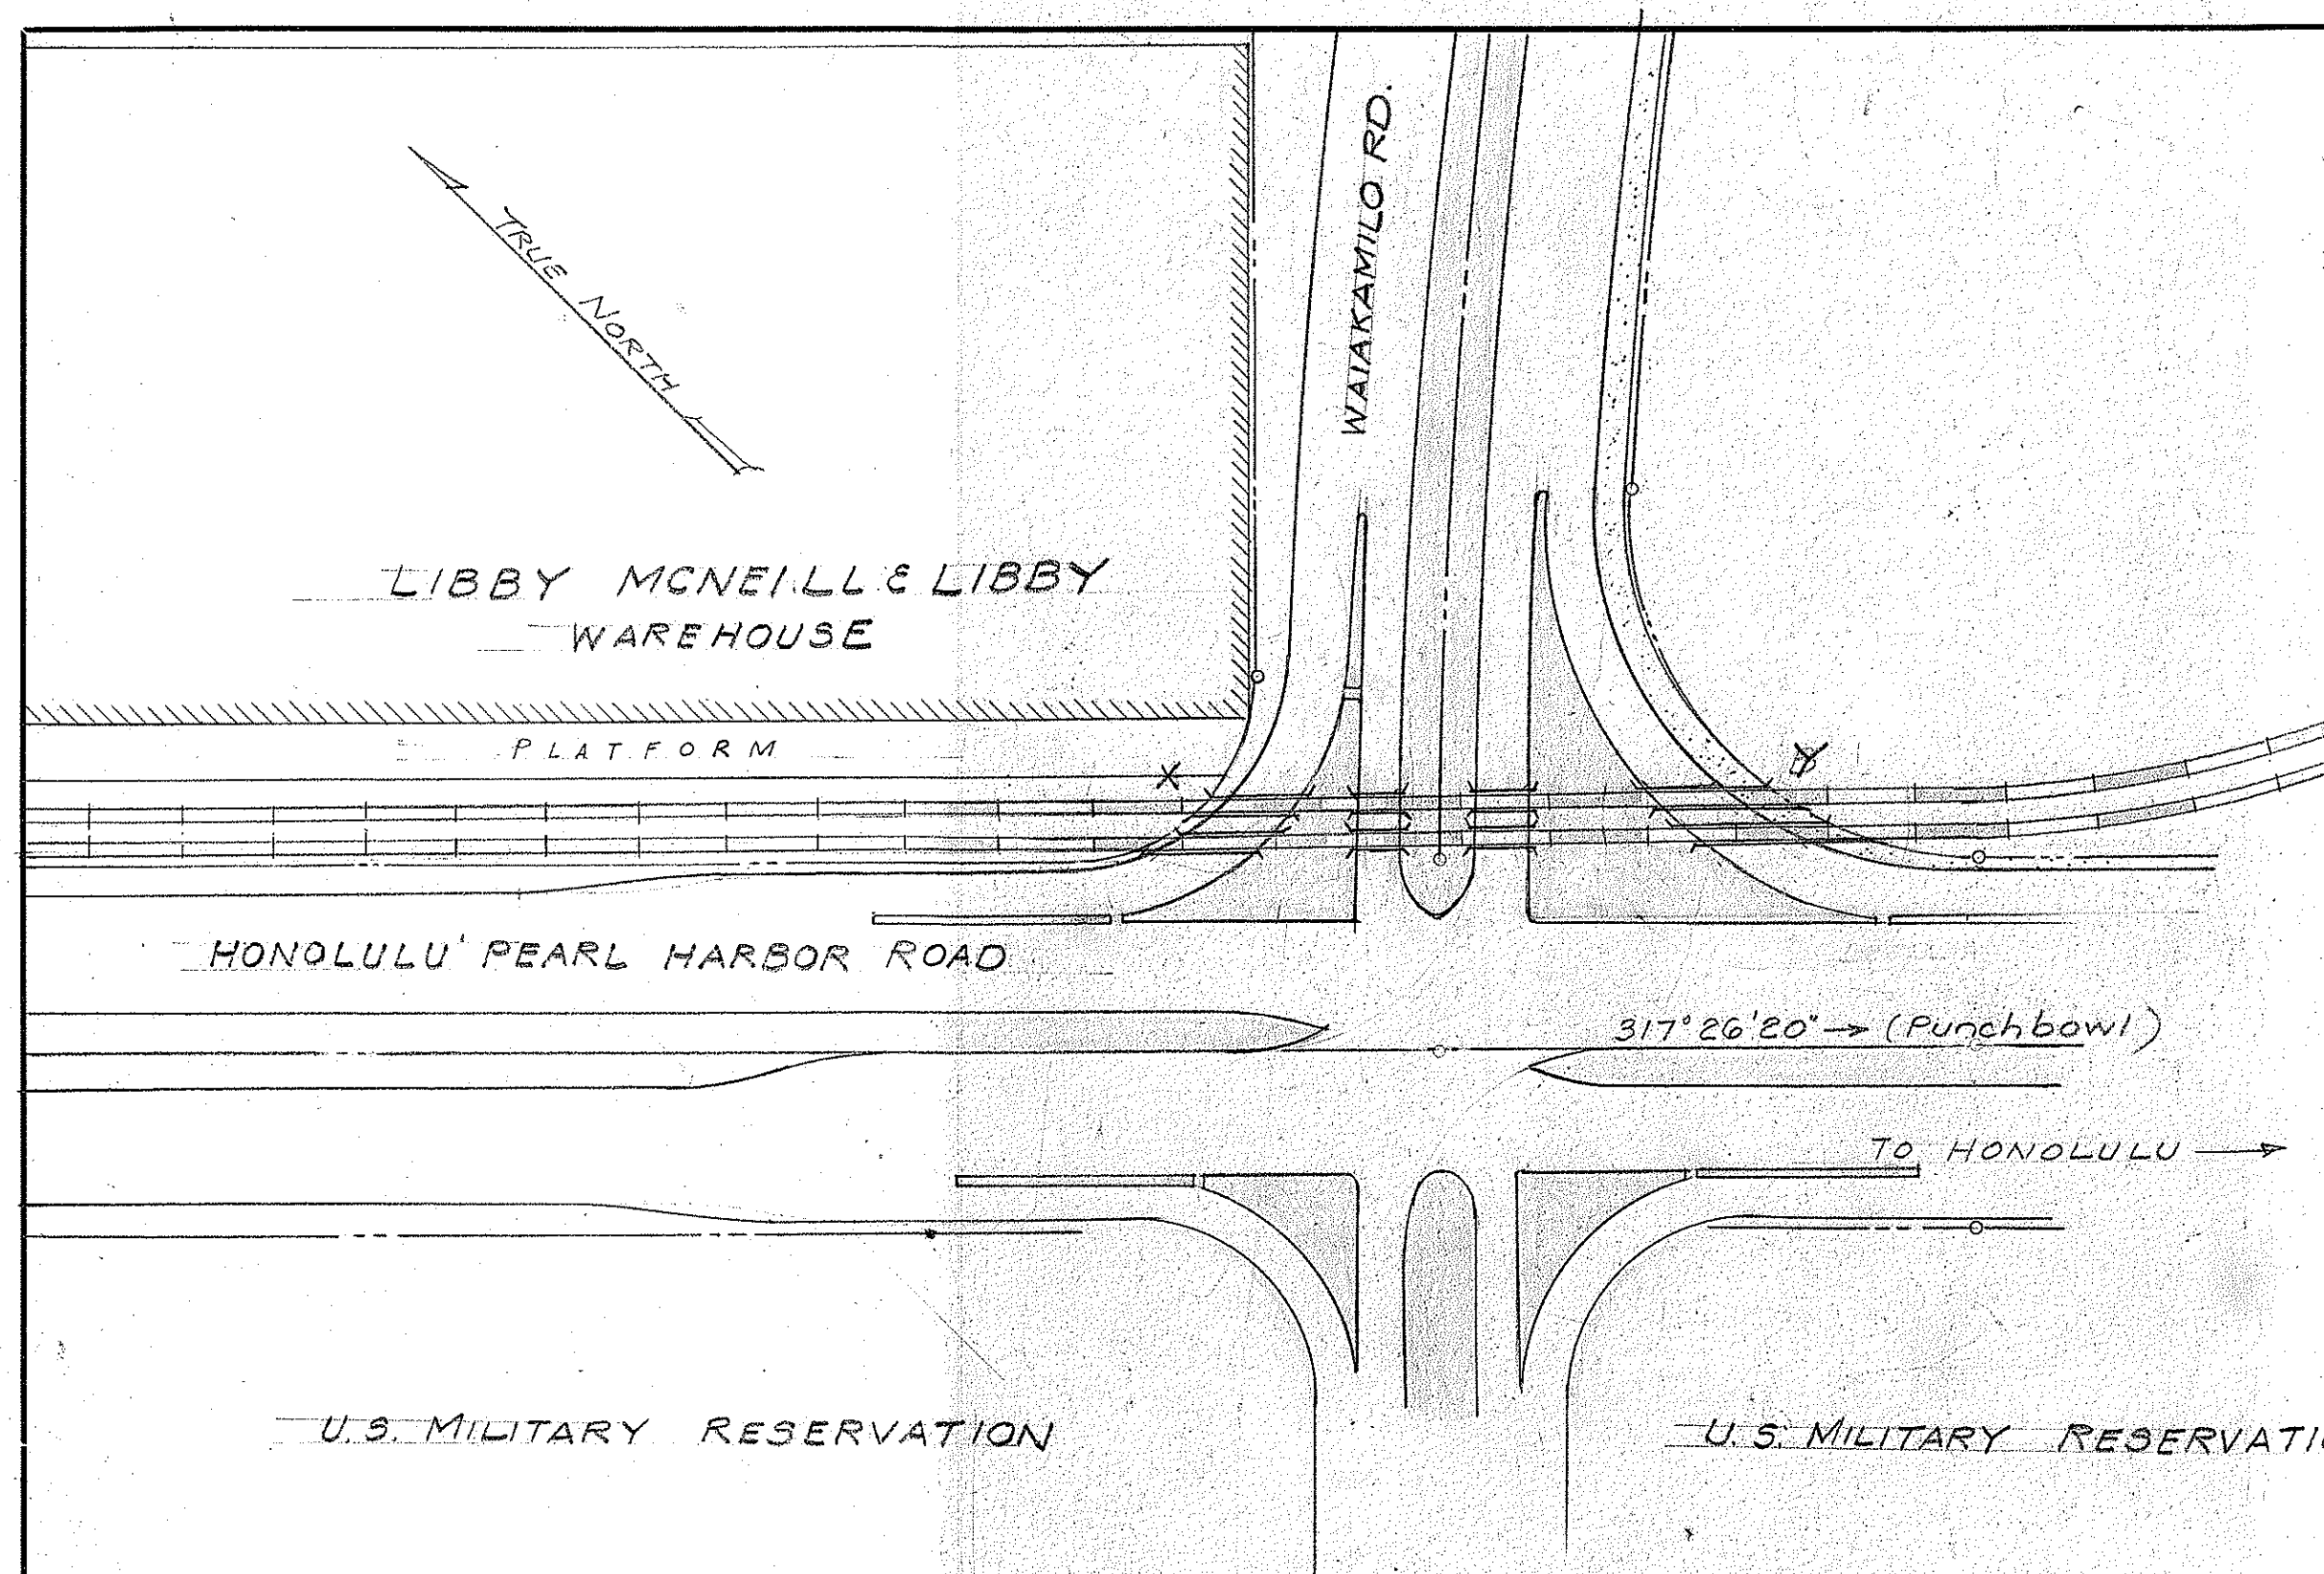


PLAN
Scale: 1" = 50'


Note:
Under item "Adjusting Industrial Track" track X-Y is to be raised 6' above present grade so that this portion of track will be brought to the same level as the adjacent track.

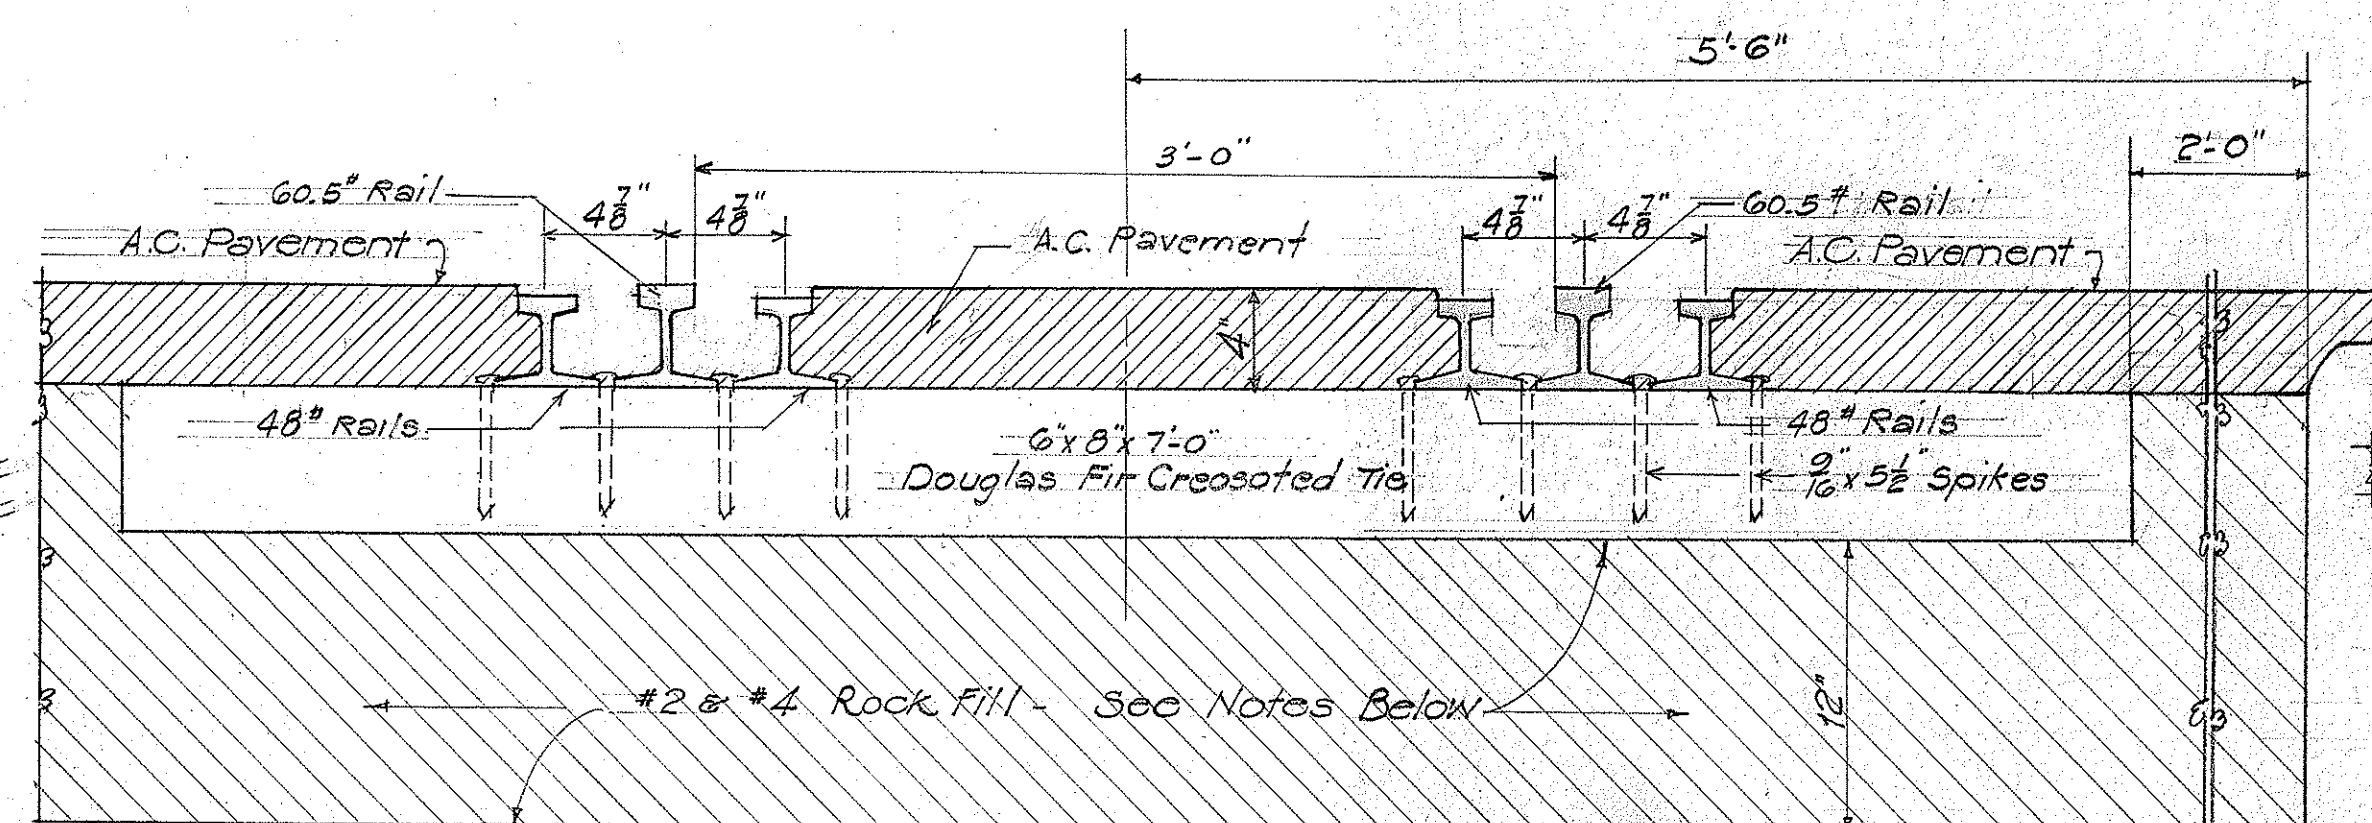

SECTION A-A
Scale: 1 1/2" = 1'-0"

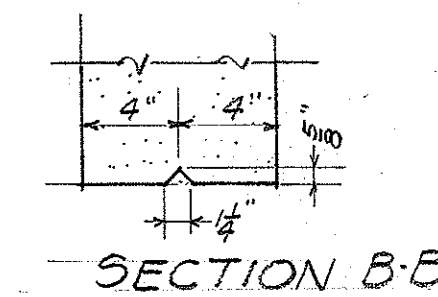

SECTION B-B

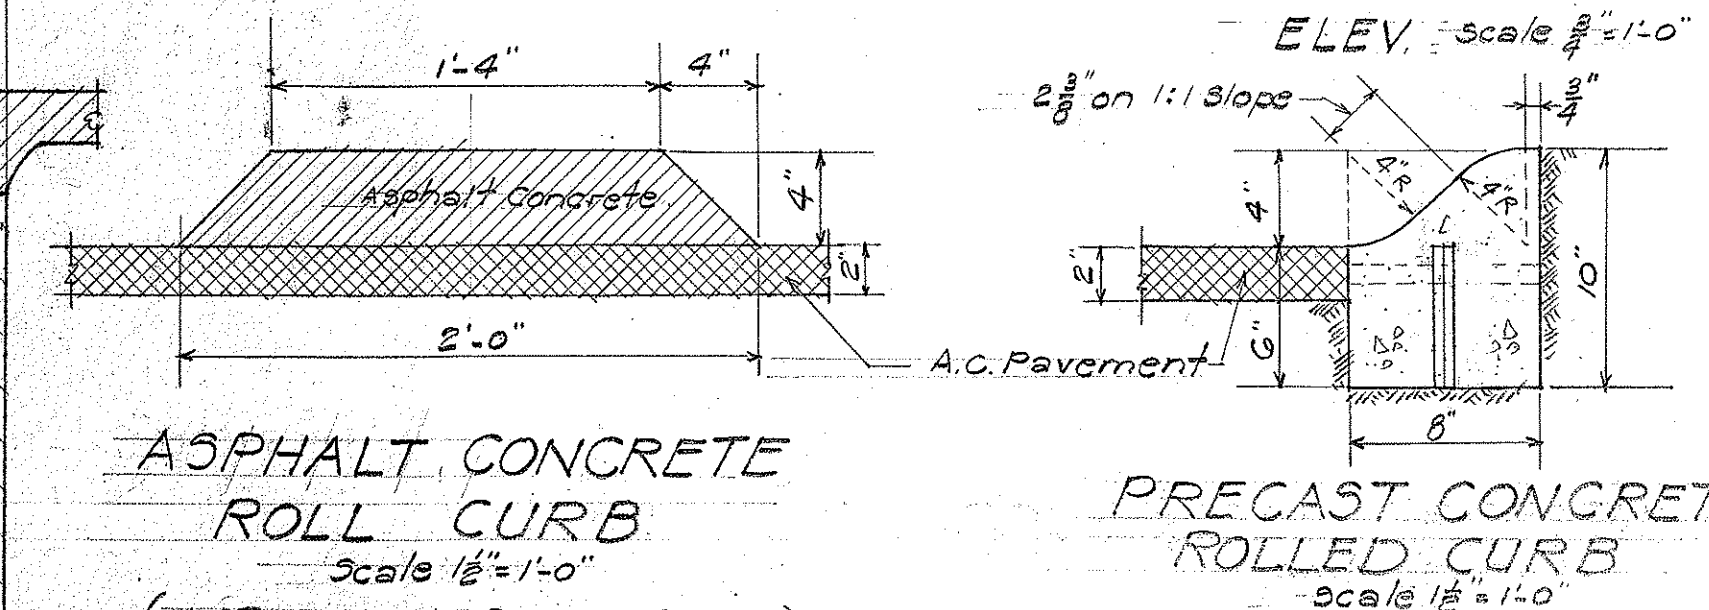

ASPHALT CONCRETE ROLL CURB
Scale: 1 1/2" = 1'-0"

PRECAST CONCRETE ROLLED CURB
Scale: 1 1/2" = 1'-0"


(TYPICAL NORMAL SECT.) OMIT ROLLED CURB IN THIS CONTRACT
NOTE: For further detail, see DETAILS OF AC ROLL CURB No. 5121 Rev. JOB No. 5121.
USE STD CONC. CURB WITH 4" EXPOSURE.

NOTE

The entire area 1-2-3-4 shown in ENLARGED PLAN from top of tie to 18" below top of tie is to be covered with No. 2 crushed rock filled with No. 4 crushed rock sand, properly sprinkled with water, if necessary, and tamped with pneumatic tamping tools until fully consolidated.
The shaded area as shown is to be paved with Asphaltic Concrete.
A.C. Pavement is to have 4" finished thickness with surface 1/4" above rails. Place this in two layers: the first layer to be 2 1/2" thick (loose) and thoroughly compacted with rollers and pneumatic tools; the second layer, sufficiently thick to bring surface to grade, shall be tamped with pneumatic tools around tracks and finished by rolling in both directions with 10 ton power roller. Keep A.C. material off of rail tops during this operation.


The hatched area within the roadway prism in the vicinity of the tracks shall be brought to grade with No. 2 crushed rock filled with No. 4 crushed rock sand as described above.

Oahu Railway & Land Co. to perform all track work.

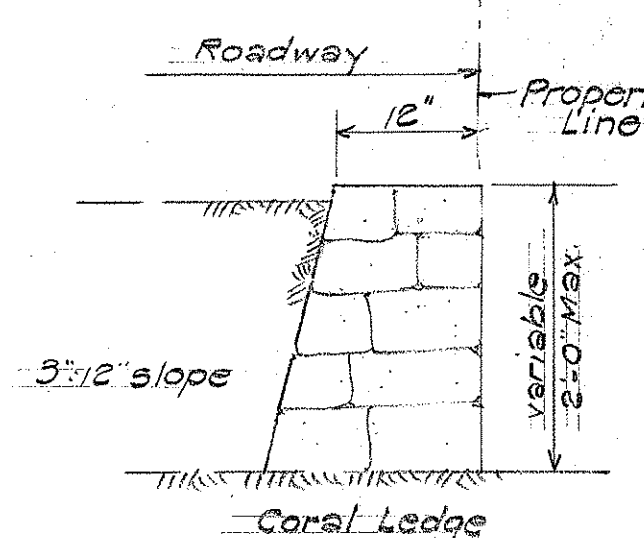

C.R.M. RETAINING WALL
Scale: 3/4" = 1'-0"

REPLACE C.R.M. WALL WITH BOULDER CONC. WALL (CLASS 'C' CONCRETE WITH RUBBLE ONE MAN STONE)
(NONE CALLED FOR UNDER DA-WR-3)

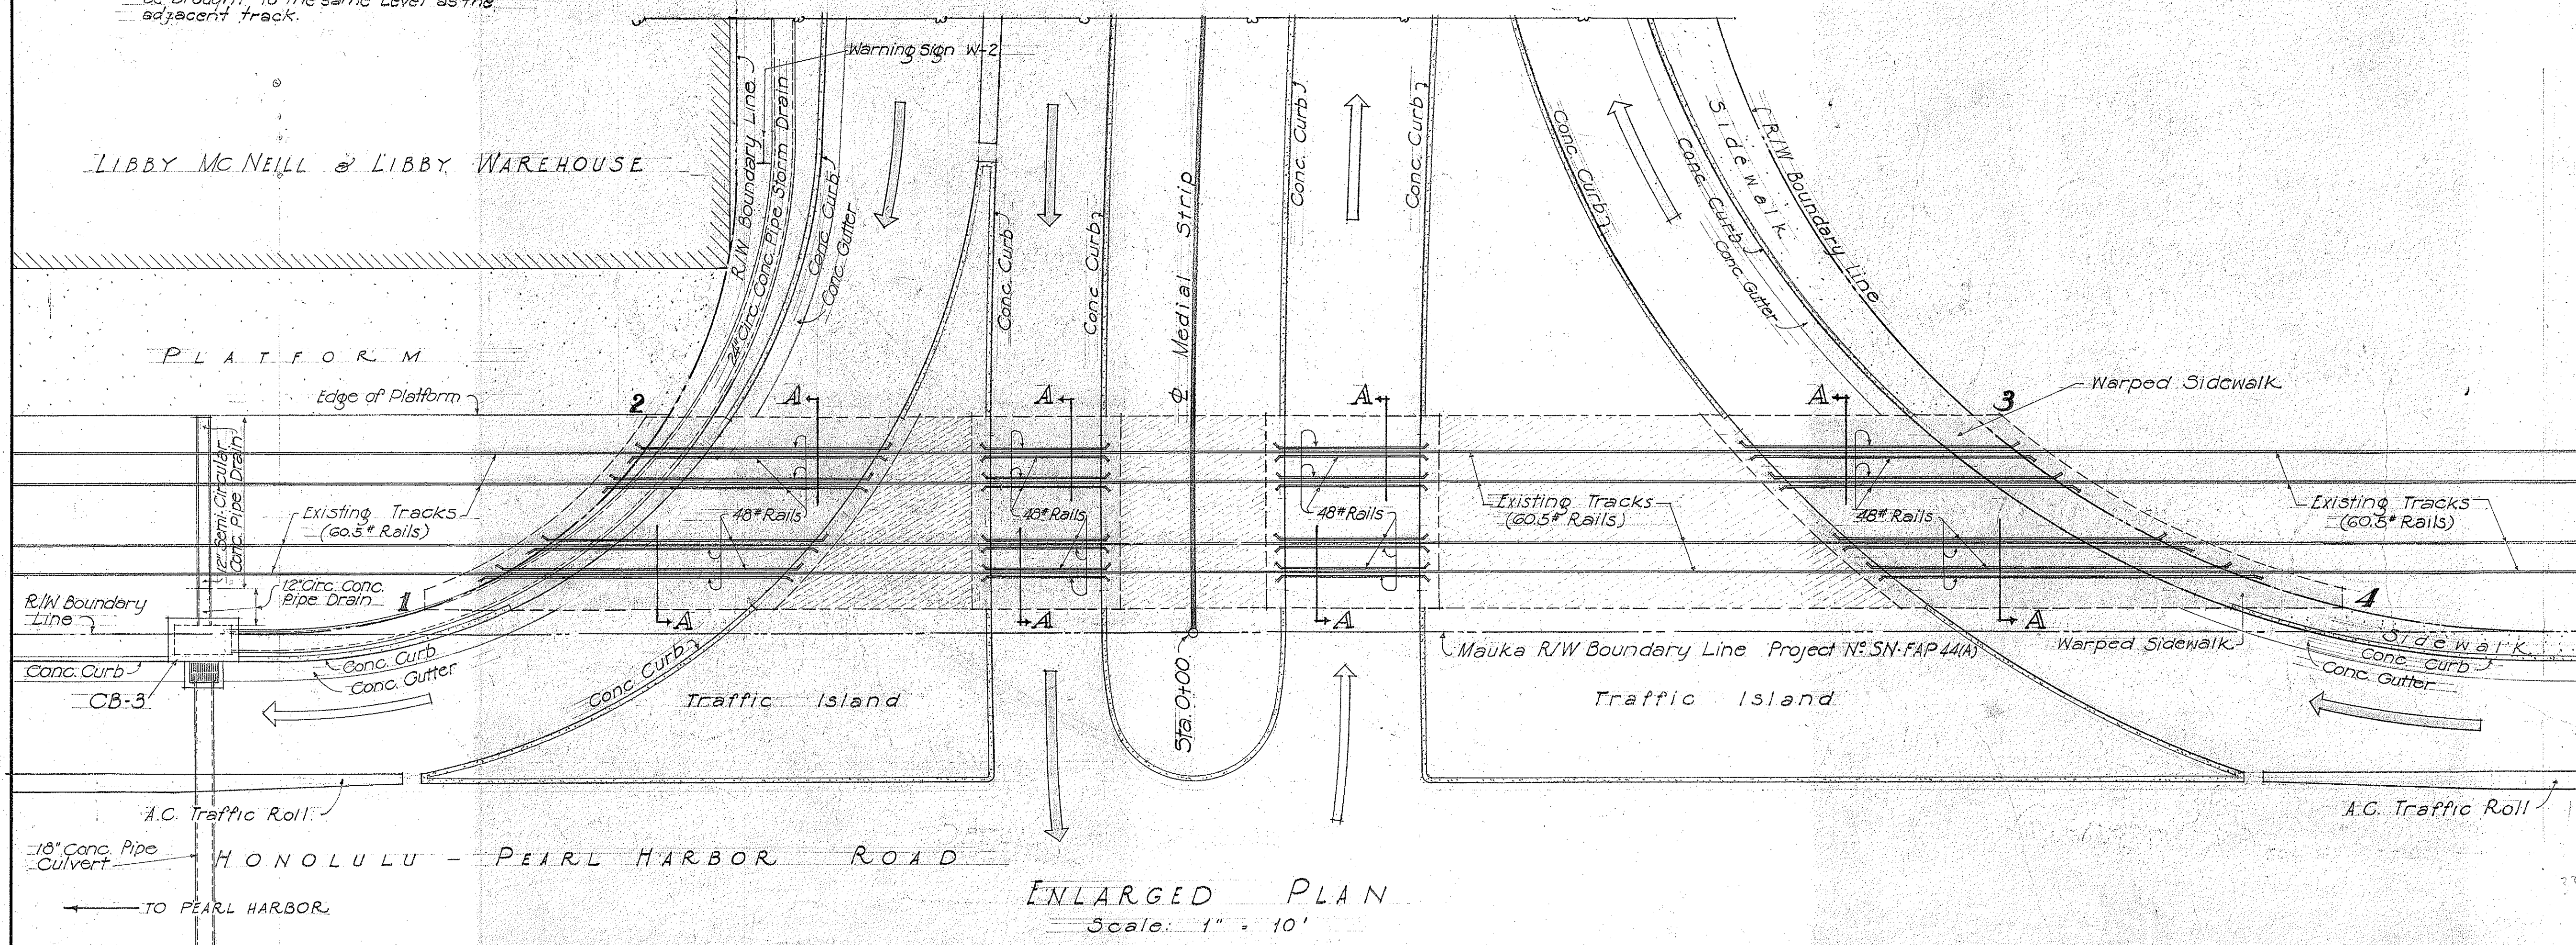

ENLARGED PLAN
Scale: 1" = 10'

TERRITORIAL HIGHWAY DEPARTMENT
TERRITORY OF HAWAII
MISCELLANEOUS DETAILS
WAIKAMILLO ROAD EXTENSION

SCALES: AS NOTED
REV. 5-18-44
APRIL 1, 1944
DA-WR-3

SHEET No. 7 OF 10 SHEETS

5109.G.D

PROJECT NO. SN-FAP 44-A (2)
PEARL HARBOR HONOLULU
HAWAII



5109.G.D

DATE: APRIL 1, 1944

Revised 5-18-44

ORIGINAL PLAN	DATE
NOTED BY	
TRACED BY	
QUANTITIES CHECKED BY	
NO.	

ORIGINAL PLAN	SURVEY PLOTTED BY.....DATE.....	
	DESIGNED BY.....	
NOTE BOOK	DRAWN BY.....	
	TRACED BY.....	
	QUANTITIES BY.....	
	CHECKED BY.....	
No.		

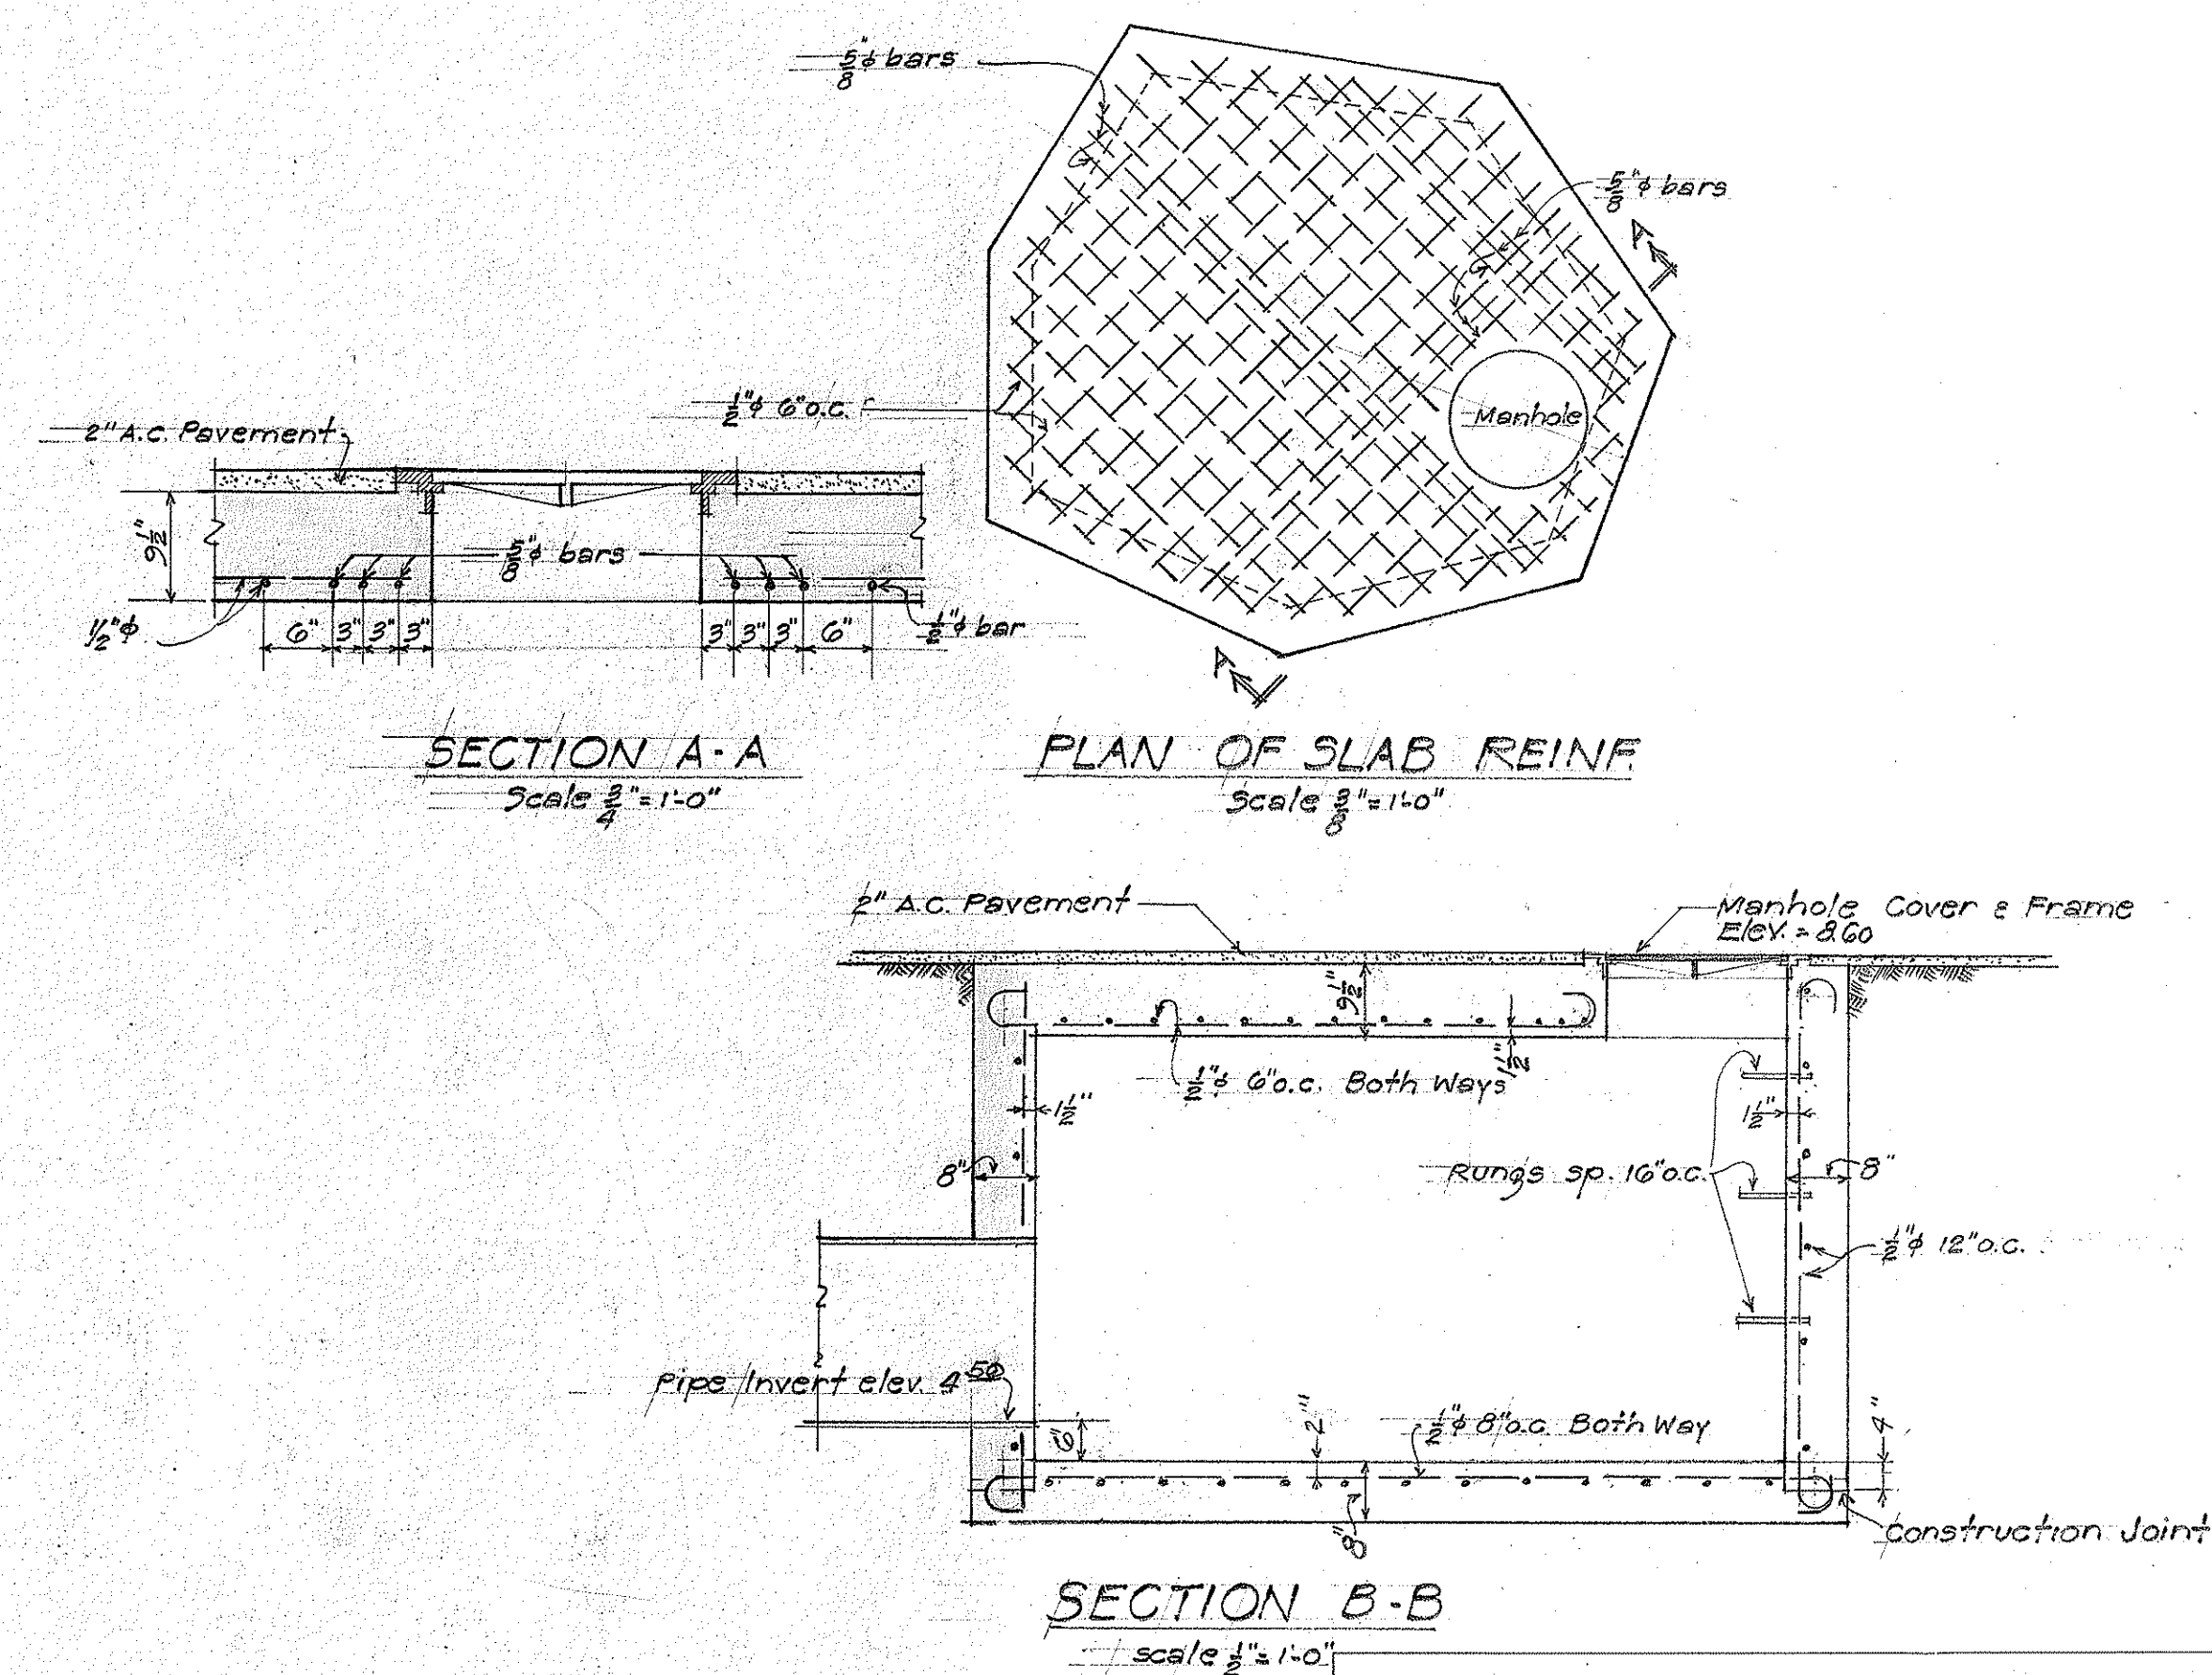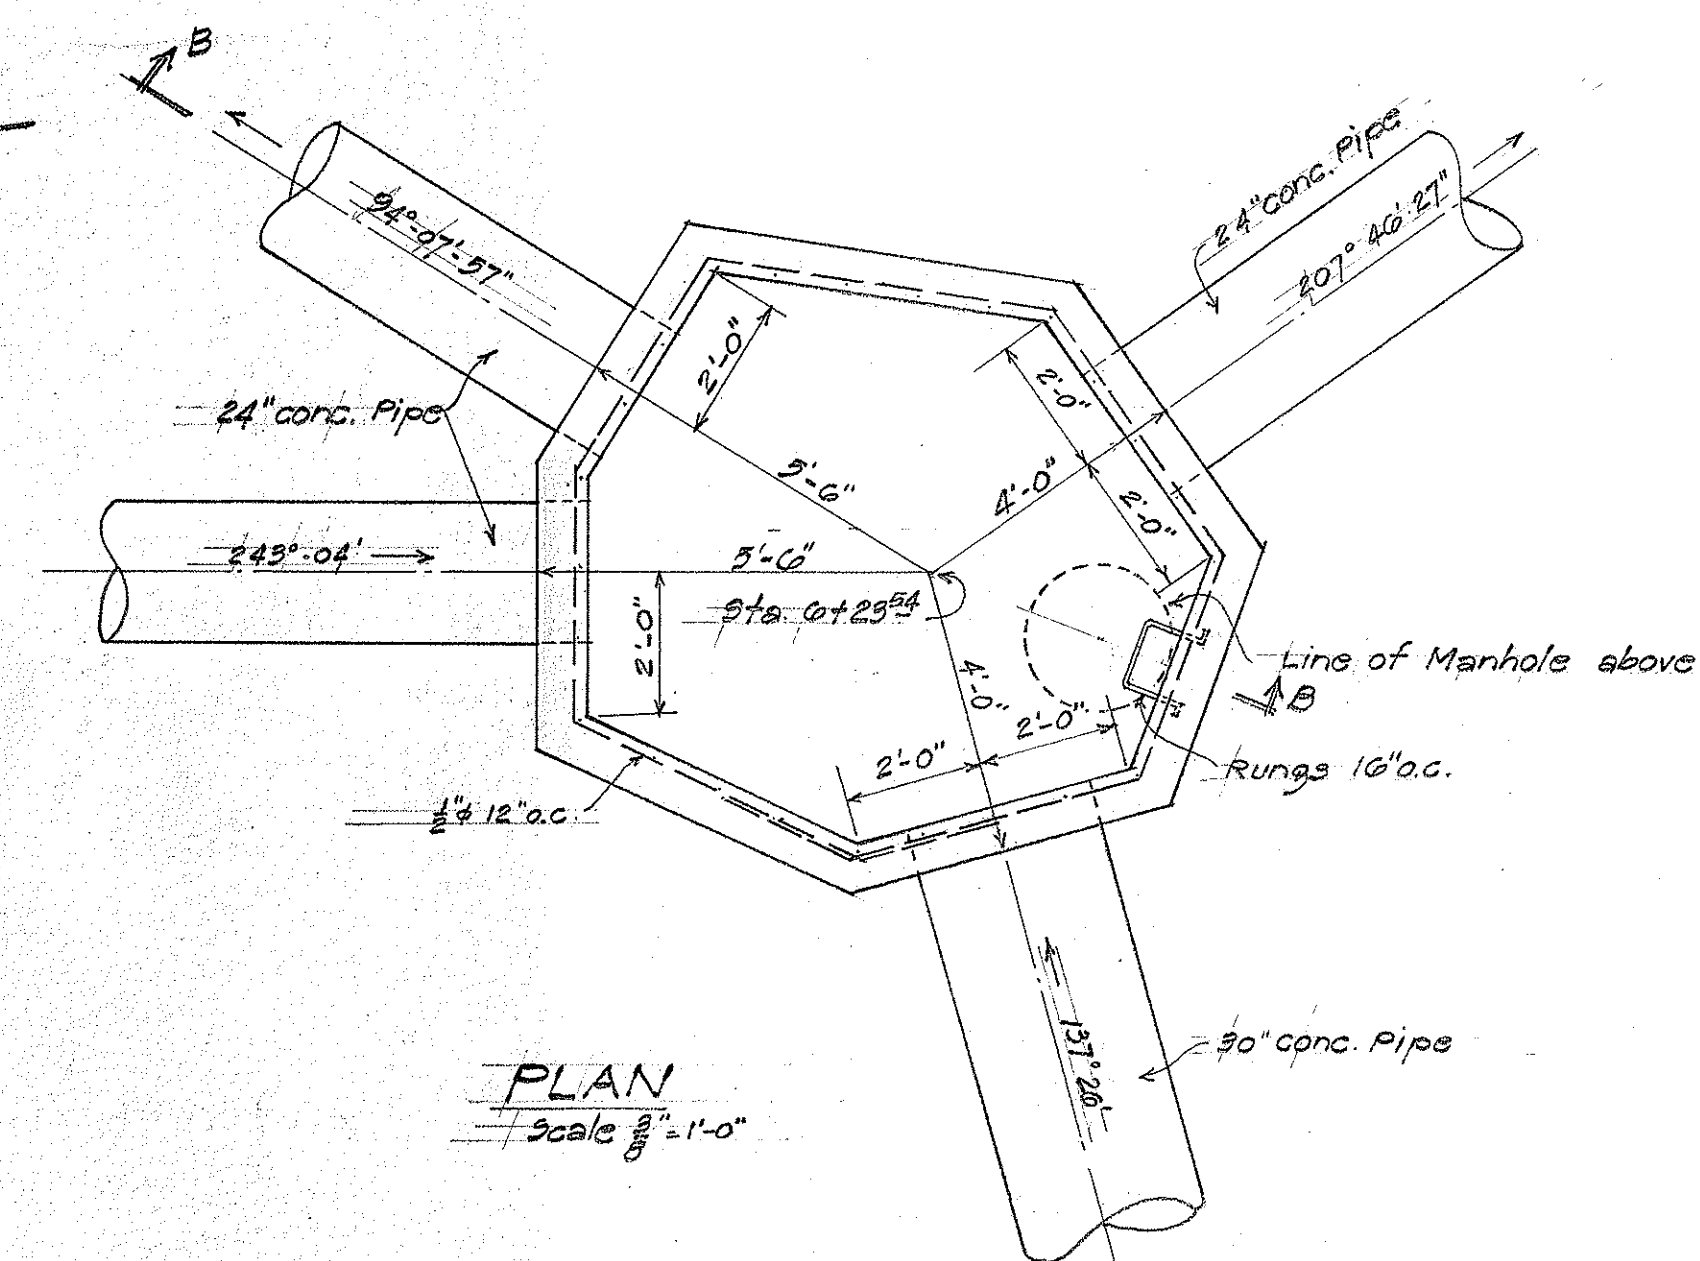

TERRITORIAL HIGHWAY DEPARTMENT
TERRITORY OF HAWAII
WAIKAKAMILO RD. EXTENSION DA-1183
April 1943