


INDEX TO DRAWINGS	
SHEET NO.	DESCRIPTIONS
1	Title Sheet
2	Typical Sections
3	Plan & Profile
4 & 5	Standard Details
6, 6A & 6B	Catch Basin Details & Intersection Details
7-10	Cross Sections

TERRITORY OF HAWAII
TERRITORIAL HIGHWAY DEPARTMENT
HONOLULU T.H.
PLANS OF
WAIKAMILO ROAD EXTENSION
FEDERAL AID PROJECT NO. DA-WR-3
DISTRICT OF HONOLULU
ISLAND OF OAHU

CONVENTIONAL
EXISTING ROAD
EXISTING FENCE
BOUNDARY LINE
CENTERLINE
PAVED APPROACHES etc.

CULVERTS
BRIDGES
RAILROAD


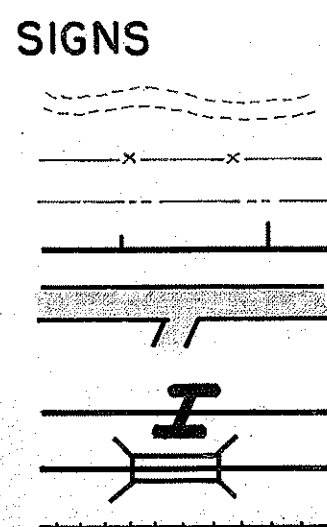


THIS PORTION OF PROJECT NO DA-WR 3 TO BE
CONSTRUCTED AS A PART OF CONTRACT NO 2996 JOB NO 5121

INDEX TO DRAWINGS FOR THIS PORTION			
REFER. NO.	DESCRIPTIONS	SHEET NO.	DATE
1	TITLE SHEET	5109.1	4/1/44
2	TYPICAL SECTIONS	5109.2	"
3	PLAN & PROFILE	5109.3A	"
4 & 5	STANDARD DETAILS	5109.4 & 5109.5	"
6	DRAINAGE	5109.6C	"
7	MISCELLANEOUS	5109.6D	5/18/44
8 & 9	CROSS SECTIONS	5109.7A & 5109.7	"
10	INTERSECTION DETAILS	5109.6E	5/18/44

SCALE

PLAN 1 INCH = 50 FT.
PROFILE HOR. 1 INCH = 50 FT.
VER. 1 INCH = 50 FT.
CROSS SECT. HOR. 1 INCH = 50 FT.
VER. 1 INCH = 50 FT.

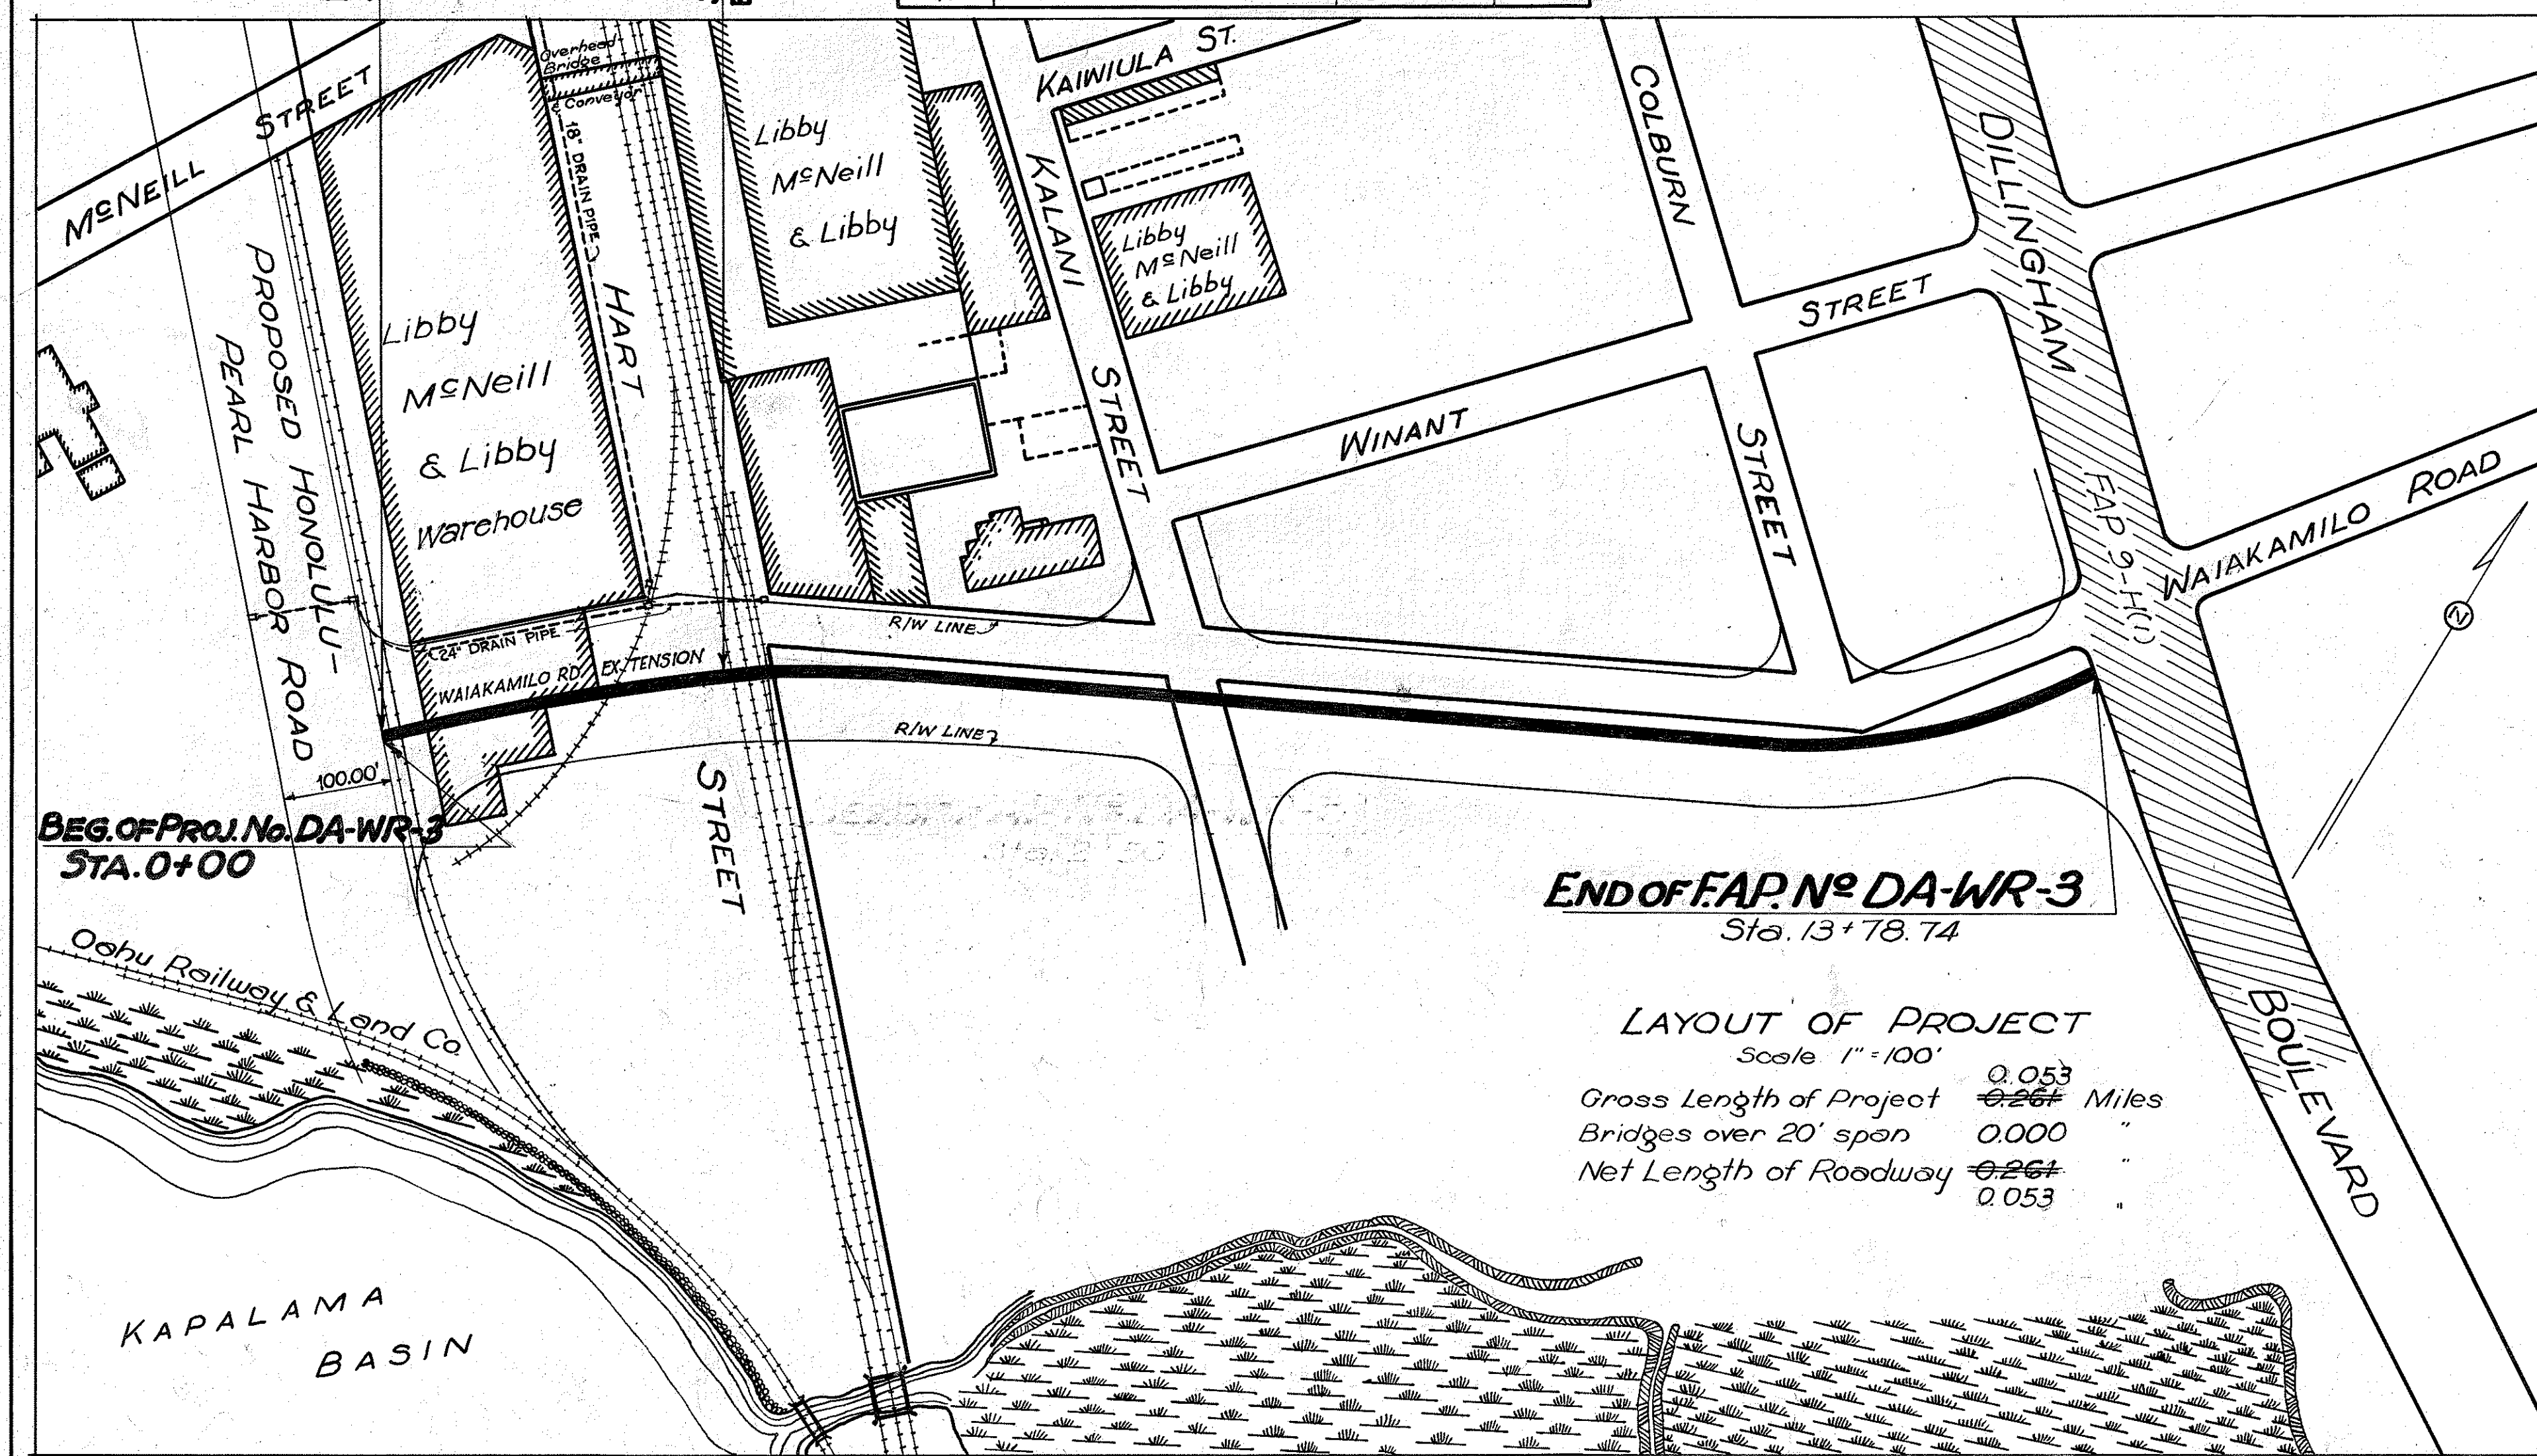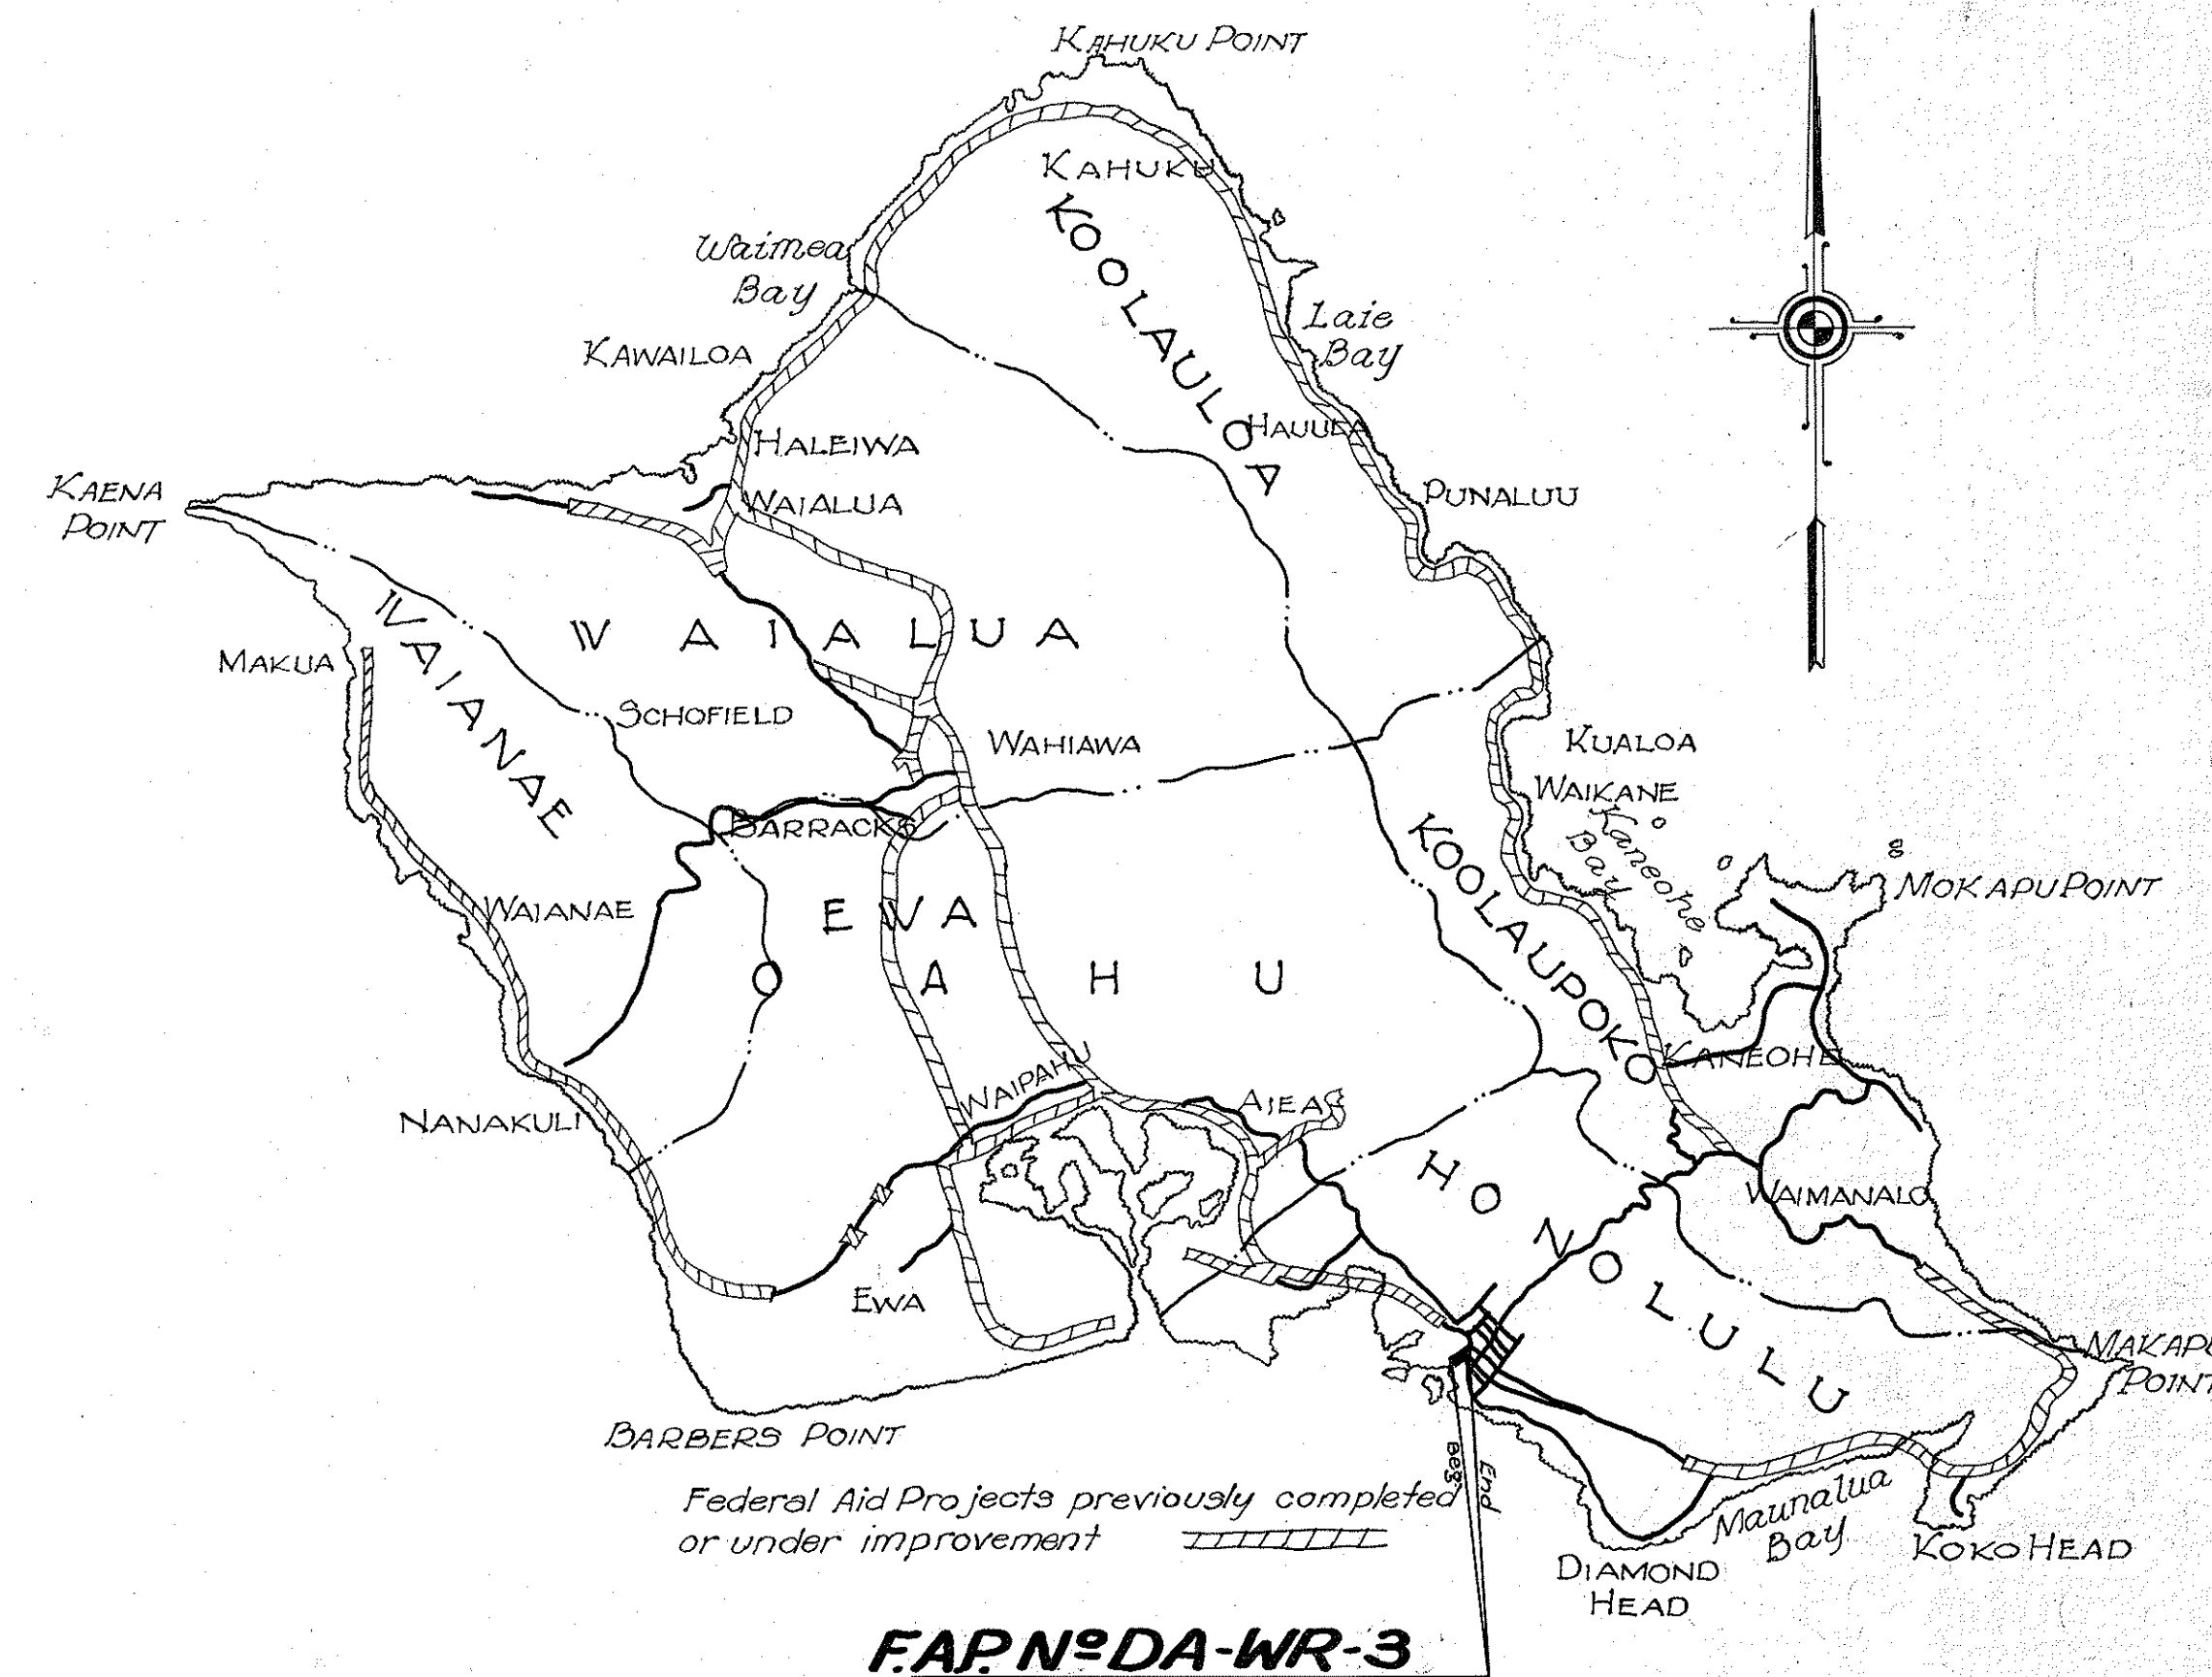

END OF F.A.P. No DA-WR-3
Sta. 13+78.74

LAYOUT OF PROJECT

Scale 1" = 100'

Gross Length of Project 0.053 Miles
Bridges over 20' span 0.000
Net Length of Roadway 0.053

APPROVED:

B. F. Rush
TERRITORIAL HIGHWAY ENGINEER APRIL 1944

APPROVED:

L. O. Baly
TERRITORIAL HIGHWAY ENGINEER APRIL 1943

RECOMMENDED FOR APPROVAL

DISTRICT ENGINEER
PUBLIC ROADS ADMINISTRATION
FEDERAL WORKS AGENCY

RECOMMENDED FOR APPROVAL

CHIEF, WESTERN REGION
PUBLIC ROADS ADMINISTRATION
FEDERAL WORKS AGENCY

APPROVED

COMMISSIONER
PUBLIC ROADS ADMINISTRATION
FEDERAL WORKS AGENCY

5109.1

DATE: APRIL 1, 1944

SURVEY PLOTTED BY: _____
DESIGNED BY: _____
TRACED BY: _____
QUANTITIES BY: _____
NOTE BOOK: _____
CHECKED BY: _____
No. _____