
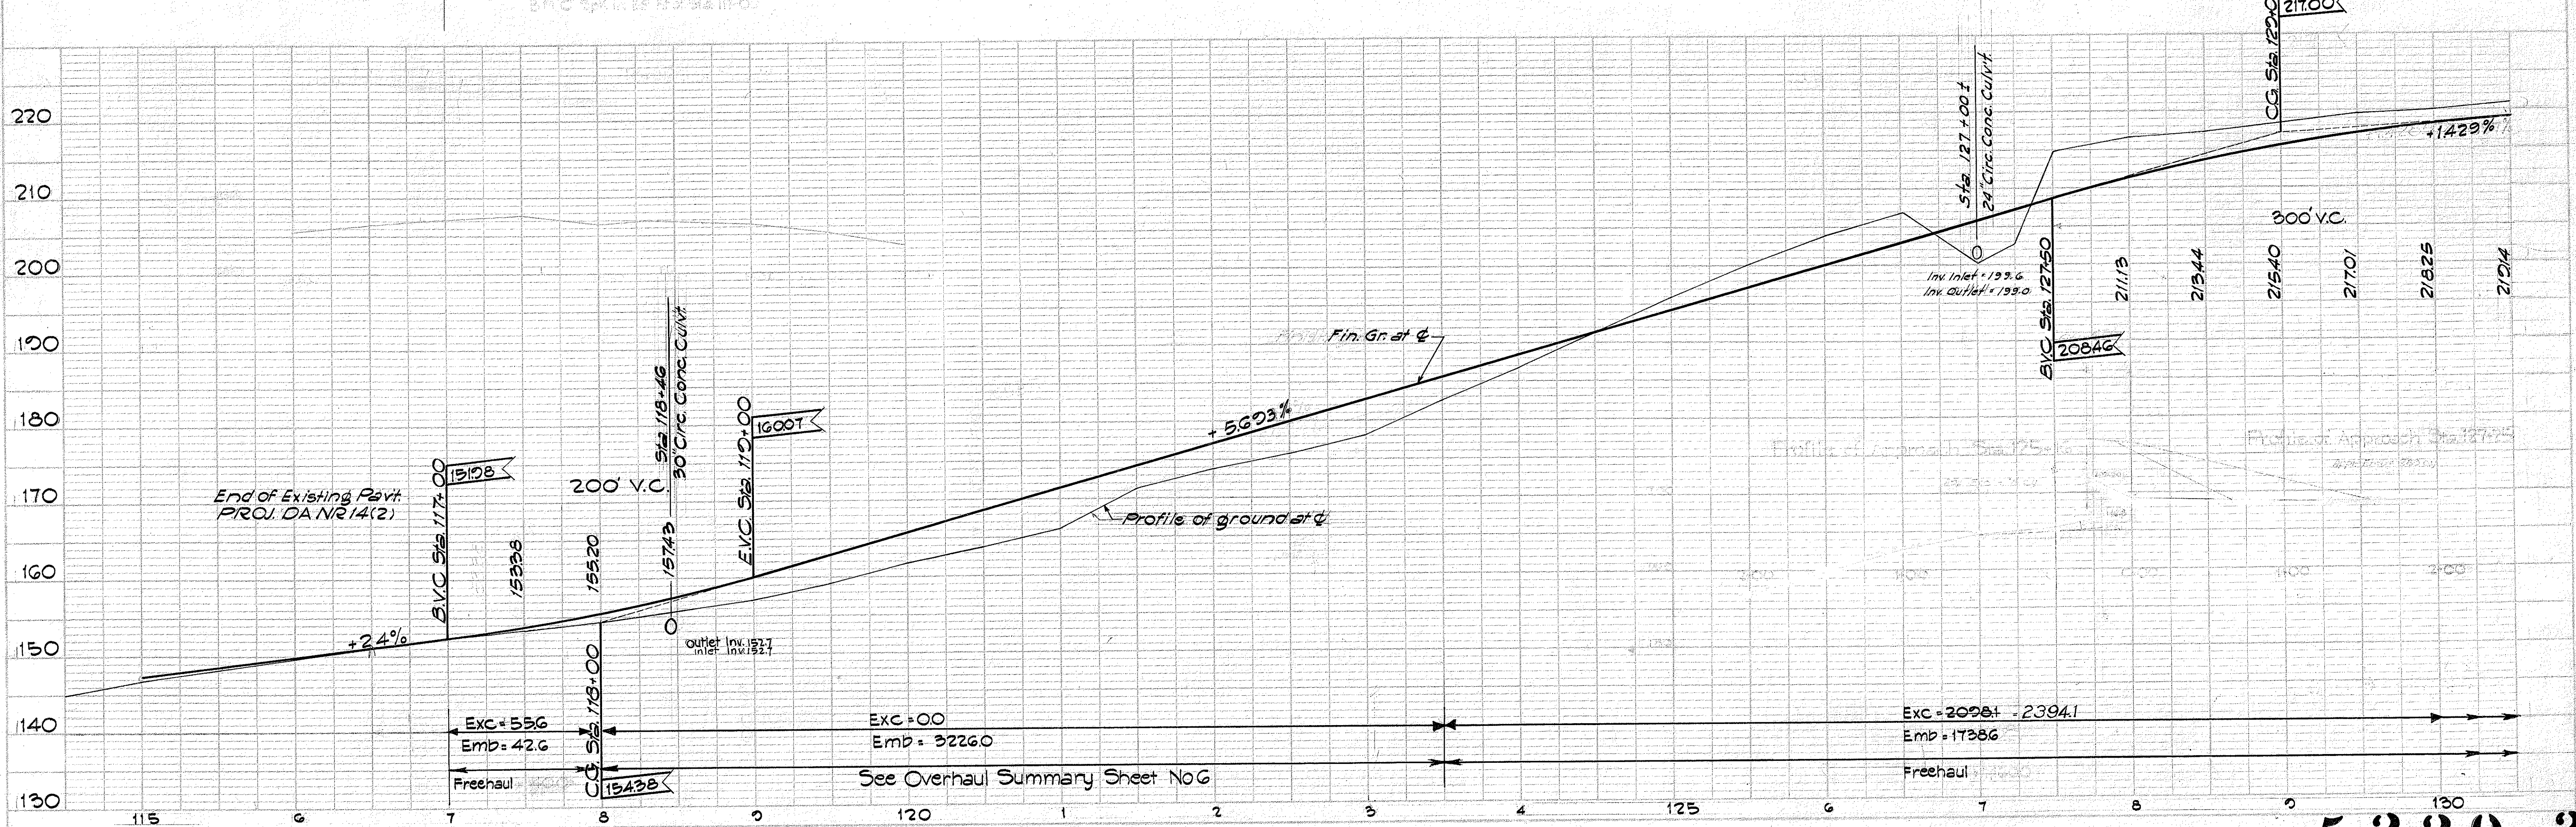




PLAN
SURVEYED BY
DATE
NOTE BOOK NO. & LOCATION CHECKED
BY
DATE
NO. OF PAGES
BY

PROFILE
SURVEYED BY
DATE
NOTE BOOK NO. & LOCATION CHECKED
BY
DATE
NO. OF PAGES
BY

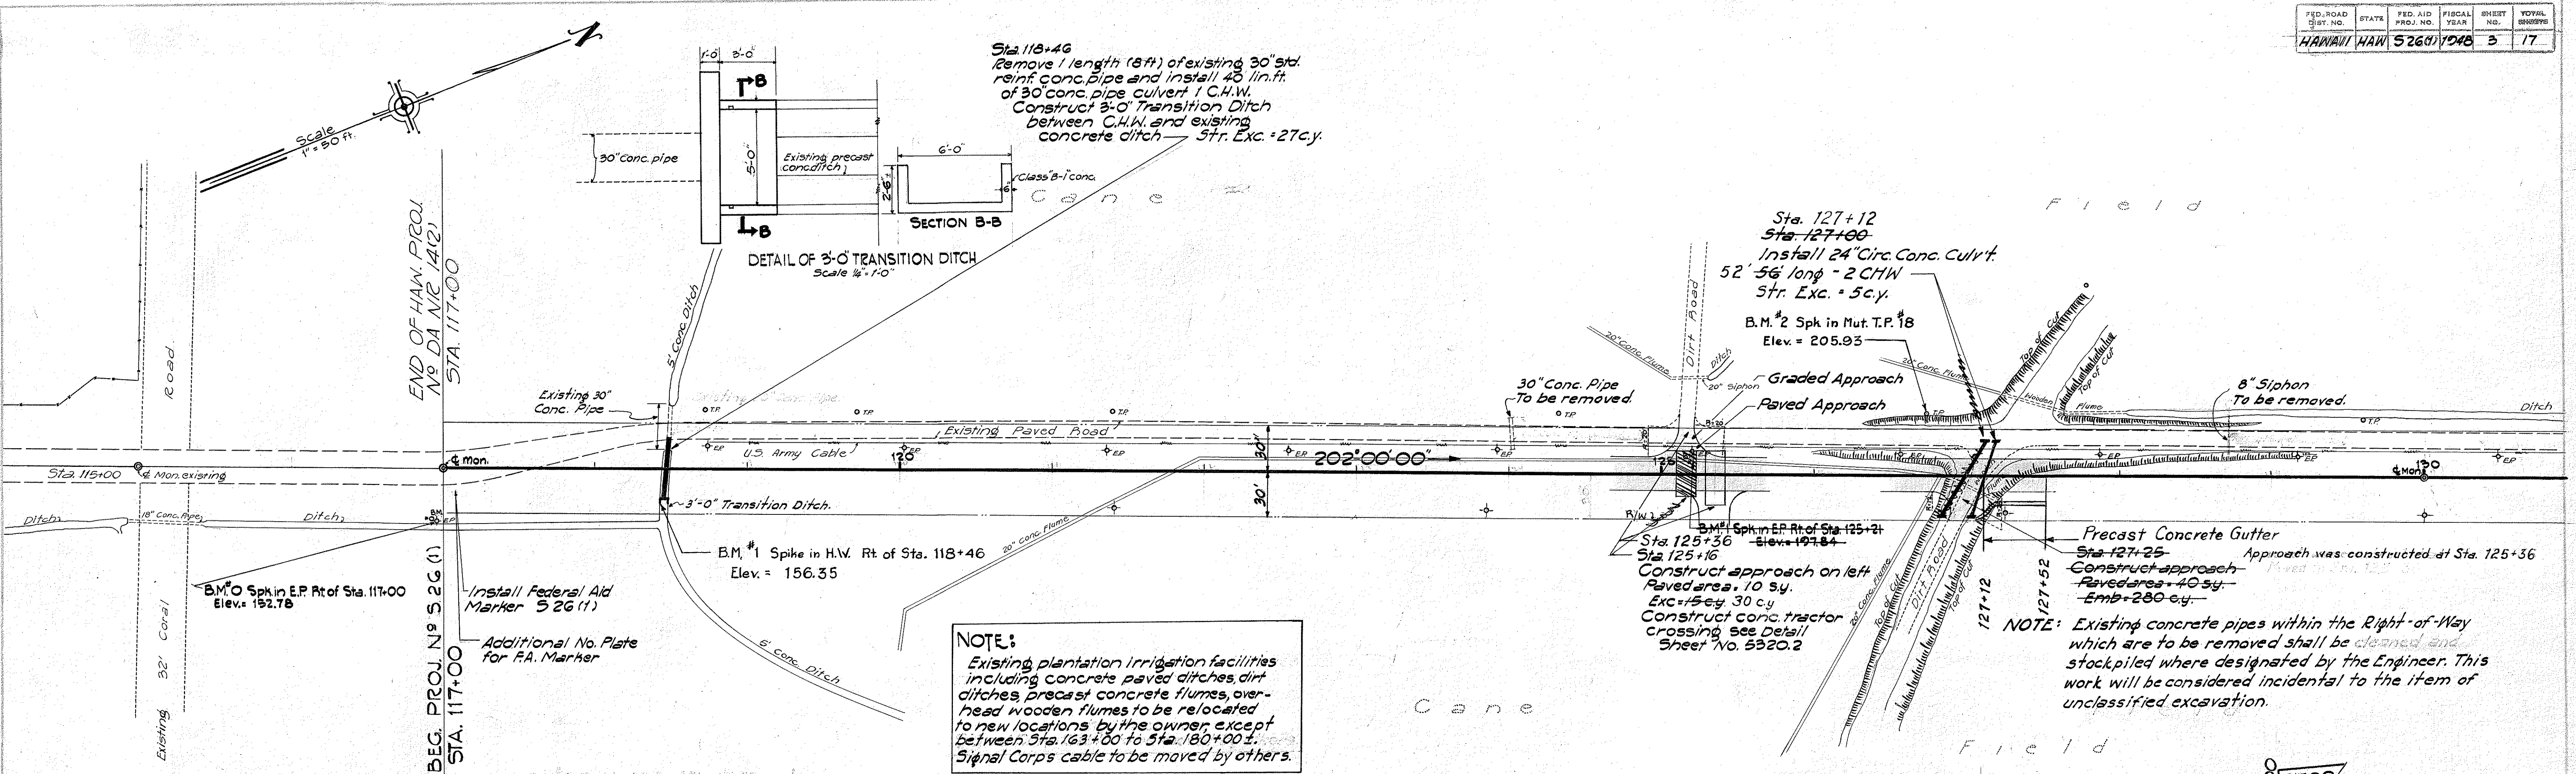





PLAN	SURVEYED	BY	DATE
	PLOTTED		
	NOTE BOOK ALIGNMENT CHECKED		
	RT. OF WAY CHECKED		
	NO.		

PROFILE	SURVEYED	BY	DATE
NOTE BOOK GRADES CHECKED	PLOTTED		
NO. B. & S. NOTED			
STRUCTURE NOTATIONS AND			

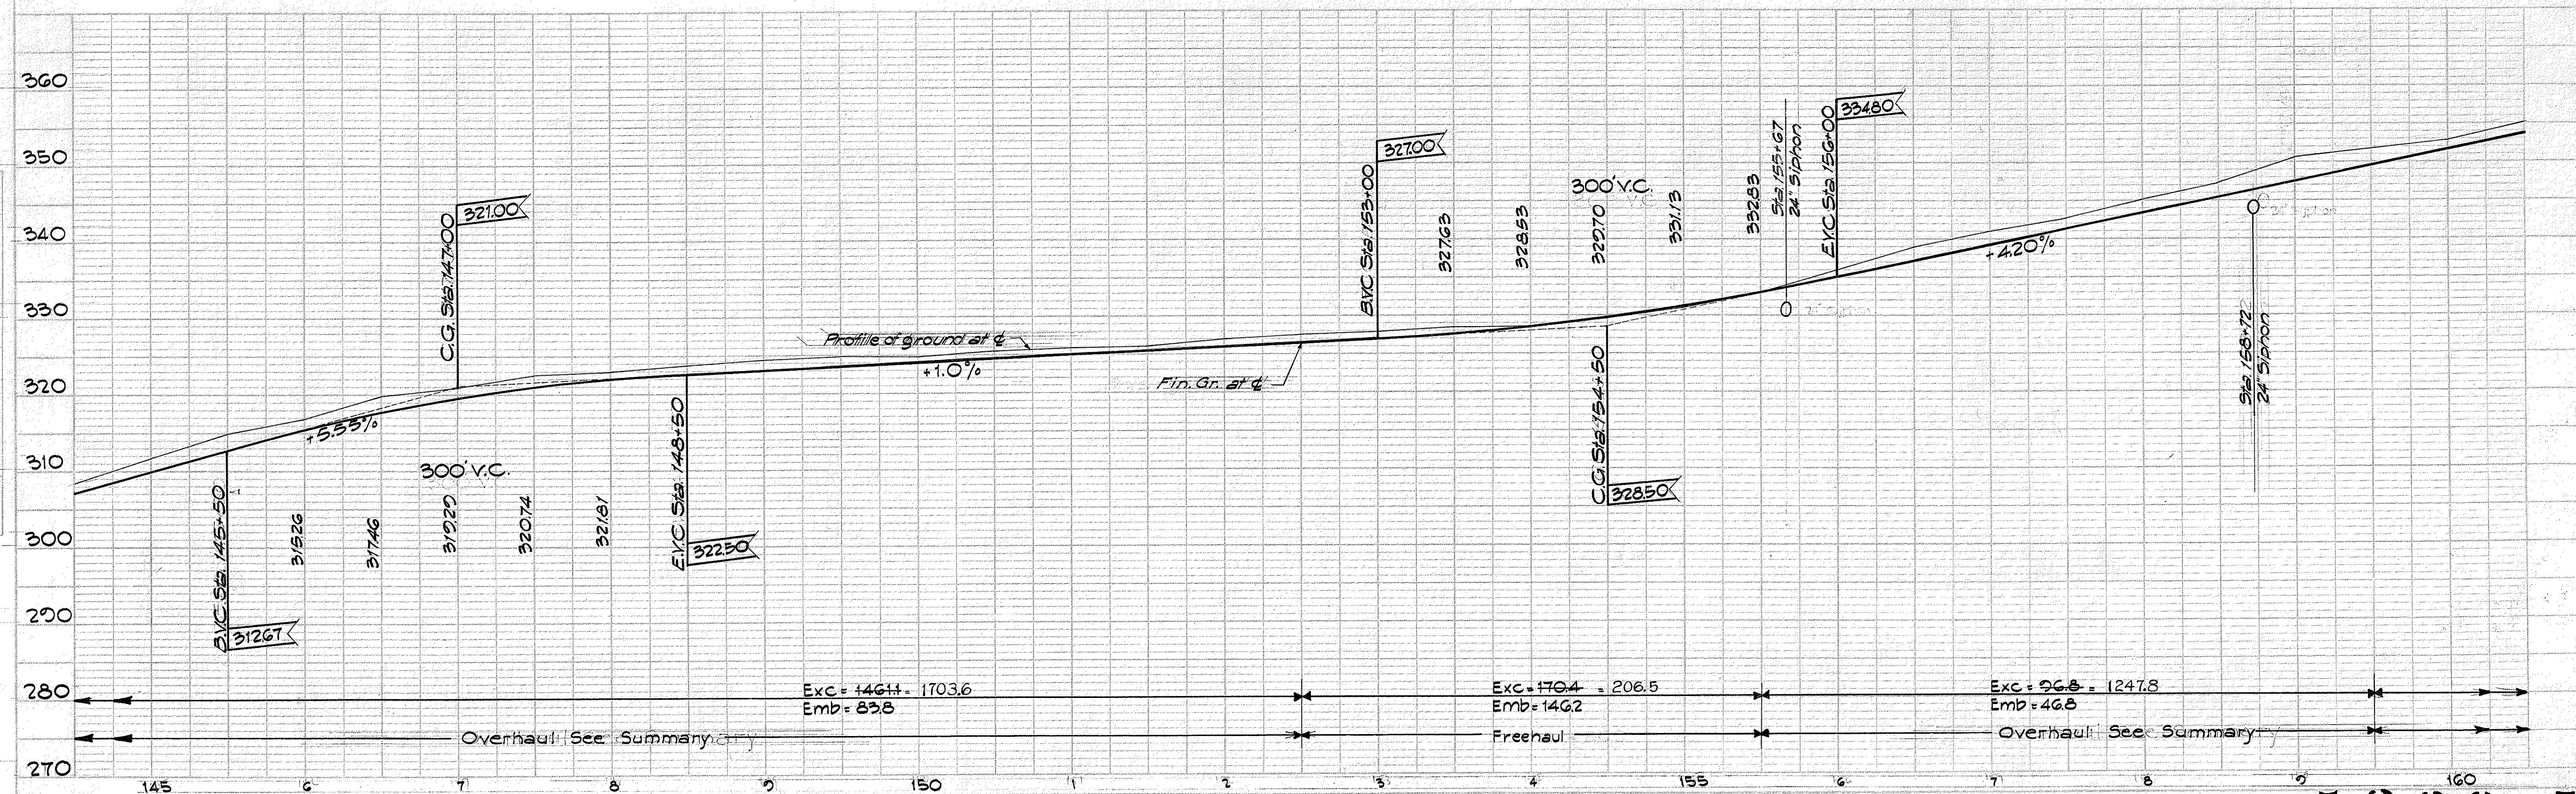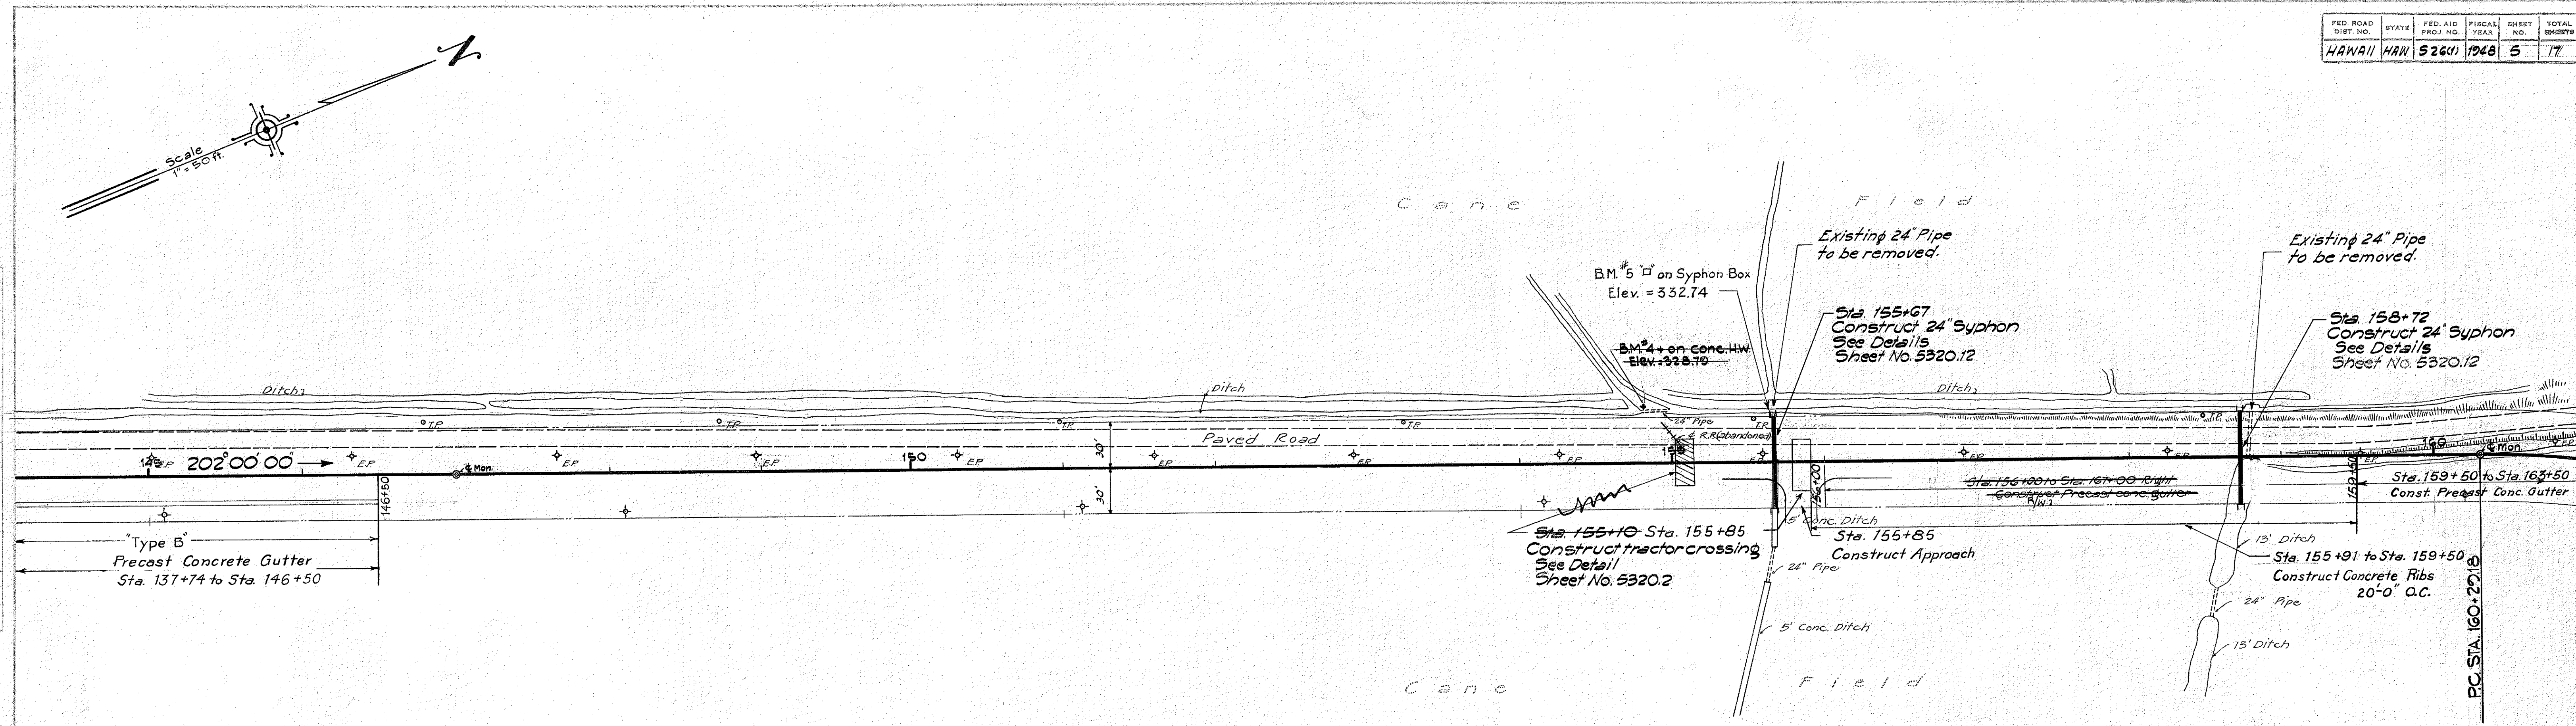


PLAN	DATE
BY	
CHECKED	
APPROVED	
NOTE BOOK	
PLANNING CHECKED	
RT. OF WAY CHECKED	
NO.	

PROFILE	DATE
BY	
CHECKED	
APPROVED	
NOTE BOOK	
GRADES CHECKED	
S. M. NOTED	
STRUCTURE NOTING OTHER	
NO.	

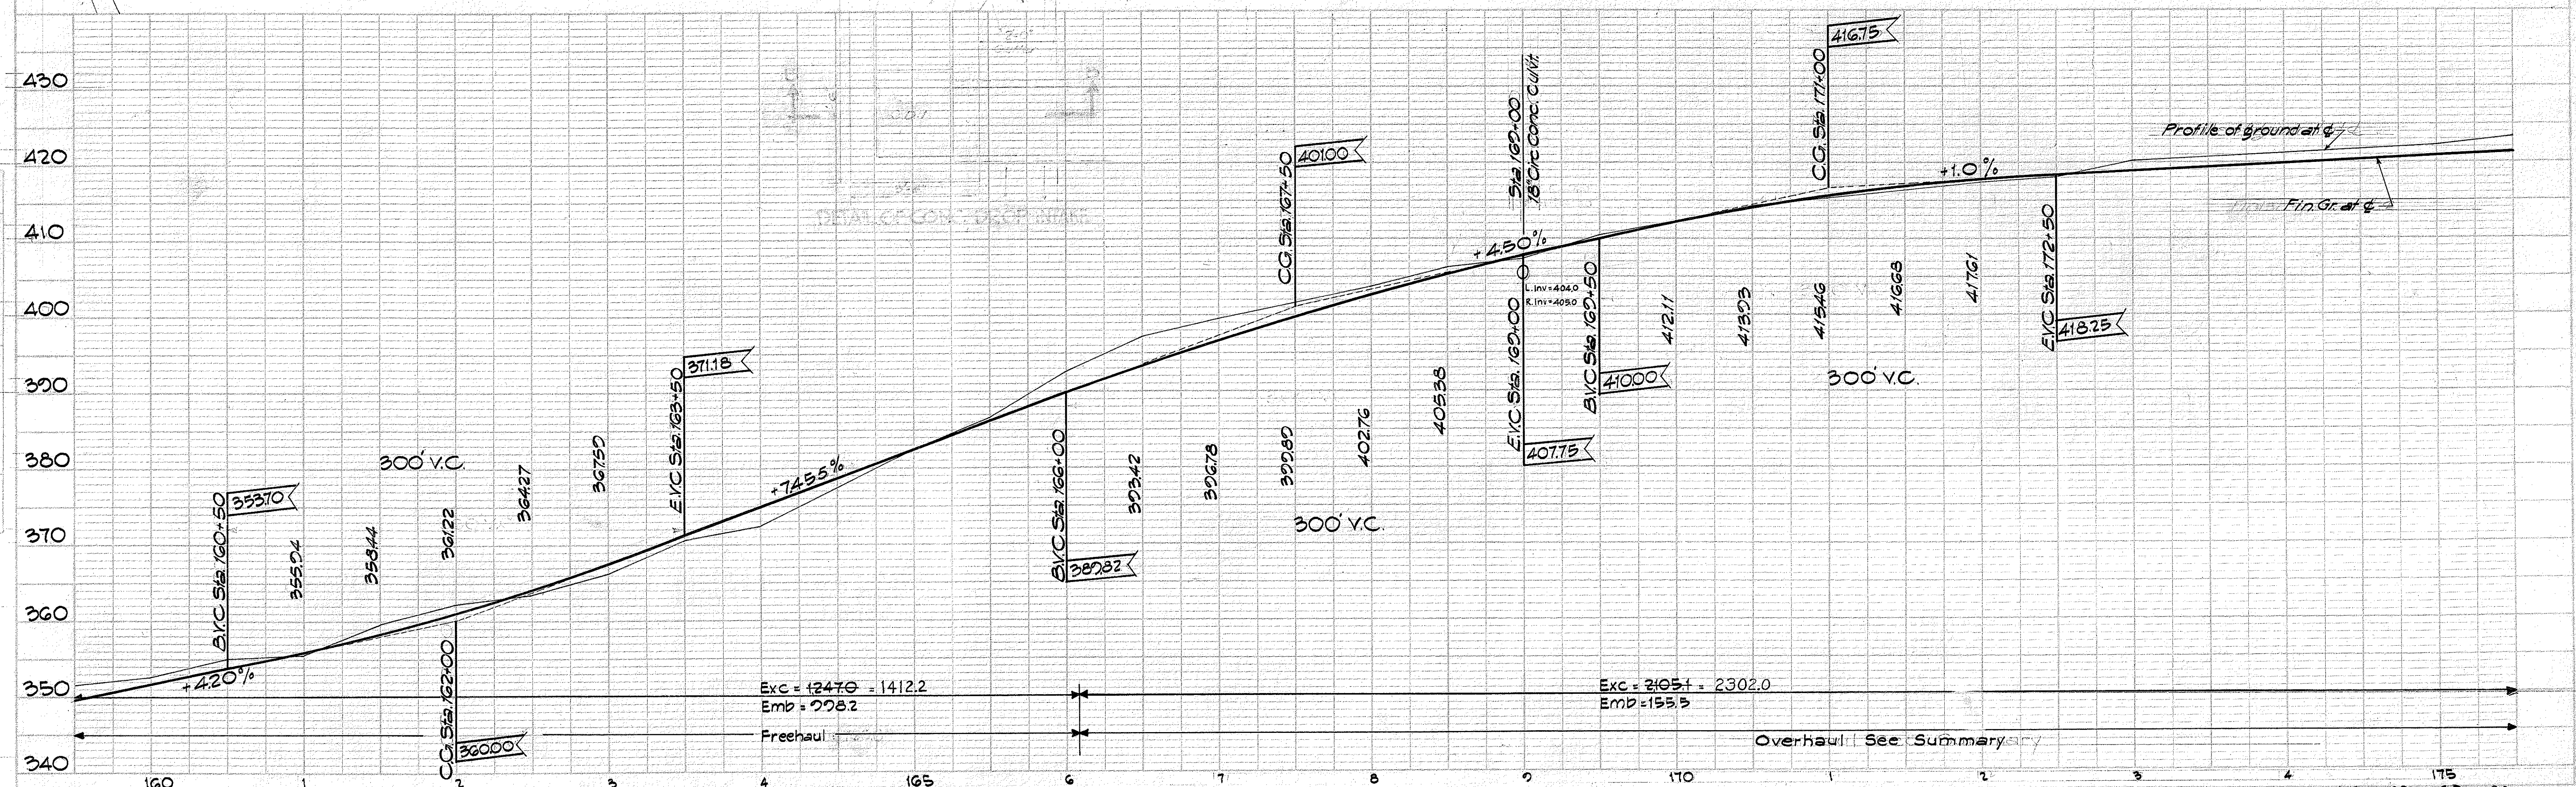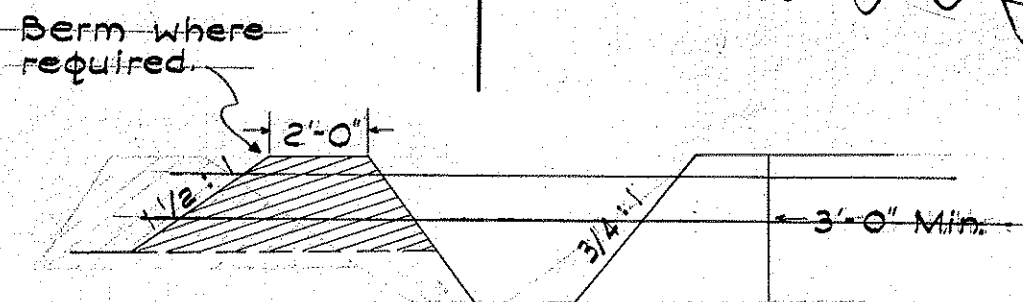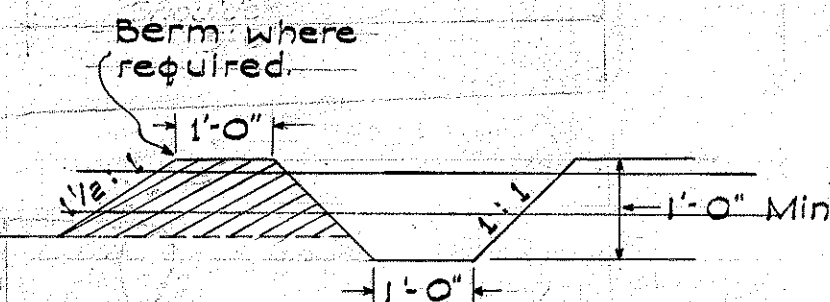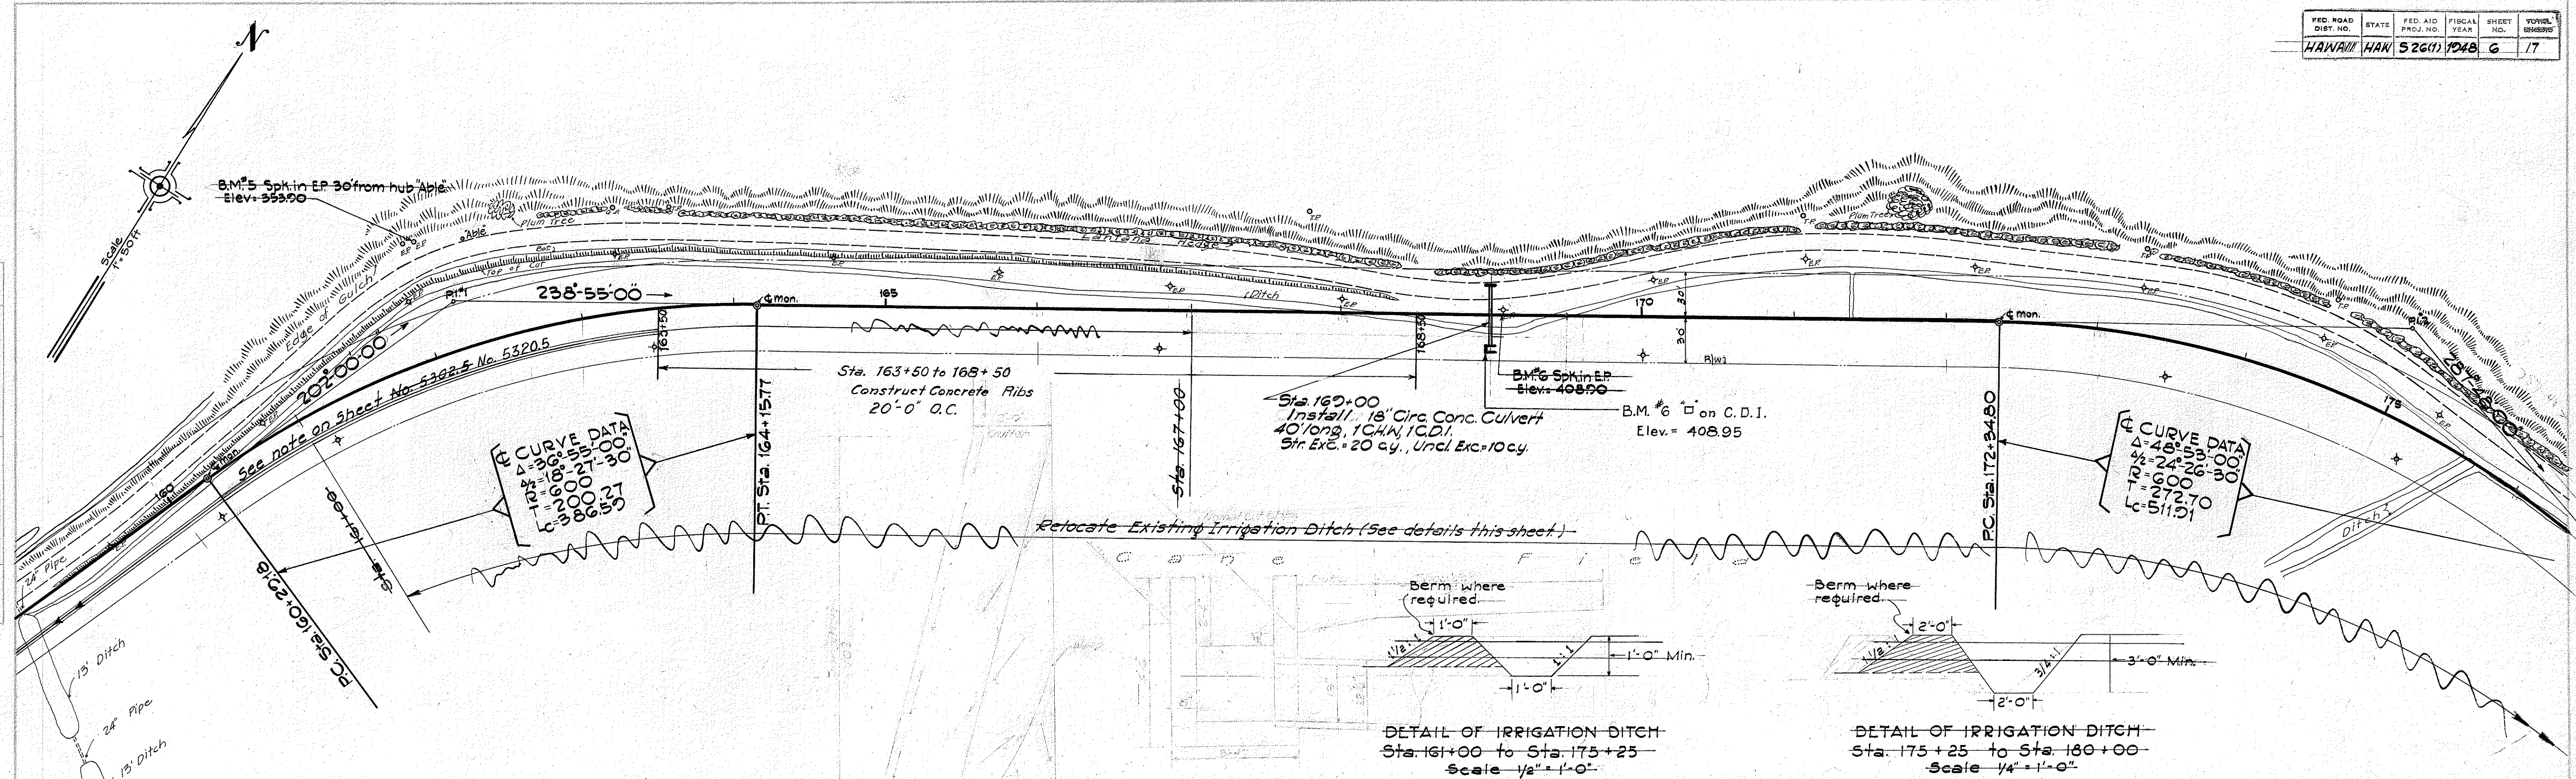

PLAN
BY: []
DATE: []
SUBMITTED: []
NOTES: []
NOTE BOOK: []
NOTE: []

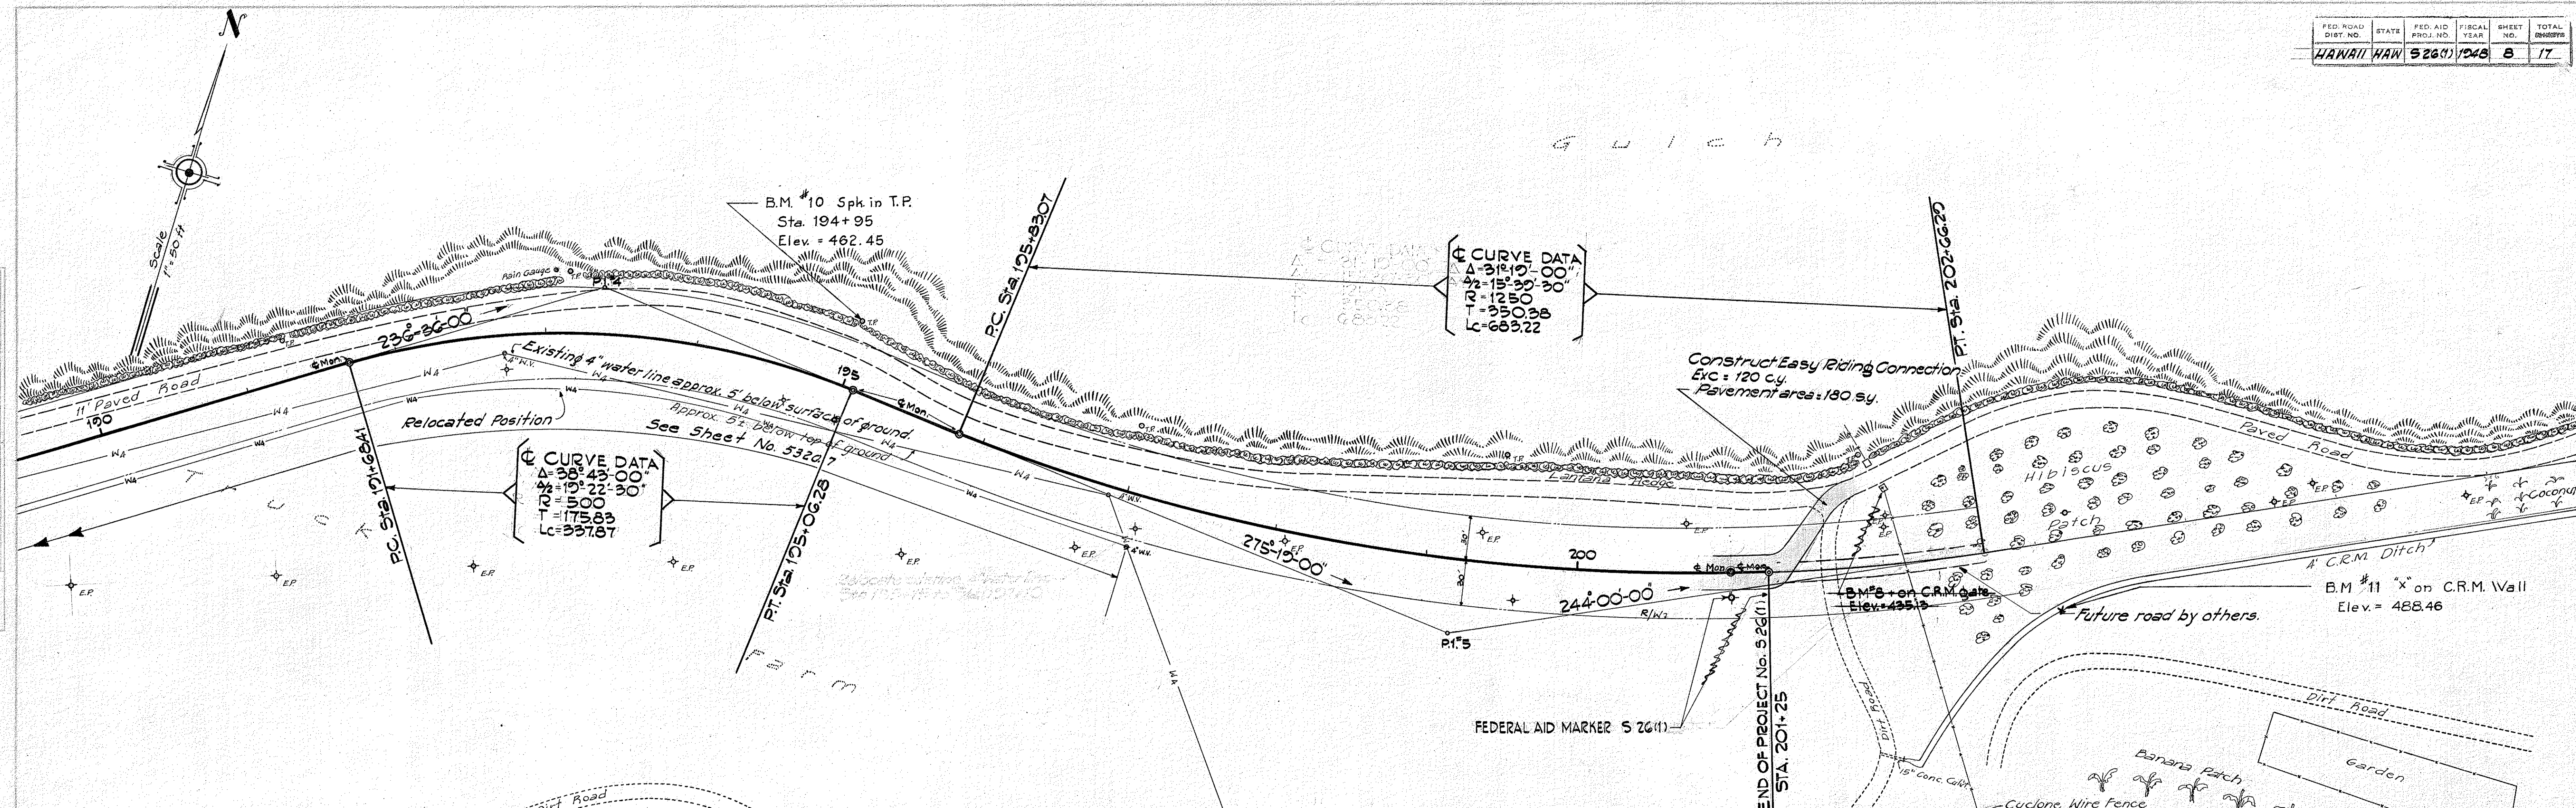

PROFILE
BY: []
DATE: []
SUBMITTED: []
NOTES: []
NOTE BOOK: []
NOTE: []

