





FINAL SURVEY	DATE	
	BY	
	SURVEYED	
	NOTE BOOK	
NO.	AREAS CHECKED	
	AREAS	
	DATE	
	BY	

ORIGINAL SURVEY	DATE	
	BY	
	SURVEYED	
	NOTE BOOK	
NO.	AREAS CHECKED	
	AREAS	
	DATE	
	BY	

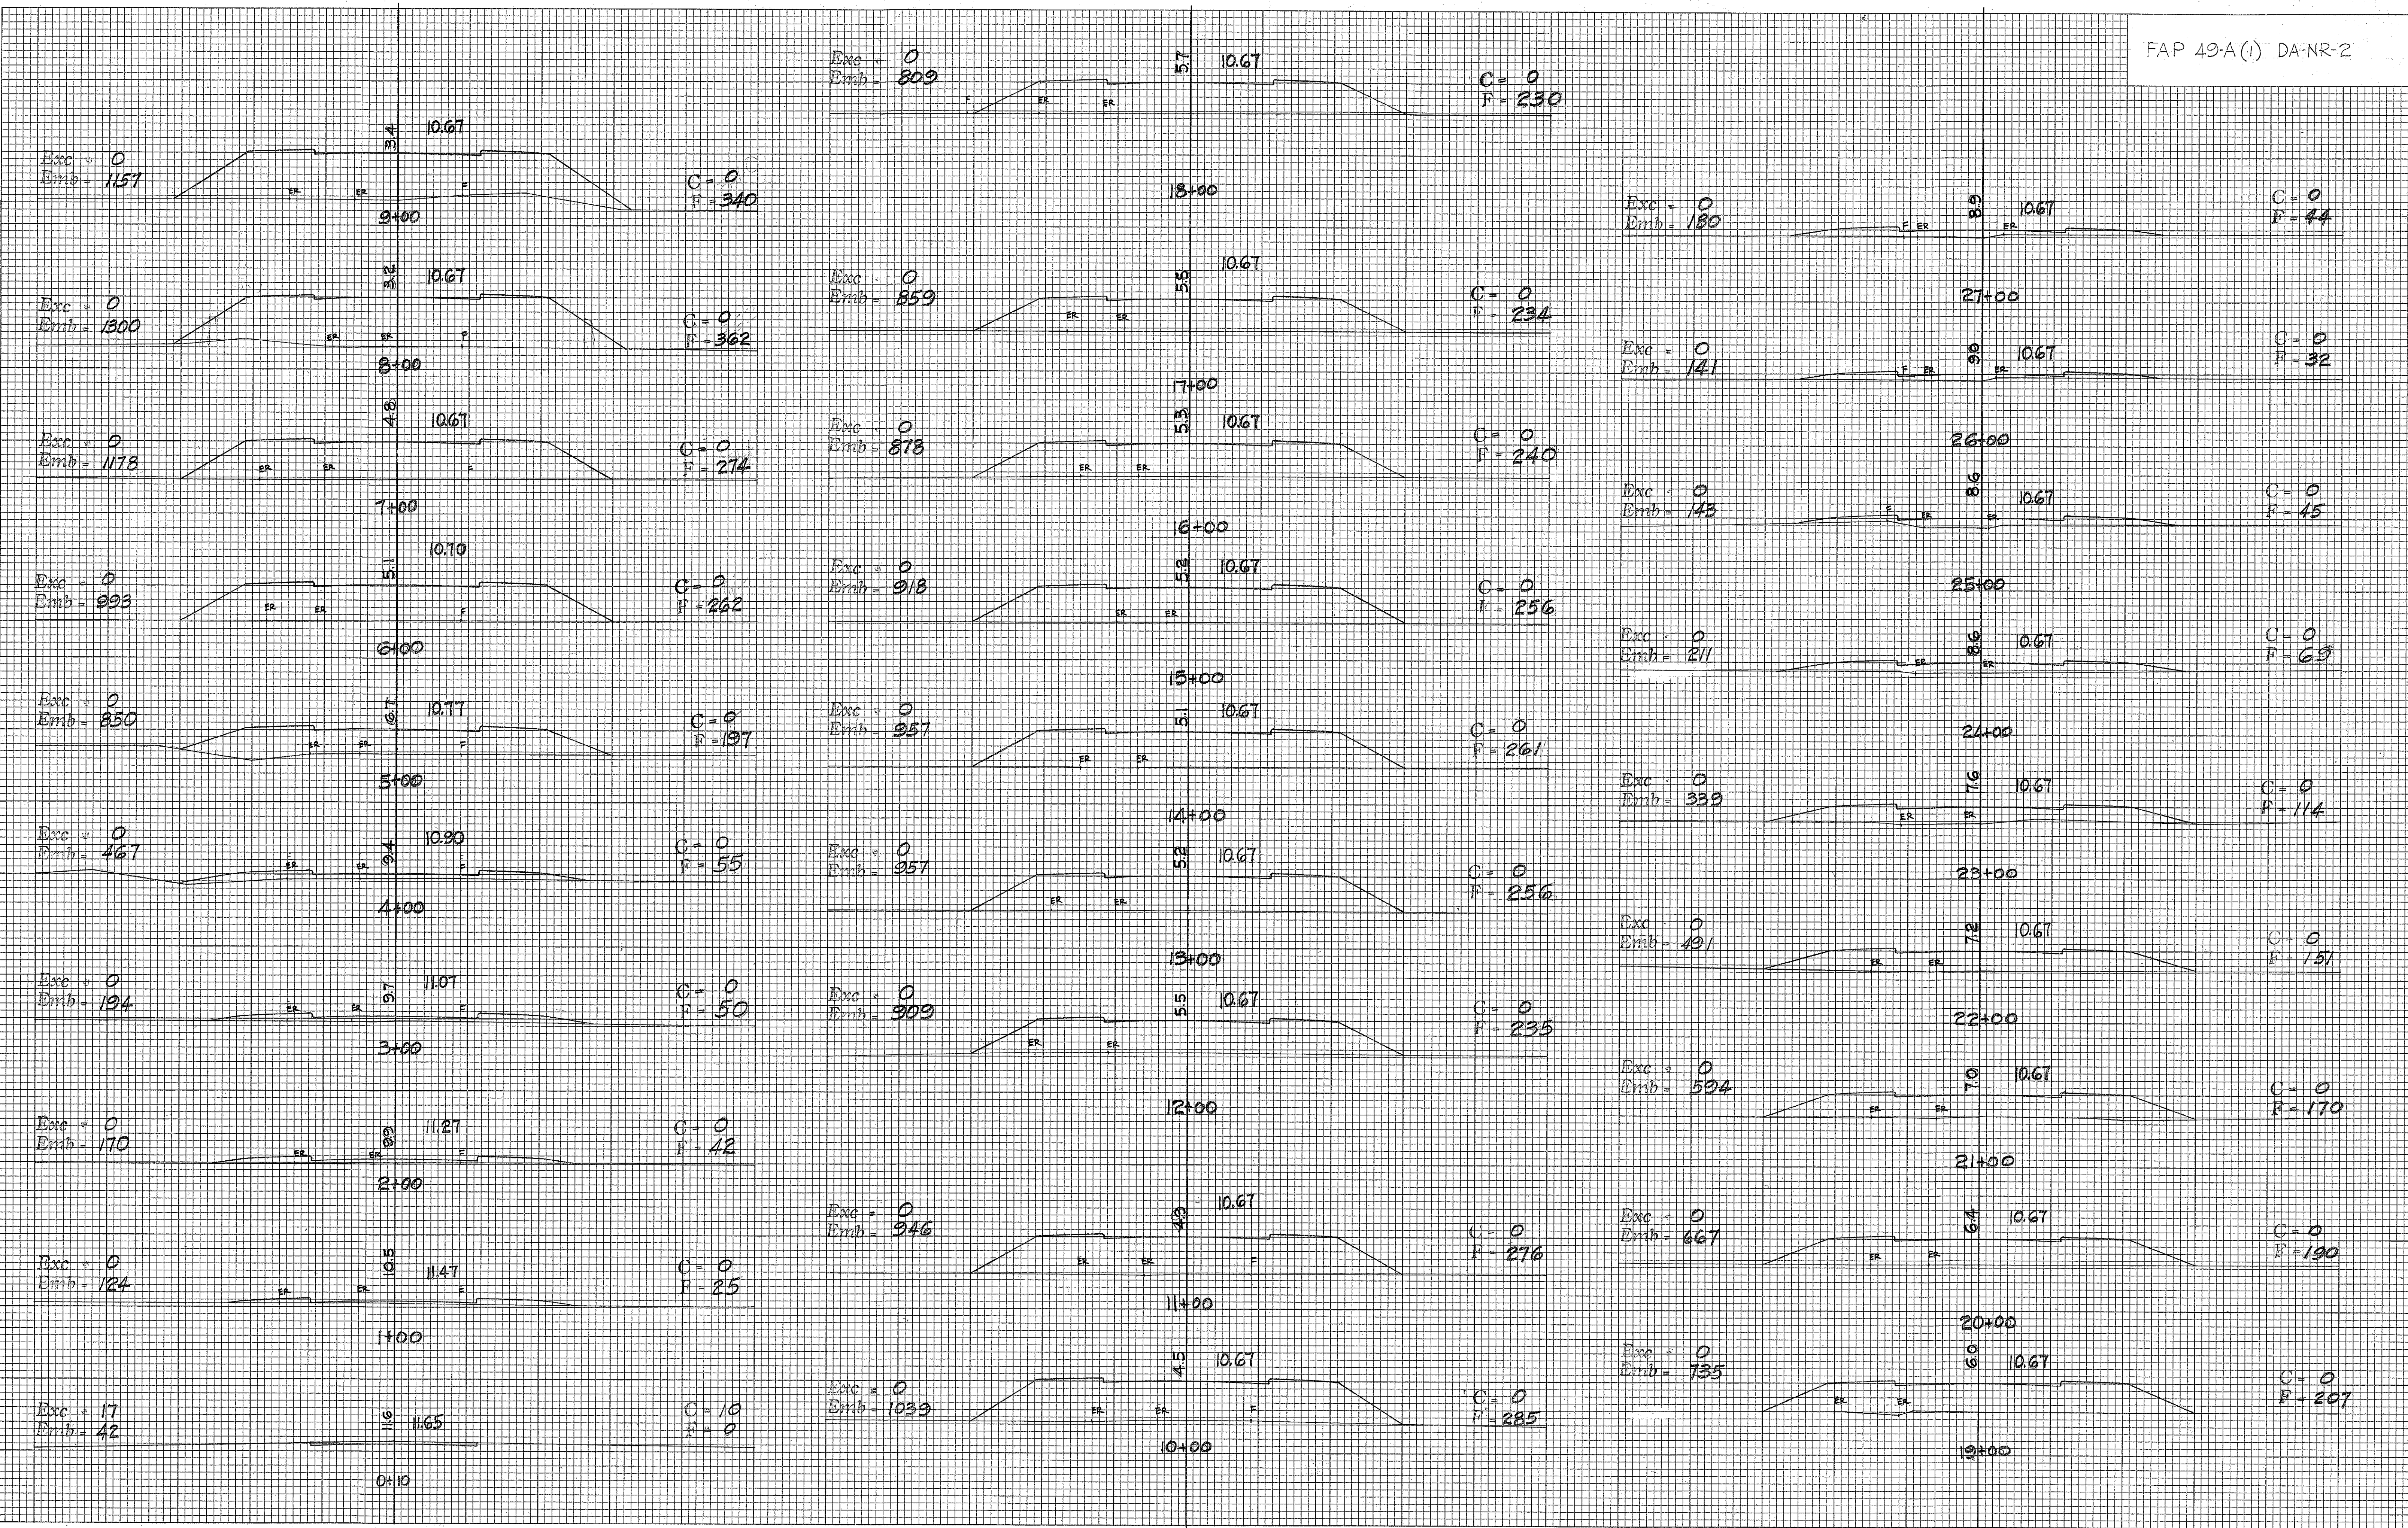

FINAL	SURVEYED	DATE
SURVEY	PLOTTED	BY
NOTE BOOK	AREA CHECKED	
NO.		

ORIGINAL	SURVEYED	DATE
SURVEY	PLOTTED	BY
NOTE BOOK	AREA CHECKED	
NO.		

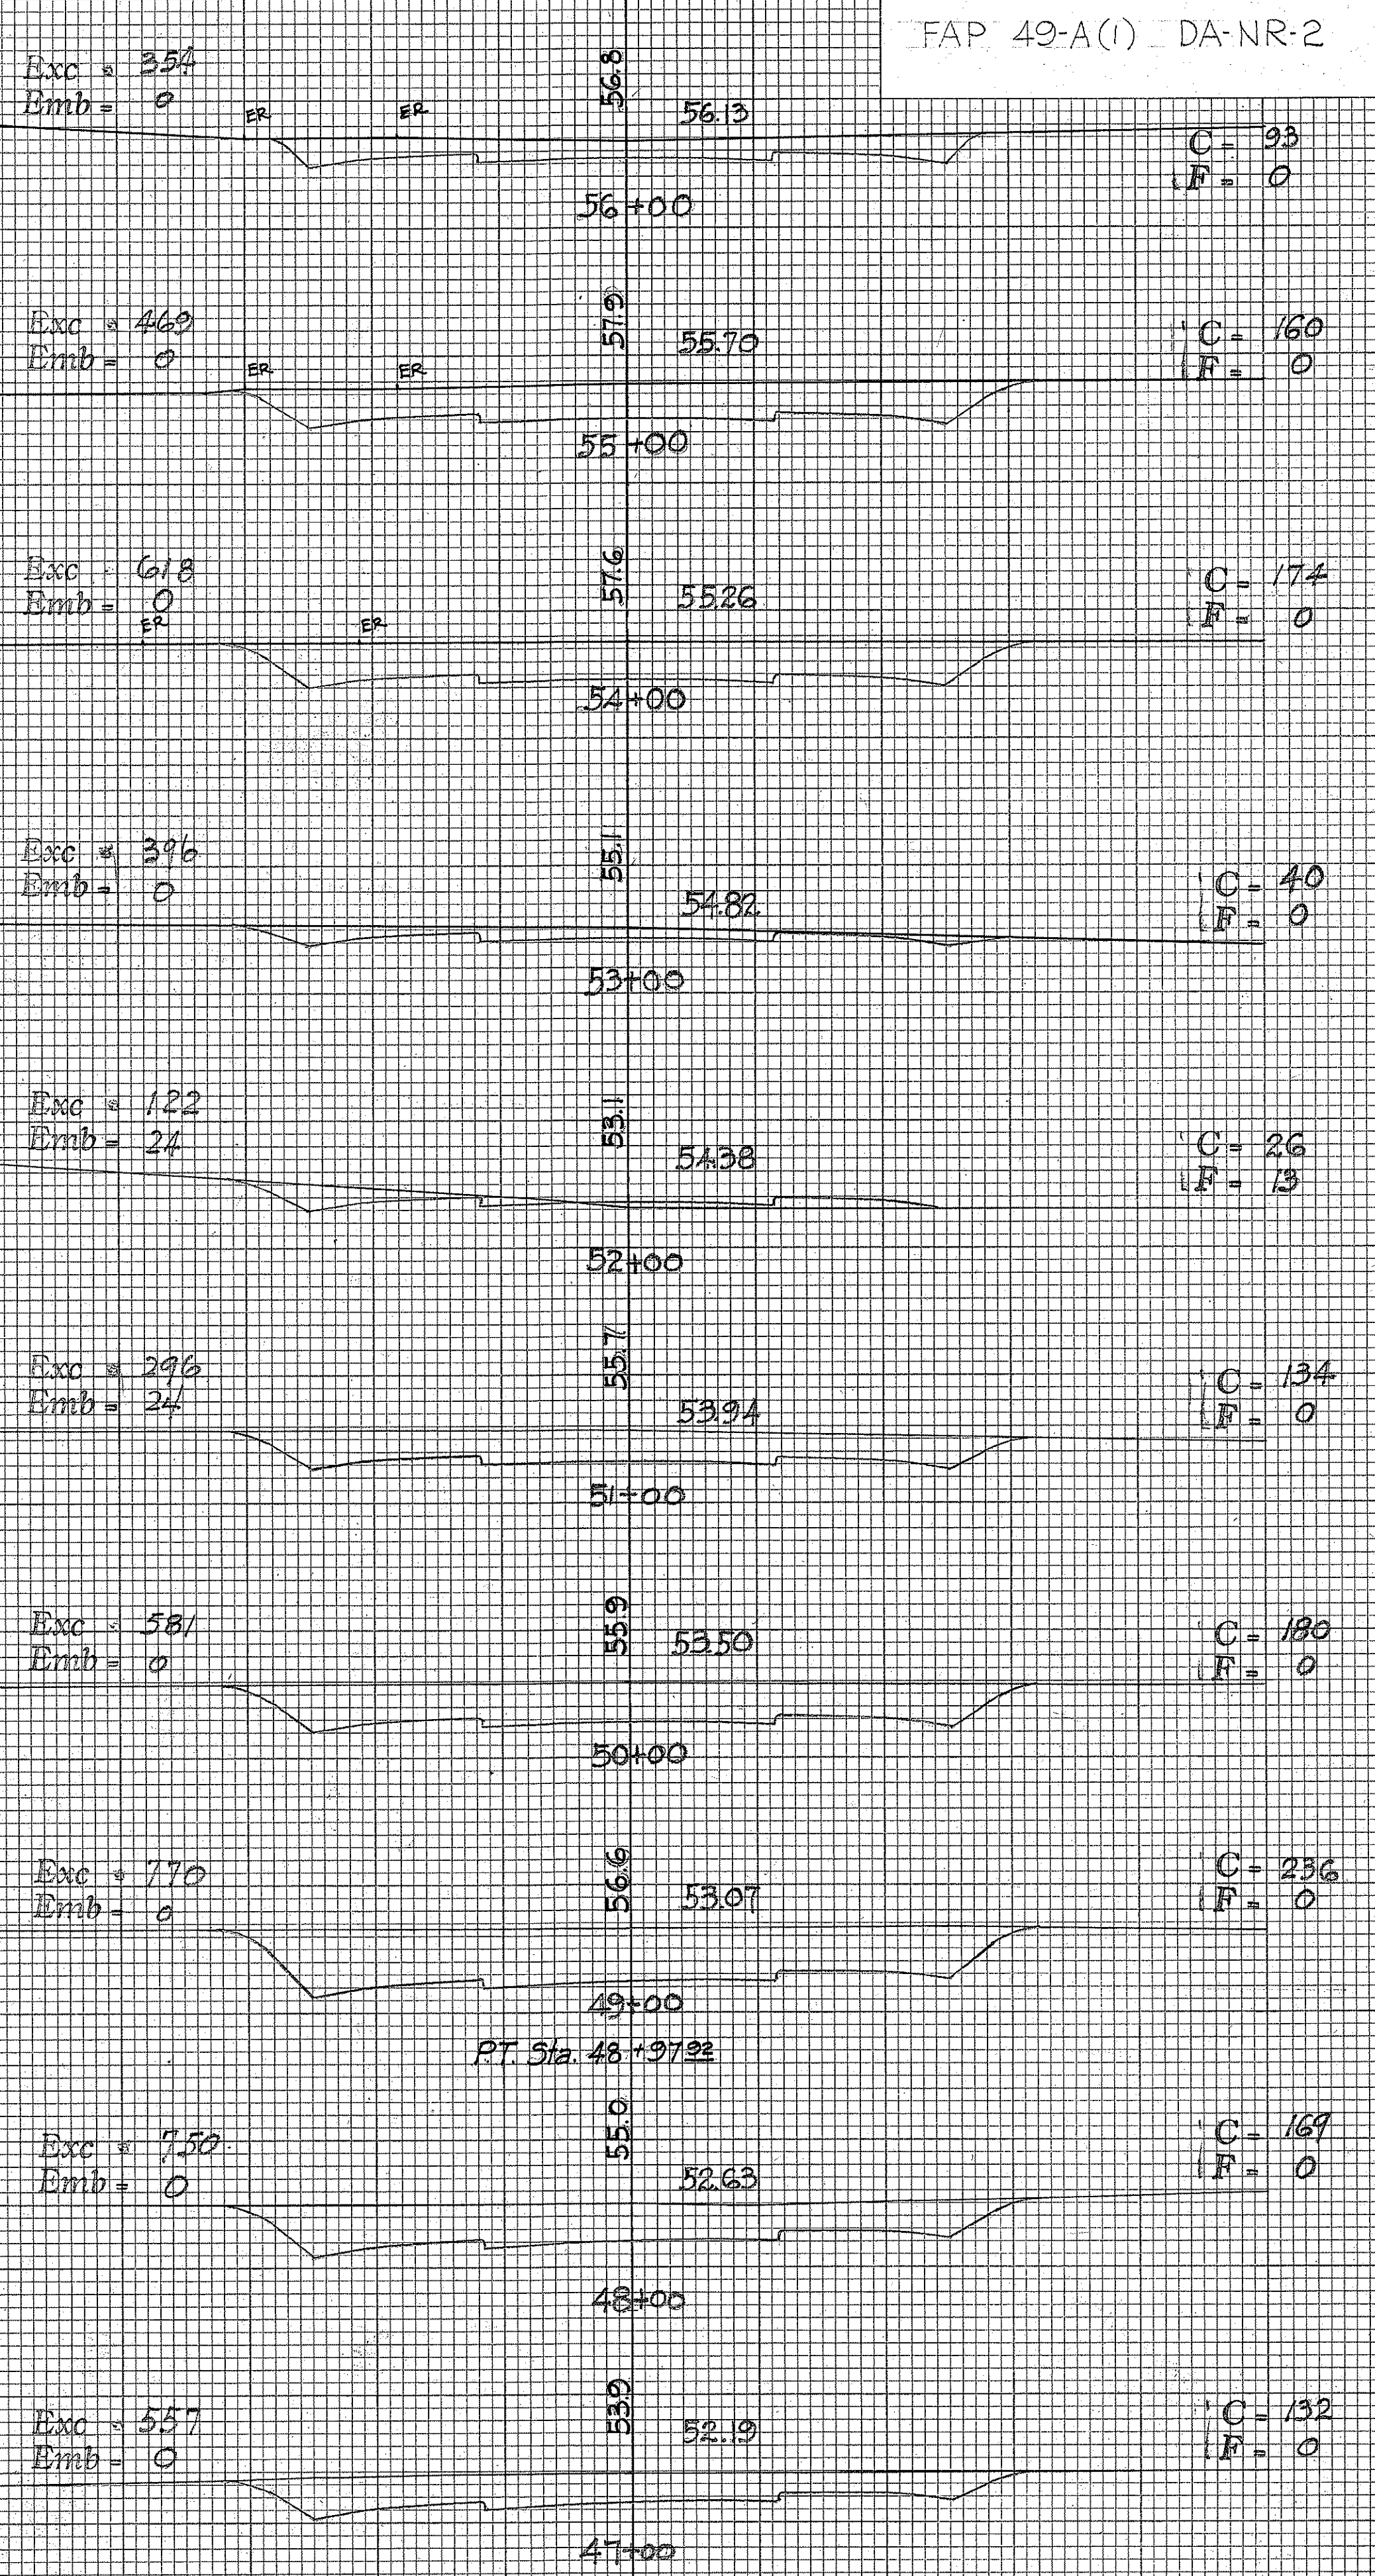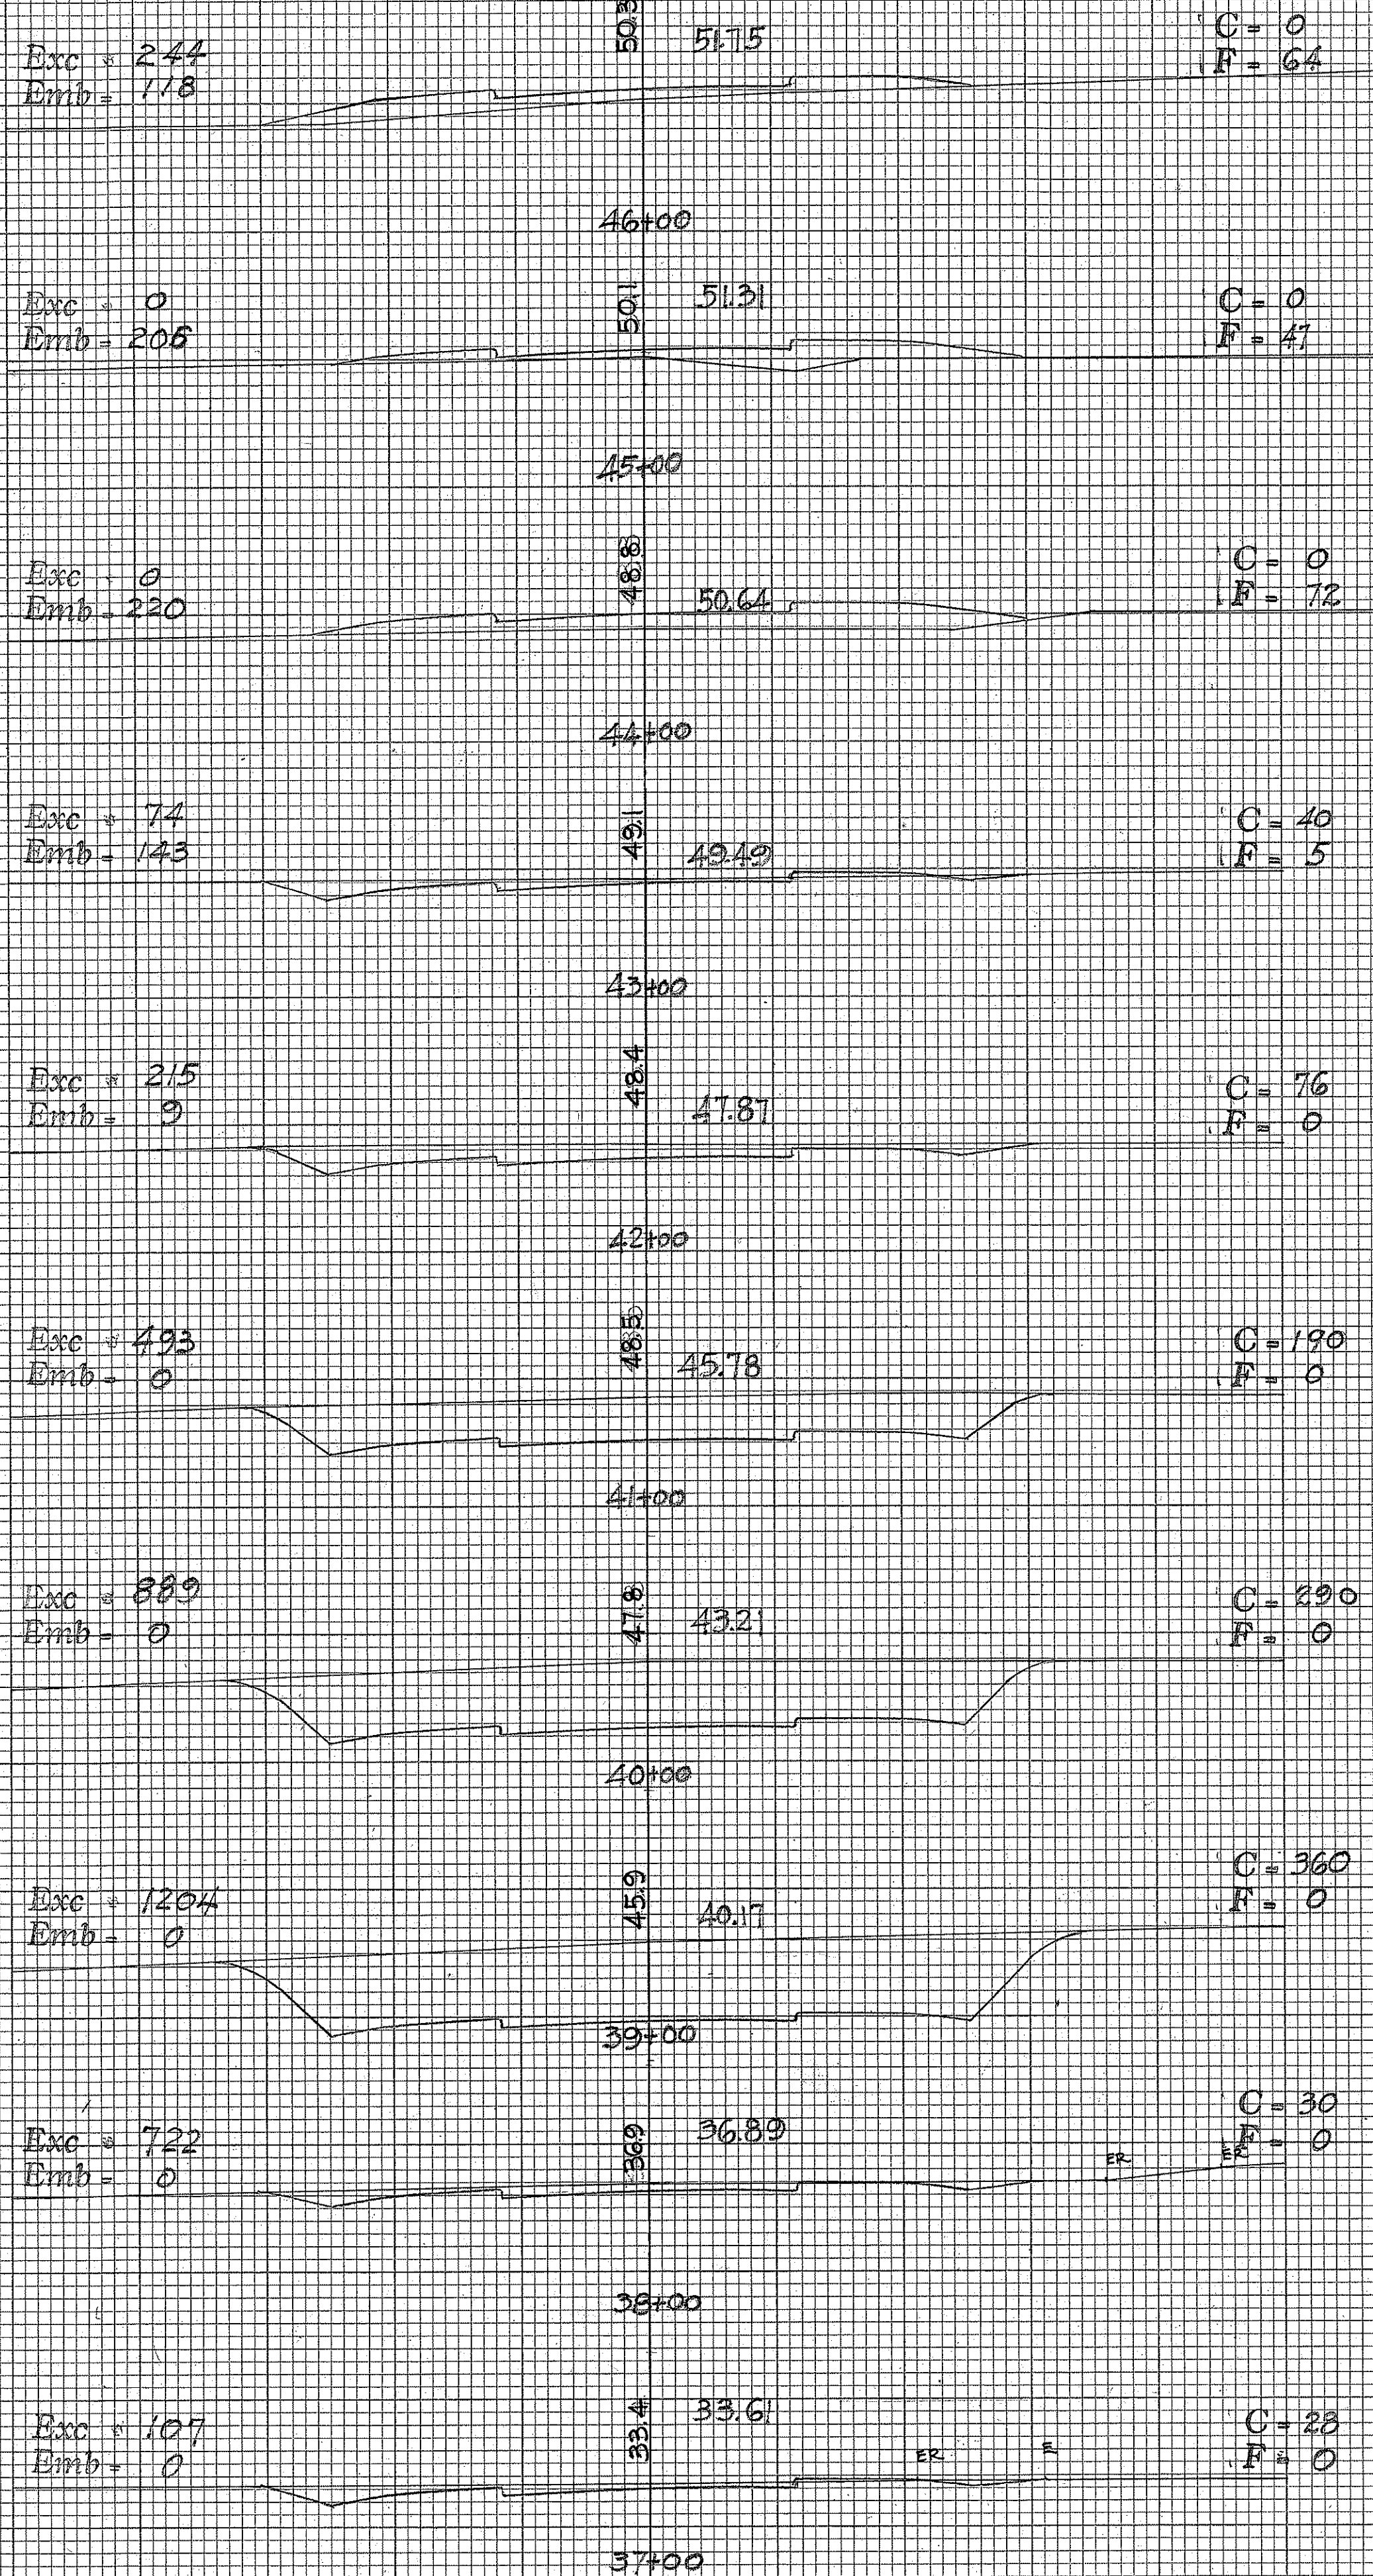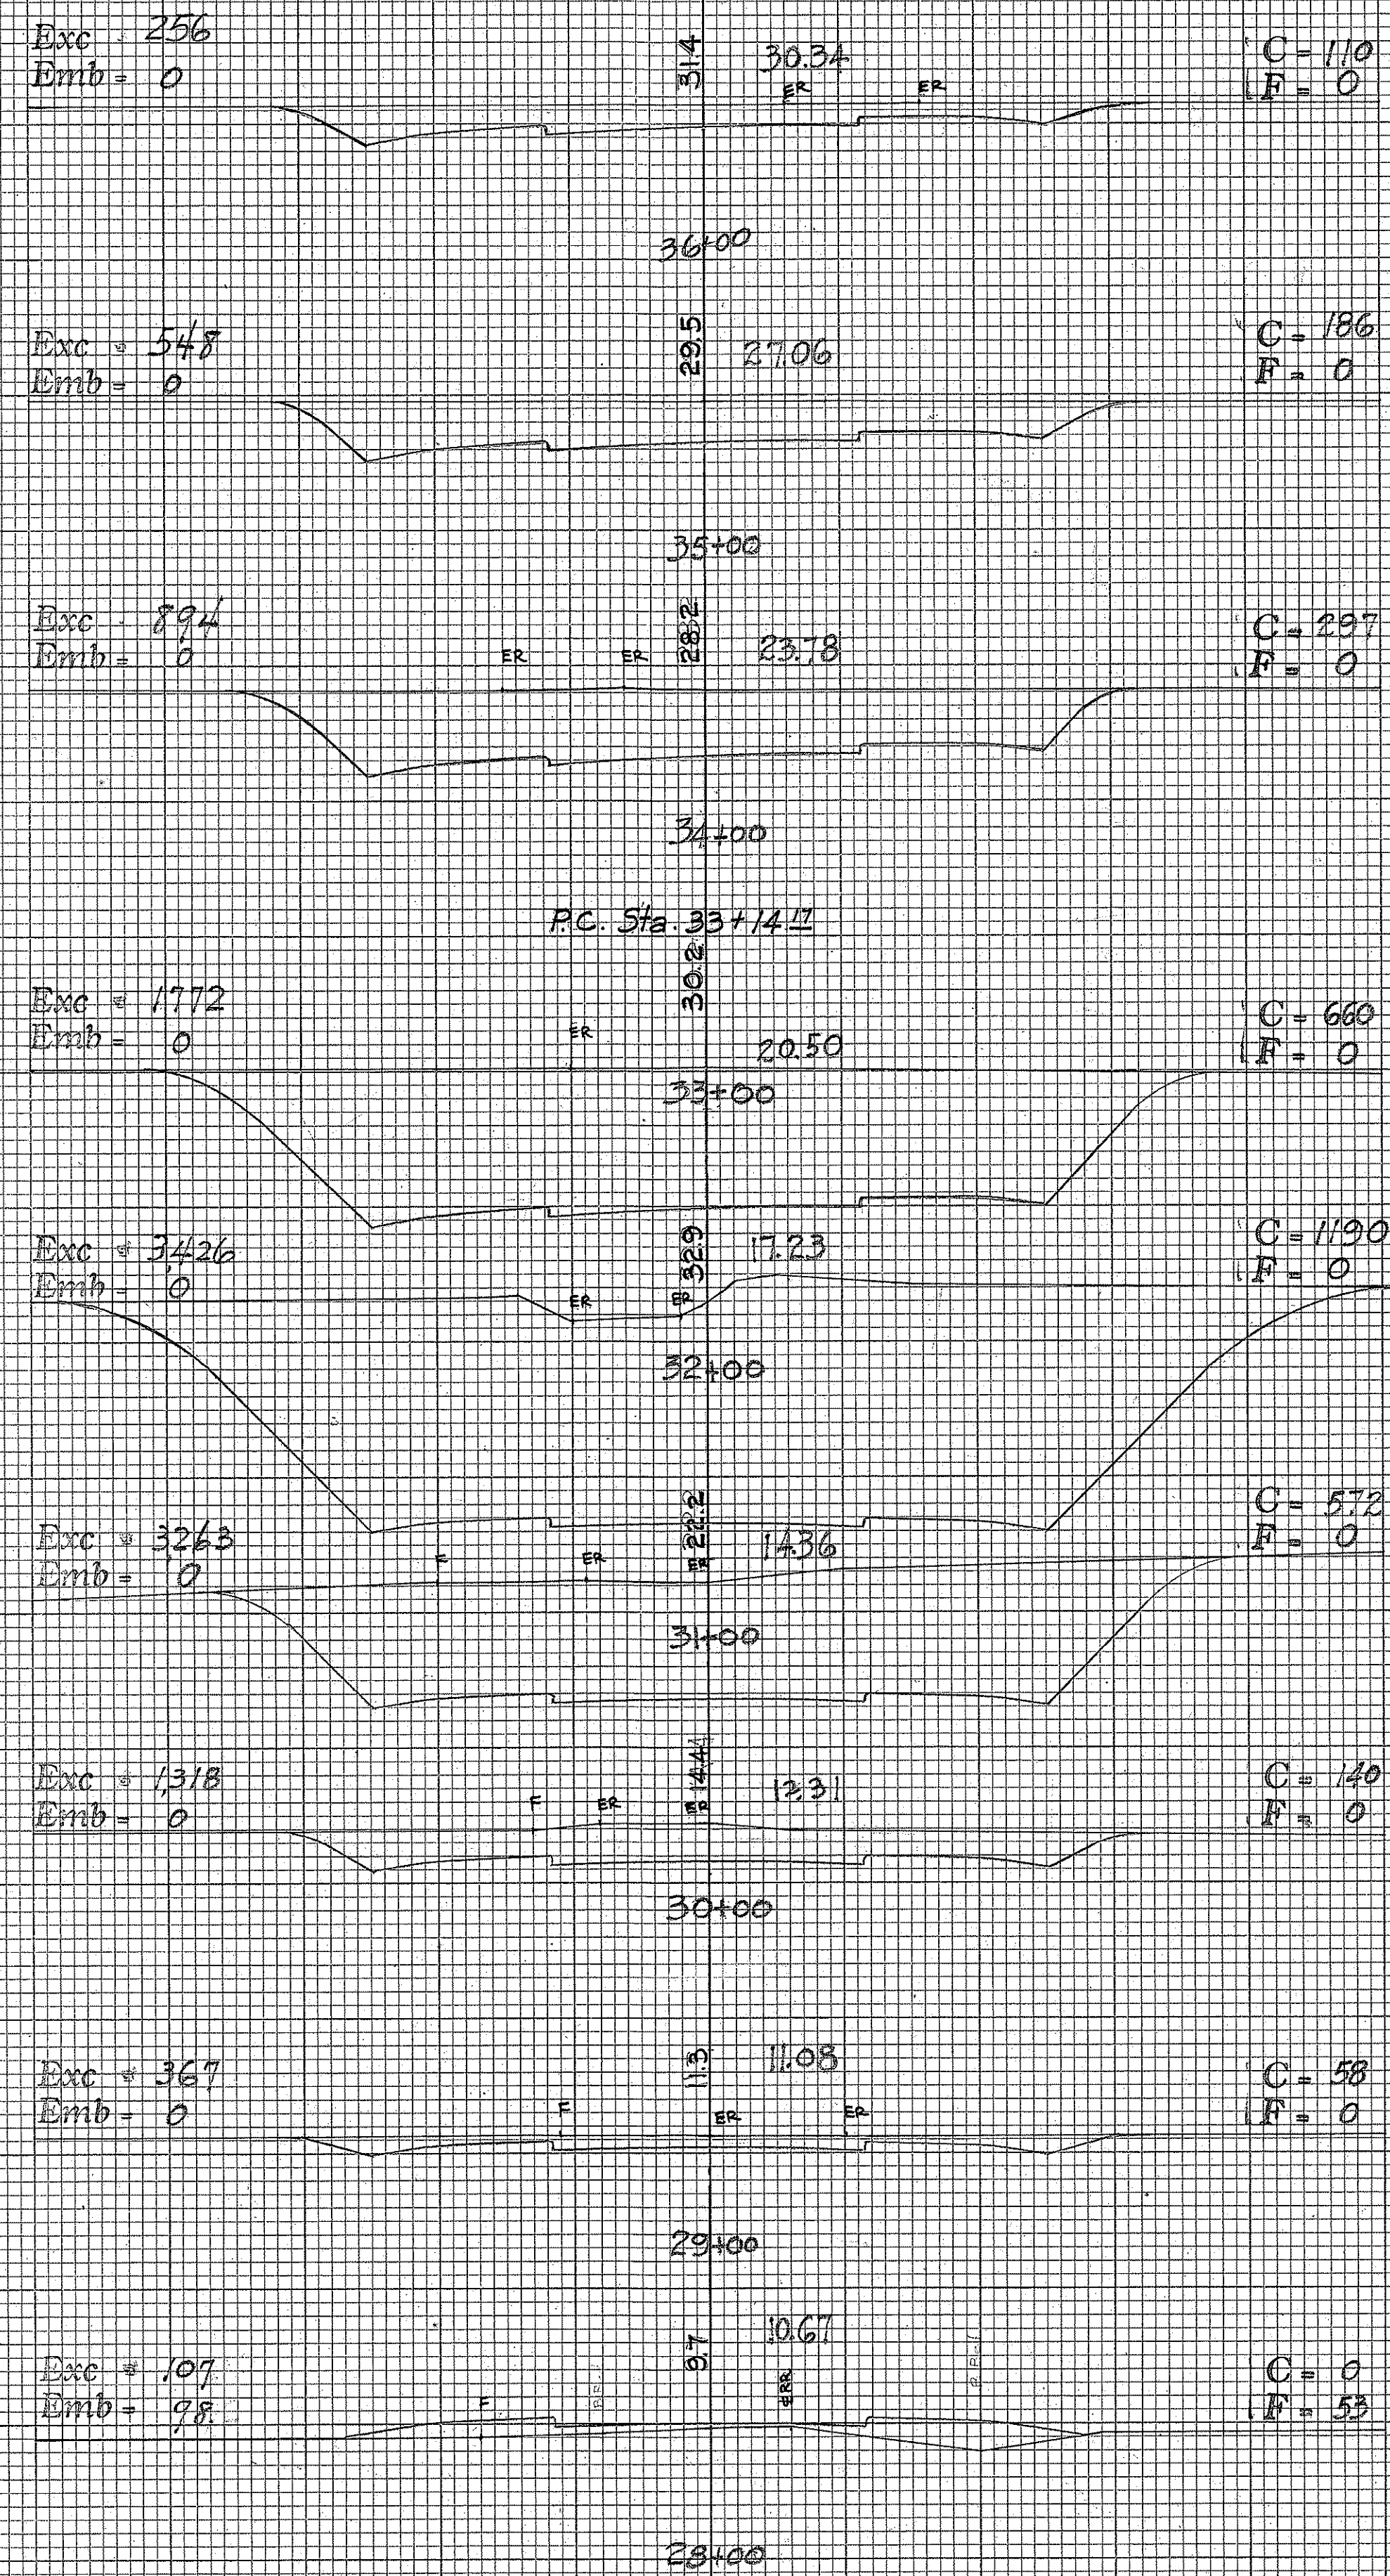

FINAL SURVEY	DATE	BY
	SURVEYED	PLOTTED
	NOTE BOOK	AREAS CHECKED
	NO.	NO.

ORIGINAL SURVEY	DATE	BY
	SURVEYED	PLOTTED
	NOTE BOOK	AREAS CHECKED
	NO.	NO.

