


1. All fence work shall be Right-of-Way consideration.
2. All work in connection with lowering of existing 12" watermain shall be done by the Suburban Water System, City & County of Honolulu, except the excavation and backfilling of trenches which shall be done by the contractor. Excavation and backfill shall be paid for under the item of "Unclassified Excavation for Water Mains".
3. All Utility Poles, except where noted, (Occupy a private R/W) shall be moved by the owners at their own expense.
4. All utility poles within new Highway Right-of-Way shall be moved by others.
5. All & Monuments shall be set according to data on Rights-of-Way Map.

1-24-50



DD-K-4

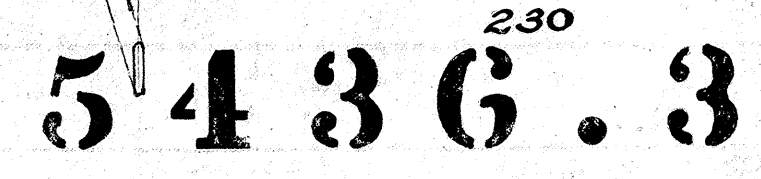

