



DATE
DESIGNED BY
DRAWN BY
CHECKED BY
NOTED BY
QUANTITIES CHECKED BY
NO.

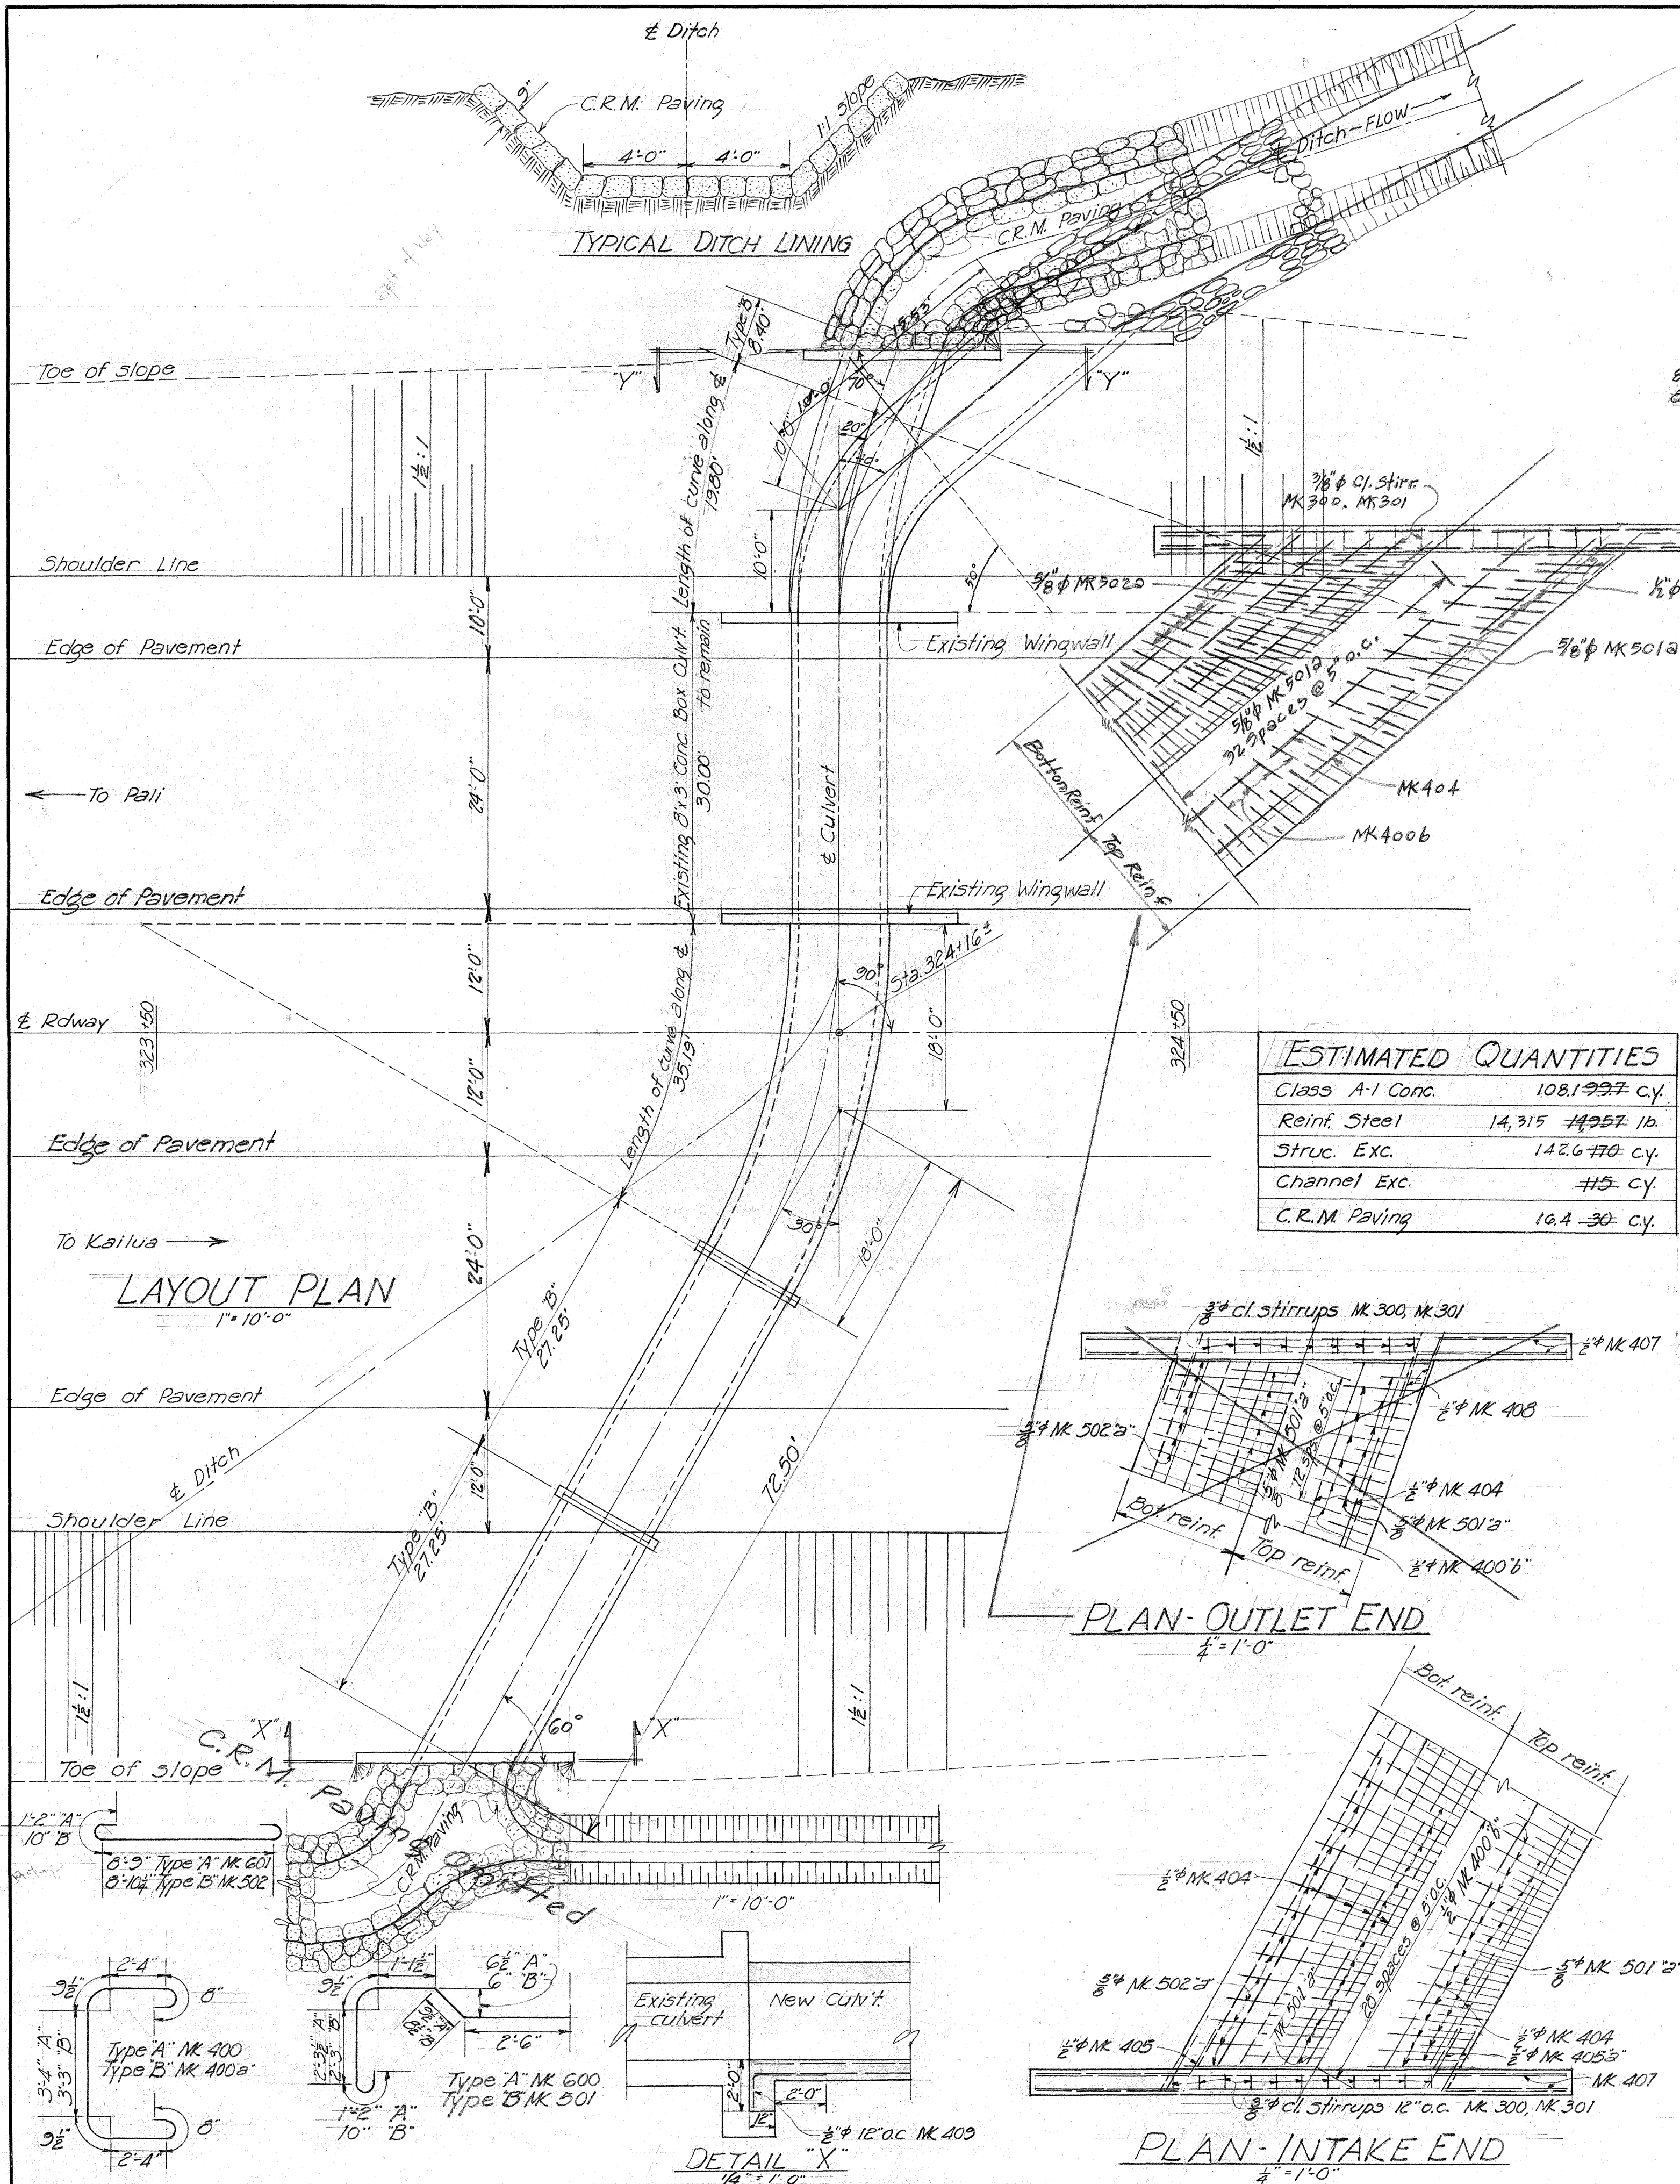

ESTIMATED QUANTITIES	
Class A-1 Conc.	1081.937 c.y.
Reinf. Steel	14,315 #4257 lb.
Struc. Exc.	1426.770 c.y.
Channel Exc.	#5 c.y.
C.R.M. Paving	164.30 c.y.

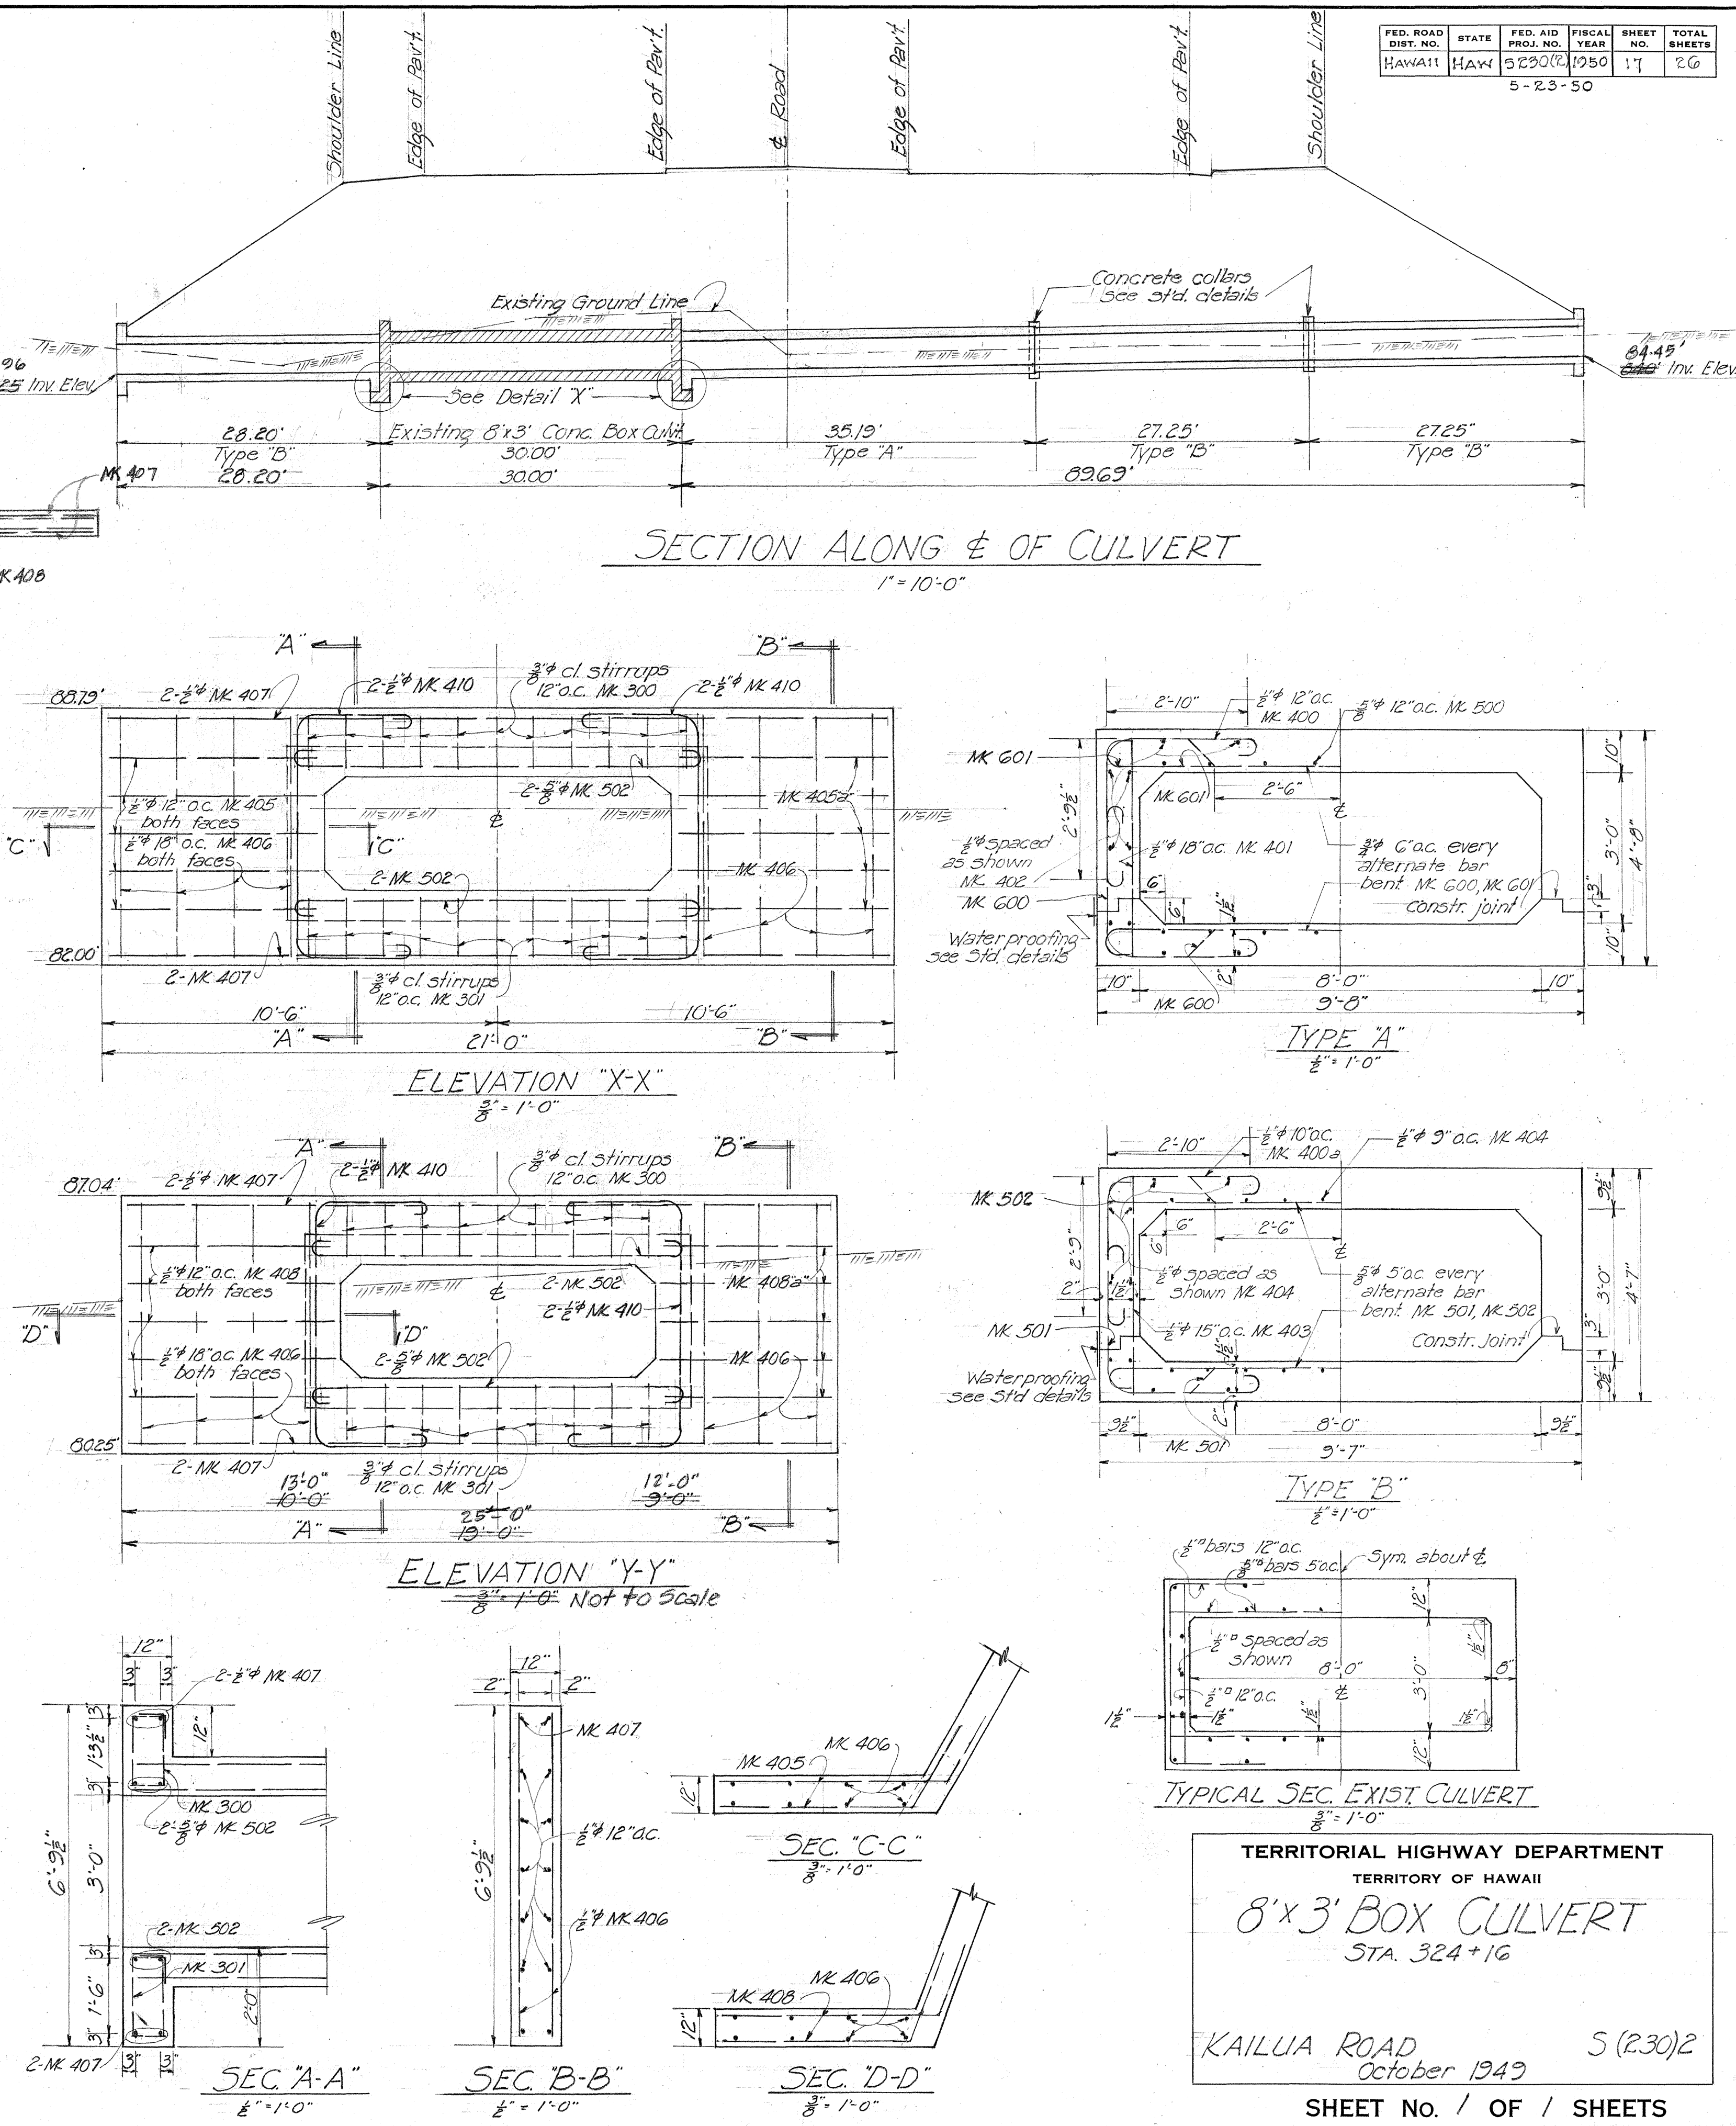

TERRITORIAL HIGHWAY DEPARTMENT
TERRITORY OF HAWAII
8'x3' BOX CULVERT
STA. 324+16
KAILUA ROAD October 1949 S (230)2
SHEET No. 1 OF 1 SHEETS