

INDEX TO DRAWINGS	
SHEET NO.	DESCRIPTION
1	TITLE SHEET
2-3	TYPICAL SECTION
4-6	PLAN & PROFILE

TERRITORY OF HAWAII
TERRITORIAL HIGHWAY DEPARTMENT
HONOLULU, OAHU, T. H.

PLANS OF REHABILITATION OF A PORTION OF KAILUA ROAD

WAR DAMAGE REHABILITATION PROJECT NO. W.D.R.9(2)


DISTRICT OF KOOLAUPOKO

ISLAND OF OAHU

SCALES


PLAN	1 IN. = 100 FT.
PROFILE	HOR. 1 IN. = 100 FT.
	VERT. 1 IN. = 10 FT.
CROSS SECTION	HOR. 1 IN. = 10 FT.
	VERT. 1 IN. = 10 FT.

CONVENTIONAL SIGNS	
Centerline	125
Boundary Lines	, or
Fences (Named)	
Existing Roadways	
Circular Culvert	
Box Culvert	
Bridge	
Telephone Pole	
Electric Power Pole	
Water Main	W ₂ W ₂ (W ₄ , 8, 12, Etc.)
Storm Drain	SD ₁₂ SD ₁₂ (SD ₁₈ , 24, Etc.)
Concrete Drop Intake	C.D.I.
Standard Catch Basin	S.C.B.
Standard Manhole	M.H.S.
Sewer Manhole	S.S. S.S. (S.S. 12, 18, 24, Etc.)
Telephone Manhole	T.M.H.
Fire Hydrant	F.H.
Tree (Large, named)	Mango, Coco
Railroad	
Mutual Telephone Underground Cable	M.T.C.
Water Meter	W.M.

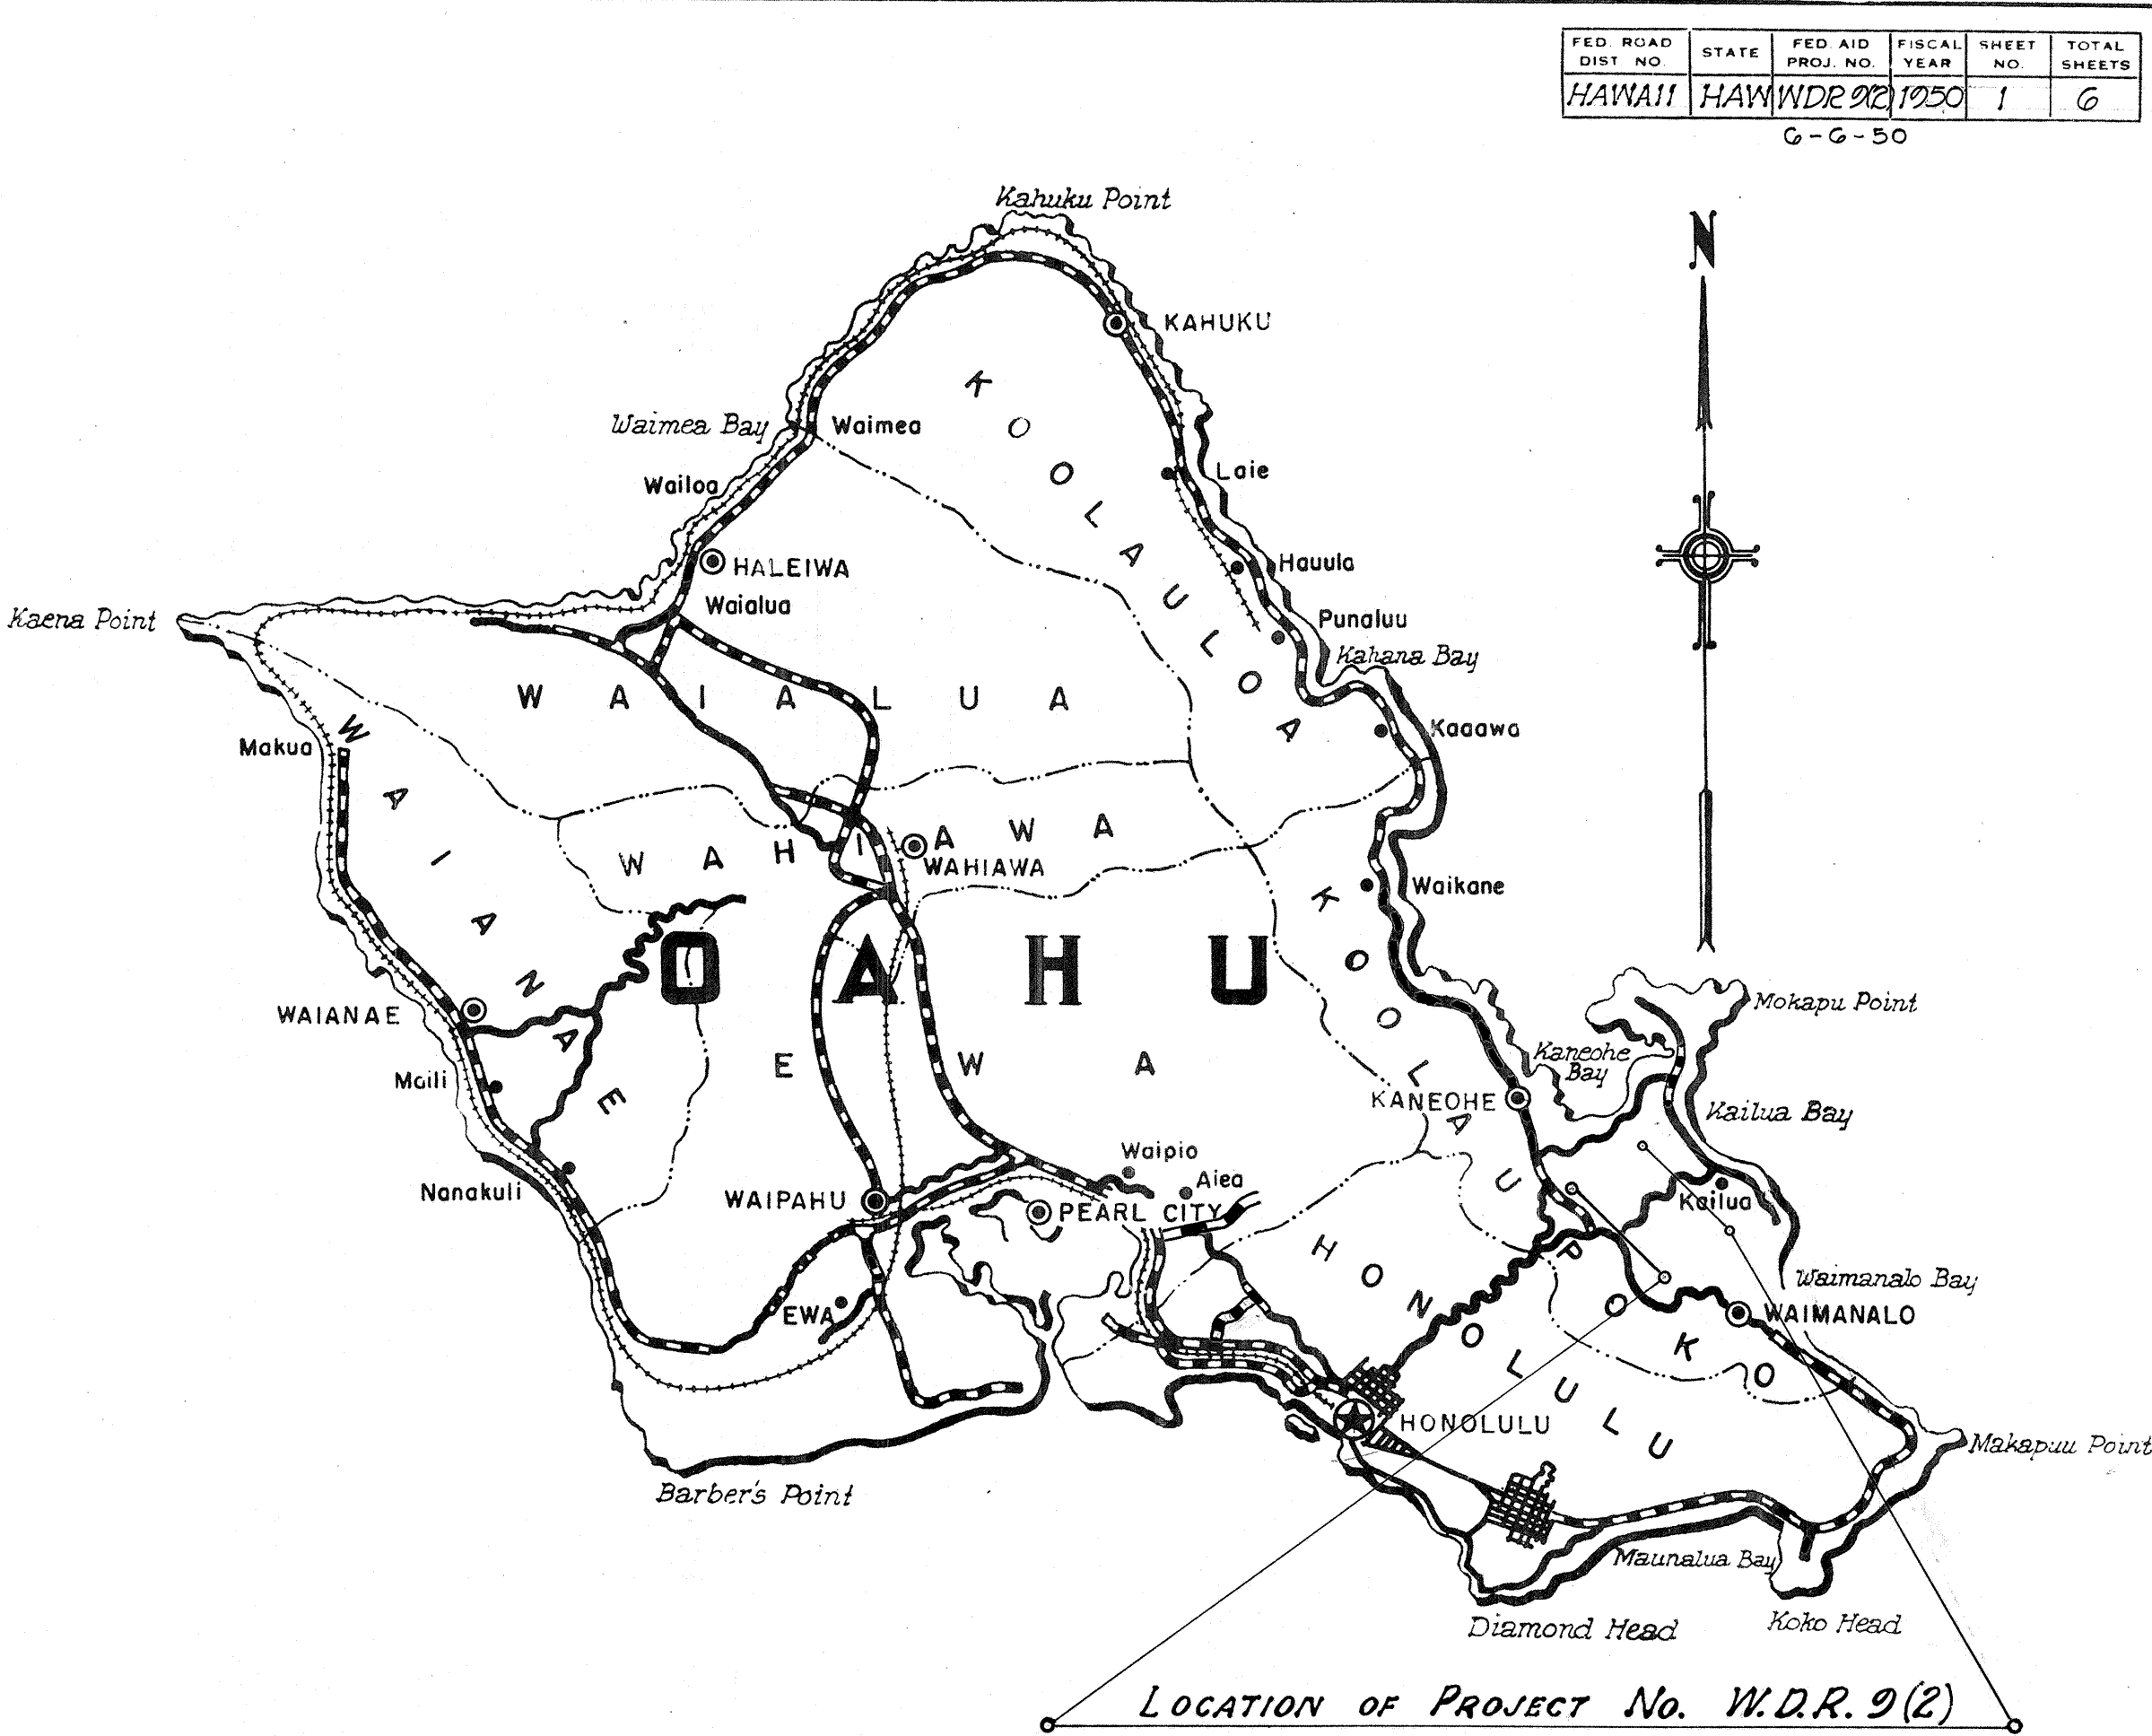

Federal Aid Projects Previously Constructed Or Under Construction

NOTE:
All changes made during construction have been noted in red on these tracings and checked.
By: Julian H. Judd
Project Engineer.
Date: October 24, 1951.

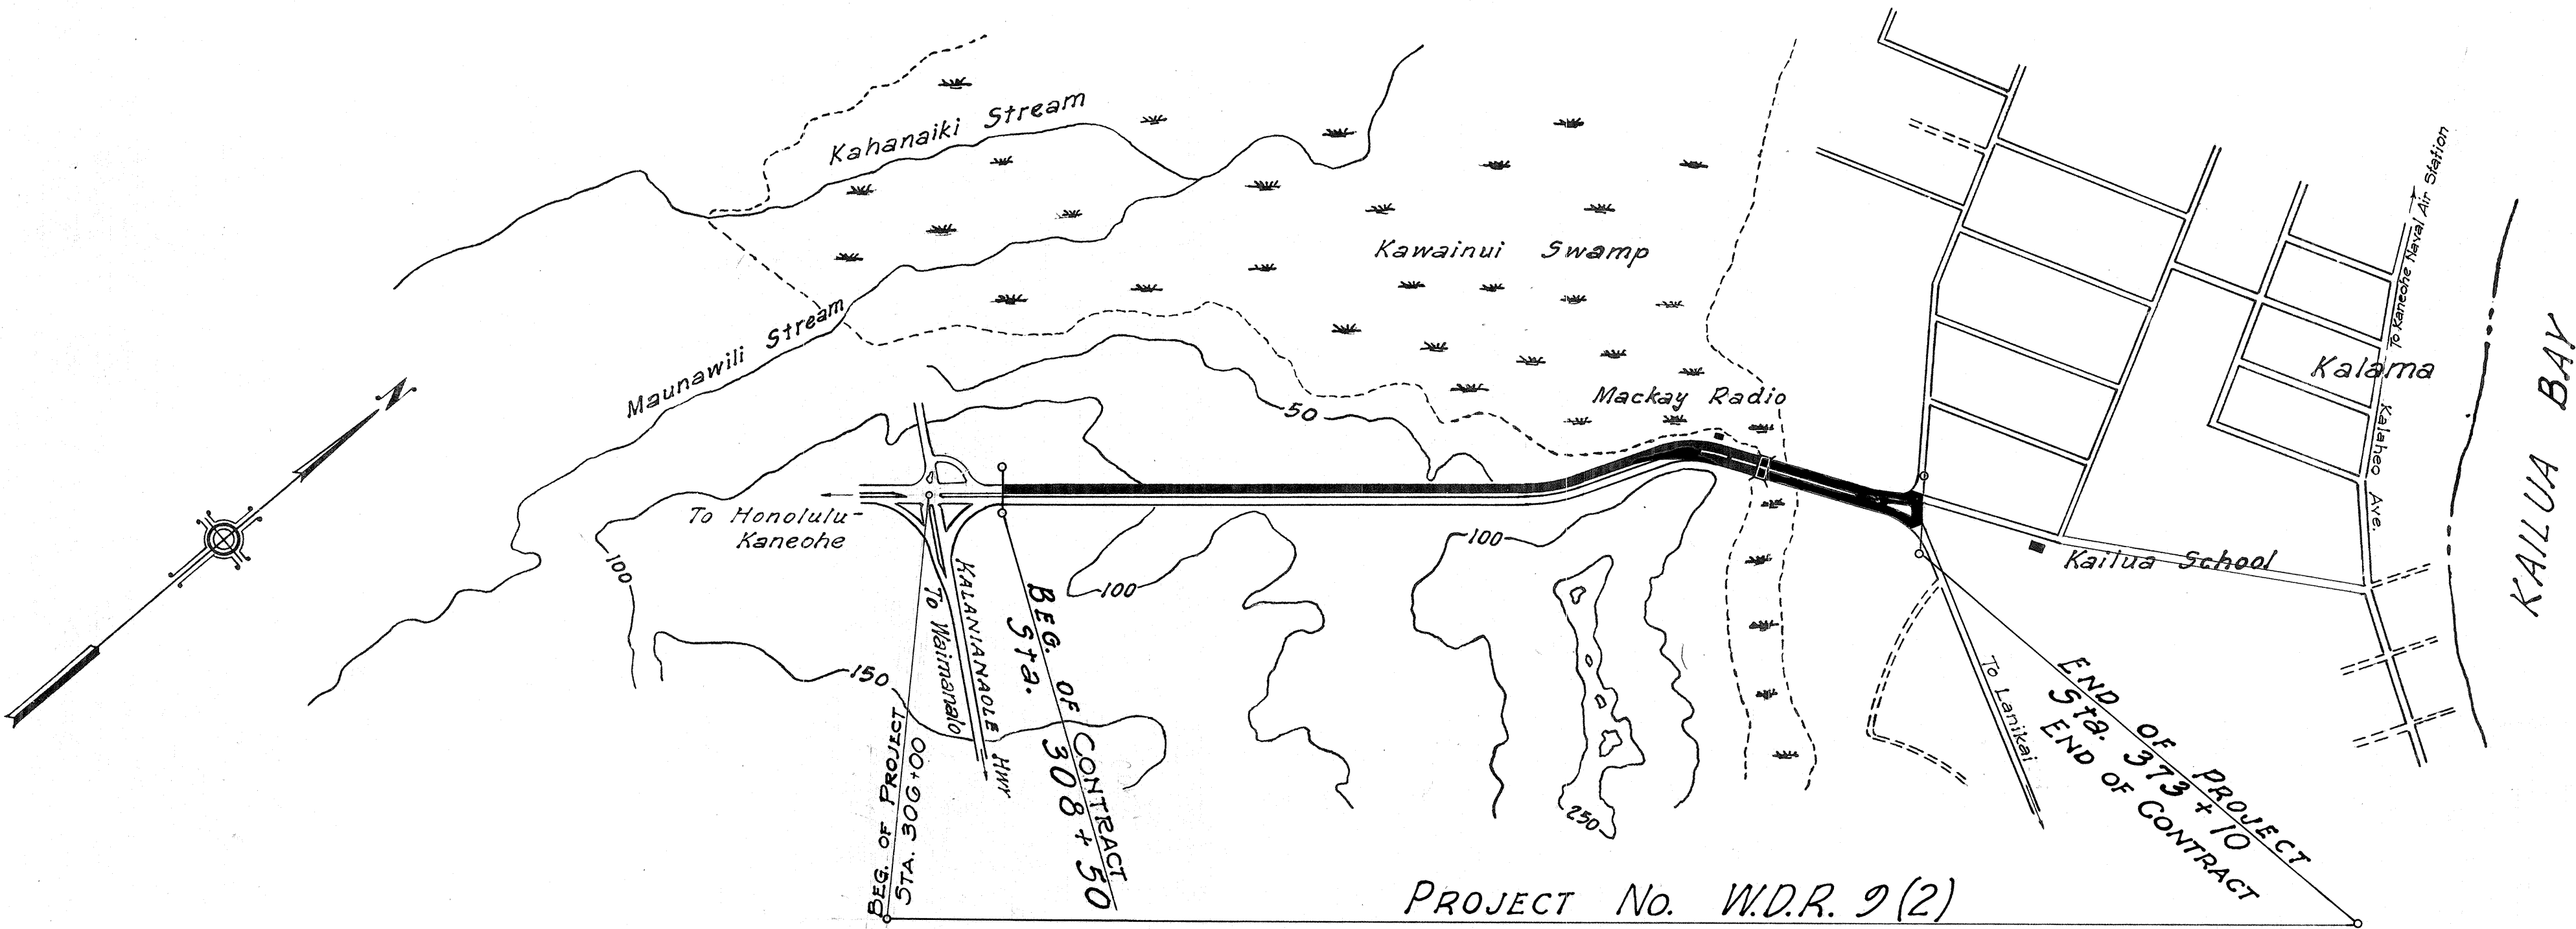

Scale: 1:10,000

LAYOUT OF PROJECT

Gross Length of Project.....1.270 Miles
Bridge.....0.010 Miles
Net Length of Project.....1.260 Miles

APPROVED
DATE Mar. 29, 1950
TERRITORIAL HIGHWAY ENGINEER

DEPARTMENT OF COMMERCE
BUREAU OF PUBLIC ROADS
RECOMMENDED FOR APPROVAL:
DISTRICT ENGINEER
APPROVED:
DIVISION ENGINEER