



NOTE: Cut slopes 1:1 from Sta. 355+50 to End of Project. See Cross Sections.



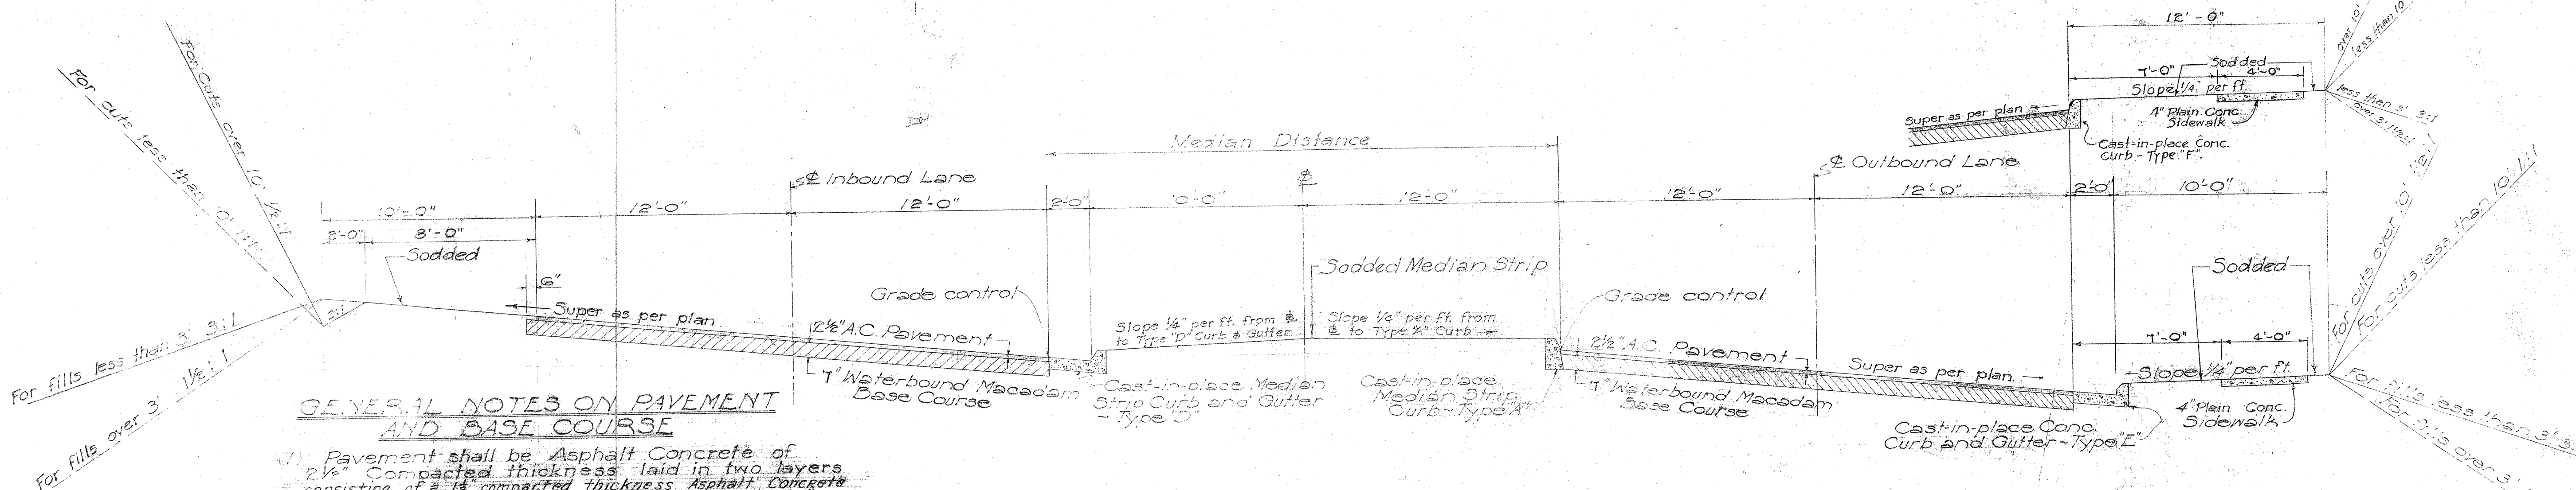


GENERAL NOTES ON PAVEMENT AND BASE COURSE

- (1) Pavement shall be Asphalt Concrete of 2 1/2" compacted thickness laid in two layers consisting of a 1 1/2" compacted thickness Asphalt Concrete leveling course Mix III for the bottom layer and a 1" compacted thickness Asphalt Concrete surface course Mix V for the top layer.
 - (2) Base Course shall be Waterbound Macadam Base Course of 7" compacted thickness, laid in two layers of 3 1/2" compacted thickness each and consisting of Mineral Aggregate (Coarse Rock No. 2) and Filler (No. 100).
- Both above Courses subject to Specifications and Special Provisions.

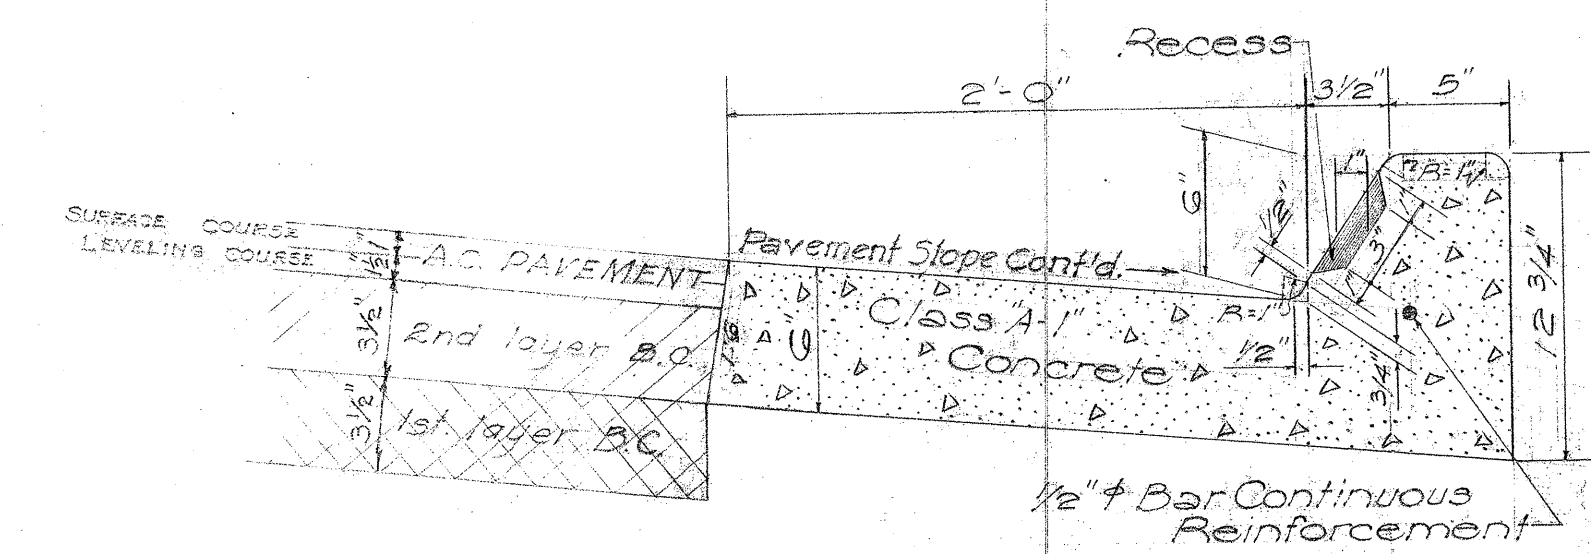

NOTE: For detail and spacing of Recess See Detail of Median Strip Curb-Type 'A'

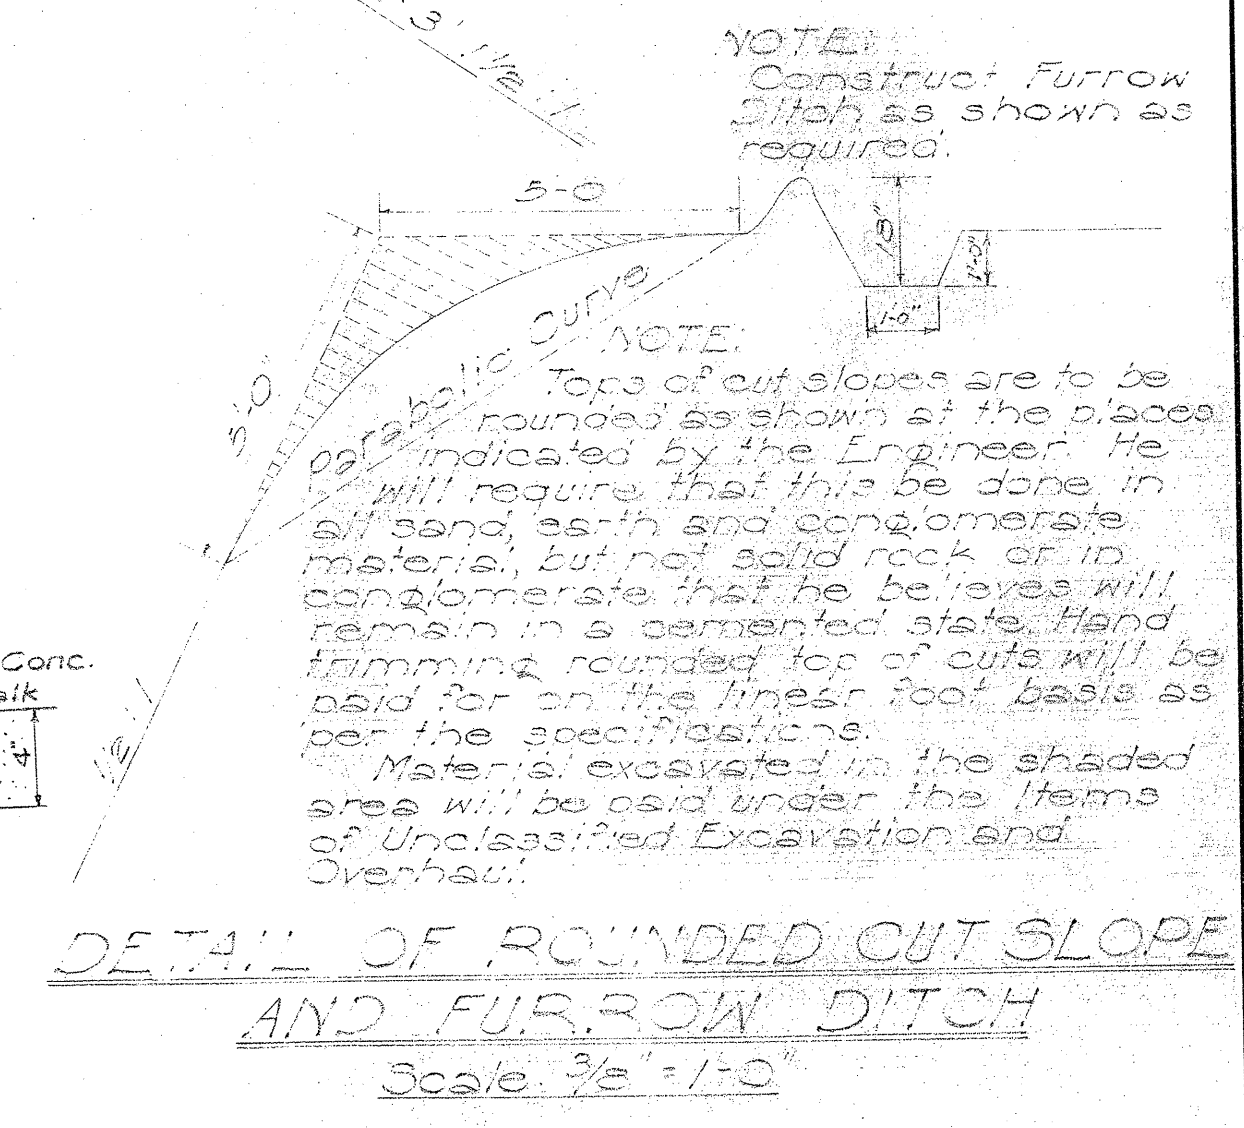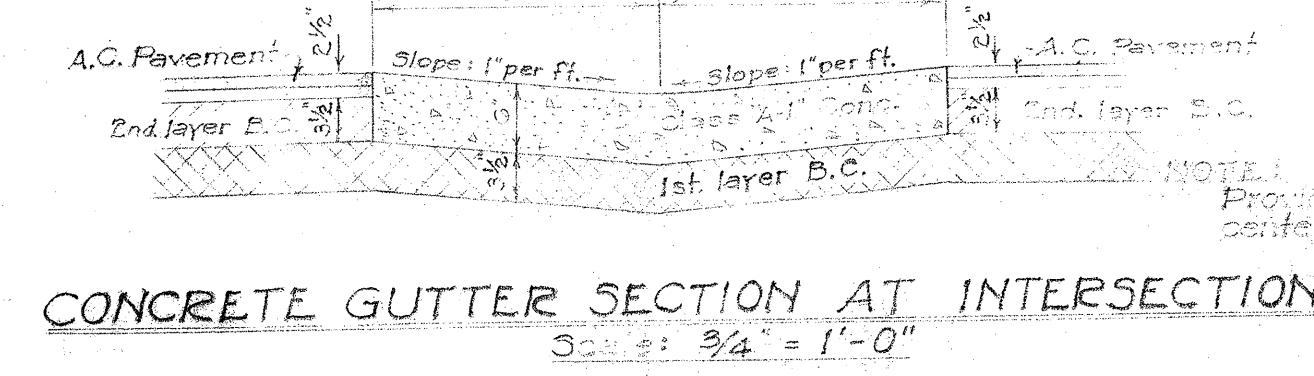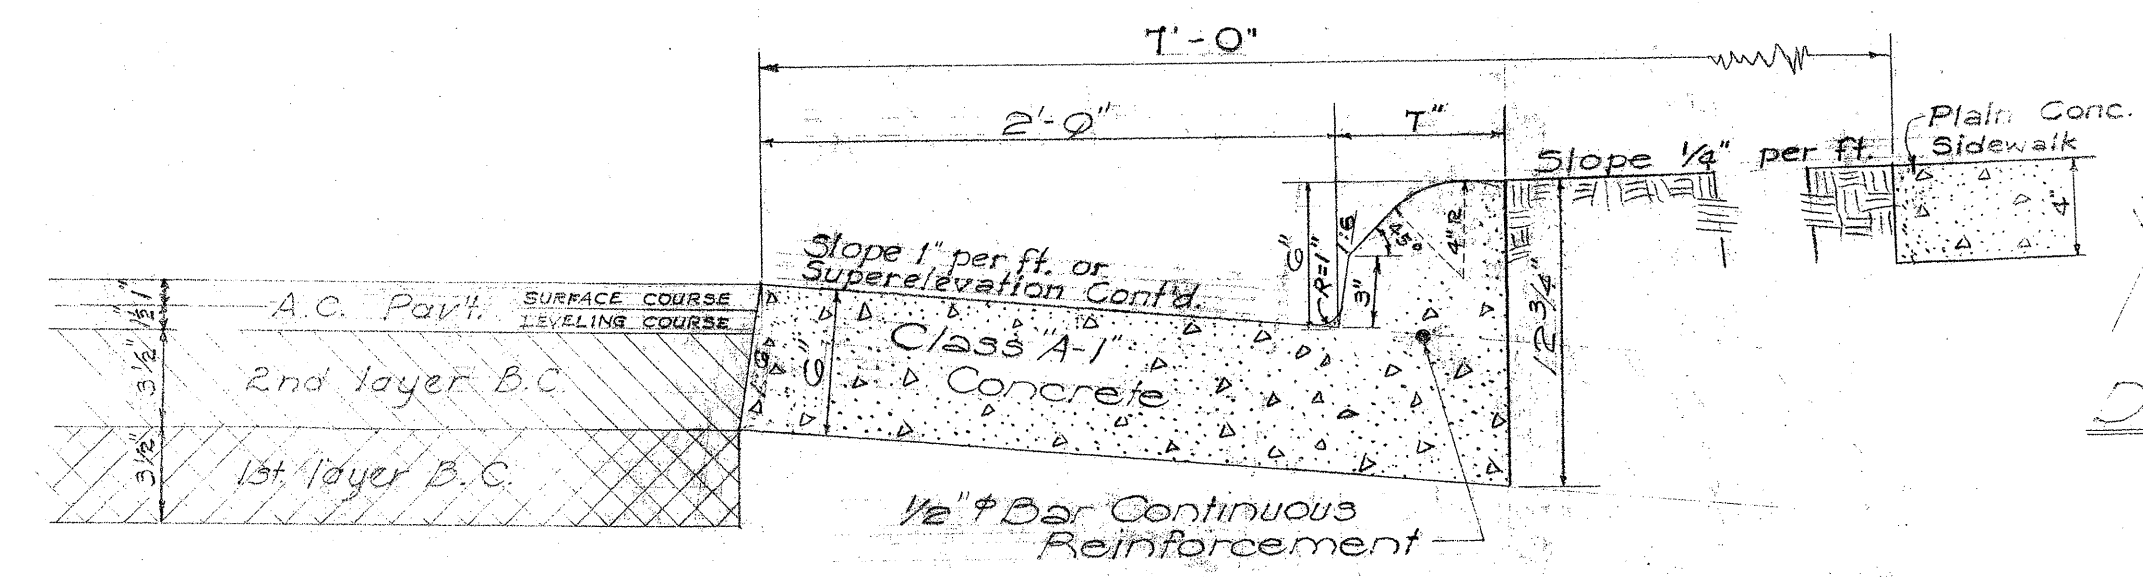


TERRITORIAL HIGHWAY DEPARTMENT
TERRITORY OF HAWAII

TYPICAL SECTIONS
KAILUA ROAD
PROJECT No. 9 230(3)
& W.D.R. 9 (2)

Scales: As noted Aug. 10, 40.

SURVEY PLOTTED BY	DATE
DESIGNED BY	
DRAWN BY	
NOTES CHECKED BY	
QUANTITIES CHECKED BY	
ORIGINAL PLAN	NO.

FED. ROAD DIST. NO.	STATE	FED. AID PROJ. NO.	FISCAL YEAR	SHEET NO.	TOTAL SHEETS
HAWAII	HAWAII	W.D.R. 9	1950	3	6
5-25-50 6-8-50					

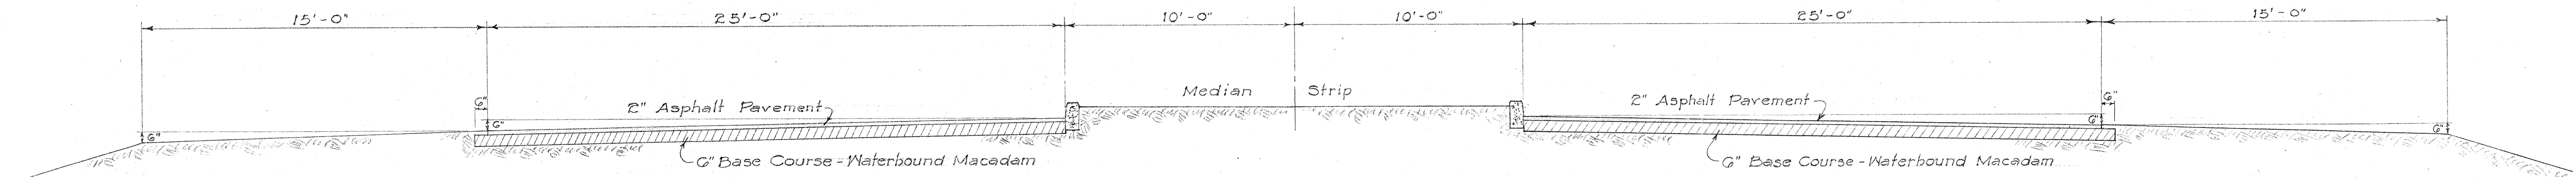


TYPICAL SECTION AS ORIGINALLY CONSTRUCTED

Scale: 1/4" = 1'-0"

NOTE

Surface of Existing Pavement shall be broomed and given a Tack Coat of 0.15 gal. of Emulsified Asphalt before laying variable thickness of Mix III Leveling Course.
A.C. Resurfacing shall consist of variable thickness (average 1") of Leveling Course, Mix III, and a Surface Course of 1" compacted thickness using Mix V.

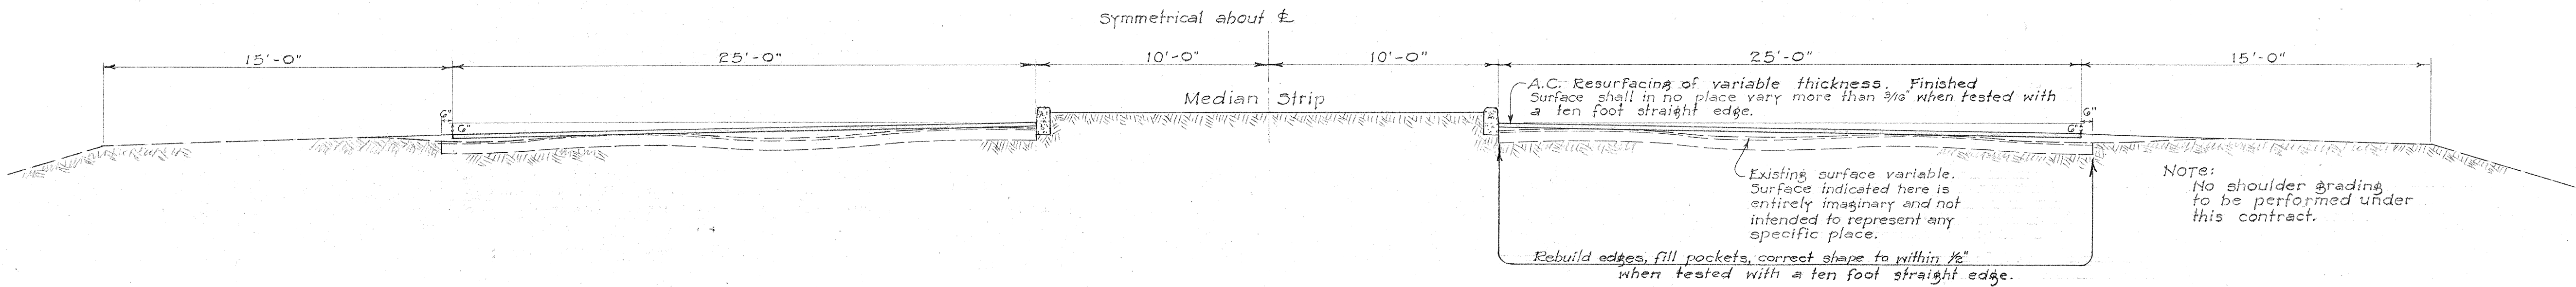

TYPICAL SECTION OF WORK TO BE DONE
KAILUA ROAD W.D.R. 9 (2)

Scale: 1/4" = 1'-0"

SURVEYED BY	DATE
DESIGNED BY	
DRAWN BY	
NOTED BY	
QUANTITIES CHECKED BY	
CHECKED BY	

TERRITORIAL HIGHWAY DEPARTMENT
TERRITORY OF HAWAII

TYPICAL SECTIONS
KAILUA ROAD
PROJECT NO. W.D.R. 9 (2)
SCALE AS NOTED Jan. 1950