
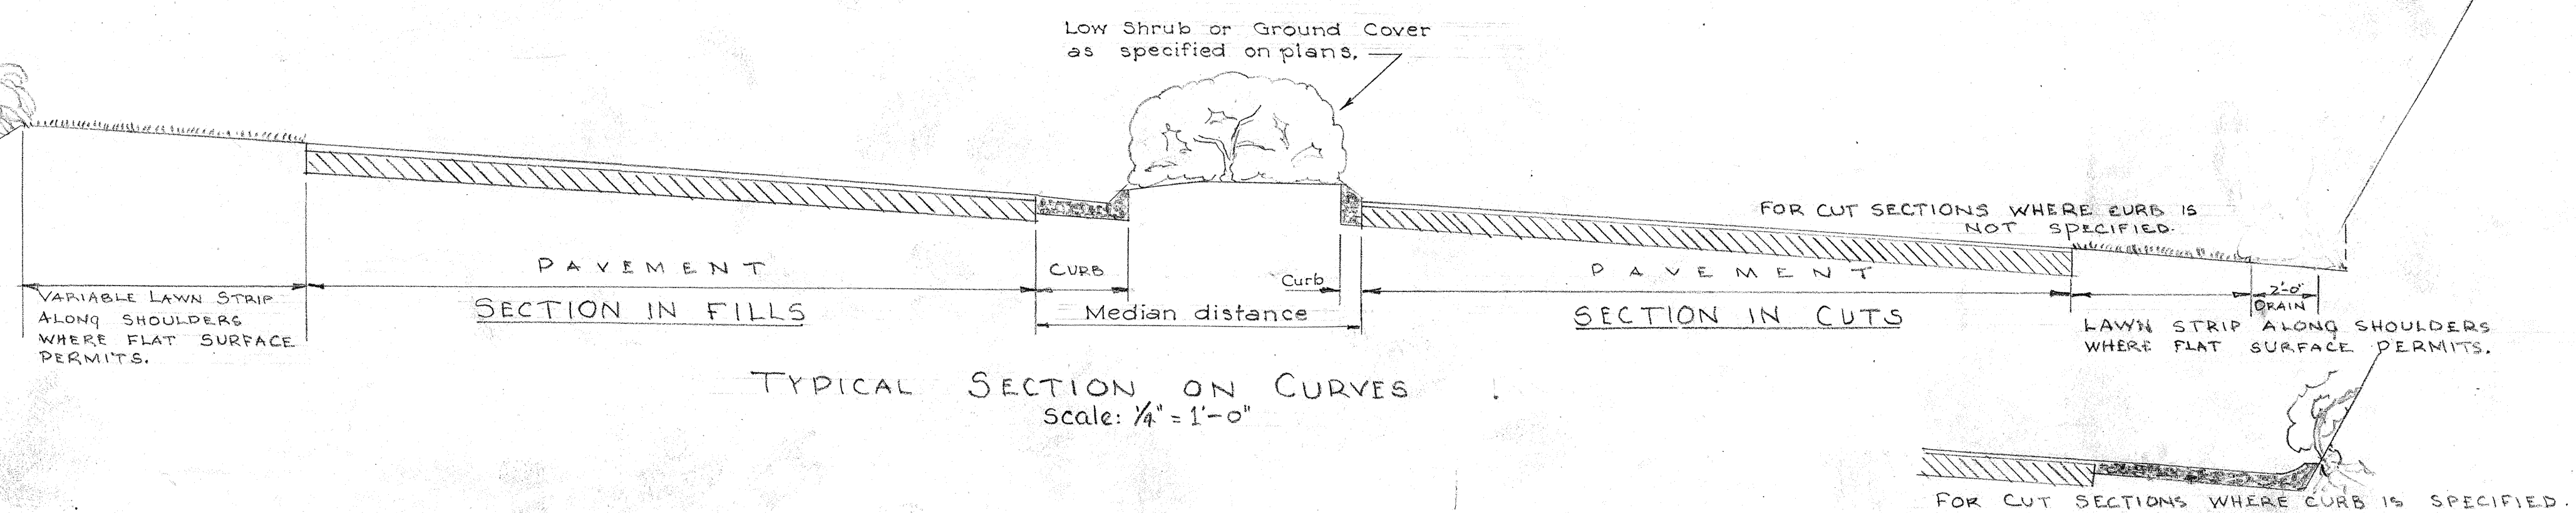
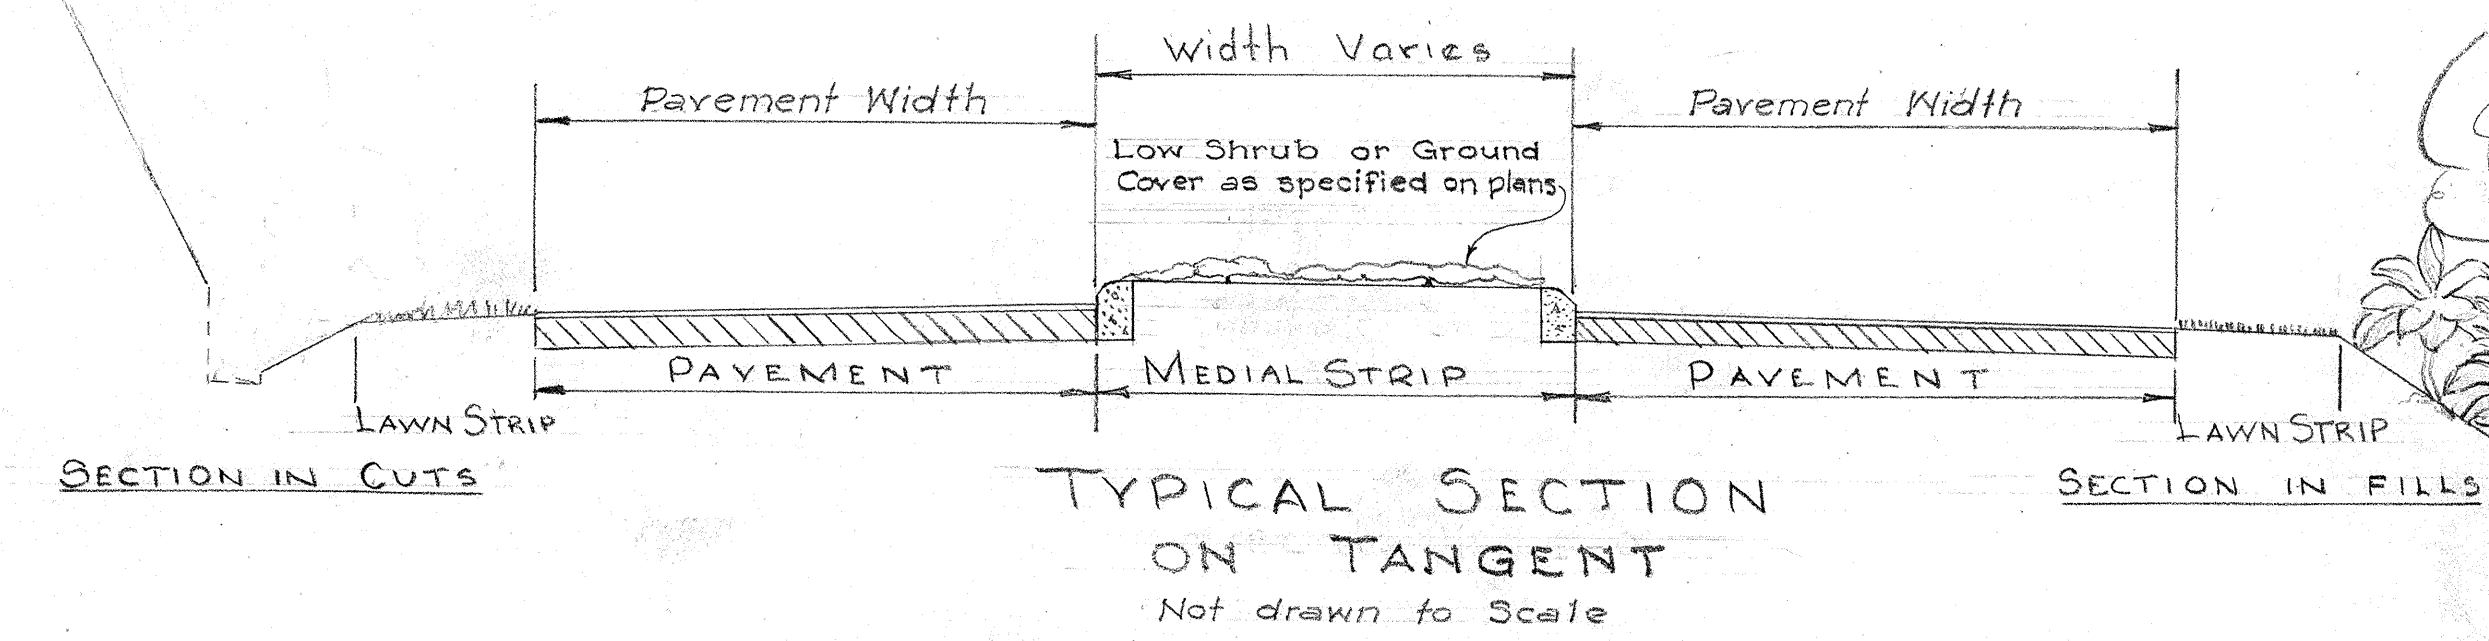


FED. ROAD DIST. NO.	STATE	FED. AID PROJ. NO.	FISCAL YEAR	SHEET NO.	TOTAL SHEETS
HAWAII	HAW.	F15 (5)	1949	2	4

6-28-50

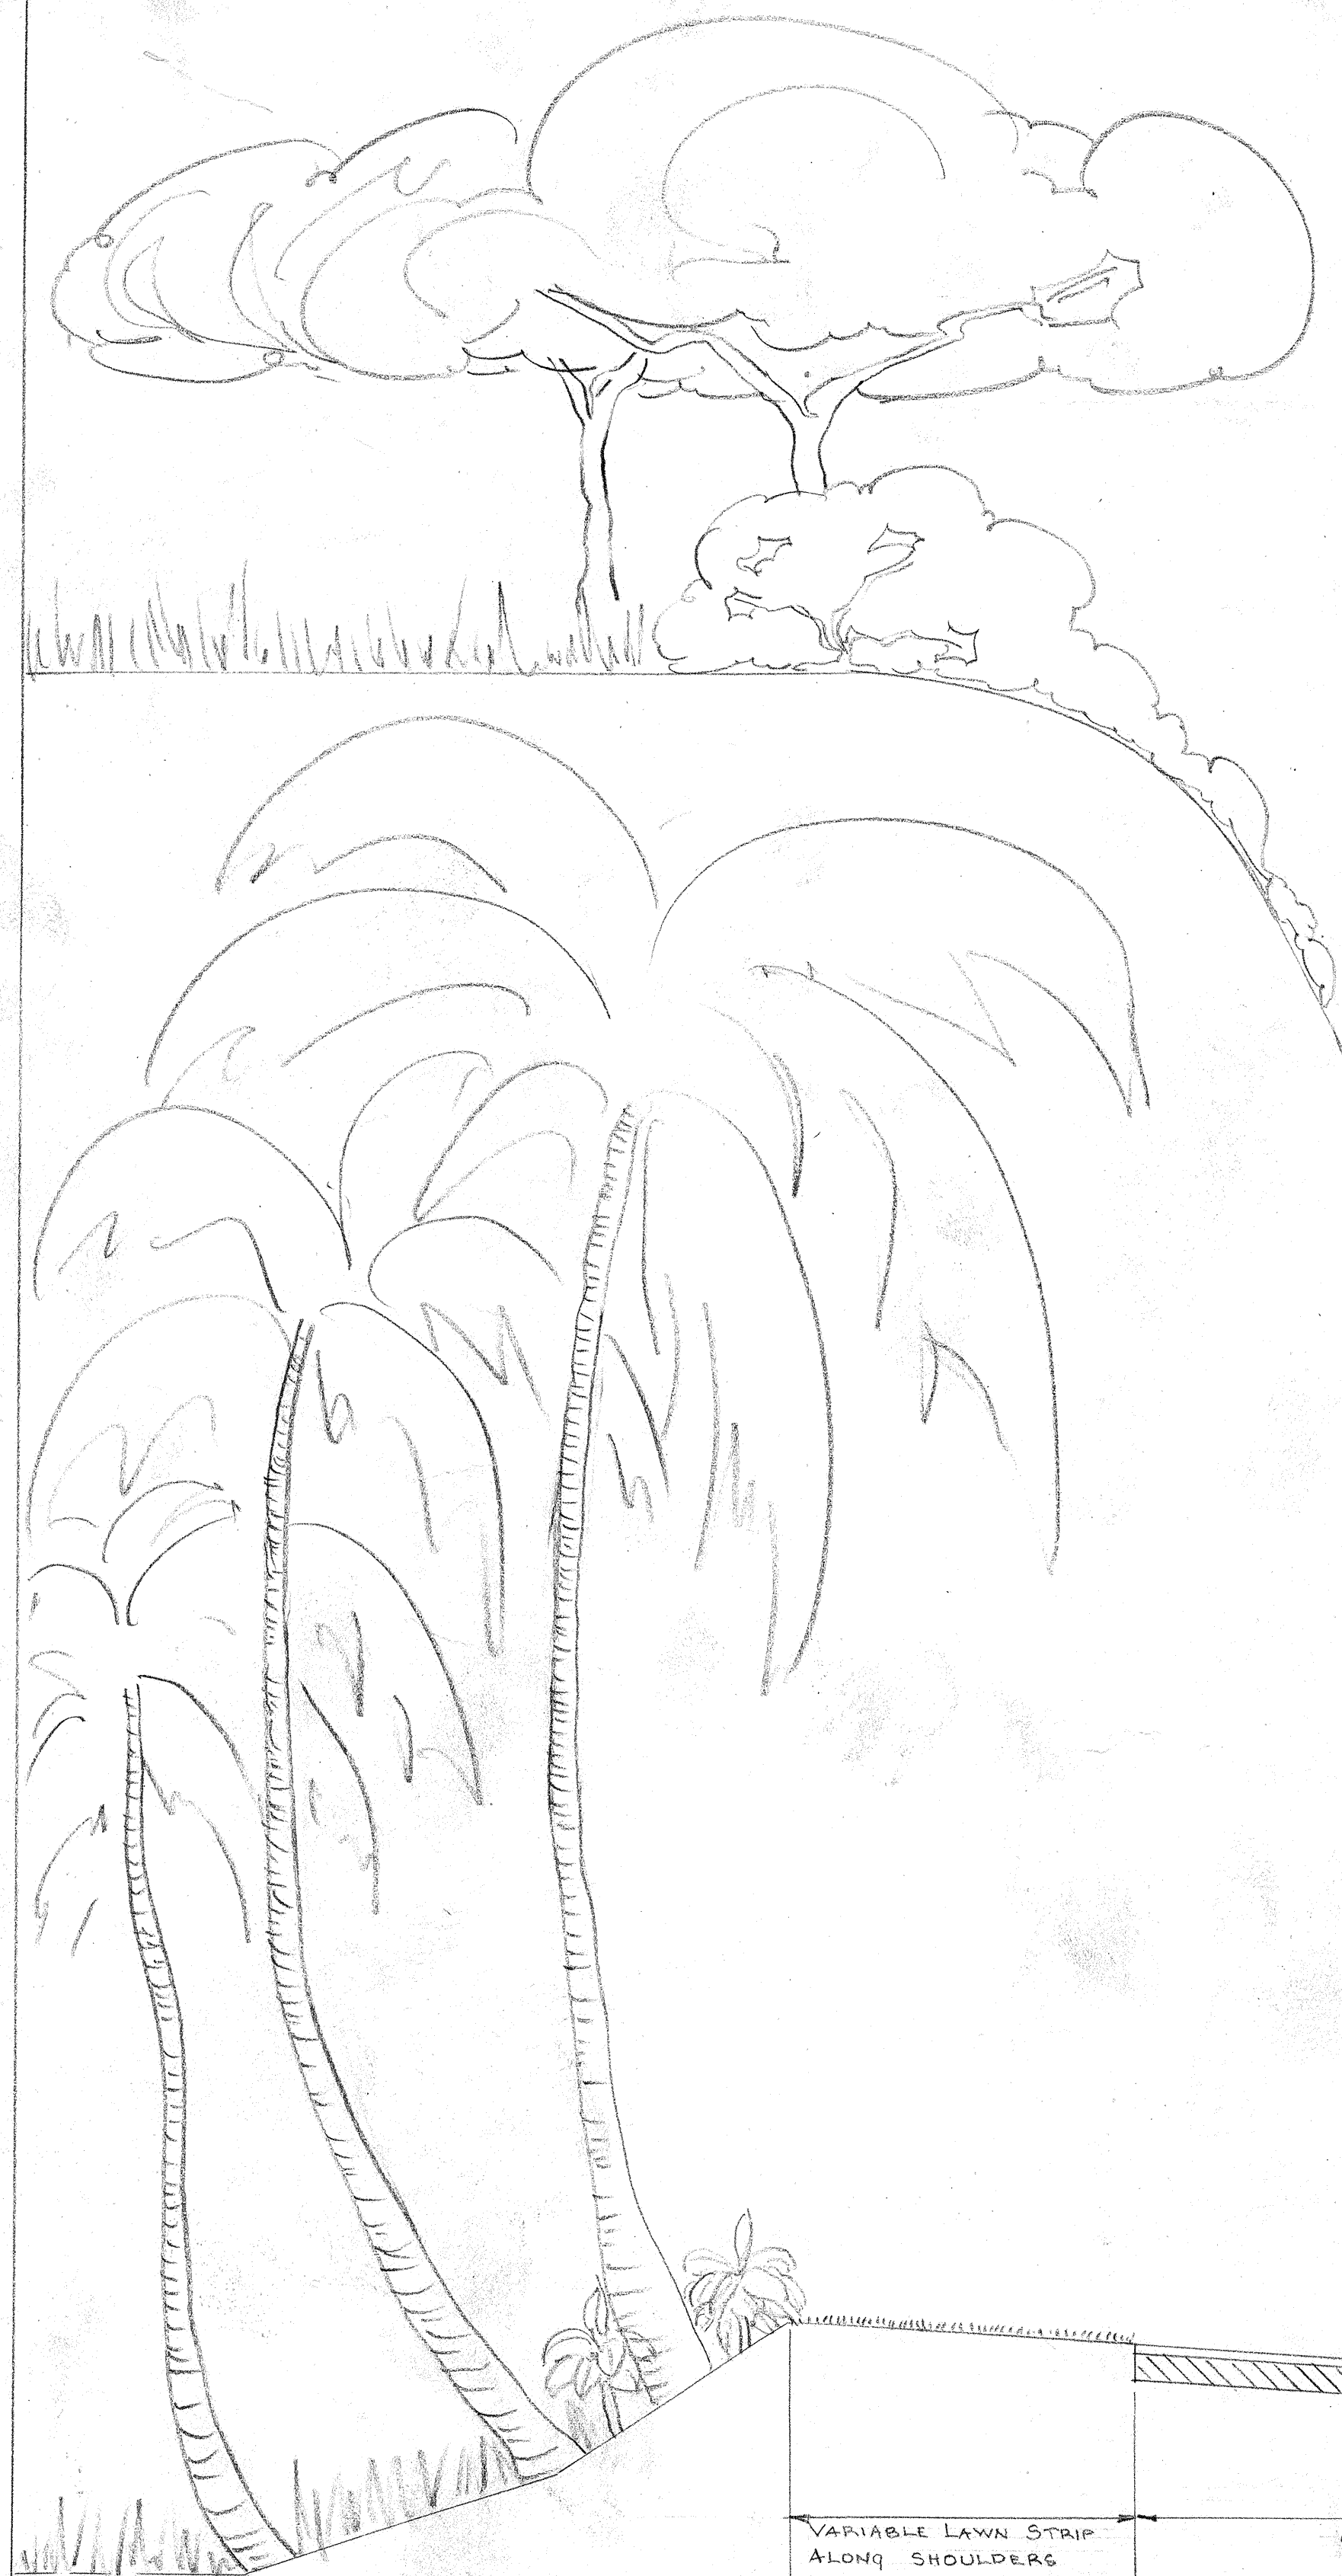

TERRITORIAL HIGHWAY DEPARTMENT
TERRITORY OF HAWAII
TYPICAL SECTION
KALANIANA'OLE HIGHWAY
PROJECT NO. F 15 (5)
Scale: As Shown Date: Dec. 49