

| INDEX TO DRAWINGS |                      |
|-------------------|----------------------|
| SHEET NO.         | DESCRIPTION          |
| 1                 | TITLE SHEET          |
| 2                 | TYPICAL SECTION      |
| 3-7               | PLAN & PROFILE       |
| 8                 | INTERSECTION DETAILS |
| 9                 | CONNECTION DETAILS   |
| 10-15             | STANDARD DETAILS     |
| 16                | SOIL INVESTIGATION   |
| 17-22             | CULVERT SECTIONS     |
| 23-27             | CROSS SECTIONS       |

TERRITORY OF HAWAII  
TERRITORIAL HIGHWAY DEPARTMENT  
HONOLULU, OAHU, T. H.

# PLANS OF PALI ROAD


FEDERAL AID SECONDARY PROJECT NO. S 216 (3)

DISTRICT OF KOOLAUPOKO

ISLAND OF OAHU

## SCALES

PLAN 1 IN. = 50 FT.  
 PROFILE HOR. 1 IN. = 50 FT.  
 VERT. 1 IN. = 10 FT.  
 GROSS SECTION HOR. 1 IN. = 10 FT.  
 VERT. 1 IN. = 10 FT.

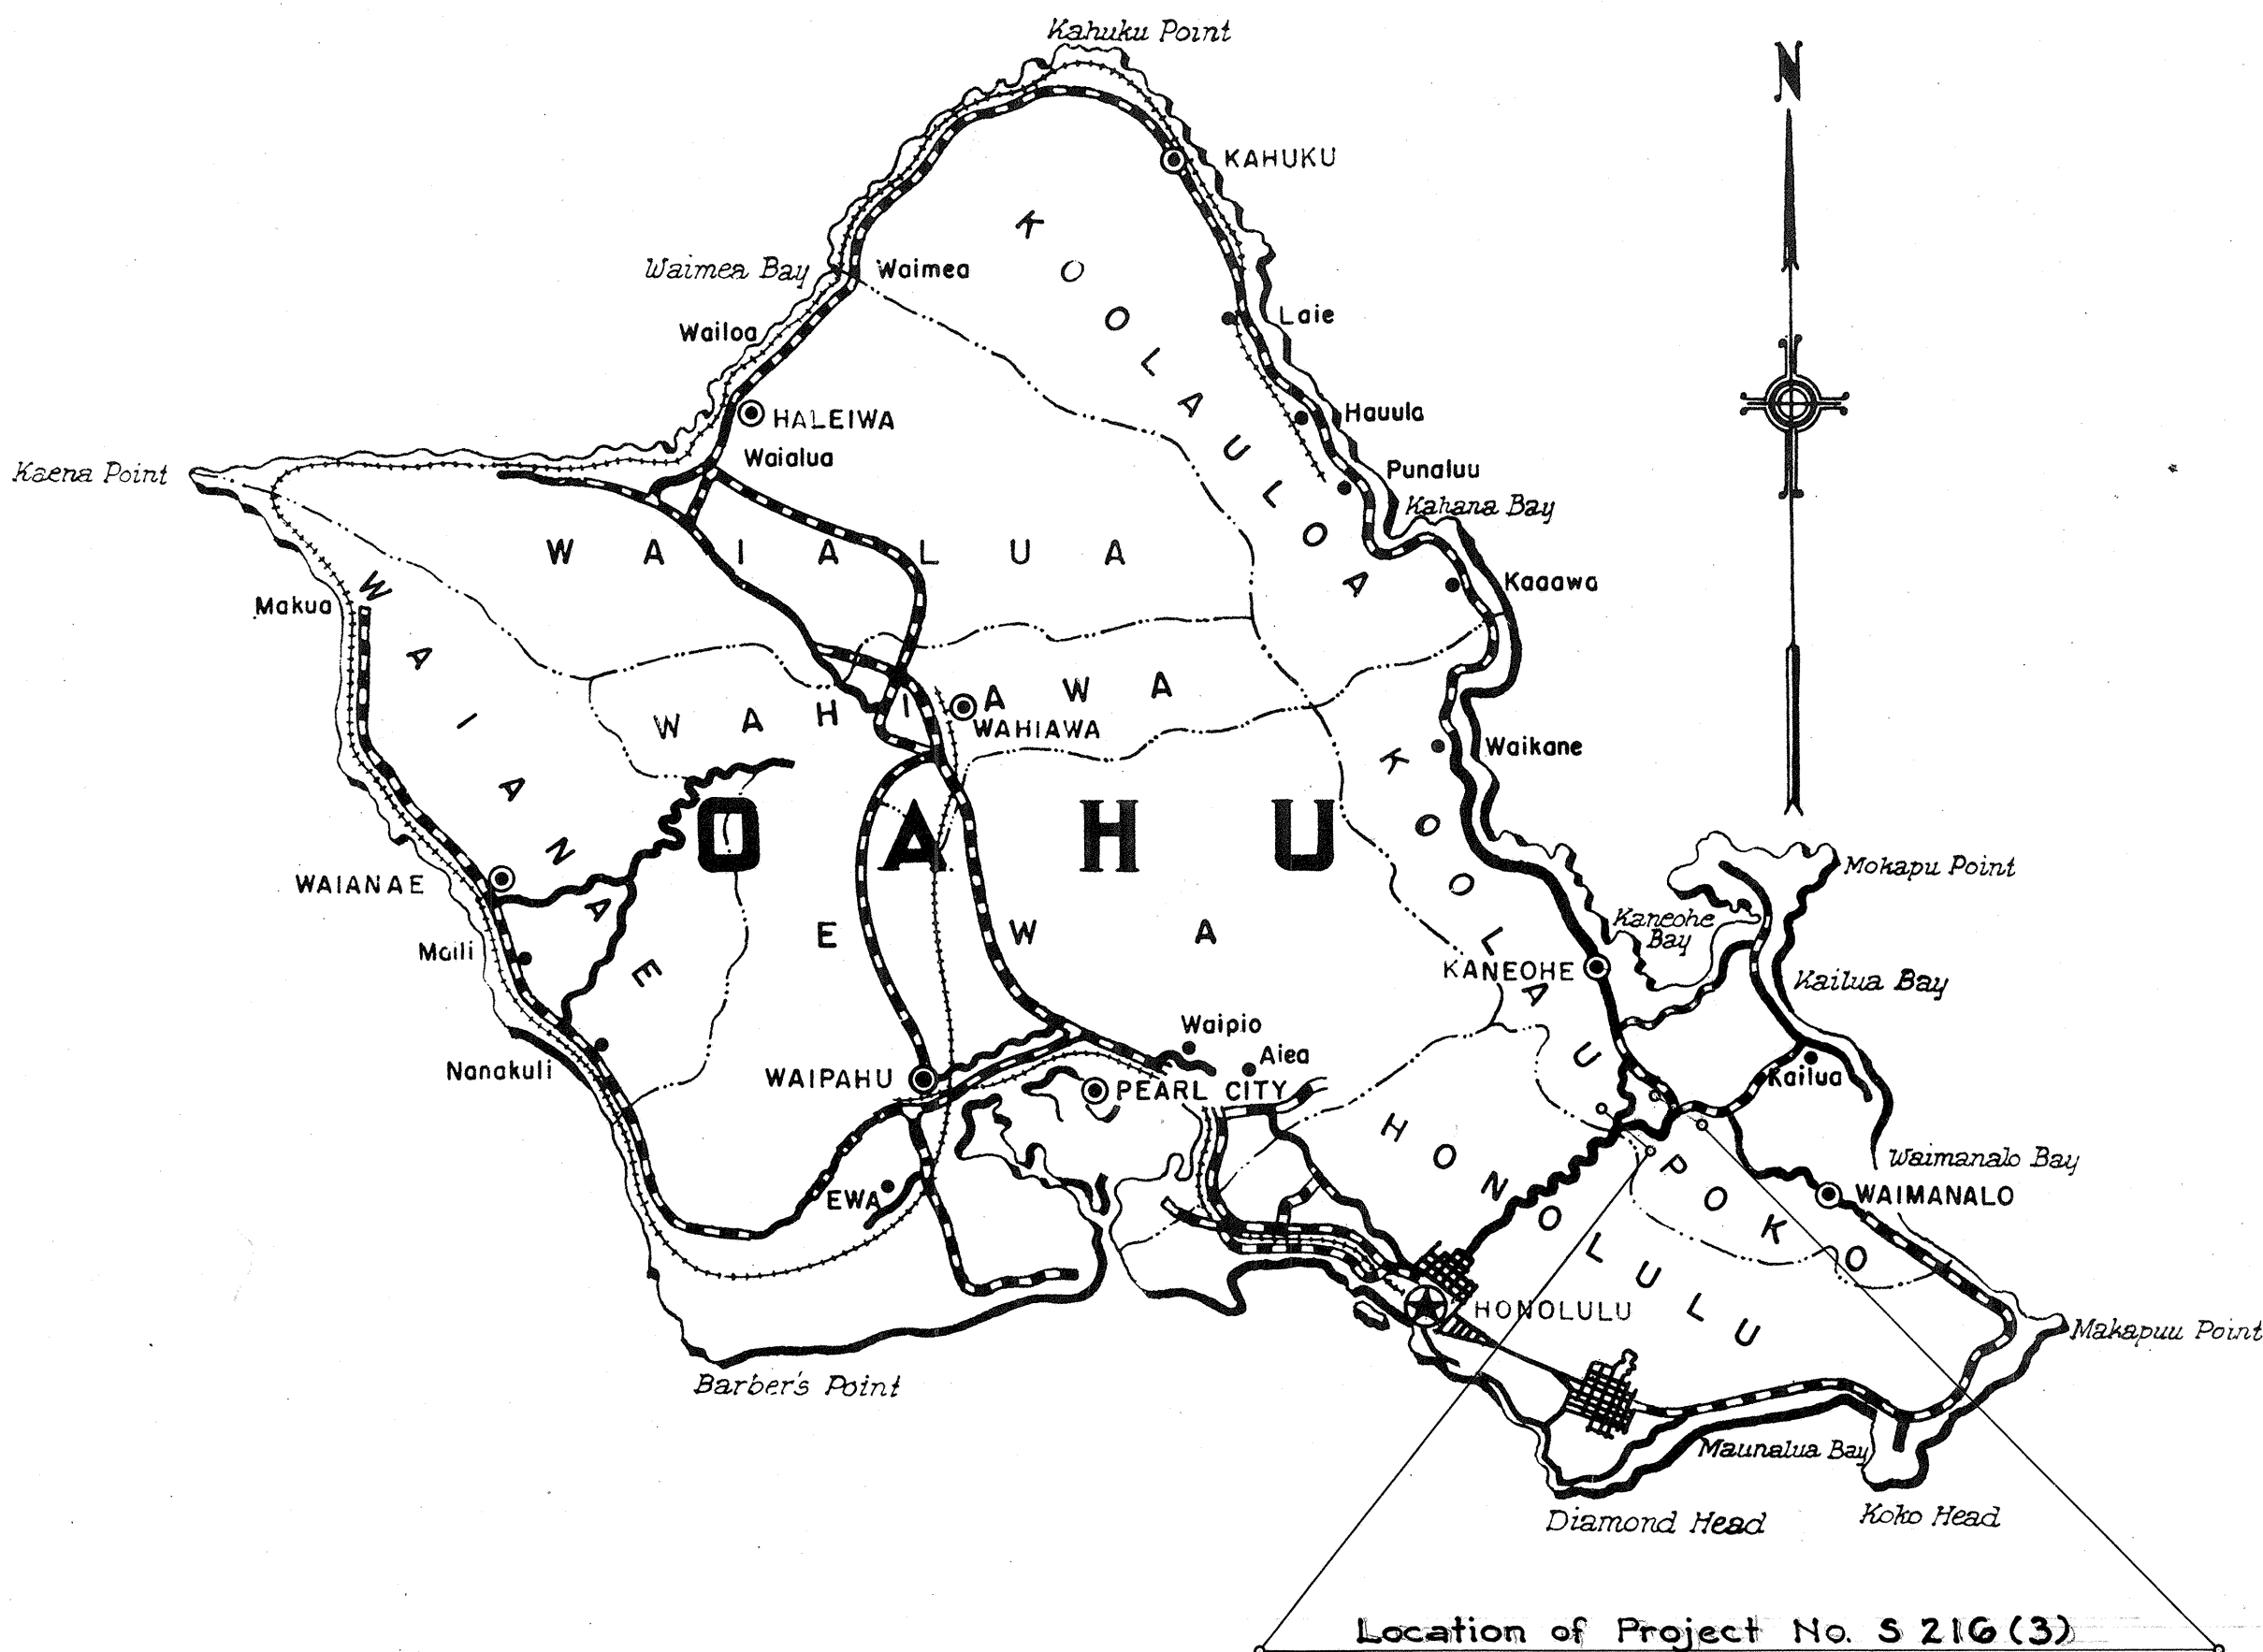


| CONVENTIONAL SIGNS                 |                                                                 |
|------------------------------------|-----------------------------------------------------------------|
| Centerline                         | 125                                                             |
| Boundary Lines                     | or                                                              |
| Fences (Named)                     |                                                                 |
| Existing Roadways                  |                                                                 |
| Circular Culvert                   |                                                                 |
| Box Culvert                        |                                                                 |
| Bridge                             |                                                                 |
| Telephone Pole                     |                                                                 |
| Electric Power Pole                |                                                                 |
| Water Main                         | W <sub>2</sub> W <sub>2</sub> (W <sub>4</sub> , 8, 12, Etc.)    |
| Storm Drain                        | SD <sub>12</sub> SD <sub>12</sub> (SD <sub>18</sub> , 24, Etc.) |
| Concrete Drop Intake               | C.D.I.                                                          |
| Standard Catch Basin               | S.C.B.                                                          |
| Standard Manhole                   | S.M.H.                                                          |
| Sewer Manhole                      | S.S. S.S. S <sub>12</sub>                                       |
| Telephone Manhole                  | T.M.H.                                                          |
| Fire Hydrant                       | F.H.                                                            |
| Tree (Large, named)                | Mango Coco                                                      |
| Railroad                           |                                                                 |
| Mutual Telephone Underground Cable | MTC                                                             |
| Water Meter                        | WM                                                              |

Federal Aid Projects Previously Constructed Or Under Construction

NOTE:  
All changes made during construction have been noted in red on these tracings and checked.

By: *Clair S. Stone*  
Project Engineer  
Date: *1-5-54*

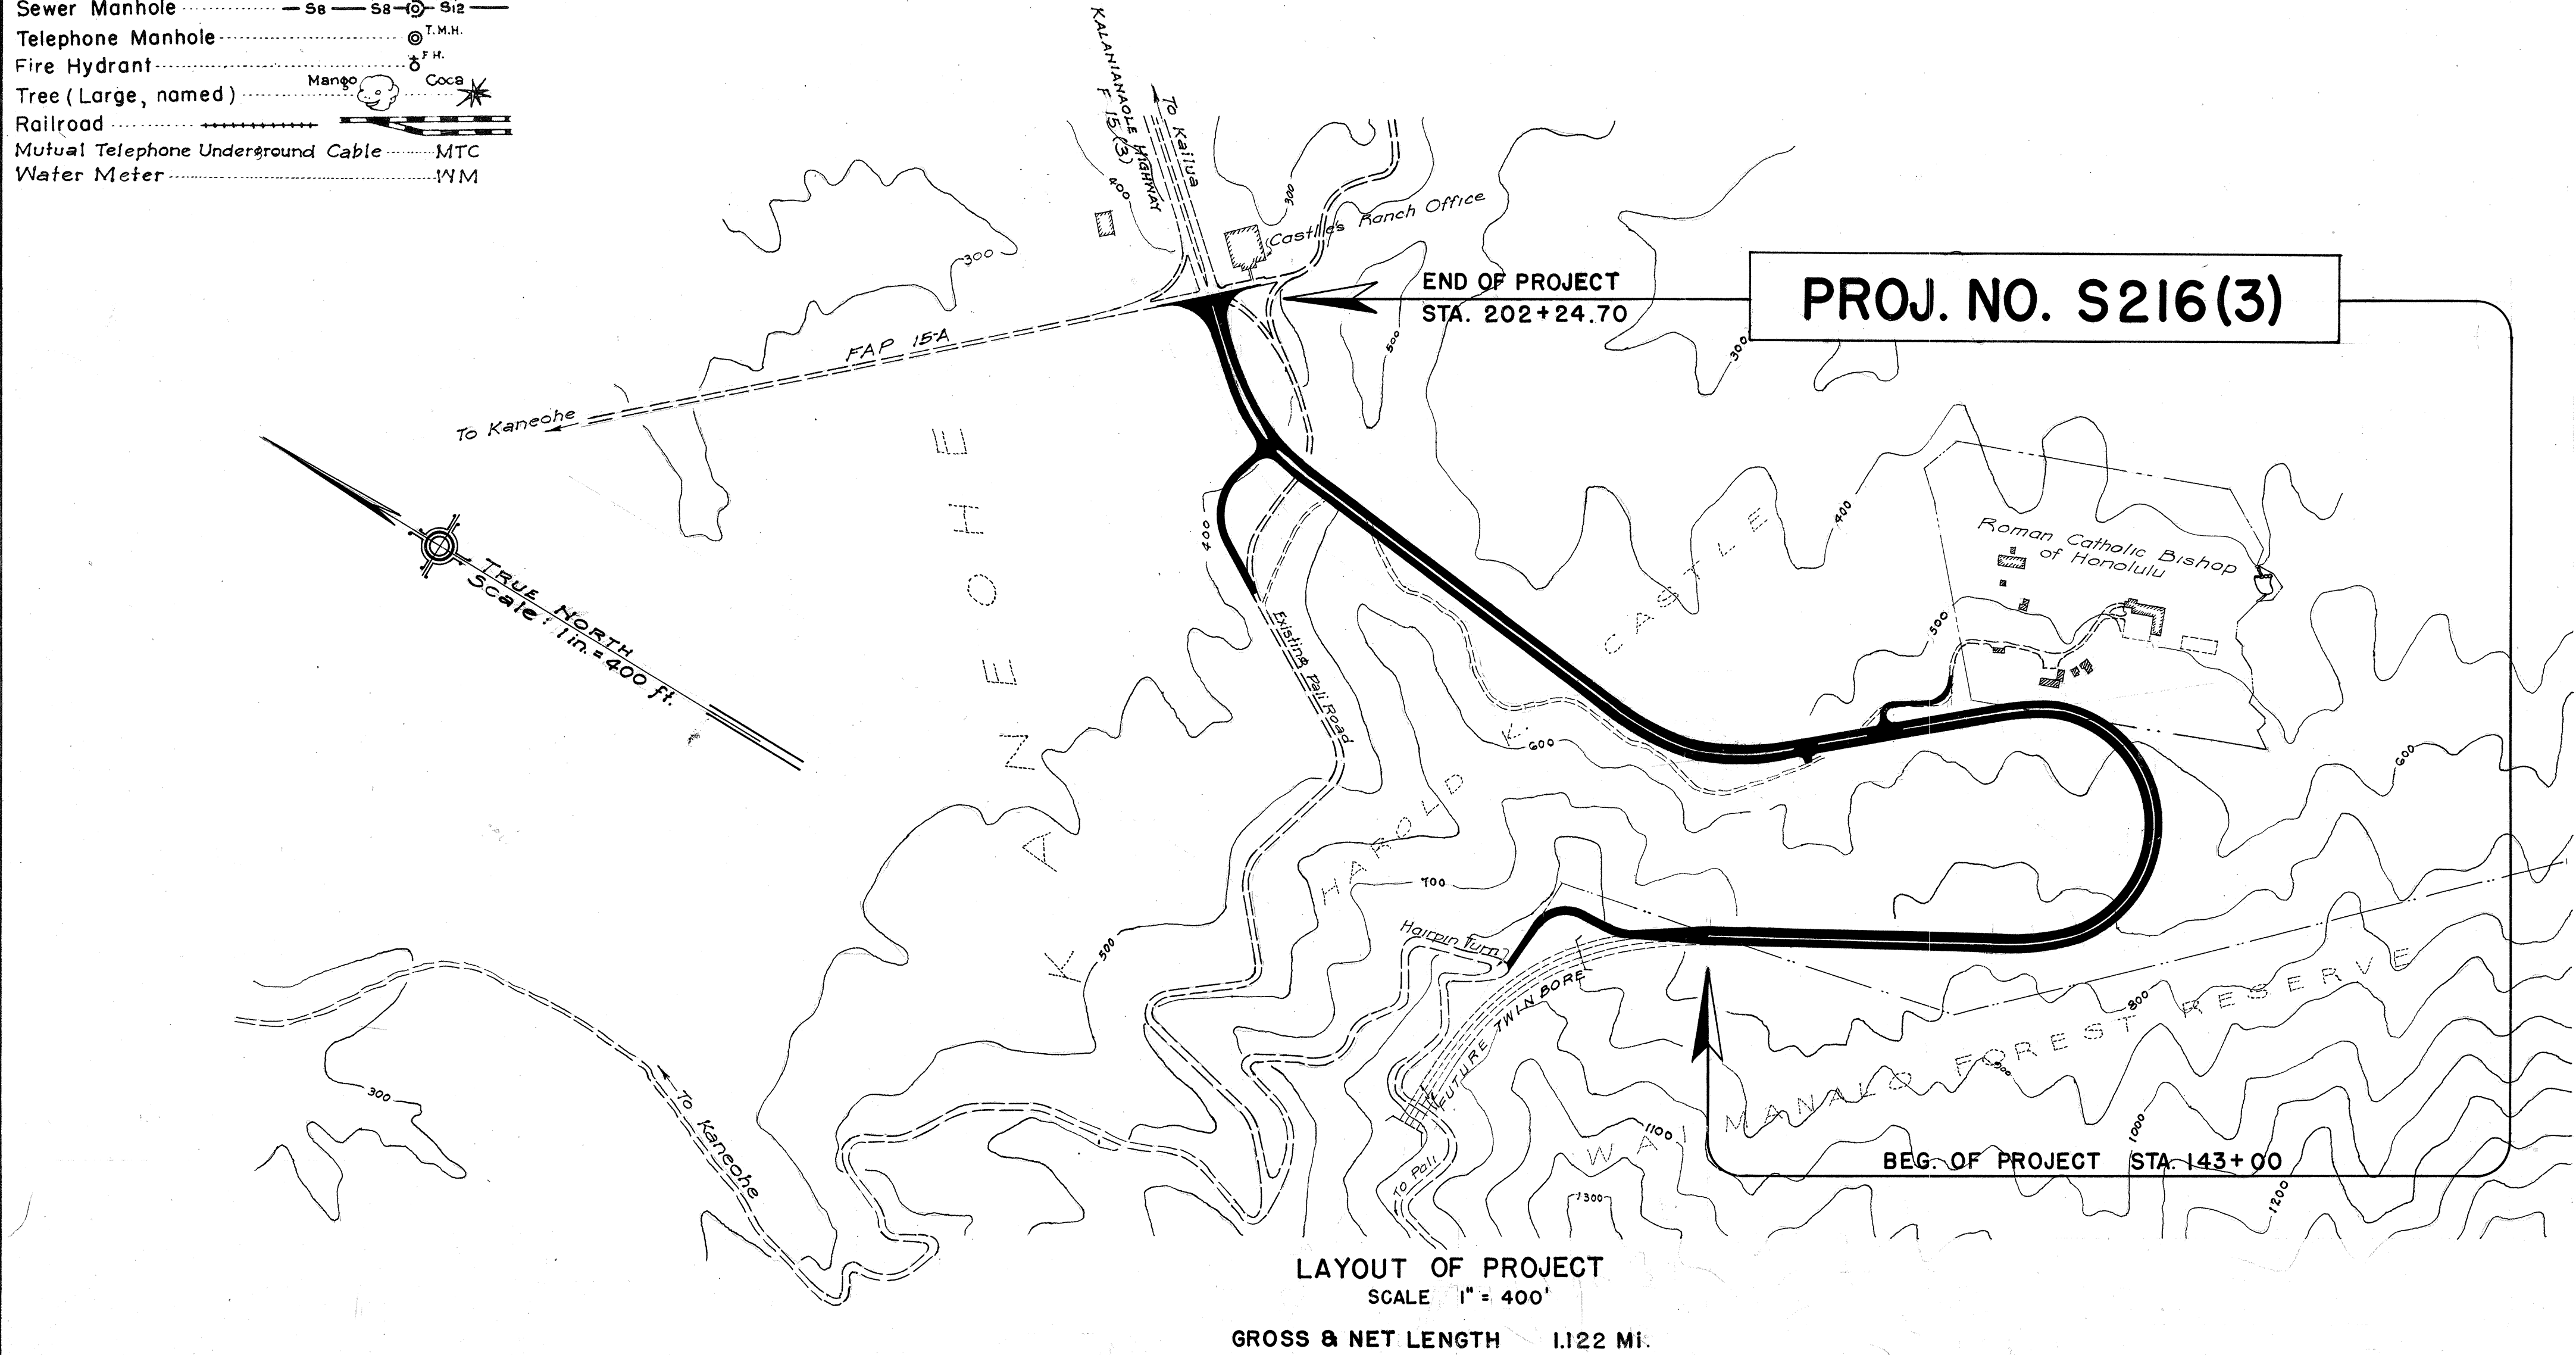

LAYOUT OF PROJECT  
SCALE 1" = 400'  
GROSS & NET LENGTH 1.122 MI.

APPROVED DATE *Dec. 5, 1951*  
*Amber*  
TERRITORIAL HIGHWAY ENGINEER

|                                                  |      |
|--------------------------------------------------|------|
| DEPARTMENT OF COMMERCE<br>BUREAU OF PUBLIC ROADS |      |
| RECOMMENDED FOR APPROVAL:                        |      |
| DISTRICT ENGINEER                                | DATE |
| DIVISION ENGINEER                                | DATE |