
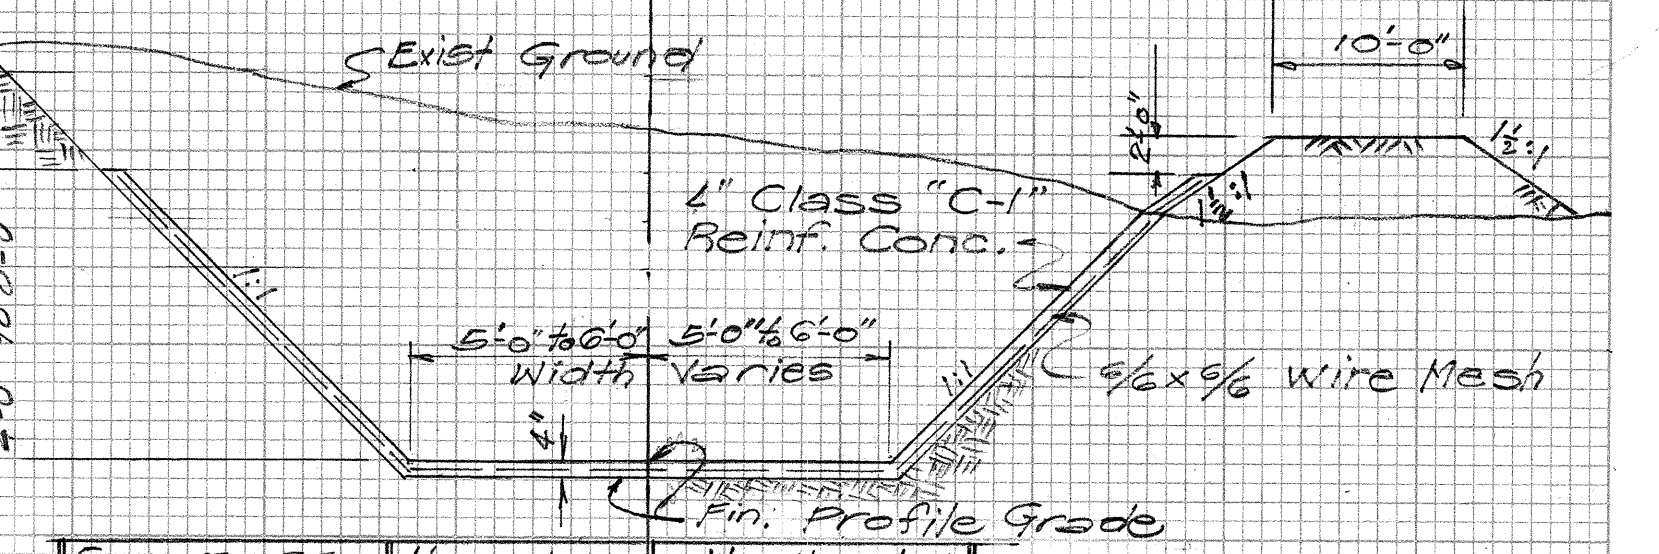
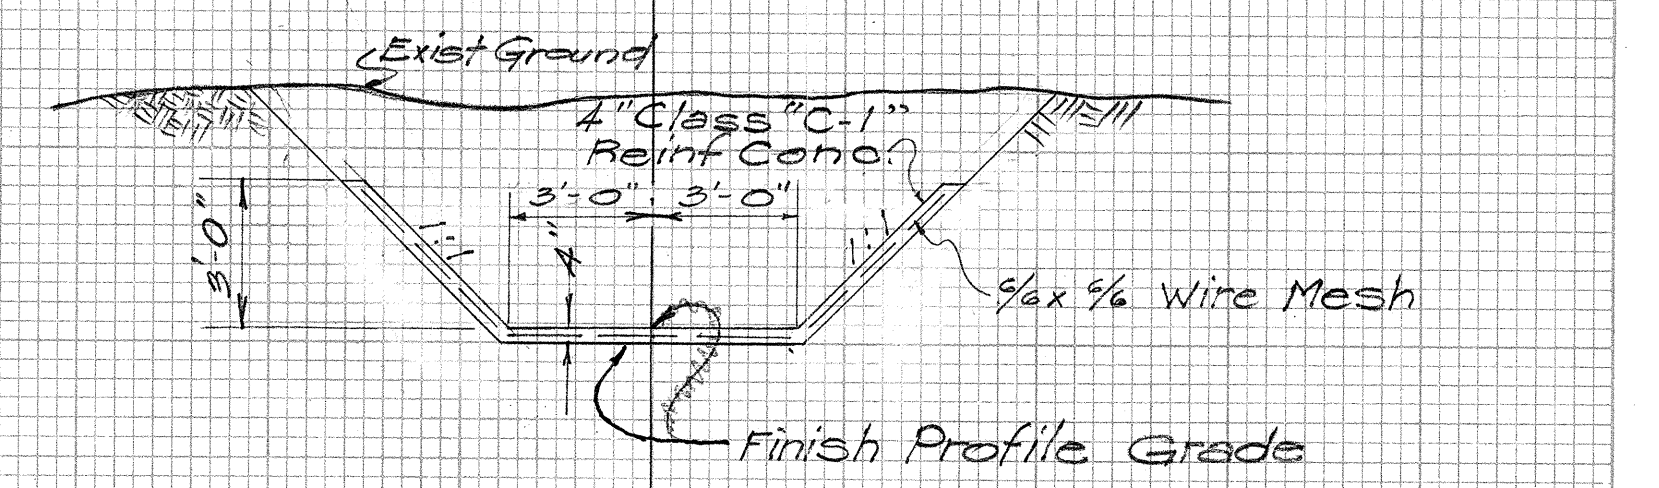


FINAL SURVEY
NOTE BOOK
NO.

ORIGINAL SURVEY
NOTE BOOK
NO.

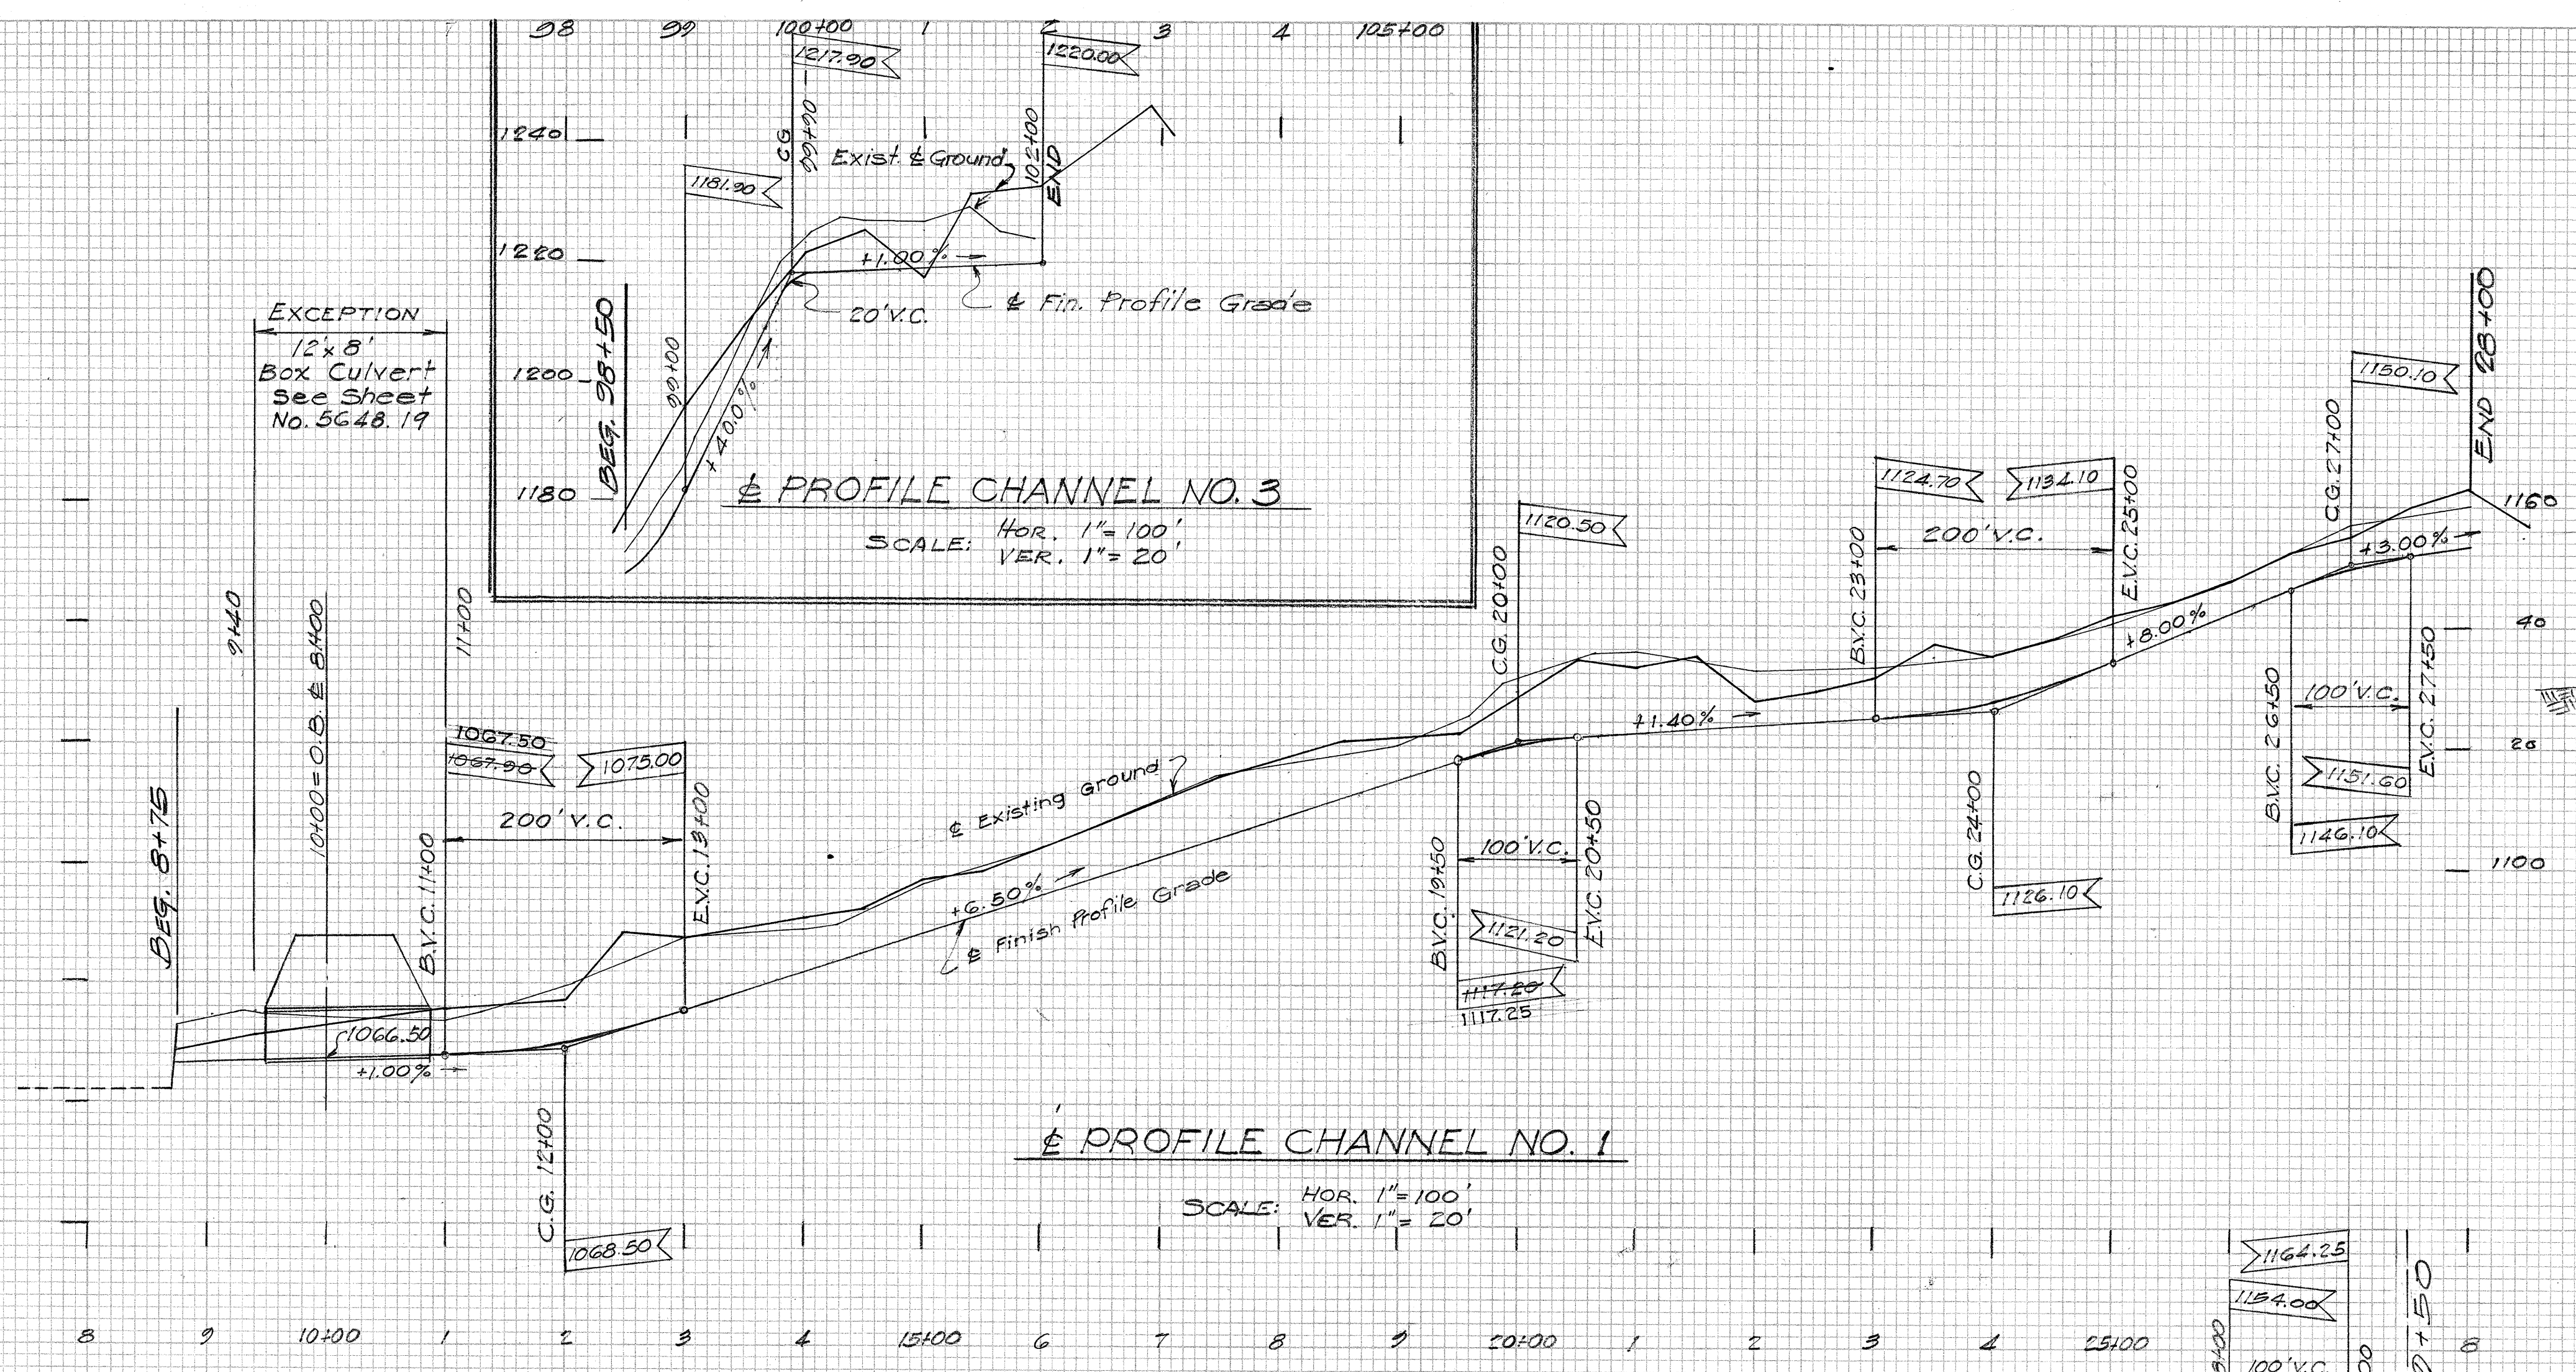



STA. TO STA.	HT. OF LIN.	WIDTH OF LIN.
8+75 - 11+00	8'-0"	12'-0"
12+00 - 13+00	6'-0"	10'-0"
14+00 - 23+00	5'-0"	10'-0"
24+00 - 28+50	4'-0"	6'-0"

NOTE: Make gradual changes in height and width between adjacent sections.

QUANTITY SUMMARY OF CHANNELS

No.	Uncl. Exc. C.Y.	Class "C-1" Conc. C.Y.	Wire Mesh lb.
1.	12,115	471.0	17,575
2.	19,058	470	15,250
3.	988	100.0	3,939
			2,134


FINAL X-SECTION MARCH 1954	
1.	11,780.0
2.	23,627.0
3.	2,849.0

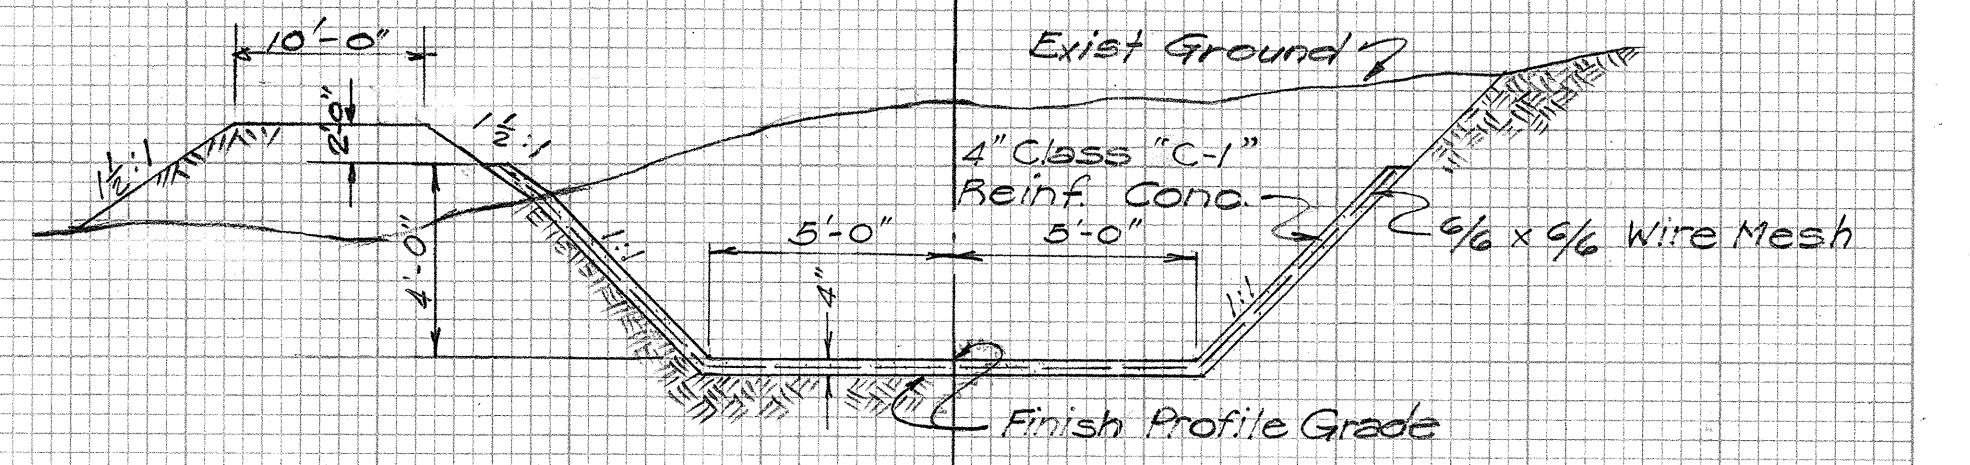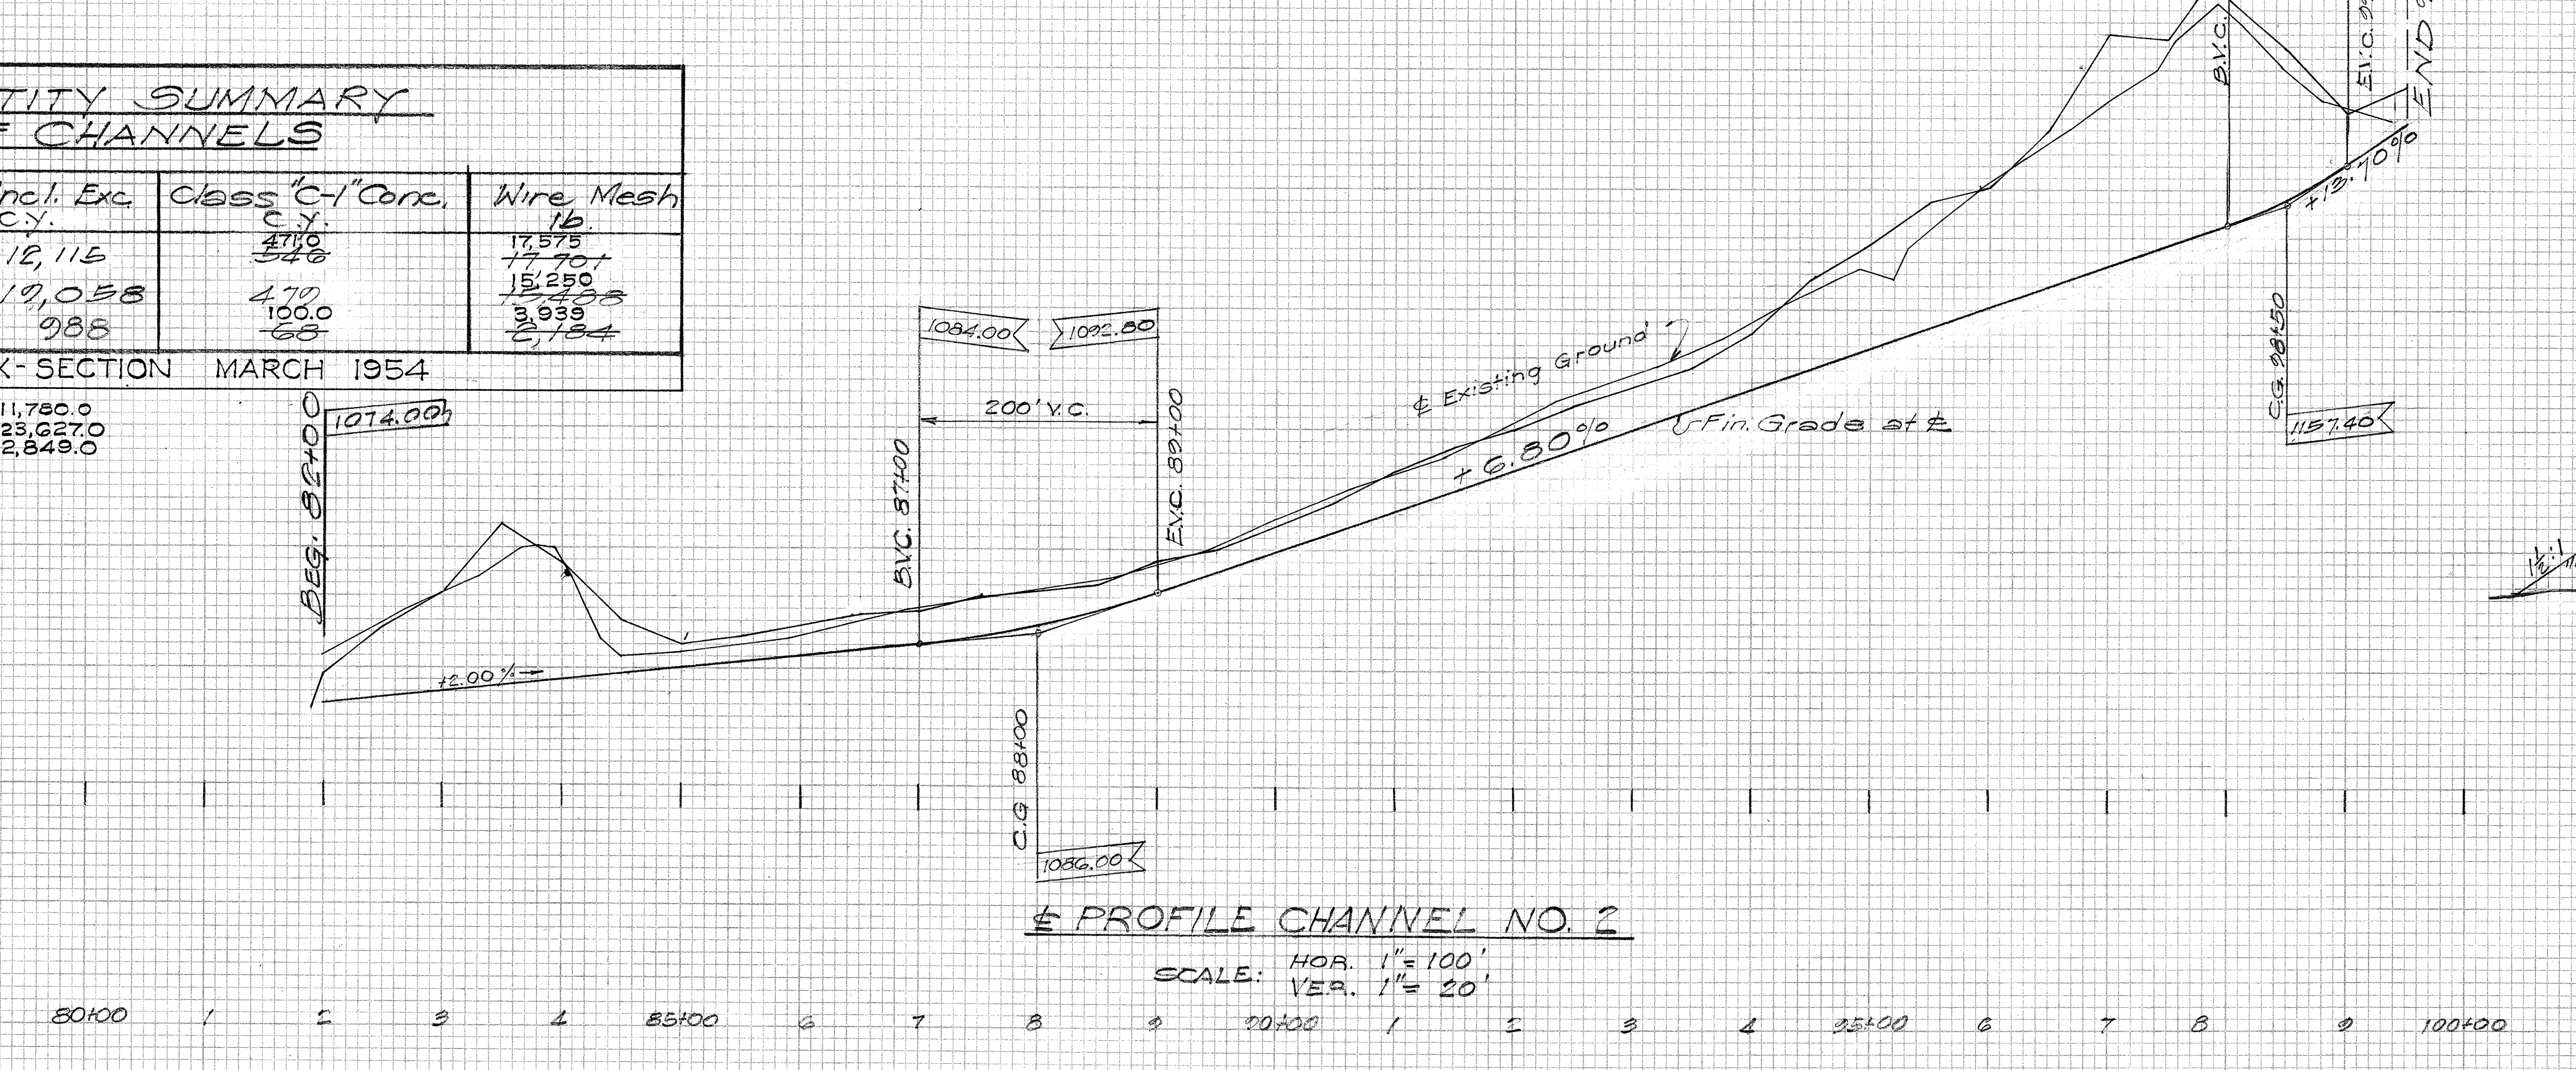

NOTE: Wire Mesh reinforcement shall be paid for under item No. 52(1) Reinforcing Steel other than at Bridges.

FINAL	SURVEYED _____	BY _____	DATE _____
SURVEY	PLOTTED _____		
NOTE BOOK	TEMPLATE _____		
NO.	AREAS _____		
	AREAS CHECKED _____		

ORIGINAL			
SURVEY	SURVEYED		
	PLOTTED		
	TEMPLATE		
NOTE BOOK	AREAS		
	CHECKED		
NO.		BY	DATE

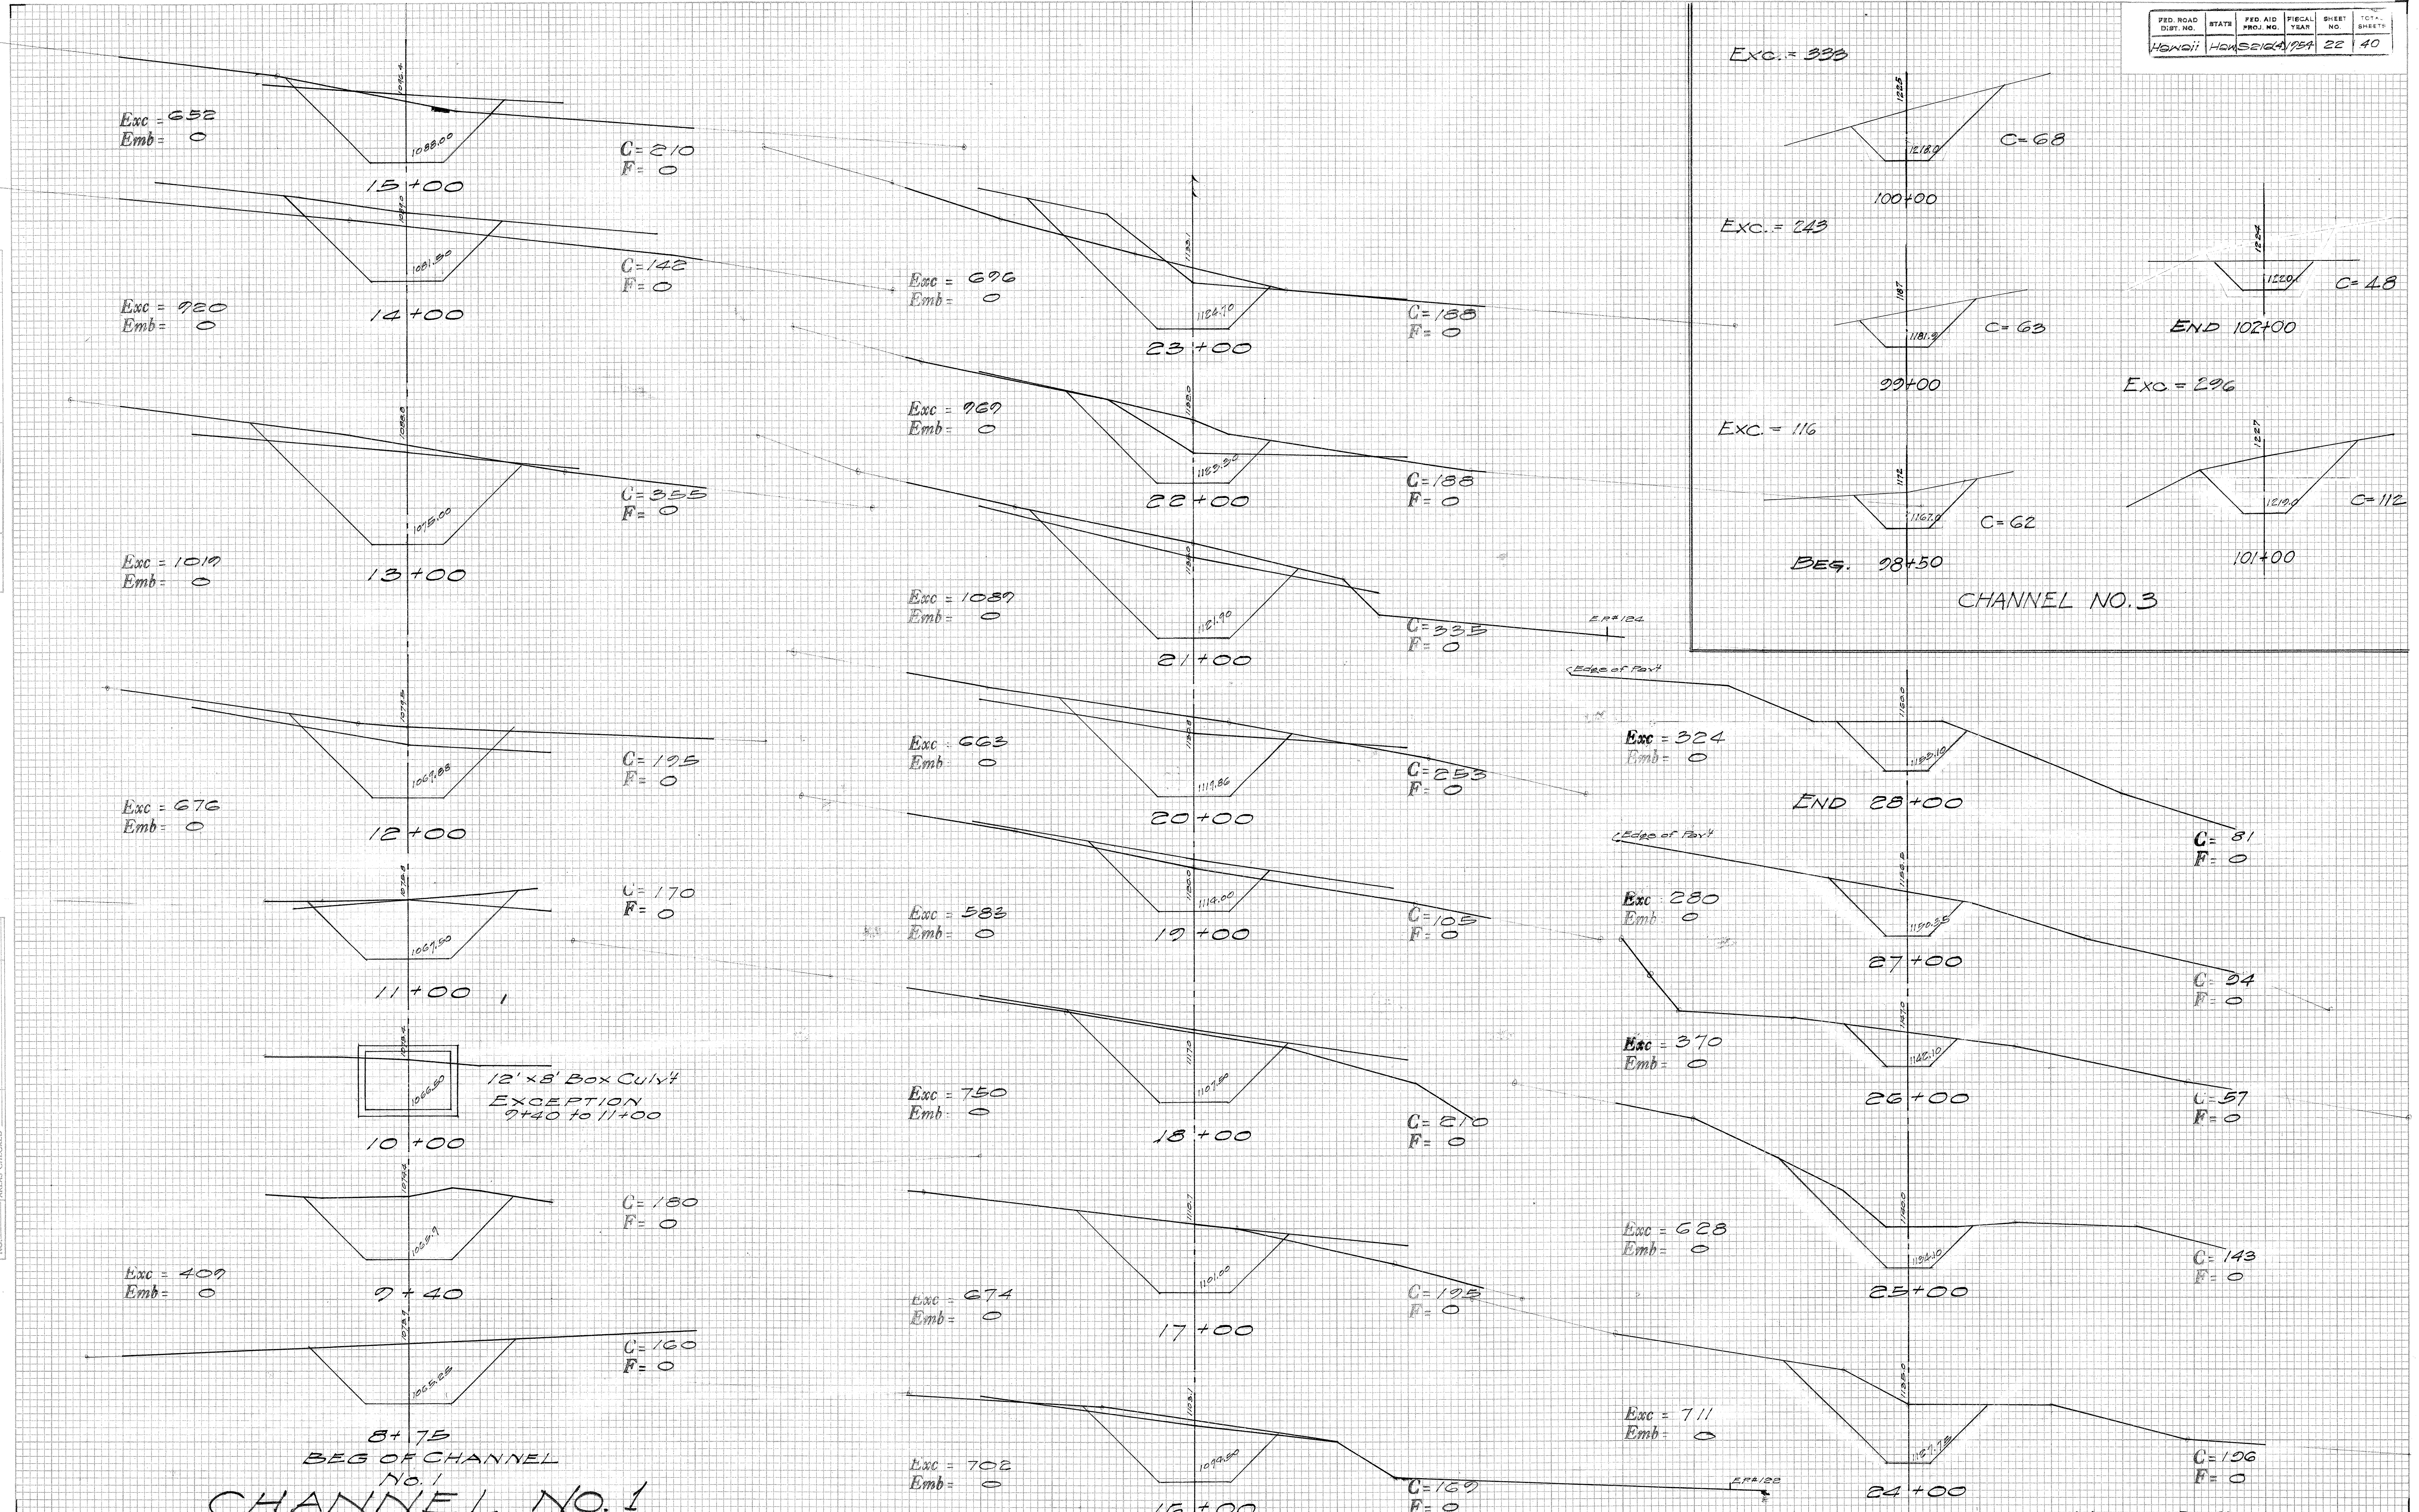

DATE	BY	NO.
ORIGINAL	SURVEY	NO.
NO.	NO.	NO.

DATE	BY	NO.
ORIGINAL	SURVEY	NO.
NO.	NO.	NO.

FED. ROAD DIST. NO.	STATE	FED. AID PROJ. NO.	FISCAL YEAR	SHEET NO.	TOTAL SHEETS
406611	HA	521694	1954	23	40

