
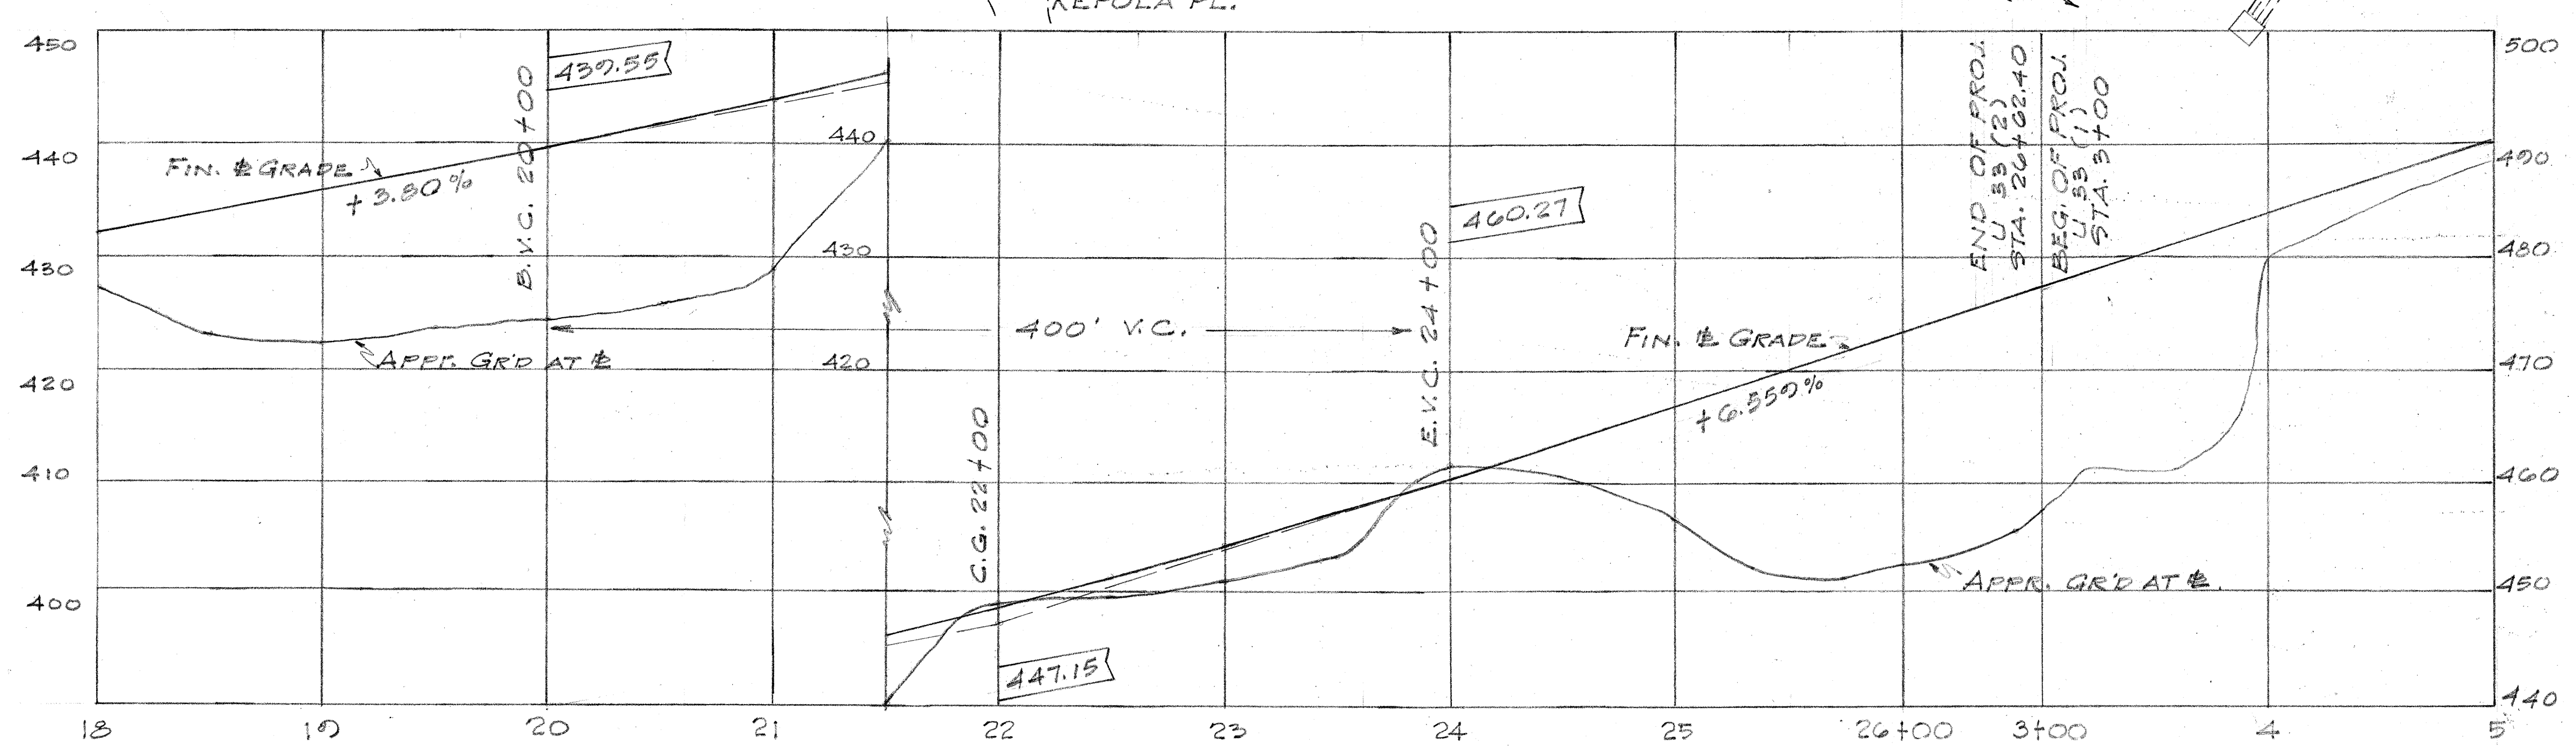
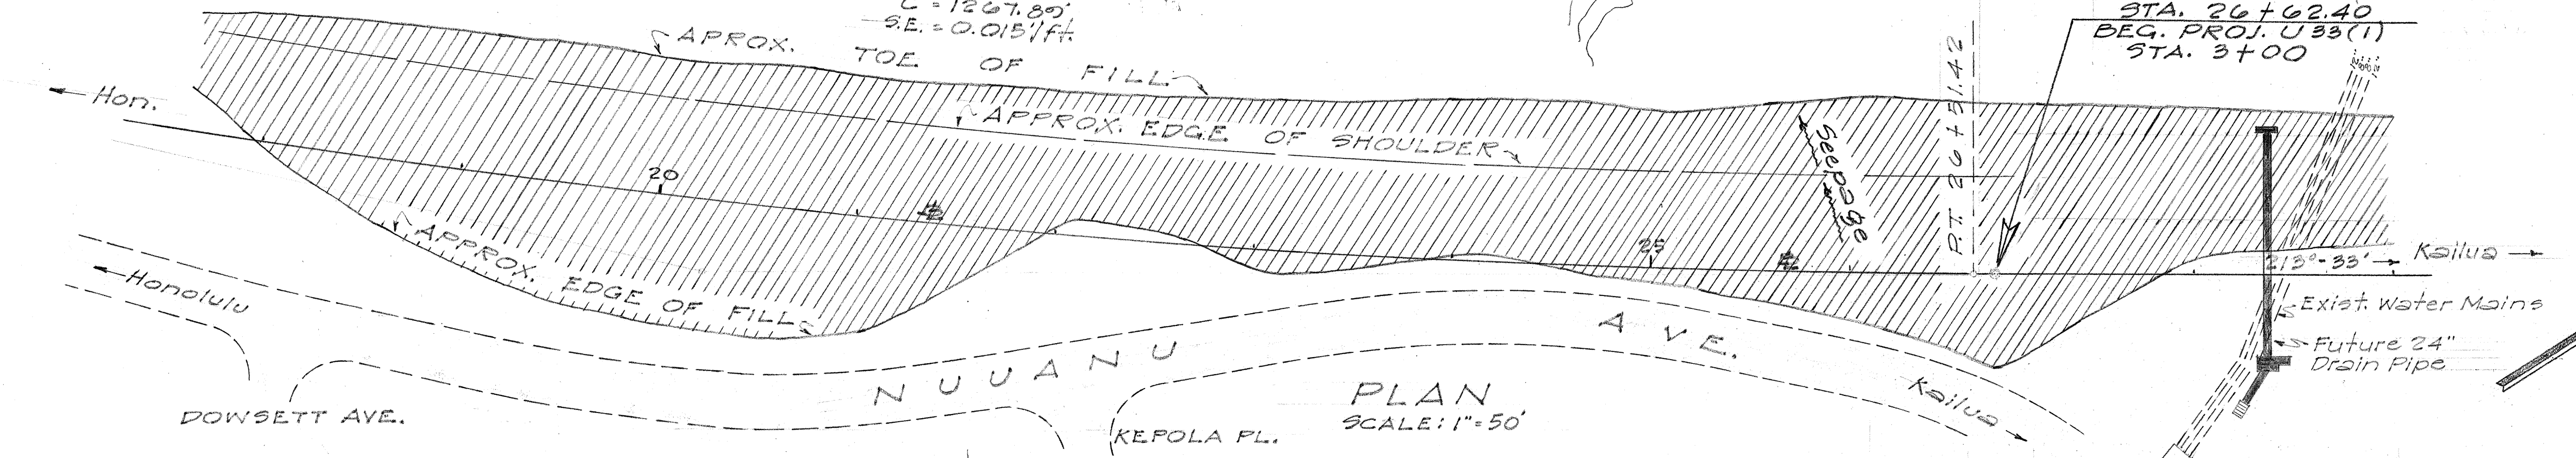


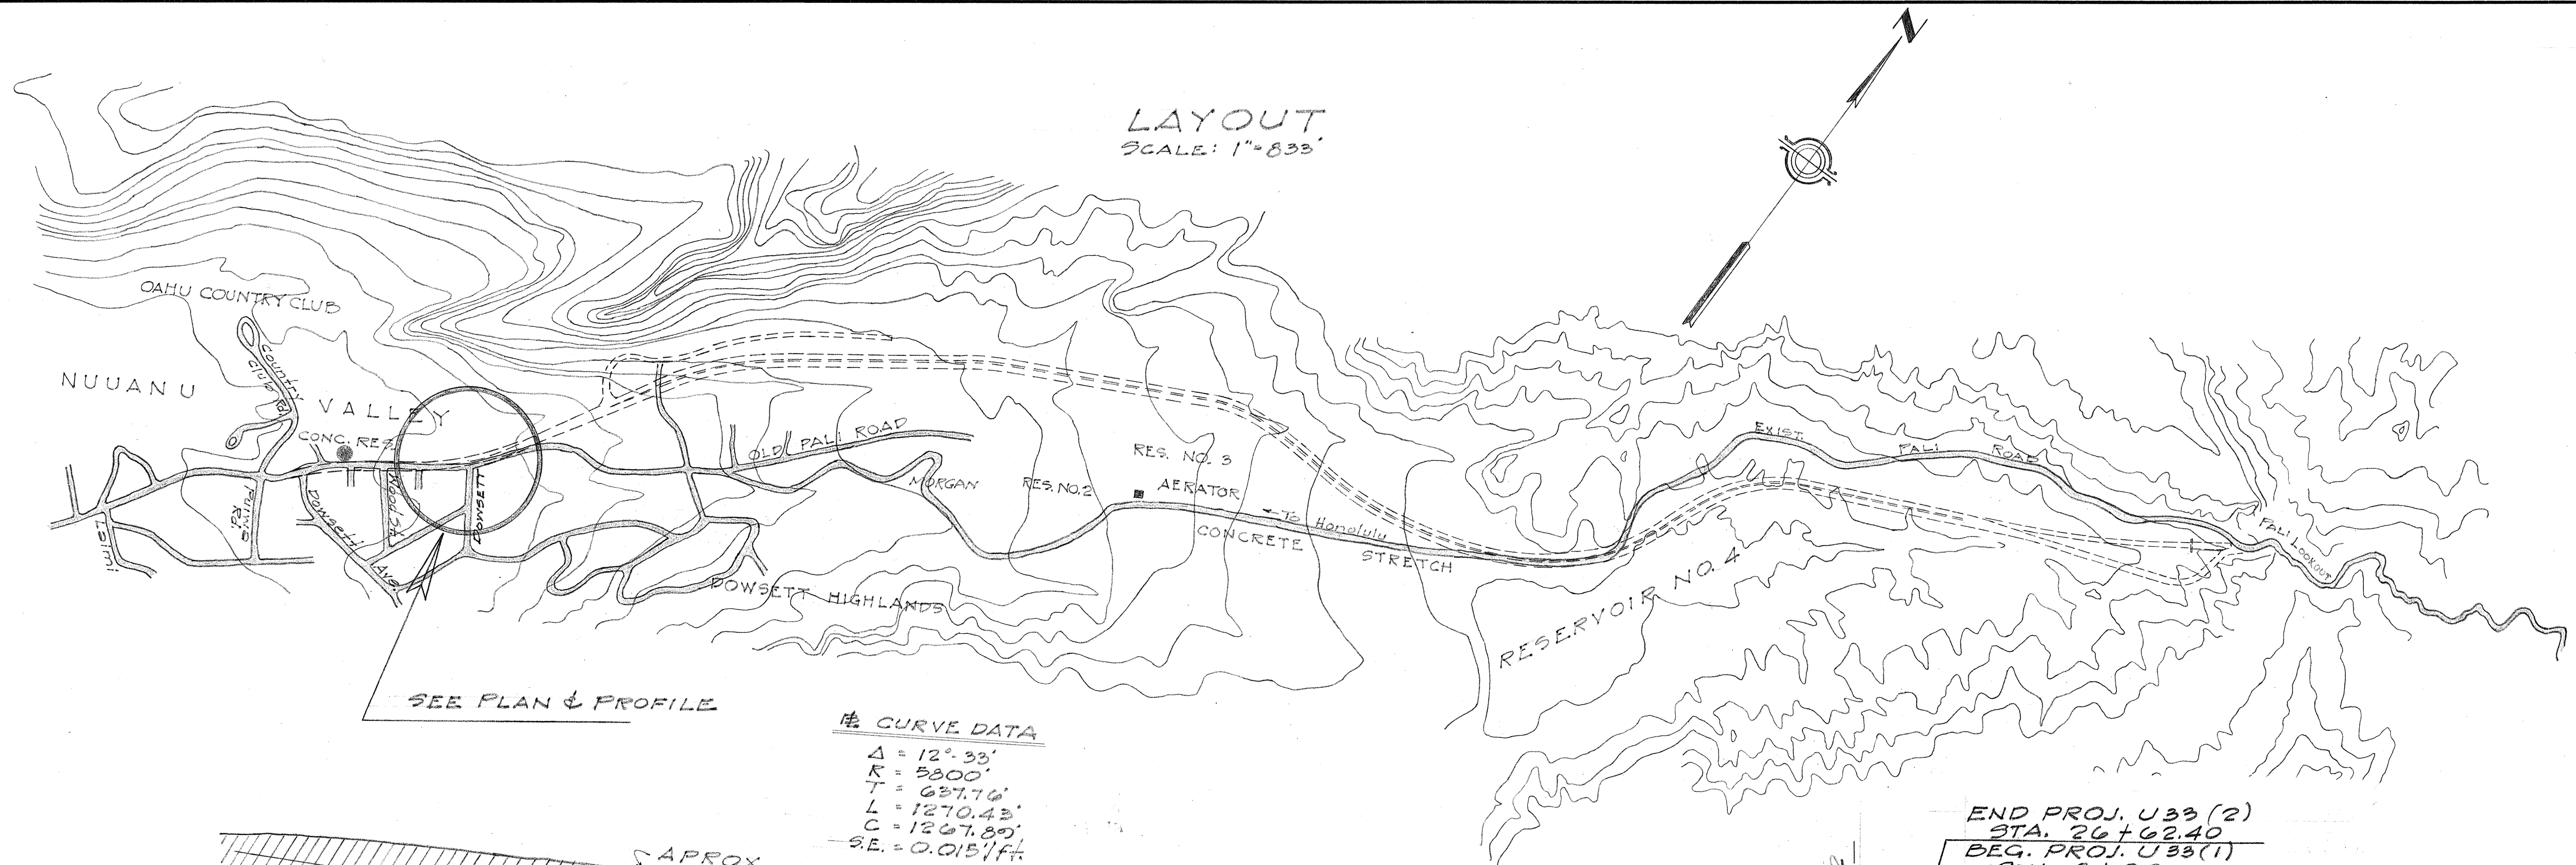

NOTE:  
Fill Waste Material between  
Sta. 17+50± and Sta. 25+00±.  
Approximate total Corrected  
Embankment Equals 30,000 c.y.  
See Special Provisions.

**TERRITORIAL HIGHWAY DEPARTMENT**  
TERRITORY OF HAWAII


LAYOUT, PLAN & PROFILE  
WASTE DISPOSAL AREA  
NO. 1  
PROJ. NO. 5216(4)  
SCALE: AS SHOWN NOV. 1953

SURVEY PLOTTED BY \_\_\_\_\_ DATE \_\_\_\_\_  
 DESIGNED BY \_\_\_\_\_  
 DRAWN BY \_\_\_\_\_  
 CHECKED BY \_\_\_\_\_  
 NOTE BOOK NO. \_\_\_\_\_  
 QUANTITIES CHECKED BY \_\_\_\_\_  
 CHECKED BY \_\_\_\_\_



DATE \_\_\_\_\_  
BY \_\_\_\_\_  
SURVEYED \_\_\_\_\_  
PLOTTER \_\_\_\_\_  
NOTE BOOK NO. \_\_\_\_\_  
AREAS CHECKED \_\_\_\_\_

DATE \_\_\_\_\_  
BY \_\_\_\_\_  
SURVEYED \_\_\_\_\_  
PLOTTER \_\_\_\_\_  
NOTE BOOK NO. \_\_\_\_\_  
AREAS CHECKED \_\_\_\_\_

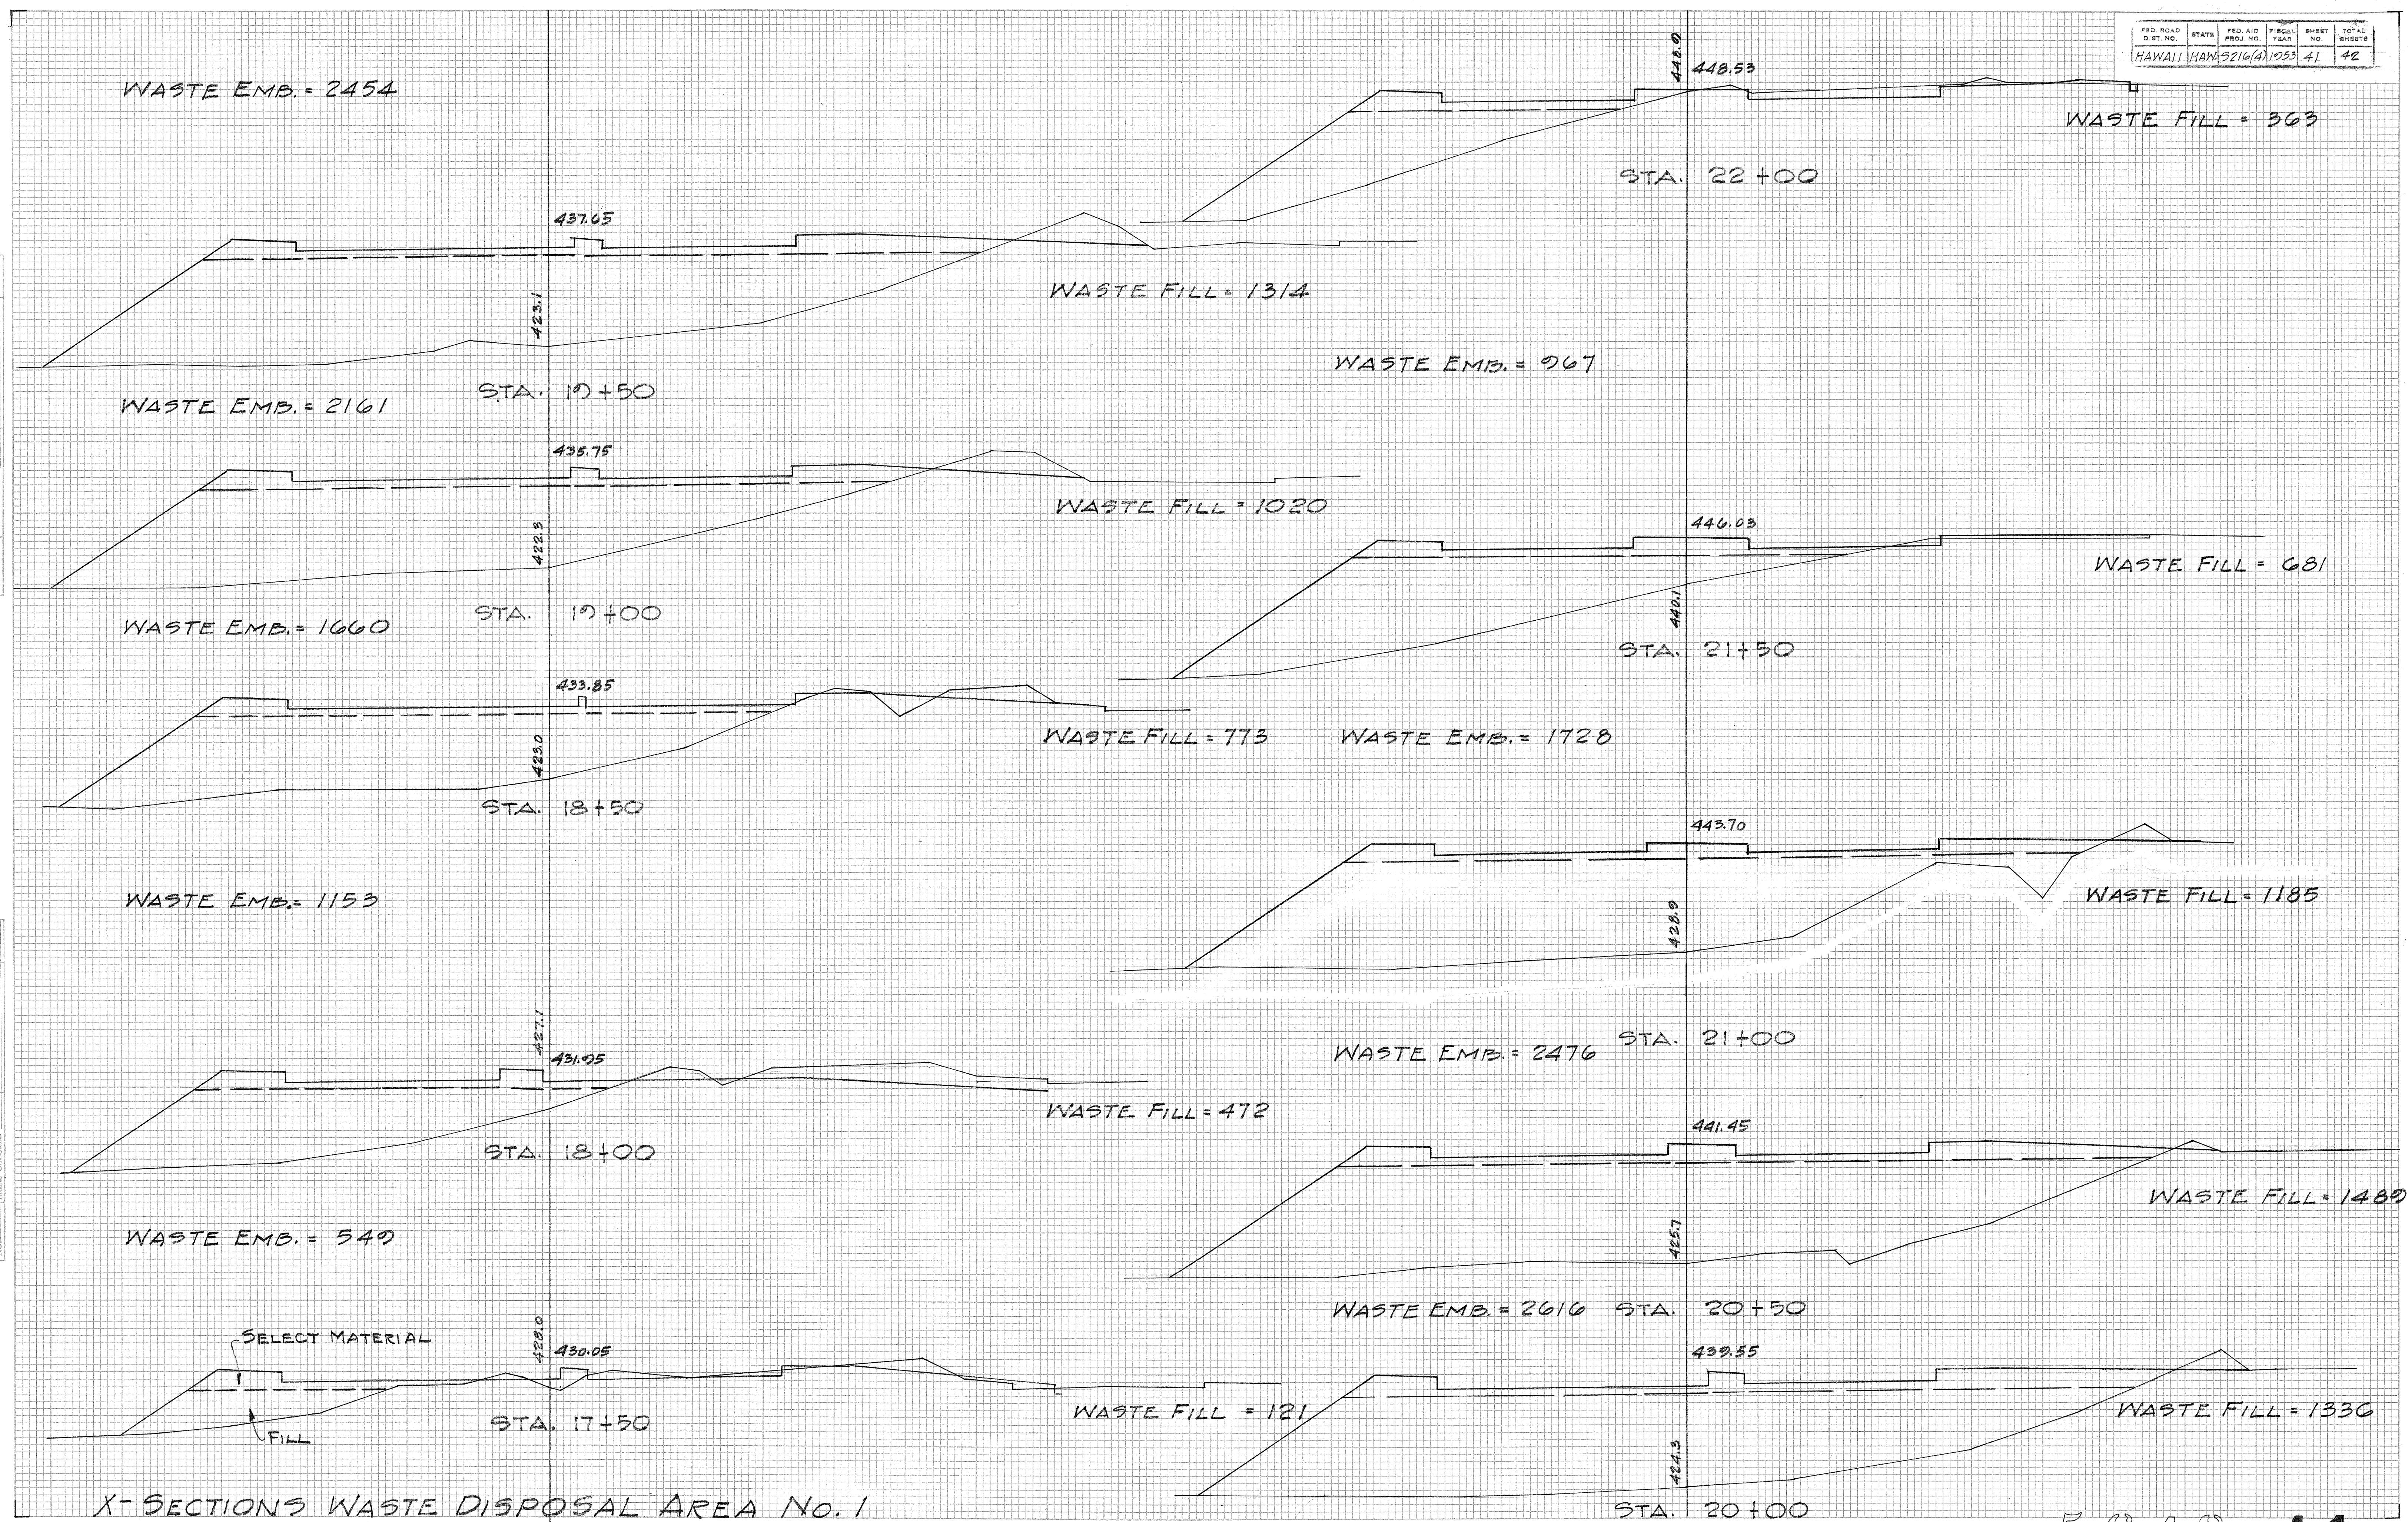

X-SECTIONS WASTE DISPOSAL AREA No. 1



|      |    |     |
|------|----|-----|
| DATE | BY | NO. |
|      |    |     |

|      |    |     |
|------|----|-----|
| DATE | BY | NO. |
|      |    |     |

