

| SPILLWAY SUMMARY                                                                                                                         |               |                |                     |
|------------------------------------------------------------------------------------------------------------------------------------------|---------------|----------------|---------------------|
| NOTE: Construct G.R.P Spillway at the following Stations from Type "E" or Type "F" Gutter. See Sheet No. 5648.14 for Detail of Spillway. |               |                |                     |
| STATION                                                                                                                                  | RIGHT OR LEFT | G.R.P. IN C.Y. | UNCL. EXC. IN C.Y.- |
| 106+10                                                                                                                                   | Left          | 5              | 7                   |
| 64+50                                                                                                                                    | Left          | 5              | 7                   |
| 65+00                                                                                                                                    | Right         | 5              | 7                   |
| 22+00                                                                                                                                    | Right         | 5              | 7                   |
| 22+50                                                                                                                                    | Left          | 5              | 7                   |
| 27+00                                                                                                                                    | Right         | 5              | 7                   |
| 60+60                                                                                                                                    | Left          | 5              | 7                   |
| 60+80                                                                                                                                    | Right         | 5              | 7                   |

*NOTE: Construct G.R.P Spillway at the following Stations from Type "E" or Type "F" Gutter. See Sheet No. 5648.14 for Detail of Spillway.*

| STATION | RIGHT OR<br>LEFT | G.R.P<br>IN C.Y. | UNCL. EXC.<br>IN C.Y. |
|---------|------------------|------------------|-----------------------|
| 106+10  | Left             | 5                | 7                     |
| 64+50   | Left             | 5                | 7                     |
| 65+00   | Right            | 5                | 7                     |
| 92+00   | Right            | 5                | 7                     |
| 92+50   | Left             | 5                | 7                     |
| 97+00   | Right            | 5                | 7                     |
| 60+60   | Left             | 5                | 7                     |
| 60+80   | Right            | 5                | 7                     |


S216(1)  
CURVE DATA  
& North Lane  
Baseline  
& South Lane

SE = 0.03/fh.


30.57 Install 36" S.S. R.C.C. Pipe,  
1000' S.S. Conc. Jacket.

C.H.W. = 16 L.F. 20 CF  
E.S. G.W. = 25 L.F. 27 CF  
36" S.S. R.C.C. Pipe = 30 L.F. 20 CF  
25" S.S. Conc. = 40 L.F. 20 CF  
Class B-1 Conc. = 40 L.F. 20 CF  
Struct. Steel = 40 L.F. 20 CF  
Struc. Exc. = 40 L.F. 20 CF  
G.R.P. = 40 L.F. 20 CF  
Uncl. Exc.

1. The locations and lengths of culverts here shown on these plans are approximate only. The Resident Engineer shall determine the exact locations, invert elevations and grades for each culvert and adjust the quantities for the various items accordingly.
2. All Curbs and Gutters are to be Cast-in-Place using Class "A-1" Concrete.
3. All Curbs shall be Type "A" unless otherwise shown.
4. Transitions between various types of Curbs and Gutters shall be smooth and pleasing to the eye.
5. All E and C & C Standard Street Monuments shall be installed according to the Right-of-Way Maps.
6. All leveling and wearing surfaces shall be of Asphaltic Concrete. See Typical Sections, Sheet 5618.2
7. All Asymutts are referred to Kailua Triangulation Station.
8. Datum - Elevation referred to Mean Sea Level.

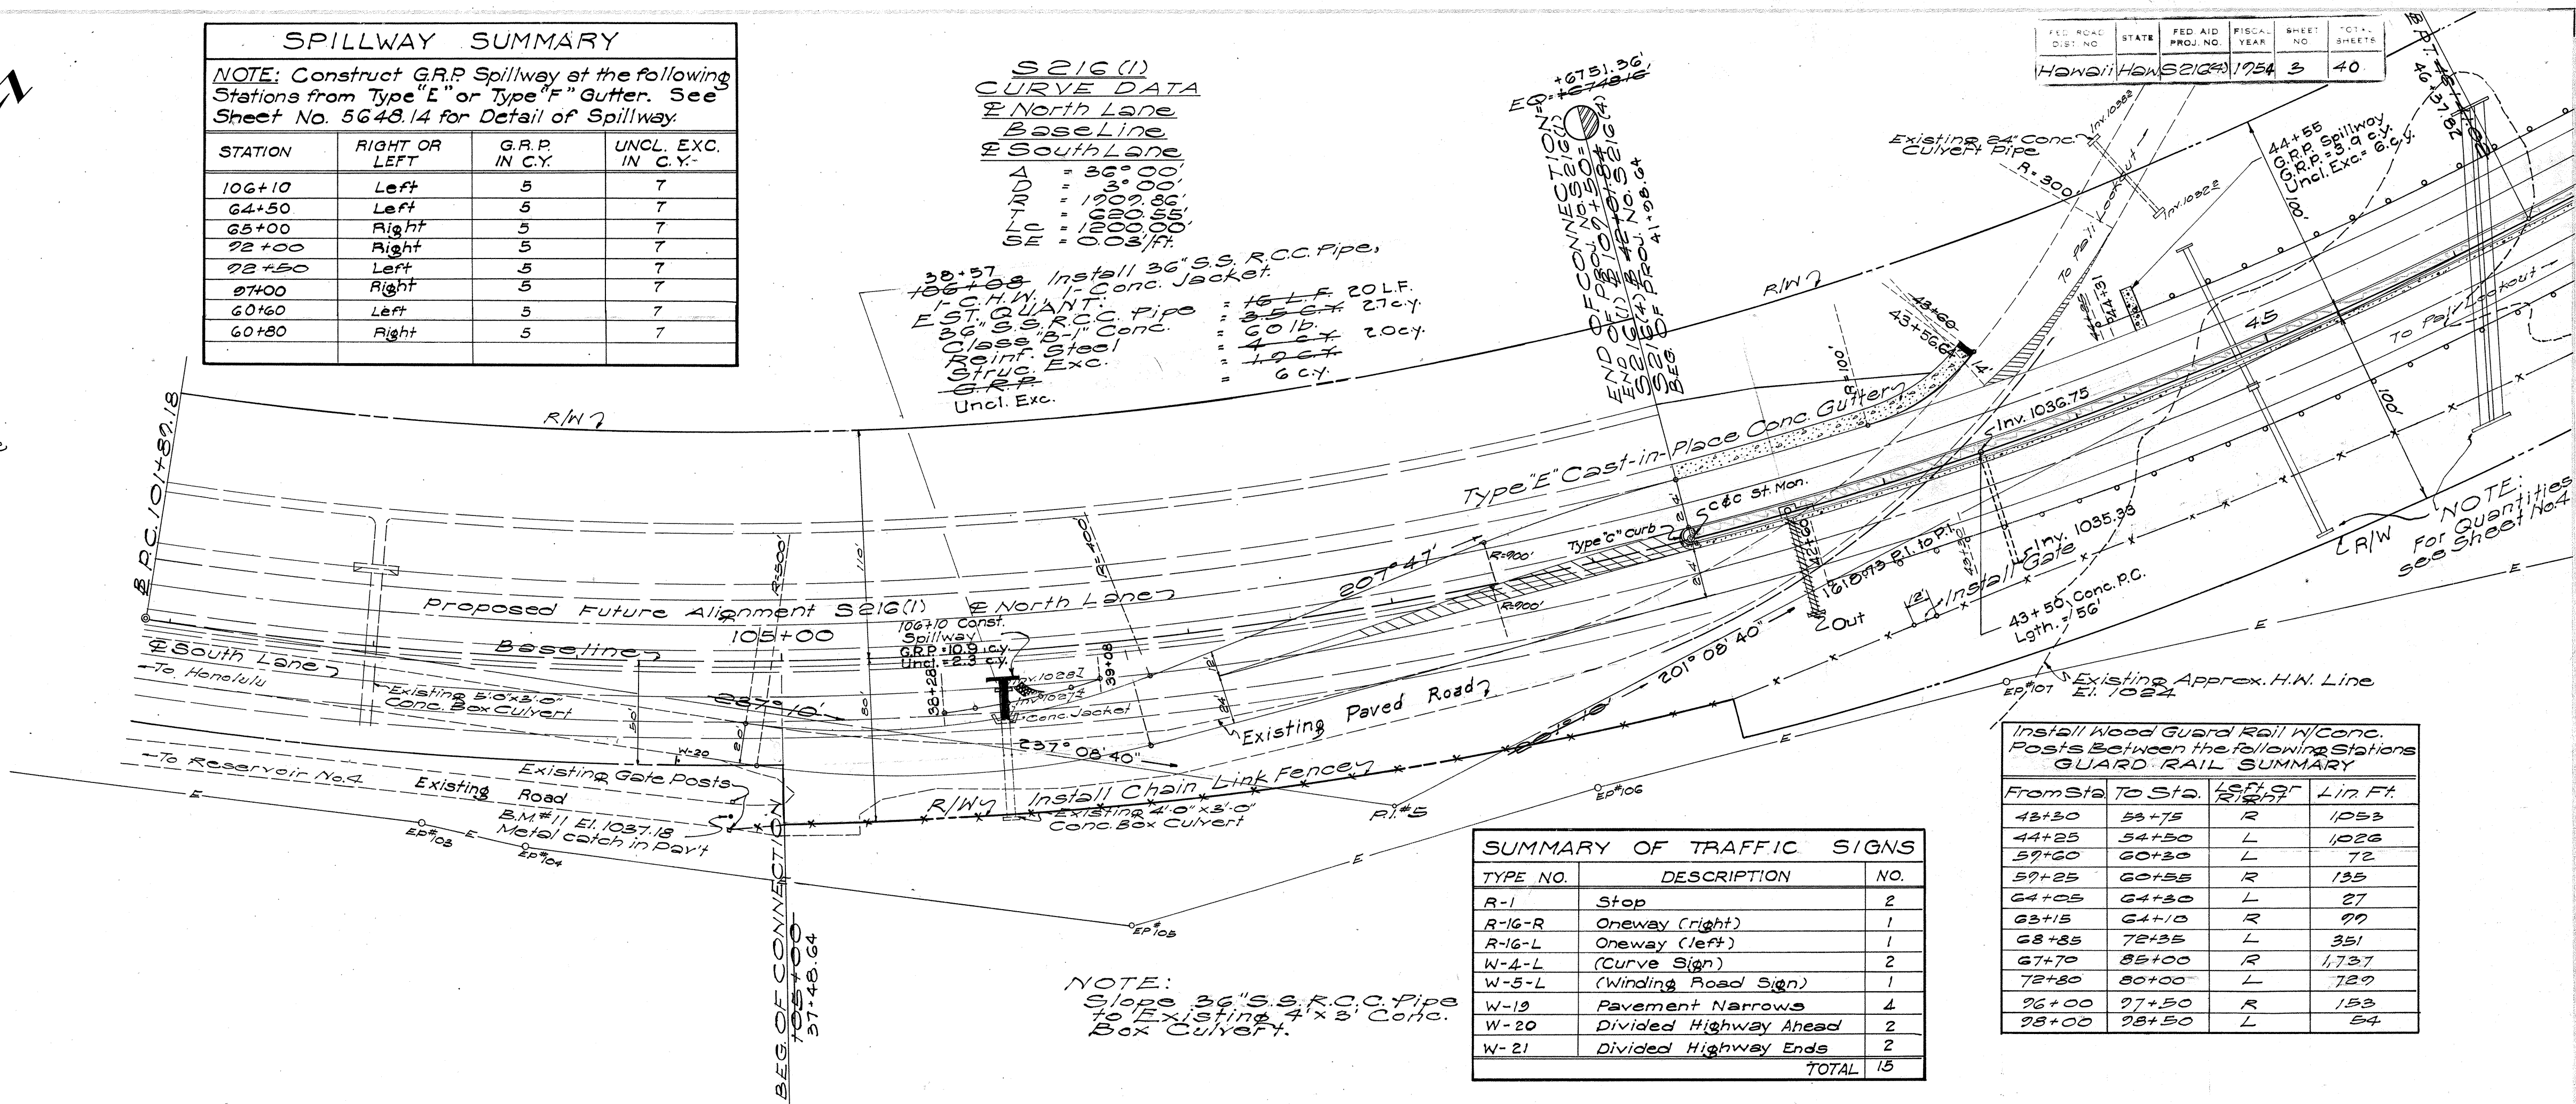

| OVERHAUL SUMMARY |         |                   |             |               |            |
|------------------|---------|-------------------|-------------|---------------|------------|
| From Sta.        | To Sta. | Overhaul Distance | Cubic Yards | Station Yards | Mile Yards |
| 98+55            | 90+10   | 0.7 Mi            | 61,646      |               | 44,392     |
| 96+65            | 59+45   | 0.5 Mi            | 3,392       |               | 1,747      |
| 94+60            | 75+20   | 940 ft.           | 116,357     | 1,093,756     |            |
| TOTAL            |         |                   | 181,395     | 1,093,756     | 46,639     |
| FREE HAUL        |         |                   | 50,415      |               |            |
| WASTE            |         |                   | 1,442       |               |            |
| TOTAL EXC.       |         |                   | 233,252     |               |            |

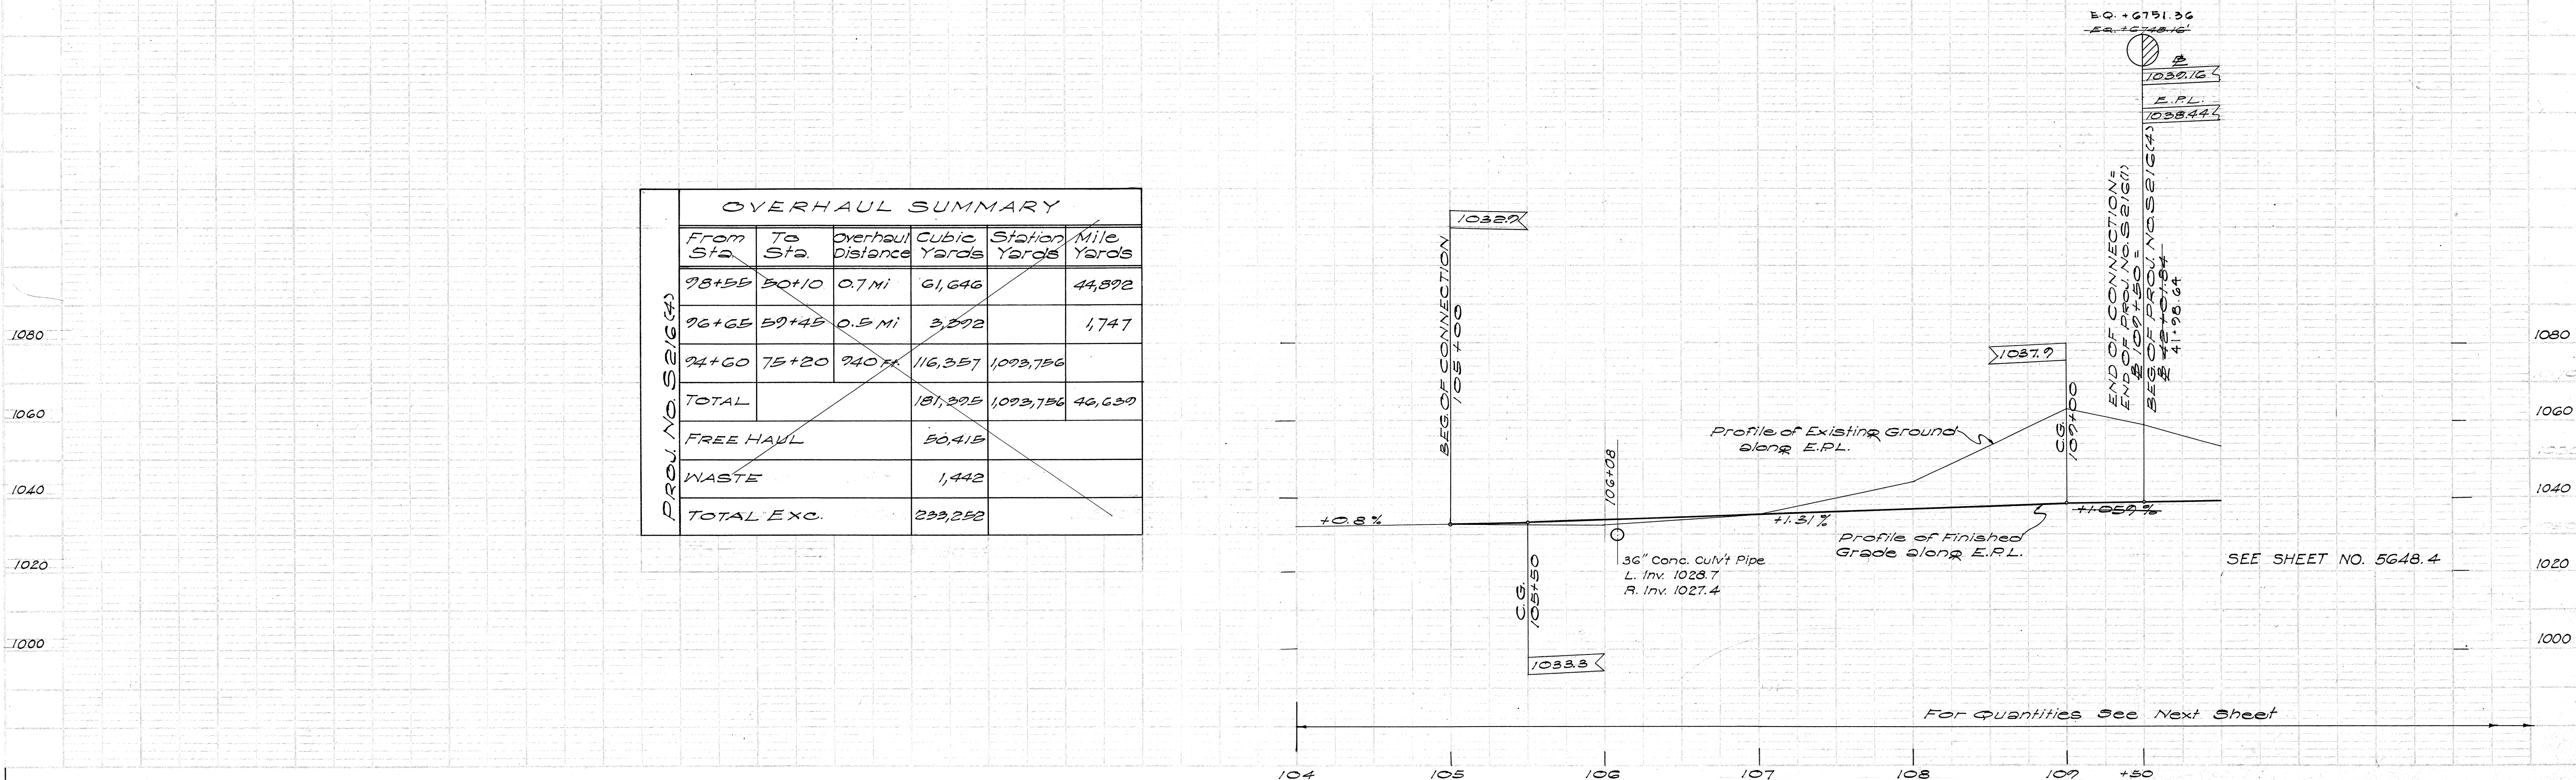









PLAN  
DATE: 10/1/54  
DRAWN BY: J. H. HARRIS  
CHECKED BY: J. H. HARRIS  
NOTE: BOOK 15, PAGE 100  
REVISIONS: 1. 10/1/54  
2. 10/1/54

PLAN  
DATE: 10/1/54  
DRAWN BY: J. H. HARRIS  
CHECKED BY: J. H. HARRIS  
NOTE: BOOK 15, PAGE 100  
REVISIONS: 1. 10/1/54  
2. 10/1/54

| FED. ROAD DIST. NO. | STATE  | FED. AID PROJ. NO. | FISCAL YEAR | SHEET NO. | TOTAL SHEETS |
|---------------------|--------|--------------------|-------------|-----------|--------------|
| Hawaii Hwy.         | HAWAII | 30164              | 1954        | 5         | 40           |

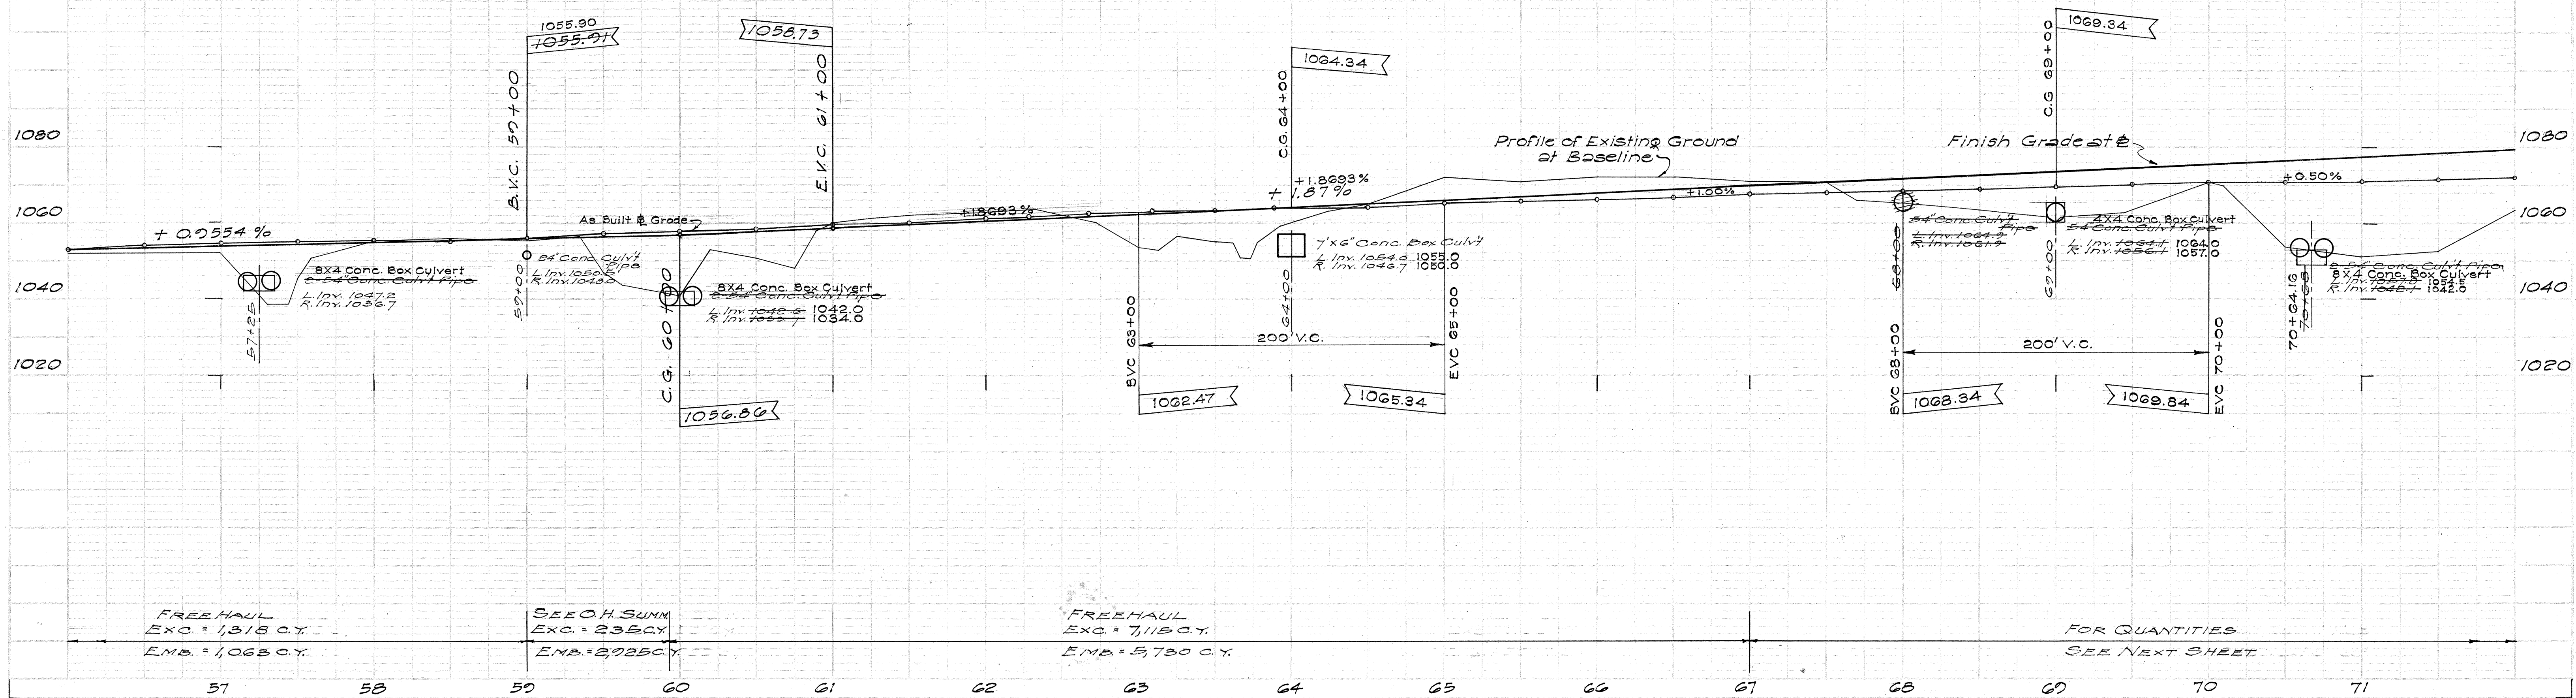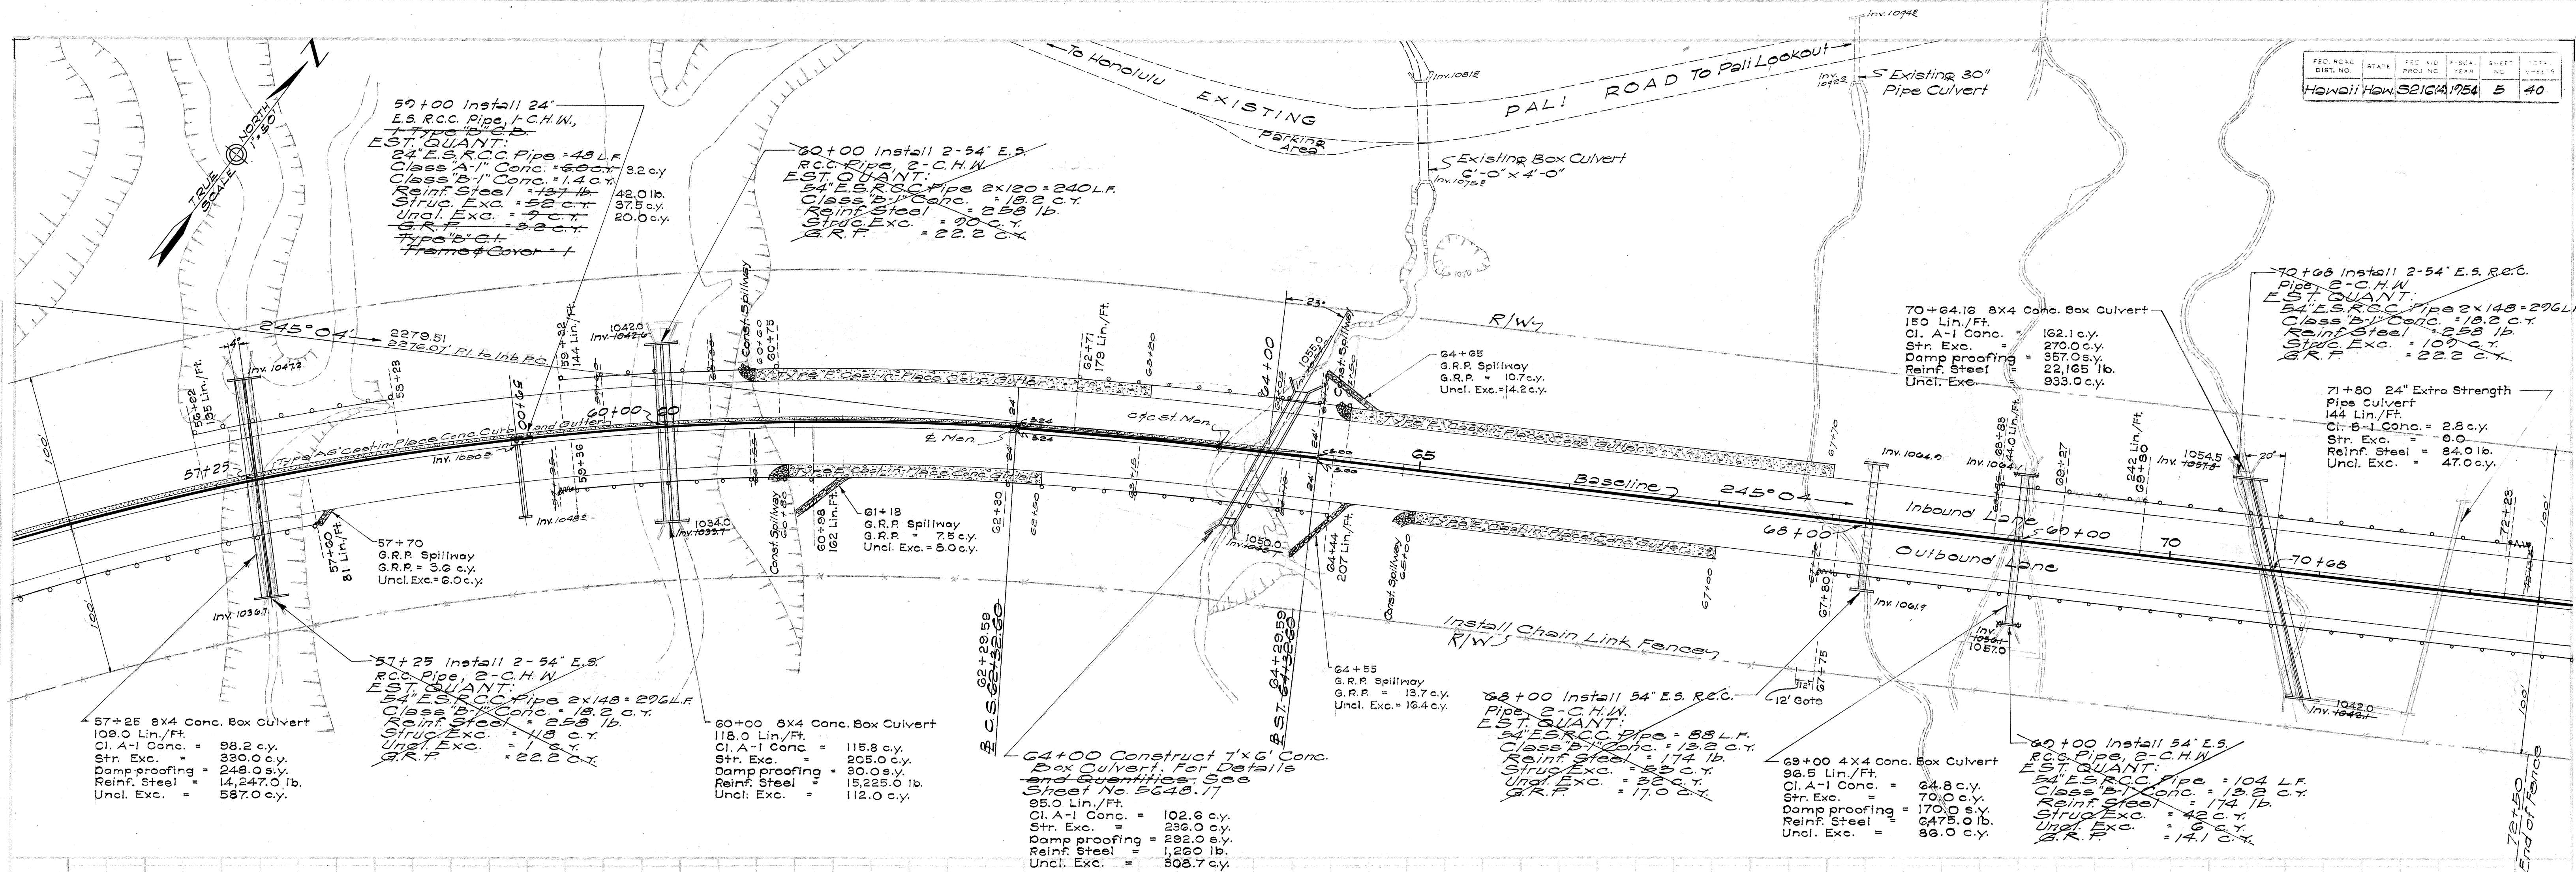



NOTE:  
Electric poles Nos. 120 to 126  
inclusive to be moved by Owners  
after area is cleared by Contractor.

| FED. ROAD DIST. NO. | STATE | FED. AID PROJ. NO. | FISCAL YEAR | SHEET NO. | OF SHEETS |
|---------------------|-------|--------------------|-------------|-----------|-----------|
| HAWAII              | HI    | 2016               | 1954        | 6         | 40        |

R.I. 7A#7C  
CURVE DATA  
 $\Delta = 10^{\circ}27'$   
 $D = 0^{\circ}40'$   
 $R = 8,574.37'$   
 $T = 785.23'$   
 $C = 1,565.33'$   
 $L = 1,567.50'$   
 $S.E. = 0.015'/ft$

R.I. B  
CURVE DATA  
 $\Delta = 10^{\circ}13'$   
 $D = 0^{\circ}40'$   
 $R = 1,000'$   
 $T = 142.47'$   
 $C = 282.00'$   
 $L = 283.03'$

R.I. A  
CURVE DATA  
 $\Delta = 63^{\circ}22'$   
 $D = 51^{\circ}41'$   
 $R = 150'$   
 $T = 72.58'$   
 $C = 187.57'$   
 $L = 165.89'$

(Conn.) 81+00 Construct 12"x8"  
Conc. Box Culvert for Details  
and Quantities. See  
Sheet No. 5648.19  
Cl. A-1 Conc. = 332.0 c.y.  
Reinf. Steel = 36,510 lb.  
Struc. Exc. = 820.0 c.y.  
Uncl. Exc. = 42.7 c.y.  
Damp proofing = 530.0 sq. y.

77+50 Install 2-54" E.S. R.C.C.  
Pipe, 2- C.H.N.  
EST. QUANT.  
54" E.S. R.C.C. Pipe 2x136' = 272 LF.  
Class B-1 Conc. = 18.2 c.y.  
Reinf. Steel = 2,538 lb.  
Struc. Exc. = 56 c.y.  
Uncl. Exc. = 28 c.y.  
G.R.P. = 42.9 c.y.

77+39.19 8x4 Conc. Box Culvert  
147.0 Lin./Ft. 2 Hdw.  
Cl. A-1 Conc. = 149.8 c.y.  
Str. Exc. = 137.0 c.y.  
Damp proofing = 352.0 sq. y.  
Reinf. Steel = 21,109 lb.  
Uncl. Exc. = 40.0 c.y.

74+80 Construct 7'x6' Conc.  
Box Culvert for Details  
and Quantities. See  
Sheet No. 5648.18

74+75 7'x6' Conc. Box Culvert L/R/W  
138.0 Lin./Ft.  
Cl. A-1 Conc. = 143.7 c.y.  
Str. Exc. = 428.0 c.y.  
Damp proofing = 403.0 sq. y.  
Reinf. Steel = 18,278 lb.  
Uncl. Exc. = 598.0 c.y.



R.I. 7E  
CURVE DATA  
 $\Delta = 5^{\circ}30'$   
 $R = 2000'$   
 $T = 96.07'$   
 $C = 191.91'$   
 $L = 191.90'$   
 $S.E. = 0.05'/ft$

R.I. "A-1"  
CURVE DATA  
 $\Delta = 33^{\circ}30'$   
 $R = 500.00'$   
 $T = 150.48'$   
 $C = 288.20'$   
 $L = 292.34'$

85+00 Install 12"x8" E.S.  
R.C.C. Pipe, 1- C.H.N., 1- C.D.I.  
EST. QUANT.  
12"x8" E.S. R.C.C. Pipe = 64 LF  
Class B-1 Conc. = 2.9 c.y.  
Reinf. Steel = 3,548 lb.  
Struc. Exc. = 22 c.y.  
Uncl. Exc. = 10 c.y.  
G.R.P. = 1.9 c.y.

CHANNEL NO. 2  
See Sheet No. 5648.21

CHANNEL NO. 1  
See Sheet No. 5648.21

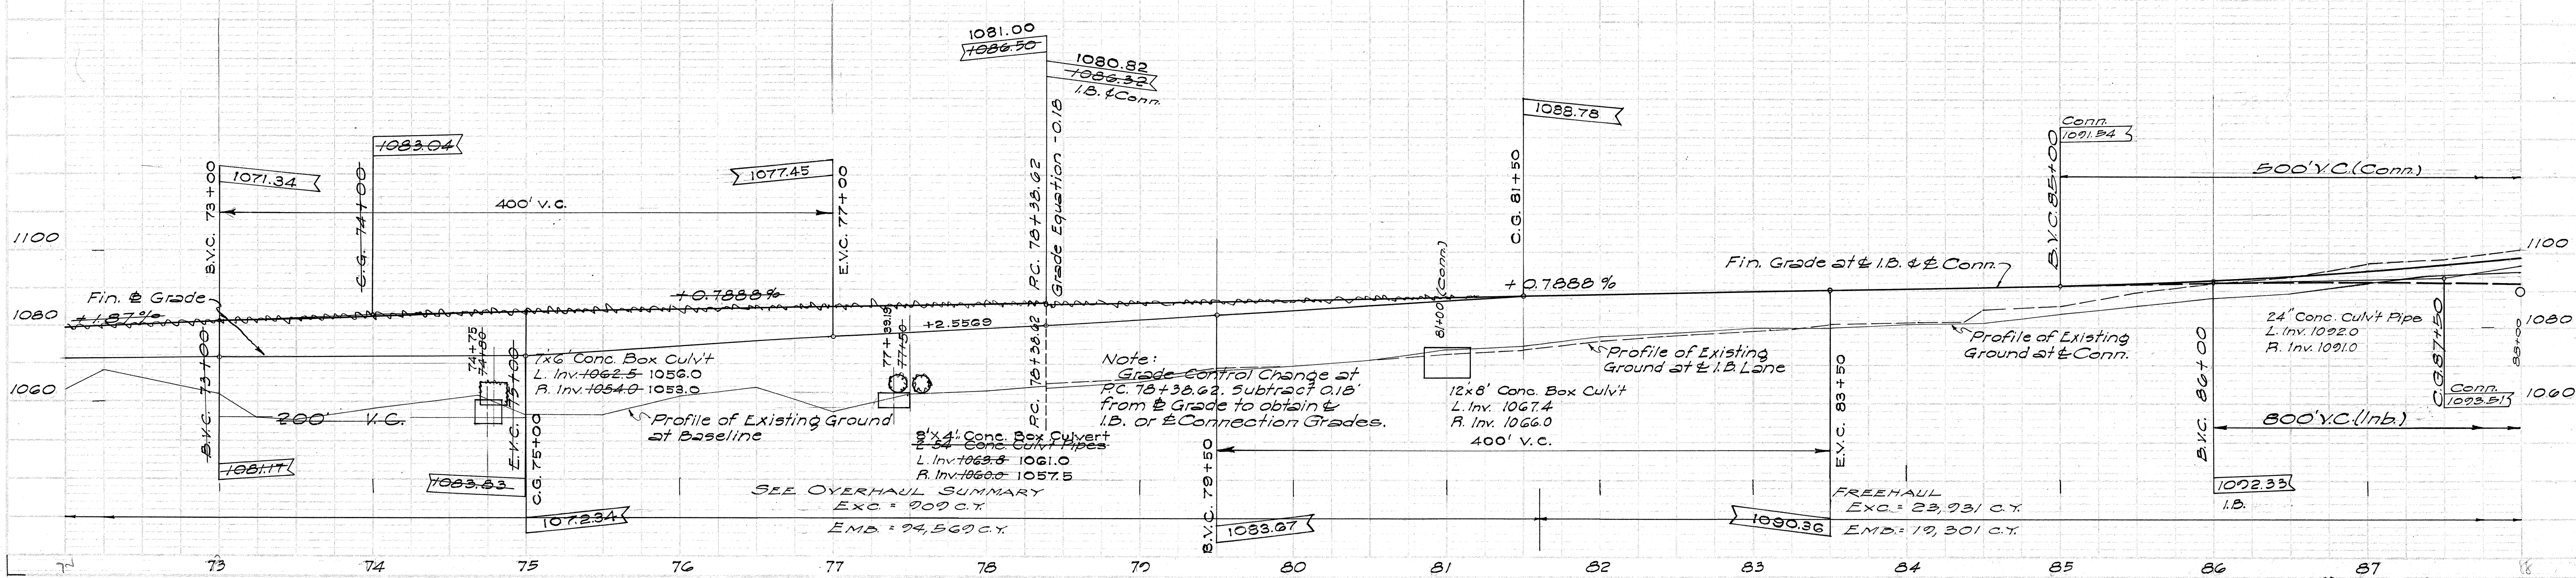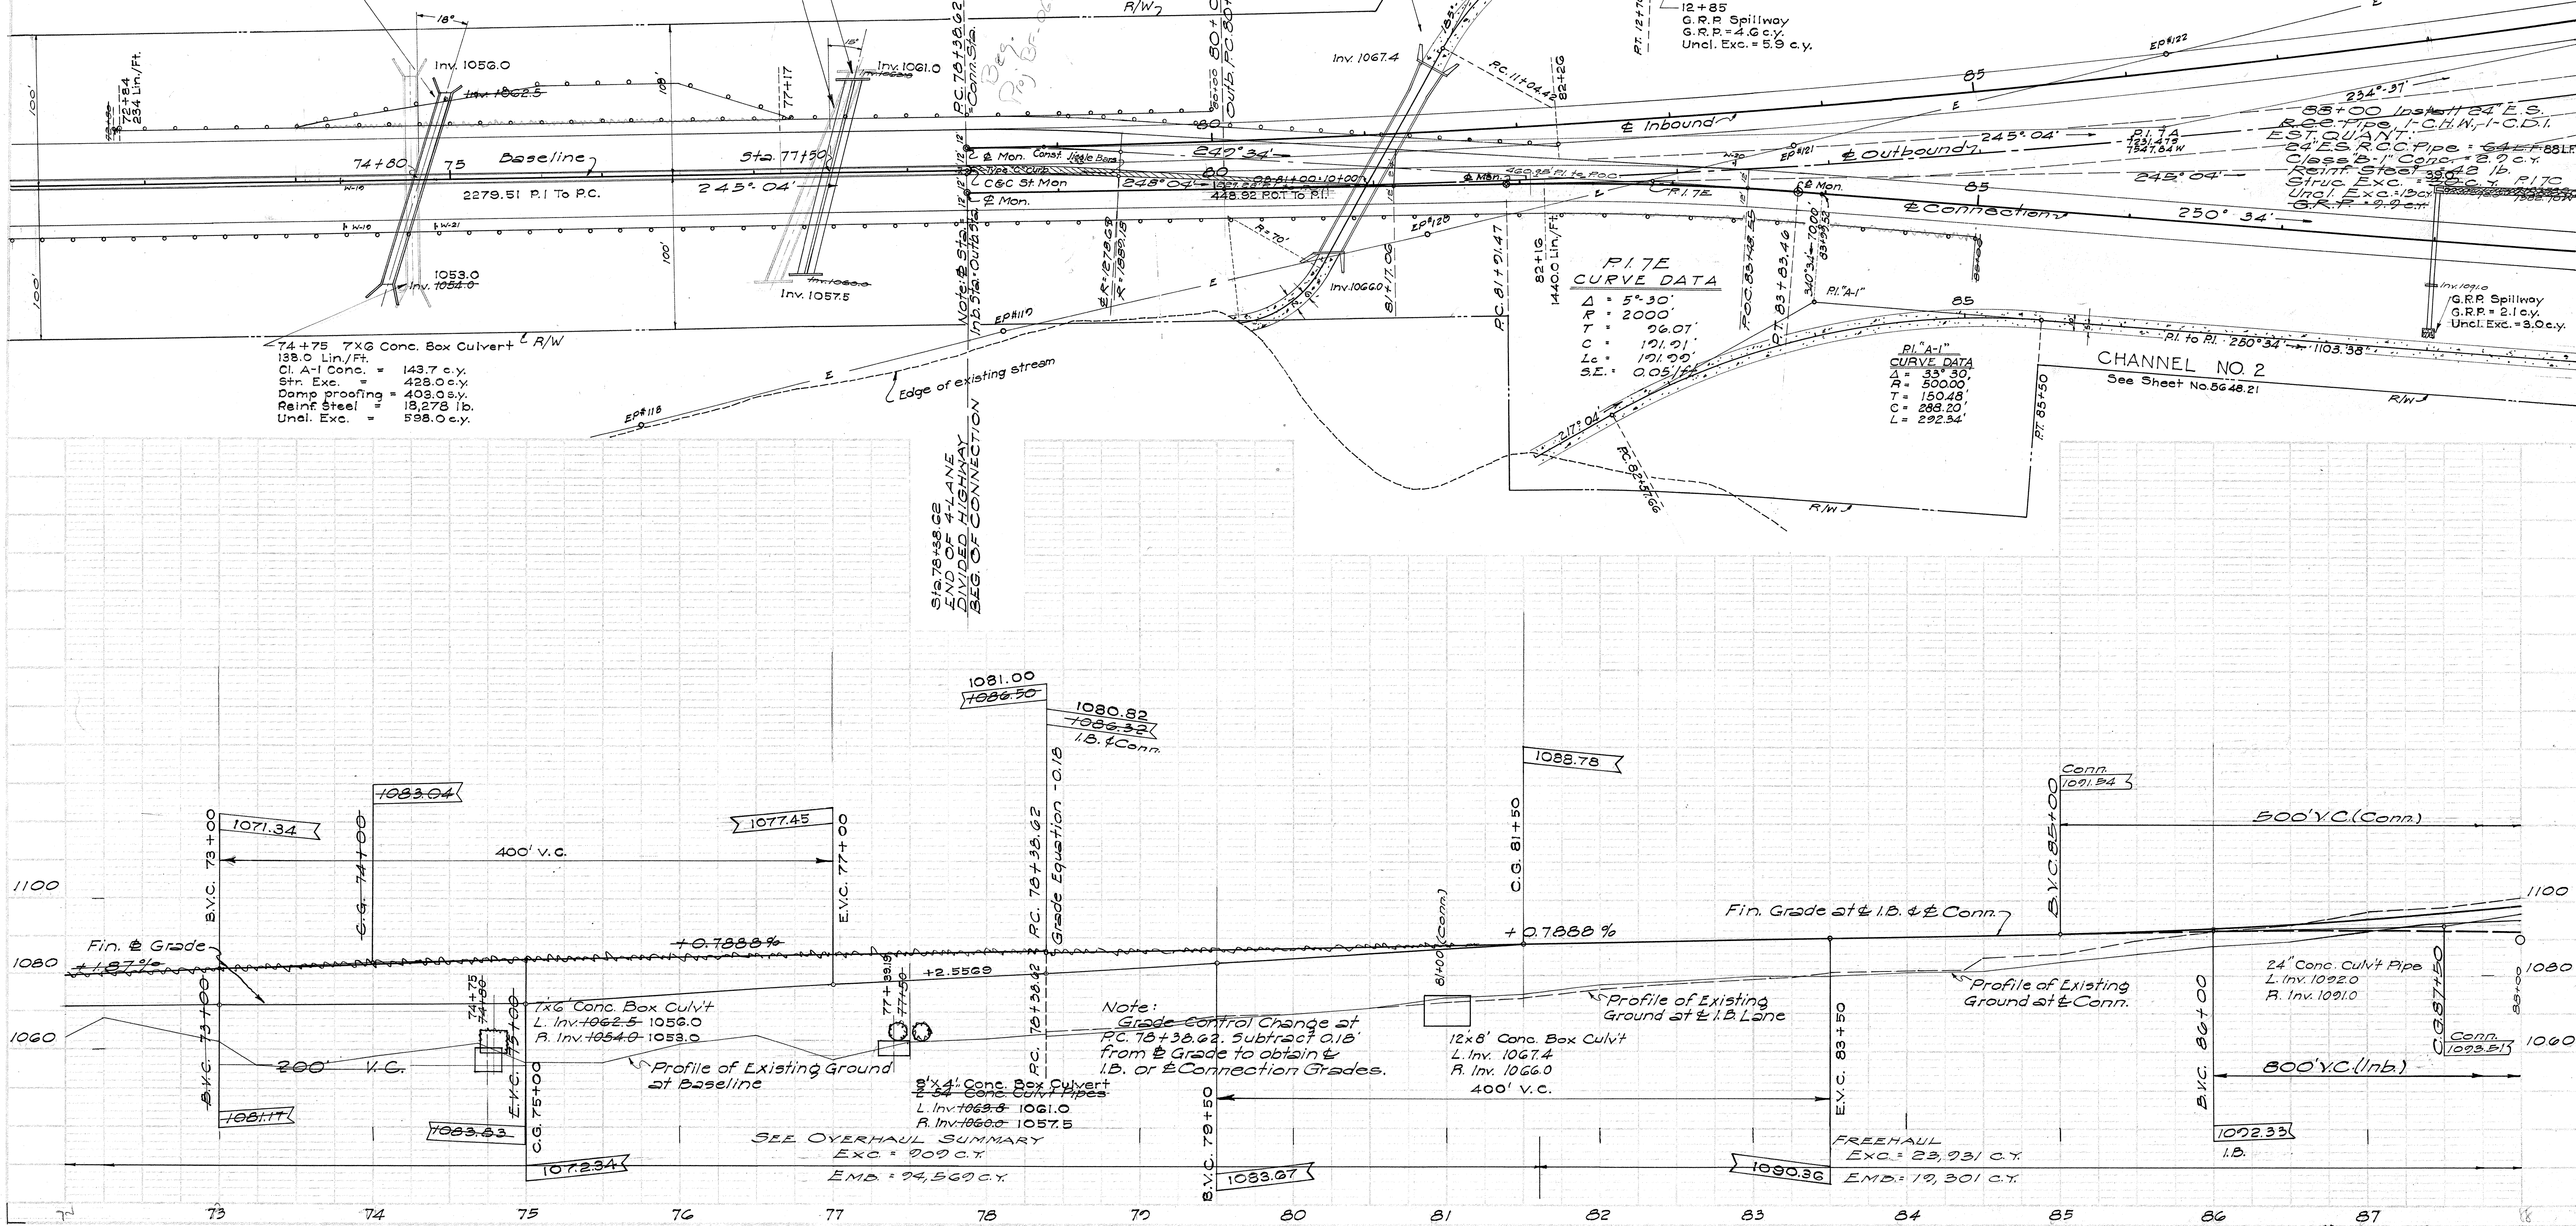

Note:  
Grade Control Change at  
PC. 78+38.62. Subtract 0.18'  
from E Grade to obtain E  
I.B. or E Connection Grades.

SEE OVERHAUL SUMMARY  
Exc. = 909 c.y.  
EMB. = 24,567 c.y.







| PROFILE                    | BY | DATE |
|----------------------------|----|------|
| SURVEYED                   |    |      |
| PLOTTED                    |    |      |
| NOTE BOOK                  |    |      |
| GRADES CHECKED             |    |      |
| B. M.'S. NOTED             |    |      |
| STRUCTURE NOTATIONS CH'KD. |    |      |

