
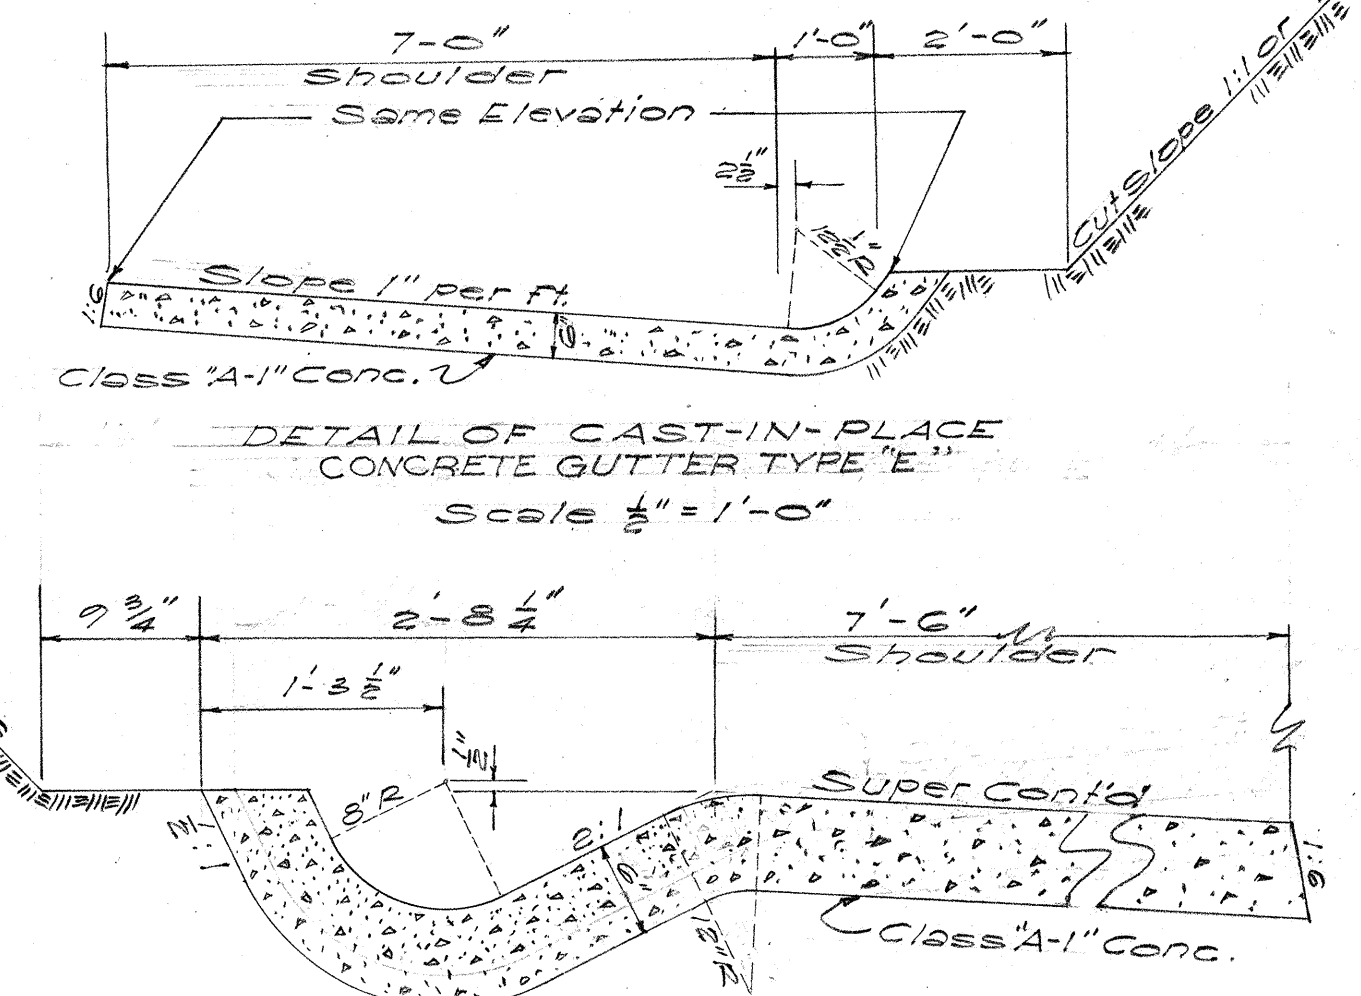


Note:
For details of Conc. Curb and
Conc. Gutter, See
Standard Details Sheet No. 5648.9

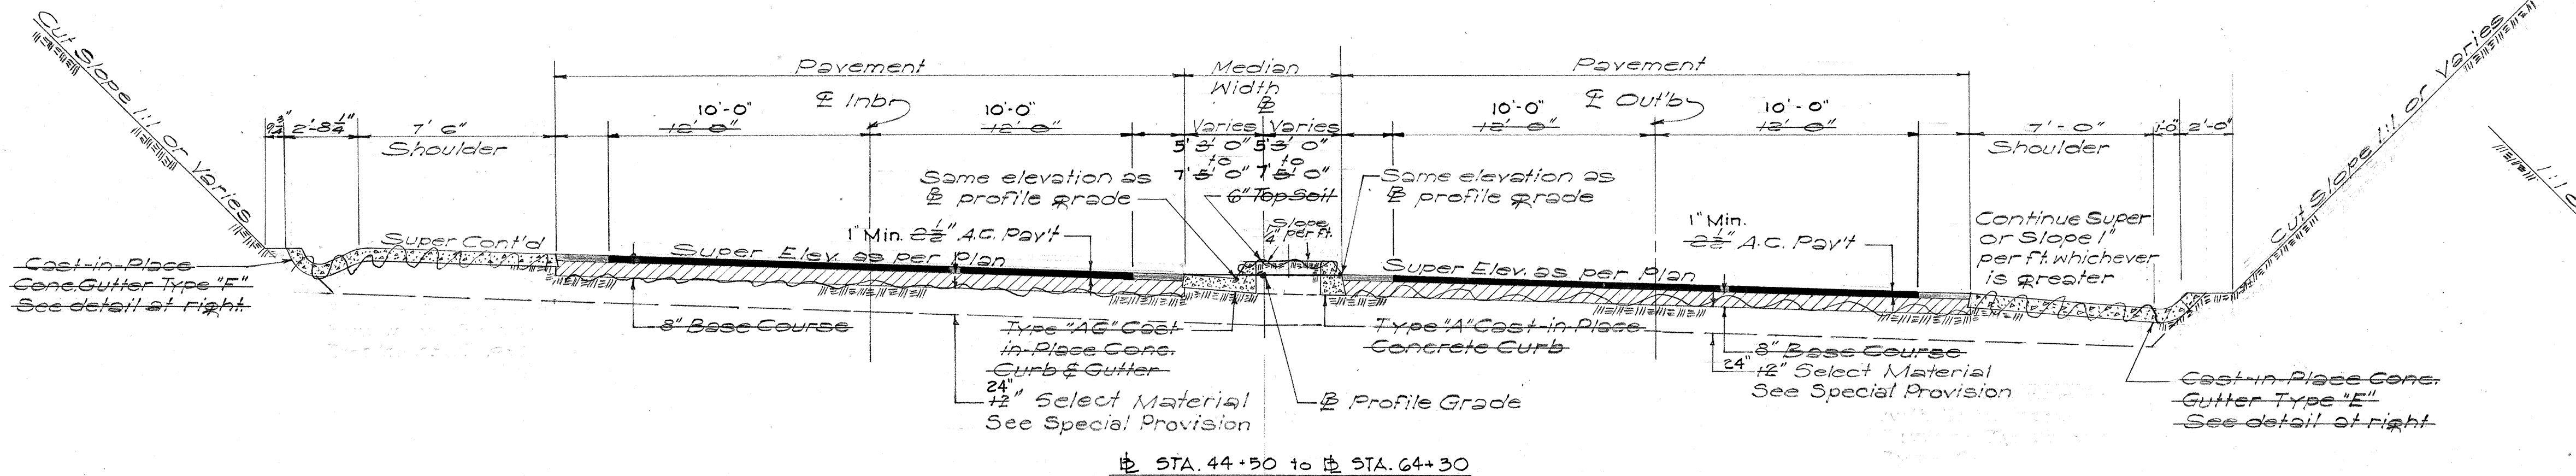

DETAIL OF CAST-IN-PLACE CONCRETE GUTTER TYPE "F"
Scale 1/2" = 1'-0"


GENERAL NOTES ON PAVEMENT AND BASE COURSE

- (1) Pavement shall be Asphalt Concrete of 2 1/2" compacted thickness laid in two layers consisting of a 1 1/2" compacted thickness Asphalt Concrete Leveling Course, Mix III for the bottom layer and a 1" compacted thickness Asphalt Concrete Surface Course, Mix I for the top layer.
- (2) Base Course shall be Waterbound Macadam Base Course of 8" compacted thickness laid in two layers of 4" compacted thickness.

The above courses shall consist of mineral aggregate (Coarse Rock No. 2) and Filler (No. 100).

Both above courses are subject to the Specifications and Special Provisions.

TYPICAL SECTION ON CURVE
B STA. 41+22 to STA. 44+50
Scale 1/4" = 1'-0"

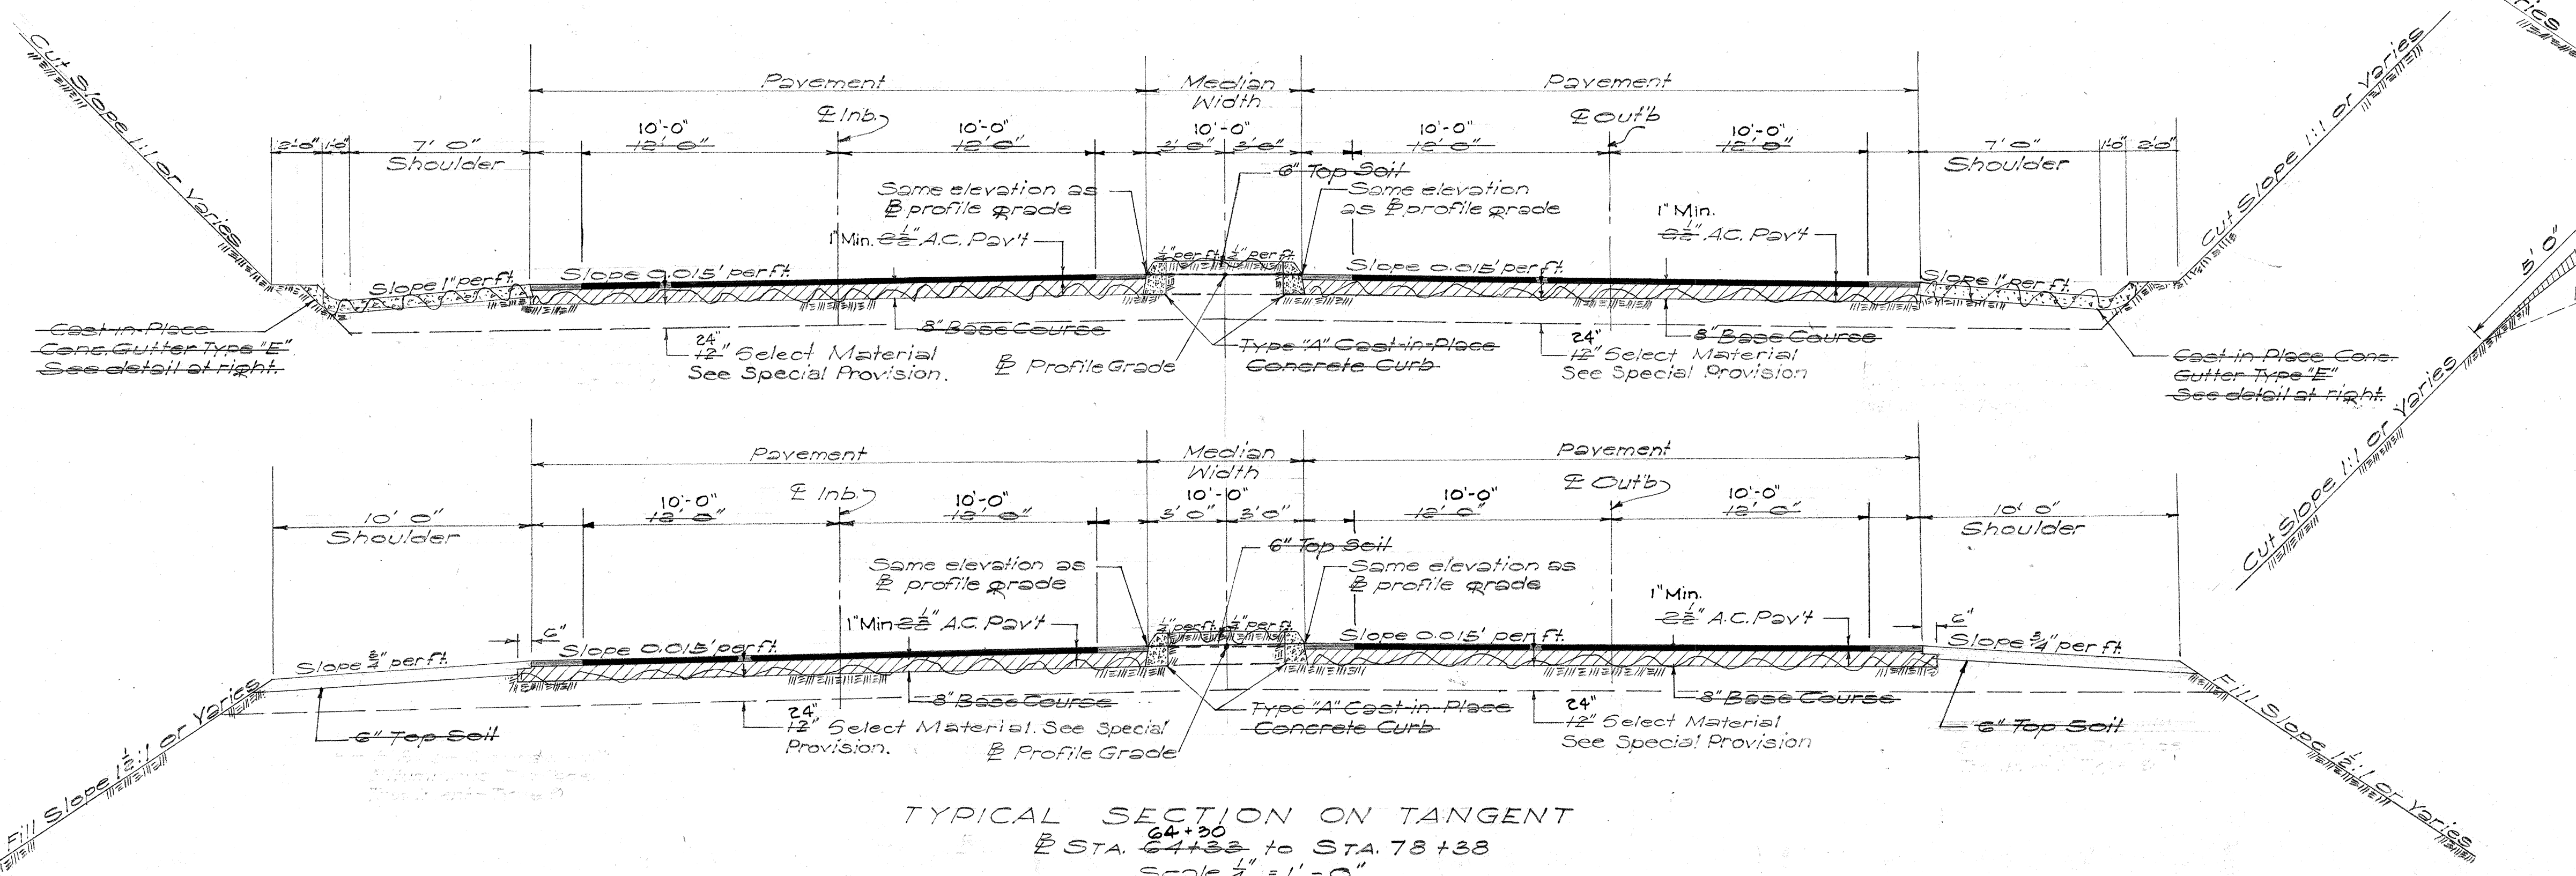

TYPICAL SECTION ON TANGENT
B STA. 64+30 to STA. 78+38
Scale 1/4" = 1'-0"

NOTE:
Tops of cut slopes are to be rounded as shown at the places indicated by the Engineer. He will require that this be done in all sand earth and conglomerate material but not solid rock or in conglomerate that he believes will remain in a cemented state. Hand trimming rounded top of cuts will be paid for on the linear foot basis as per specifications. Material excavated in the shaded area will be paid under the items of Unclassified Excavation and Overhaul.


TERRITORIAL HIGHWAY DEPARTMENT
TERRITORY OF HAWAII

TYPICAL SECTIONS
PALI ROAD
PROJECT No. S216(4)
Scales As Noted July 1953

SHEET No. 1 OF 2 SHEETS


5648.9

DESIGNED BY	DATE
DRAWN BY	
TRACED BY	
QUANTITIES CHECKED BY	
NOTE BOOK	
No.	

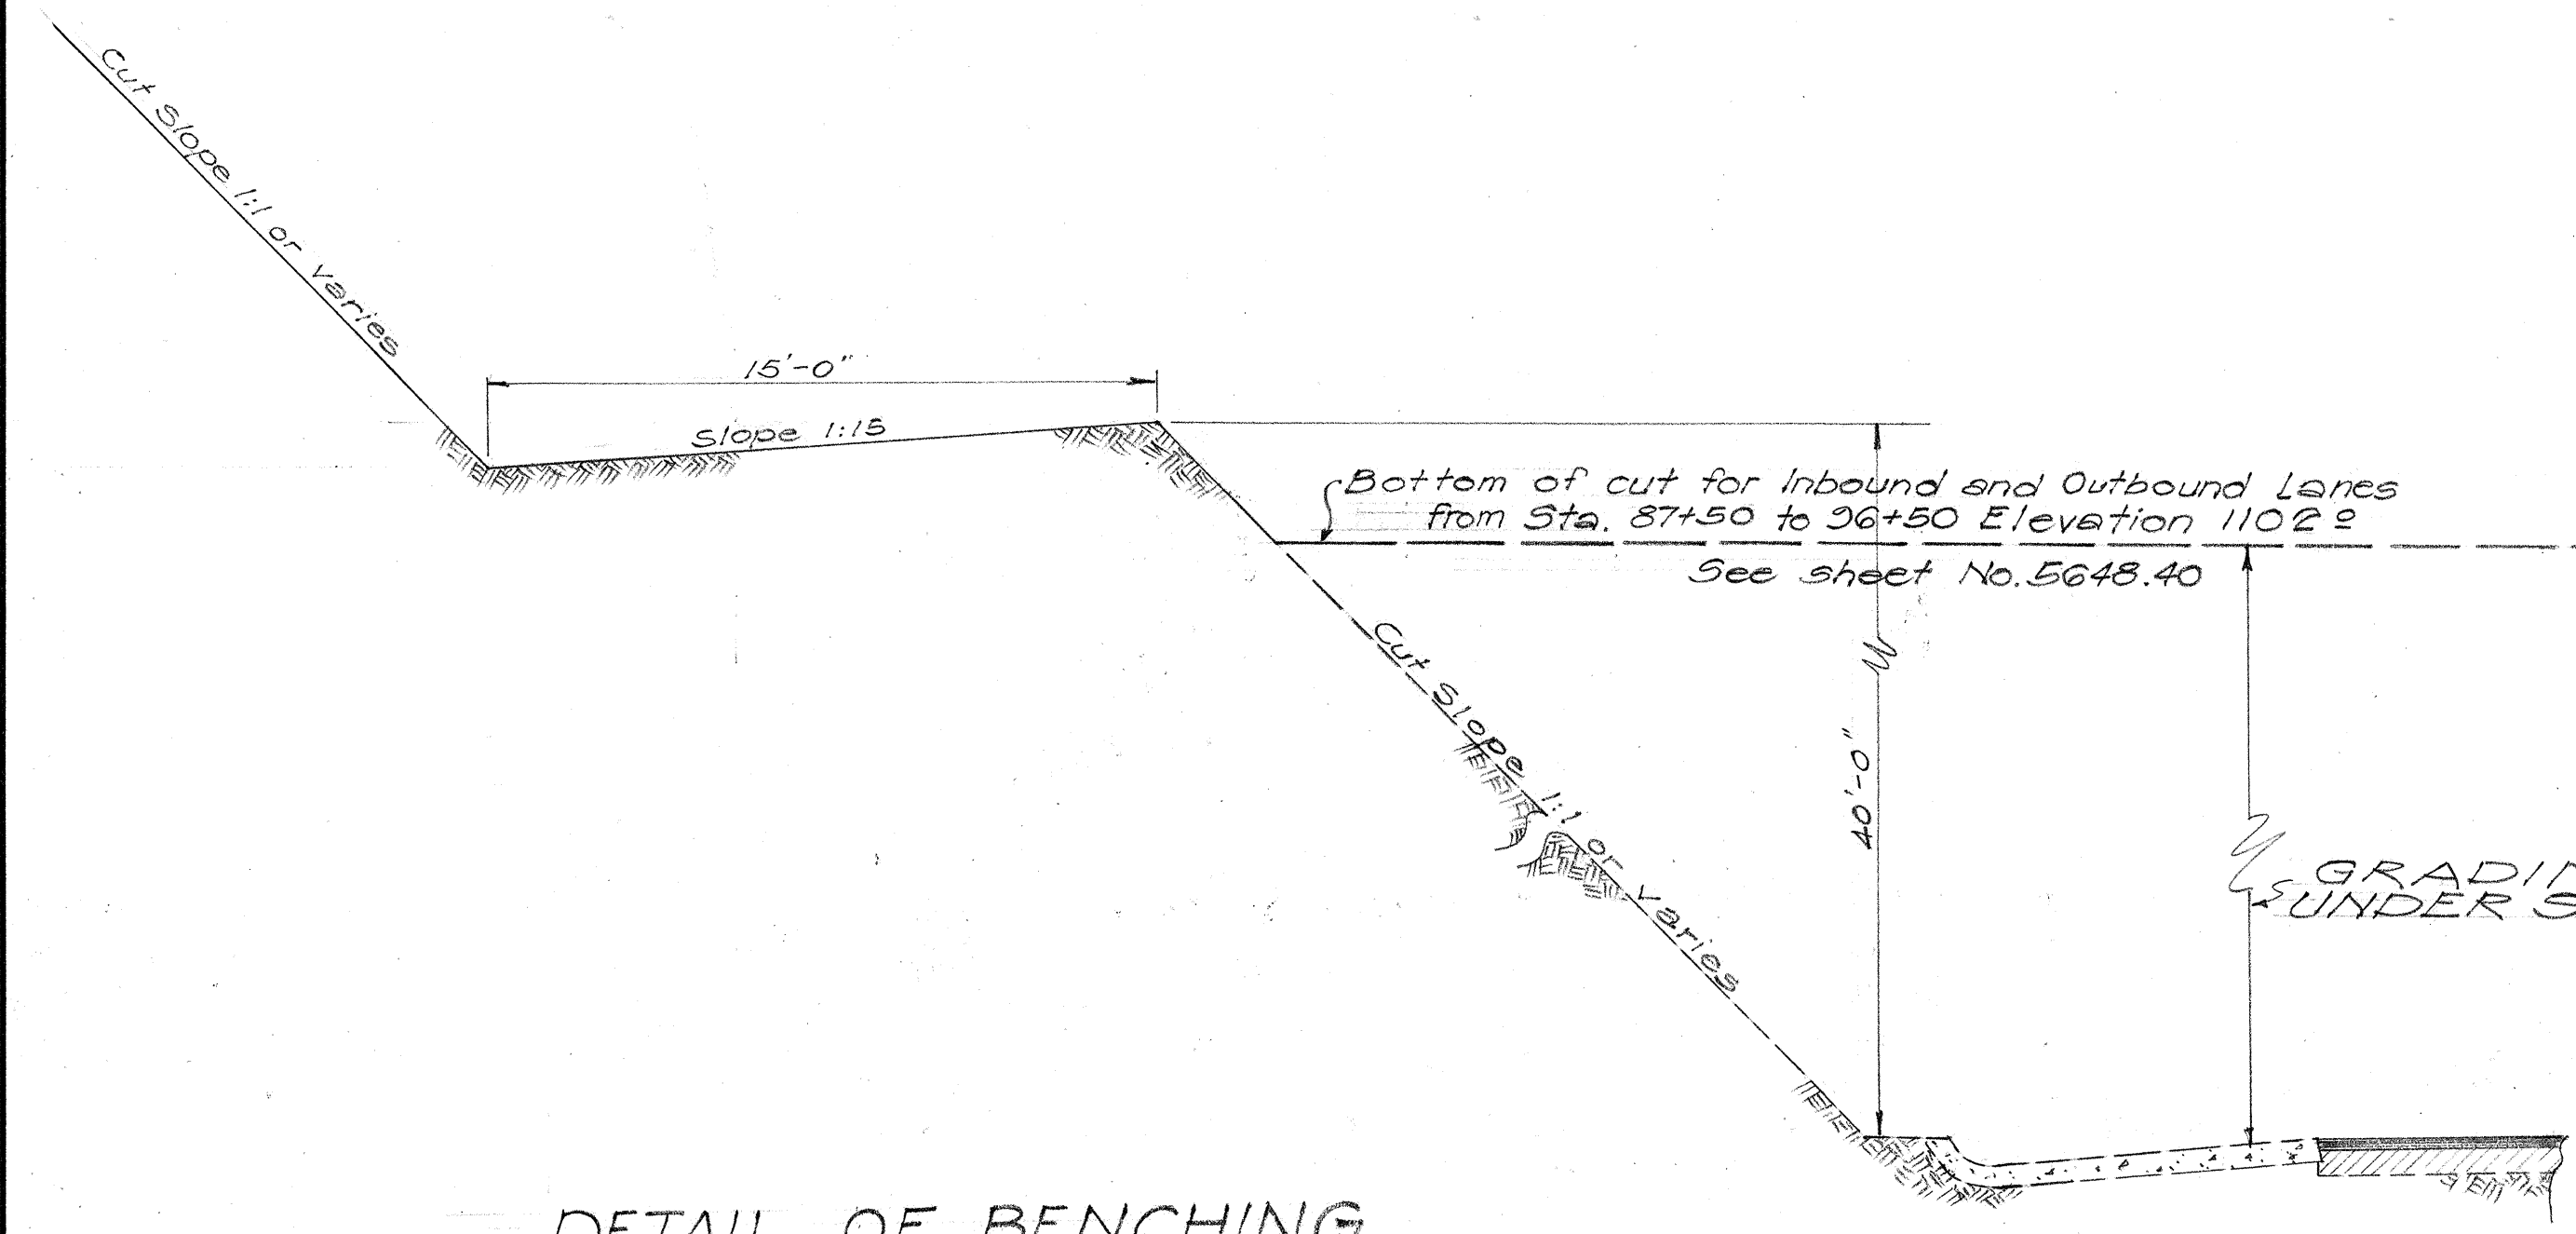

DETAIL OF BENCHING


NOTE: Benches shall be built for cuts deeper than 40 feet on both sides of cut. See cross-sections.

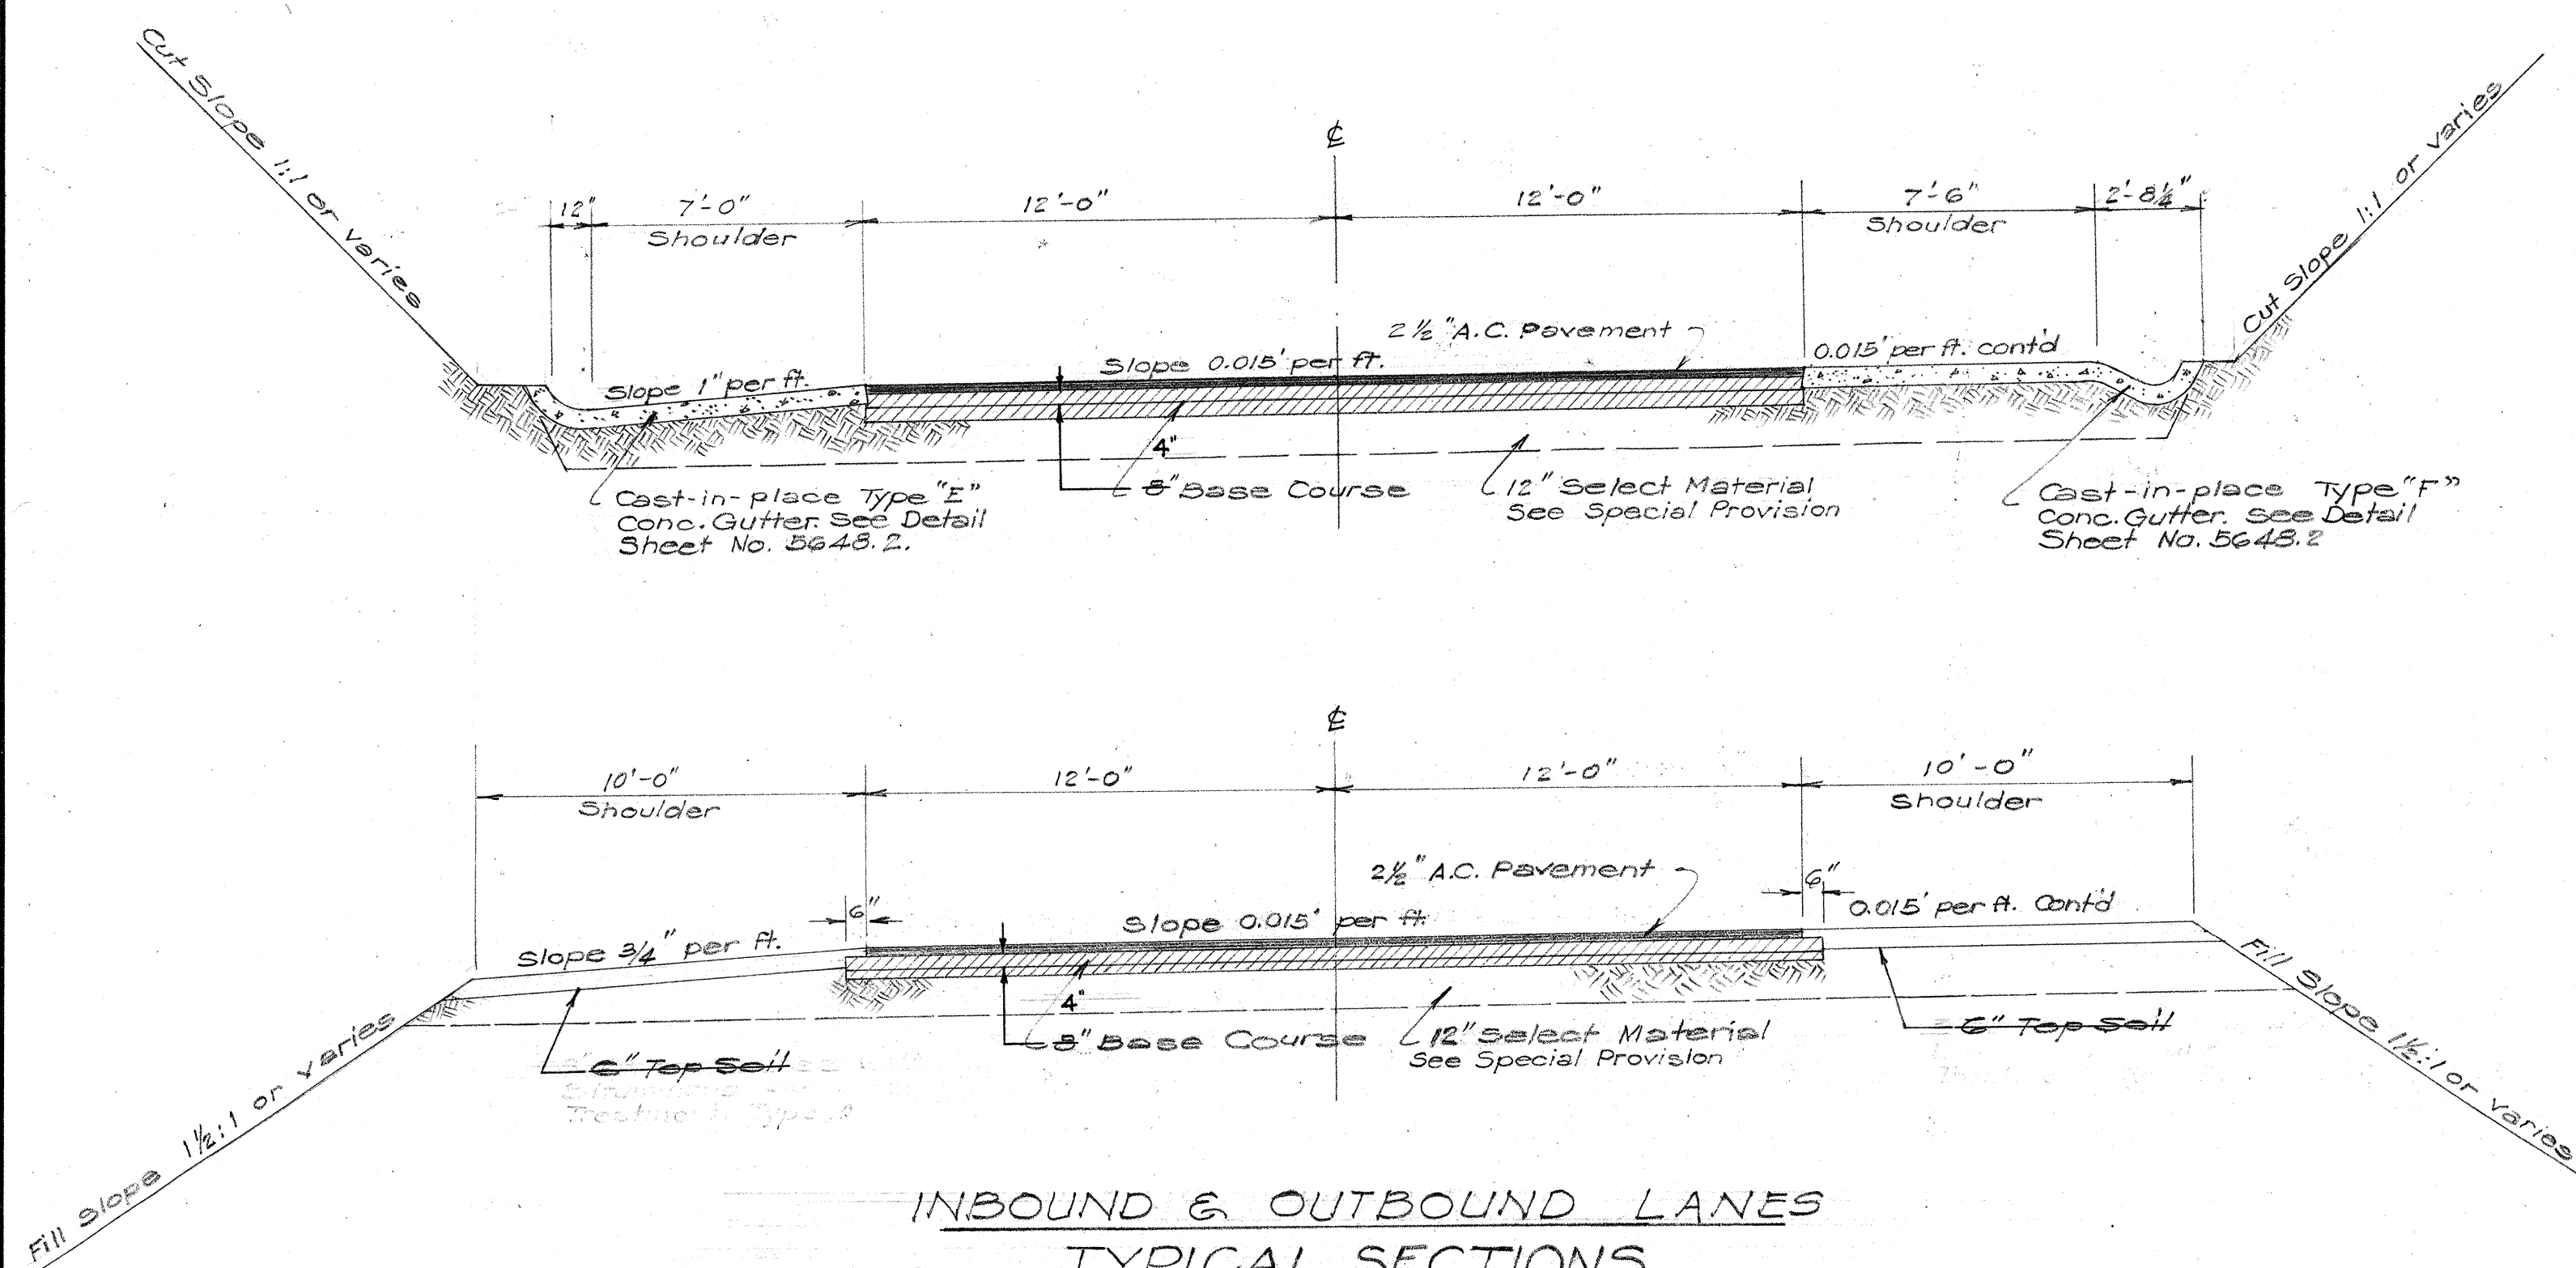


INBOUND & OUTBOUND LANES TYPICAL SECTIONS ON TANGENT & CURVE

STA. 78+38 TO STA. 96+50
UP TO STA. 83+00 NO BASE COURSE

NOTE: Inbound and Outbound lanes shall be excavated to elevation 1102.2. Select material, gutters, base course, and pavement shall be built under a separate contract. See cross-sections and sheet No. 5648.40

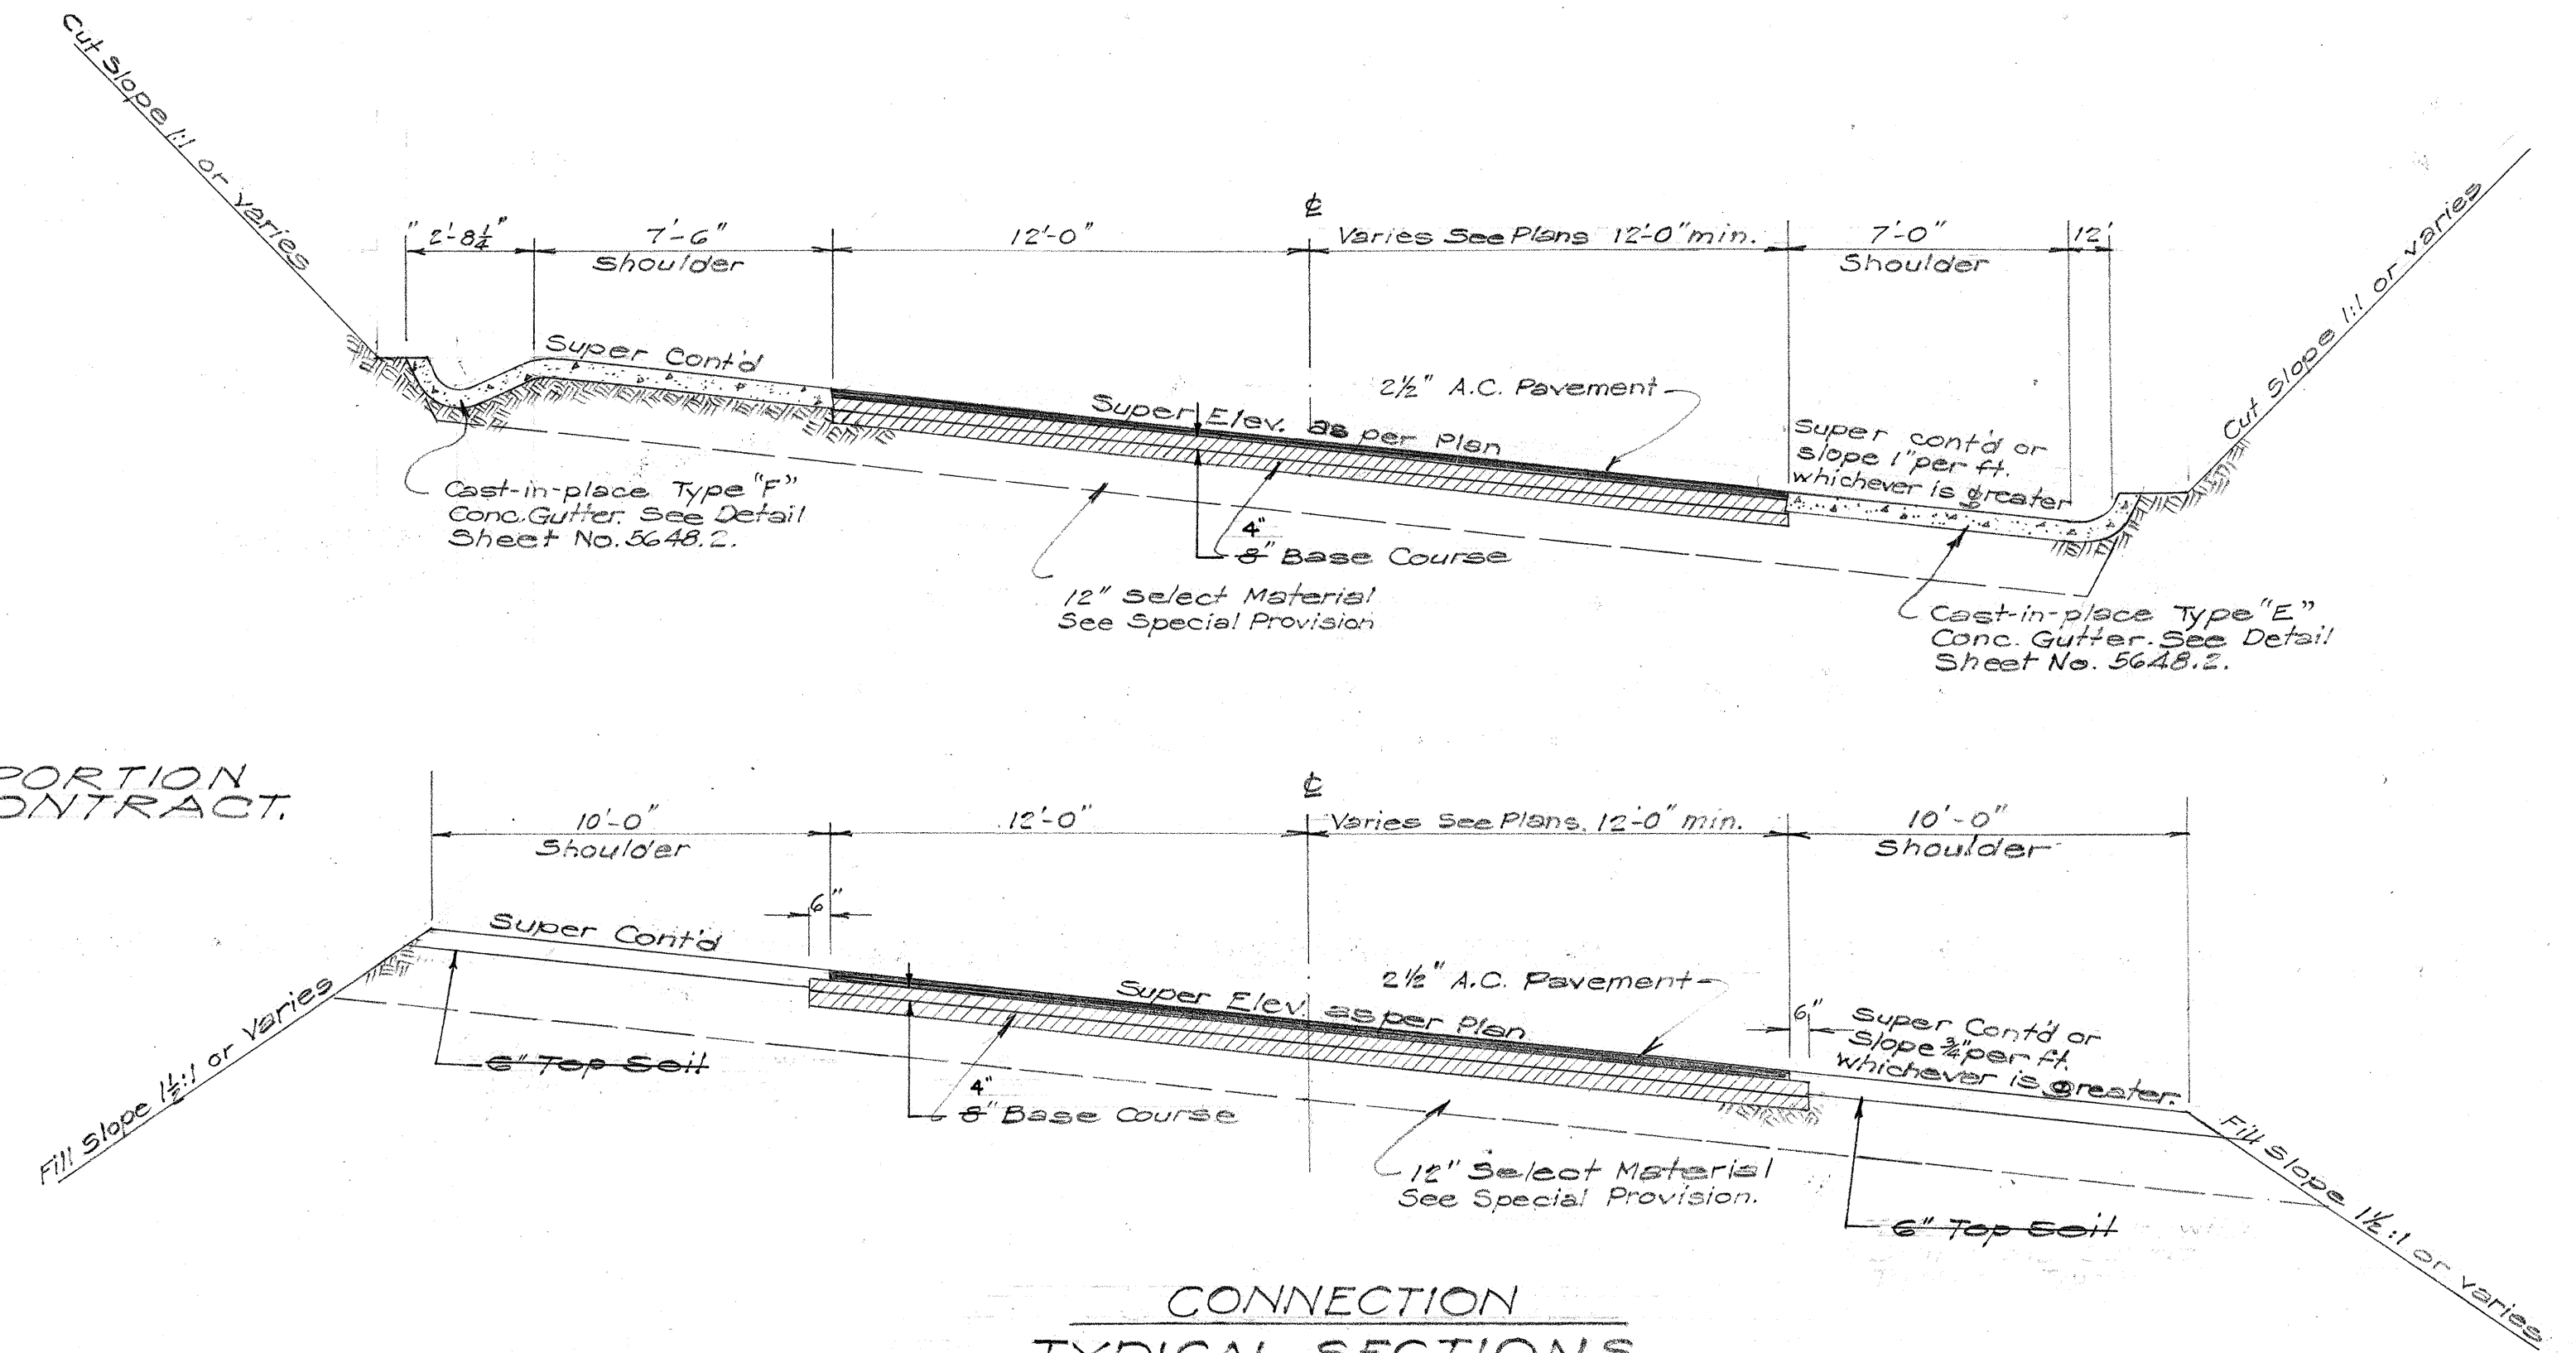

CONNECTION TYPICAL SECTIONS ON CURVE

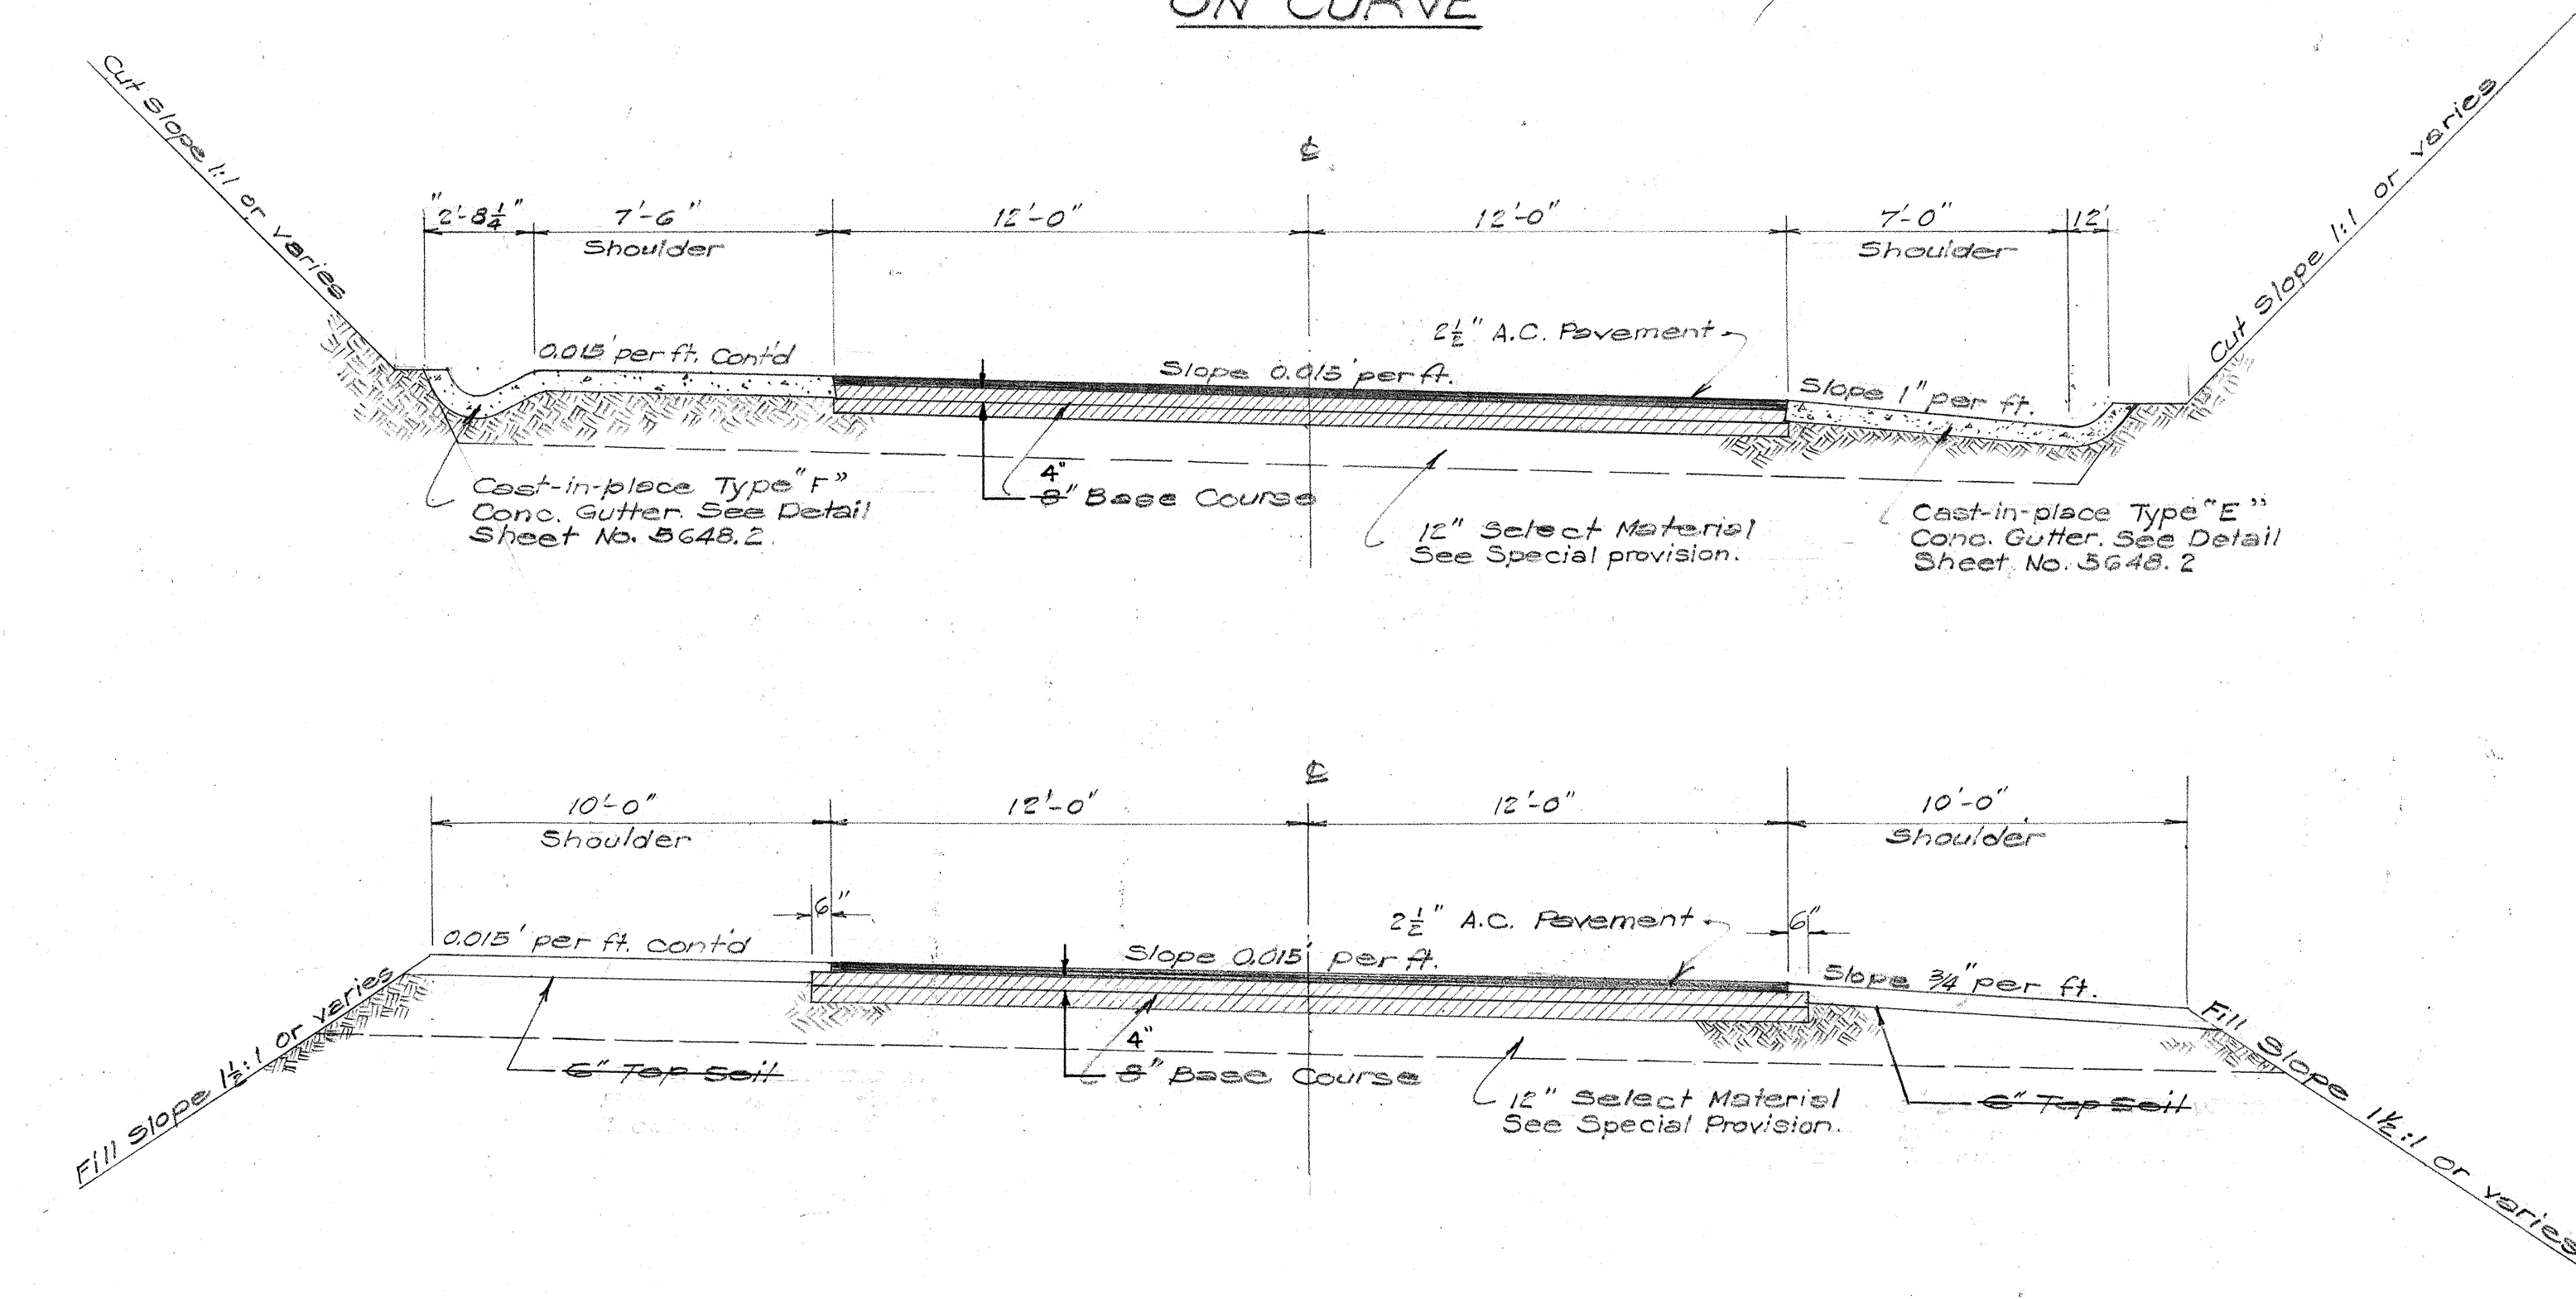

CONNECTION TYPICAL SECTIONS ON TANGENT

NOTE: Connection typical sections apply from 78+38 to 103+00 ±

TERRITORIAL HIGHWAY DEPARTMENT
TERRITORY OF HAWAII

TYPICAL SECTIONS
PALI ROAD
PROJECT NO. S216(4)

SCALE: 1/4" = 1'-0" NOVEMBER 1953

SHEET NO. 2 OF 2 SHEETS

5648.2A

DATE	
SURVEY PLOTTED BY	
DESIGNED BY	
DRAWN BY	
CHECKED BY	
NOTE BOOK	
No.	