



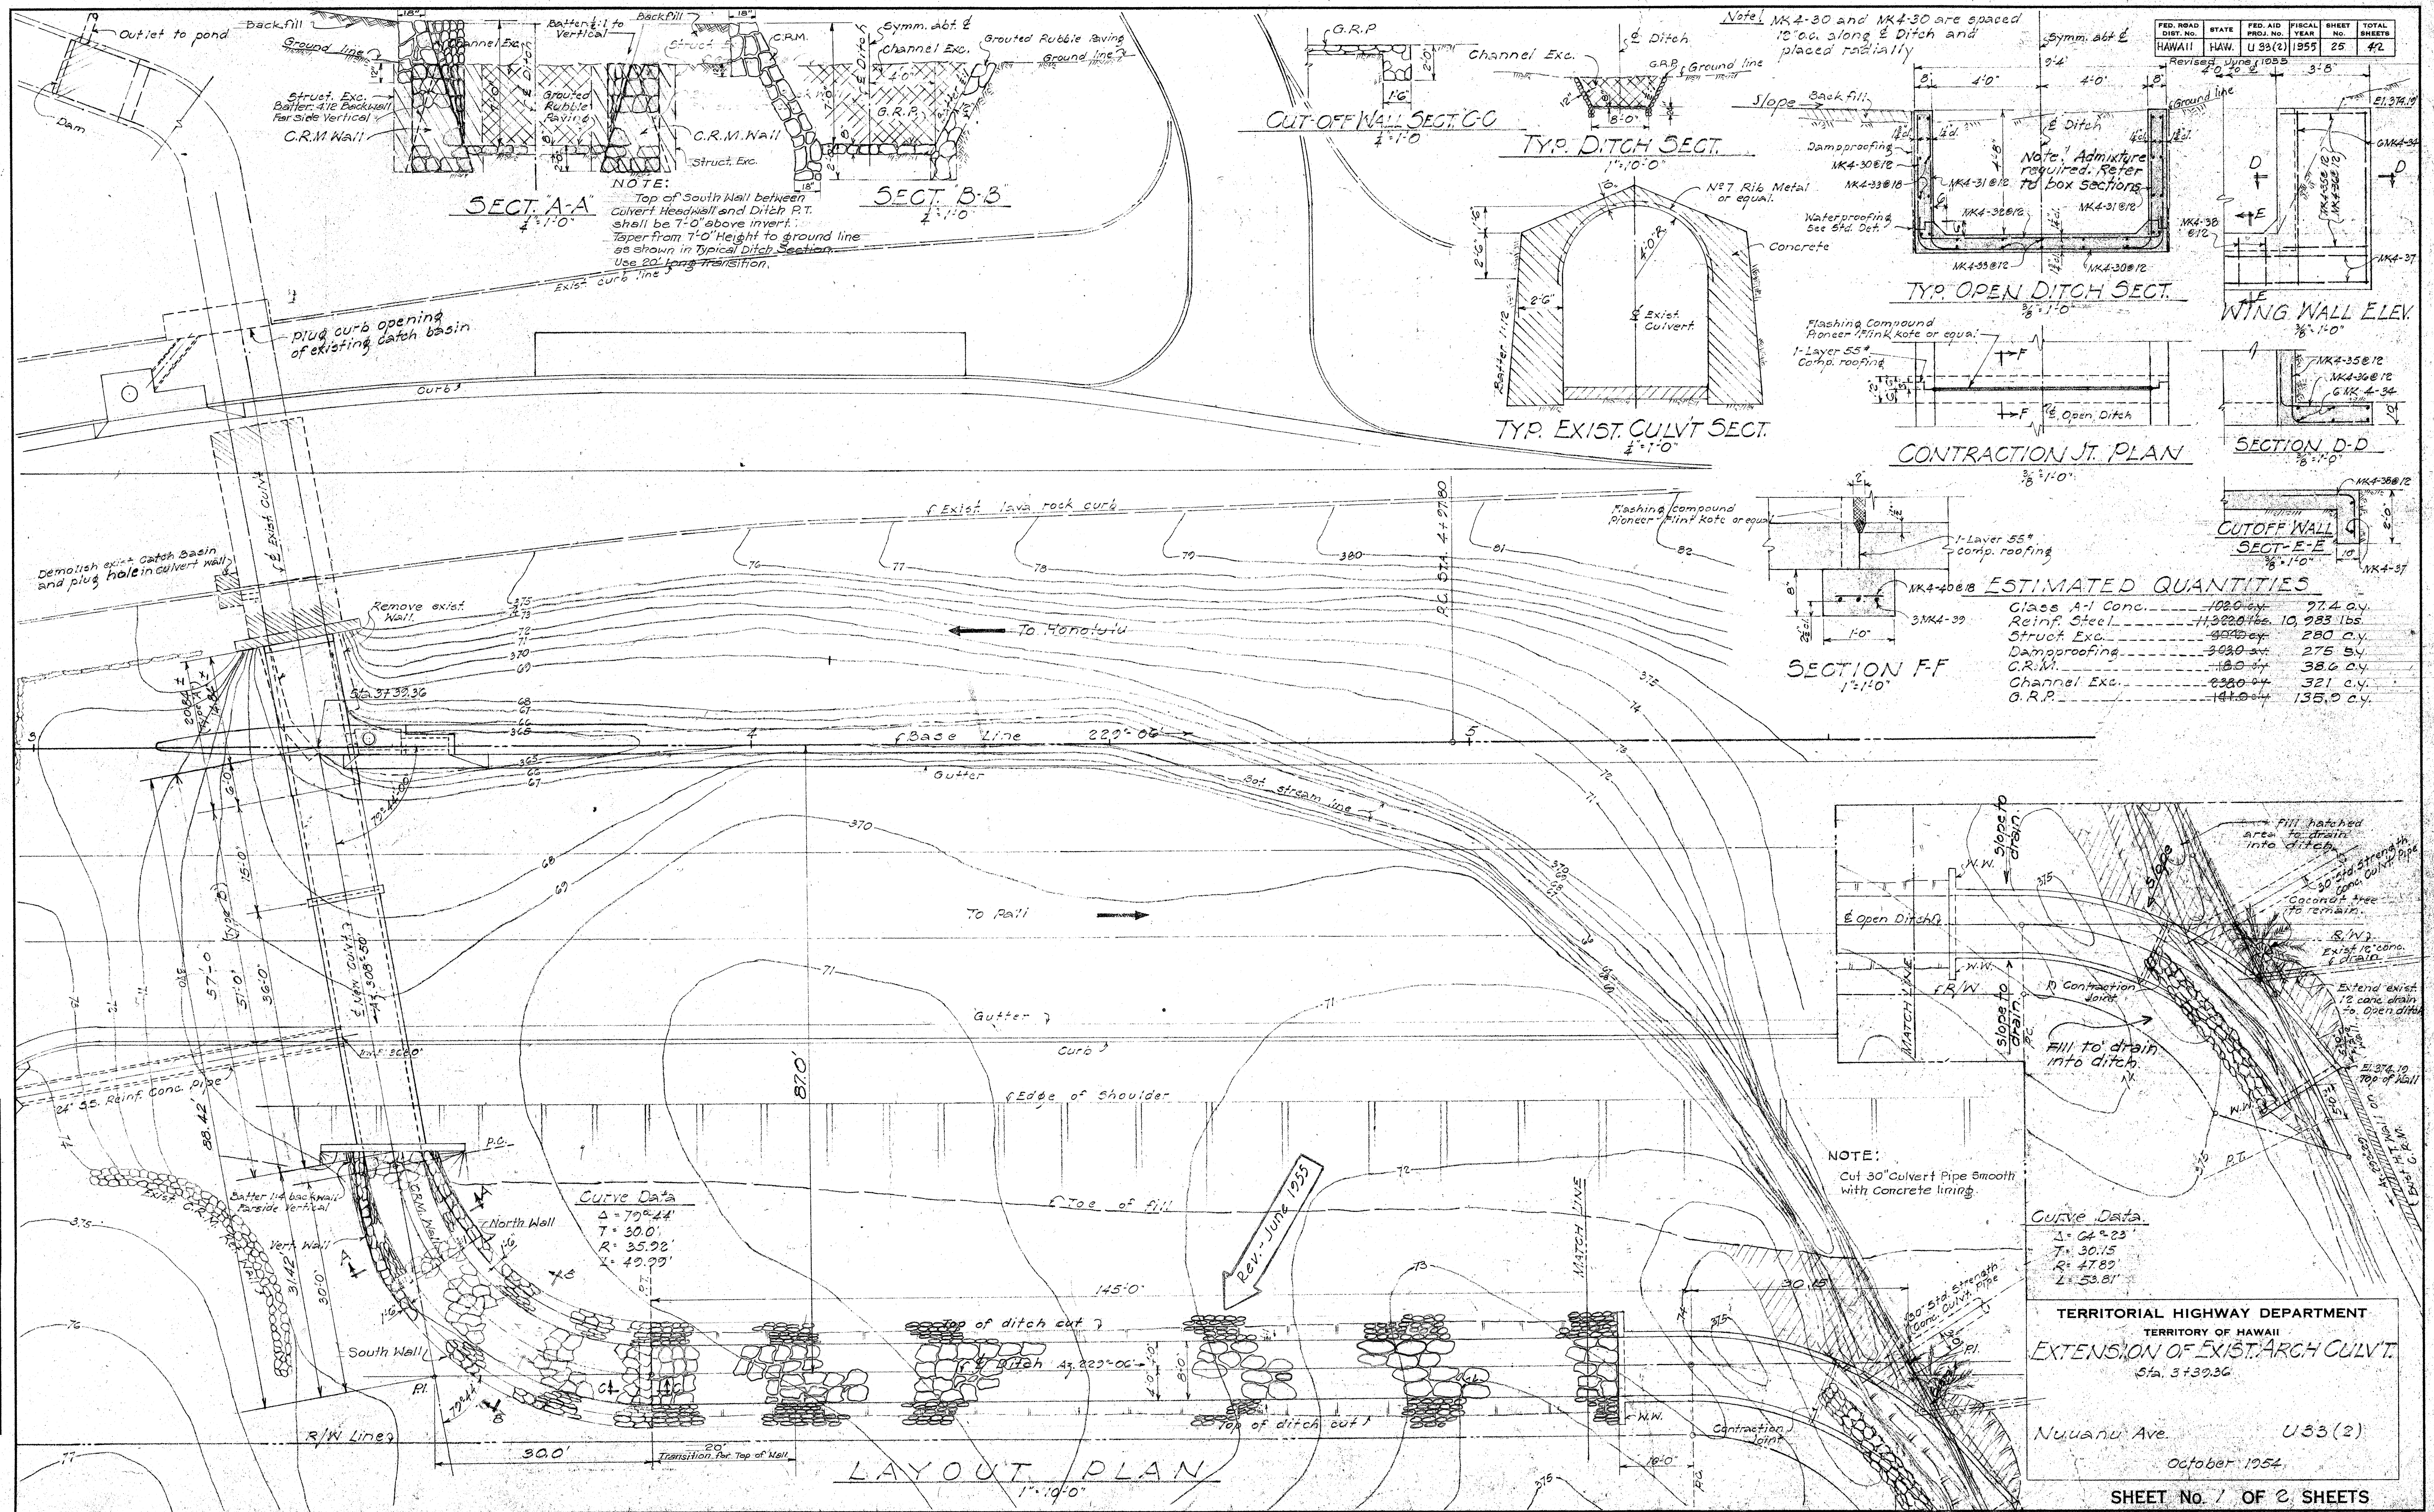

FED. ROAD DIST. No.	STATE	FED. AID PROJ. No.	FISCAL YEAR	SHEET No.	TOTAL SHEETS
HAWAII	HAW	U 33(2)	1955	26	42

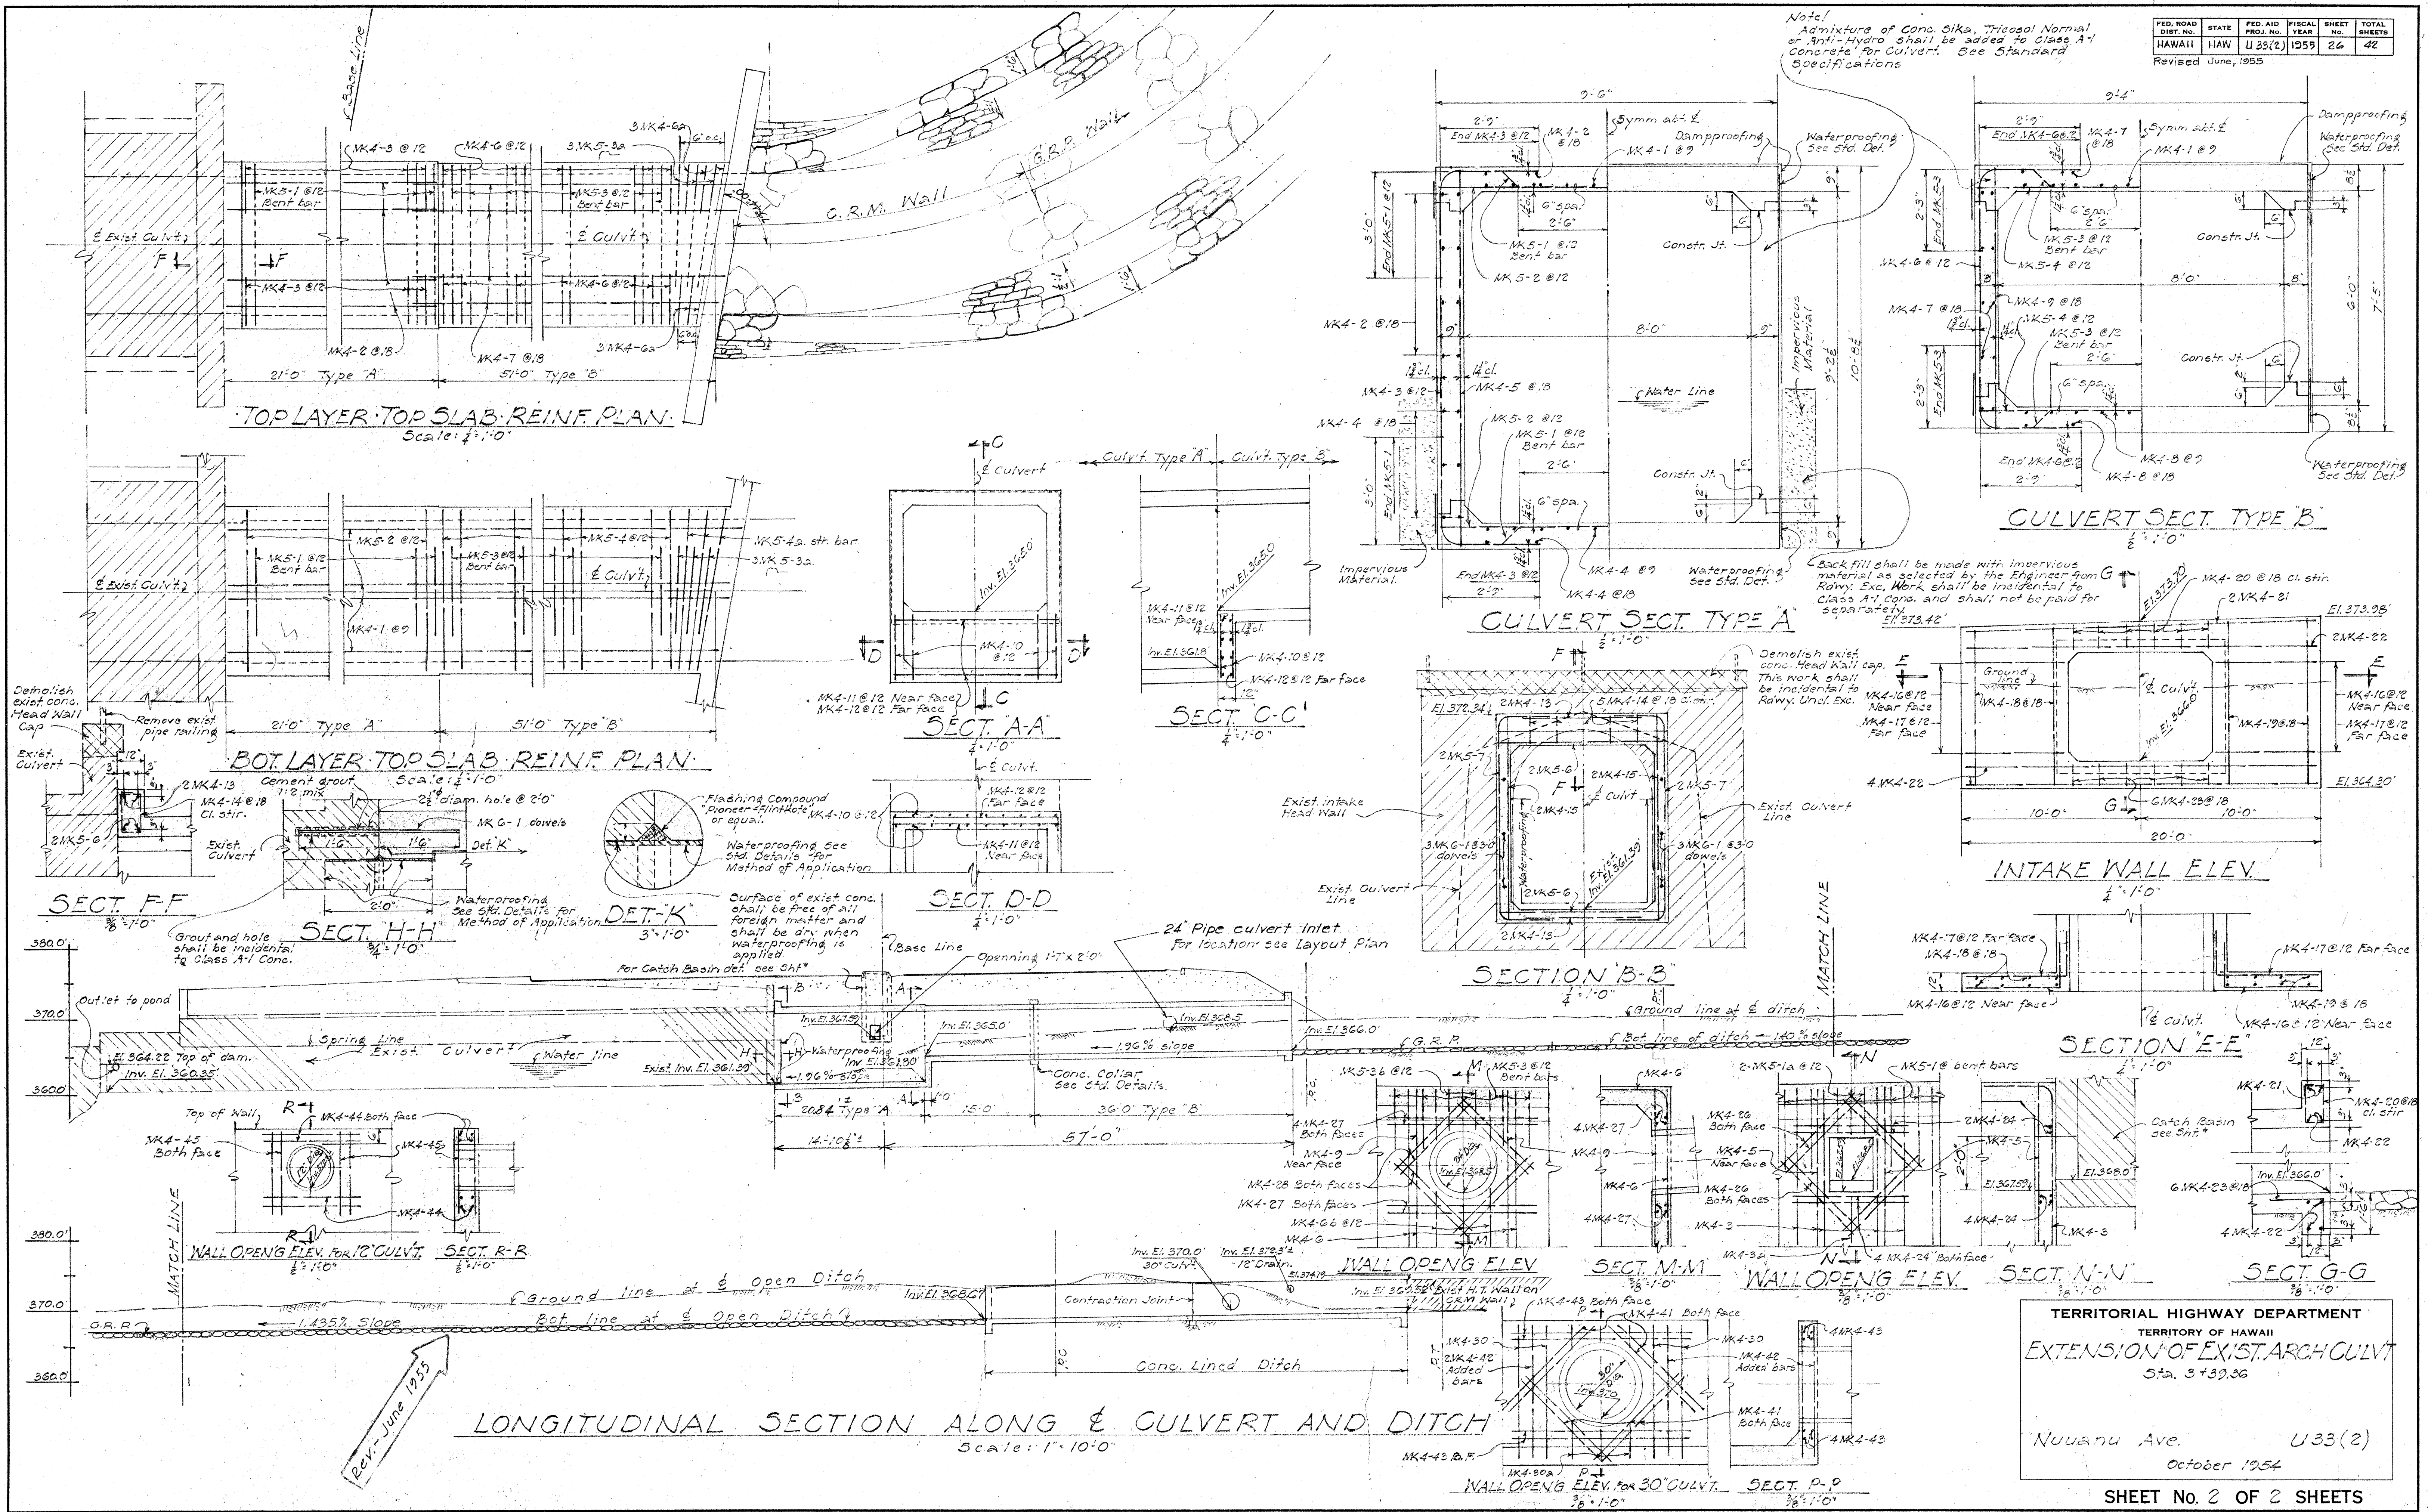

Note!
Admixture of Conc. Silica, Tricosol Normal
or Anti-Hydro shall be added to Class A-1
Concrete for Culvert. See Standard
Specifications

TERRITORIAL HIGHWAY DEPARTMENT
TERRITORY OF HAWAII
EXTENSION OF EXIST. ARCH CULVT
Sta. 3+39.36
Nuuanu Ave. U33(2)
October 1954

5746.26A