




FED. ROAD DIST. NO.	STATE	FED. AID PROJ. NO.	FISCAL YEAR	SHEET NO.	TOTAL SHEETS
HAWAII	HAWAII	U 33(2)	1955	7	42

DATE	DESIGNED BY	TRACED BY	QUANTITIES BY	CHECKED BY
PLN	NO.	NO.	NO.	NO.

TYPICAL TREATMENT OF MEDIAN TIPS
SCALE: 1" = 10'-0"

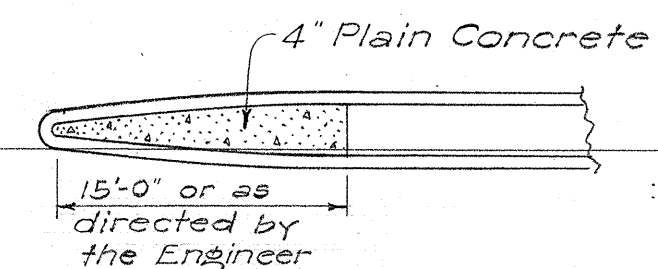

True North
Scale: 1" = 20'

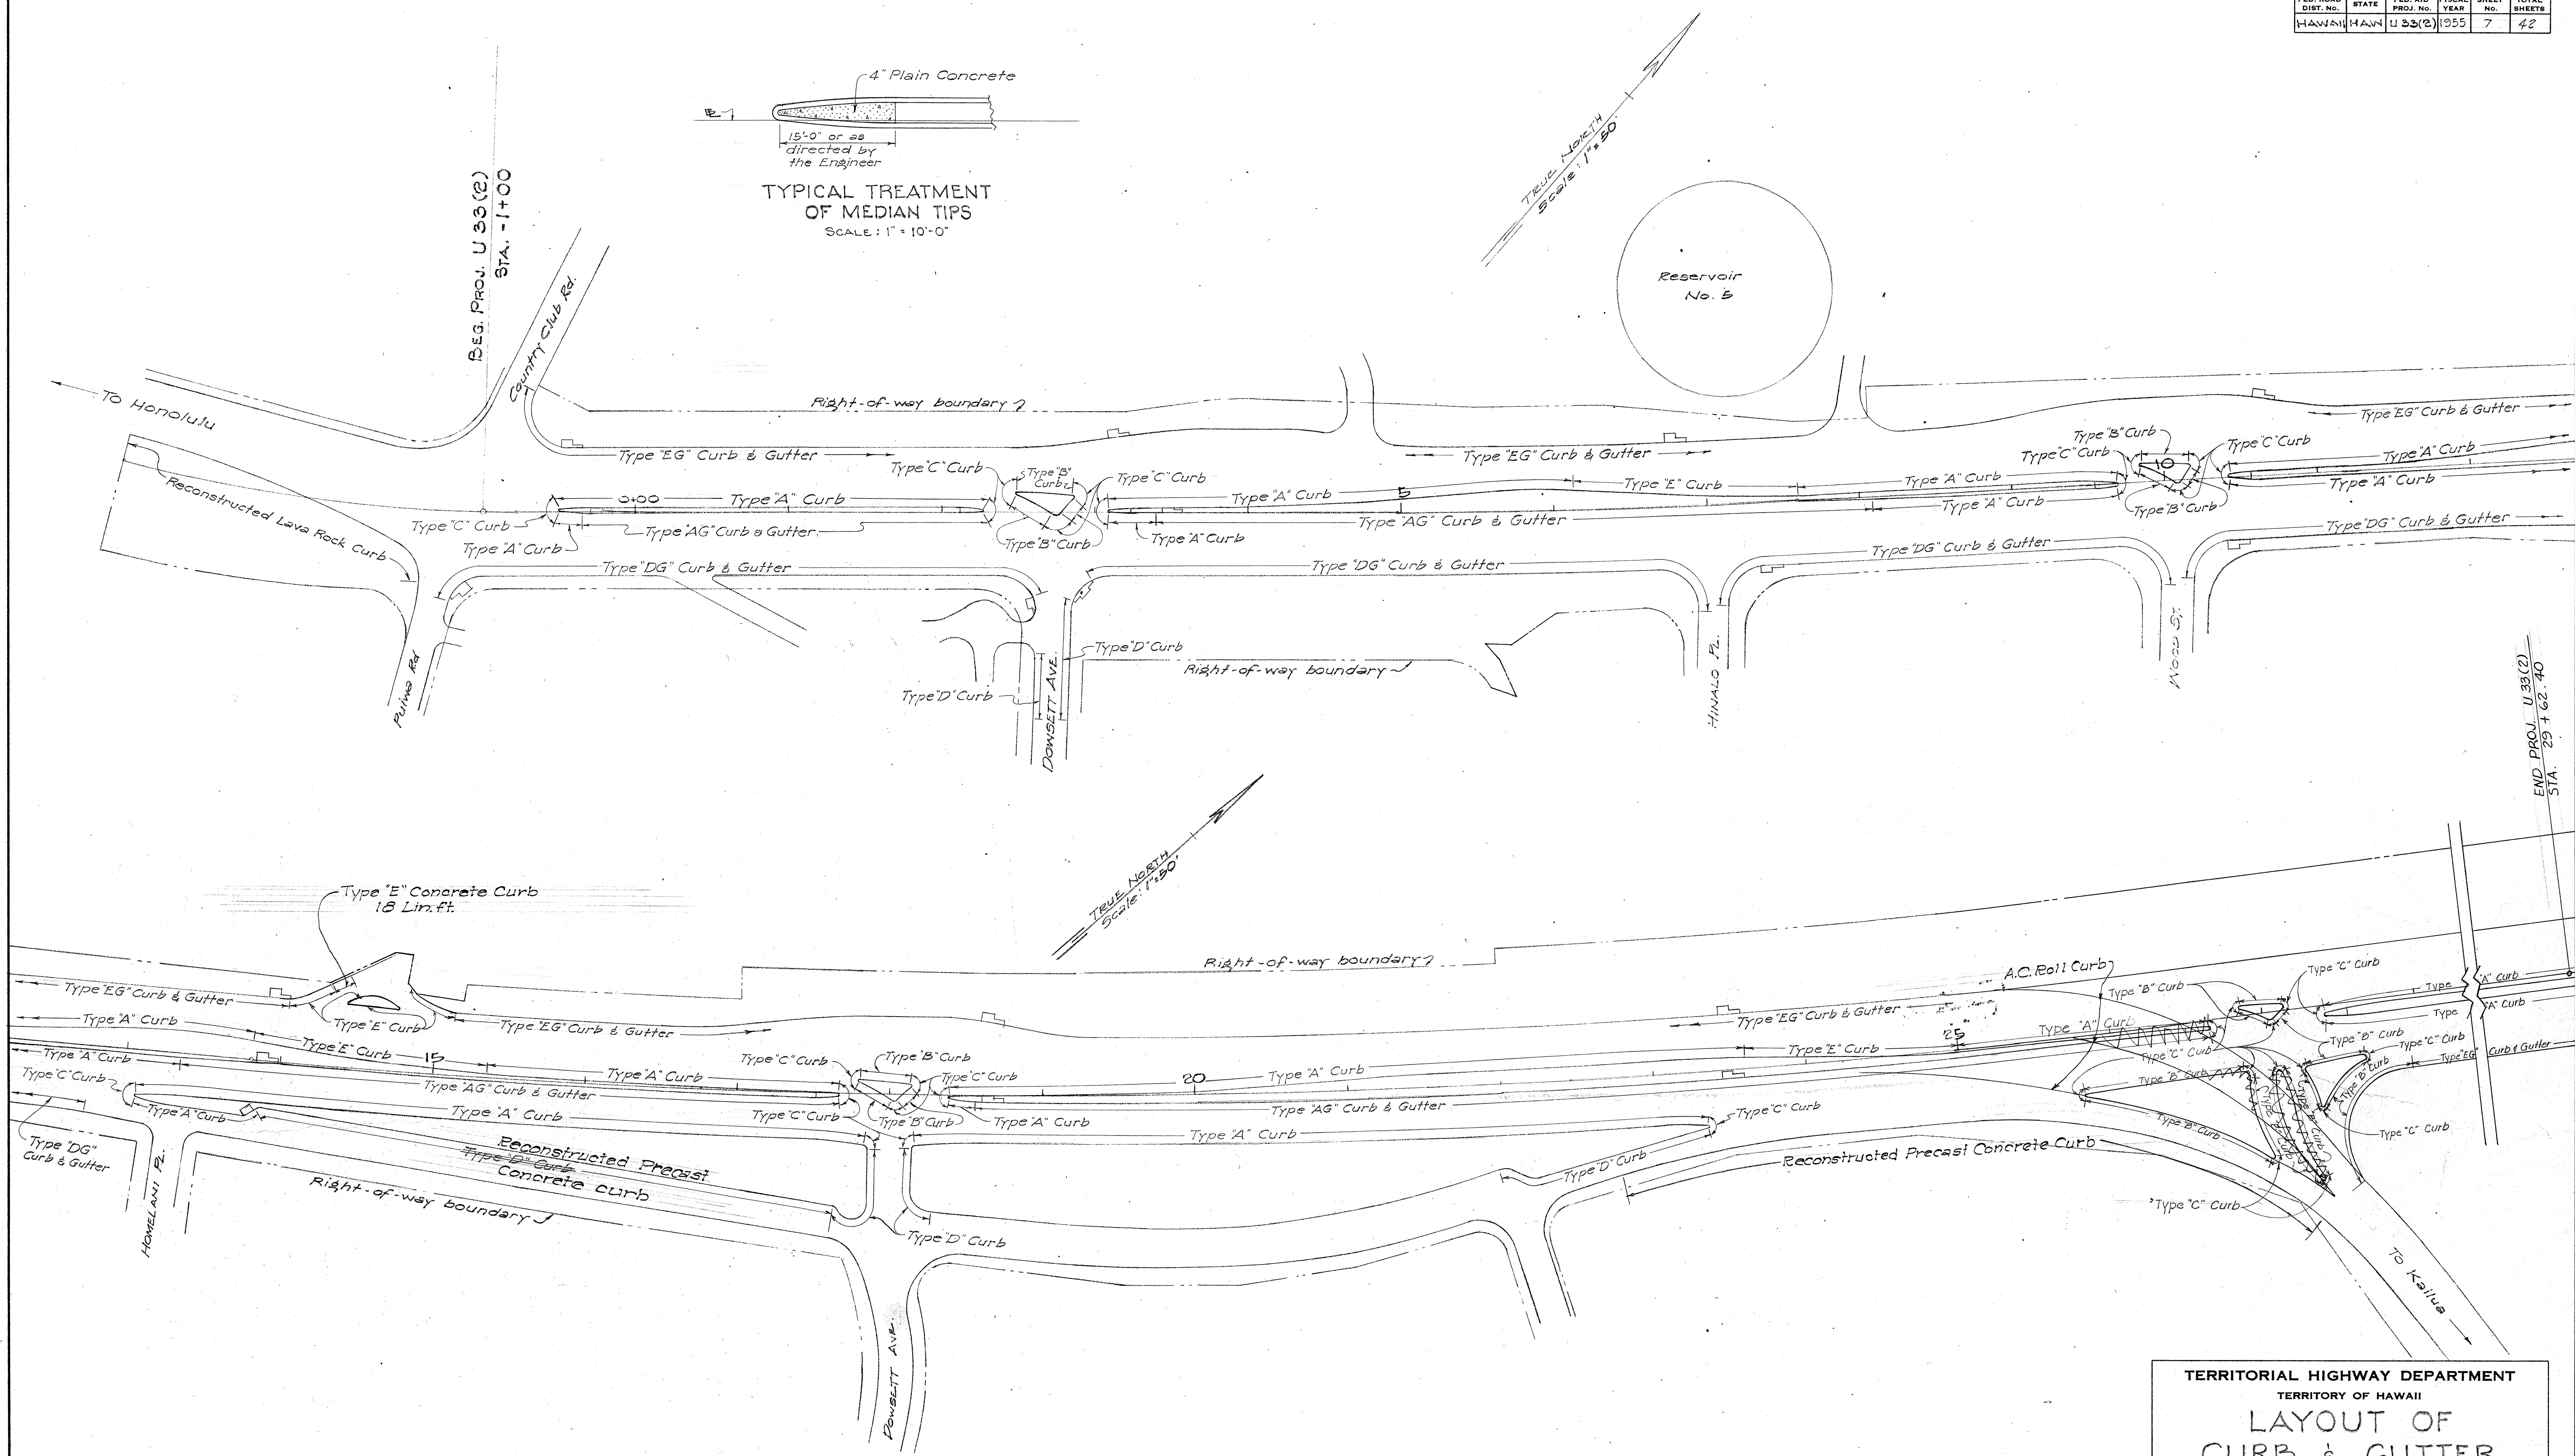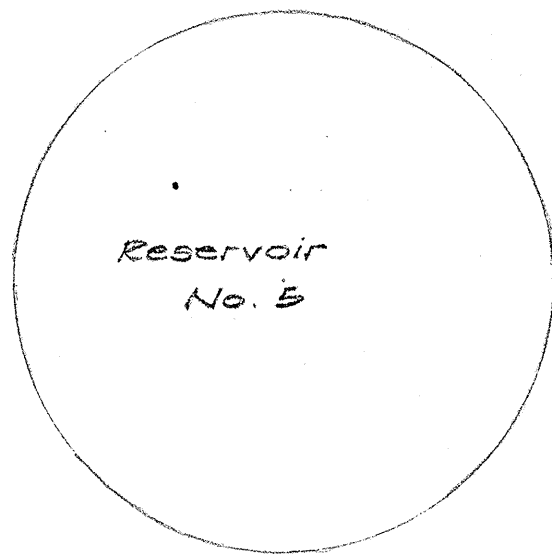

TERRITORIAL HIGHWAY DEPARTMENT
TERRITORY OF HAWAII
LAYOUT OF CURB & GUTTER
NUUANU AVENUE
PROJECT NO. U 33(2)
SCALE AS NOTED JANUARY 1955

5746.7