


FED. ROAD DIST. NO.	STATE	FED. AID PROJ. NO.	FISCAL YEAR	SHEET NO.	TOTAL SHEETS
HAWAII	HAW.	U 33(2)	1955	6	42

2-14-55

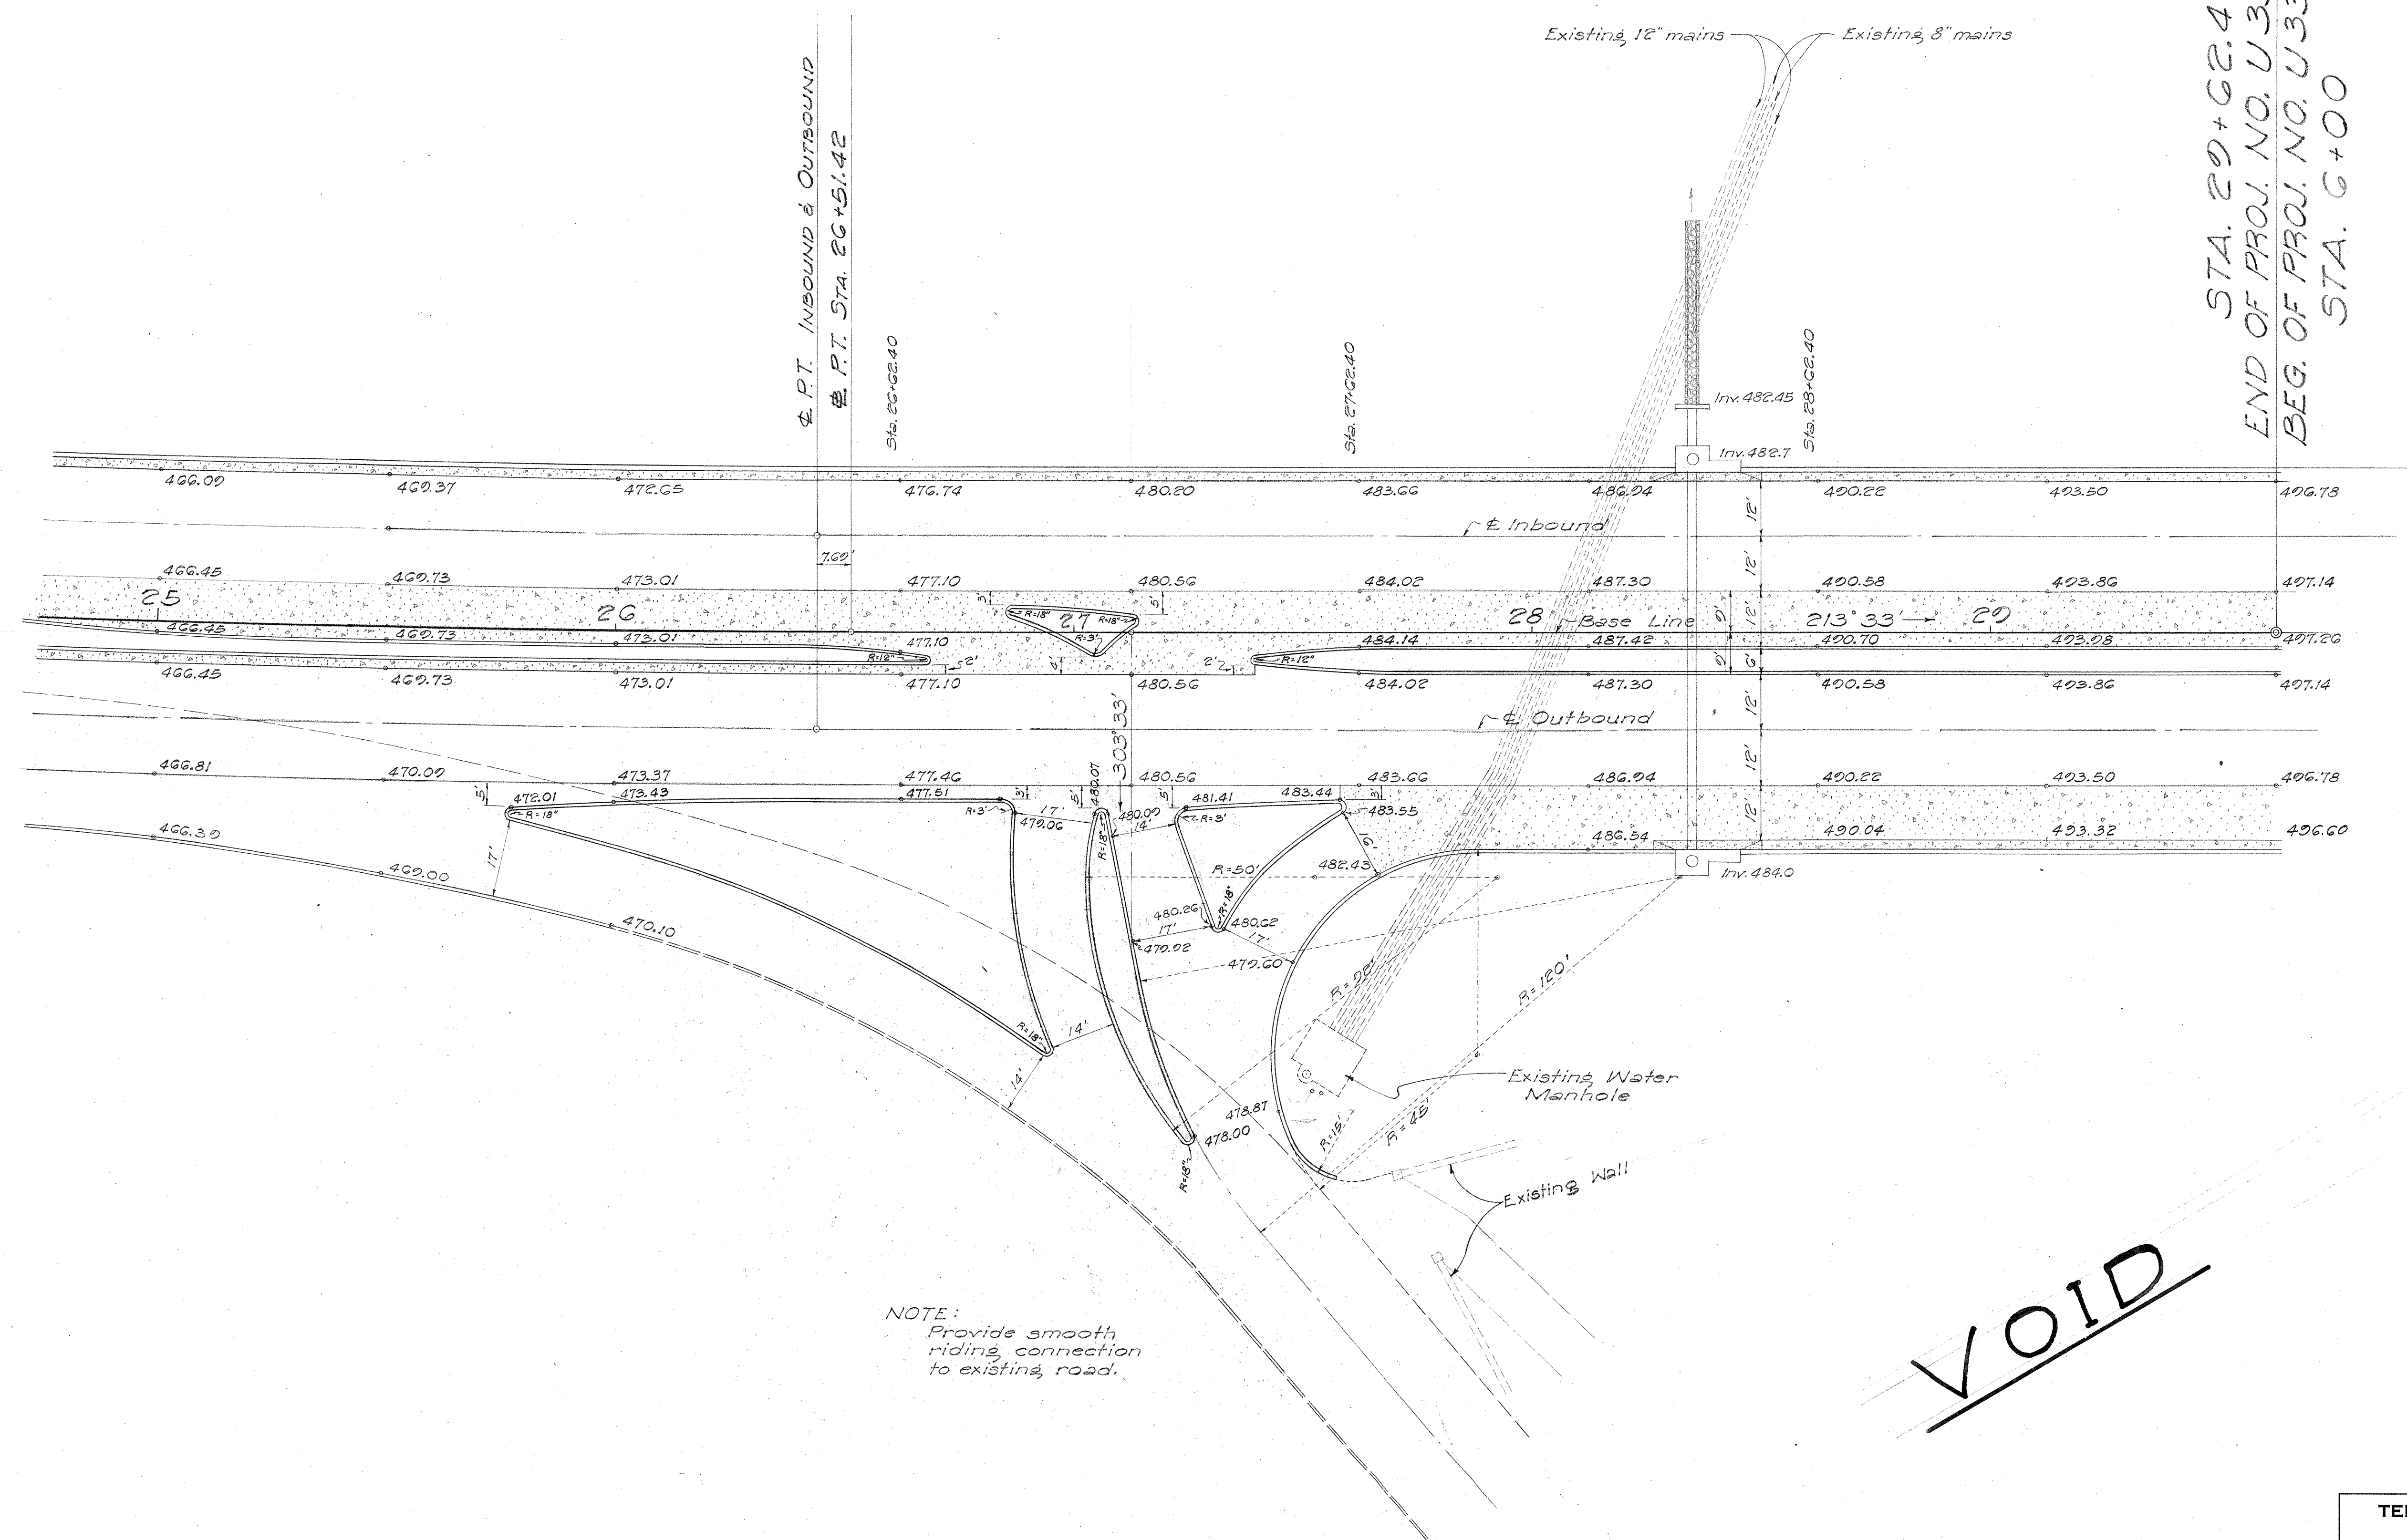

STA. 29+62.40
END OF PROJ. NO. U 33 (2)
BEG. OF PROJ. NO. U 33 (1)
STA. 6+00

NOTE:
Provide smooth riding connection to existing road.

VOID

ORIGINAL PLAN	SURVEY PLOTTED BY	DATE
DESIGNED BY		
NOTED BY		
QUANTITIES CHECKED BY		
CHECKED BY		

TERRITORIAL HIGHWAY DEPARTMENT
TERRITORY OF HAWAII

INTERSECTION DETAIL
STA. 27+12.40
NUUANU AVENUE
PROJECT NO. U 33 (2)
Scale: 1" = 20' Feb. 1955

SHEET No. 1 OF 1 SHEETS

57416.6