


FED. ROAD DIST. NO.	STATE	FED. AID PROJ. NO.	FISCAL YEAR	SHEET NO.	TOTAL SHEETS
HAWAII	HAW	U33(2)	1955	8	42

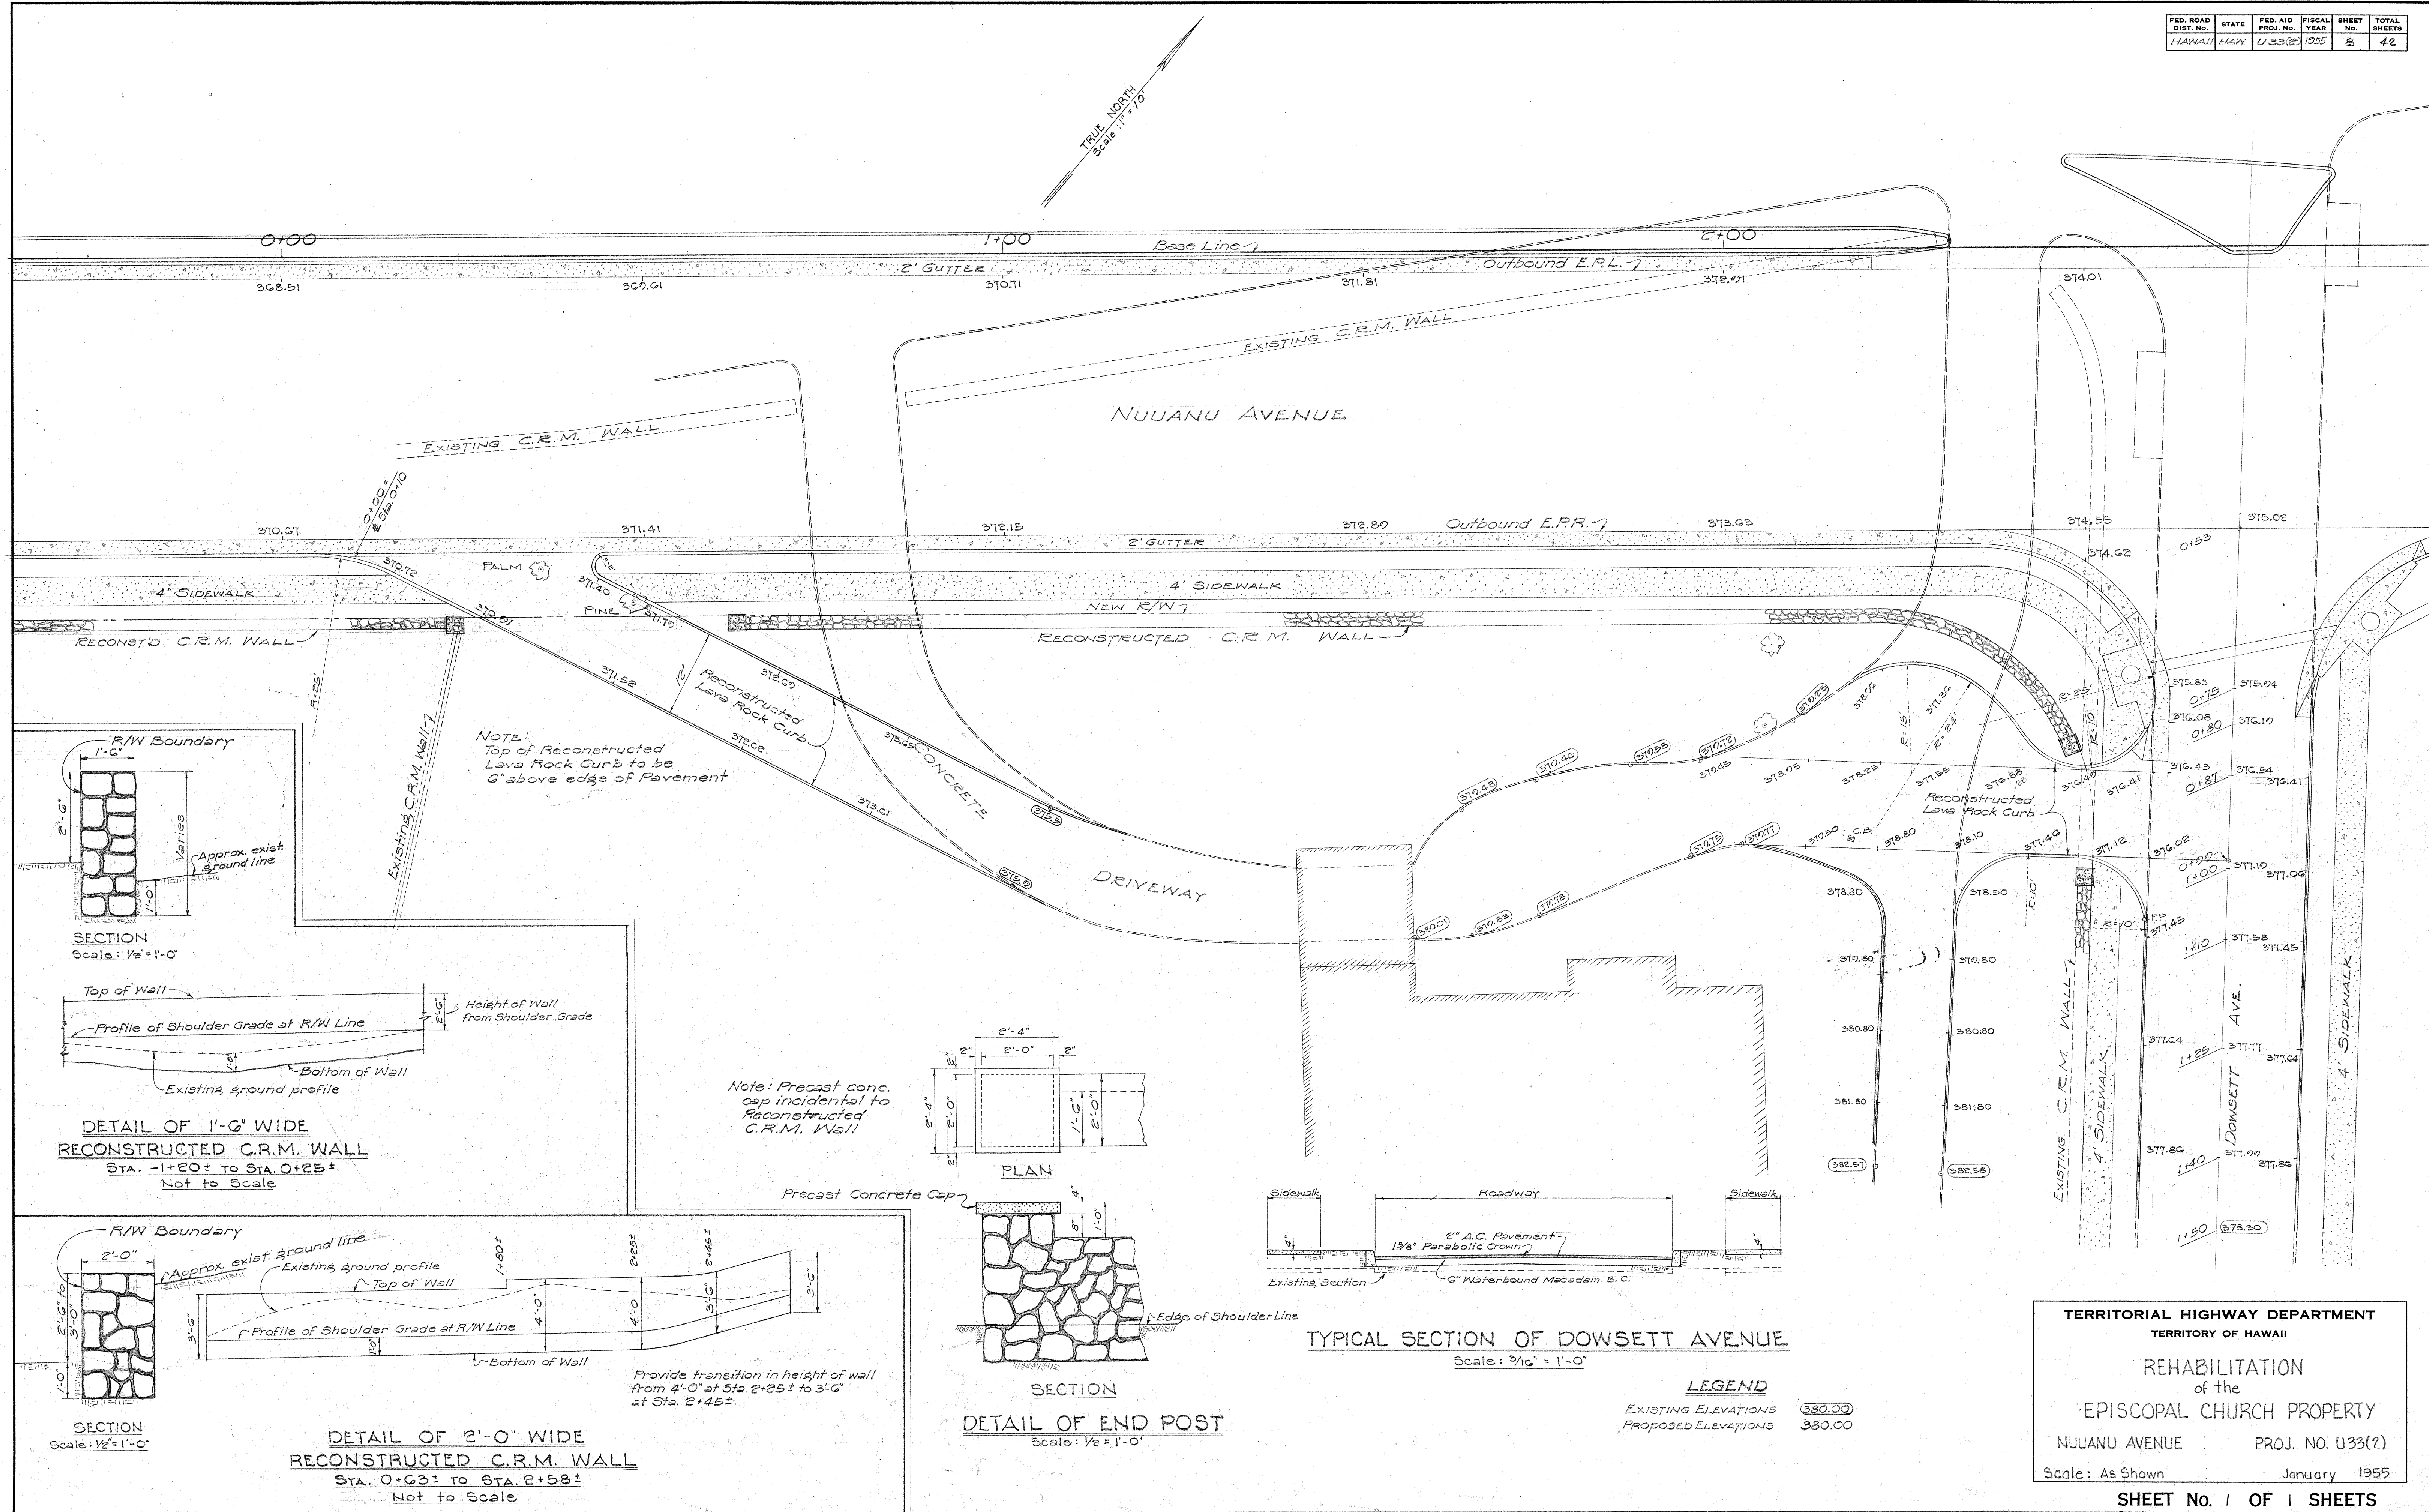

DATE	
SURVEY BY	
DESIGNED BY	
DRAWN BY	
CHECKED BY	
NOTE BOOK	
CHECKED BY	
NO.	