
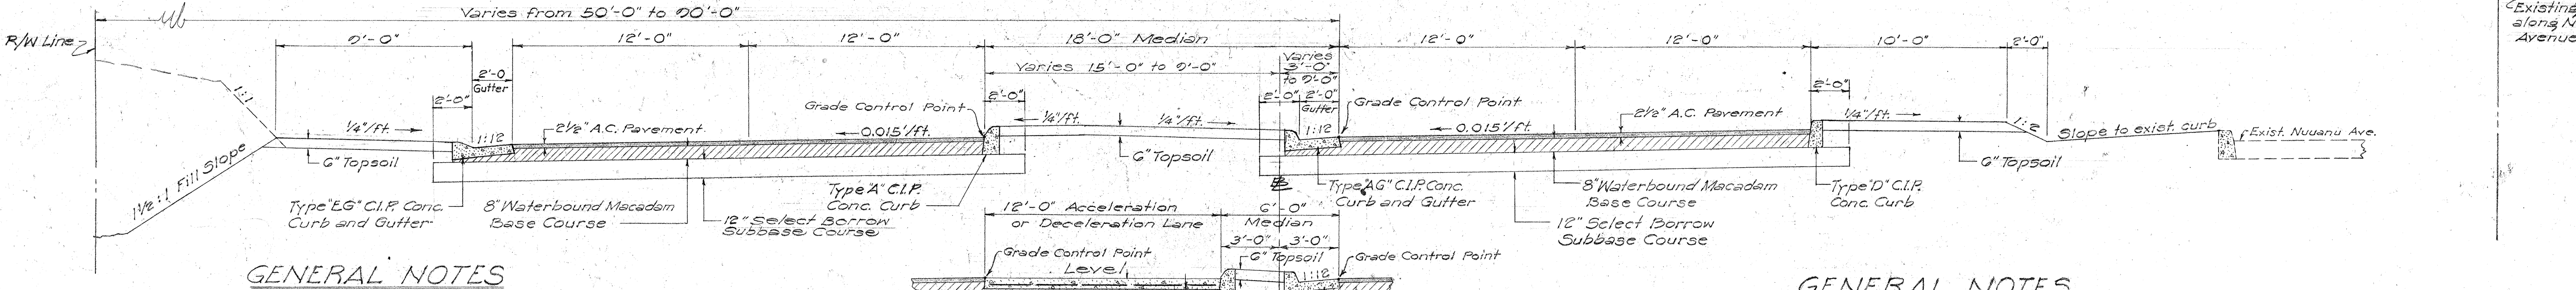
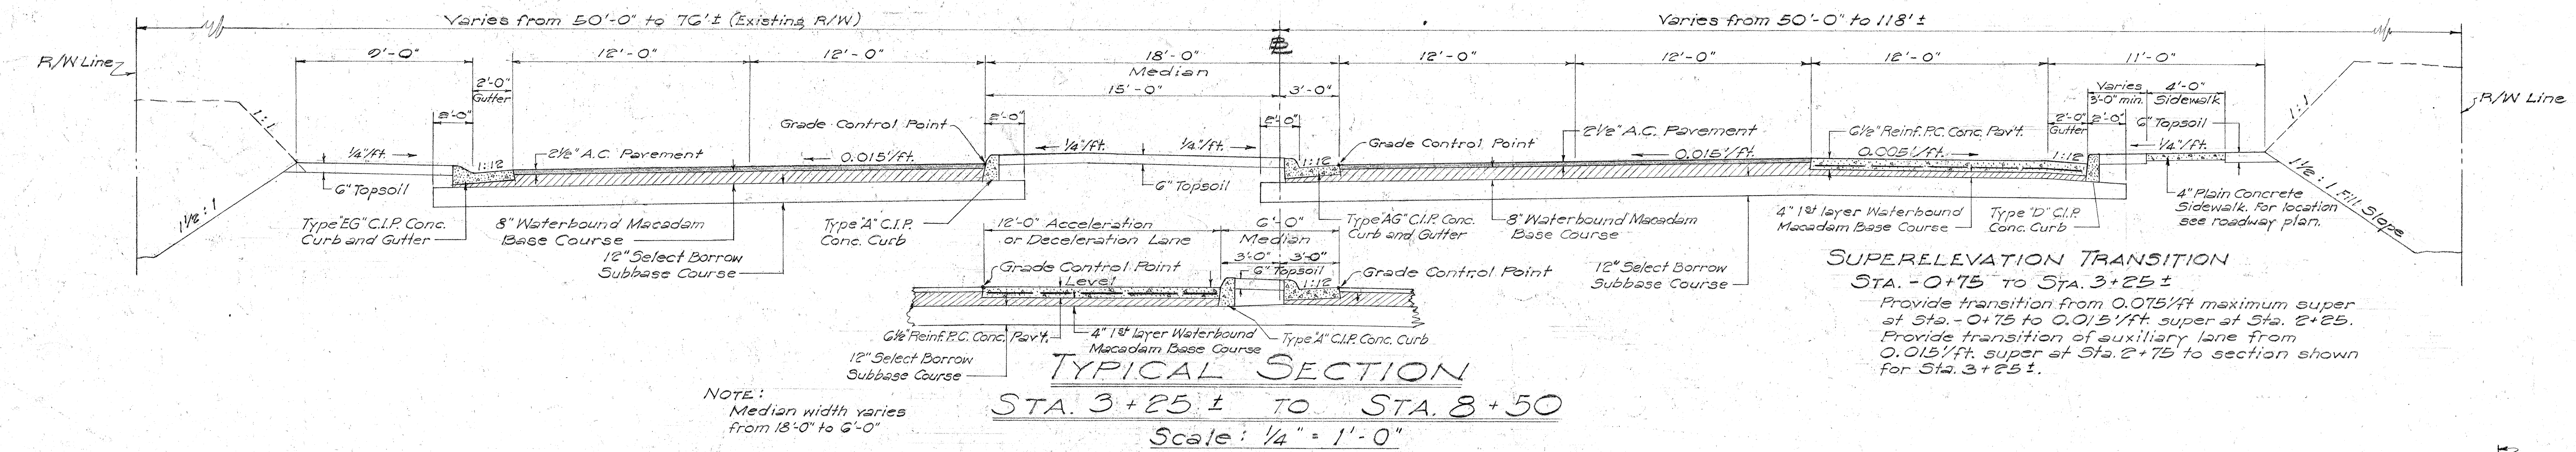


2-16-55

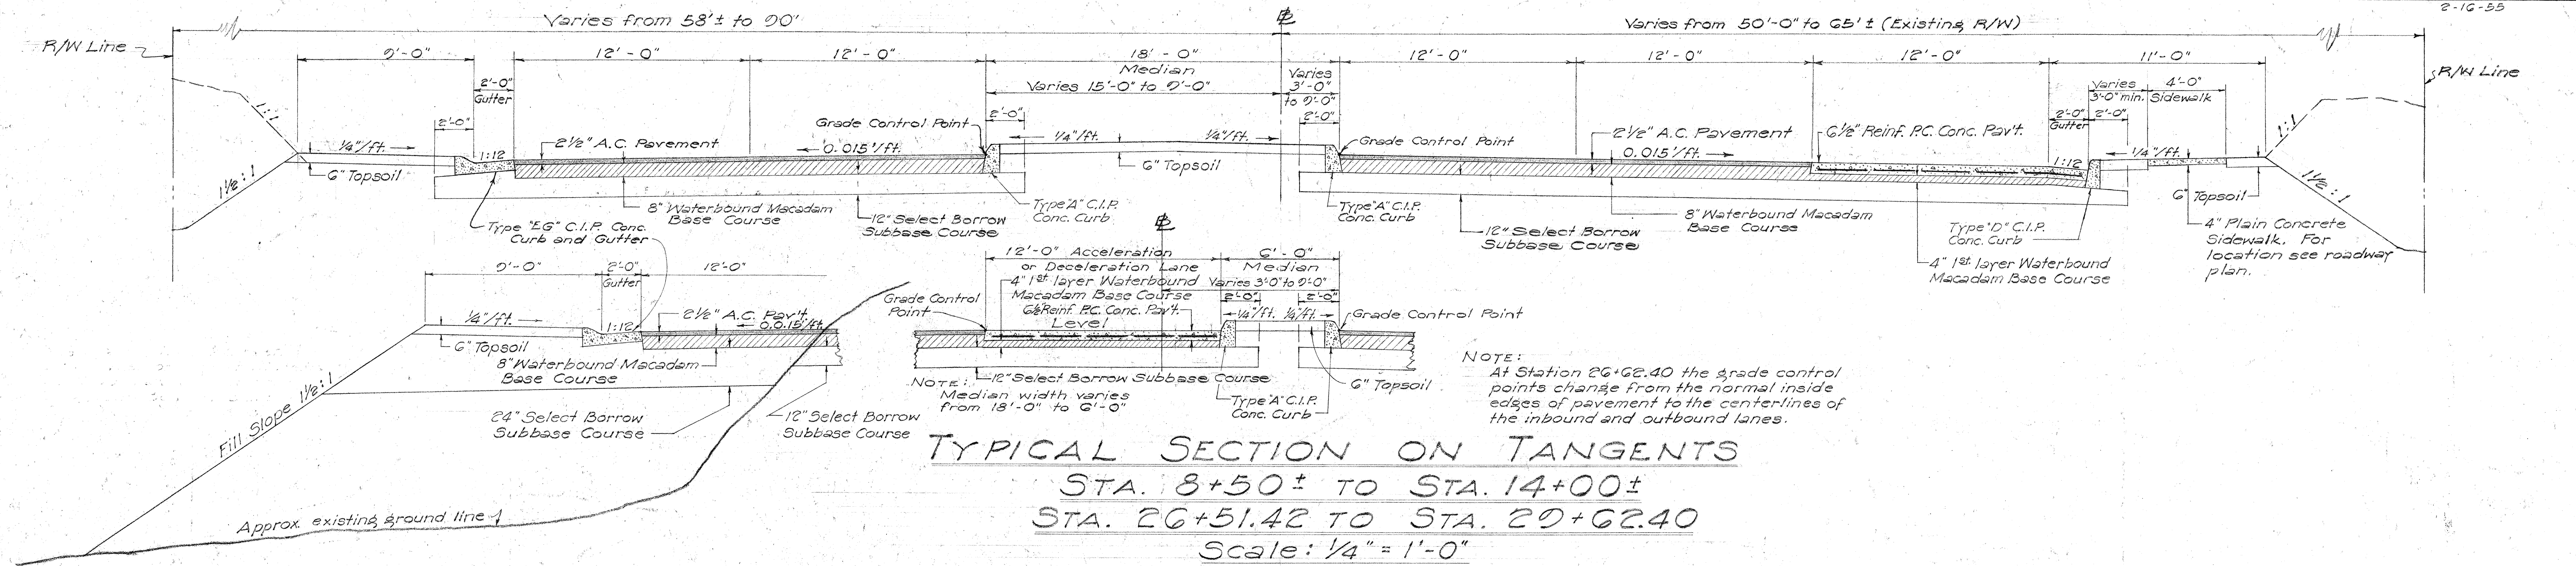

GENERAL NOTES

ASPHALT CONCRETE PAVEMENT shall be 2 1/2" thick when fully compacted and shall consist of (1) a 1 1/2" Mix No. II Leveling Course and (2) a 1" Mix No. V Surface Course.

PRIME COAT: Slow Curing Liquid Asphalt for Prime Coat shall be applied to the surface of the Base Course at the rate of 0.35 gal. per sq. yd. before placing the Leveling Course.

BASE COURSE shall be 8" thick when fully compacted and shall be laid in two layers of 4" compacted thickness Waterbound Macadam Base Course consisting of Coarse Rock No. 2 (2 1/2"-3/4") and Filler (1/2"-No. 100).

SUBBASE COURSE: In cut sections and fills less than 4 1/2" thick Select Borrow Subbase Course shall be 12" thick when fully compacted and shall be laid in one layer. On fills higher than 4 1/2" feet, Select Borrow Subbase Course shall be 24" thick when fully compacted and shall be laid in one layer. See Cross Sections for location.

GENERAL NOTES

REINFORCED CONCRETE PAVEMENT shall be Class A-1 Portland Cement Concrete 6 1/2" thick and shall be poured full width with no longitudinal contact joints or expansion joints. Weakened plane joints shall be installed on approximately 30 ft. centers. Reinforcing shall be 6 1/2" x 6 1/2" wire mesh weighing at least 40 pound per 100 square feet.

CURBS AND CURB AND GUTTER: For location of types of curbs and curb and gutters see Curb Layout Sheet No. 5746.7

GENERAL NOTES

REINFORCED CONCRETE PAVEMENT shall be Class A-1 Portland Cement Concrete 6 1/2" thick and shall be poured full width with no longitudinal contact joints or expansion joints. Weakened plane joints shall be installed on approximately 30 ft. centers. Reinforcing shall be 6 1/2" x 6 1/2" wire mesh weighing at least 40 pound per 100 square feet.

CURBS AND CURB AND GUTTER: For location of types of curbs and curb and gutters see Curb Layout Sheet No. 5746.7

TERRITORIAL HIGHWAY DEPARTMENT
 TERRITORY OF HAWAII

TYPICAL SECTION
 NUUANU AVENUE
 PROJECT NO. U 33(2)
 Scale as noted January 1955

SHEET No. OF SHEETS

5 7 4 1 6 . 2