




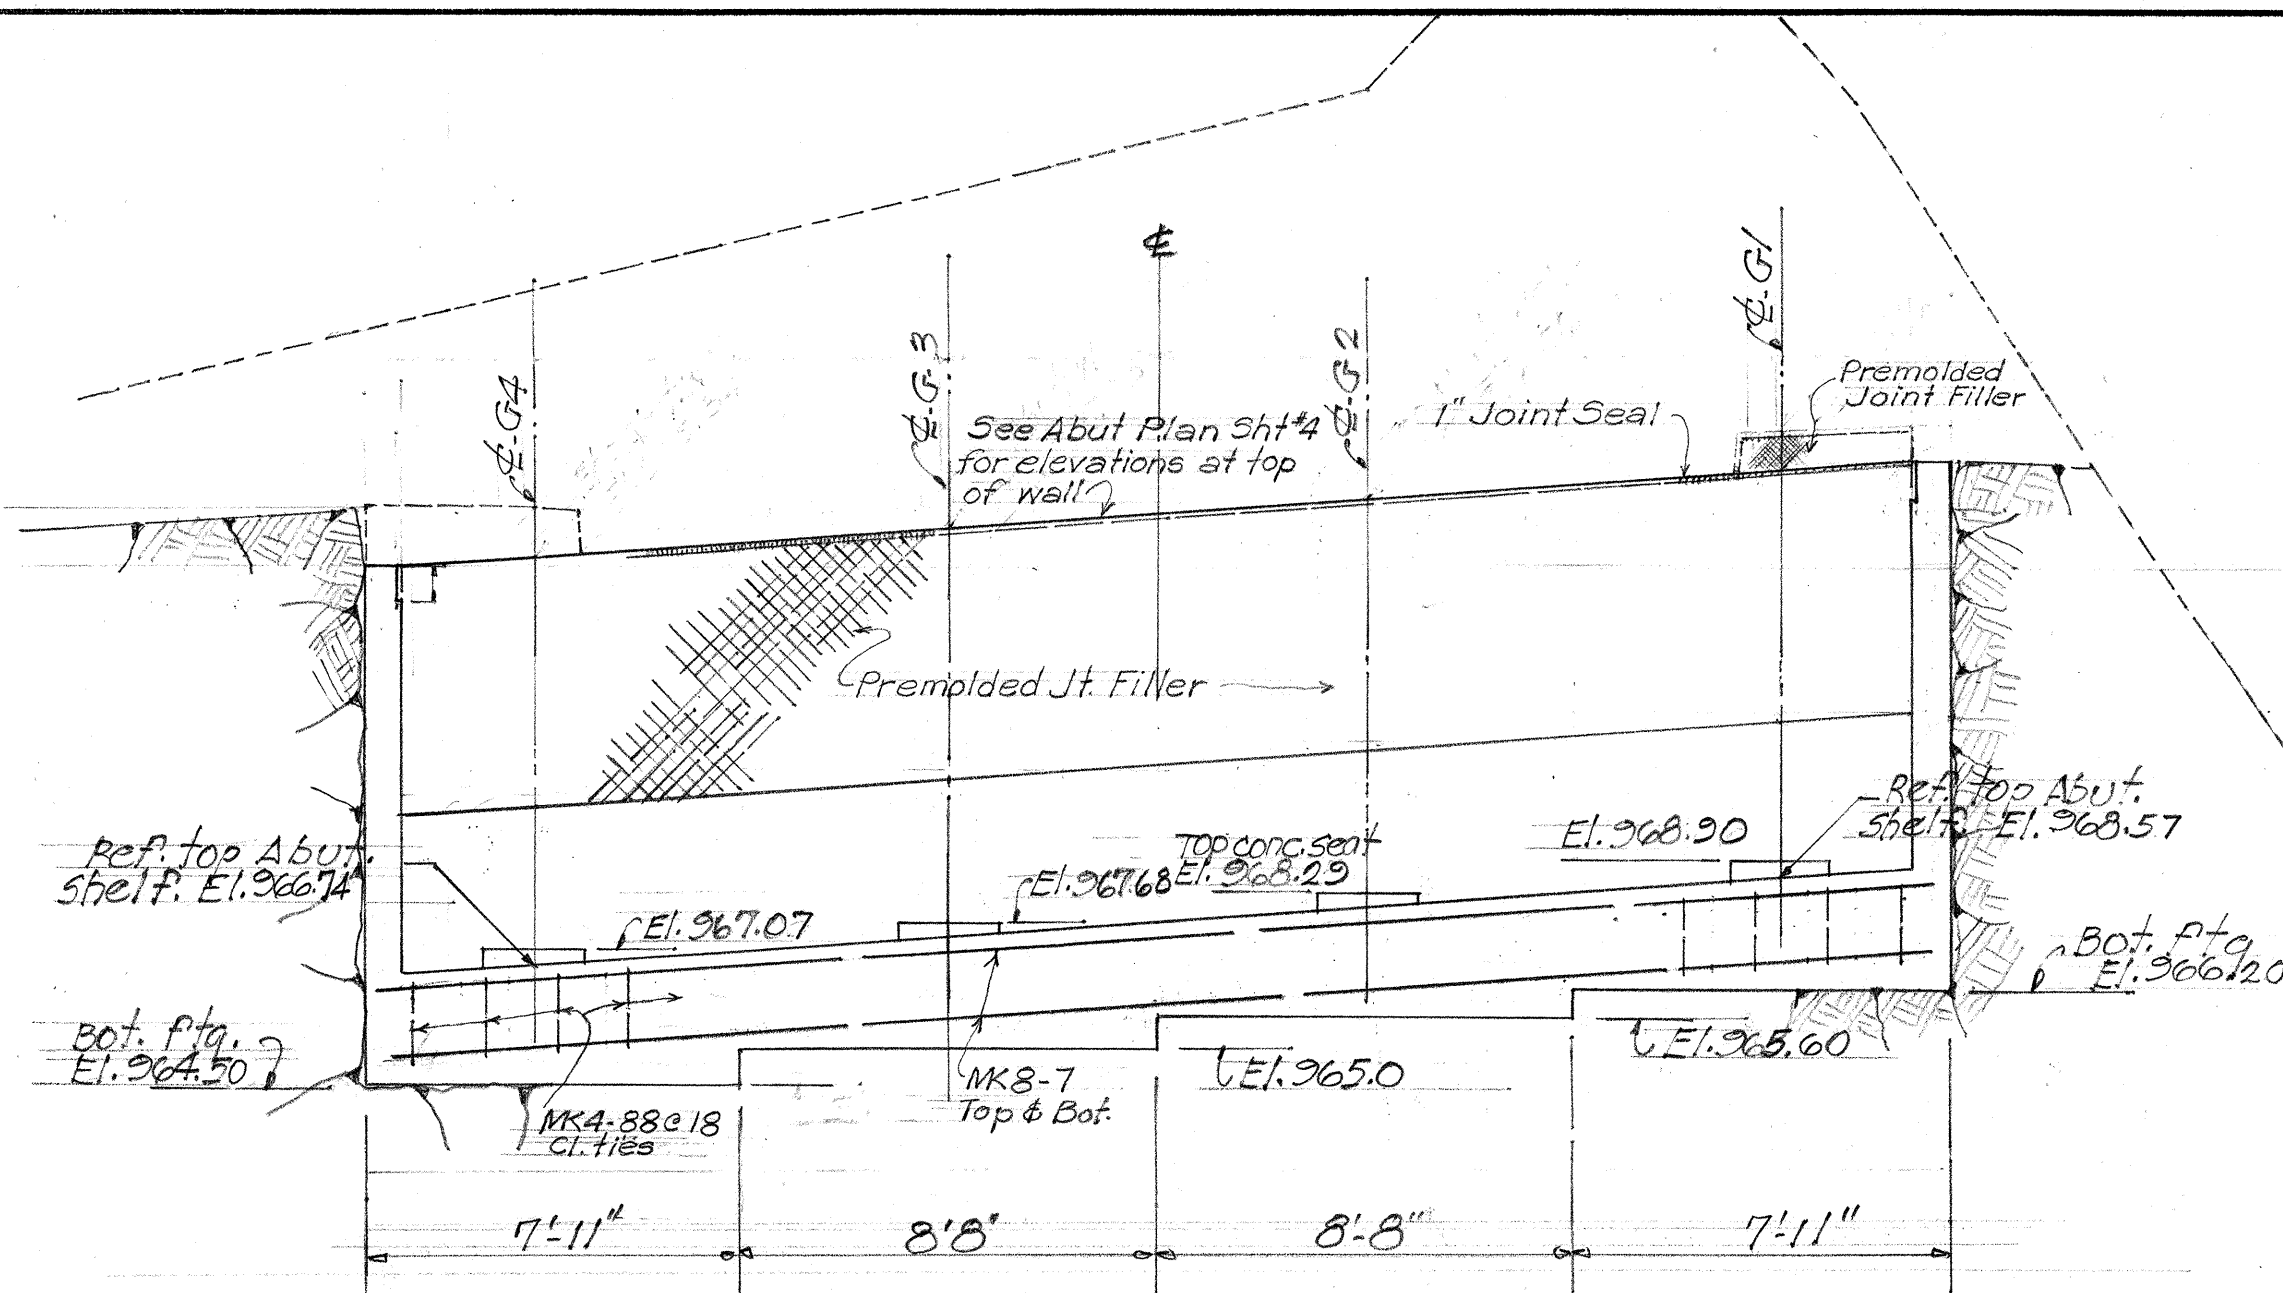


ELEVATION *E-E ABUT. NO. 1. BRIDGE NO. 3
SCALE: 1/4" = 1'-0"

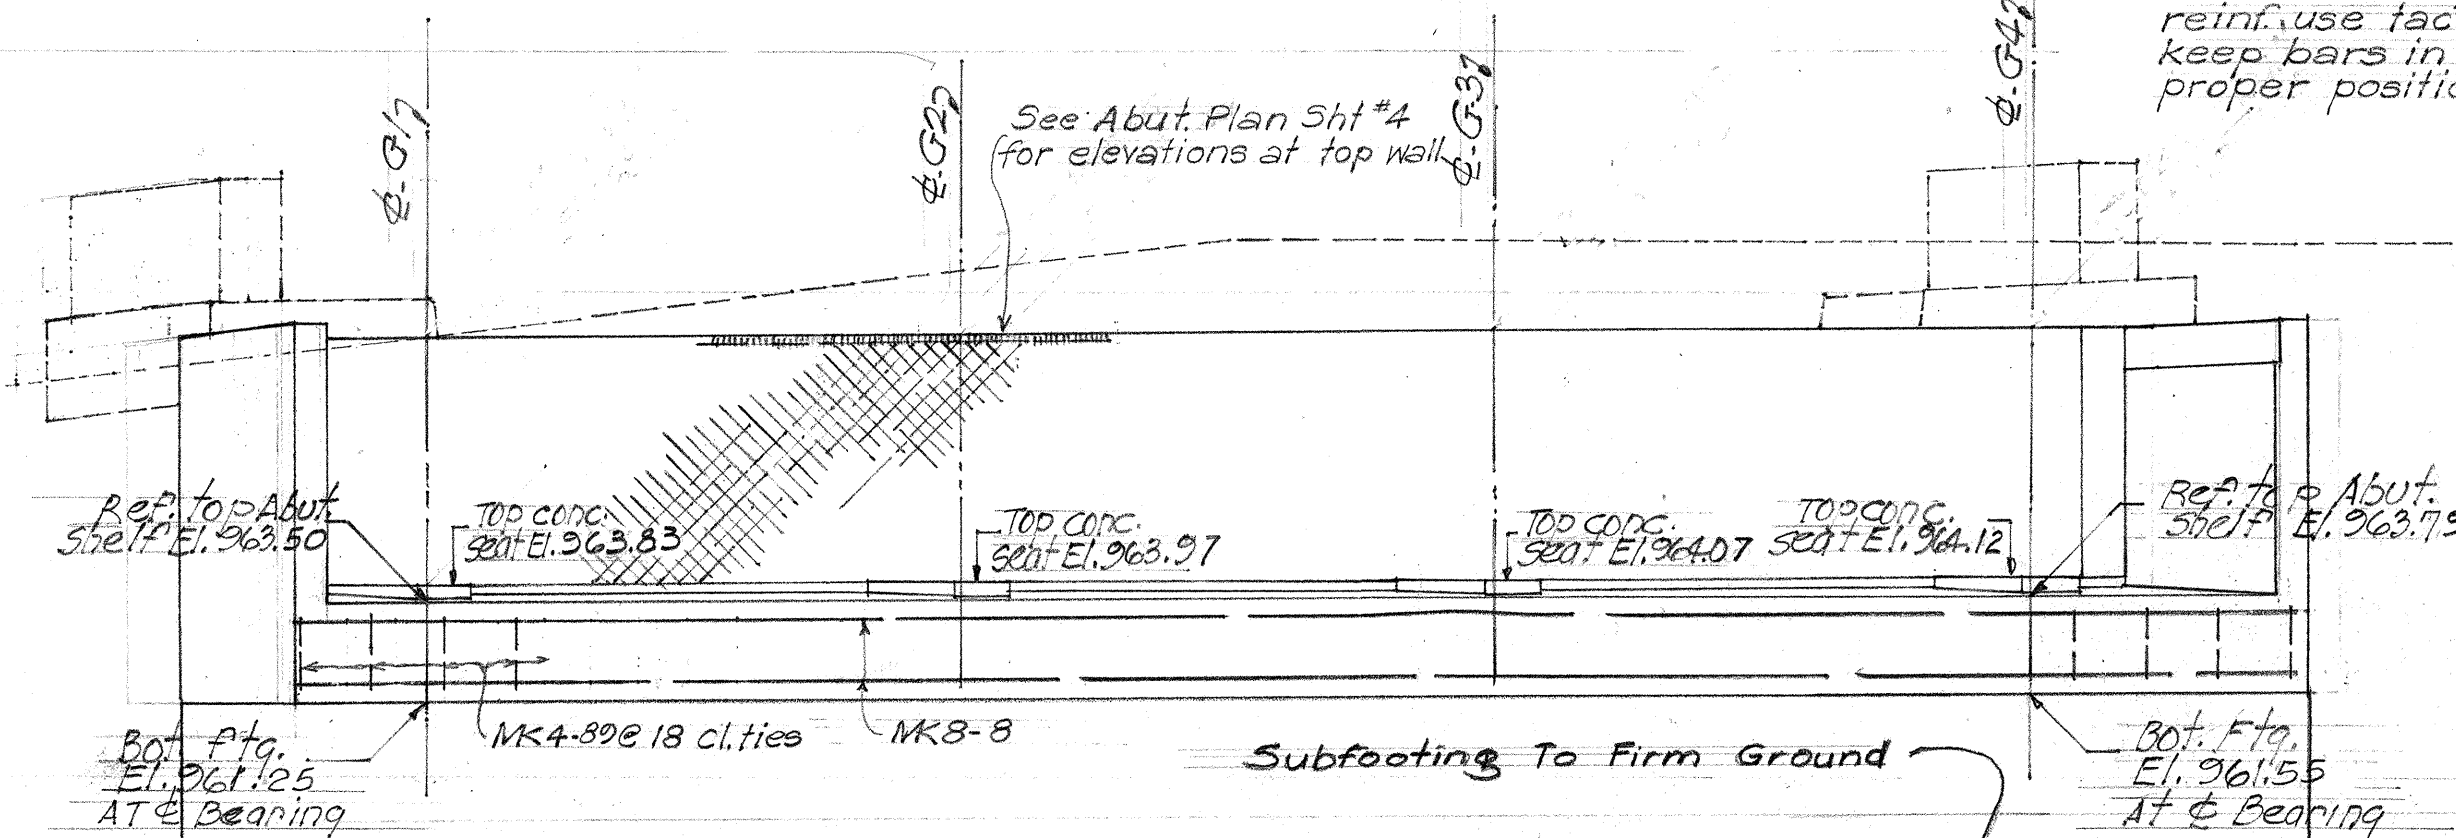


ELEVATION *F-F ABUT. NO. 2. BRIDGE NO. 3
SCALE: 1/4" = 1'-0"

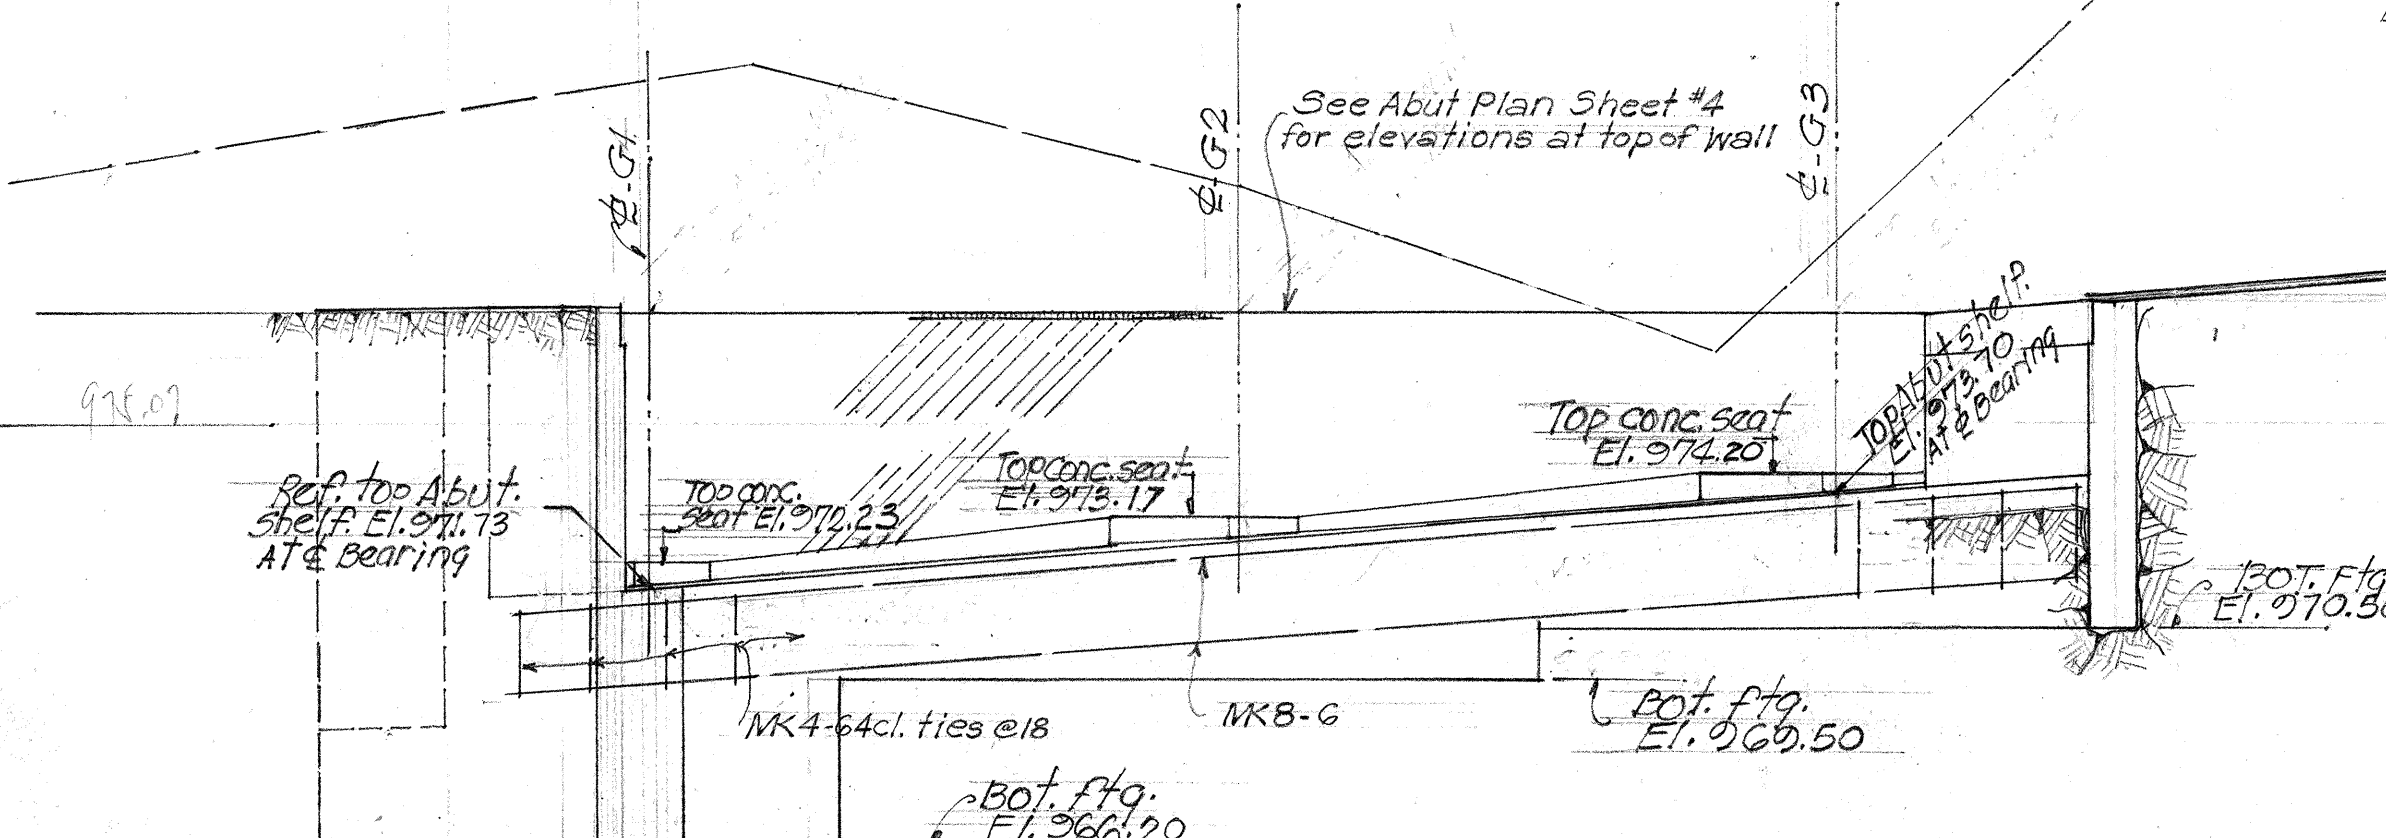


ELEVATION *G-G ABUT. NO. 2. PARTIAL BR. #2
SCALE: 1/4" = 1'-0"

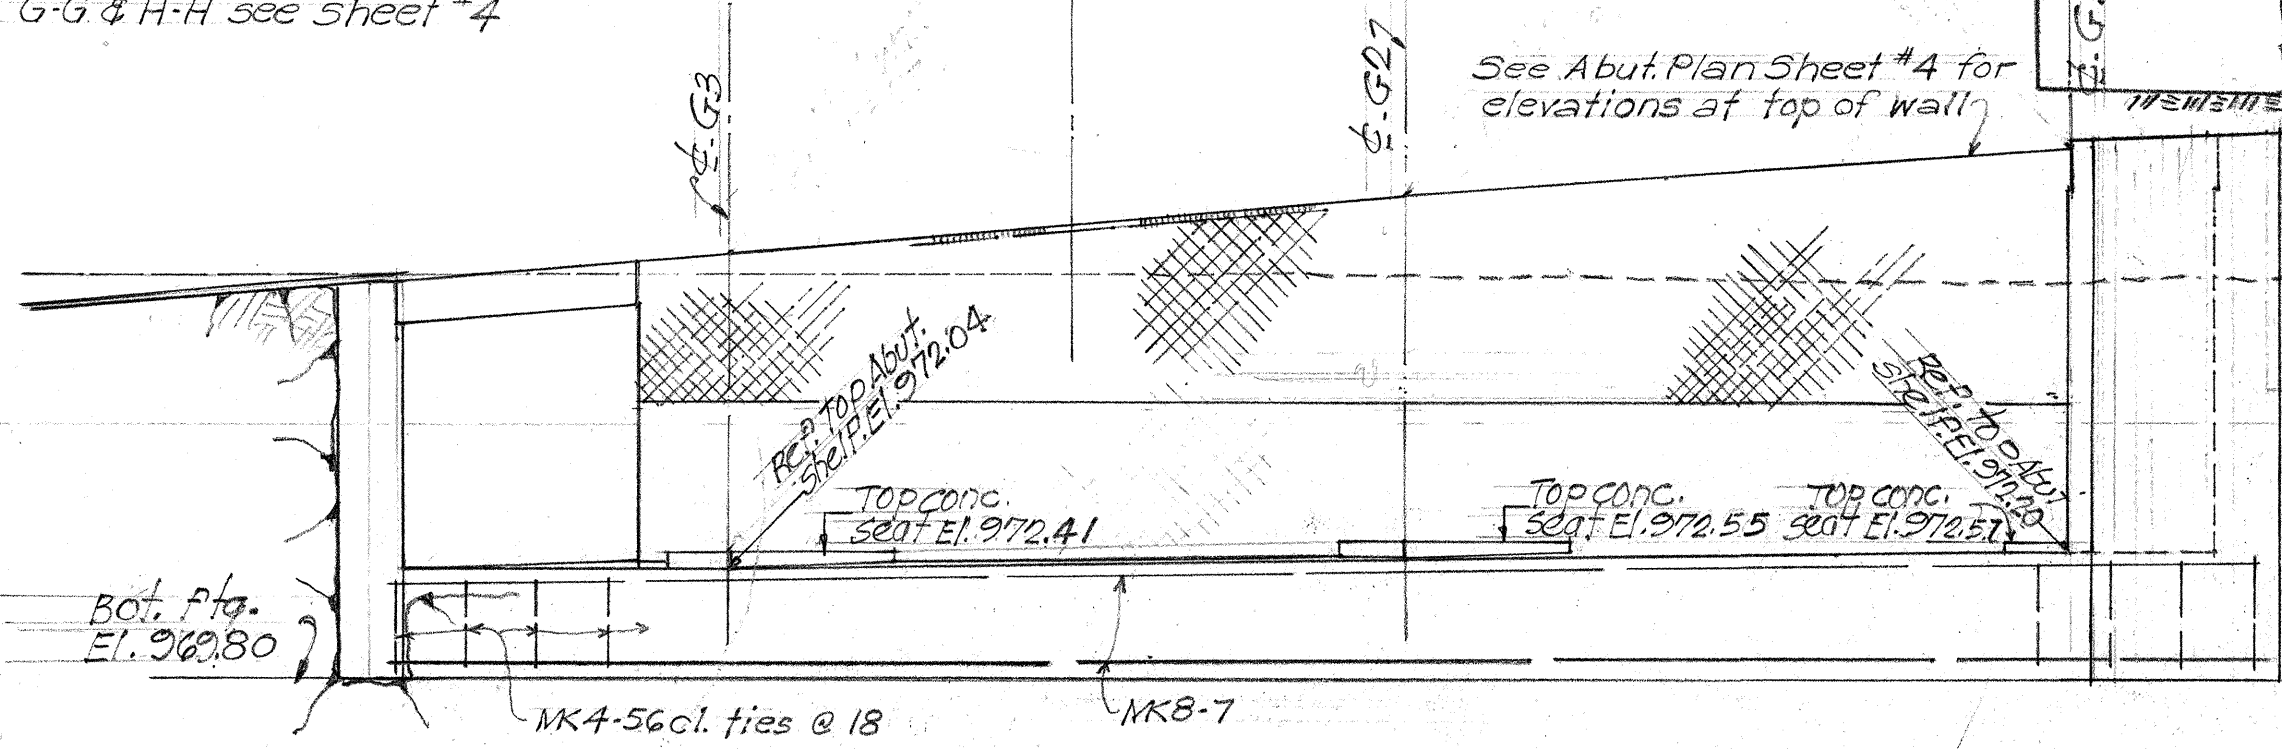


ELEVATION *H-H ABUT. NO. 1. PARTIAL BR. #2
SCALE: 1/4" = 1'-0"

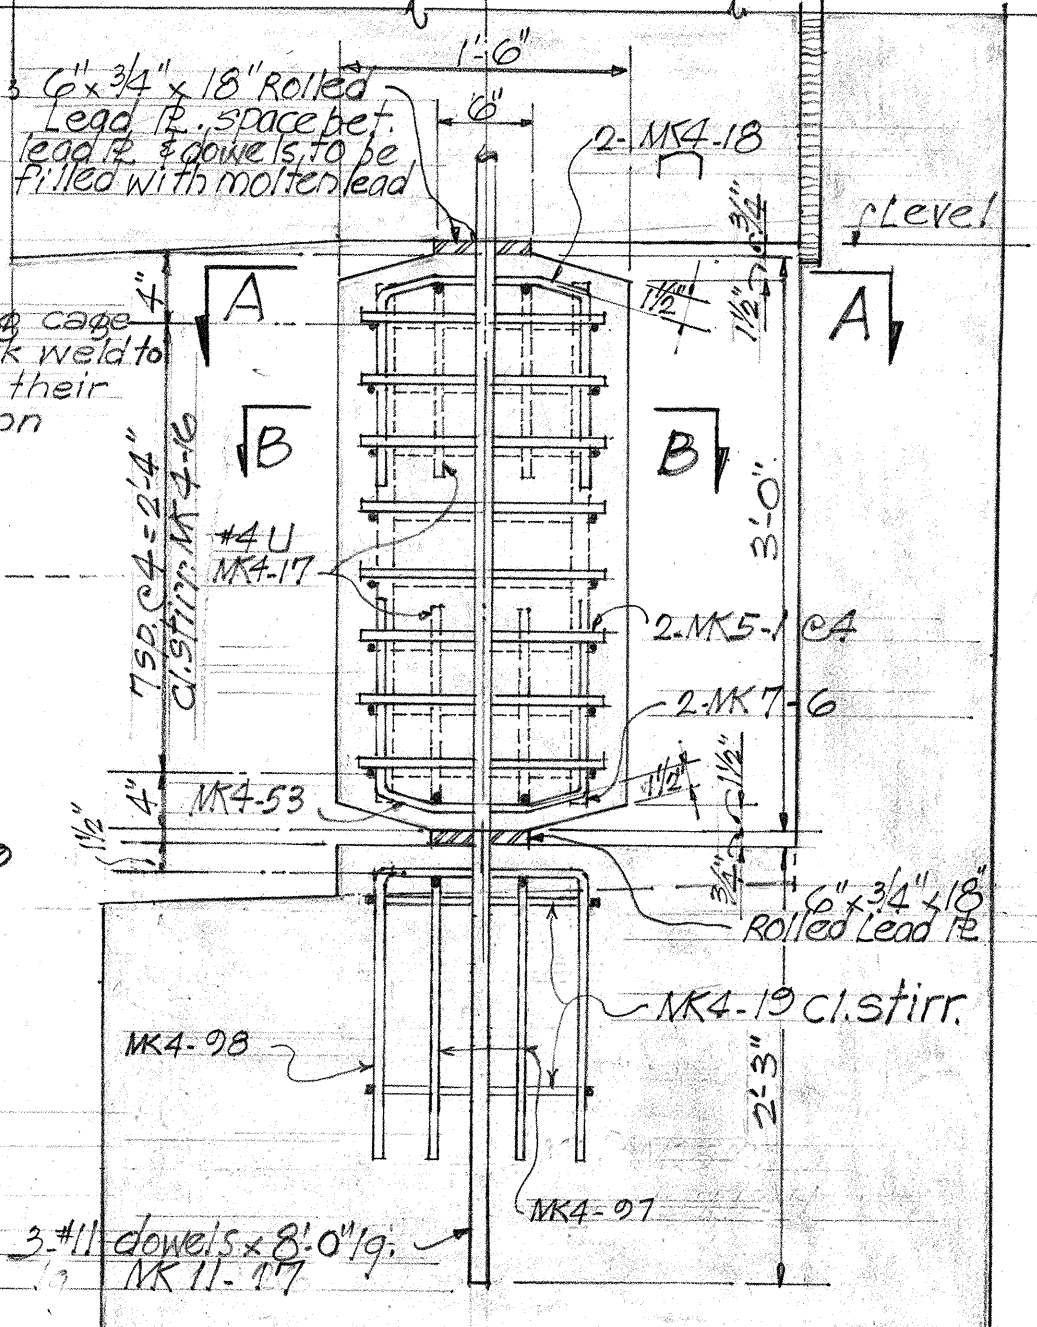


TYPICAL ROCKER DETAIL
SCALE: 1" = 1'-0"

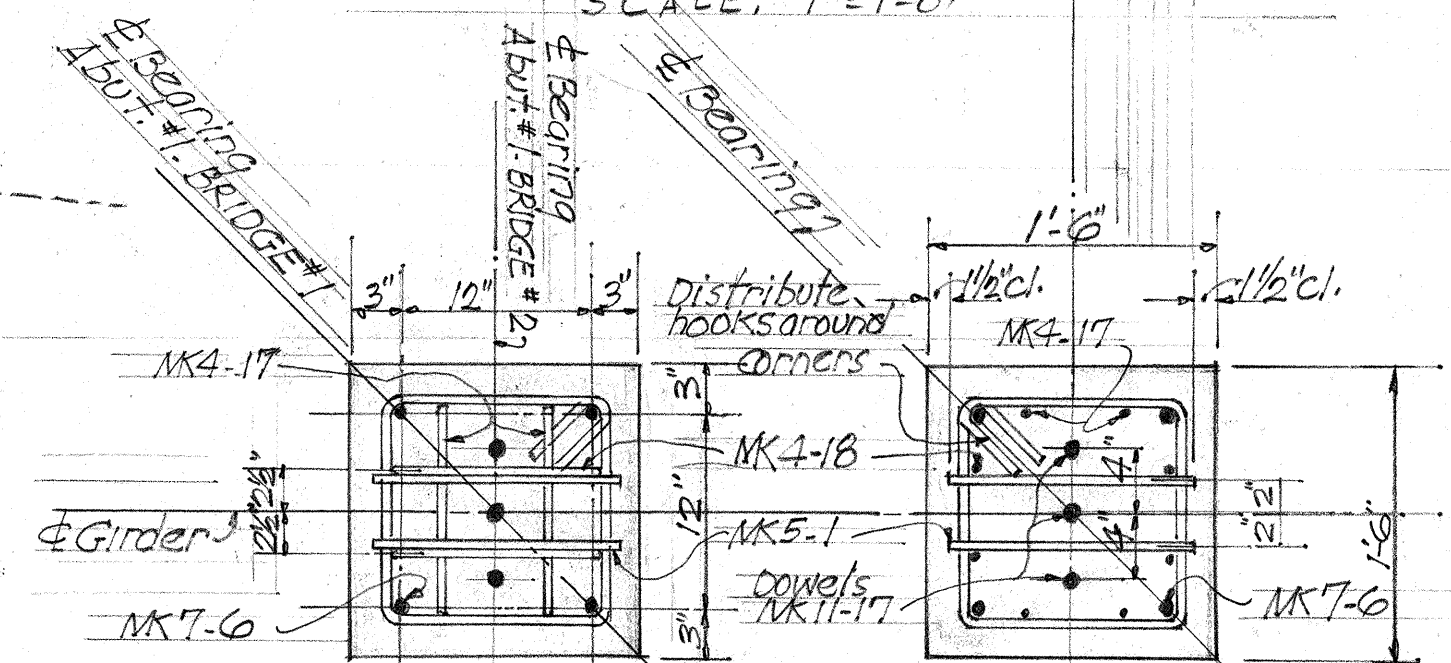


SECTION "A-A" SECTION "B-B"
SCALE: 1" = 1'-0"

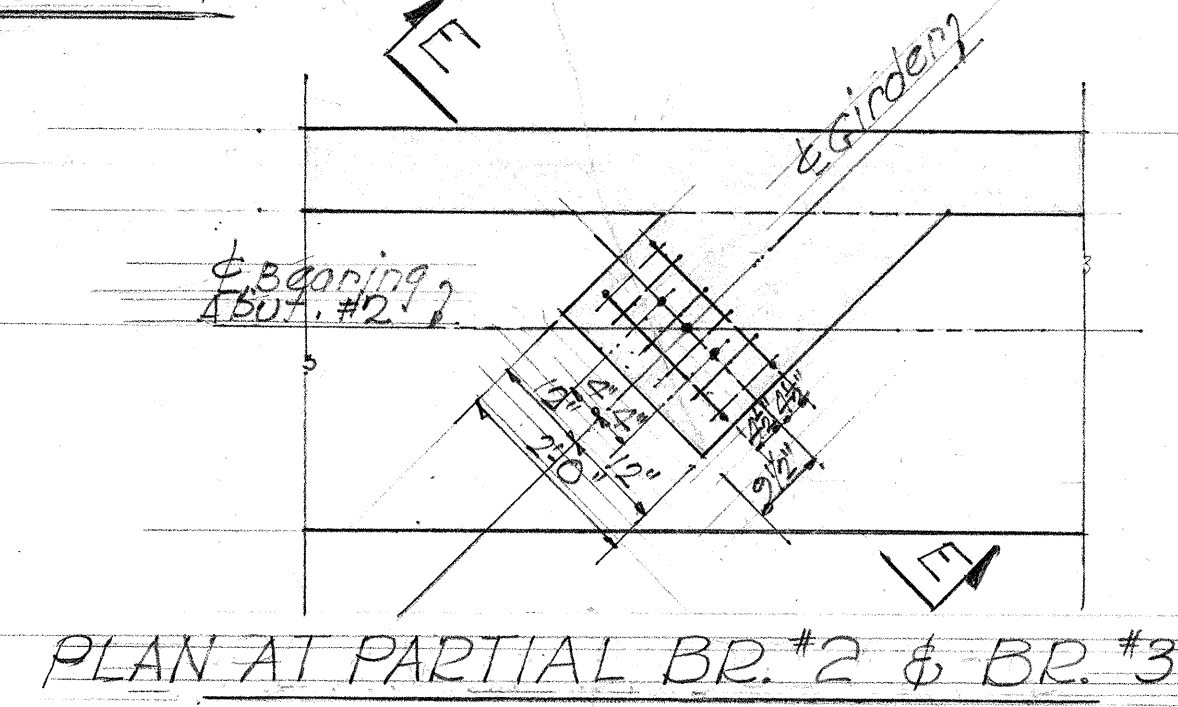


PLAN AT PARTIAL BR. #2 & BR. #3

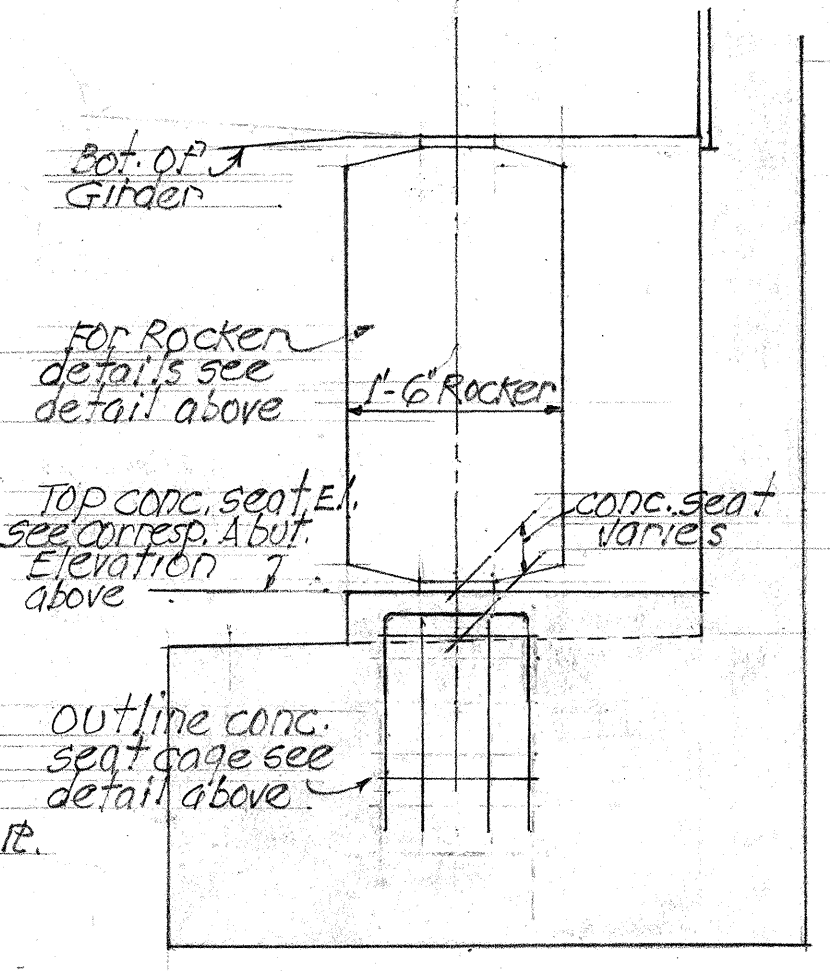


SECTION "C-C"

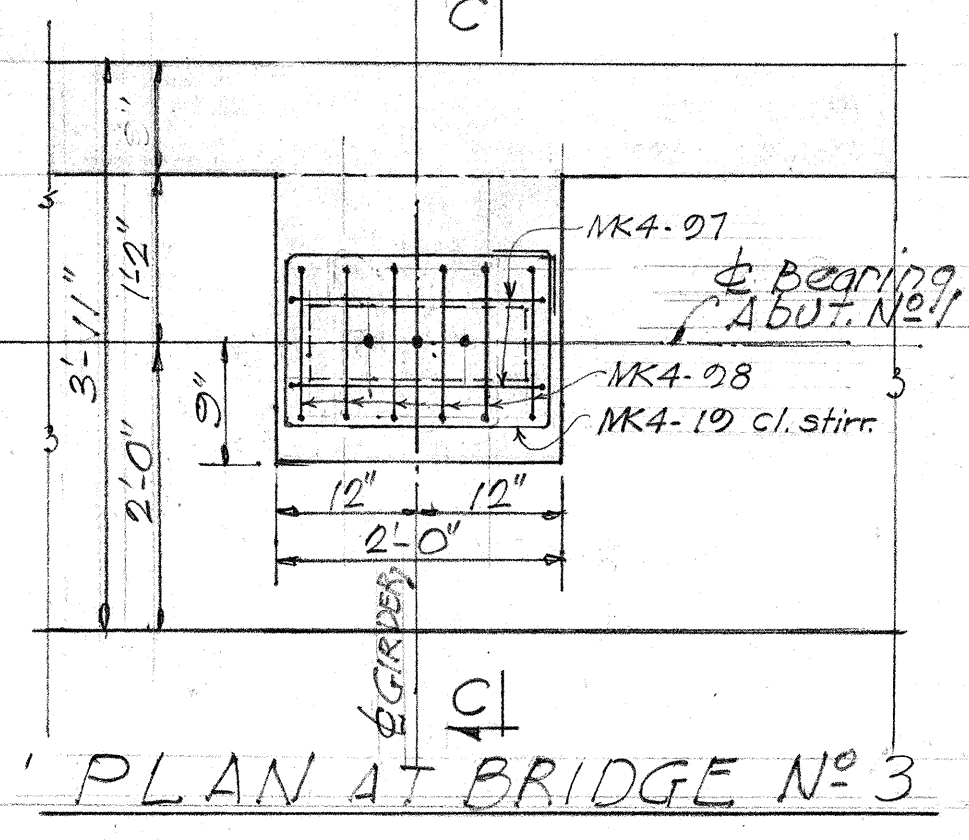


PLAN AT BRIDGE NO. 3

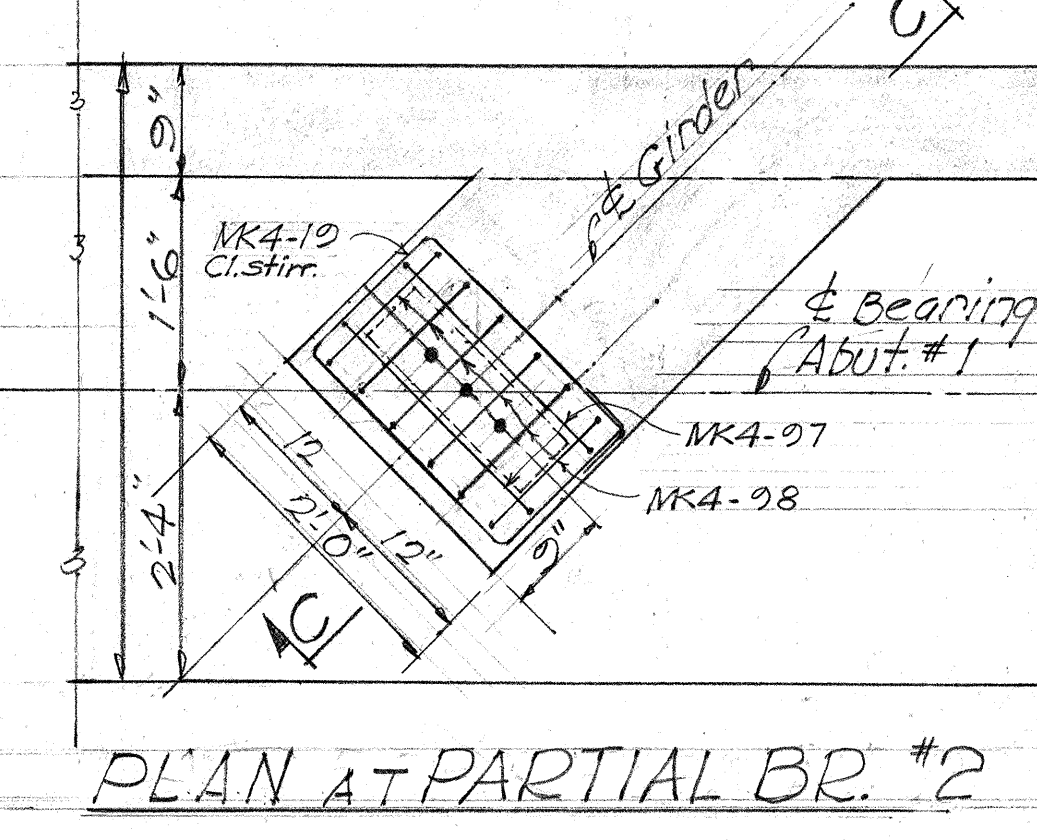

PLAN AT PARTIAL BR. #2


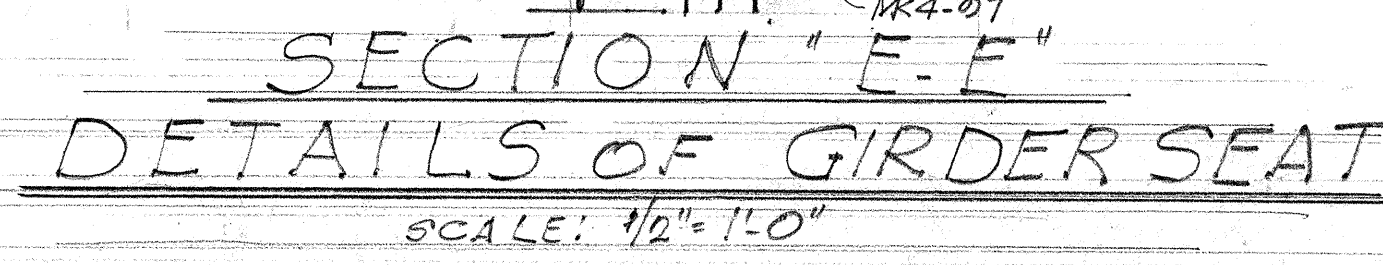


SECTION "E-E" DETAILS OF GIRDER SEAT
SCALE: 1/2" = 1'-0"



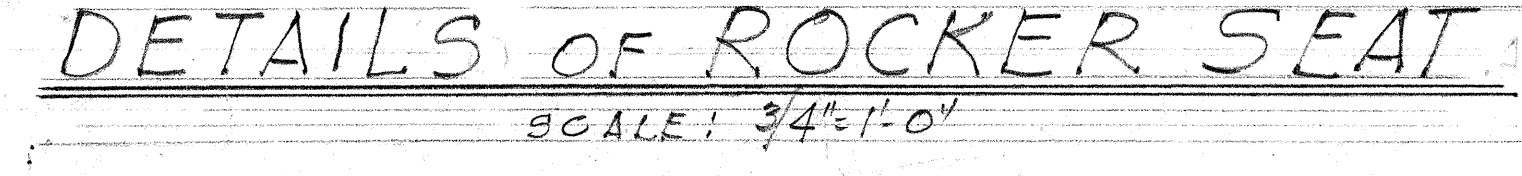


DETAILS OF ROCKER SEAT
SCALE: 3/4" = 1'-0"

TERRITORIAL HIGHWAY DEPARTMENT
TERRITORY OF HAWAII
PARTIAL BRIDGE #2 Sta. 107+72.55 to Sta. 108+35.00
BRIDGE #3 Sta. 108+35.00 to Sta. 109+47.55
Pali Road (Tunnel Section) Proj. 5216(5)
June 1954
SHEET No. 5 OF 12 SHEETS

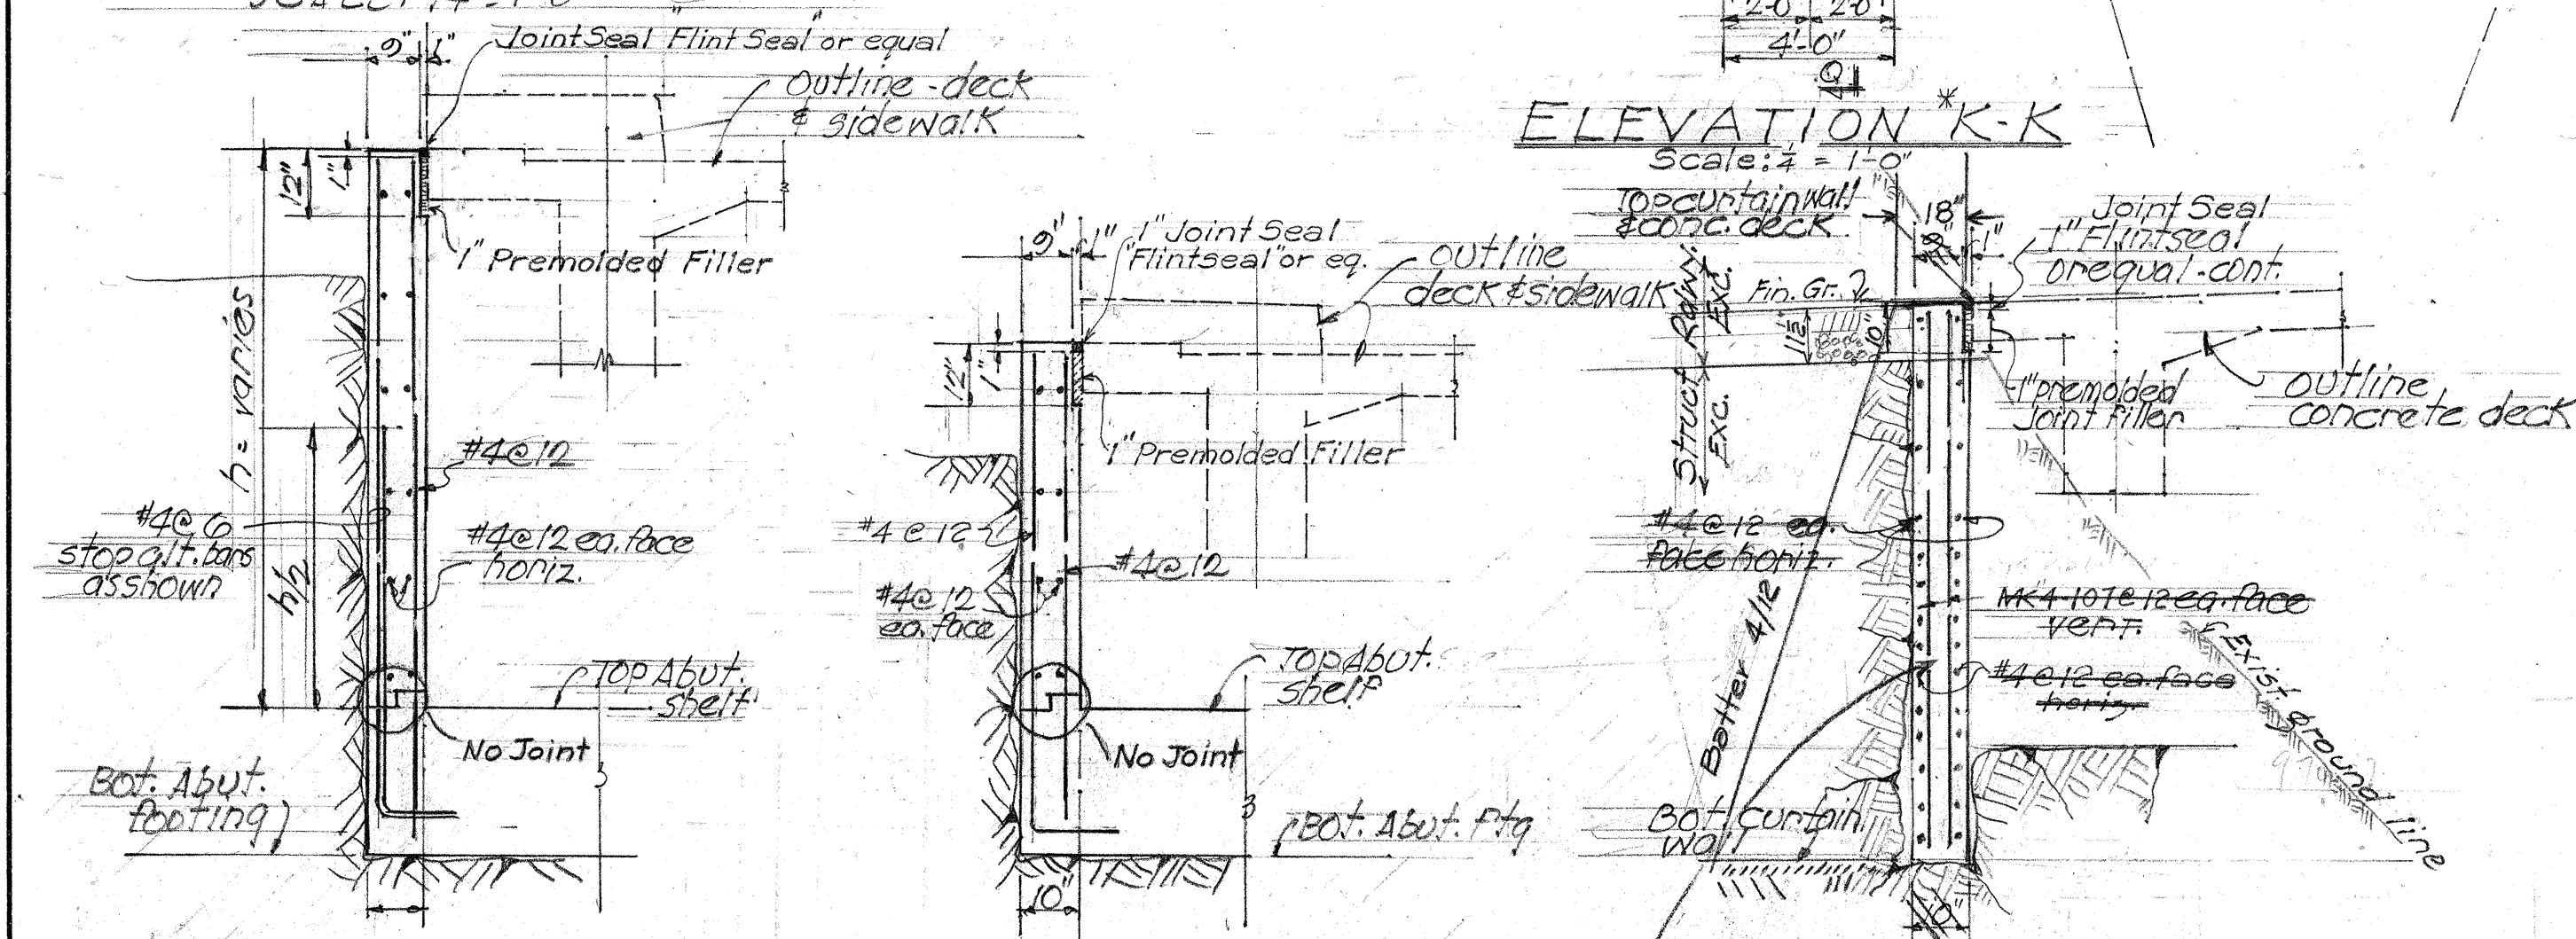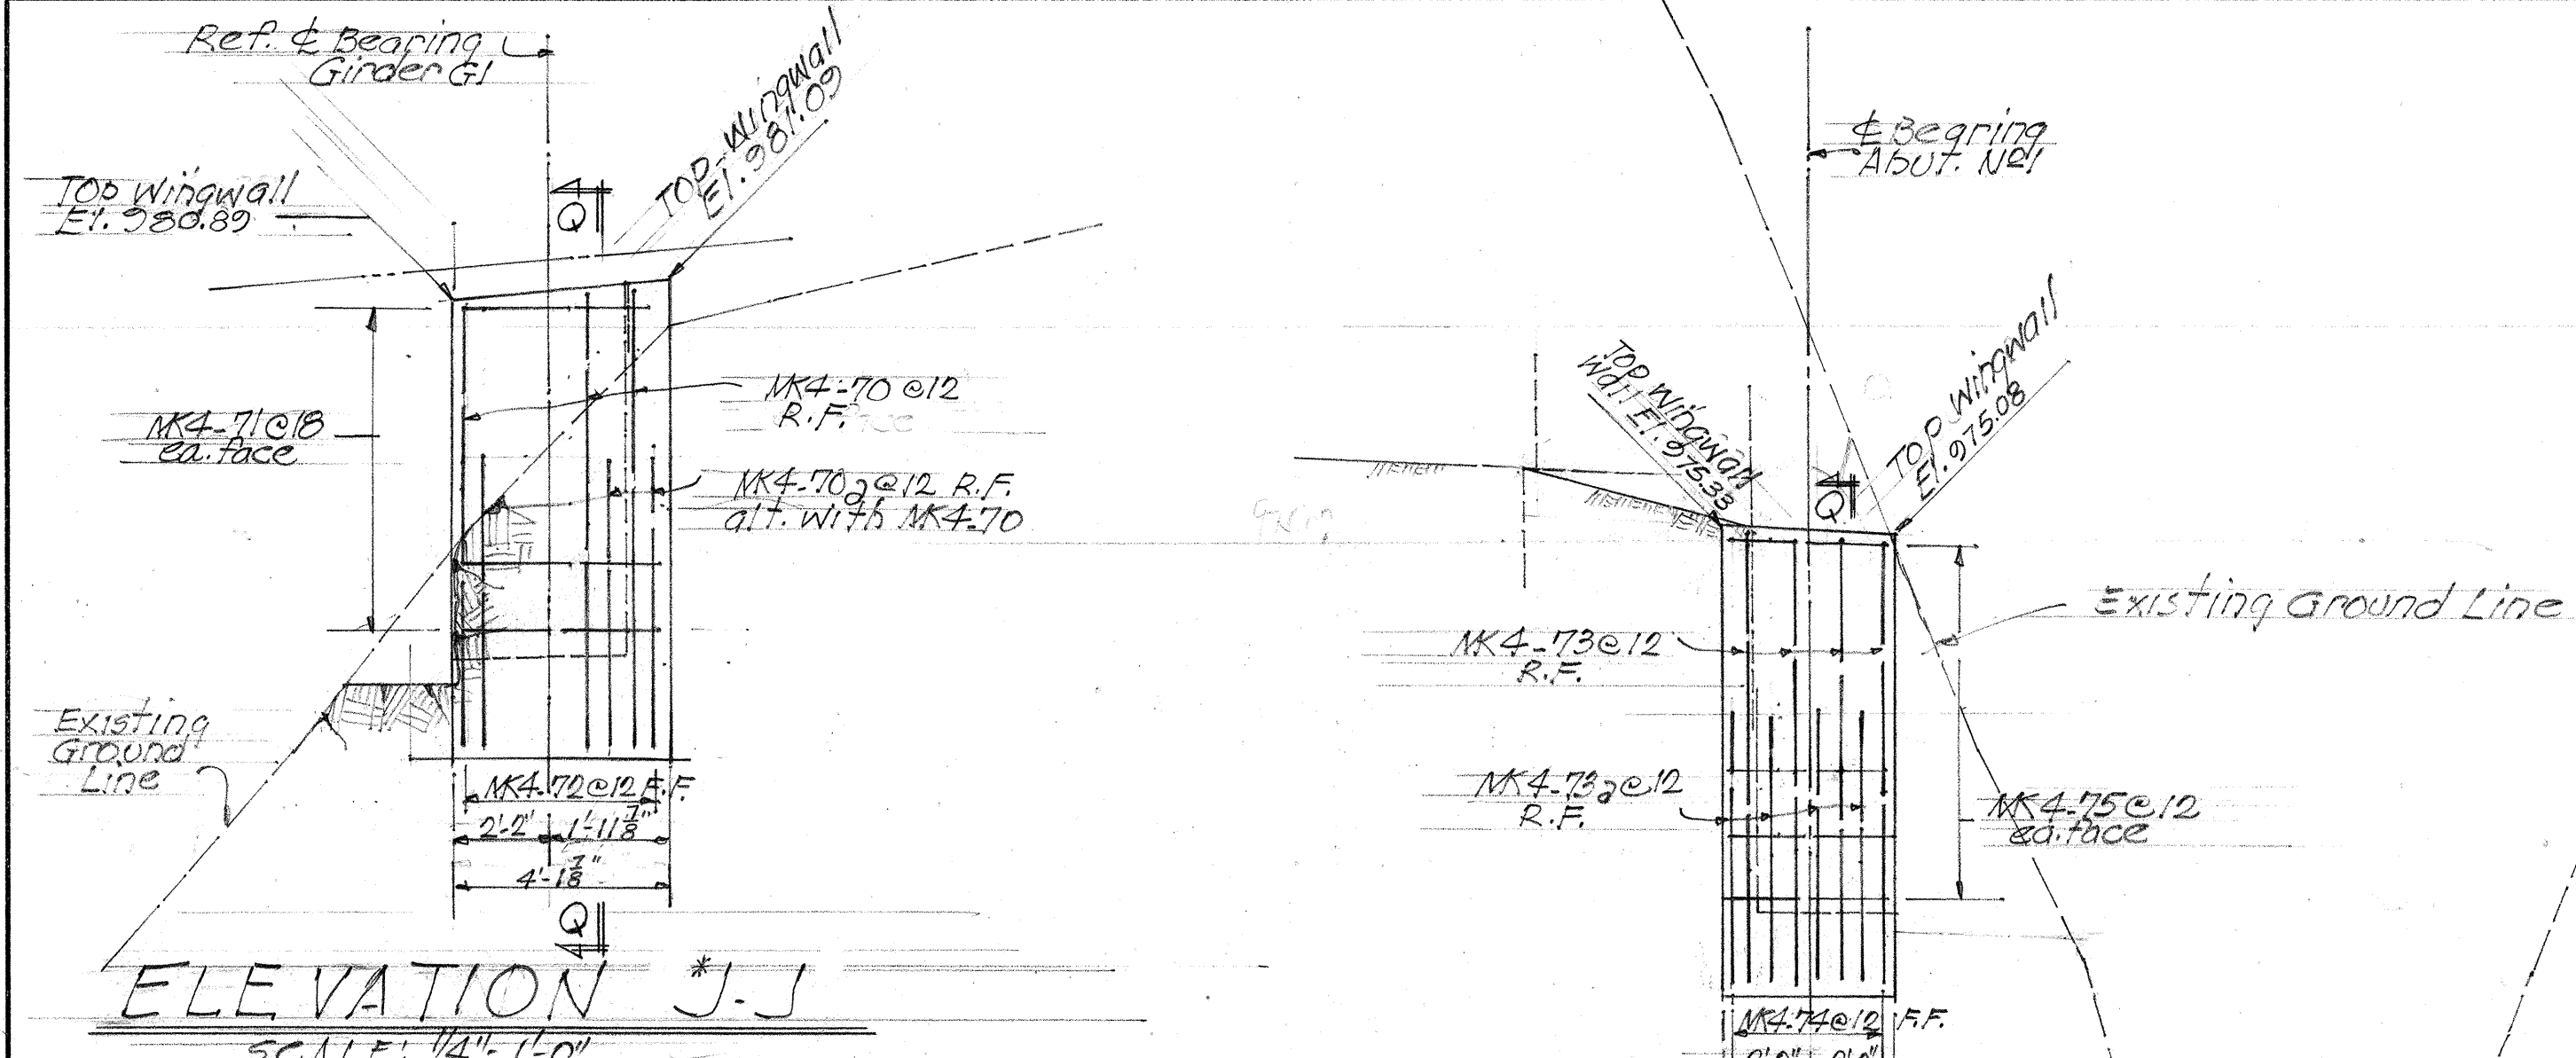


SECTION "Q-Q" SECTION "R-R" SECTION "S-S"
TYPICAL SECTIONS THRU ABUT. WING WALL

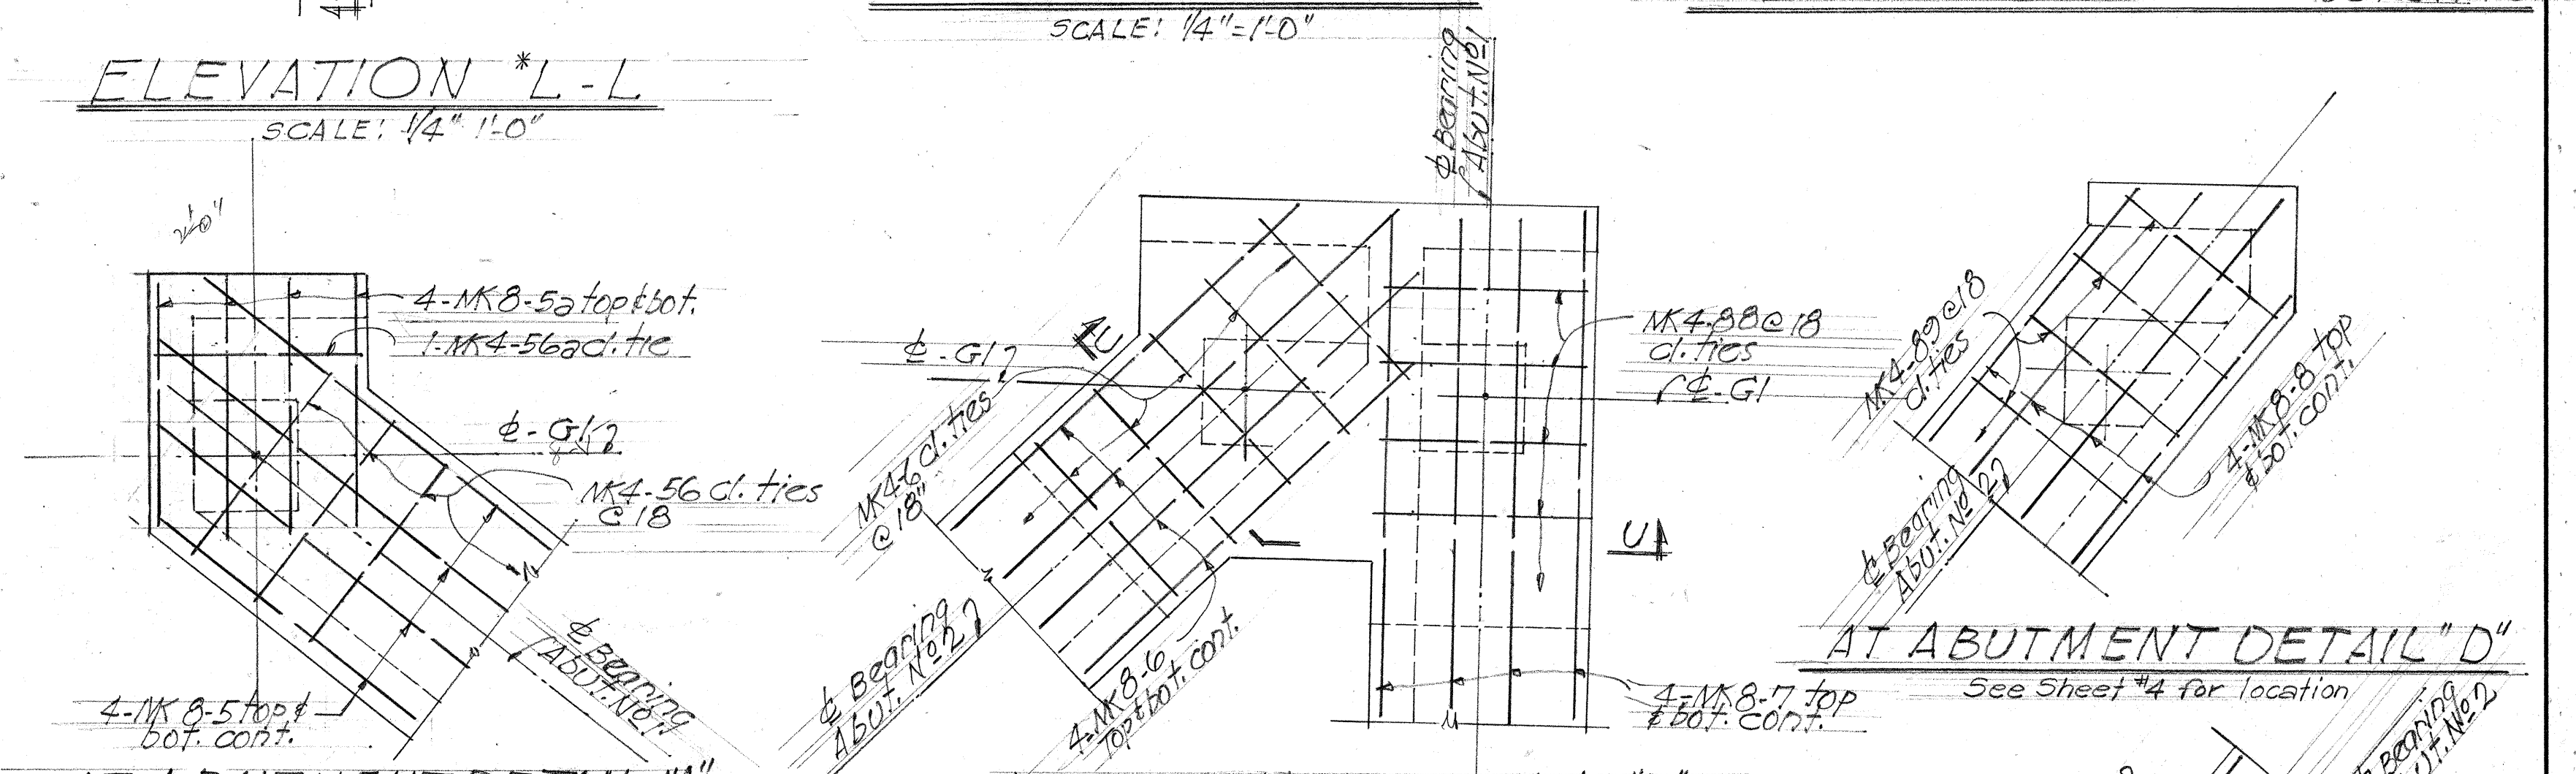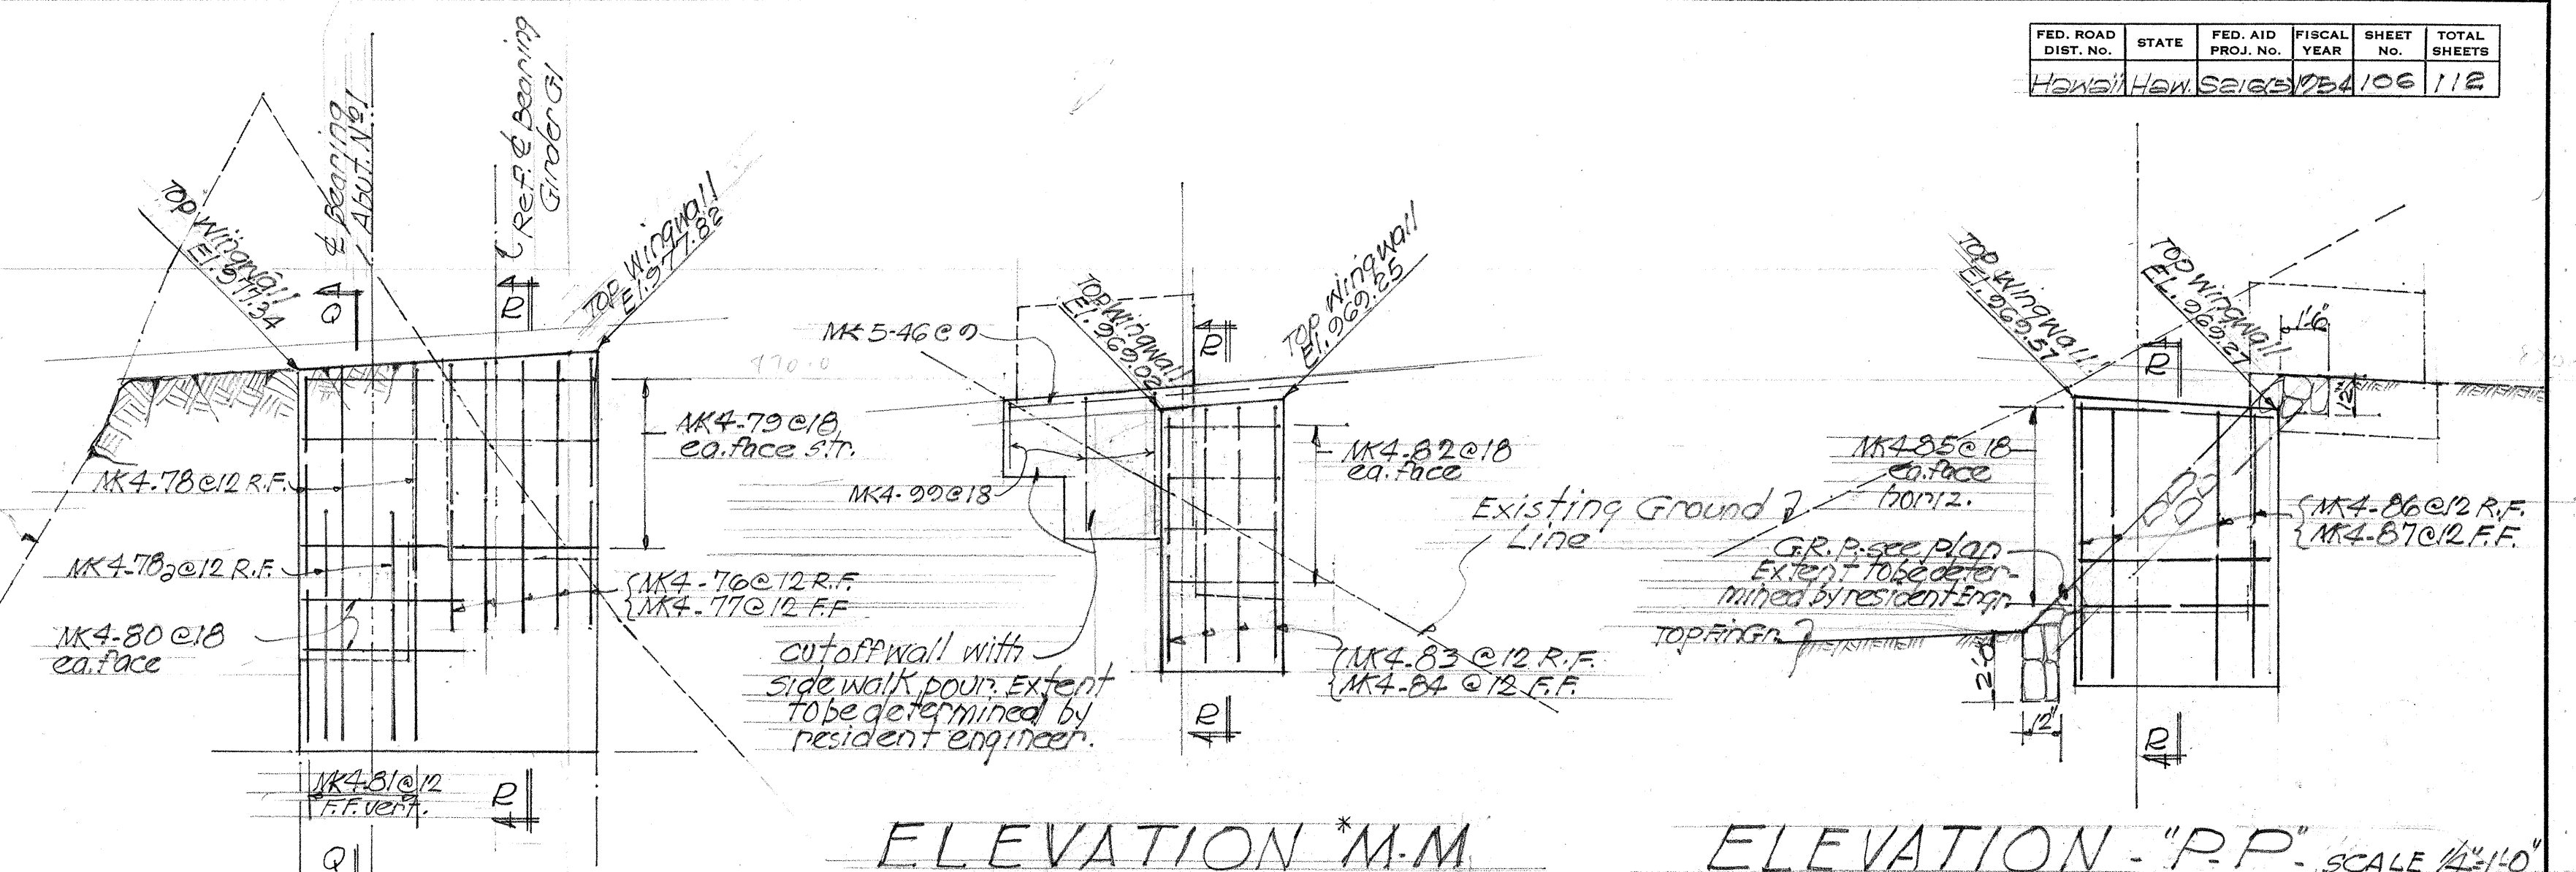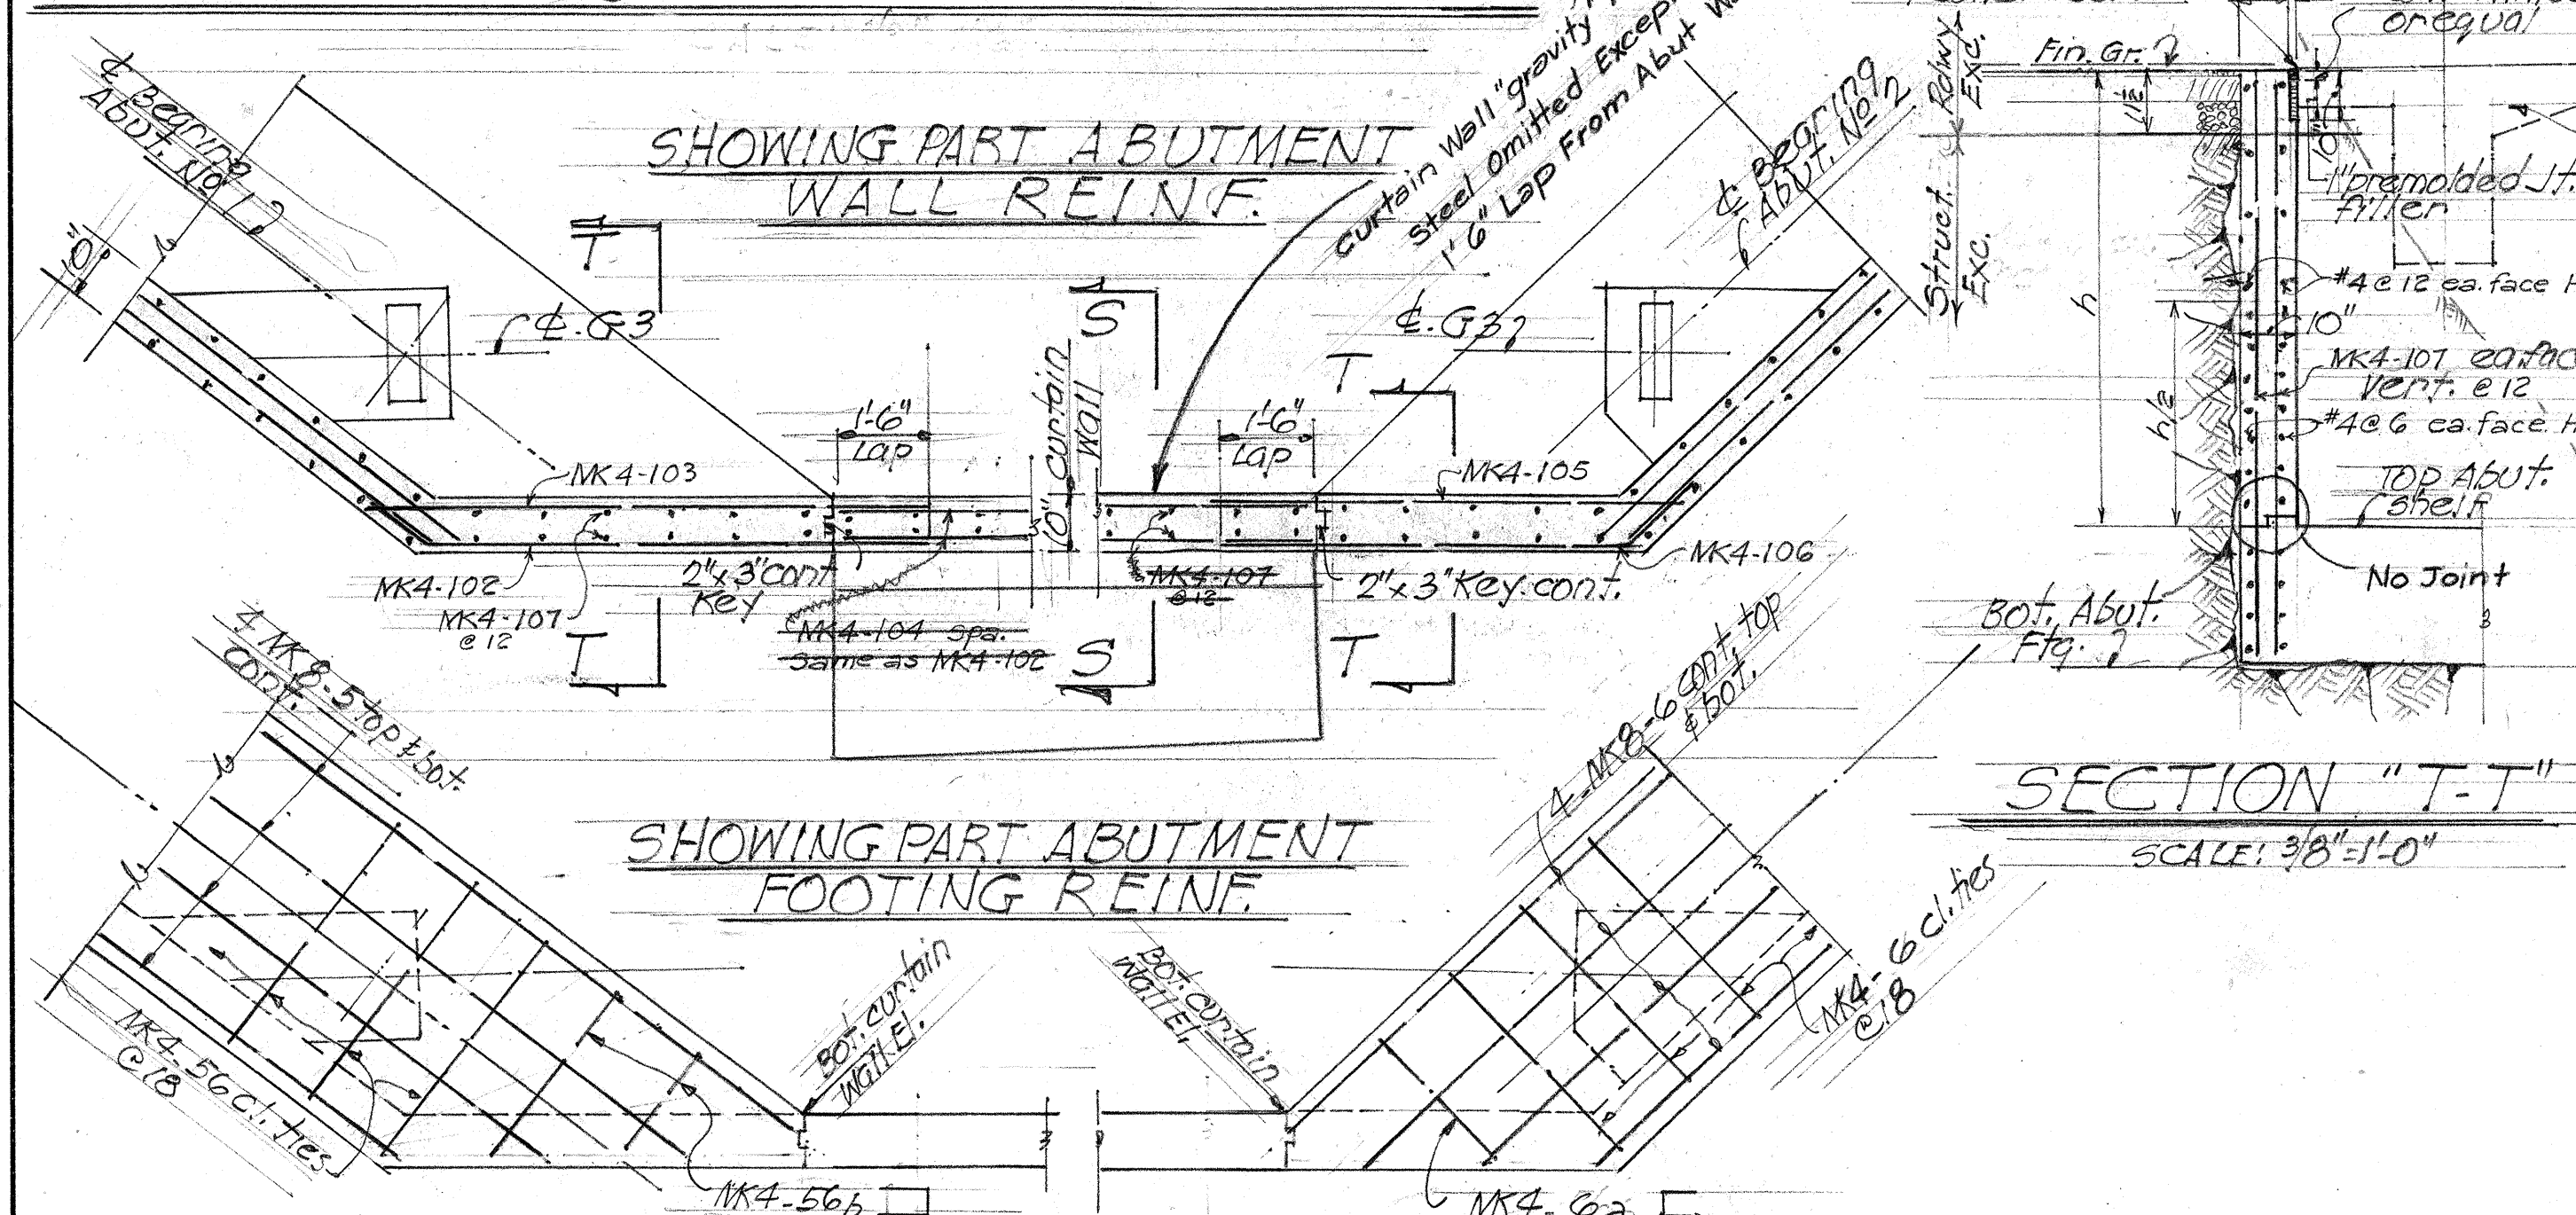

AT ABUTMENT DETAIL "A" AT ABUTMENT DETAIL "B" AT ABUTMENT DETAIL "D"
See Sheet #4 for location

PART PLAN - SHOWING ARRANGEMENT OF ABUTMENT FOOTING REINFORCEMENT
SCALE: 1/4"=1'-0"

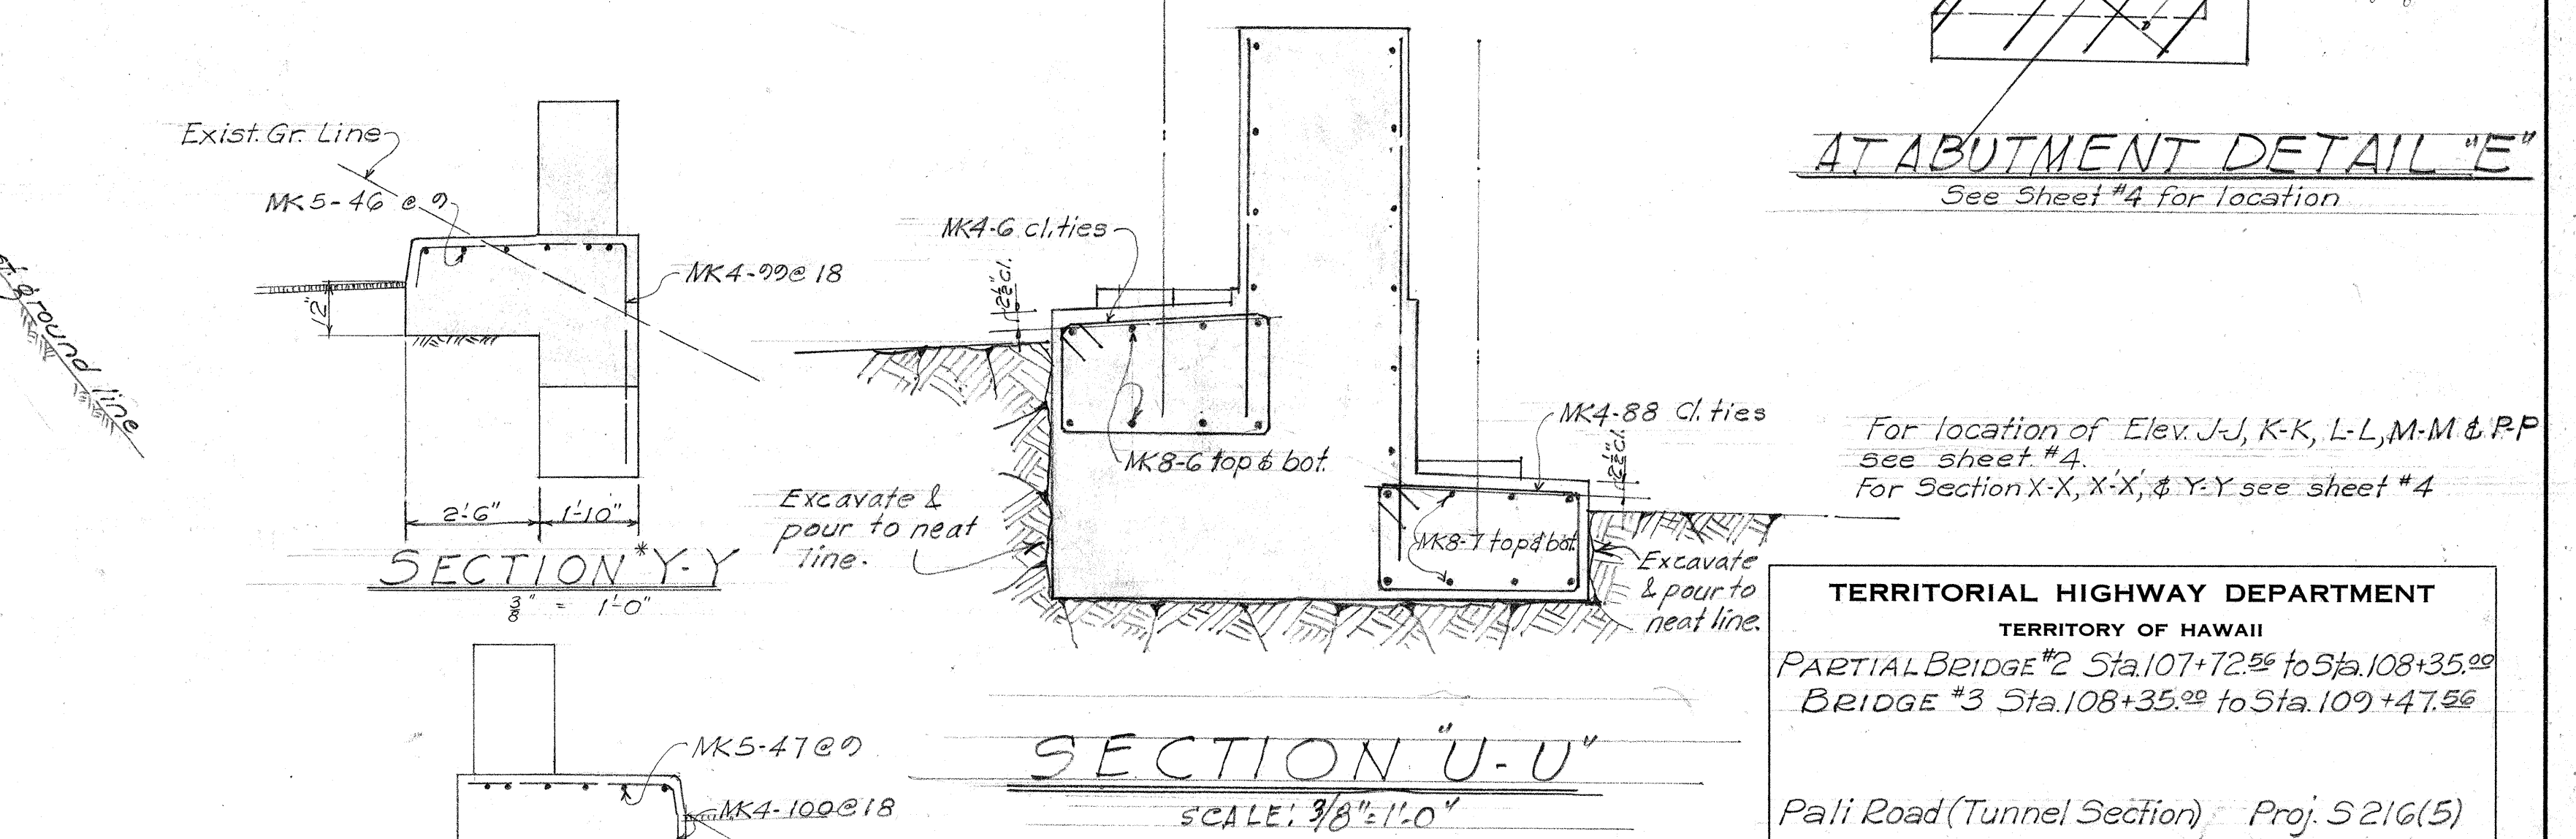

SECTION "U-U"
SCALE: 3/8"=1'-0"

TERRITORIAL HIGHWAY DEPARTMENT
TERRITORY OF HAWAII
PARTIAL BRIDGE #2 Sta. 107+72.56 to Sta. 108+35.29
BRIDGE #3 Sta. 108+35.29 to Sta. 109+47.56
Pali Road (Tunnel Section) Proj. S216(5)
June 1954