


GENERAL CONDUIT DATA

- 3-2" CONDUITS SHALL BE INSTALLED BETWEEN T.H.D. SIDEWALK JUNCTION BOXES & HANDHOLES FROM PORTAL #1 TO PORTAL #2.
- 1-2" CONDUIT SHALL BE INSTALLED BETWEEN H.T.CO. JUNCTION BOX FROM PORTAL #1 TO PORTAL #4.
- EACH H.T.CO. WALL PHONE BOX SHALL BE CONNECTED TO H.T.CO. JUNCTION BOX WITH 3/4" CONDUIT.
- FOR CONDUIT RUNS AT EACH PORTAL, SEE PORTAL ELECTRICAL PLANS.
- FOR CONDUITS REQUIRED FOR C.O. SAMPLING SYSTEM, SEE C.O. SAMPLING SYSTEM DWG.
- ALL UNUSED CONDUITS TO BE EQUIPPED WITH #12 GALVANIZED PULL WIRE.

LEGEND

- H.T.CO. HANDHOLE
- H.T.CO. WALL PHONE BOX, FIRE EXTINGUISHER & EMERGENCY LIGHT STATION.
- H.T.CO. SIDEWALK JUNCTION BOX
- T.H.D. SIDEWALK ELEC. JUNCTION BOX
- T.H.D. HANDHOLE
- C.O. SAMPLER
- C.O. SIDEWALK OR WALL JUNCTION BOX
- ⊗ ROADWAY LIGHT. FOR STATION NUMBER SEE LIGHTING PLAN.
- ⊗ ROADWAY LIGHT WITH TRAFFIC SIGNAL.
- 3W— CONDUIT RUN - 3W INDICATES 3-2" CONDUITS, 2W INDICATES 2-2" CONDUITS, ETC.

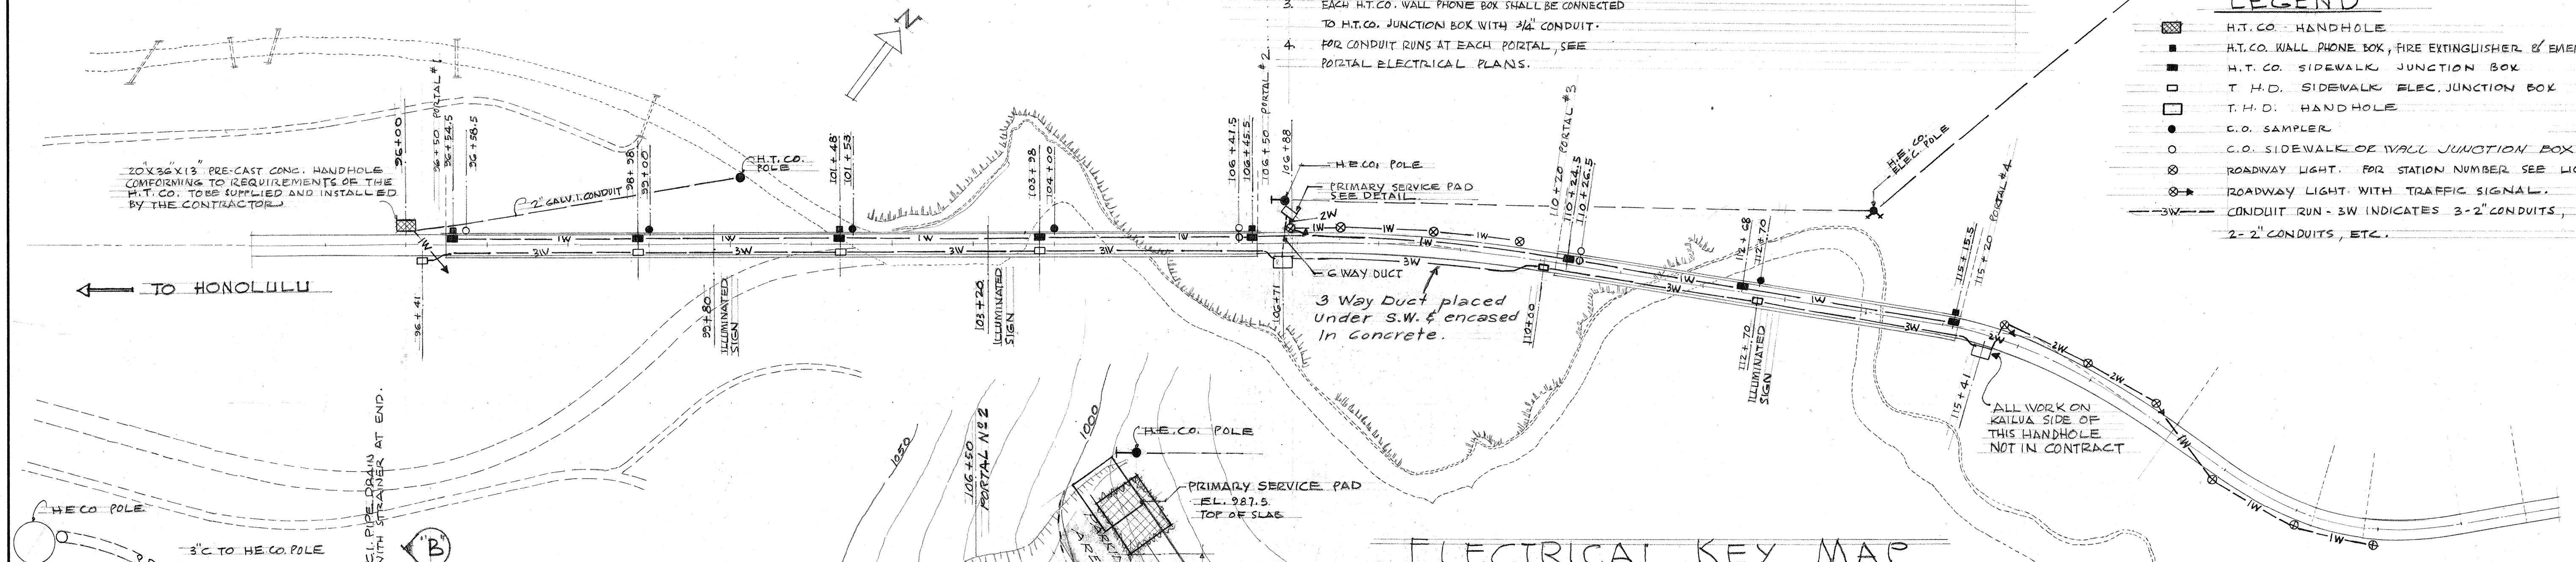




ELECTRICAL KEY MAP

SCALE: 1" = 100'-0"

NOTE: PAD MAY BE MOVED 50'-0" MAX. FROM LOCATION SHOWN IF DIRECTED BY ENGINEER.

LOCATION OF PRIMARY SERVICE PAD

SCALE: 1" = 20'-0"

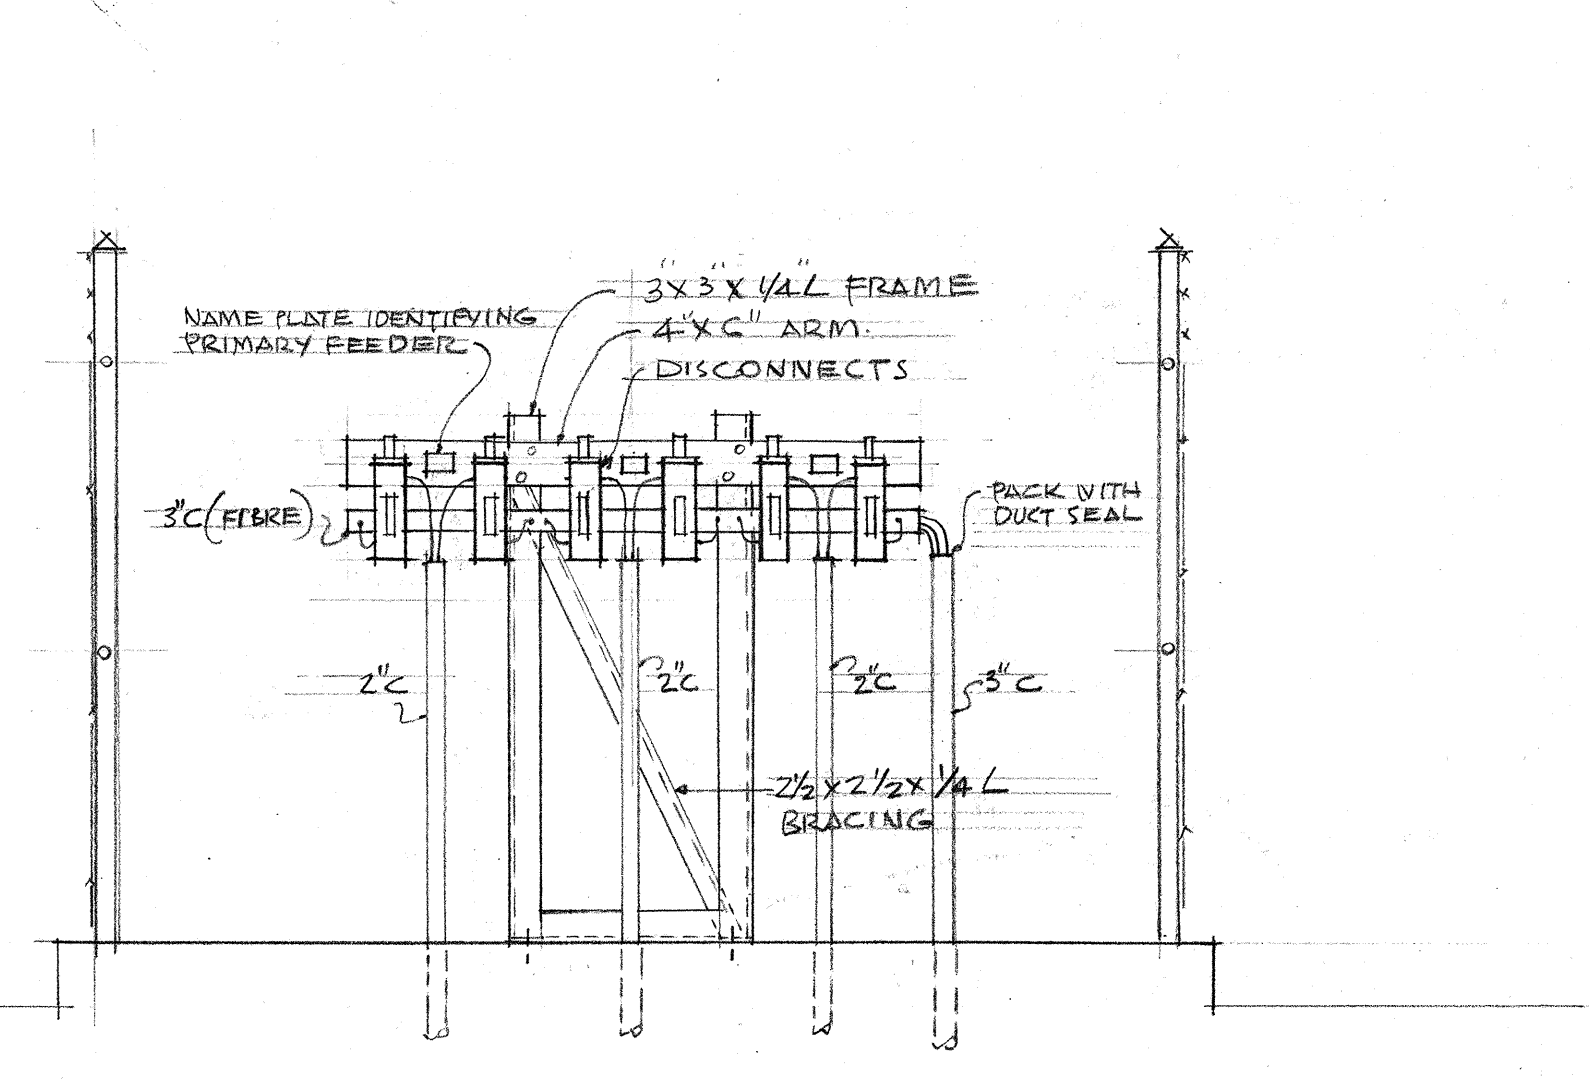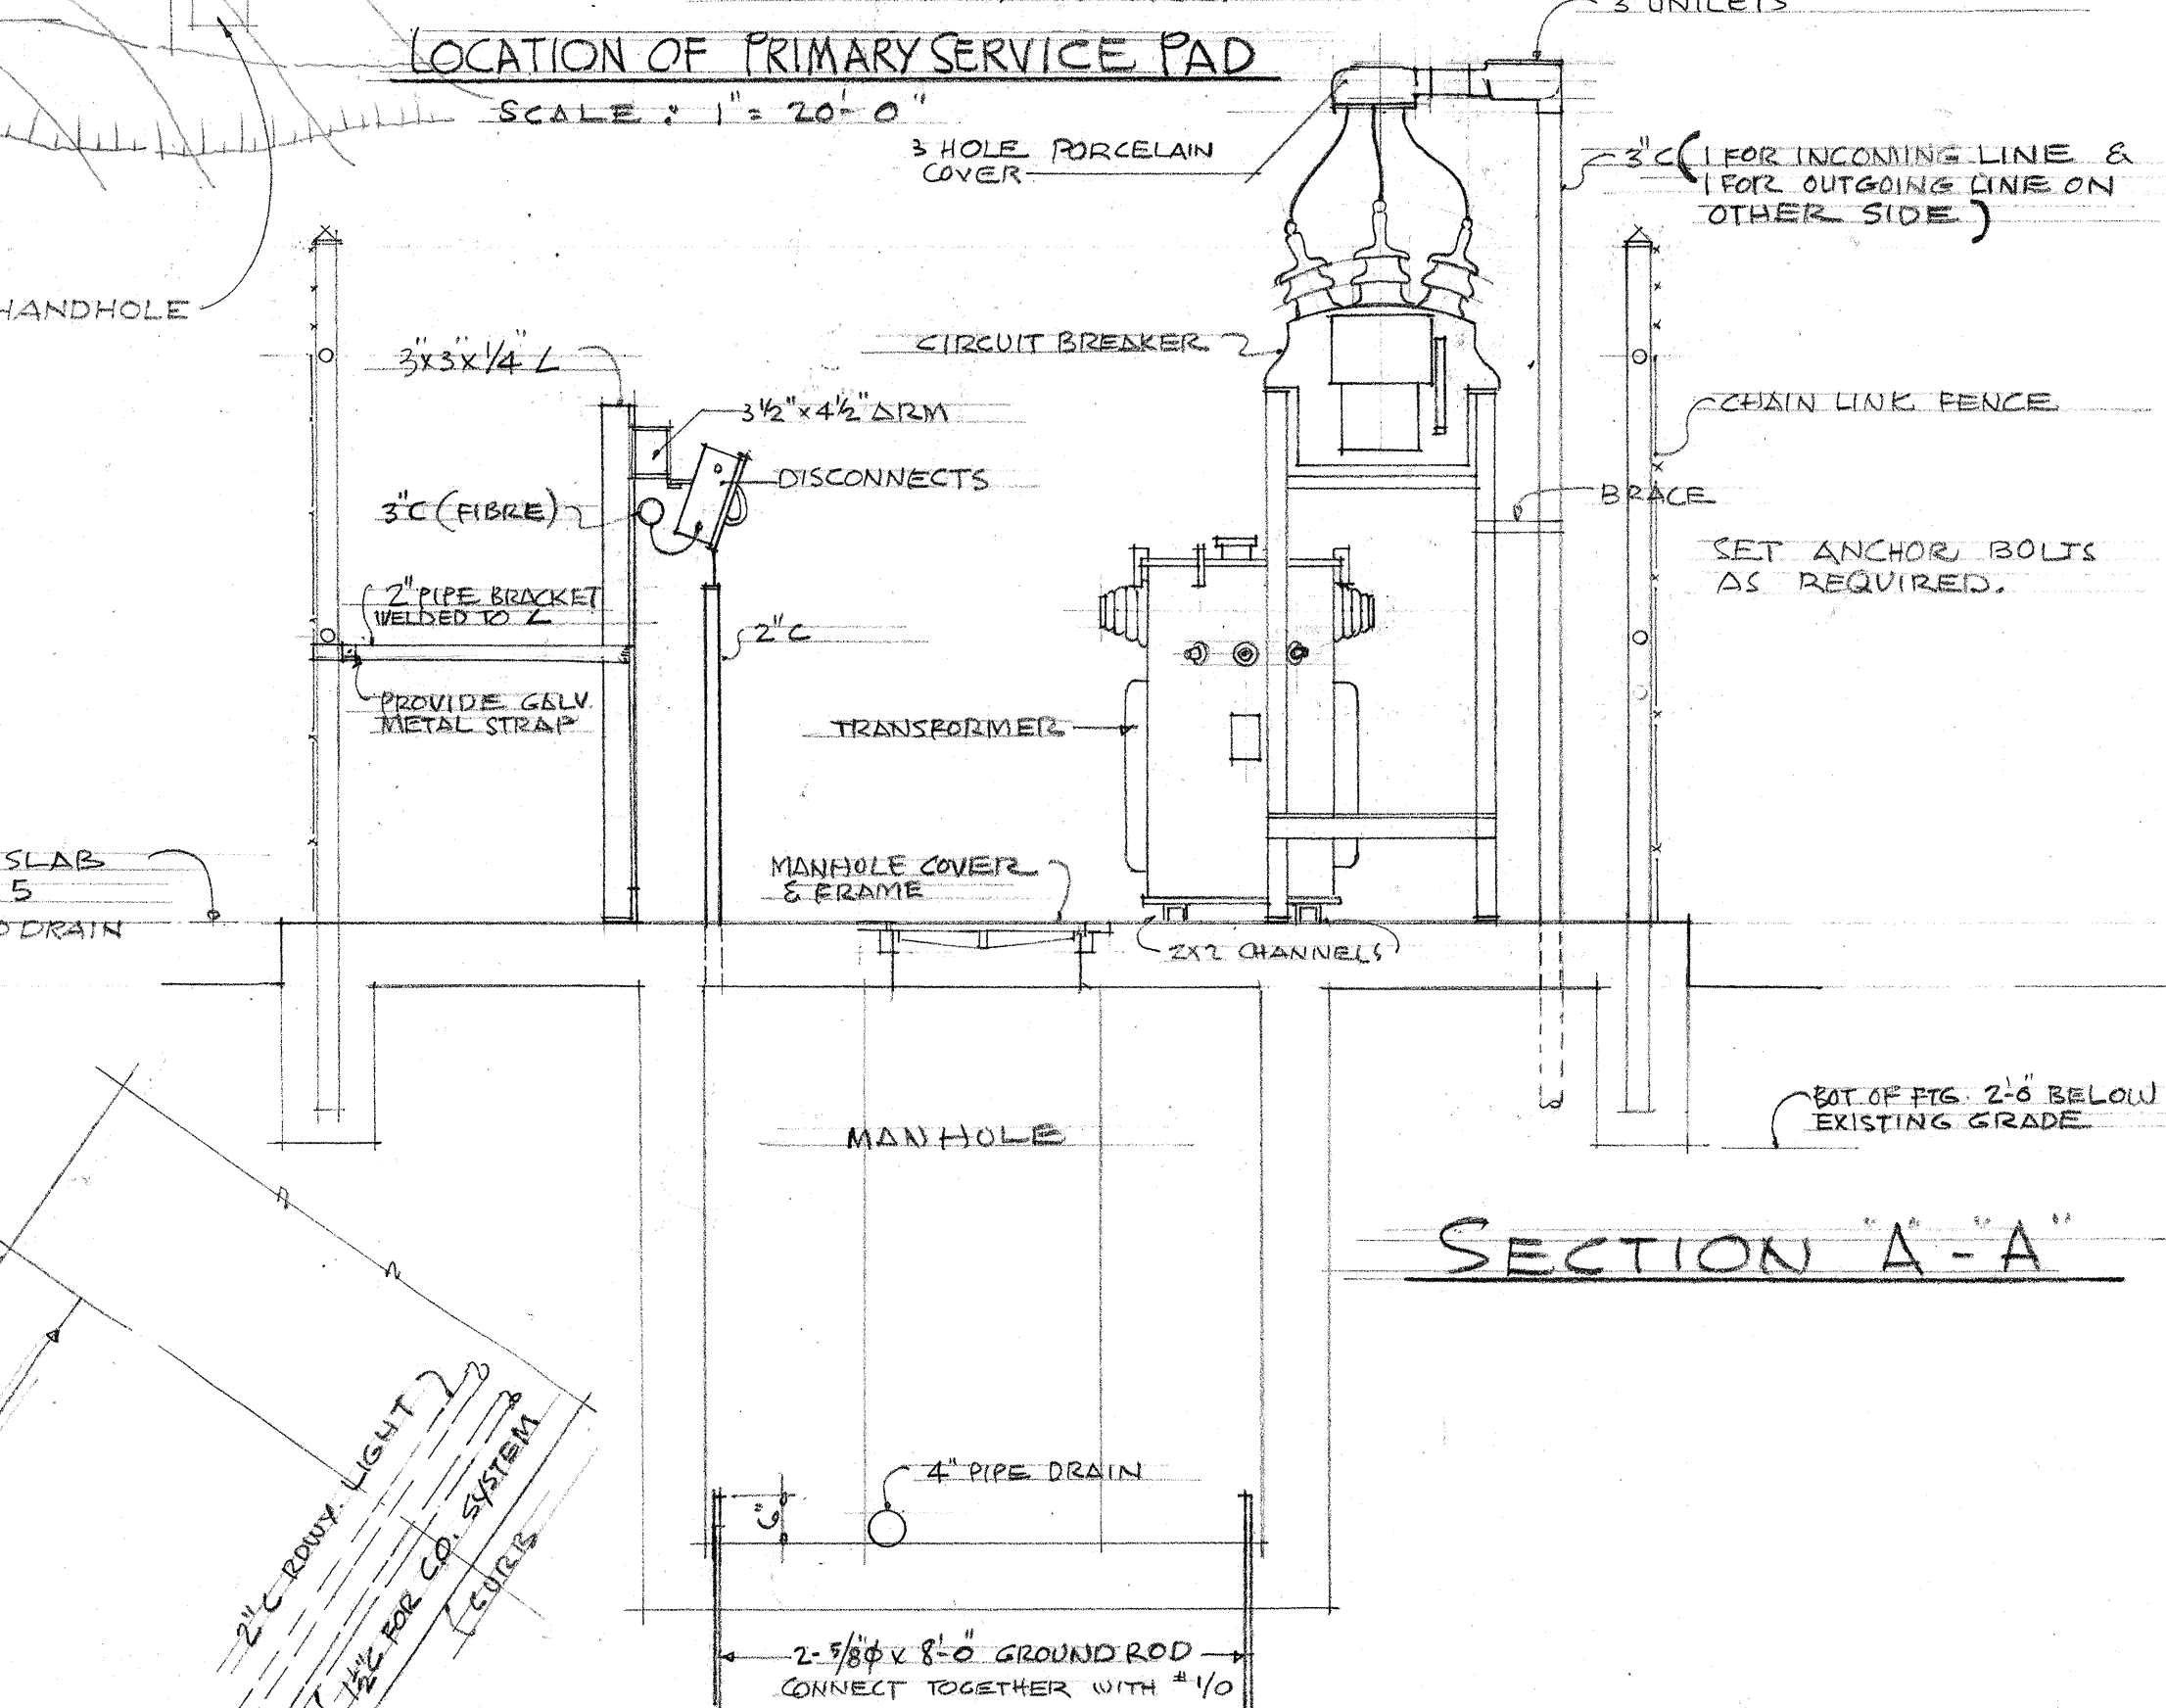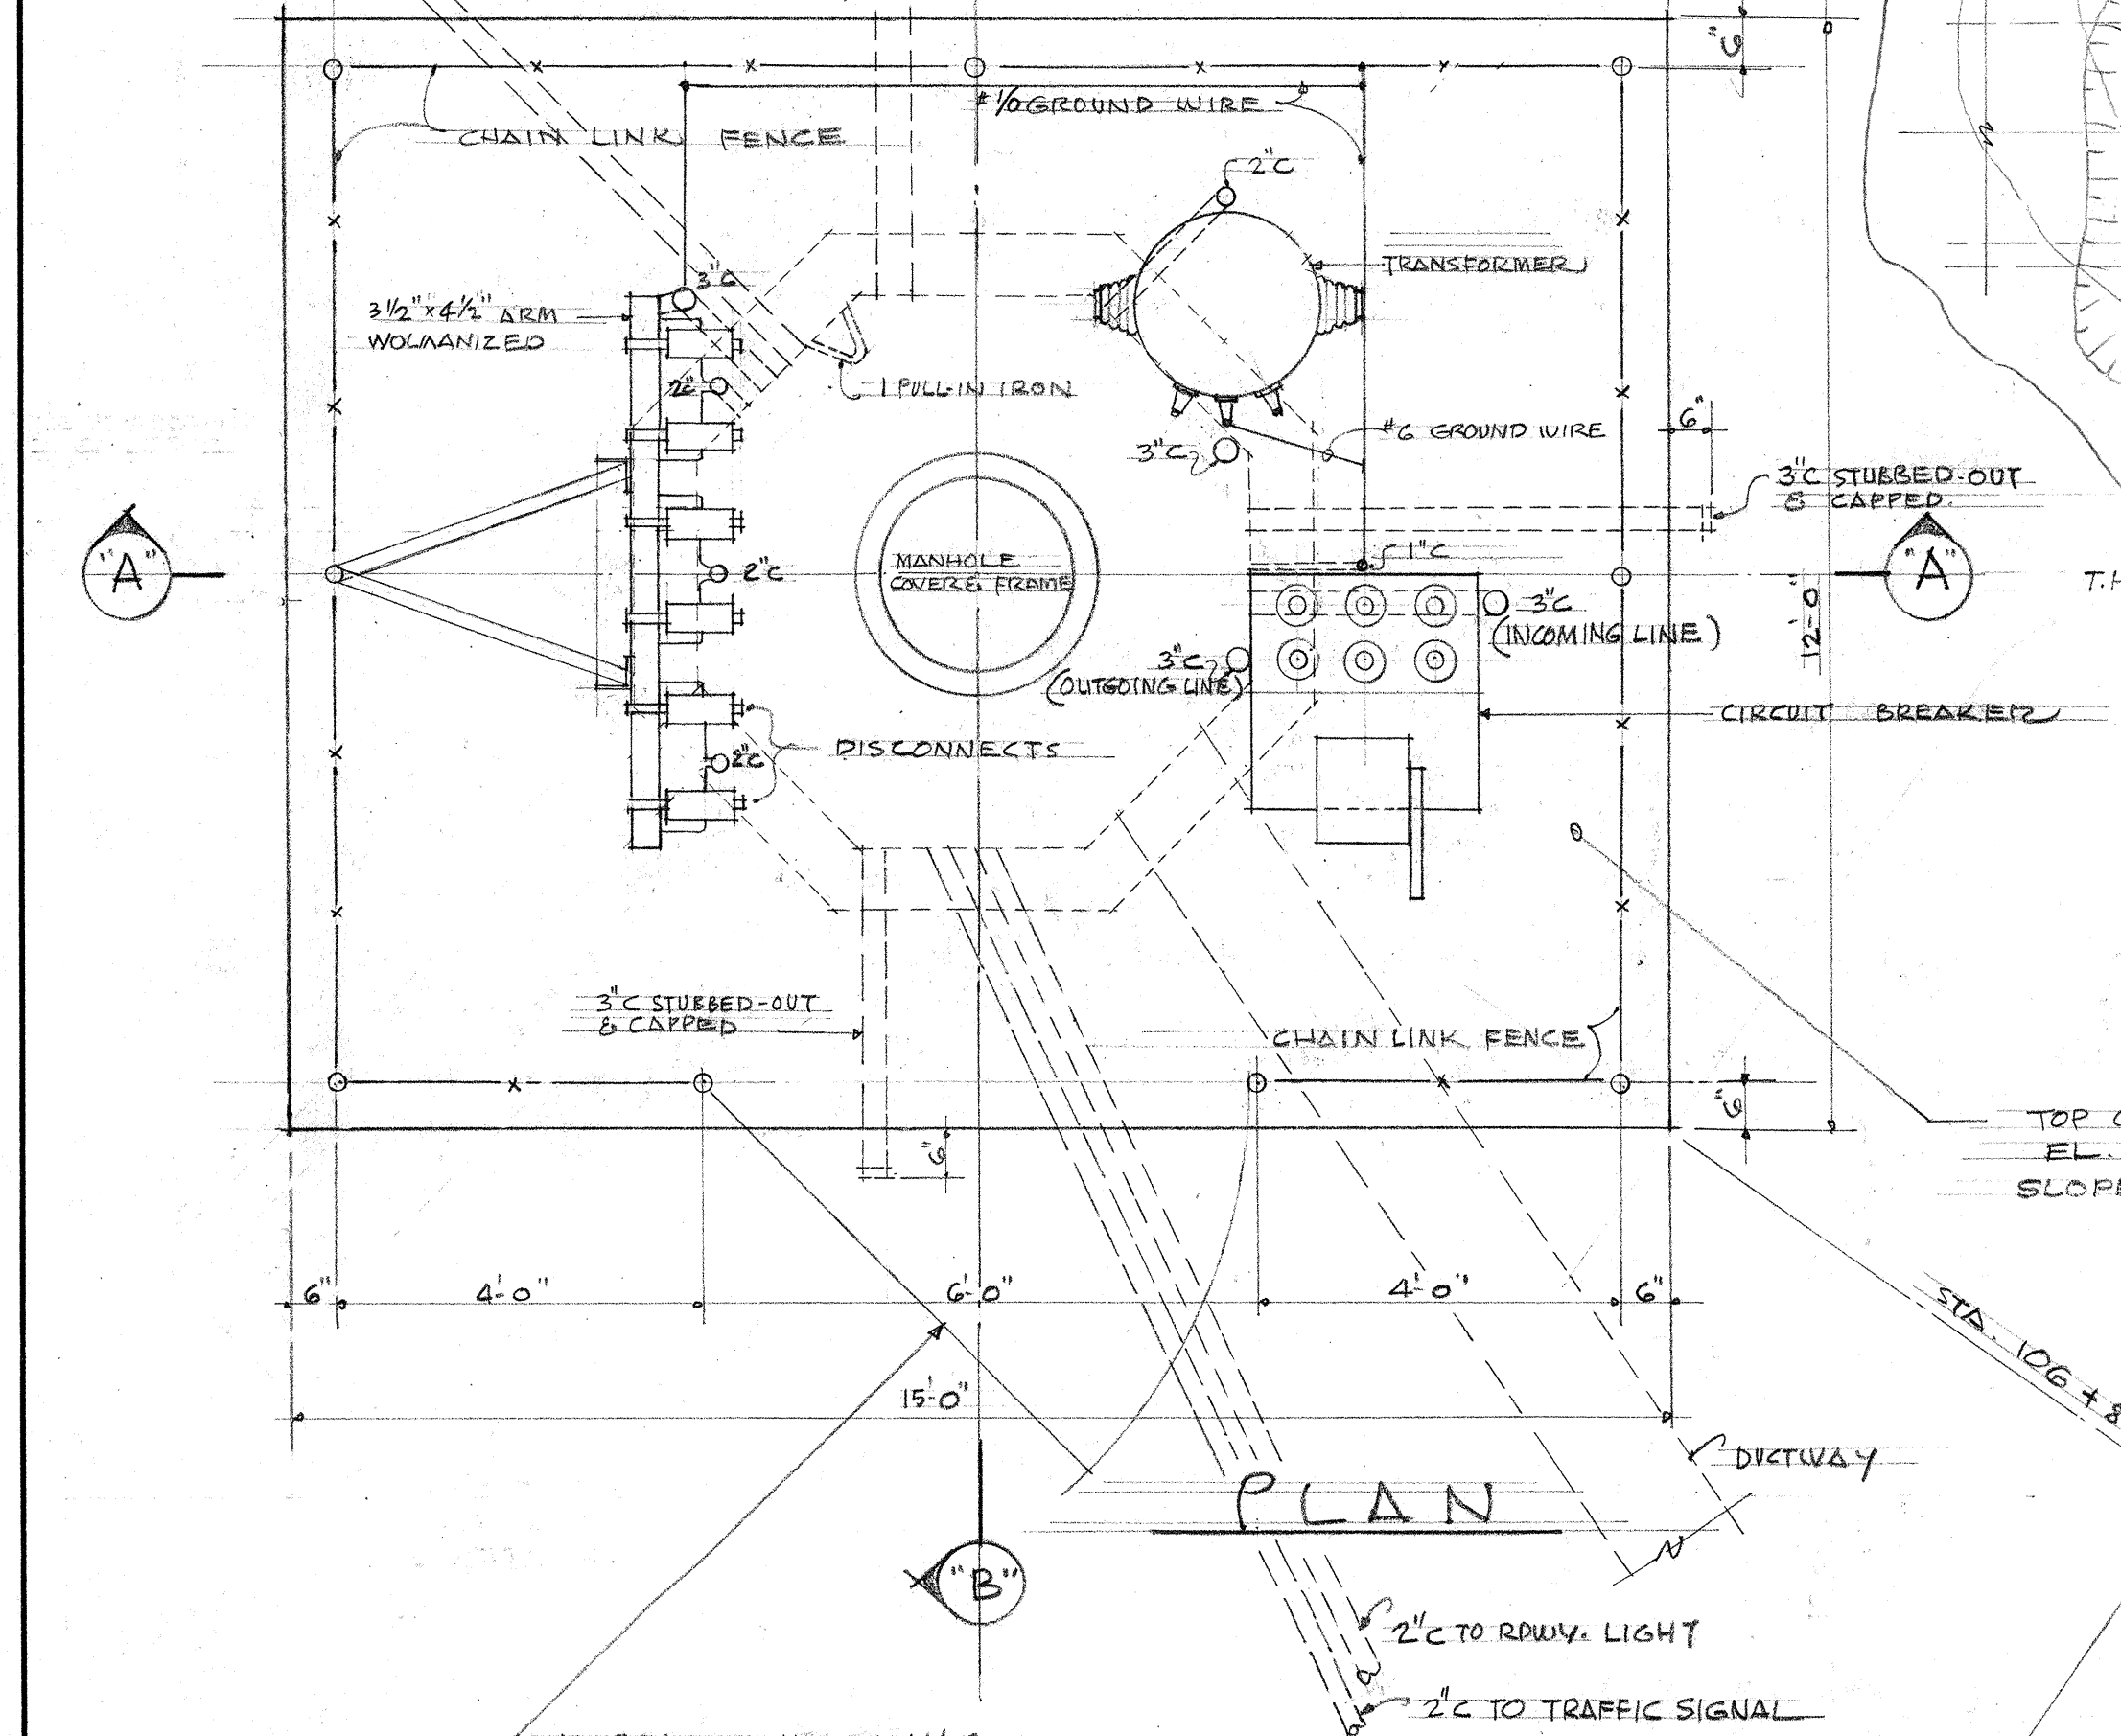

DETAILS OF PRIMARY SERVICE PAD

SCALE: 1/2" = 1'-0"

NOTE: See Sheet 50 for Structural Details of Manhole and Pad.

TERRITORIAL HIGHWAY DEPARTMENT
TERRITORY OF HAWAII
ELECTRICAL
ELECTRICAL KEY MAP
AND PRIMARY SERVICE PAD
NUUANU PALI TUNNELS


JAMES J. OBERHAUSEN
ELECTRICAL ENGINEER

PALI ROAD
PROJ. NO. S 216 (S)
SCALE: AS NOTED DATE: AUG. 27, 1954


SHEET No. 1 OF 2 SHEETS

5708.43

DATE: _____
DESIGNED BY: _____
DRAWN BY: _____
CHECKED BY: _____
ORIGINAL PLAN NO. _____
NOTE BOOK NO. _____

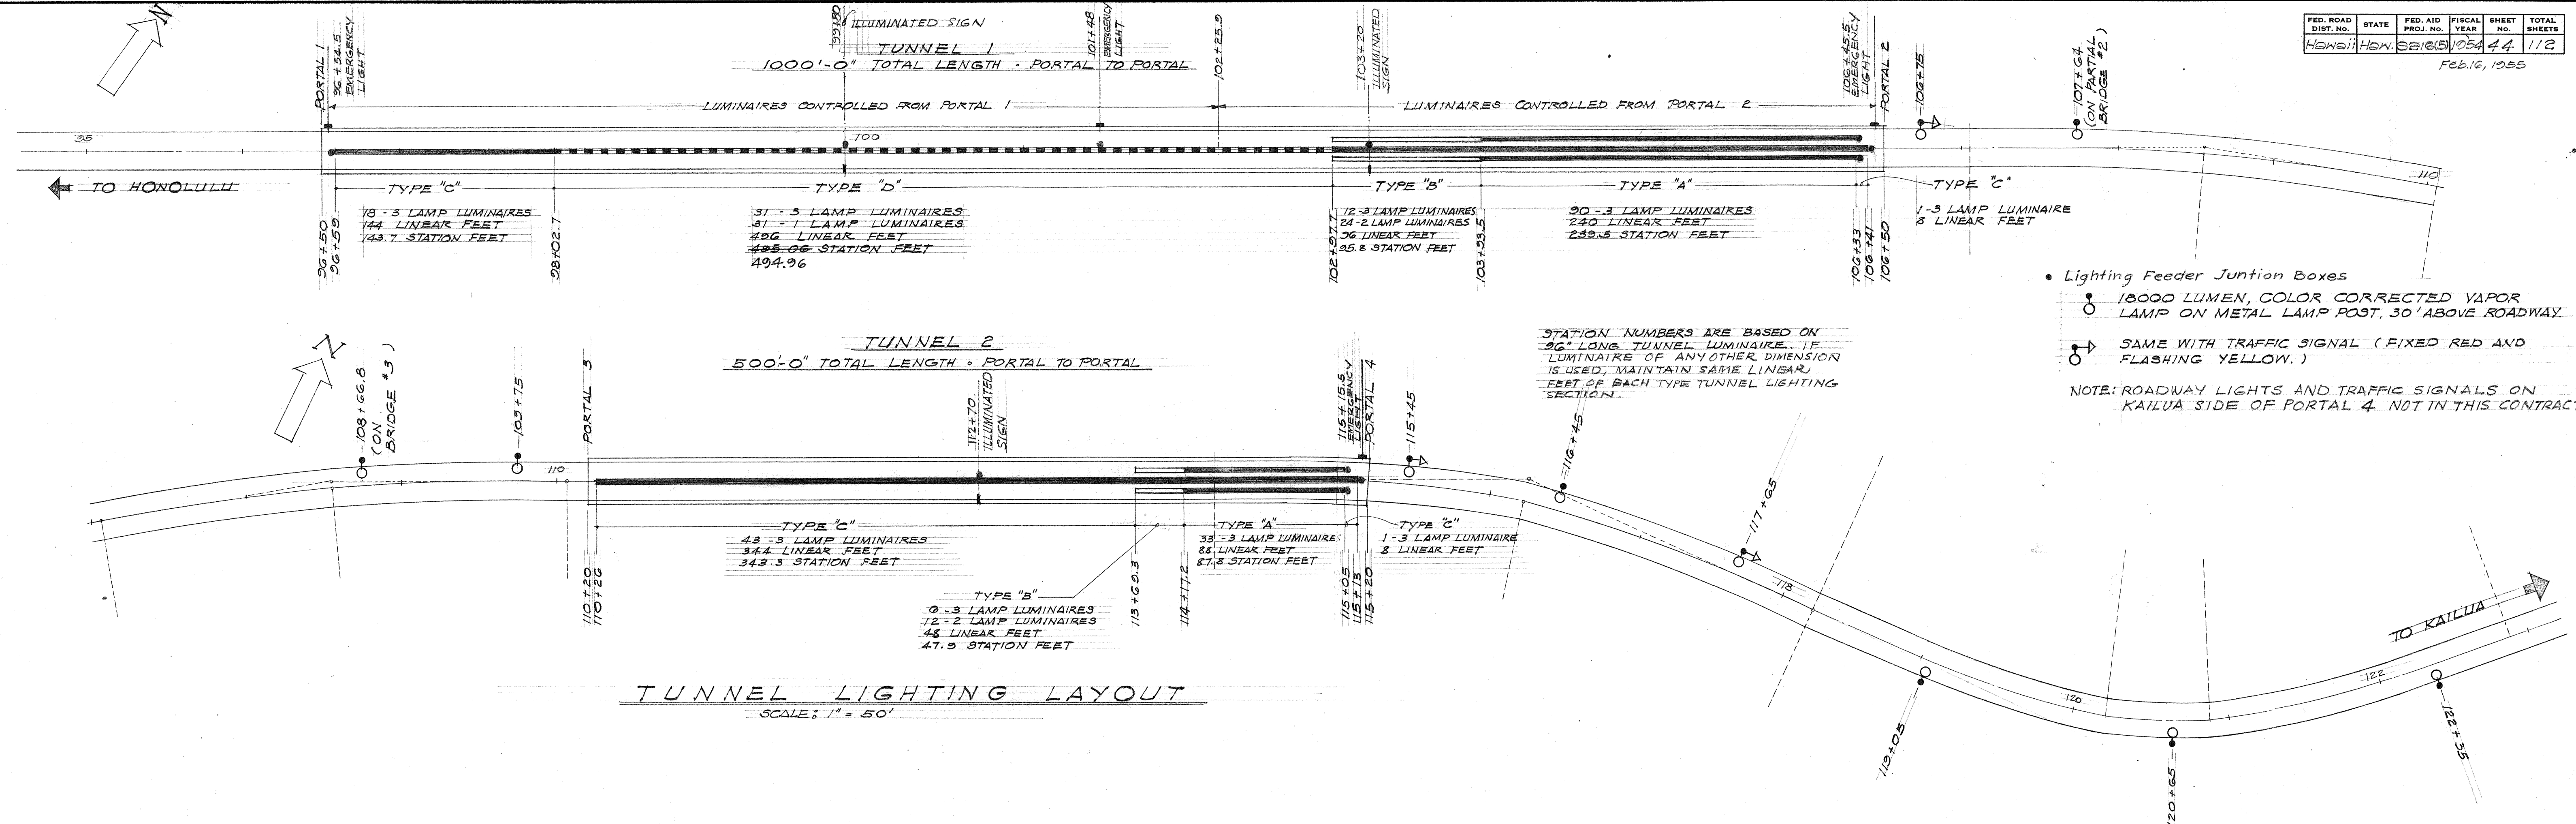

TUNNEL LIGHTING LAYOUT
SCALE: 1" = 50'

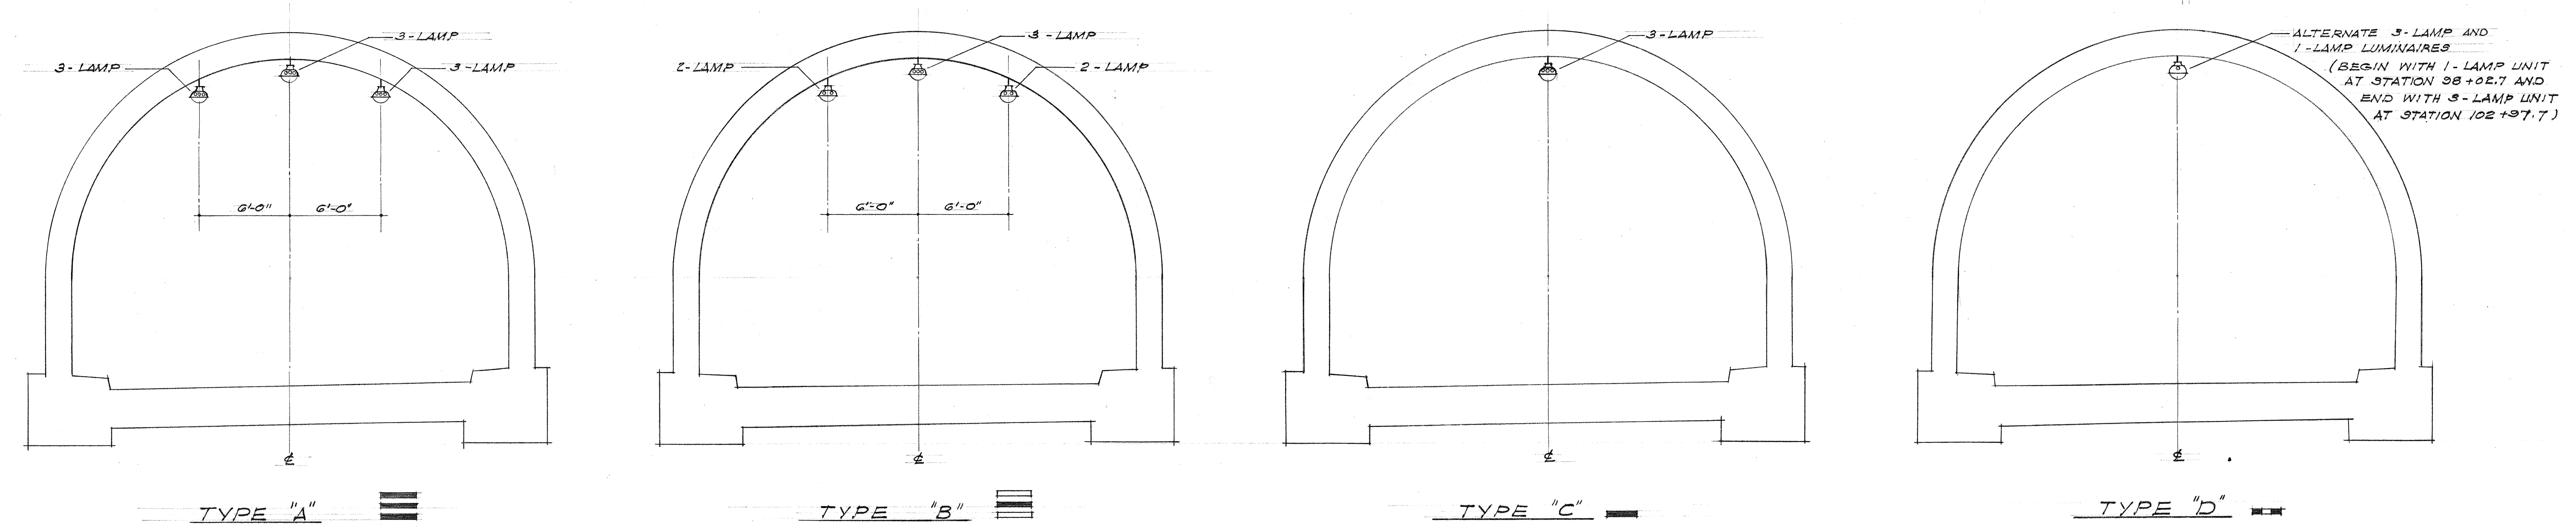

TYPICAL TUNNEL LIGHTING SECTIONS
SCALE: 3/16" = 1'-0"

WIRE SIZE AND LAMP HOOK-UP SCHEDULE (BASE ON 36" LAMP)

CIRCUIT NUMBER	PORTAL 1				PORTAL 2				PORTAL 4			
	CENTER ROW	NORTH ROW	CENTER ROW	SOUTH ROW	CENTER ROW	NORTH ROW	CENTER ROW	SOUTH ROW	CENTER ROW	NORTH ROW	CENTER ROW	SOUTH ROW
AWG WIRE SIZE	N 1 3 2 4	N 5 7	N 1 3 2 4	N 6 8	N 5 7	N 1 3 2 4	N 6 8	N 5 7	N 1 3 2 4	N 6 8	N 5 7	N 6 8
CONTINUOUS SCHEDULE LAMPS	36		26		31							
DAY SCHEDULE LAMPS	44 44	56 58	48 48	56 58	22 23	60 62		22 23				
DAY (FUTURE CONTINUOUS) SCHEDULE LAMPS		35		26				30				

ROADWAY LIGHTING CIRCUITS FED FROM PORTAL 2 AND PORTAL 4 SHALL BE 240 V, 1 ϕ , AND SHALL BE #6 AWG WIRE.

TRAFFIC SIGNAL CIRCUITS FED FROM PORTAL 2 AND PORTAL 4 SHALL BE 120 V, 1 ϕ , AND SHALL BE #10 AWG WIRE. (3 SINGLE CONDUCTORS)

TERRITORIAL HIGHWAY DEPARTMENT
TERRITORY OF HAWAII






ELECTRICAL LIGHTING PLAN

NUUANU PALI TUNNELS


PALI ROAD
PROJ. NO. S 216(S)
SCALE: AS NOTED DATE: AUG. 27, 1954

JAMES J. OBERHAUSEN
ELECTRICAL ENGINEER

DATE: _____
DESIGNED BY: _____
DRAWN BY: _____
CHECKED BY: _____
NOTE BOOK NO. _____

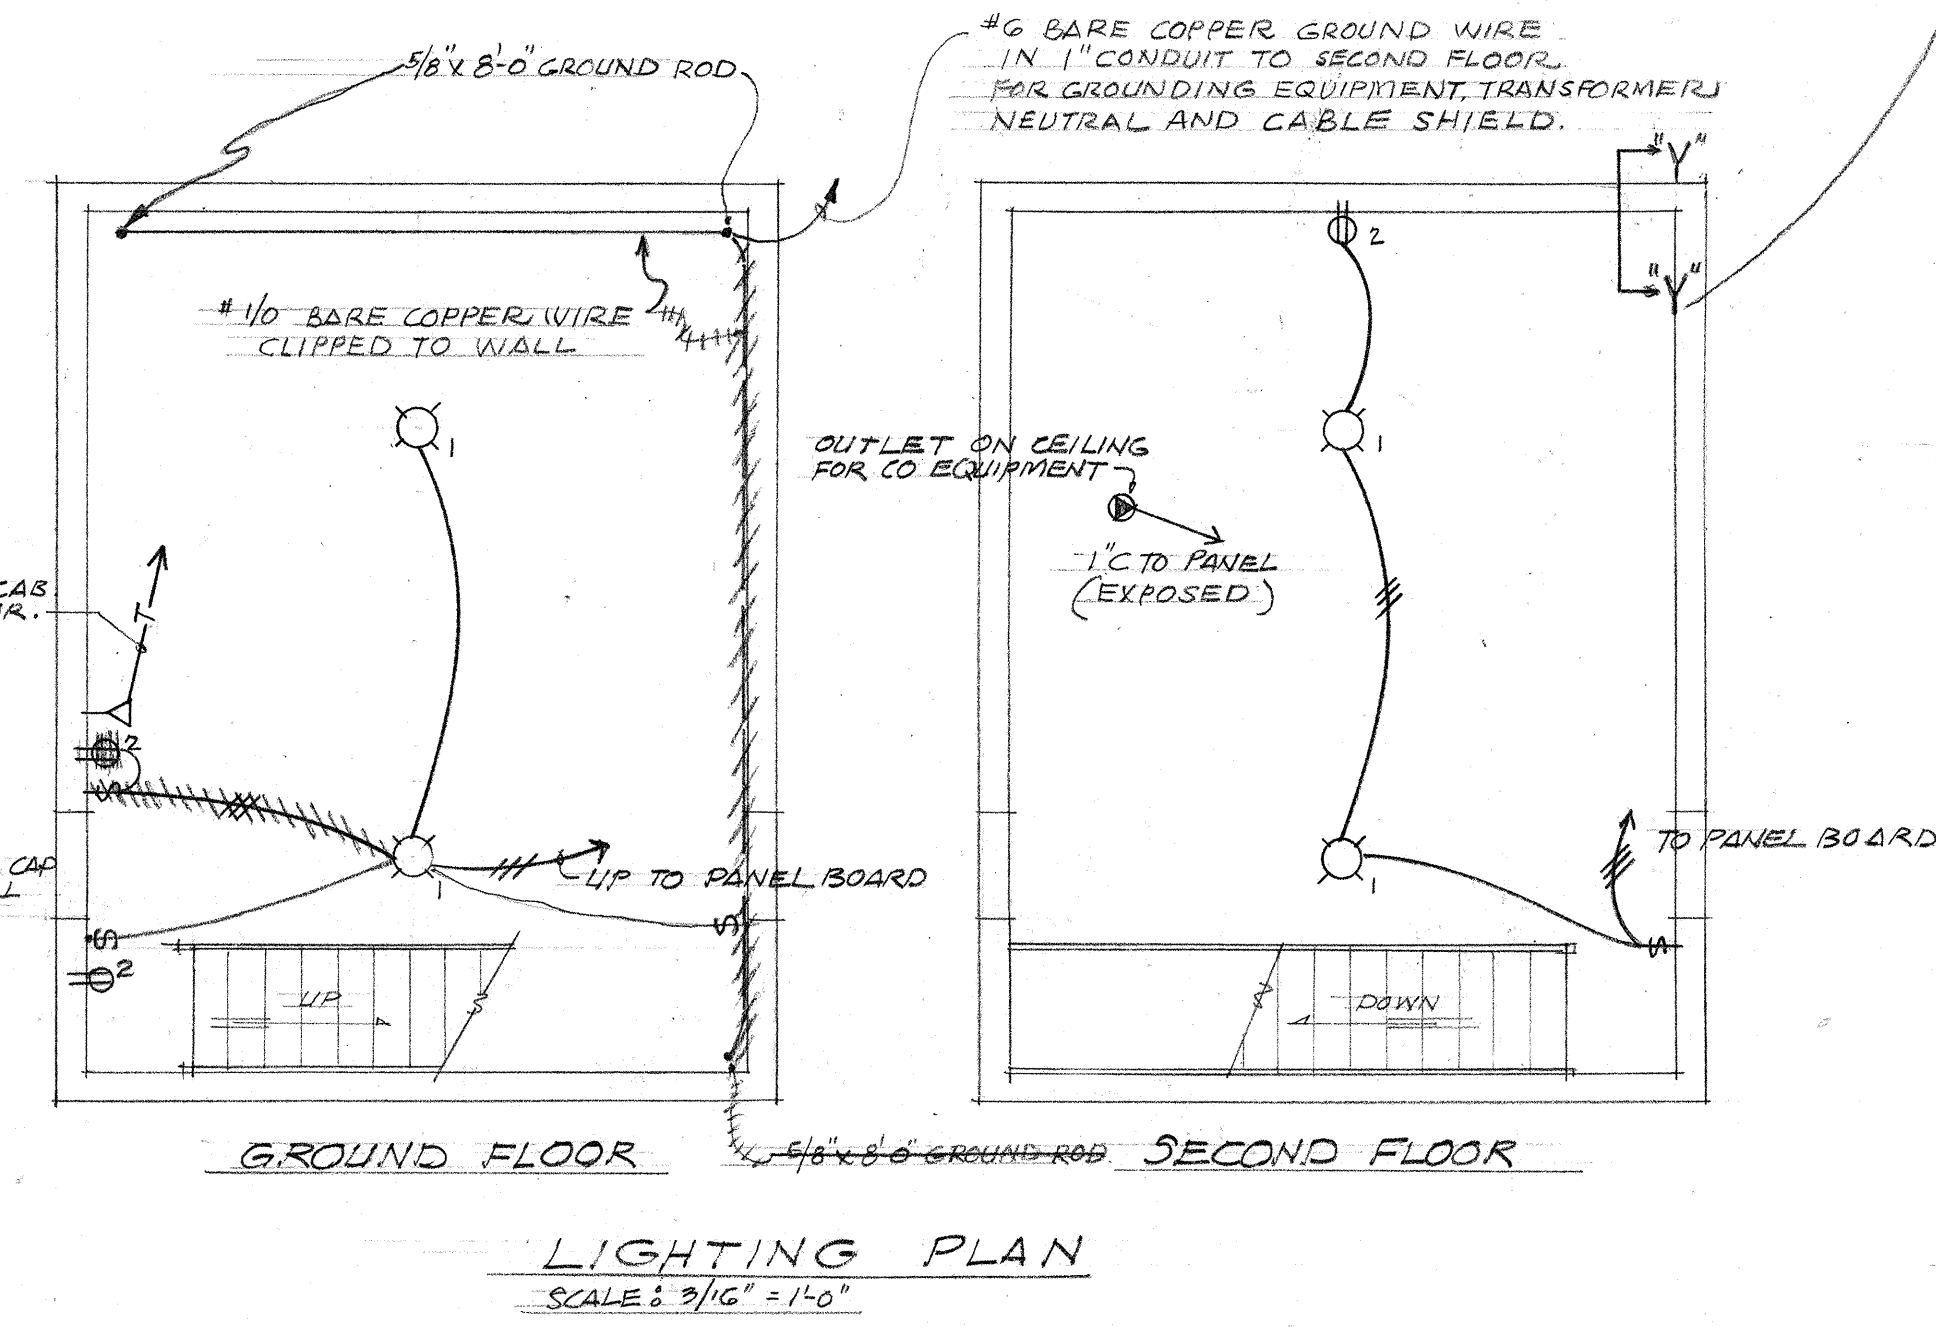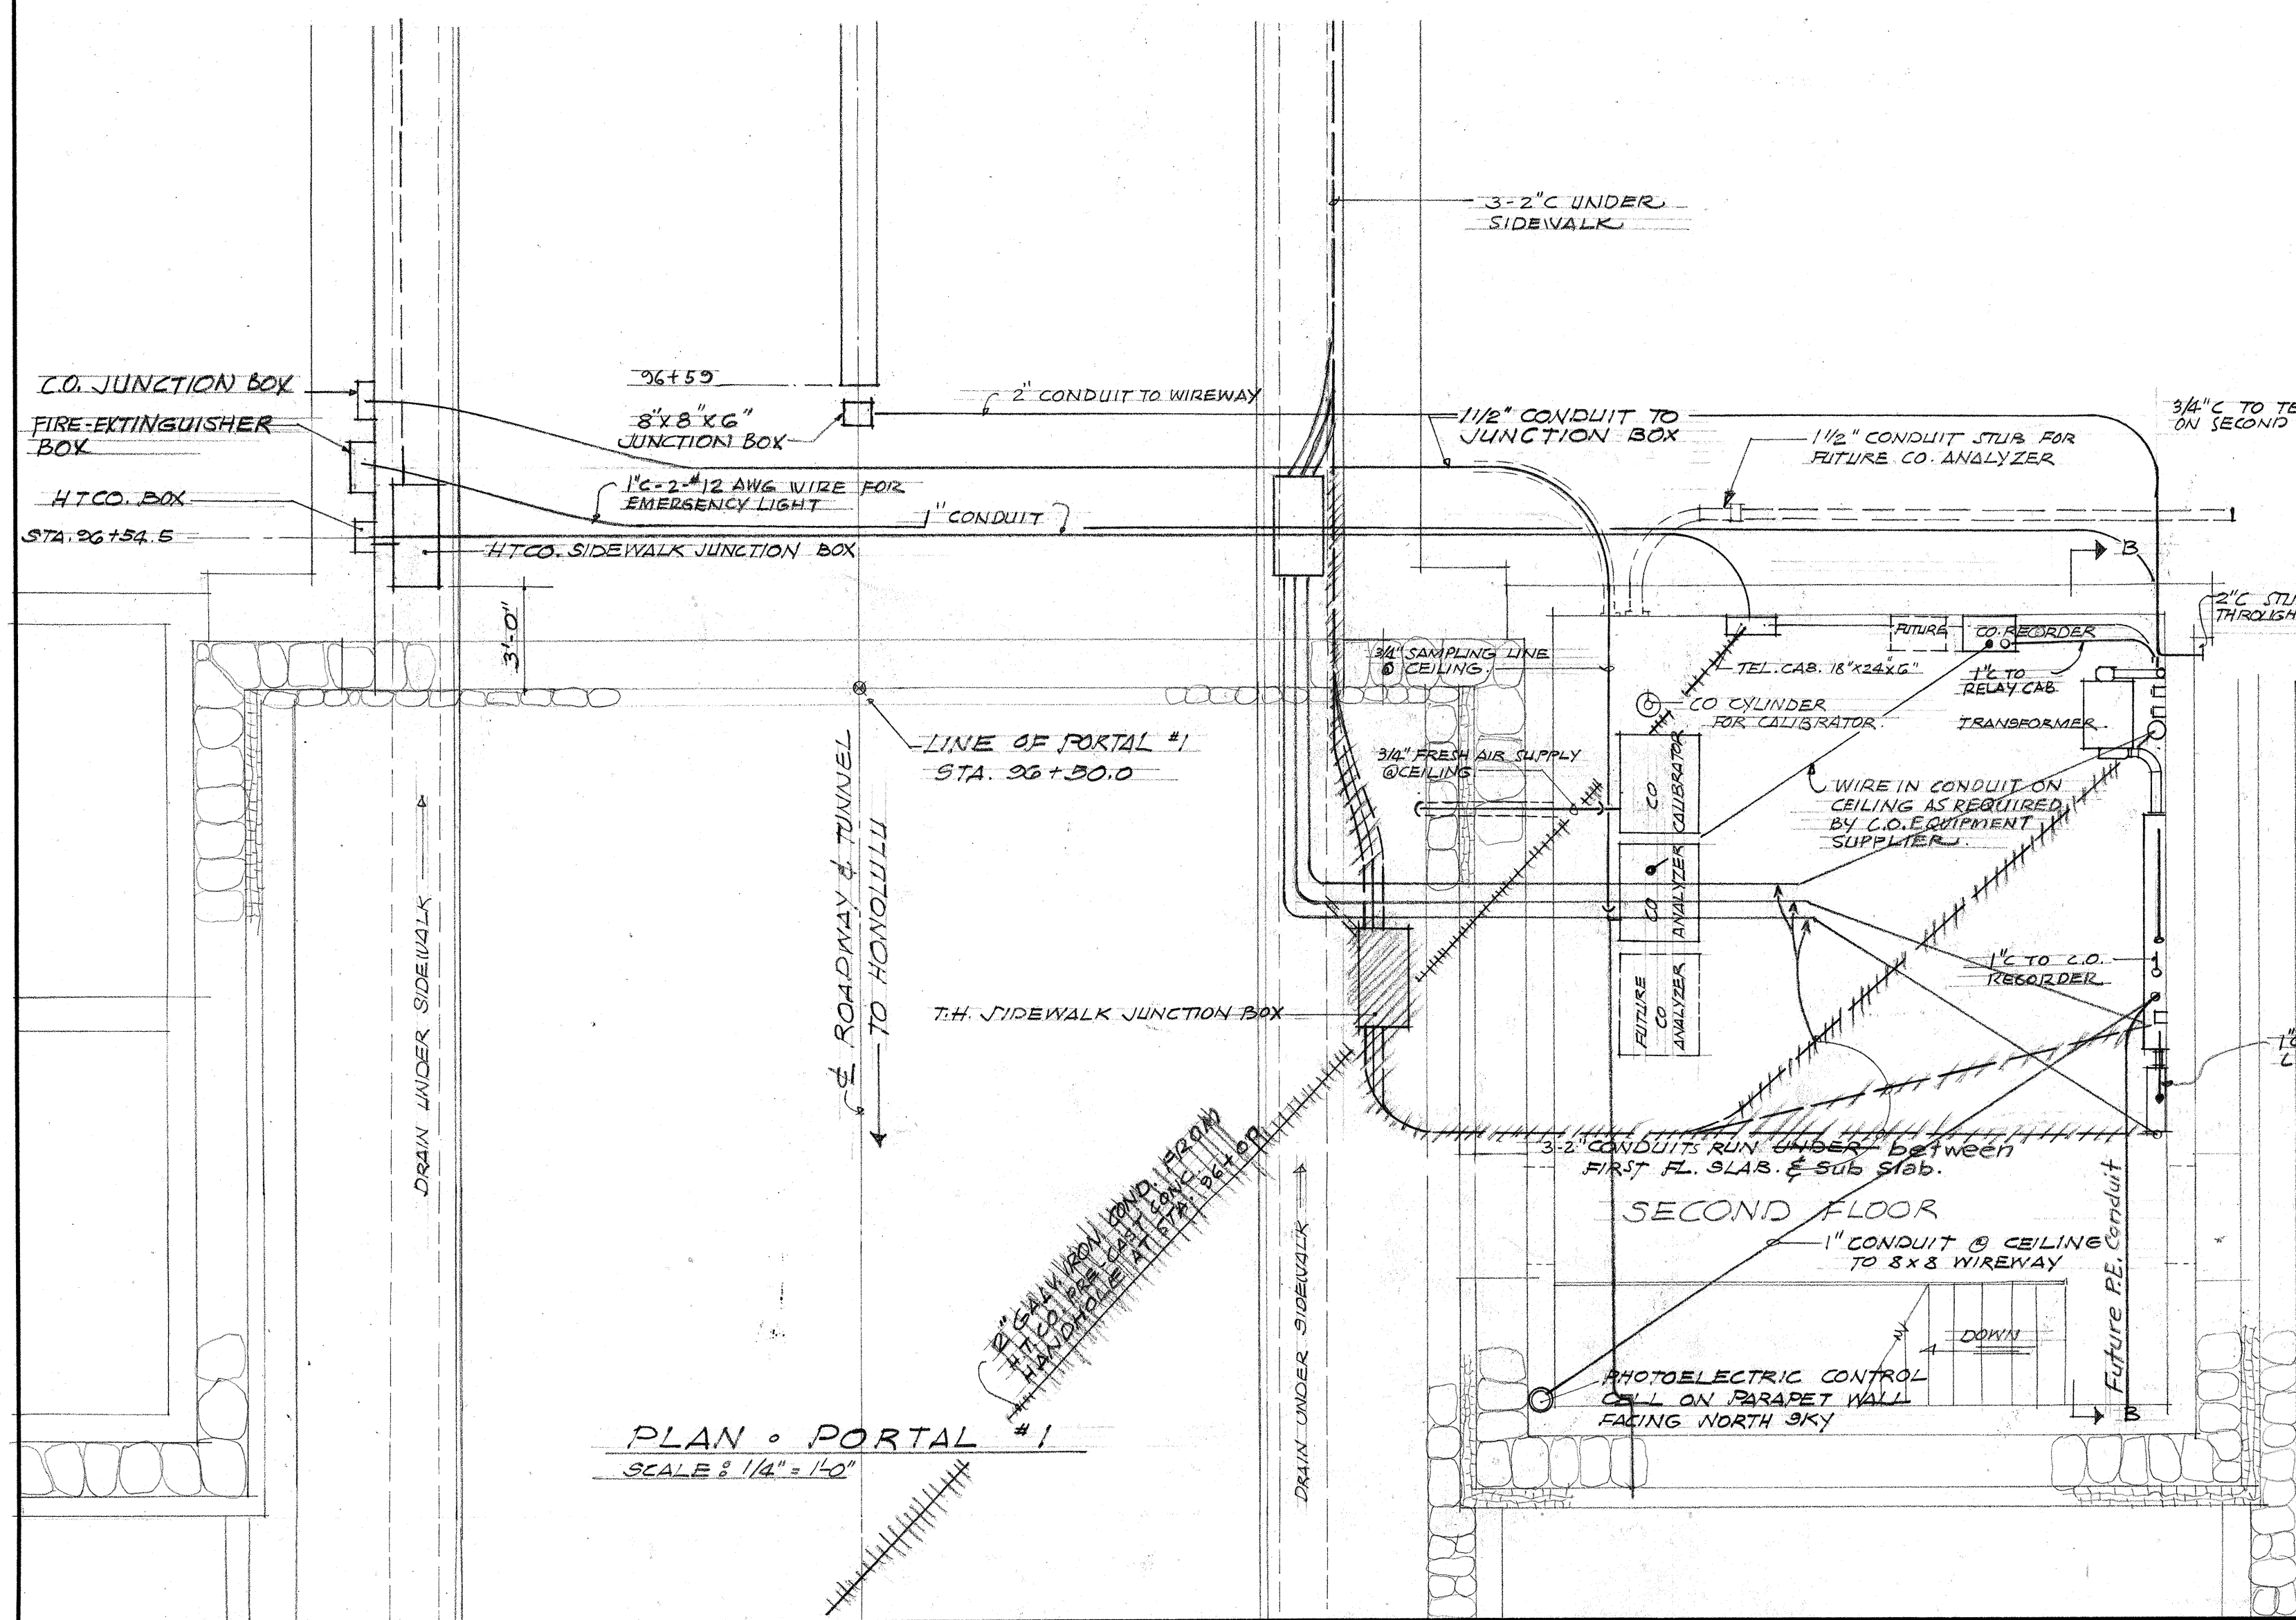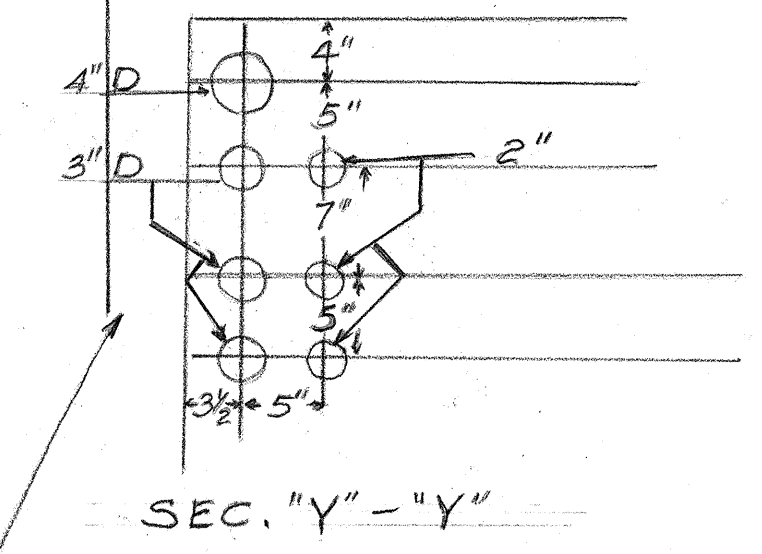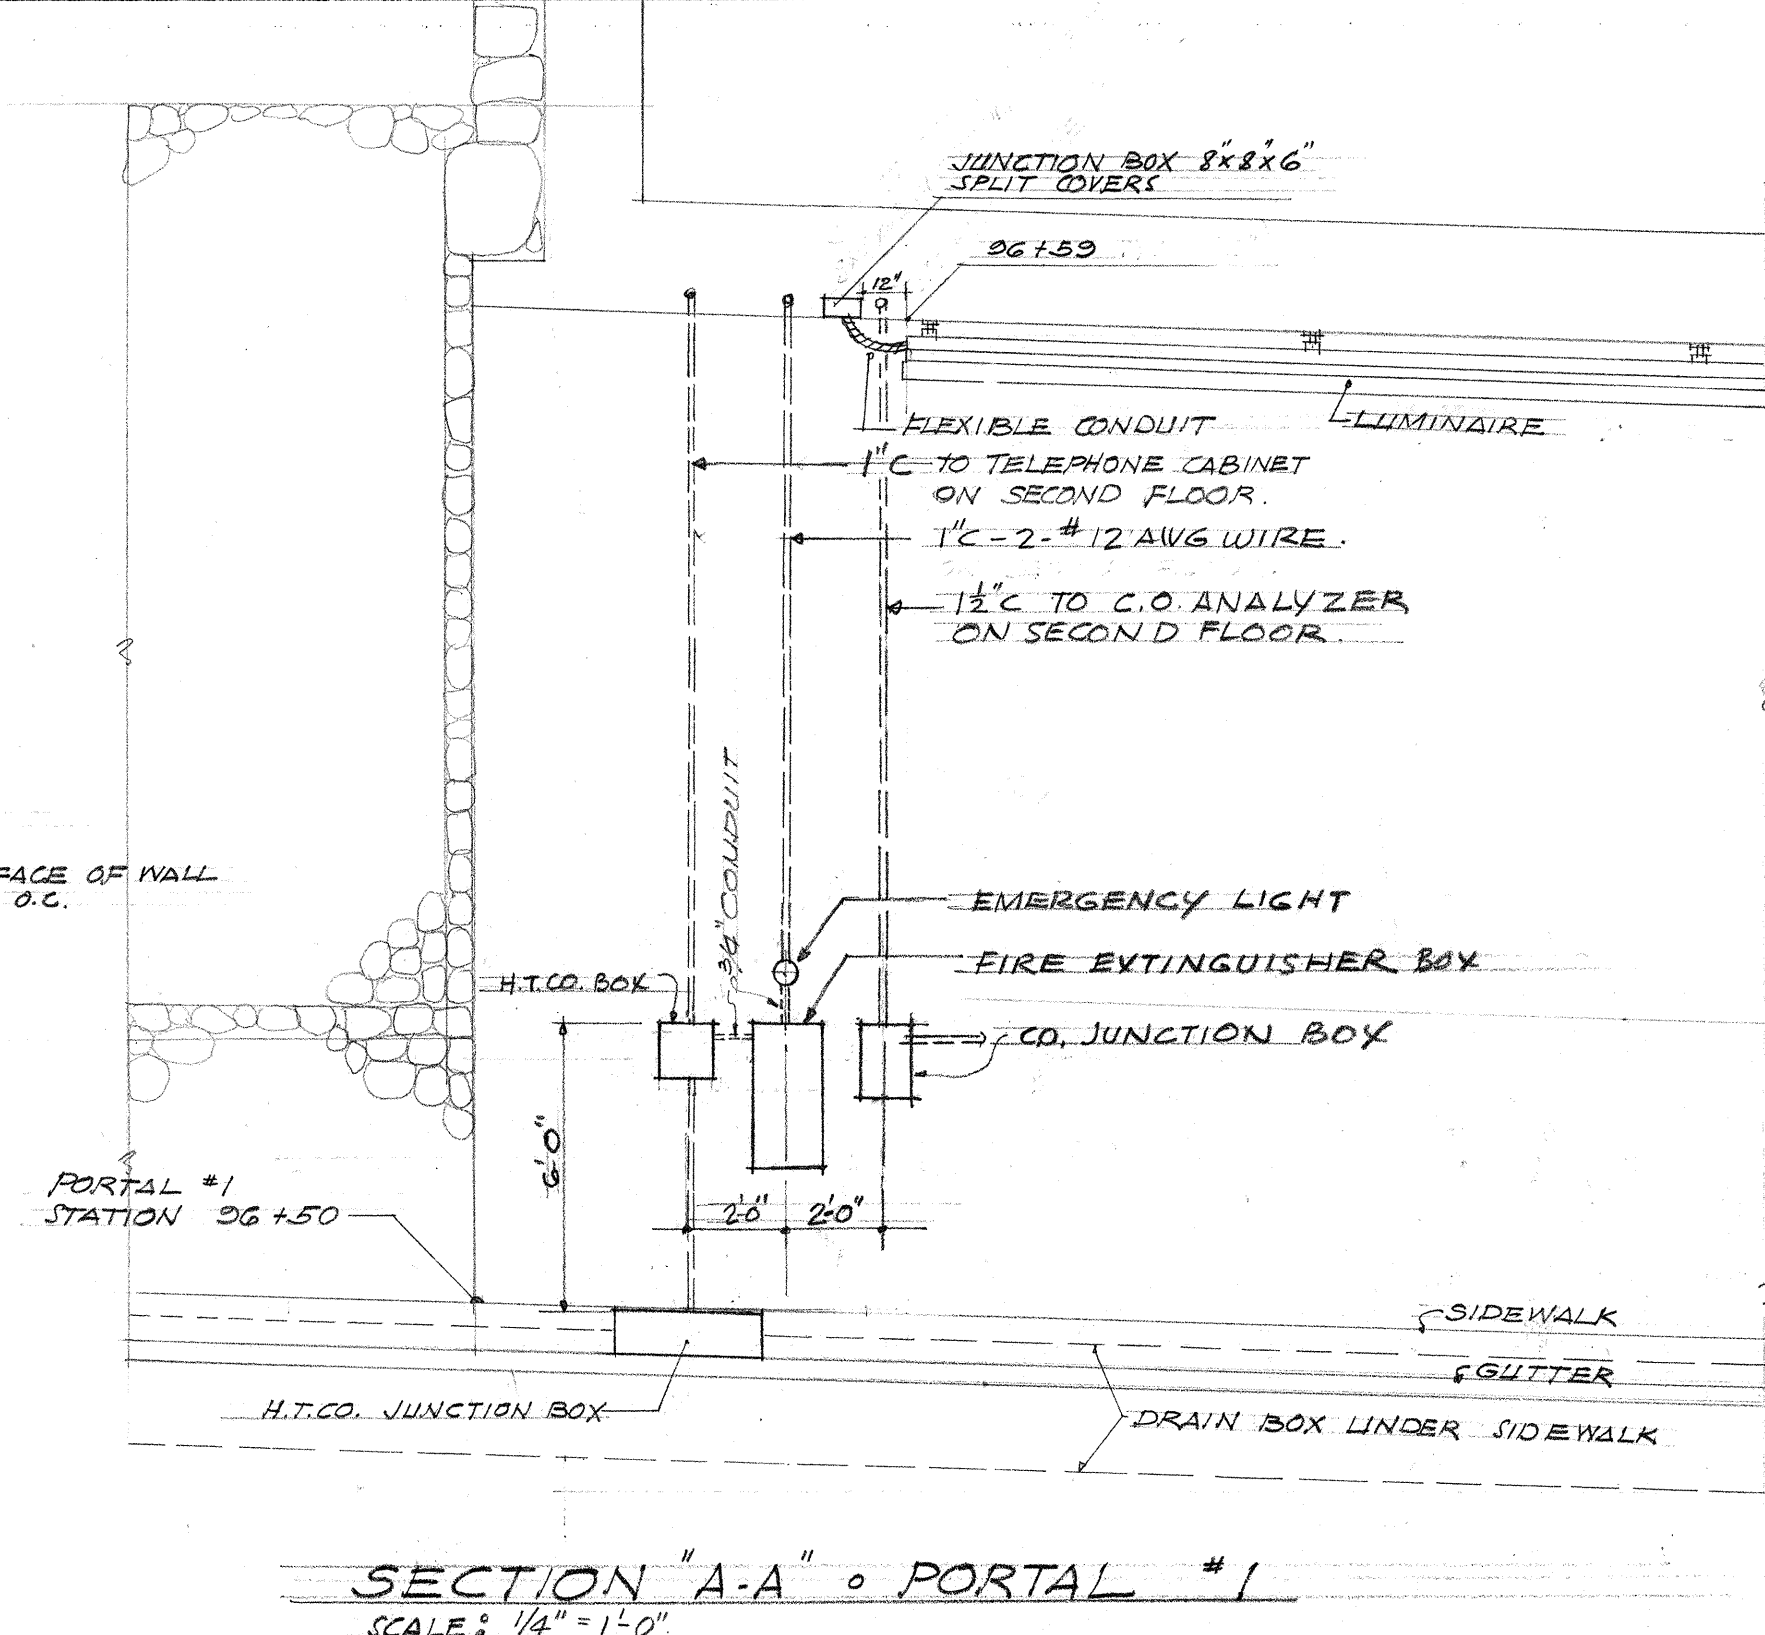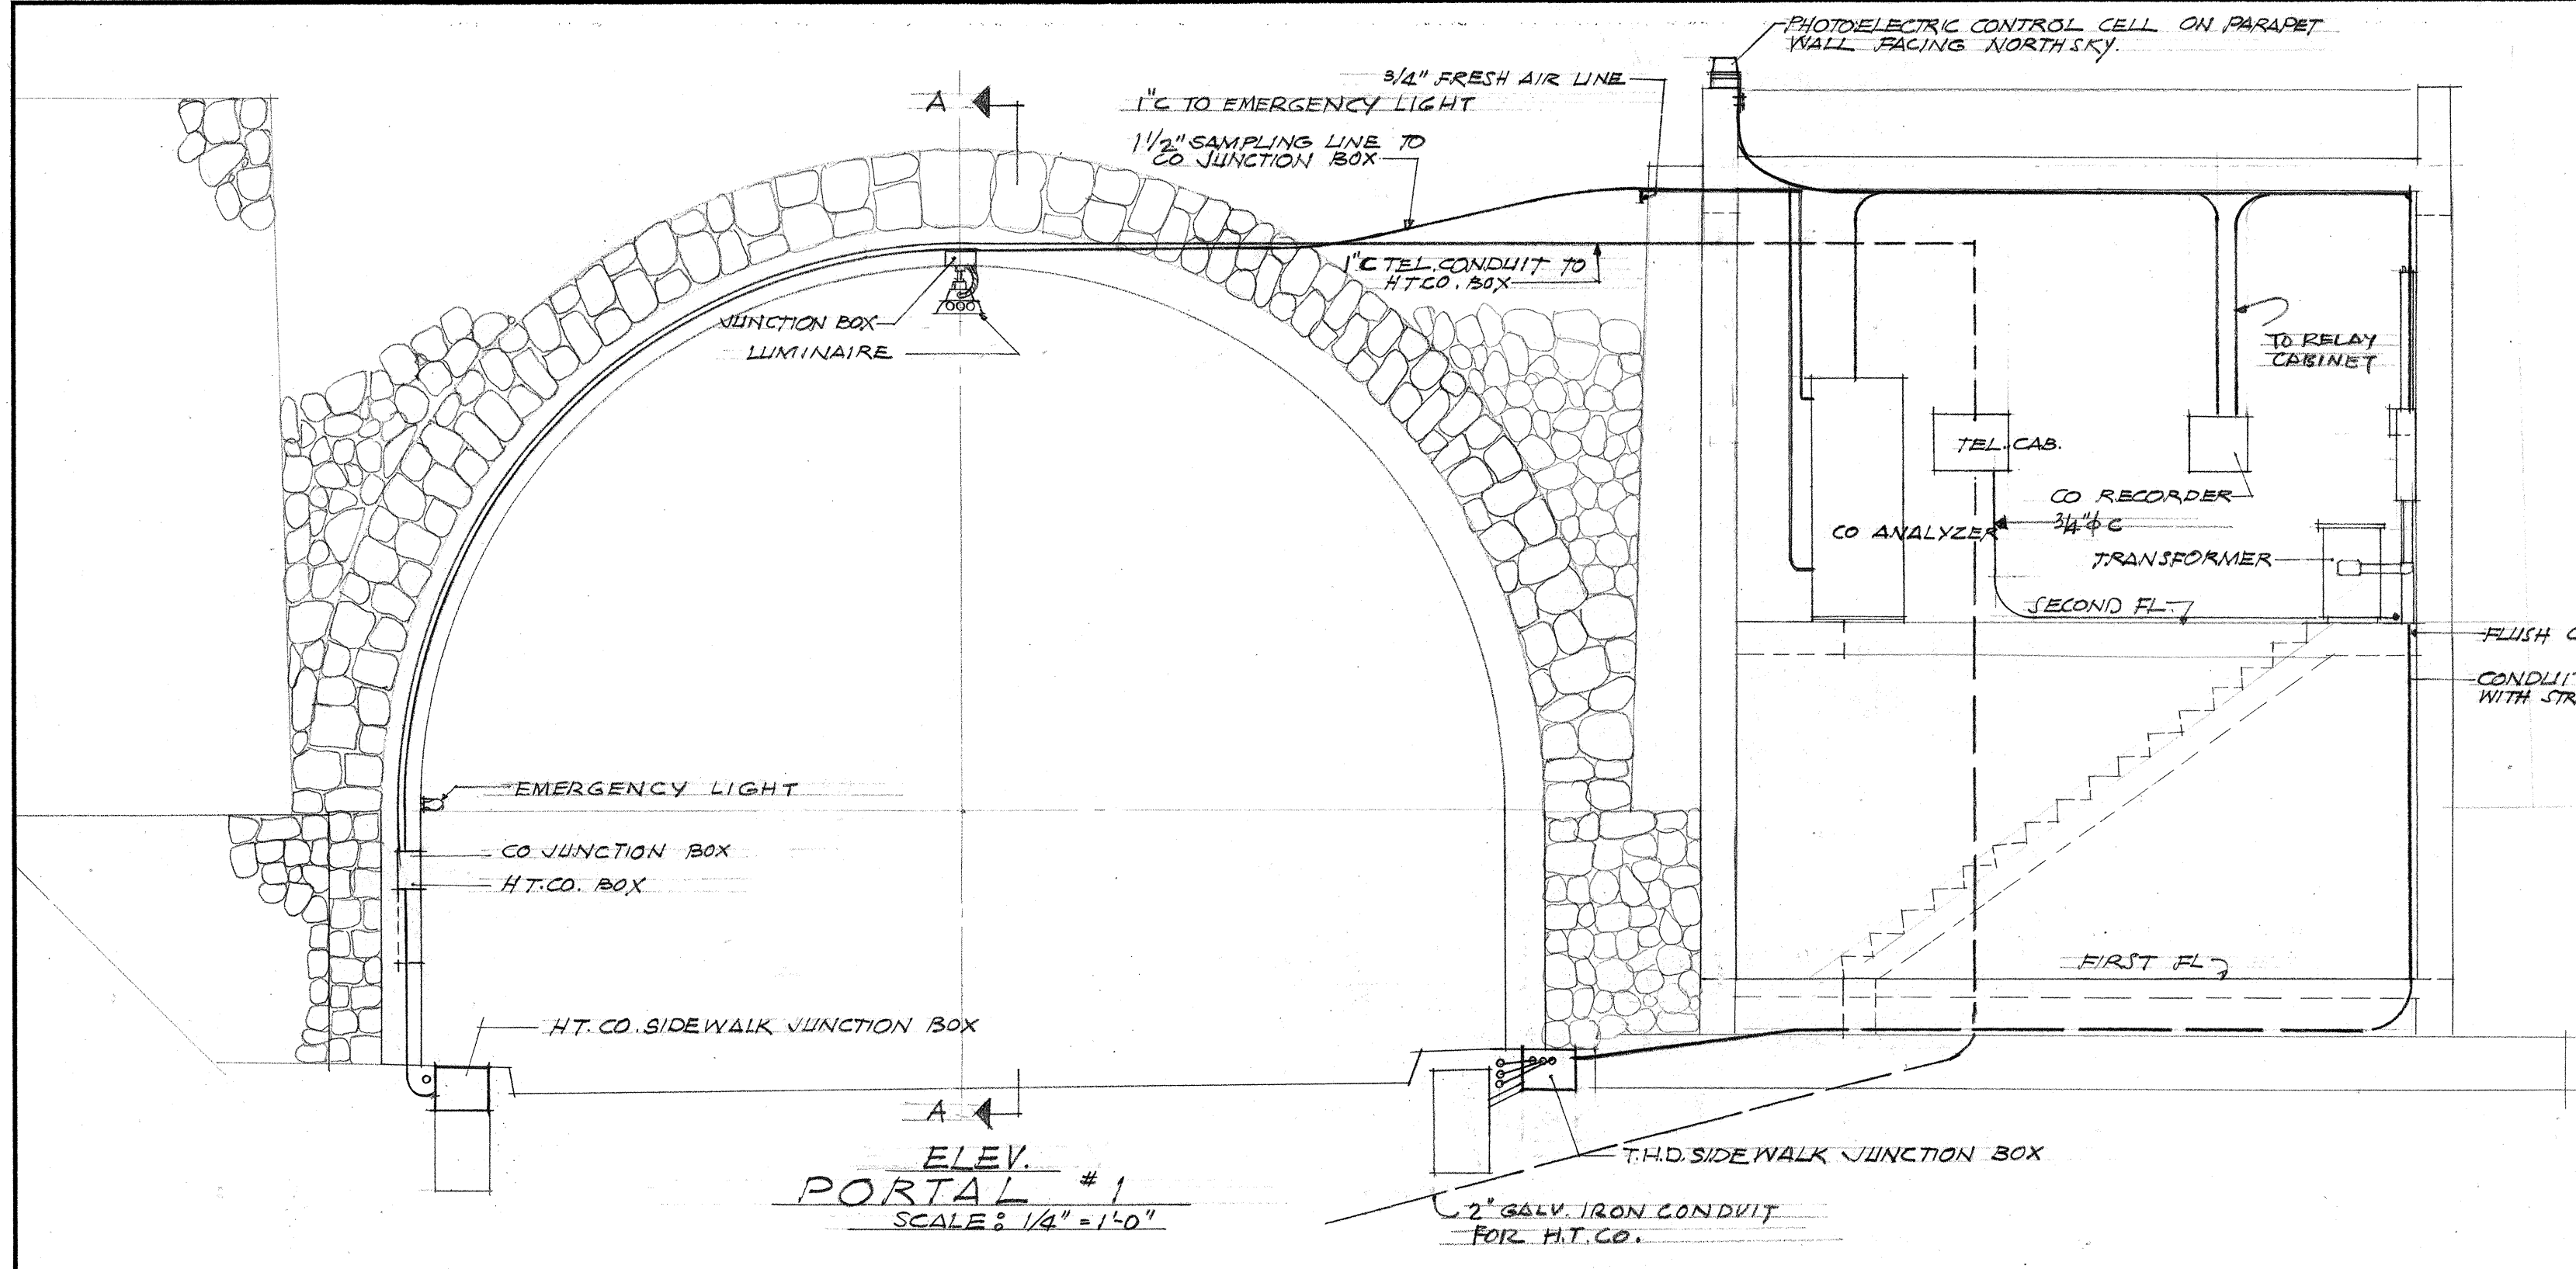

- LEGEND**
- RLM STANDARD DOME REFLECTOR FOR OUTLET BOX MOUNTING WITH 200 WATT I.F. LAMP.
 - DUPLEX CONVENIENCE OUTLET, FLUSH IN WALL, 30" HIGH, STAINLESS STEEL PLATE.
 - 20 AMPERE SINGLE POLE WALL SWITCH, FLUSH, 4'-0" ABOVE FLOOR, STAINLESS STEEL PLATE.
 - BRANCH CIRCUIT IN CONCEALED CONDUIT EXCEPT AS NOTED, #12 AWG, TYPE TW.
 - 4" SQUARE BY 2 1/8" DEEP BOX FLUSH IN WALL WITH STAINLESS STEEL COVER WITH SINGLE BUSHED HOLE.
 - 3/4" CONCEALED CONDUIT (WITH PULL WIRE...) FOR TELEPHONE.
 - OUTLET ON CEILING FOR POWER TO CO EQUIPMENT. WIRE SIZE TO BE AS SPECIFIED BY CO EQUIPMENT SUPPLIER. CONNECT TO EQUIPMENT WITH FLEXIBLE CONDUIT.

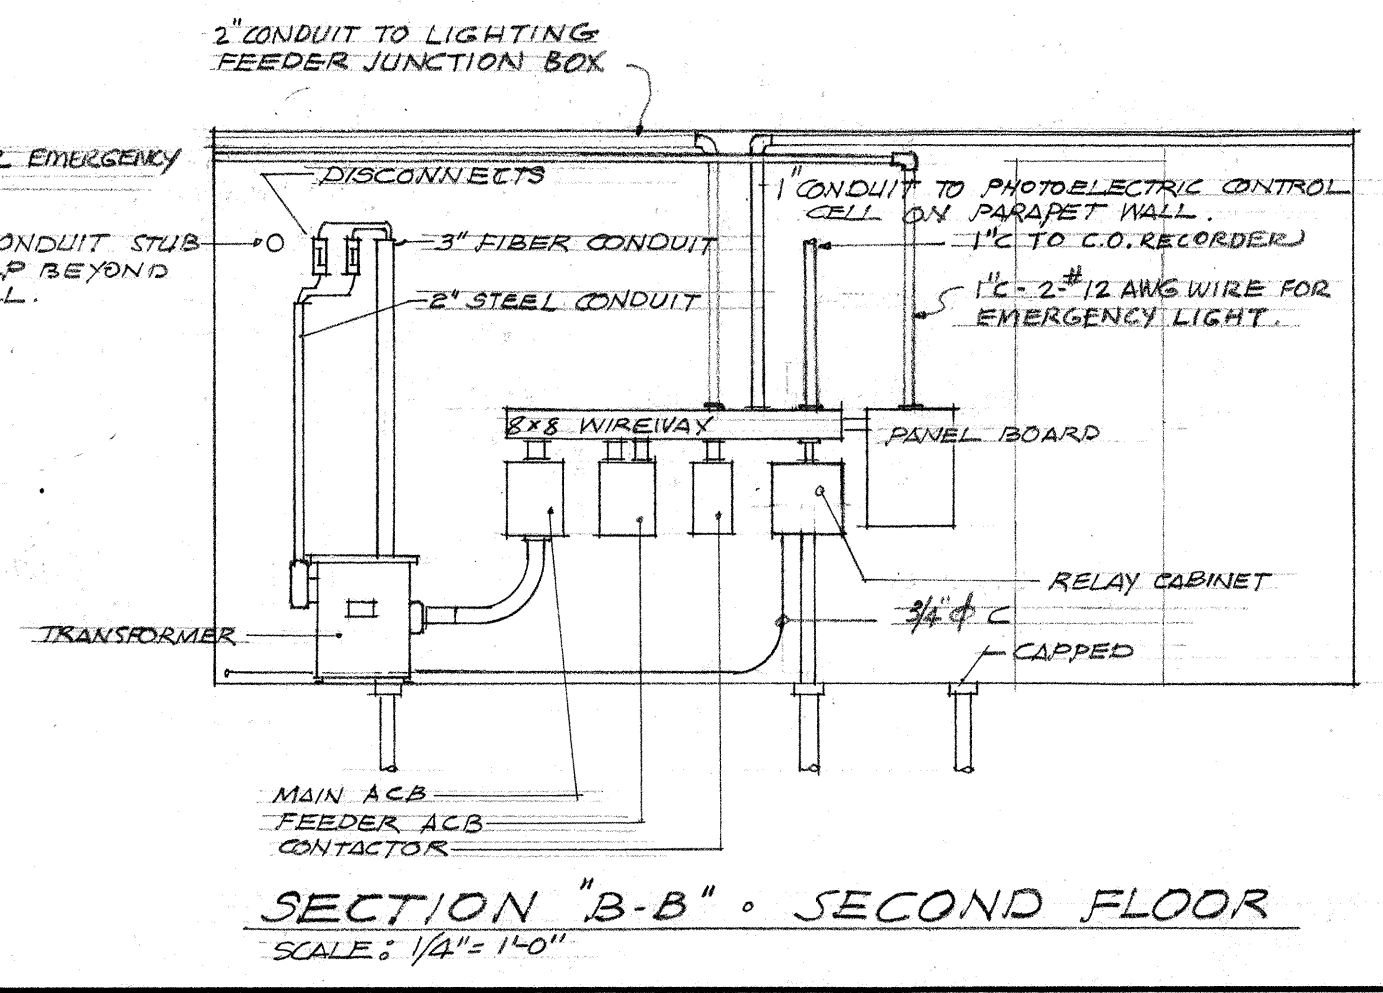

See Sheet 45.A for Revised Arrangement of Equipment and additional stubs for future tunnel.

TERRITORIAL HIGHWAY DEPARTMENT
TERRITORY OF HAWAII
ELECTRICAL
PORTAL #1 ELECTRICAL PLAN
NUUANU PALI TUNNELS
PALI ROAD
PROJ. NO. S 216 (5)
SCALES: AS NOTED DATE: AUG 27, 1954





JAMES J. OBERHAUSEN
ELECTRICAL ENGINEER

SHEET No. 3 OF 2 SHEETS

5708.45

DATE: _____
DESIGNED BY: _____
CHECKED BY: _____
QUANTITIES BY: _____
NOTE BOOK NO. _____

FED. ROAD DIST. NO.	STATE	FED. AID PROJ. NO.	FISCAL YEAR	SHEET NO.	TOTAL SHEETS

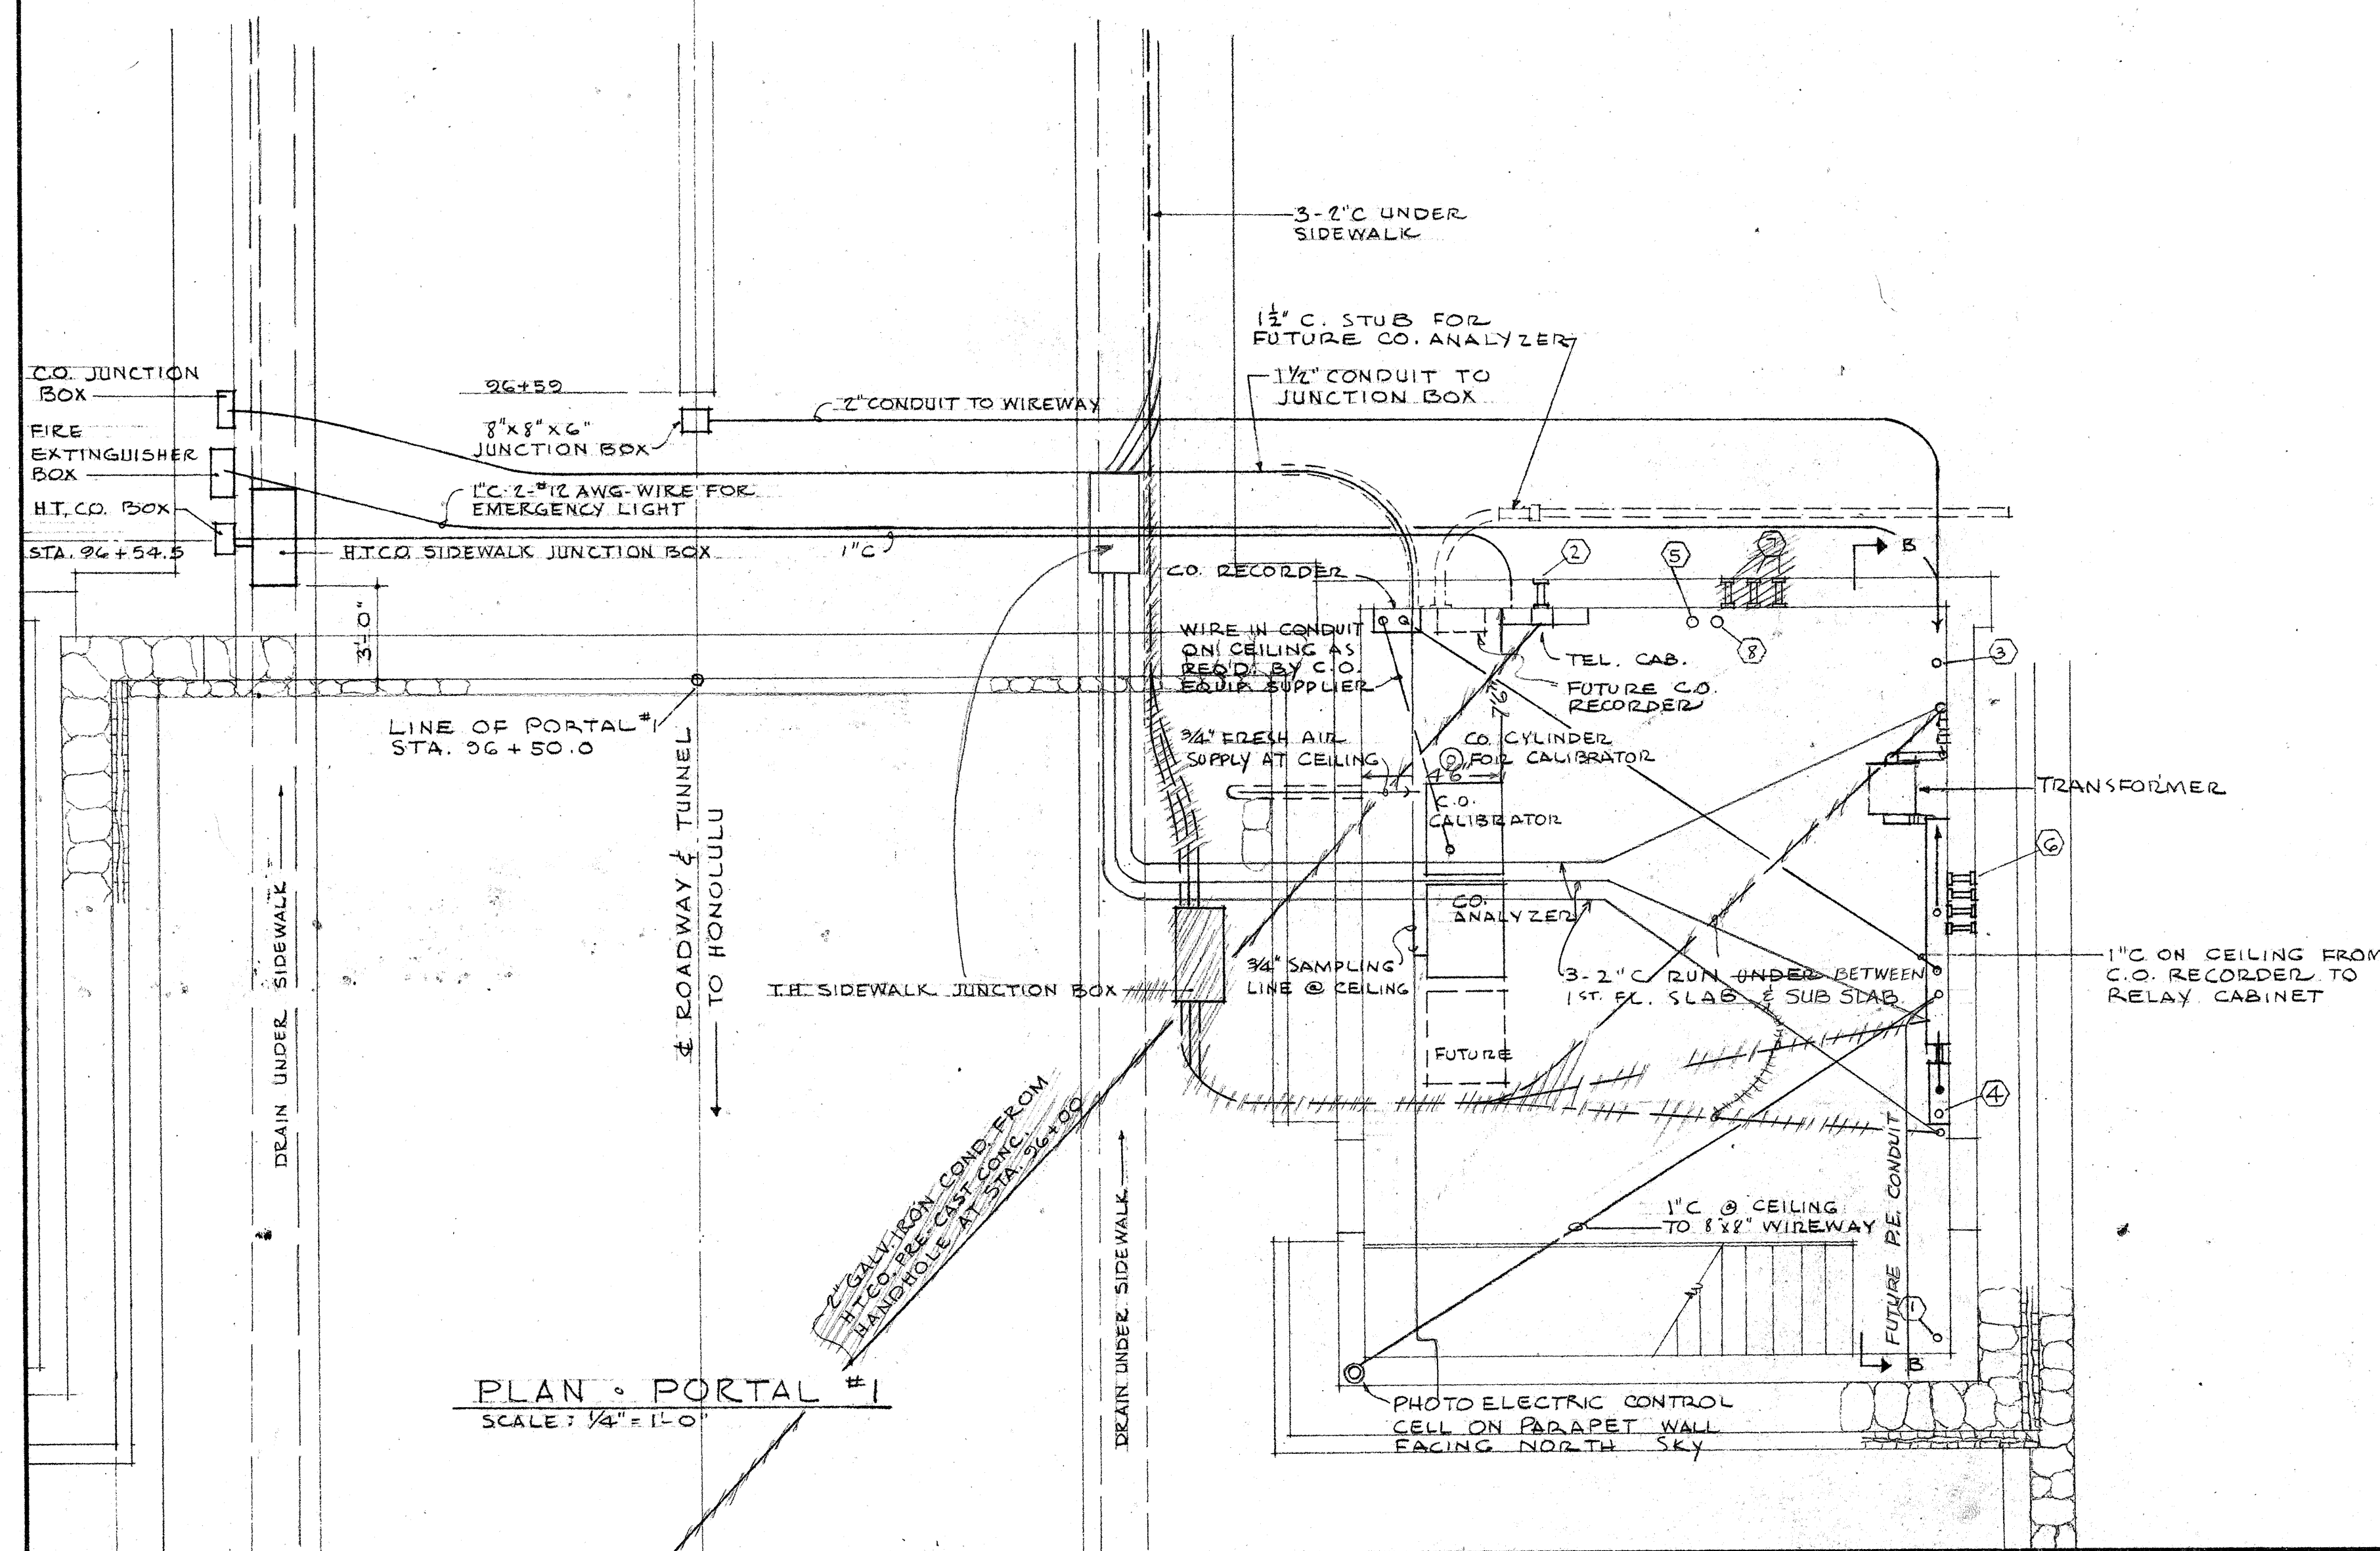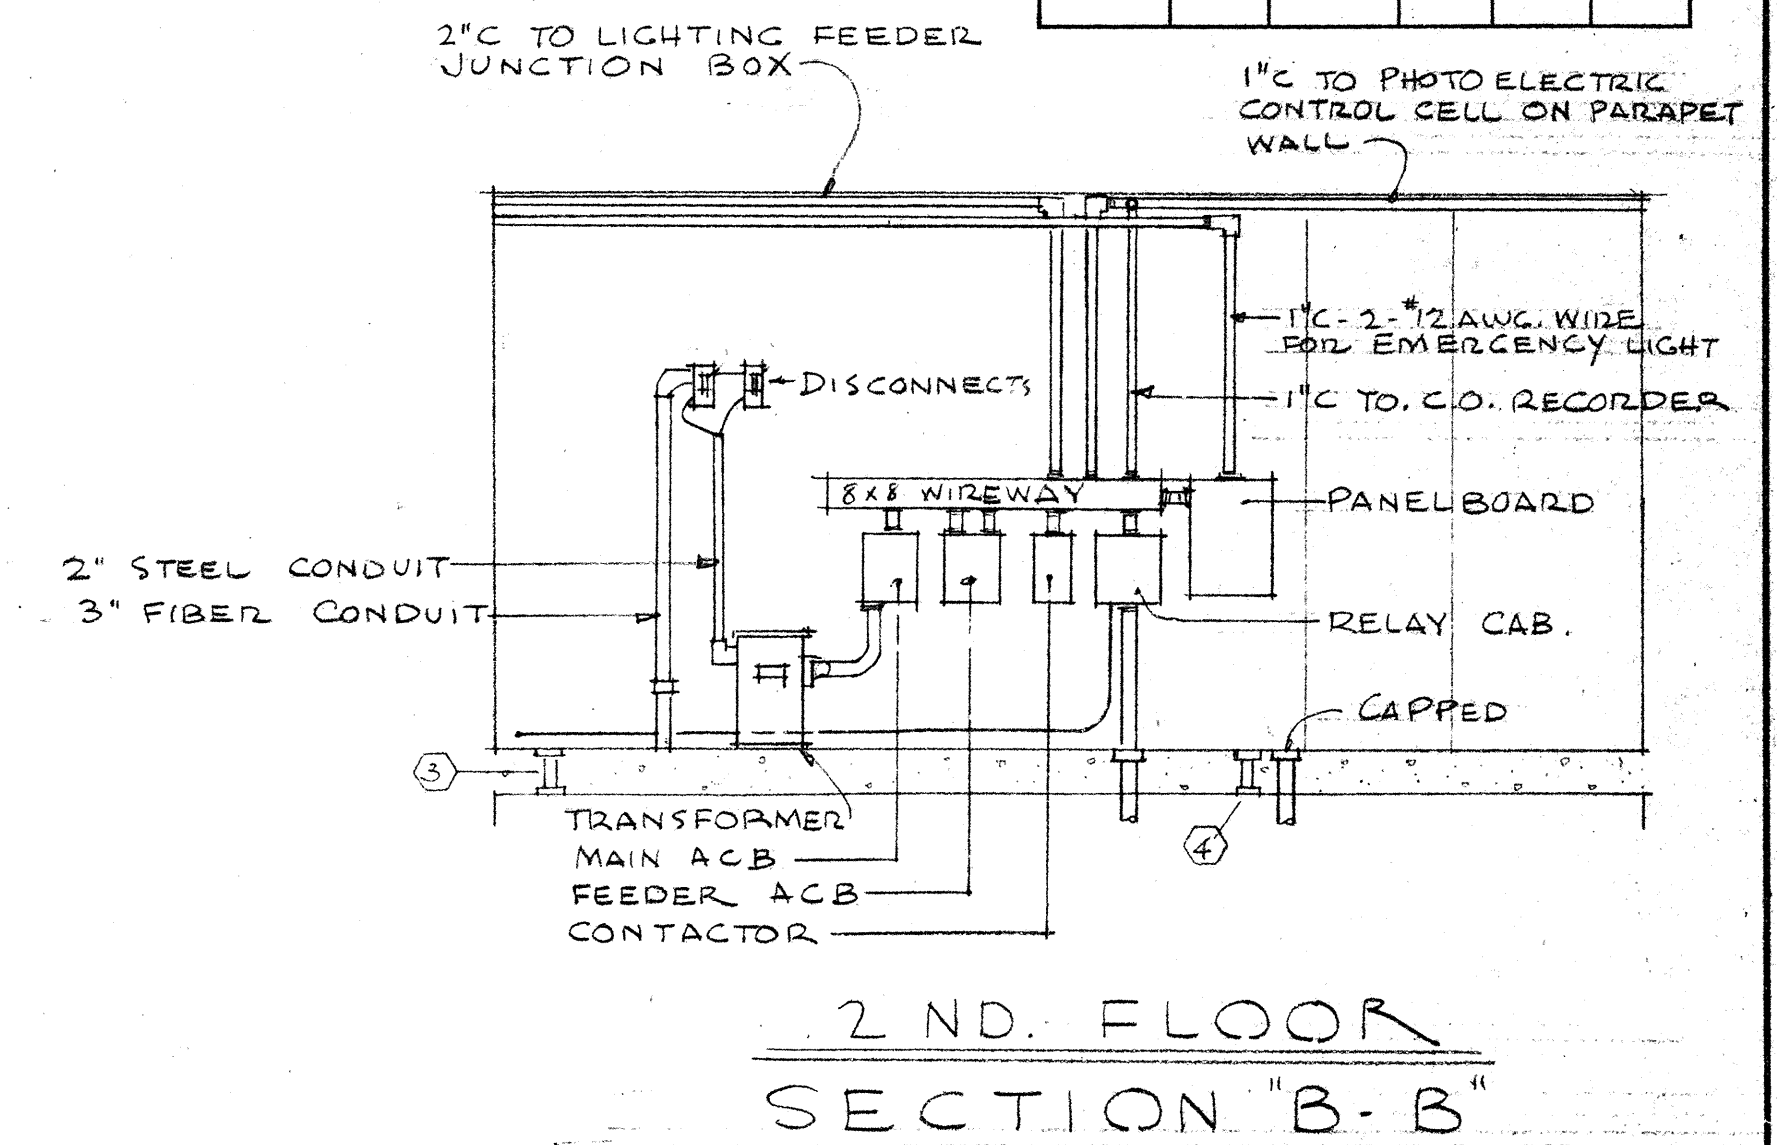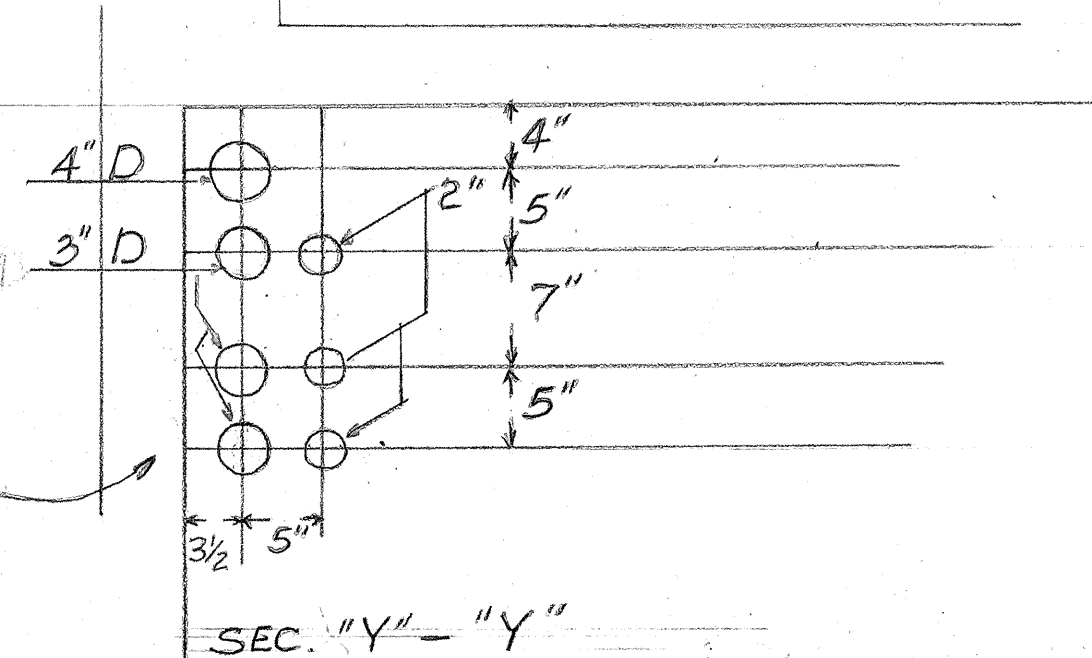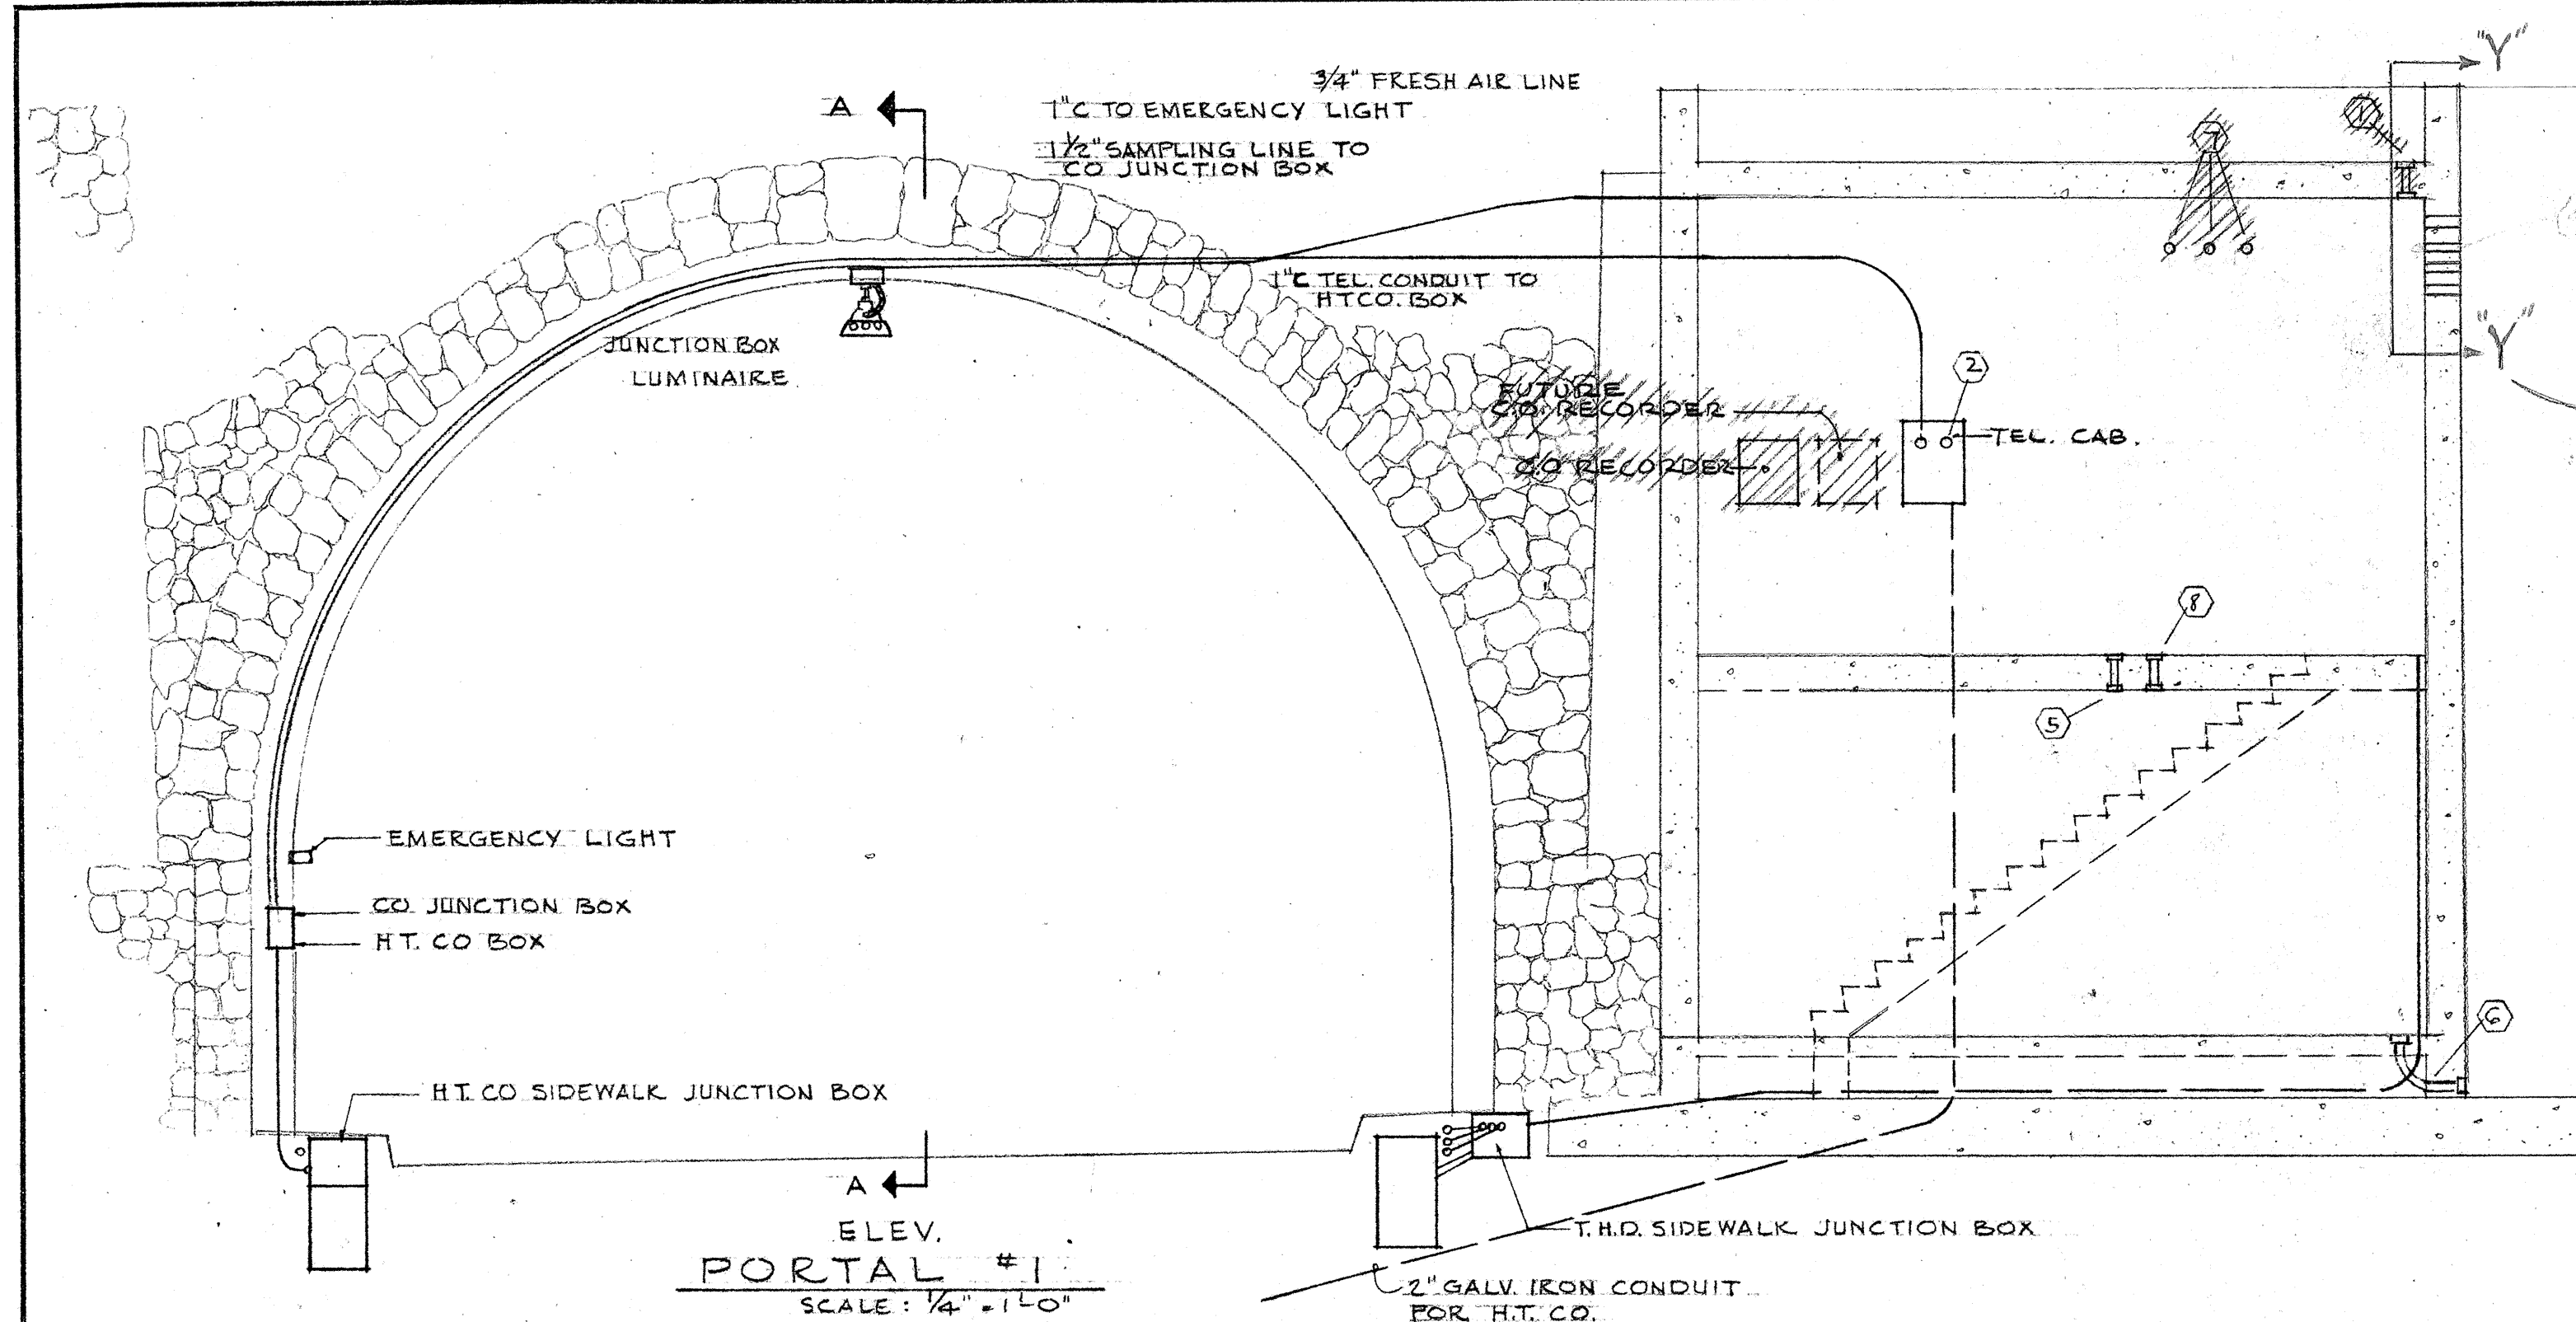

SCHEDULE OF CONDUIT SLEEVES TO BE ADDED TO PROVIDE FOR SECOND BORE

- ① 1" CONDUIT THROUGH ROOF FOR FUTURE PHOTO-CELL CONTROL.
- ② 1" CONDUIT THROUGH WALL FOR FUTURE H.T.CO. SERVICE TO EMERGENCY PHONES.
- ③ 2" CONDUIT THROUGH 2nd FLOOR SLAB FOR FUTURE ROADWAY LIGHTING.
- ④ 2" CONDUIT THROUGH 2nd FLOOR SLAB FOR SPARE.
- ⑤ 2" CONDUIT THROUGH 2nd FLOOR SLAB FOR FUTURE CONTROL.
- ⑥ 4-2" CONDUITS THROUGH FIRST FLOOR SLAB TO OUTSIDE FOR FUTURE CONTROL, ROADWAY LIGHTING, TRAFFIC SIGNALS, AND SPARE.
- ⑦ 3-2" CONDUITS THROUGH WALL FOR FUTURE TUNNEL LIGHTING.
- ⑧ 2" CONDUIT THROUGH 2nd FLOOR SLAB FOR FUTURE TRAFFIC SIGNALS.
- ⑨ 1" CONDUIT THROUGH WALL FOR FUTURE EMERGENCY LIGHT.

CHASES MAY BE INSTALLED INSTEAD OF CONDUITS. EACH CONDUIT EMERGING FROM MASONRY SHALL BE TERMINATED IN A FLUSH THREADED COUPLING.

THIS SHEET REARRANGES EQUIPMENT LAYOUT SHOWN ON SHEET 5708.45 AND INDICATES ADDITIONAL CONDUIT SLEEVES WHICH WILL BE USED FOR SECOND BORE WITH SYMBOLS SUCH AS ⑤. SEE SCHEDULE.










TERRITORIAL HIGHWAY DEPARTMENT
TERRITORY OF HAWAII

JAN. 10, 1957

SHEET NO. OF SHEETS

5708 45A

SURVEY PLOTTED BY	DATE
DESIGNED BY	
DRAWN BY	
TRACED BY	
QUANTITIES CHECKED BY	
NOTE BOOK	
NO.	

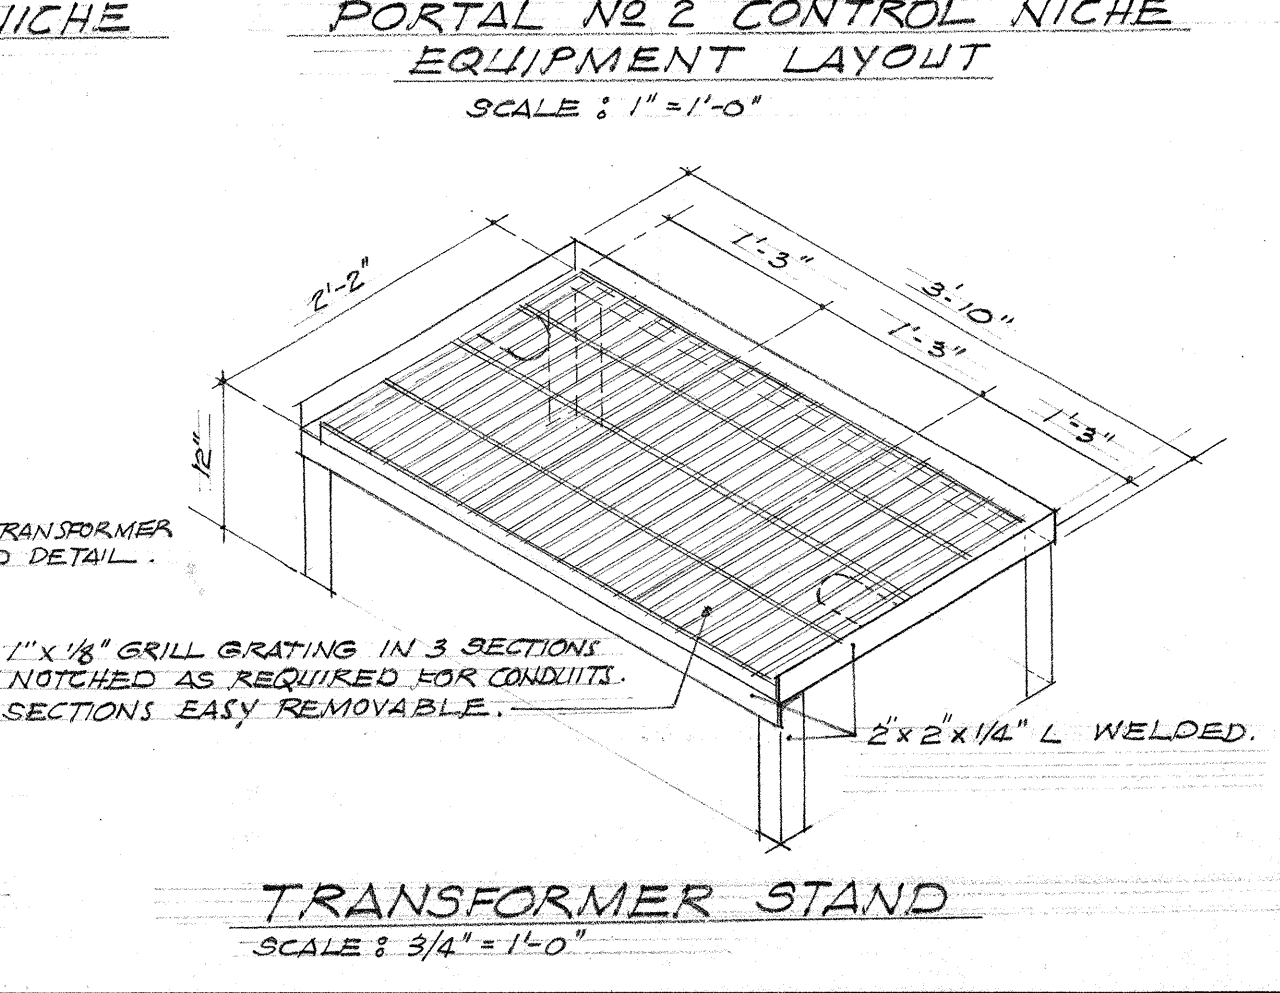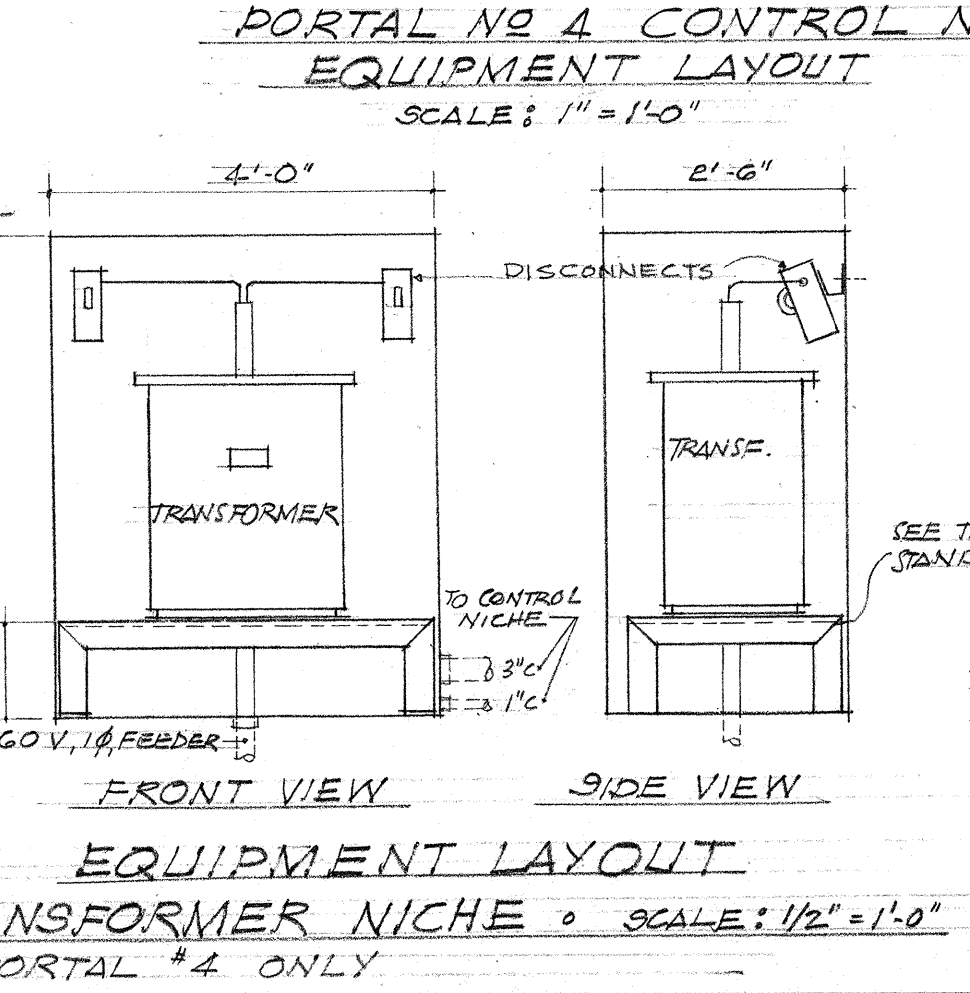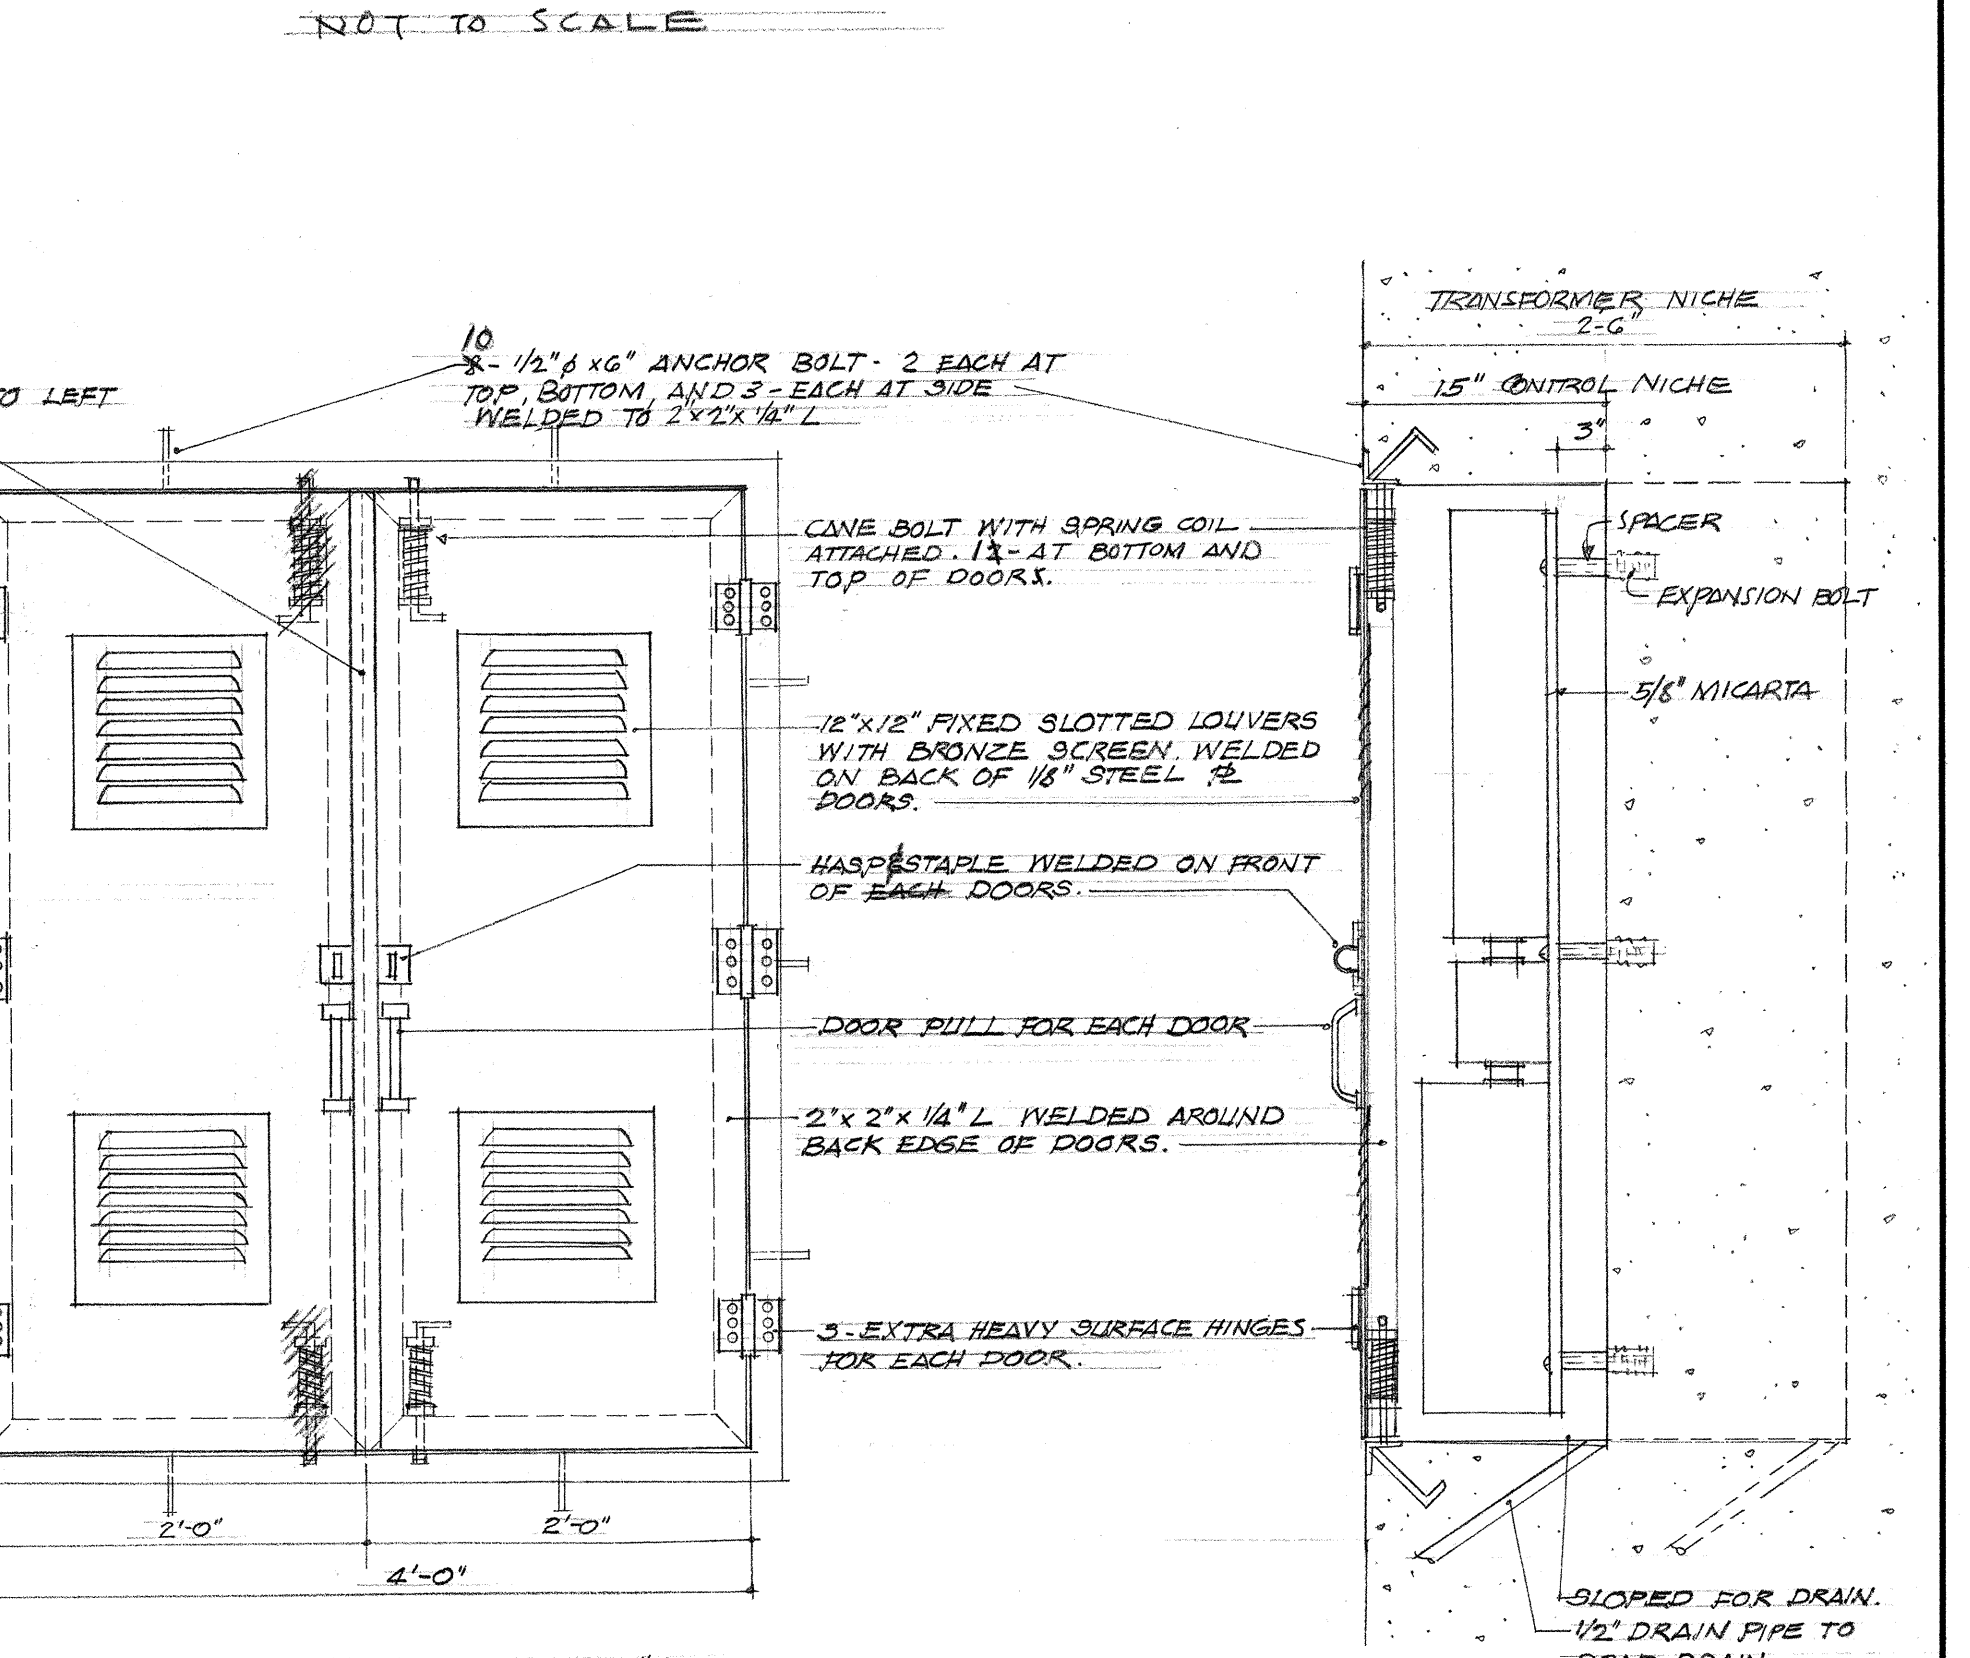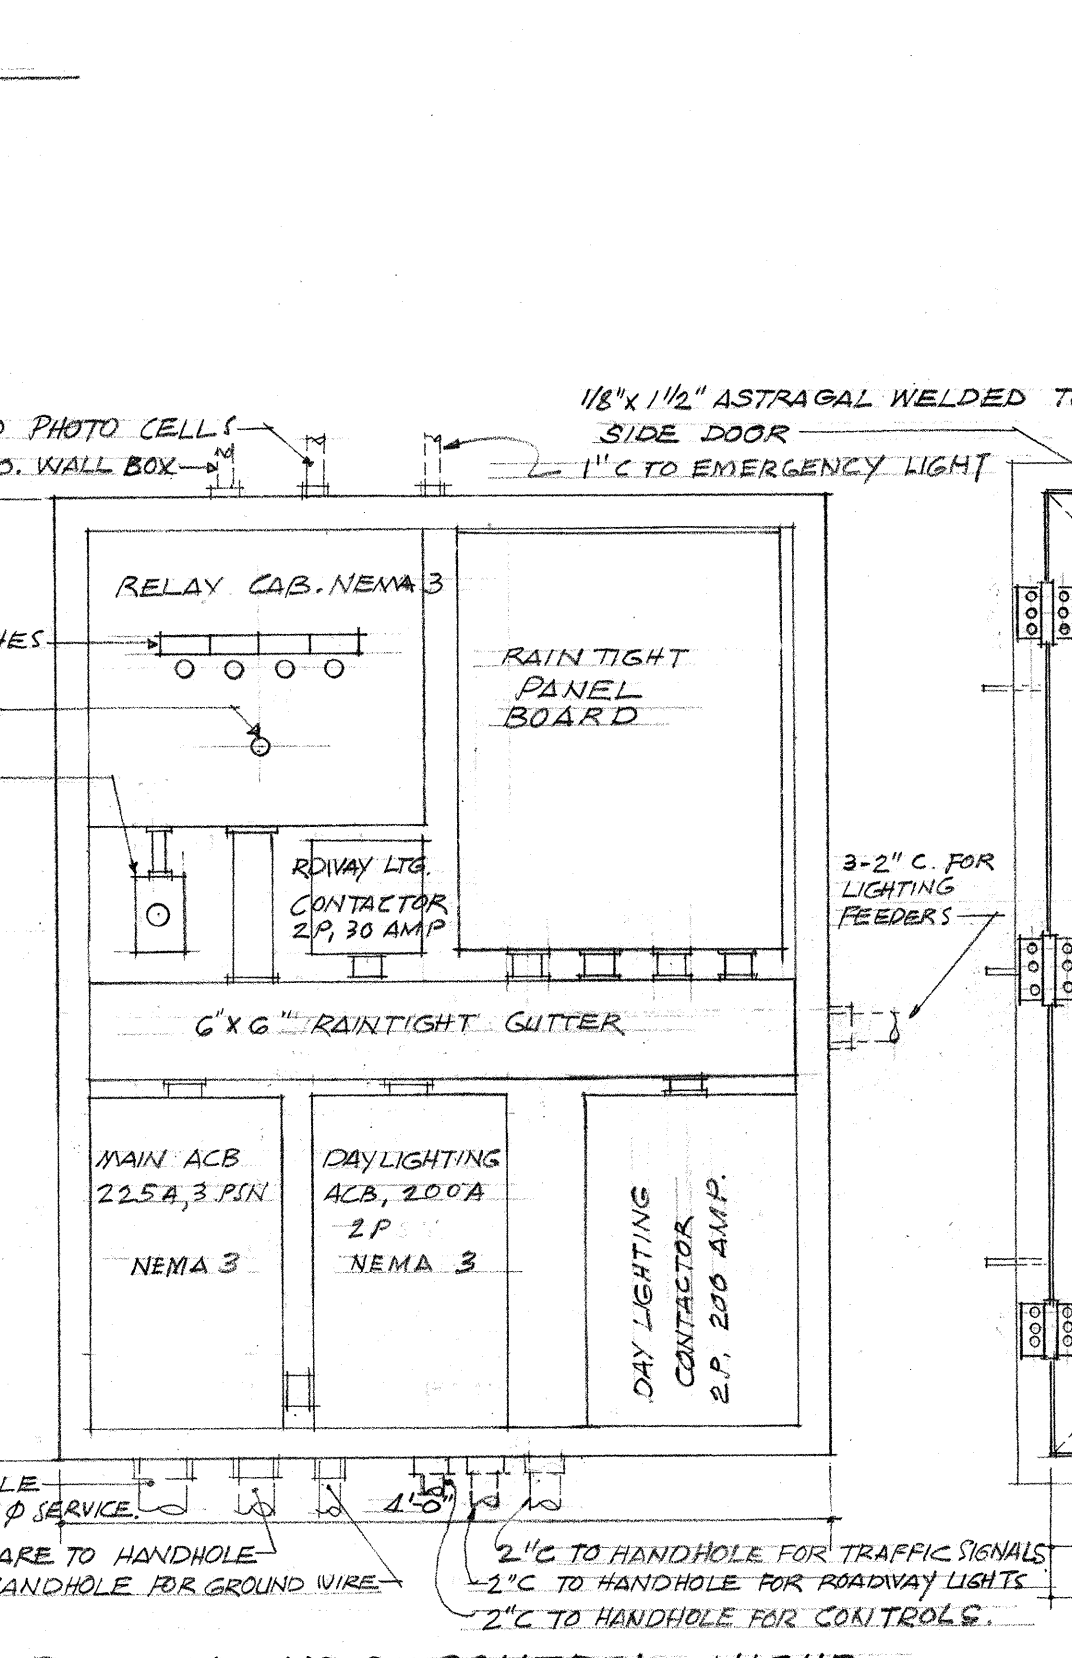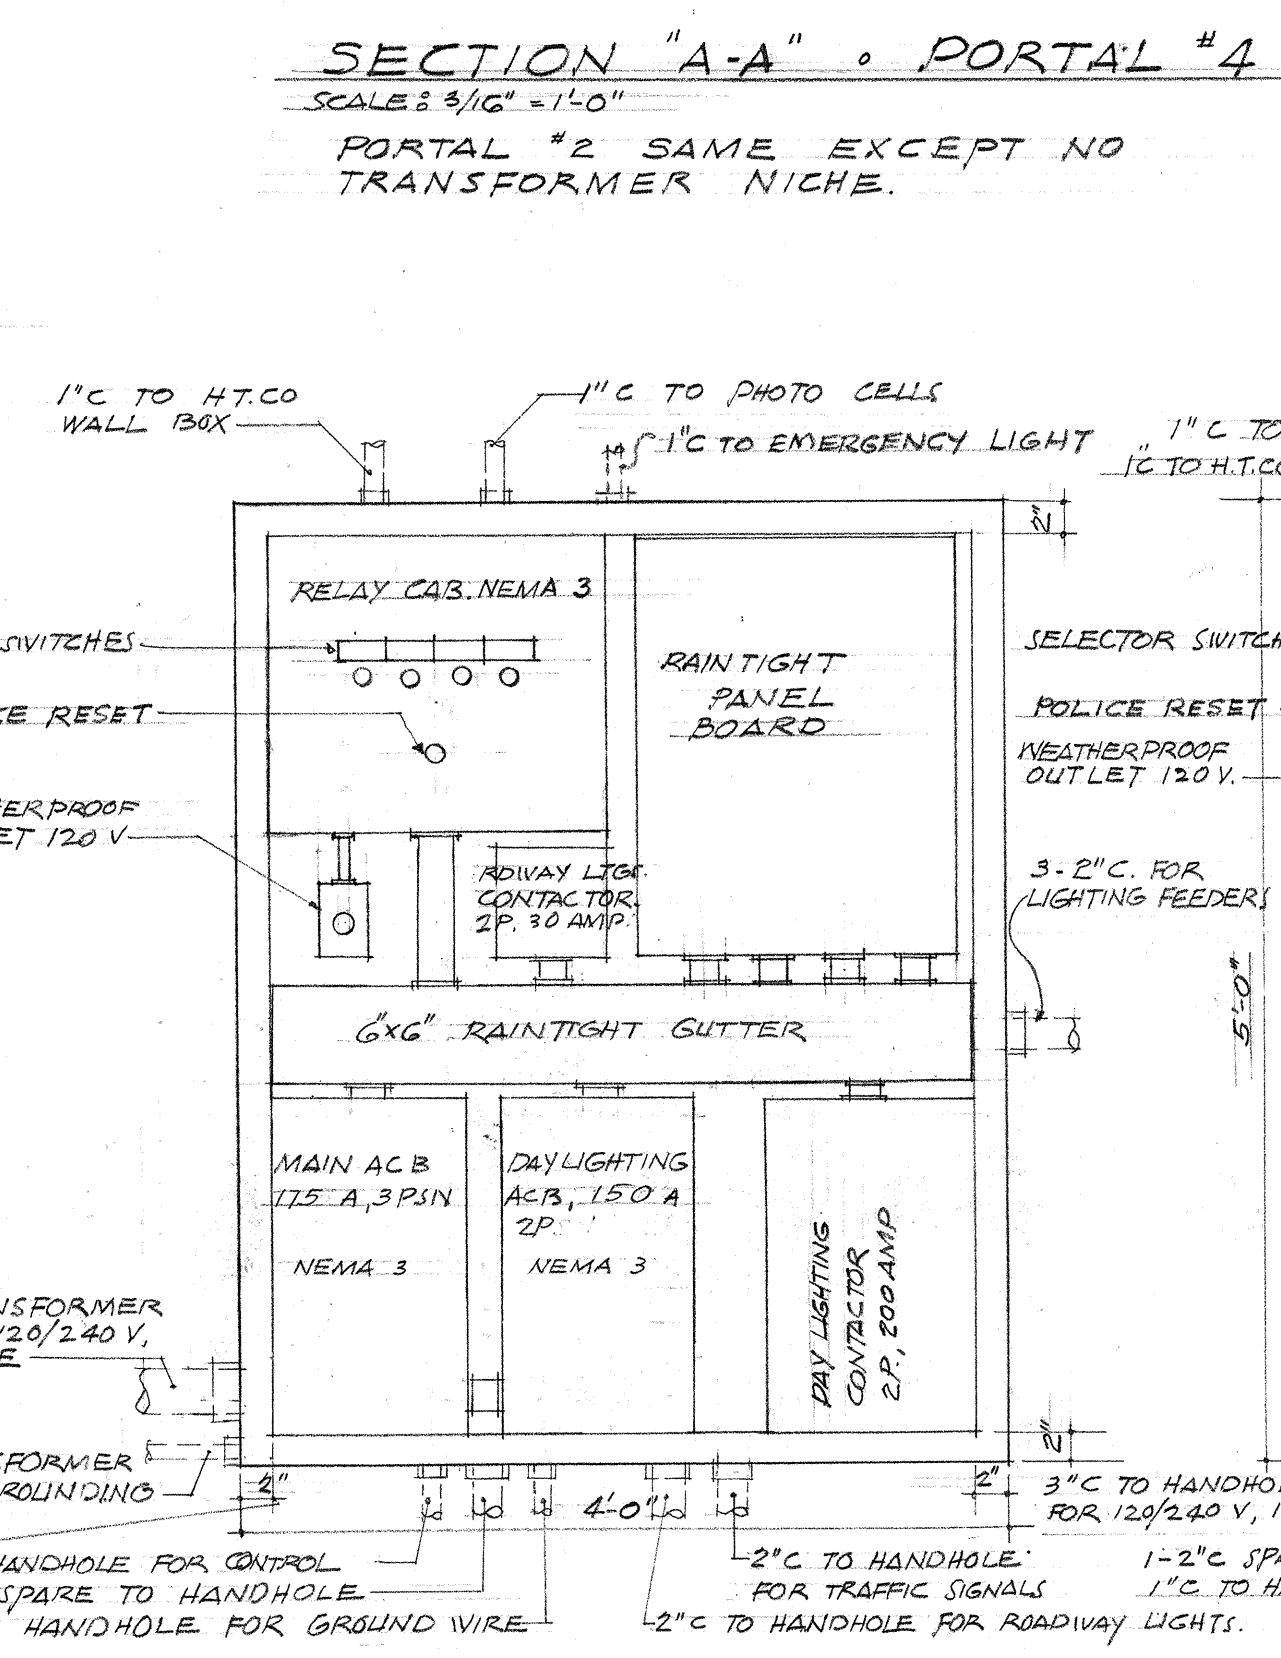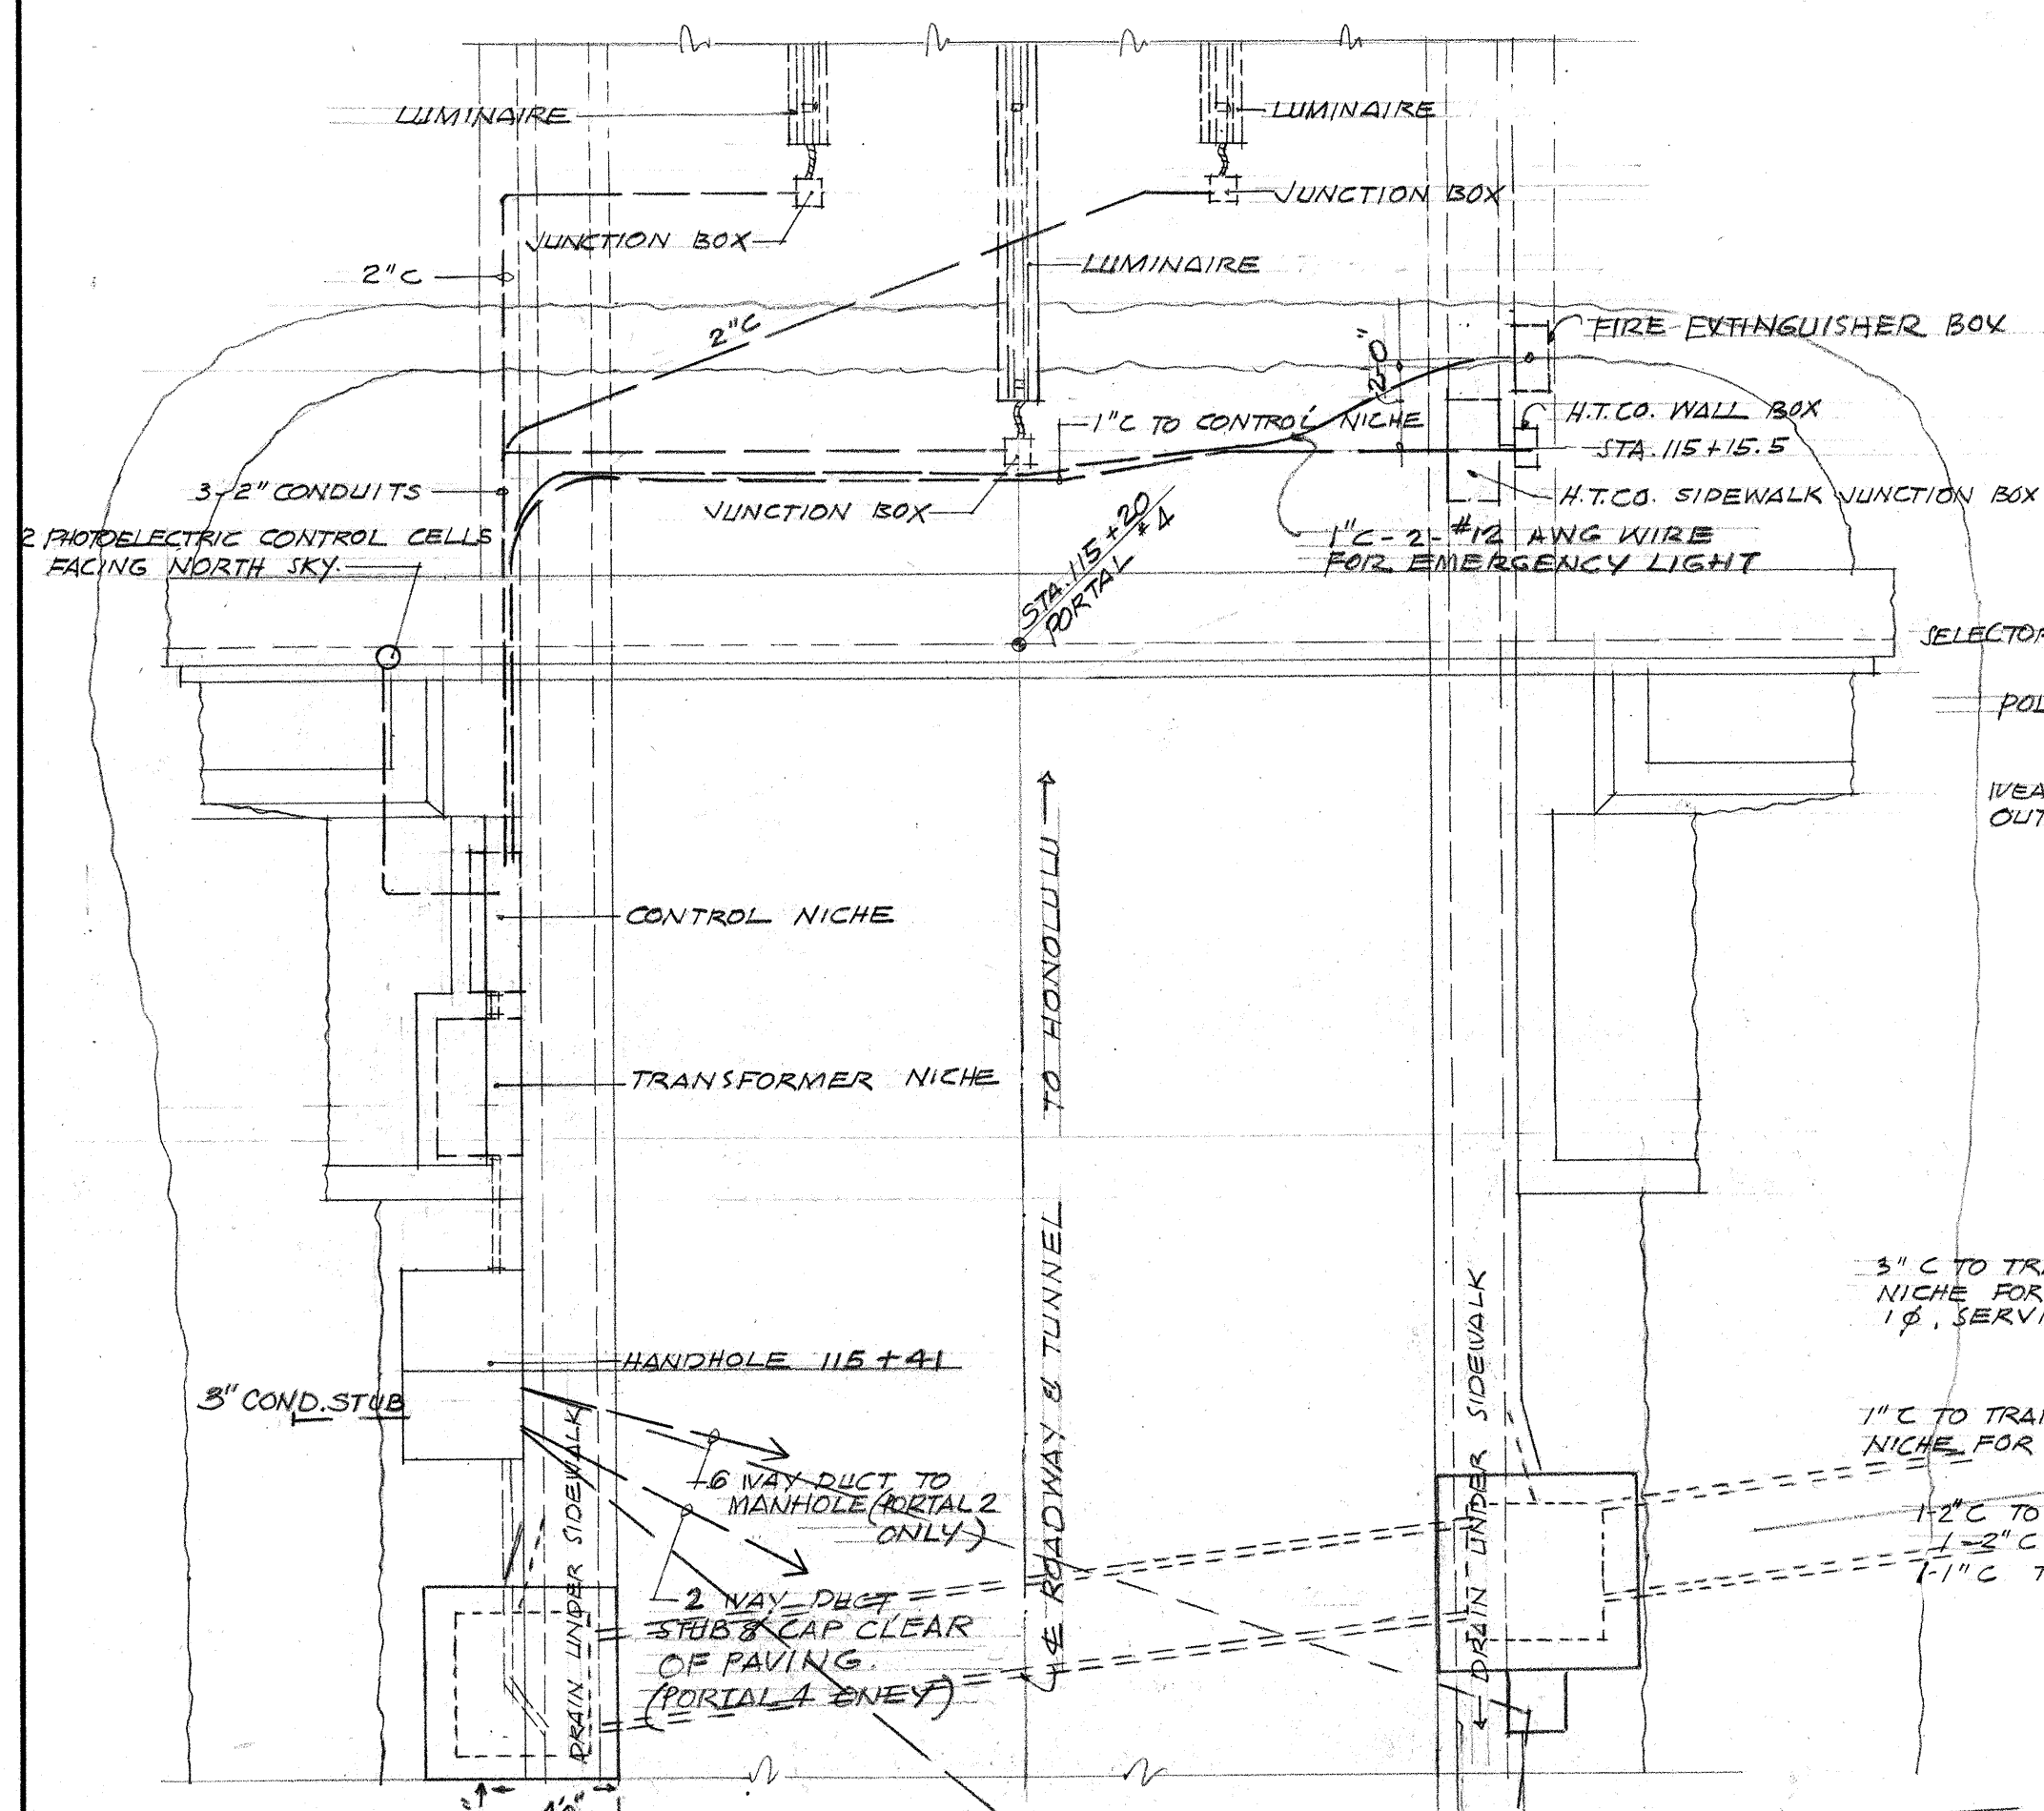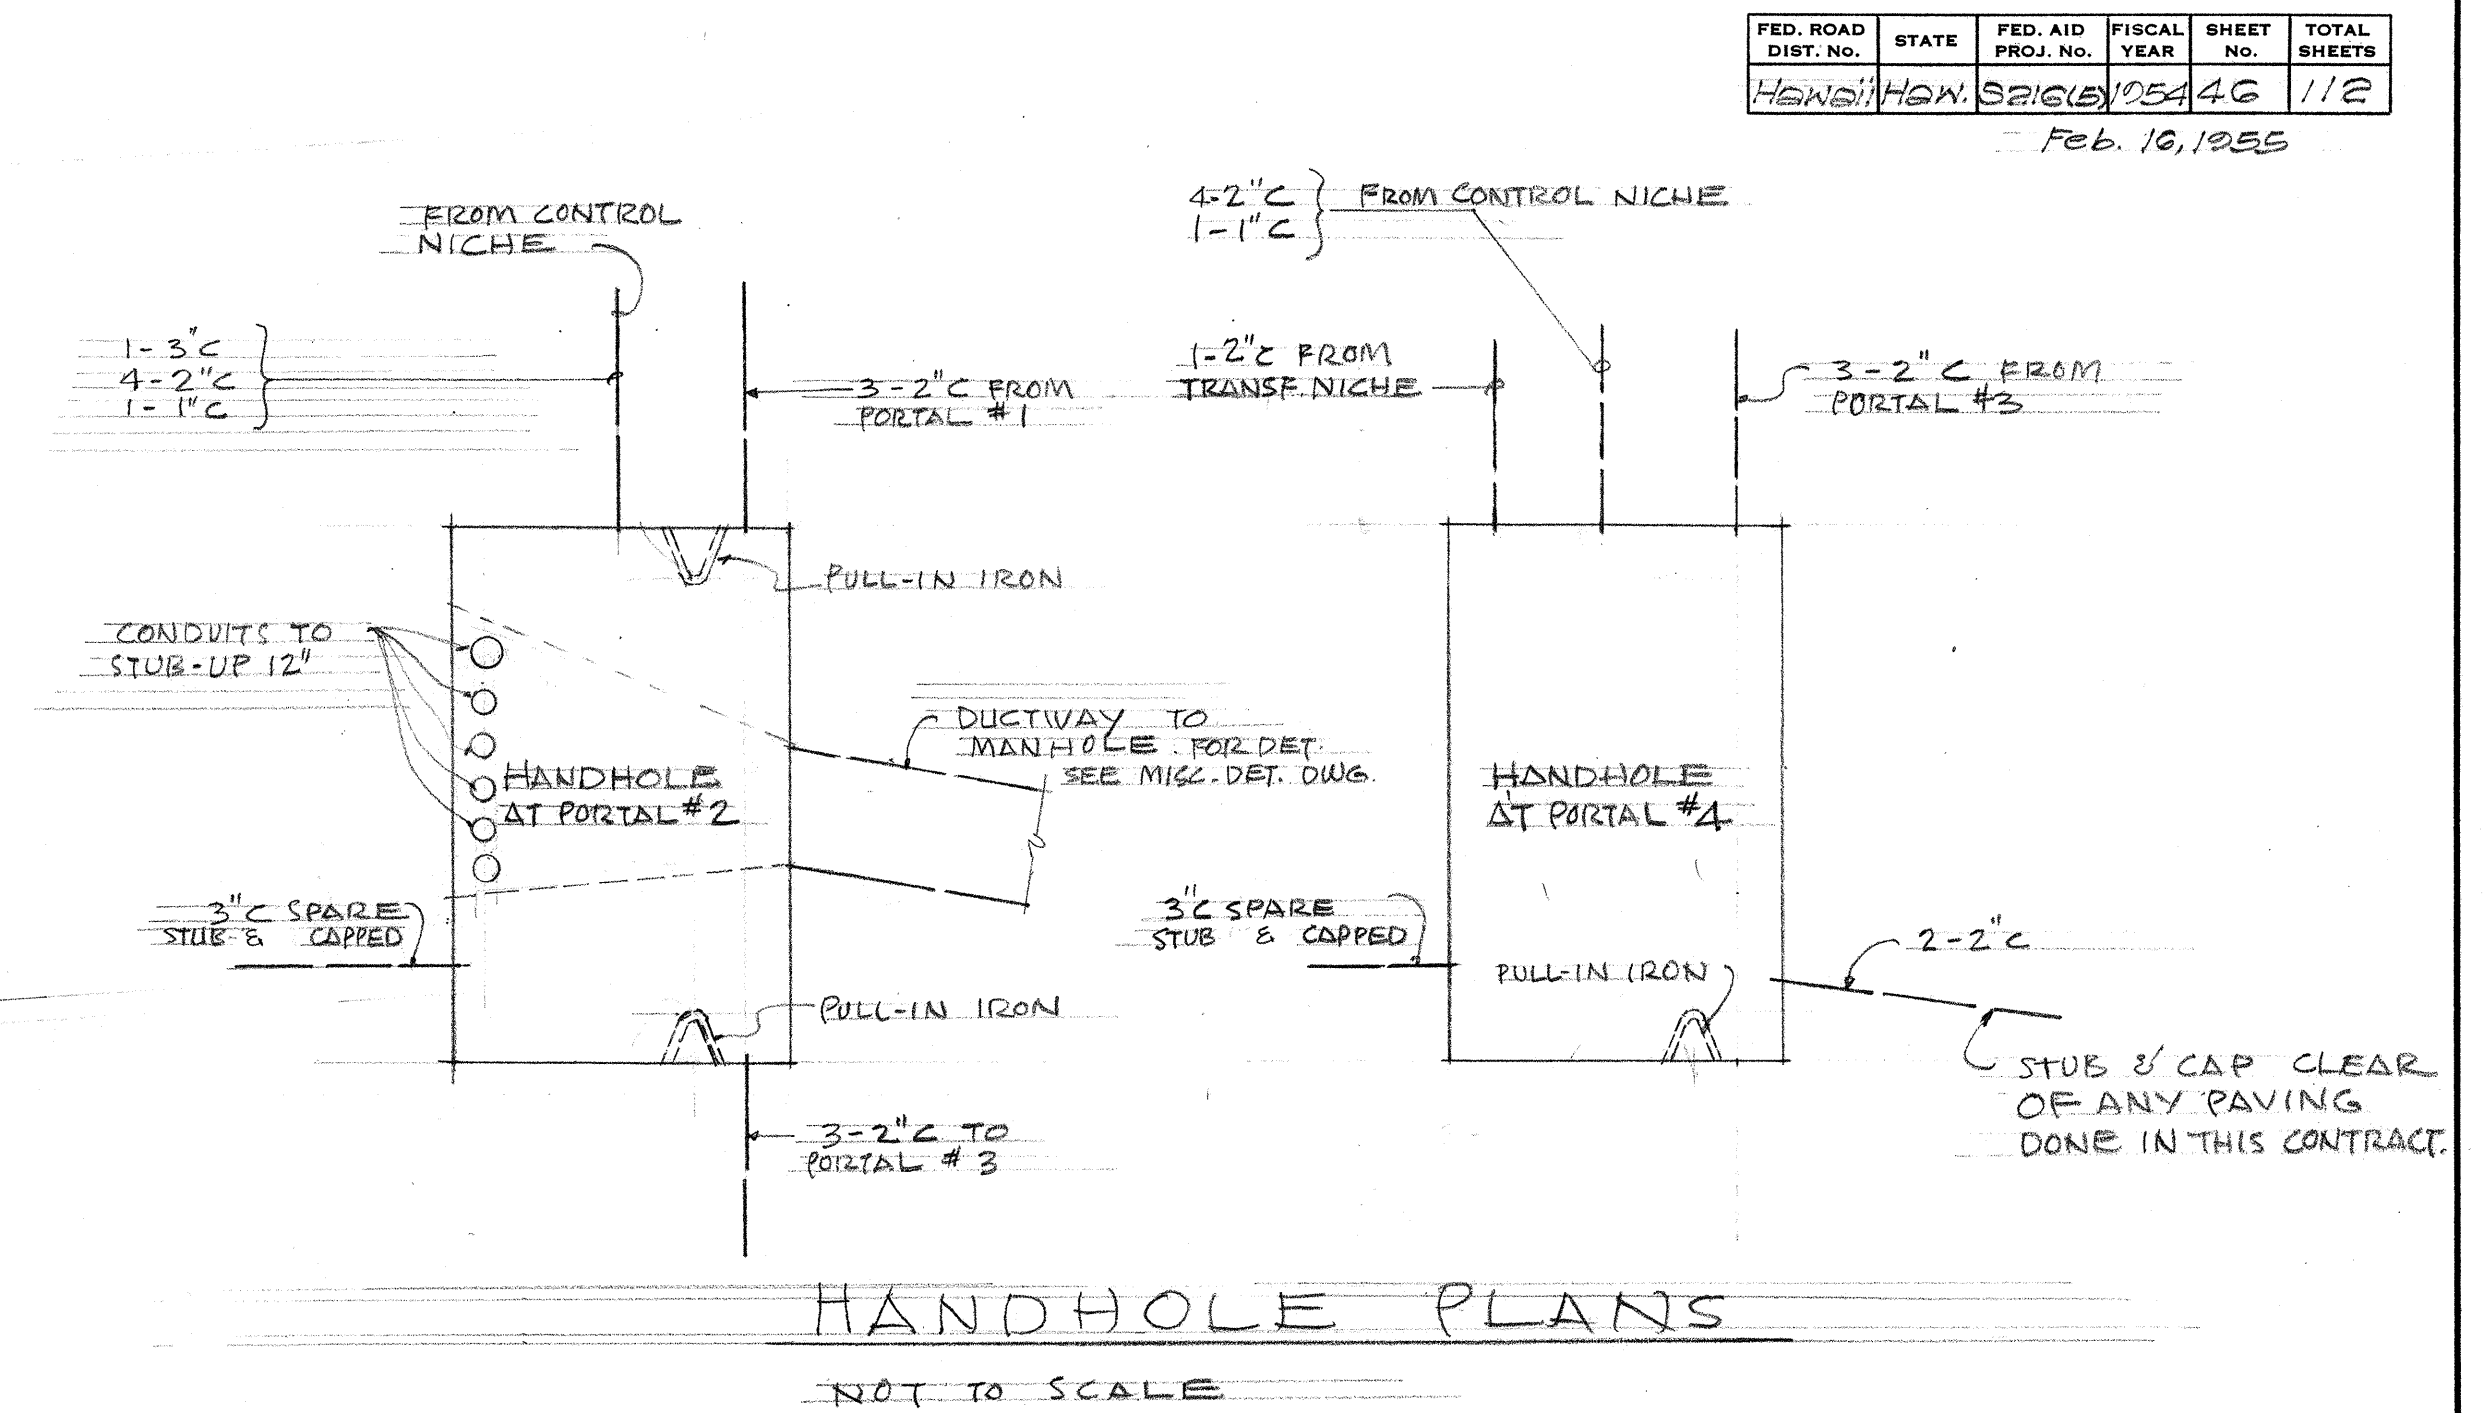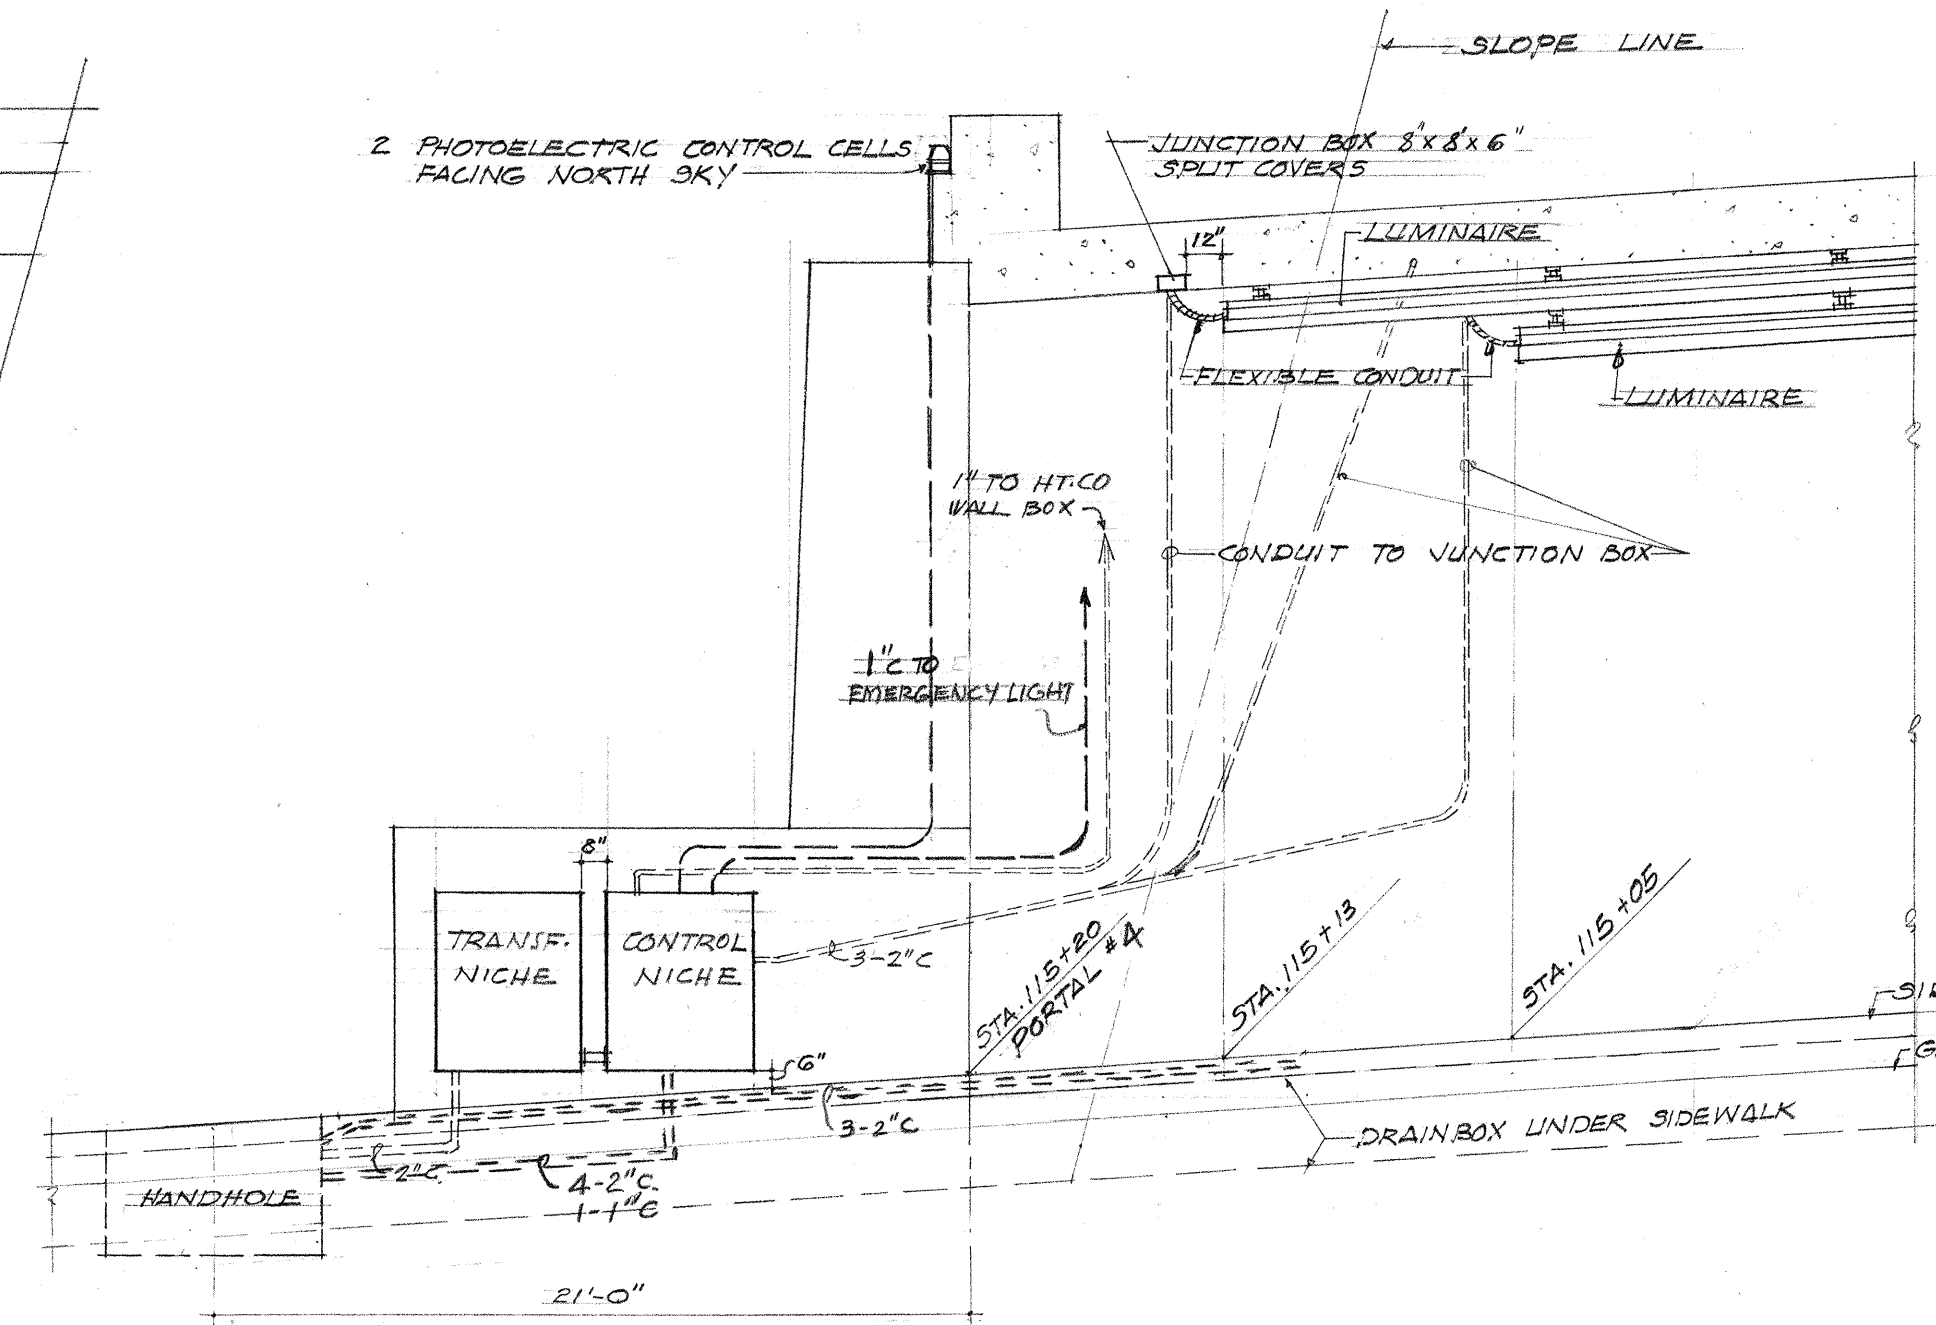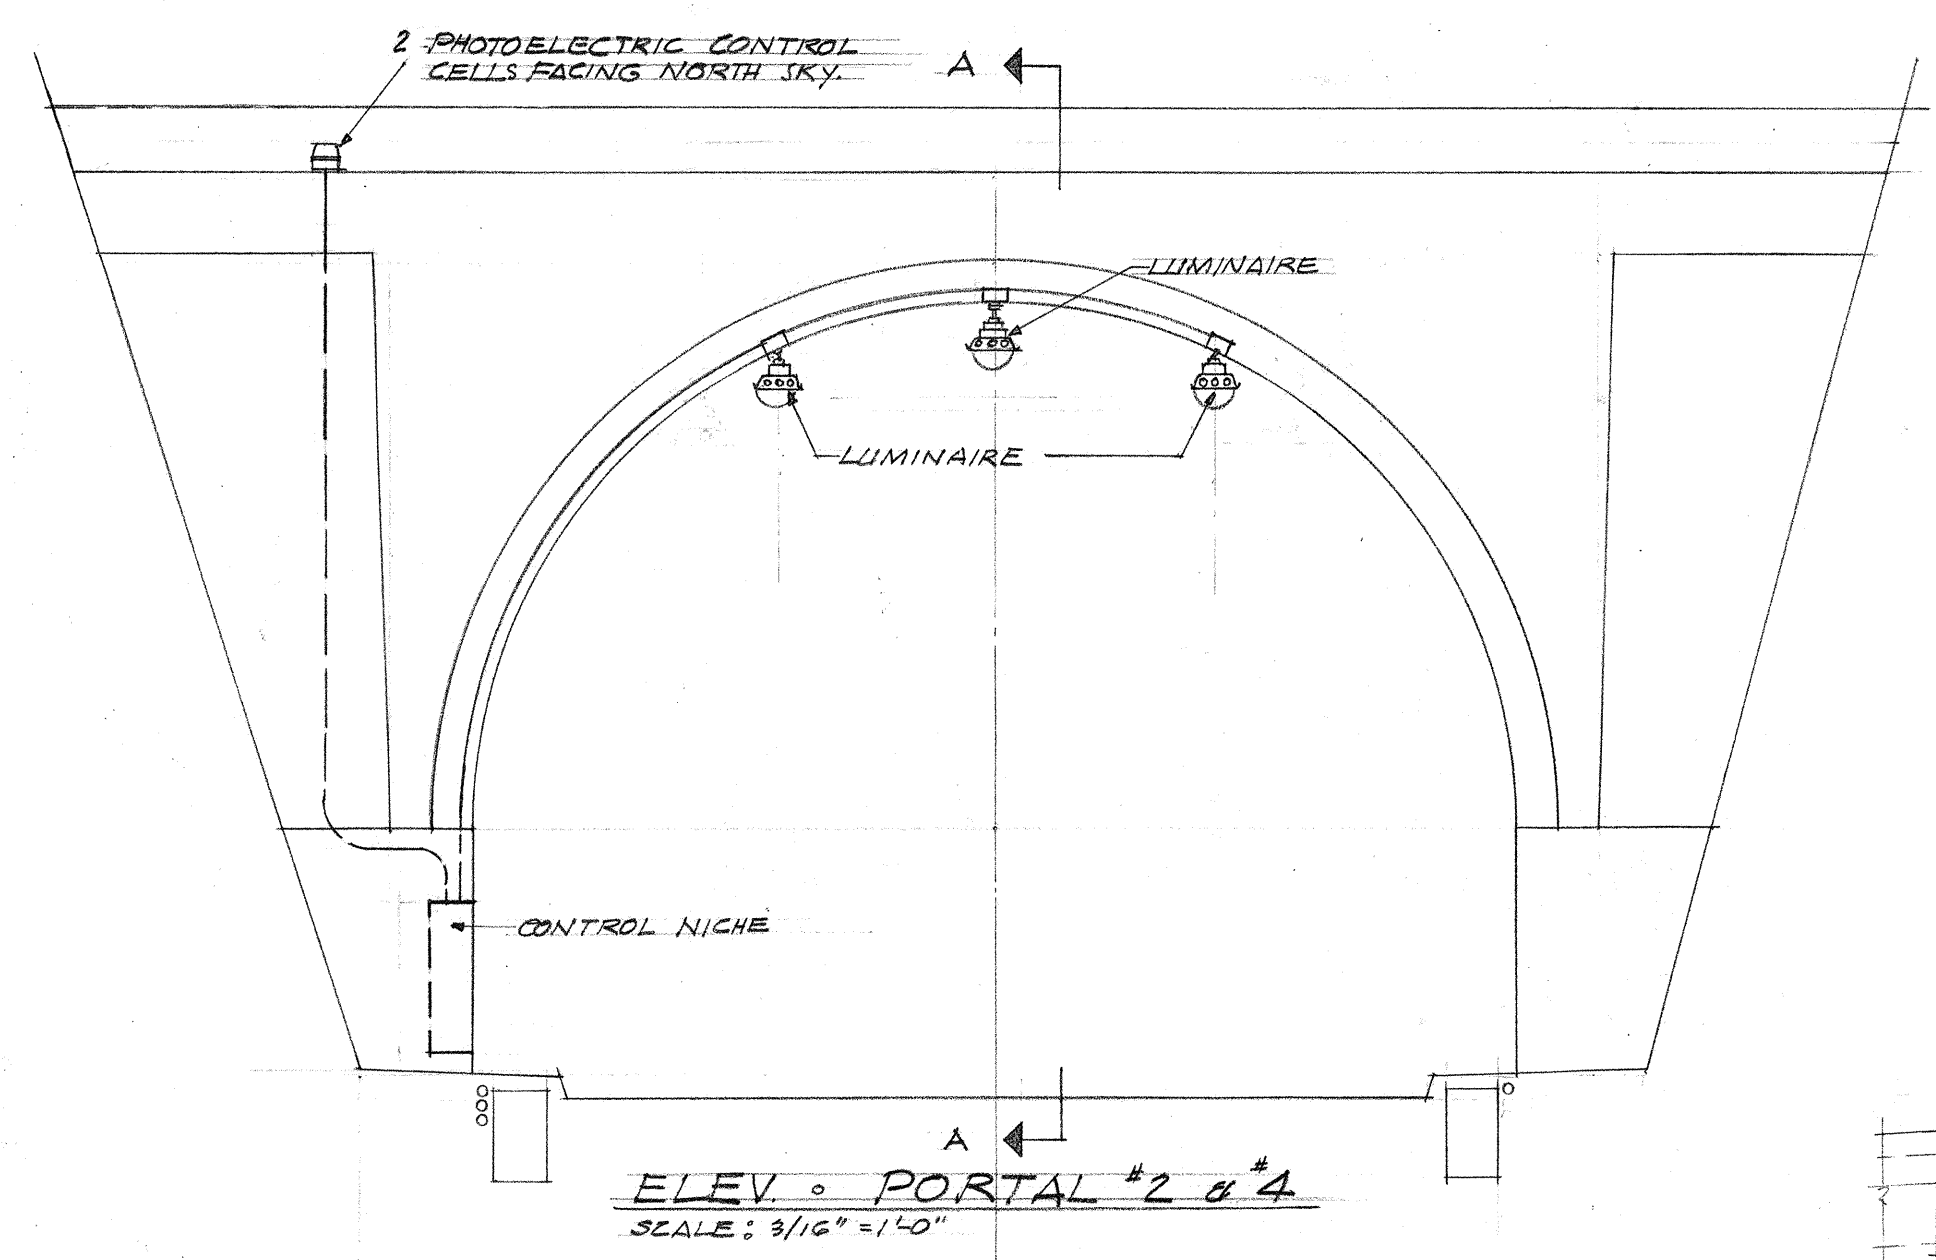

DOOR DETAILS - FRONT VIEW
SCALE: 1" = 1'-0"

AFTER PURCHASE OF EQUIPMENT, CONTRACTOR SHALL SUBMIT A DIMENSIONED DRAWING OF EACH NICHE EQUIPMENT LAYOUT FOR APPROVAL.

TERRITORIAL HIGHWAY DEPARTMENT
TERRITORY OF HAWAII

ELECTRICAL

PORTAL #2 & #4 ELECTRICAL PLAN

NUUANU PALI TUNNELS

PALI ROAD

PROJ. NO. S 216(S)

SCALES: AS NOTED DATE: AUG 27, 1954

JAMES J. OBERHAUSEN
ELECTRICAL ENGINEER

SHEET No. 4 OF 9 SHEETS

DATE: _____

SURVEY PLOTTED BY: _____


DESIGNED BY: _____

TRACED BY: _____

QUANTITIES BY: _____

CHECKED BY: _____


NO. _____

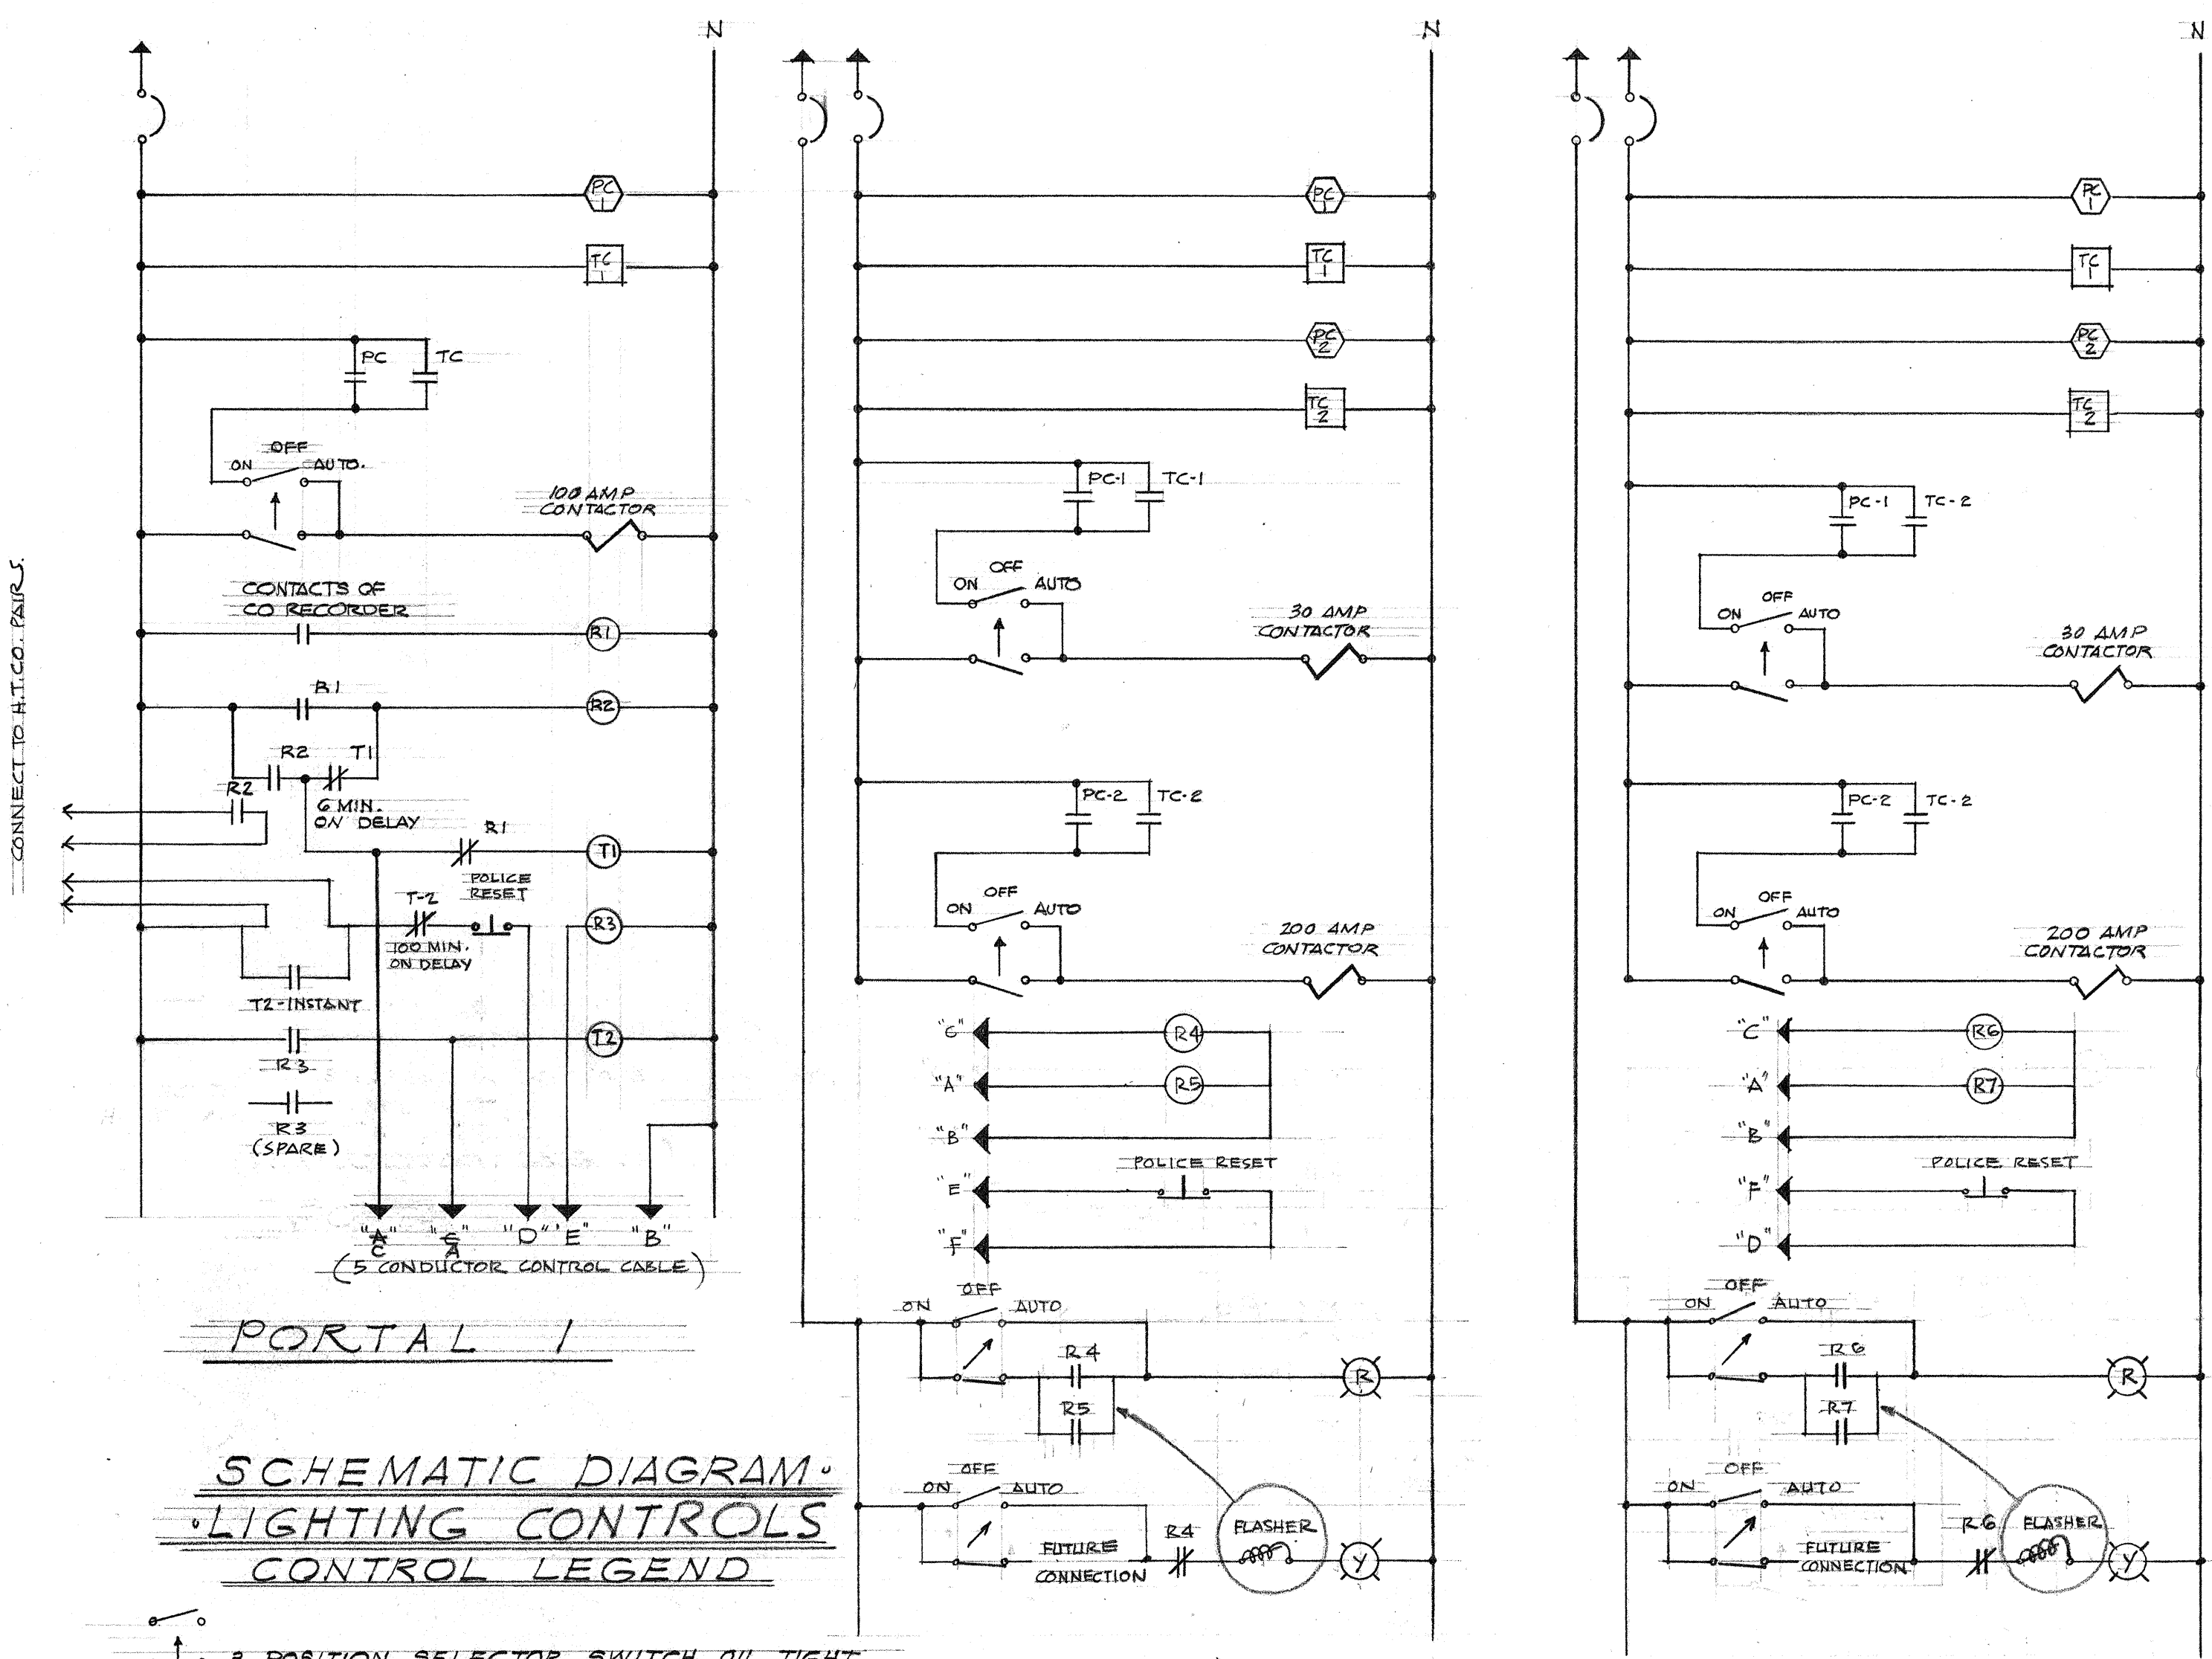




- 3 POSITION SELECTOR SWITCH, OIL TIGHT
- RELAY - FOR CHARACTERISTICS, SEE RELAY SCHEDULE
- TRAFFIC SIGNAL OR ILLUMINATED SIGN
- OPERATING COIL OF MAGNETICALLY HELD CONTACTOR
- PHOTO-CELL
- TIME SWITCH
- NORMALLY OPEN CONTACTS
- NORMALLY CLOSED CONTACTS
- CIRCUIT BREAKER
- PUSH BUTTON, NORMALLY CLOSED, OIL TIGHT

RELAY SCHEDULE


R1, R4, R6 - 1 SET OF N.O. & 1 SET OF N.C. CONTACTS
 R5, R7, R9 - 1 SET OF N.O. CONTACTS
 R2, R3, R8 - 2 SETS OF N.O. CONTACTS
 T1, T2 - TIMING RELAY, 3 TO 100 MIN., 1 INSTANTANEOUS CONTACT, 1 N.O., AND 1 N.C. TIMED CONTACTS

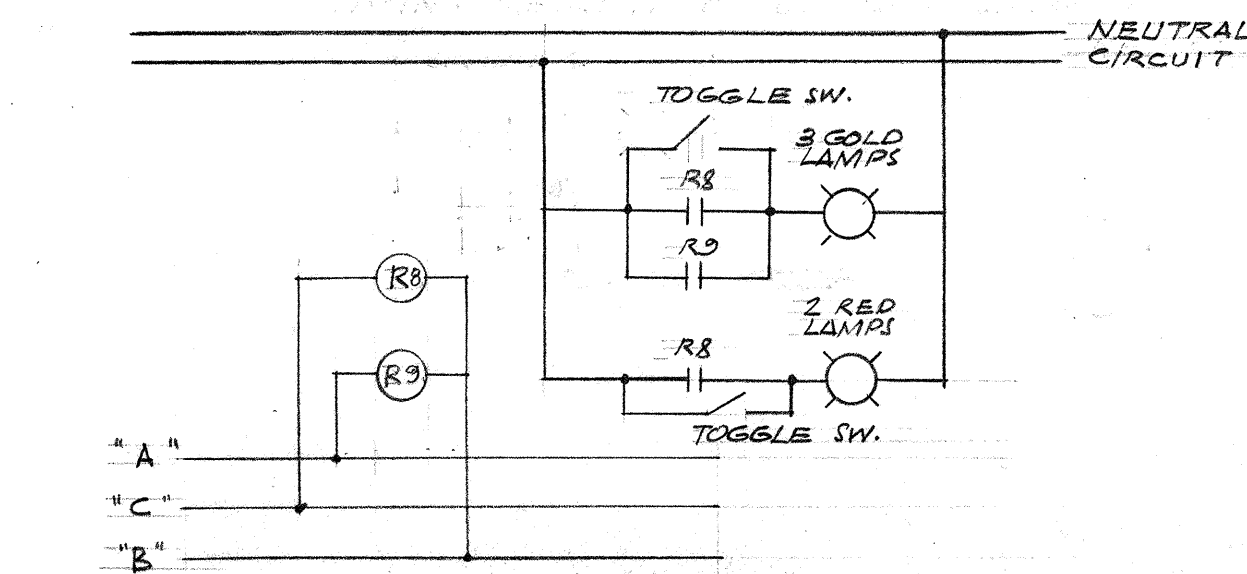

ILLUMINATED SIGN WIRING

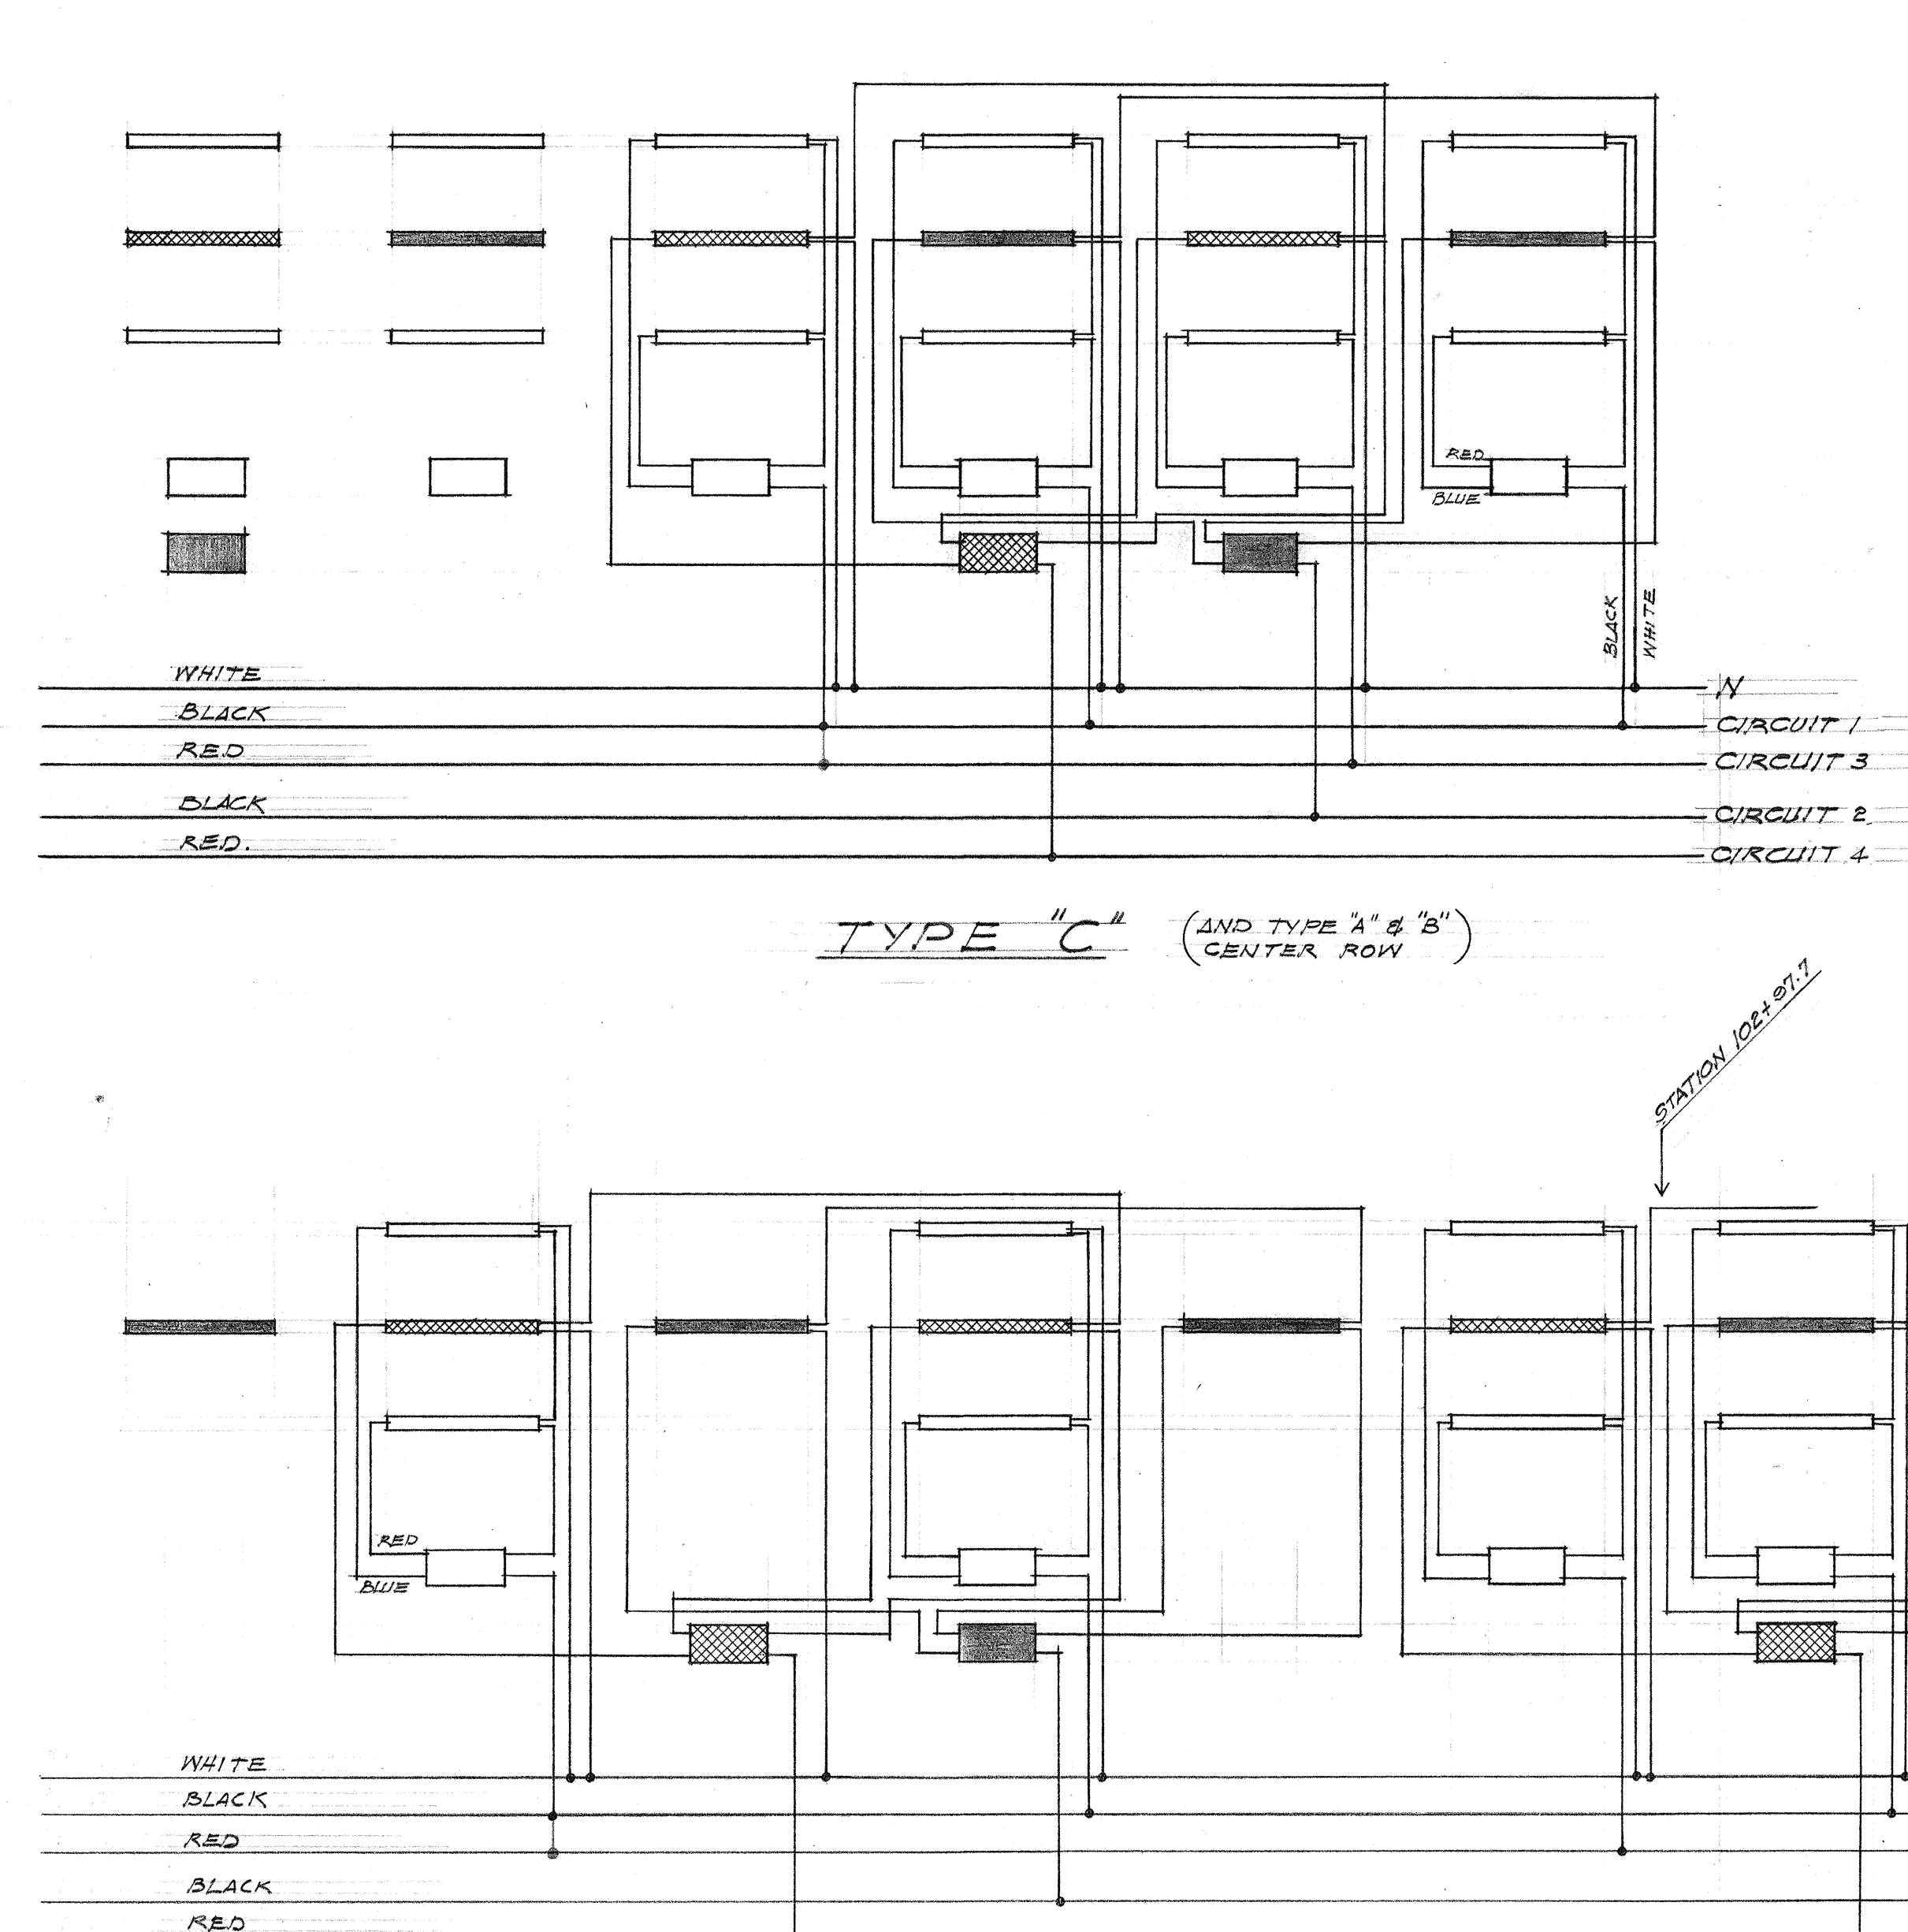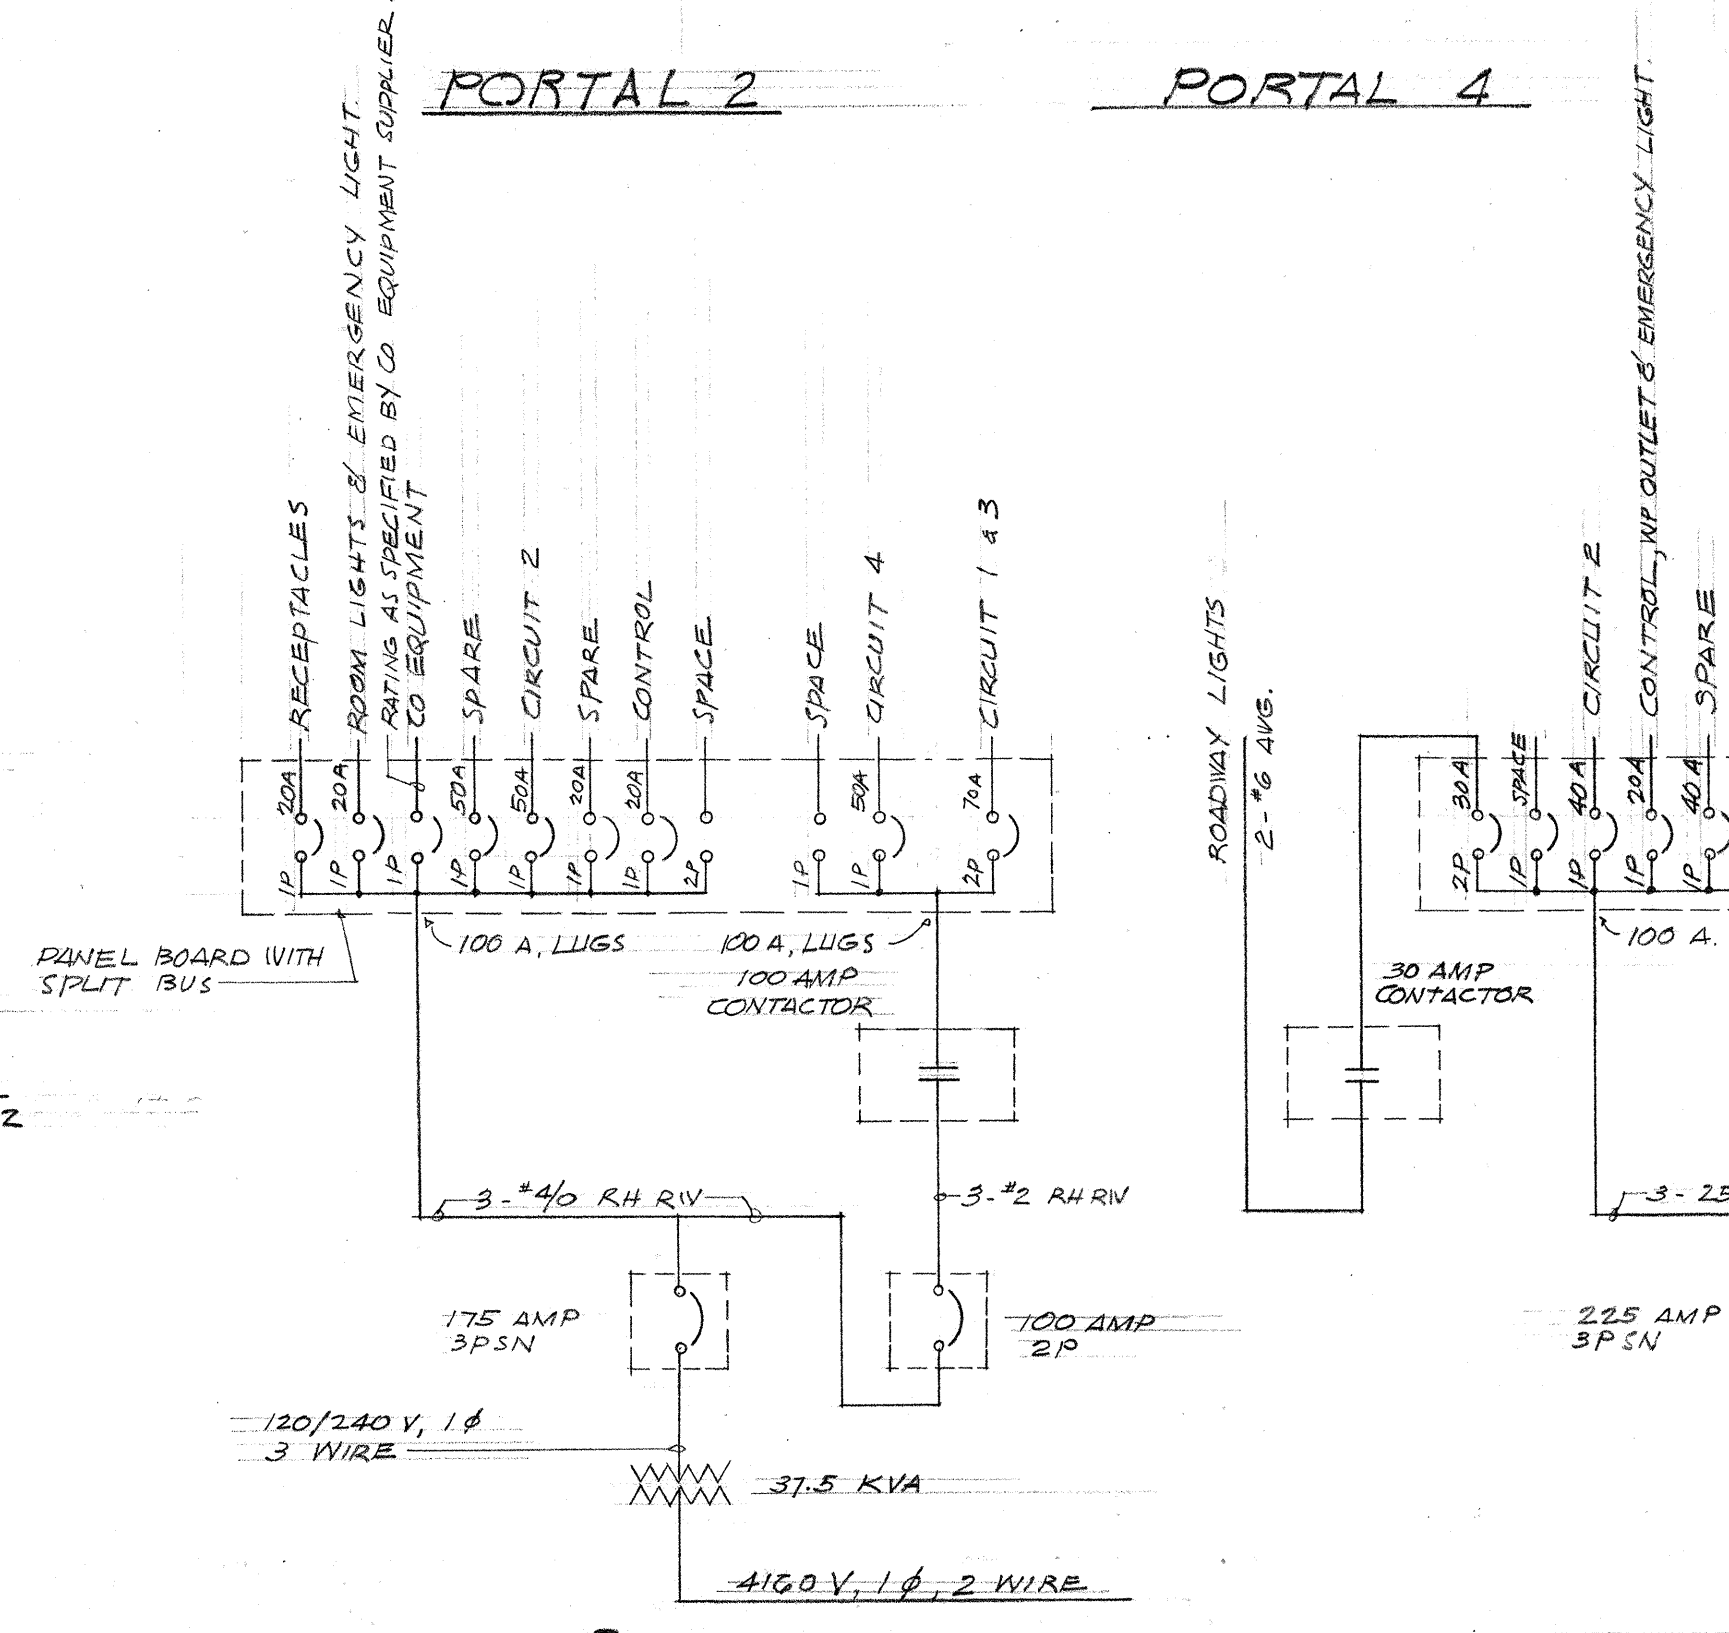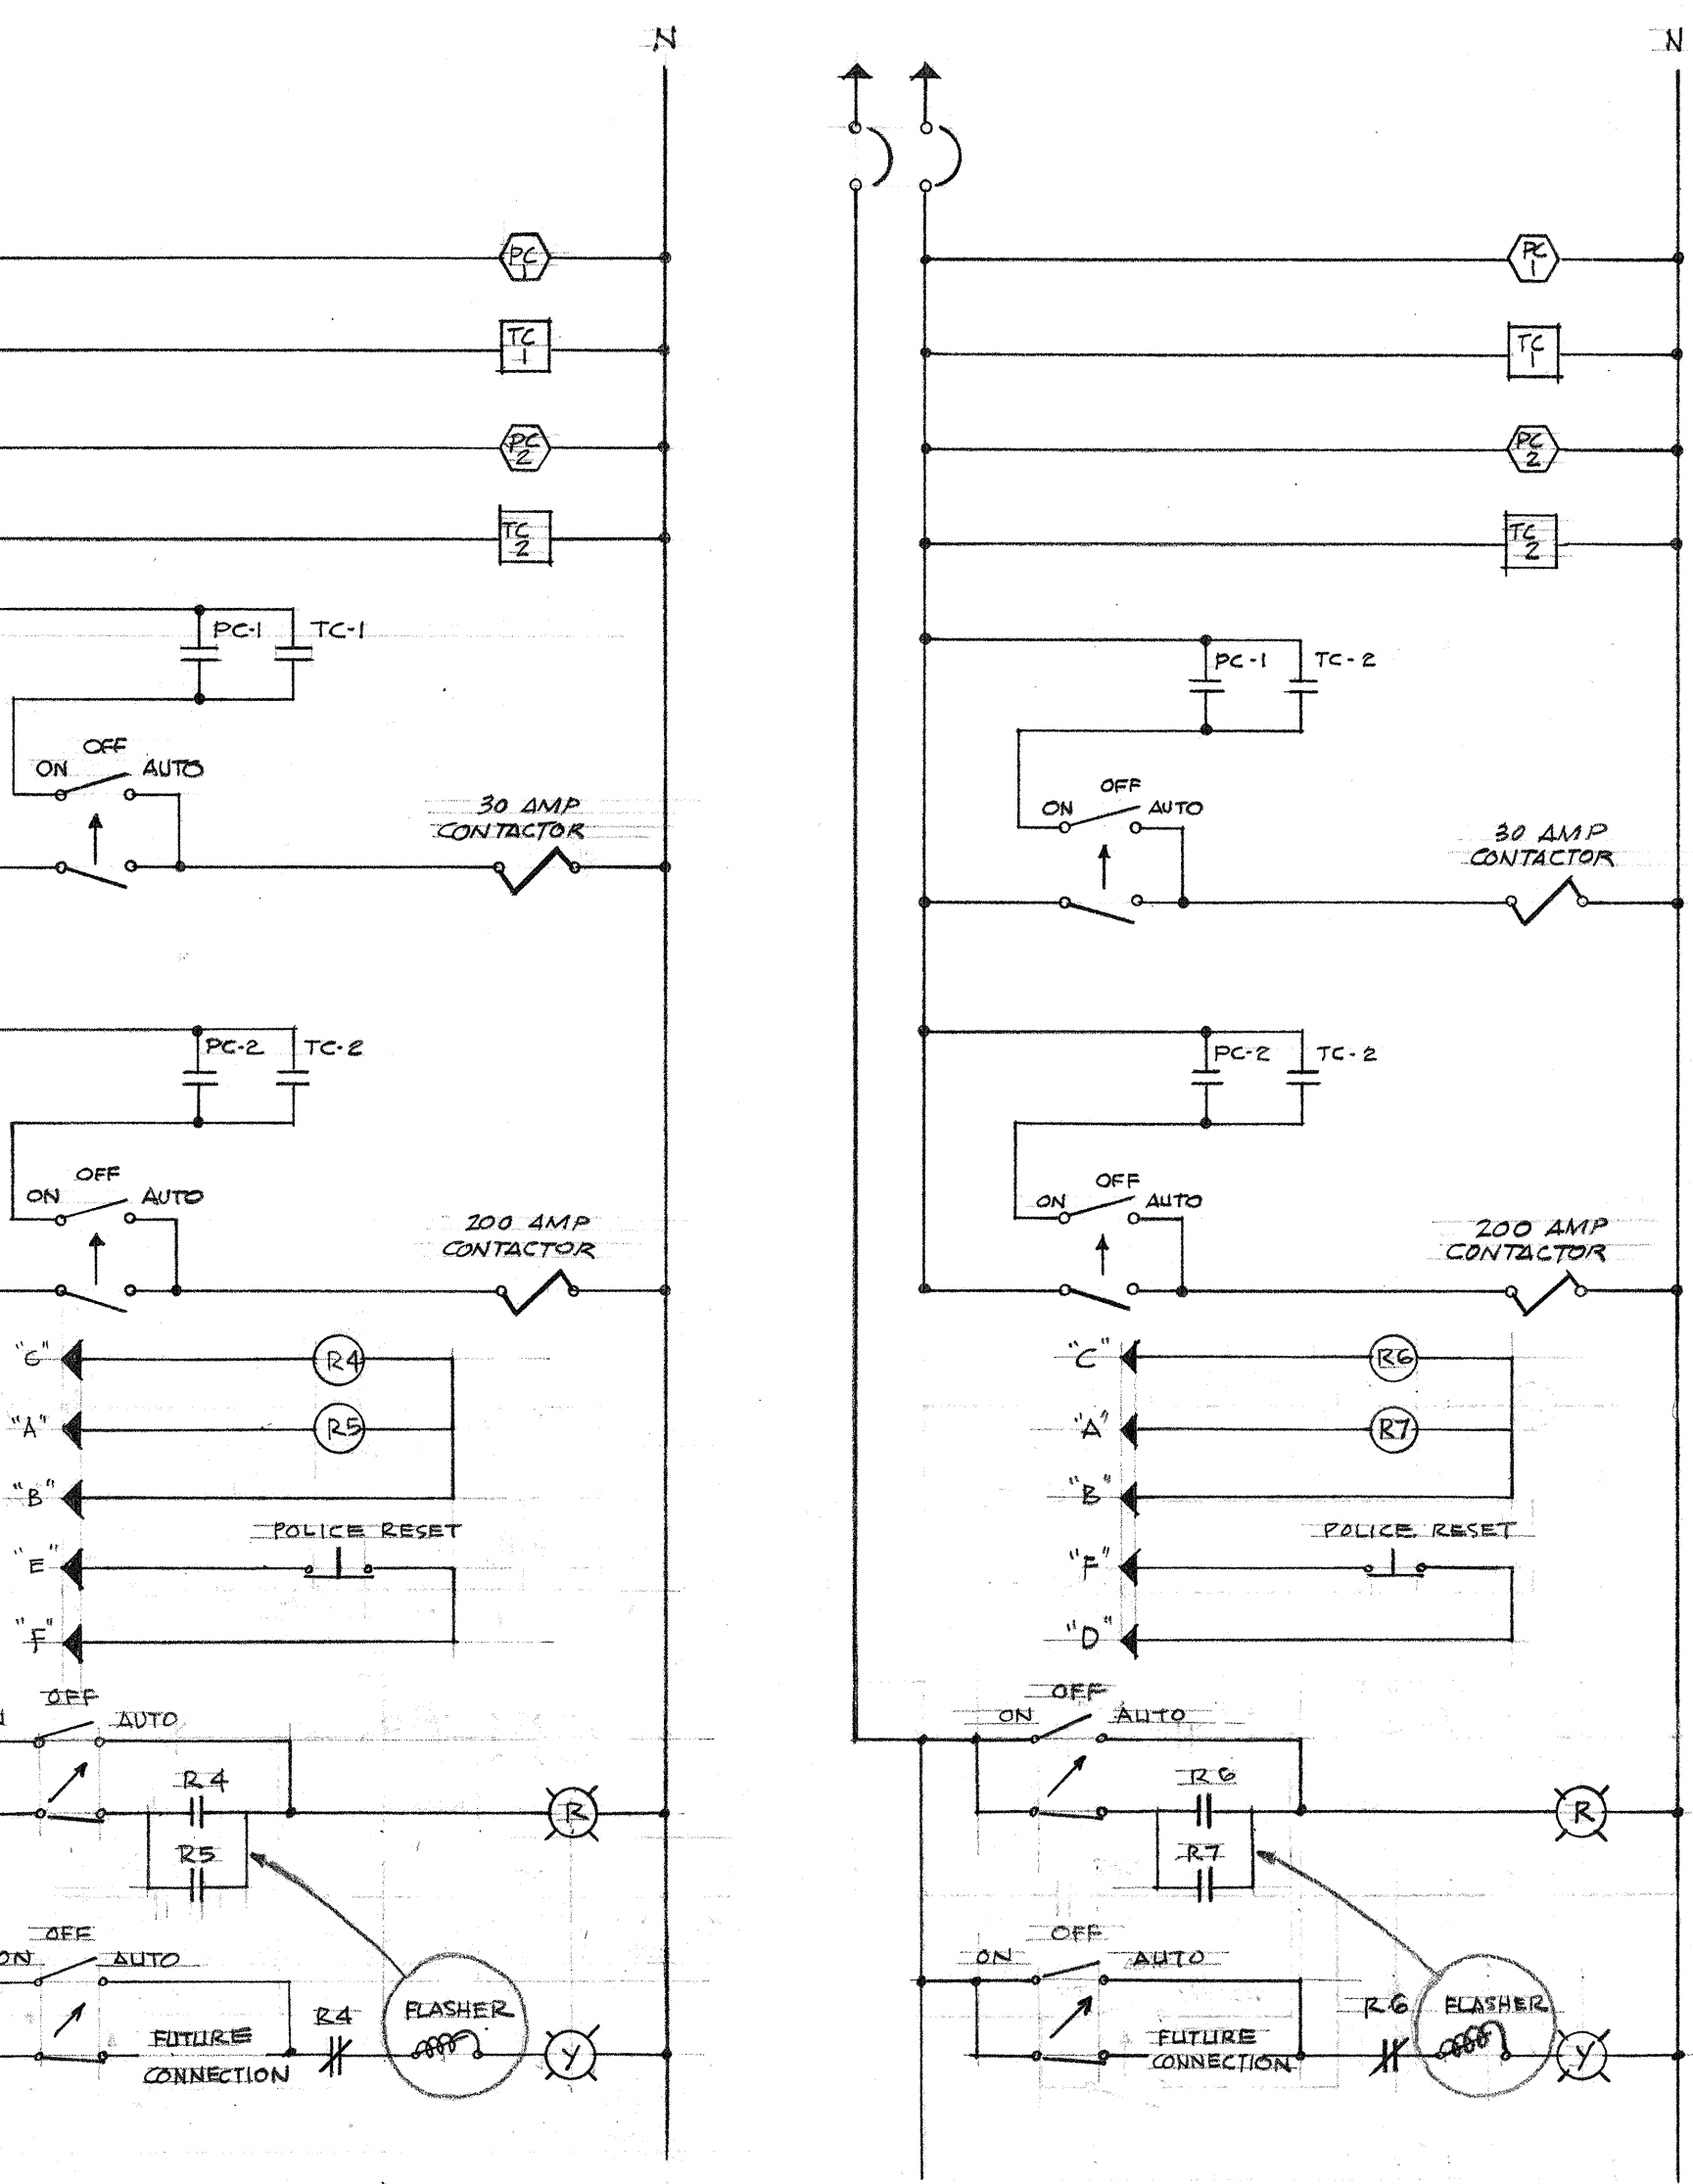


- LAMP ON CONTINUOUS SCHEDULE.
 - LAMP ON DAY SCHEDULE.
 - LAMP ON DAY SCHEDULE WITH PROVISION FOR CONNECTING TO CONTINUOUS SCHEDULE AT PORTAL.
 - BALLAST FOR 2 LAMPS ON CONTINUOUS SCHEDULE.
 - BALLAST FOR 2 LAMPS ON DAY SCHEDULE.
 - BALLAST FOR 2 LAMPS ON DAY SCHEDULE WITH PROVISION FOR CONNECTING TO CONTINUOUS SCHEDULE AT PORTAL.
1. CENTER LAMP IN LUMINAIRE CLOSES TO PORTAL 2 AND 4 AND THEN IN EVERY OTHER LUMINAIRE THROUGHOUT TUNNEL SHALL BE ON CONTINUOUS SCHEDULE.
 2. ALL WIRING BETWEEN BALLASTS AND LAMPS SHALL BE 1/4 AWG. 1000 VOLT, THERMOPLASTIC FIXTURE WIRE, WITH UL APPROVED INSULATION FOR 80°C. WIRE SHALL BE CODED AS INDICATED.
 3. EACH CUTOFF TYPE LAMPHOLDER SHALL BE TOWARD KAILUA END OF TUNNEL.
 4. ONE SINGLE LAMP HIGH POWER FACTOR BALLAST SHALL BE INSTALLED ON EACH CIRCUIT HAVING AN UNEVEN NUMBER OF LAMPS.
 5. FOR WIRE SIZE OF LIGHTING FEEDERS FROM EACH PORTAL, SEE SCHEDULE ON "LIGHTING PLAN."

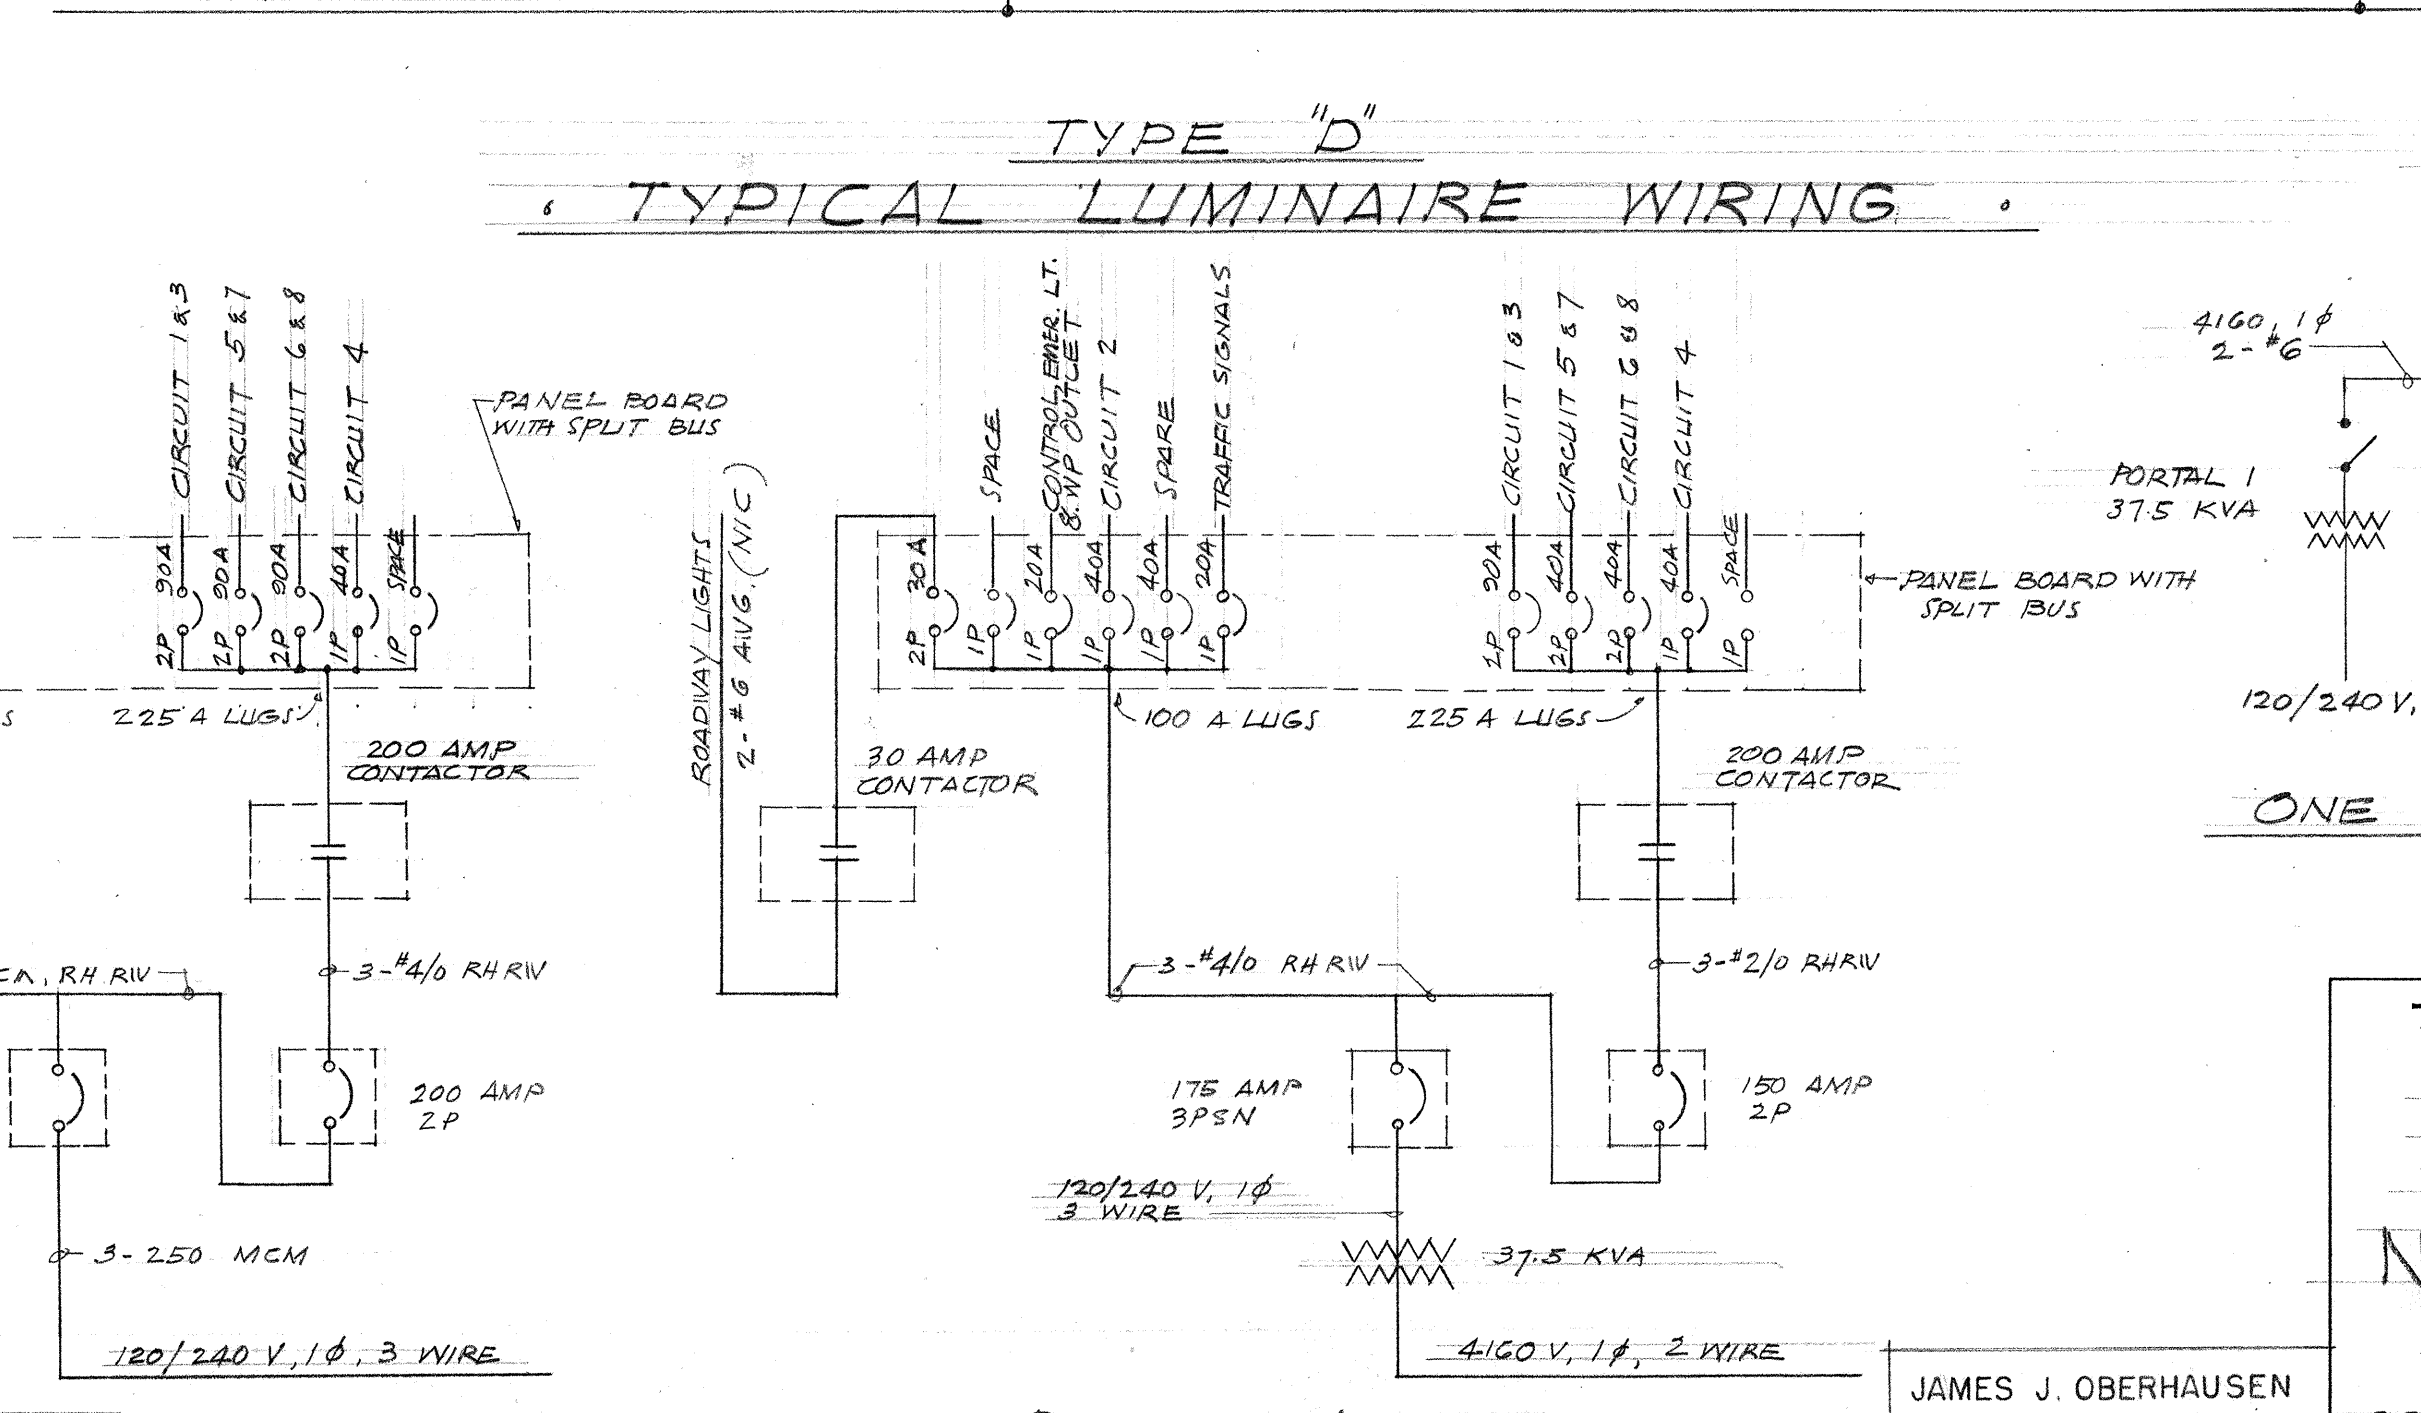

TERRITORIAL HIGHWAY DEPARTMENT
 TERRITORY OF HAWAII
ELECTRICAL
 WIRING DIAGRAMS
NUUANU PALI TUNNELS
 PALI ROAD
 PROJ. NO. S 216(S)
 SCALES: AS NOTED DATE: AUG. 27, 1954
 JAMES J. OBERHAUSEN
 ELECTRICAL ENGINEER


DEC. 3, 1954
FEB. 10, 1955

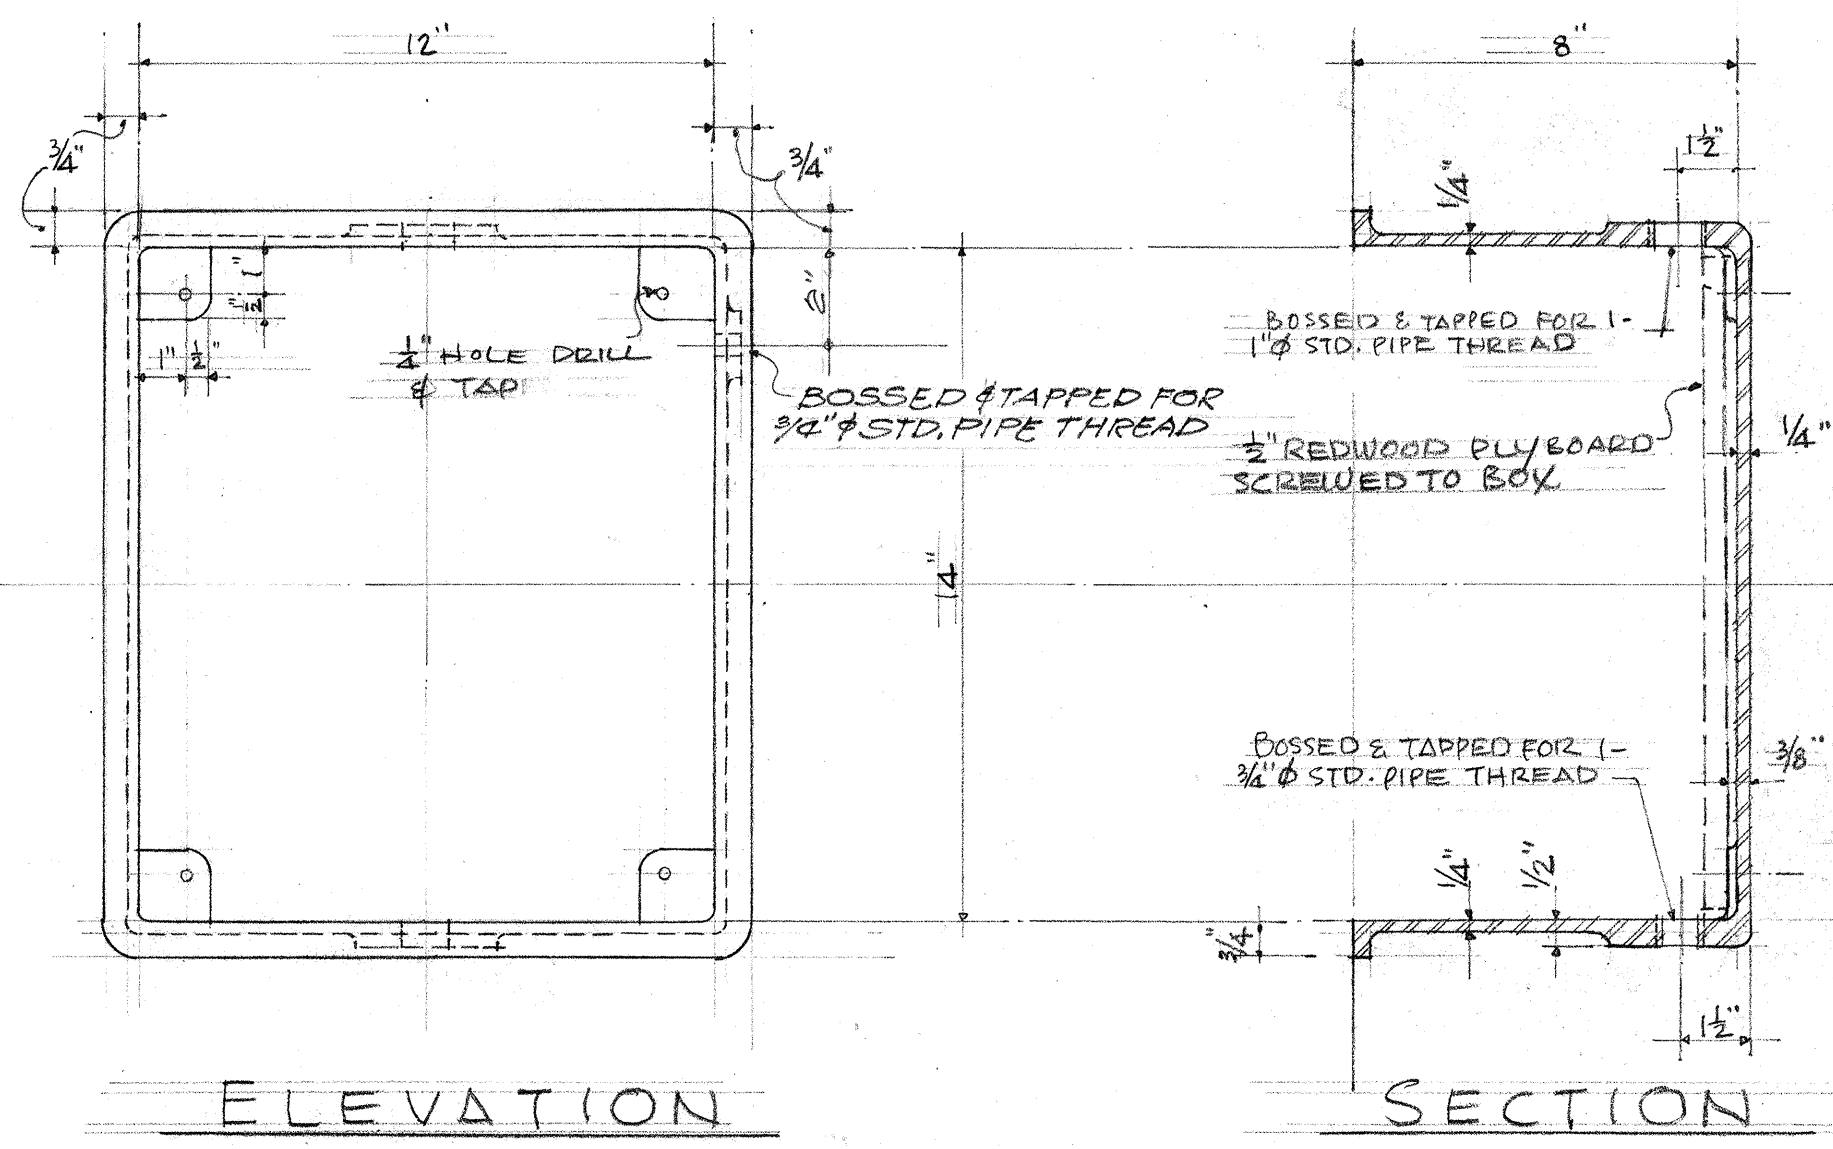

ELEVATION

SECTION


DETAILS OF H.T.CO. WALL PHONE BOX
SCALE: 3" = 1'-0"

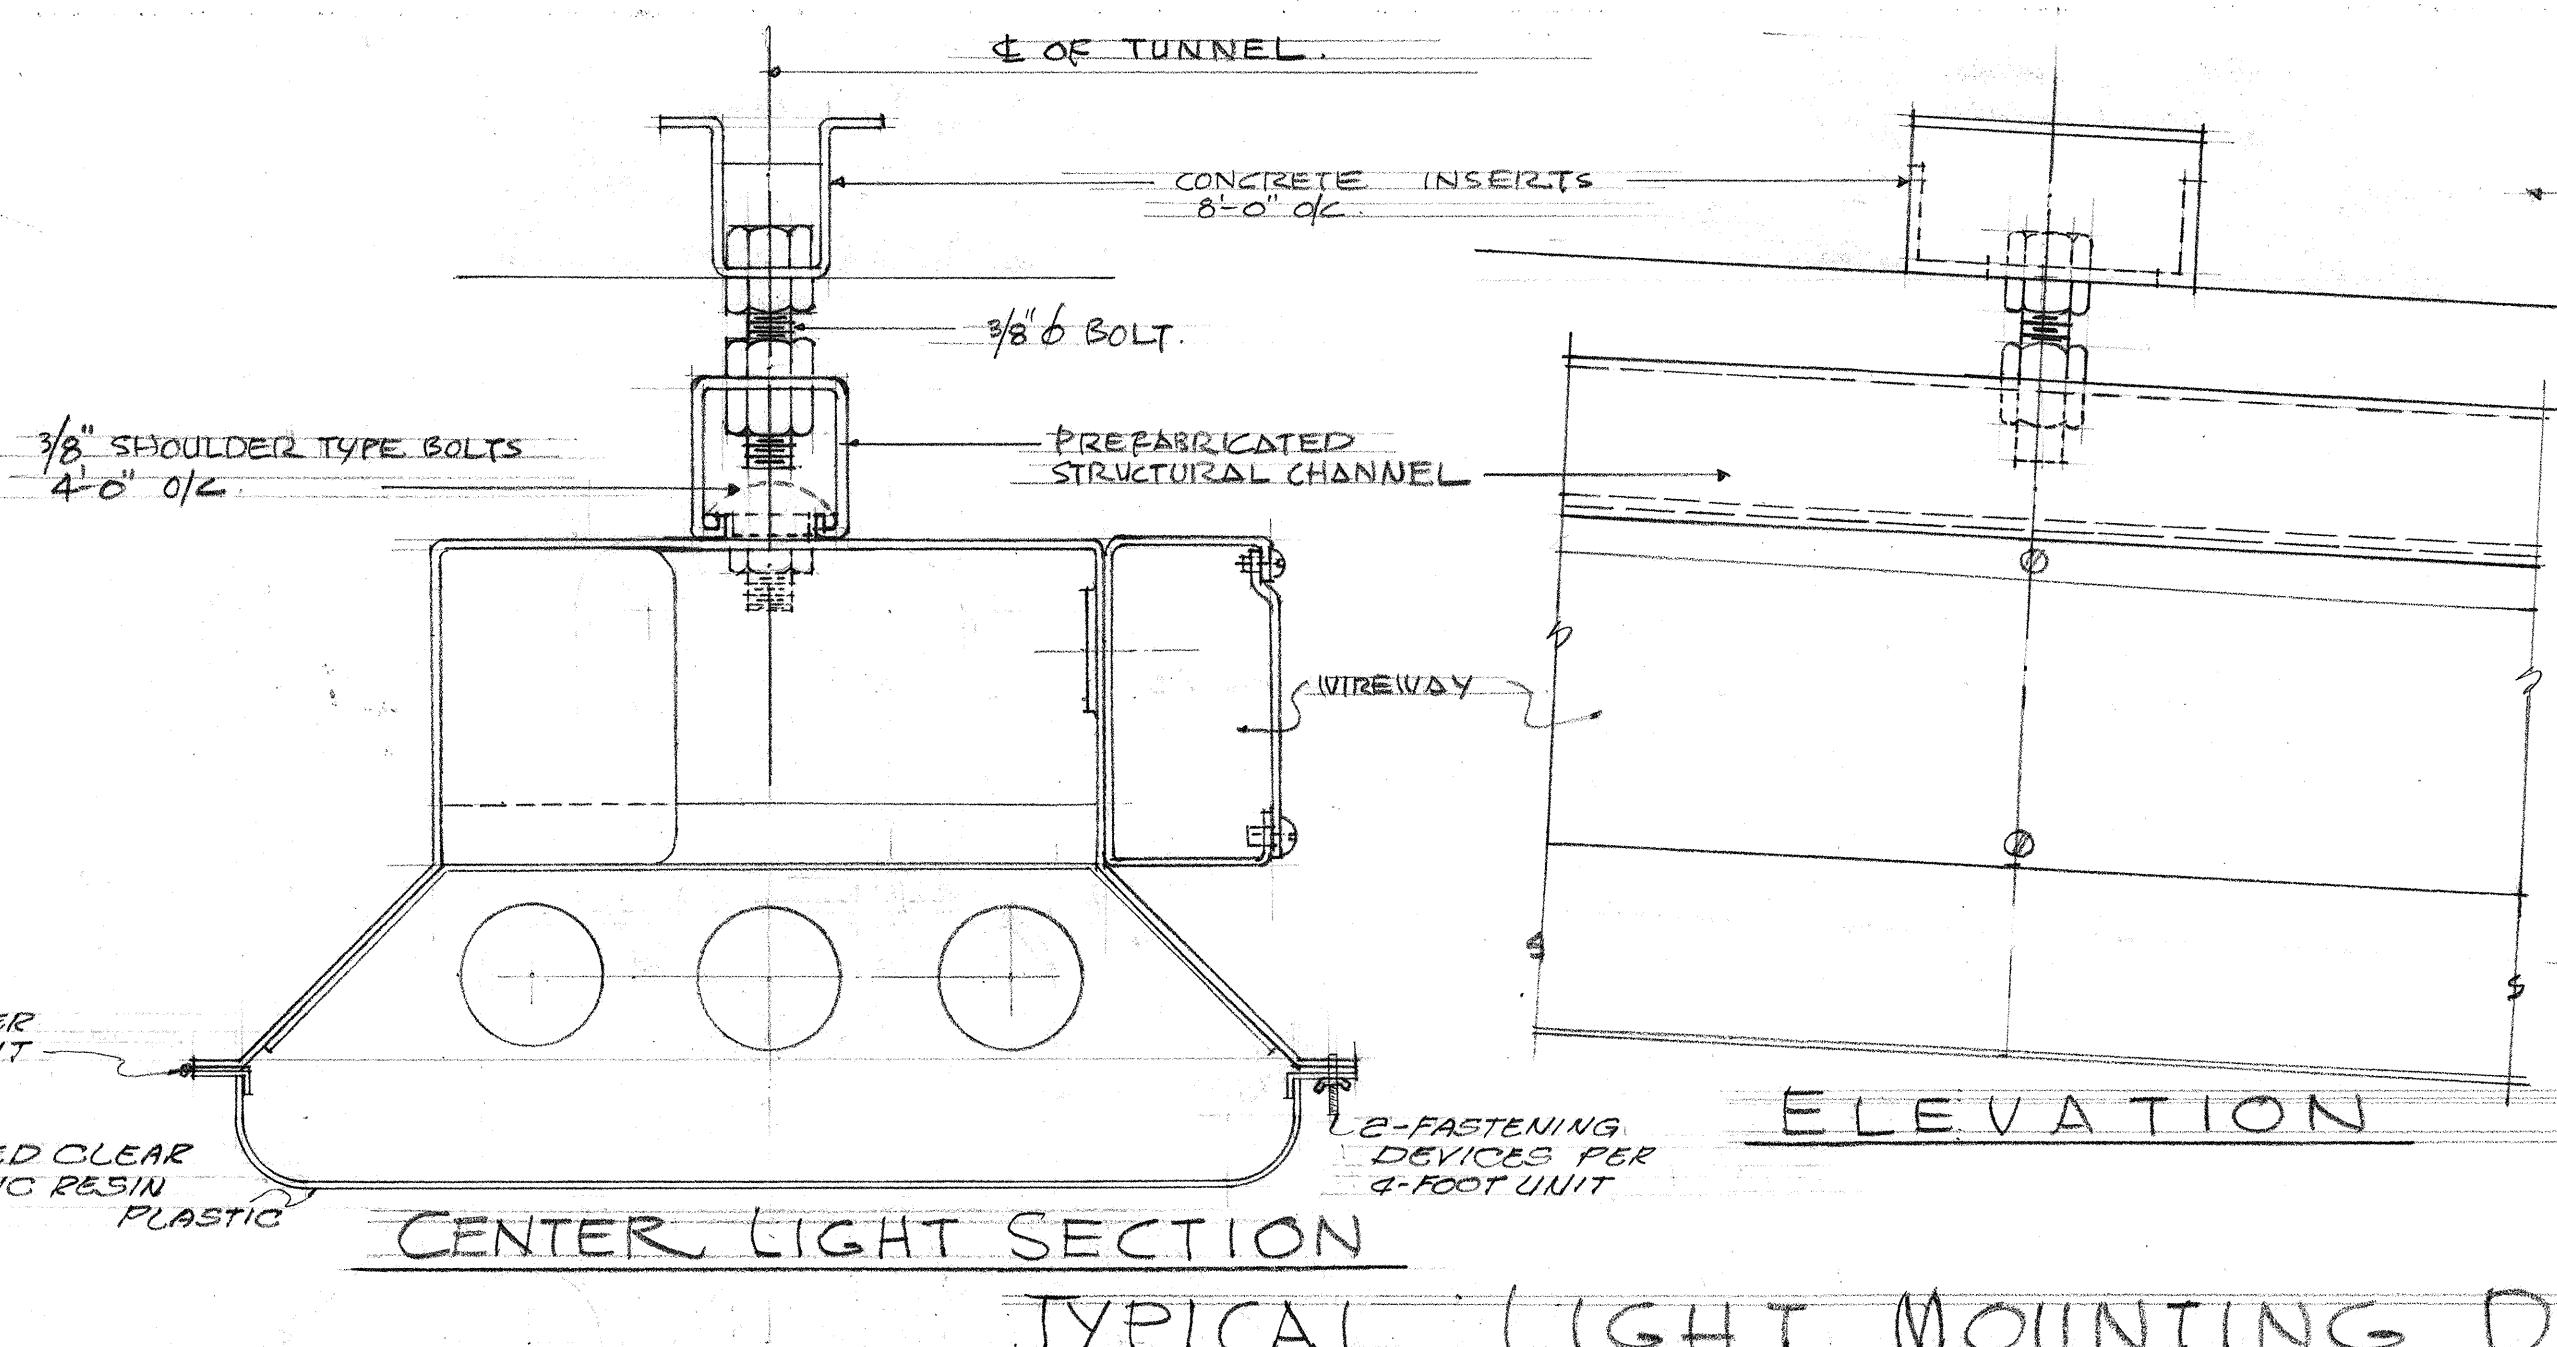

CENTER LIGHT SECTION

ELEVATION

TYPICAL LIGHT MOUNTING DETAILS
1/2 F.S.S.

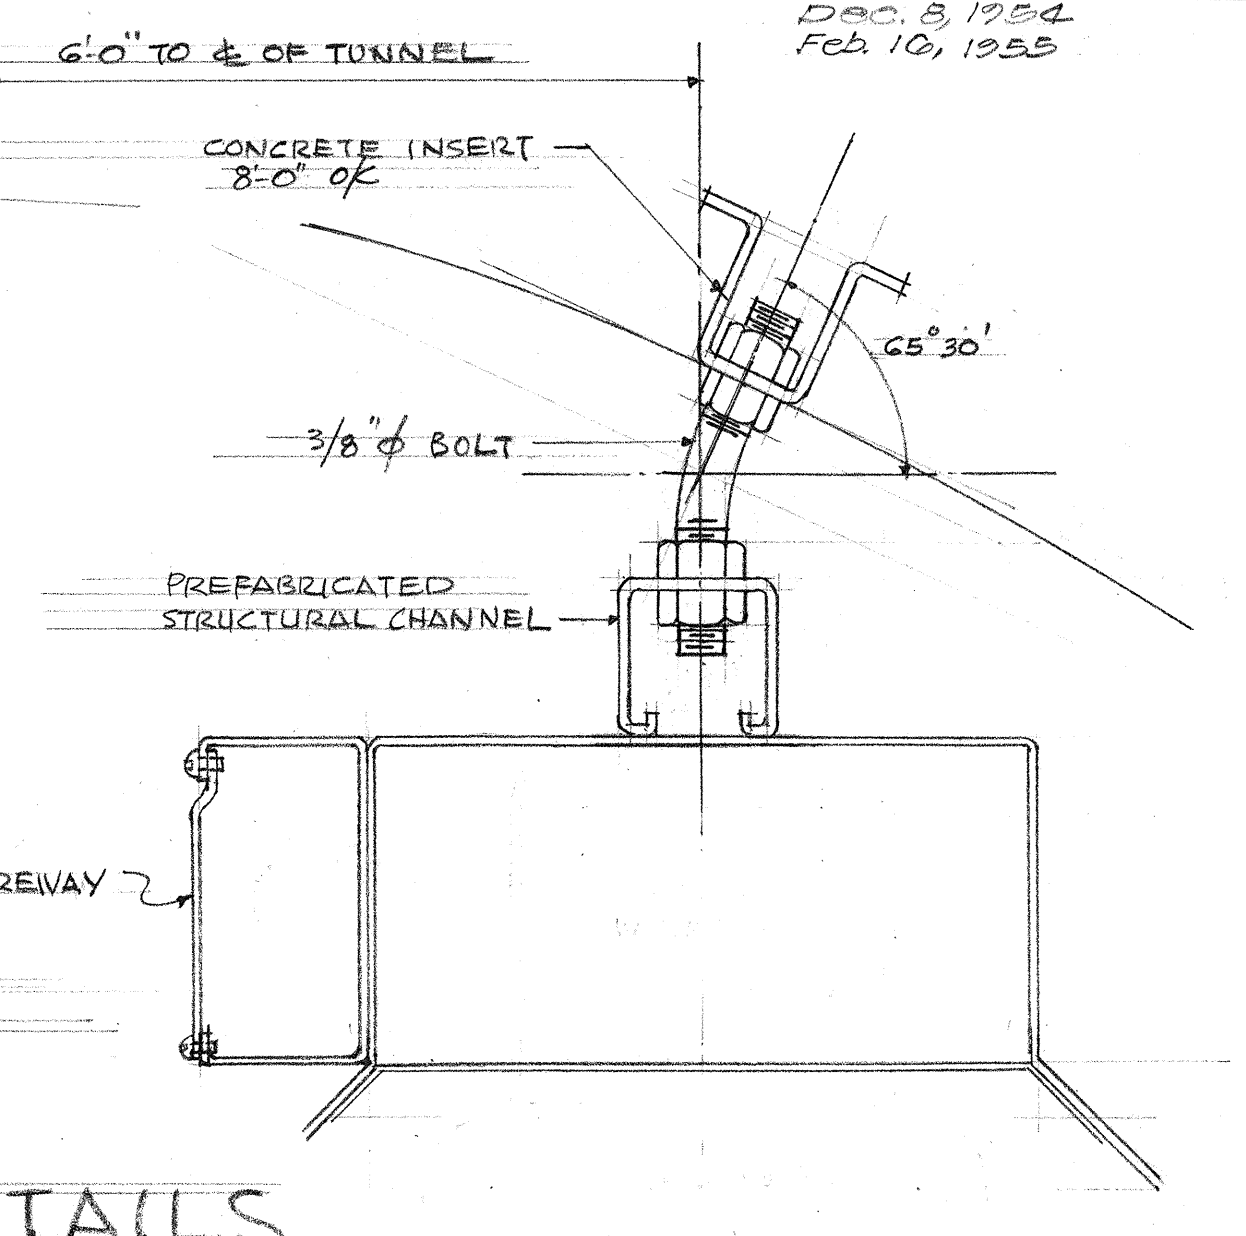

SIDE LIGHT SECTION

NOTE: A 4 FOOT LONG REMOVABLE FORMED LOUVER SECTION 6" WIDE 18 GAUGE TRANSVERSE ALUMINUM STRIPS ON 2" CENTERS AND PAINTED BLACK SHALL BE INSTALLED ON THE TUNNEL LIGHTING LUMINAIRE IMMEDIATELY IN FRONT OF EACH ILLUMINATED SIGN.


CONCRETE INSERTS TO BE SAME AS FOR TUNNEL LIGHTING LUMINAIRE. SWIVEL, HANGERS, CANOPY, AND TUNNEL INSERTS TO BE FURNISHED AS REQUIRED FOR SIGN.

- 1 - LIGHTING FEEDER JUNCTION BOX
- 1 - PORTAL 1
- 1 - ILLUMINATED SIGN AT STA. 99+80
- 1 - EMERGENCY PHONE AT STA. 101+48
- 1 - ILLUMINATED SIGN AT STA. 103+20
- 1 - PORTAL 2
- 1 - ILLUMINATED SIGN AT STA. 112+70
- 1 - PORTAL 4


1" 2 #6 WIRE CONNECT TO CIRCUIT #2

3" #12 3/4" C FROM NEAREST T.H.D. SIDEWALK JUNCTION BOX TO LIGHTING FEEDER JUNCTION BOX.

3" 2" CONDUIT WHERE SUPERELEVATION DOES NOT PERMIT 3" 2" C ABOVE EACH OTHER. PLACE IN SIDEWALK AS DIRECTED BY ENGINEER.

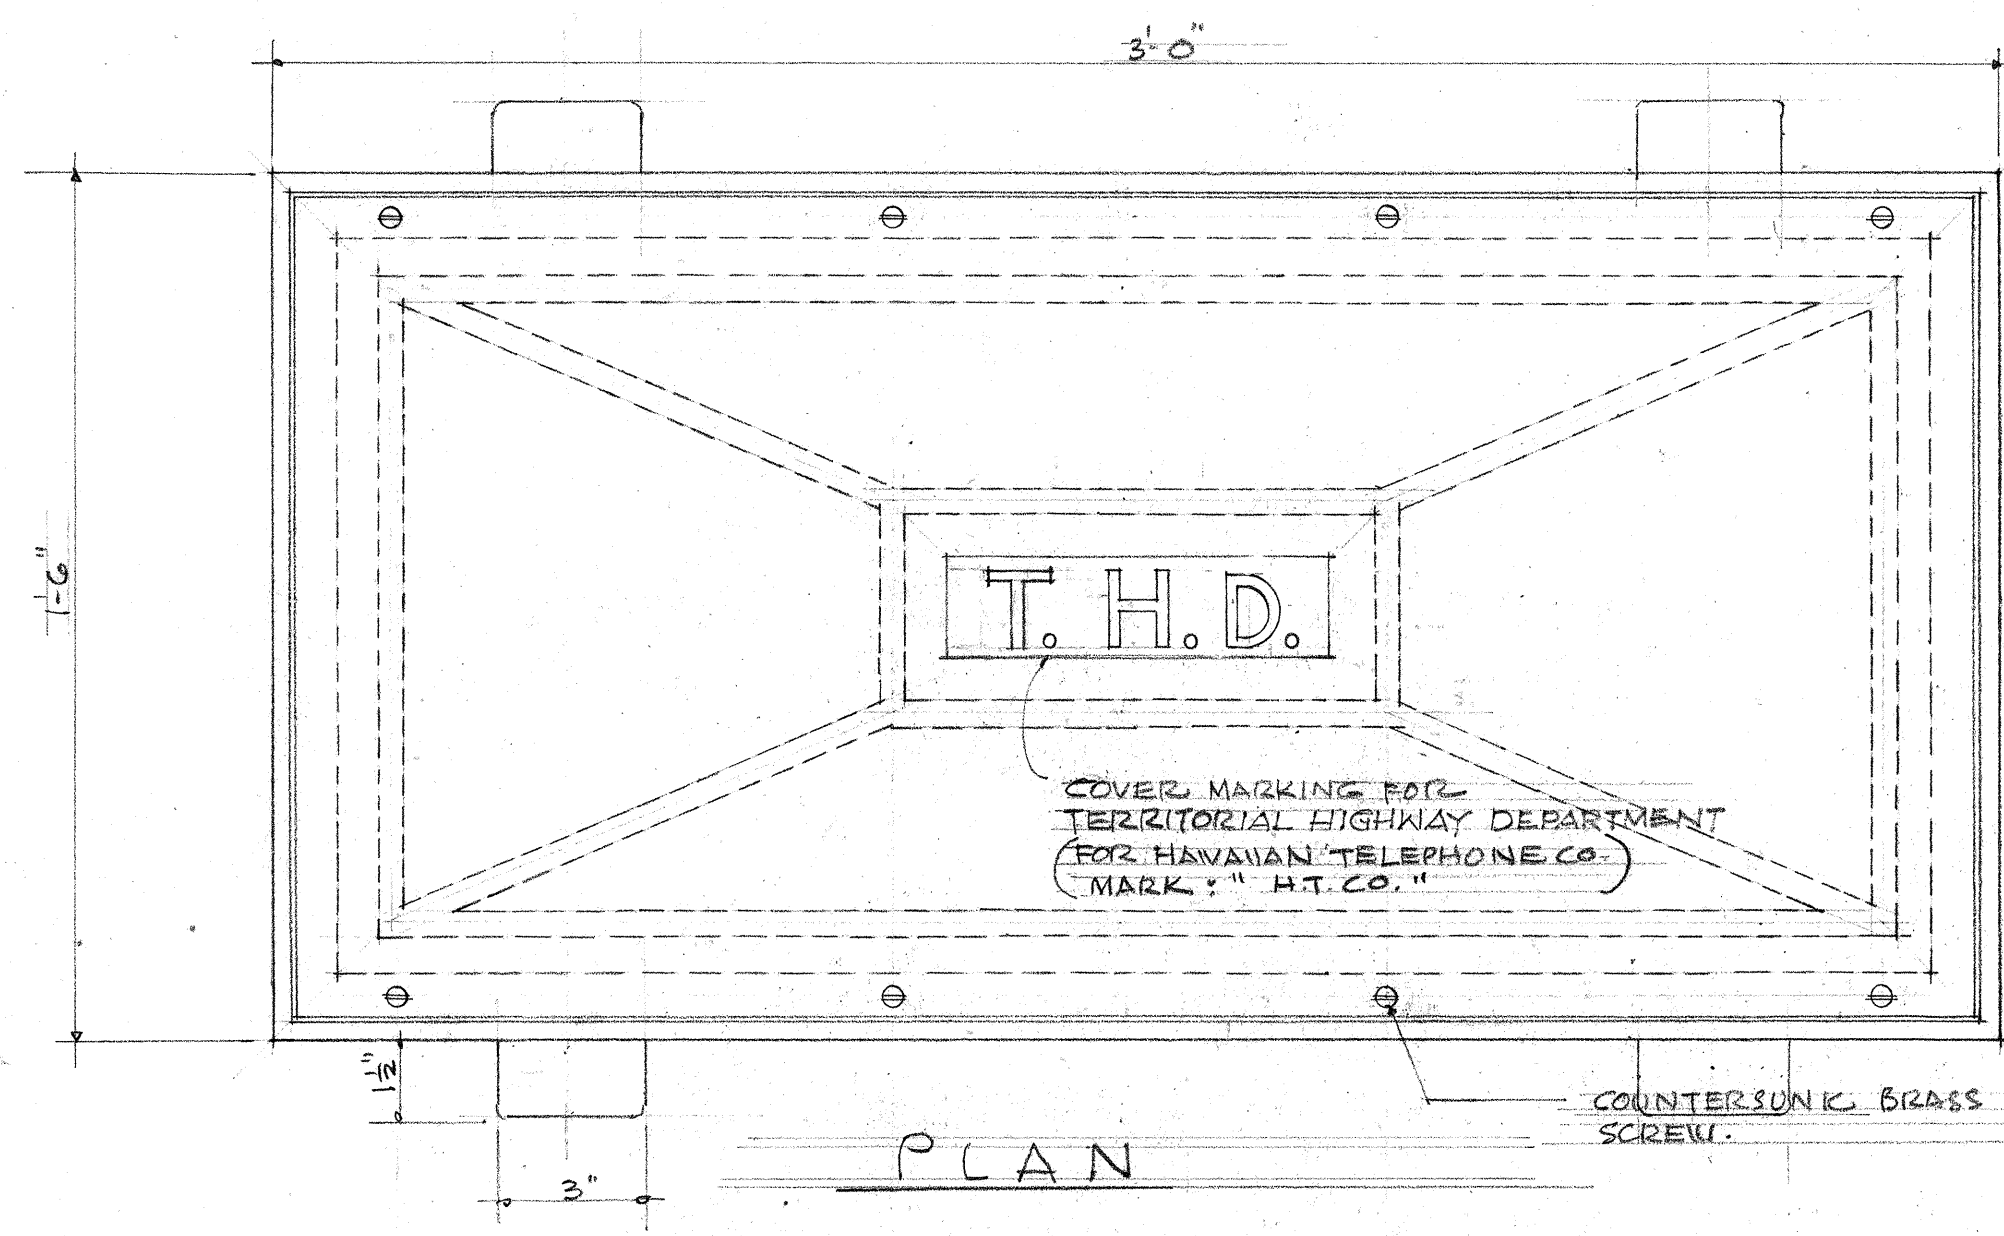


PLAN

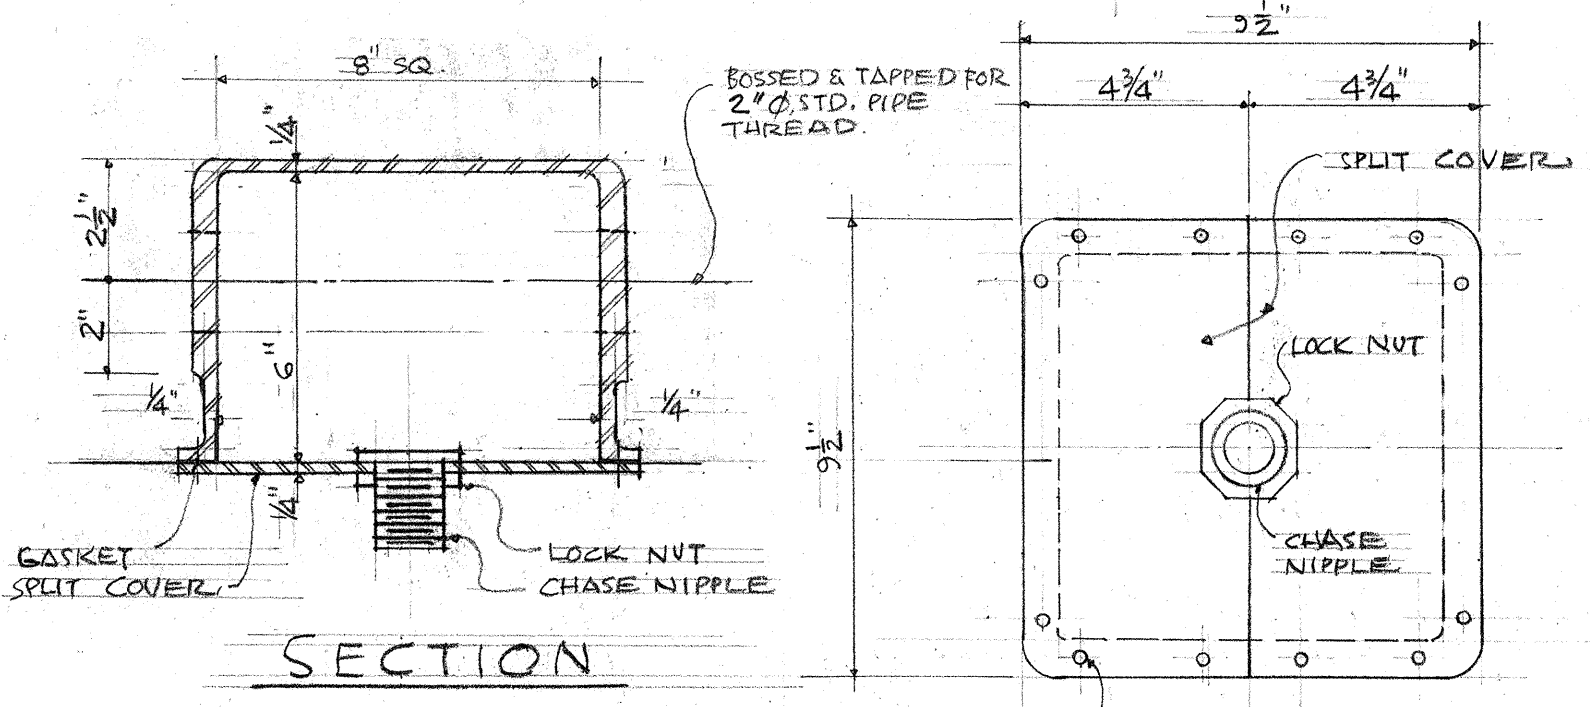

SECTION

PLAN


LIGHTING FEEDER JUNCTION BOX
SCALE: 3" = 1'-0"

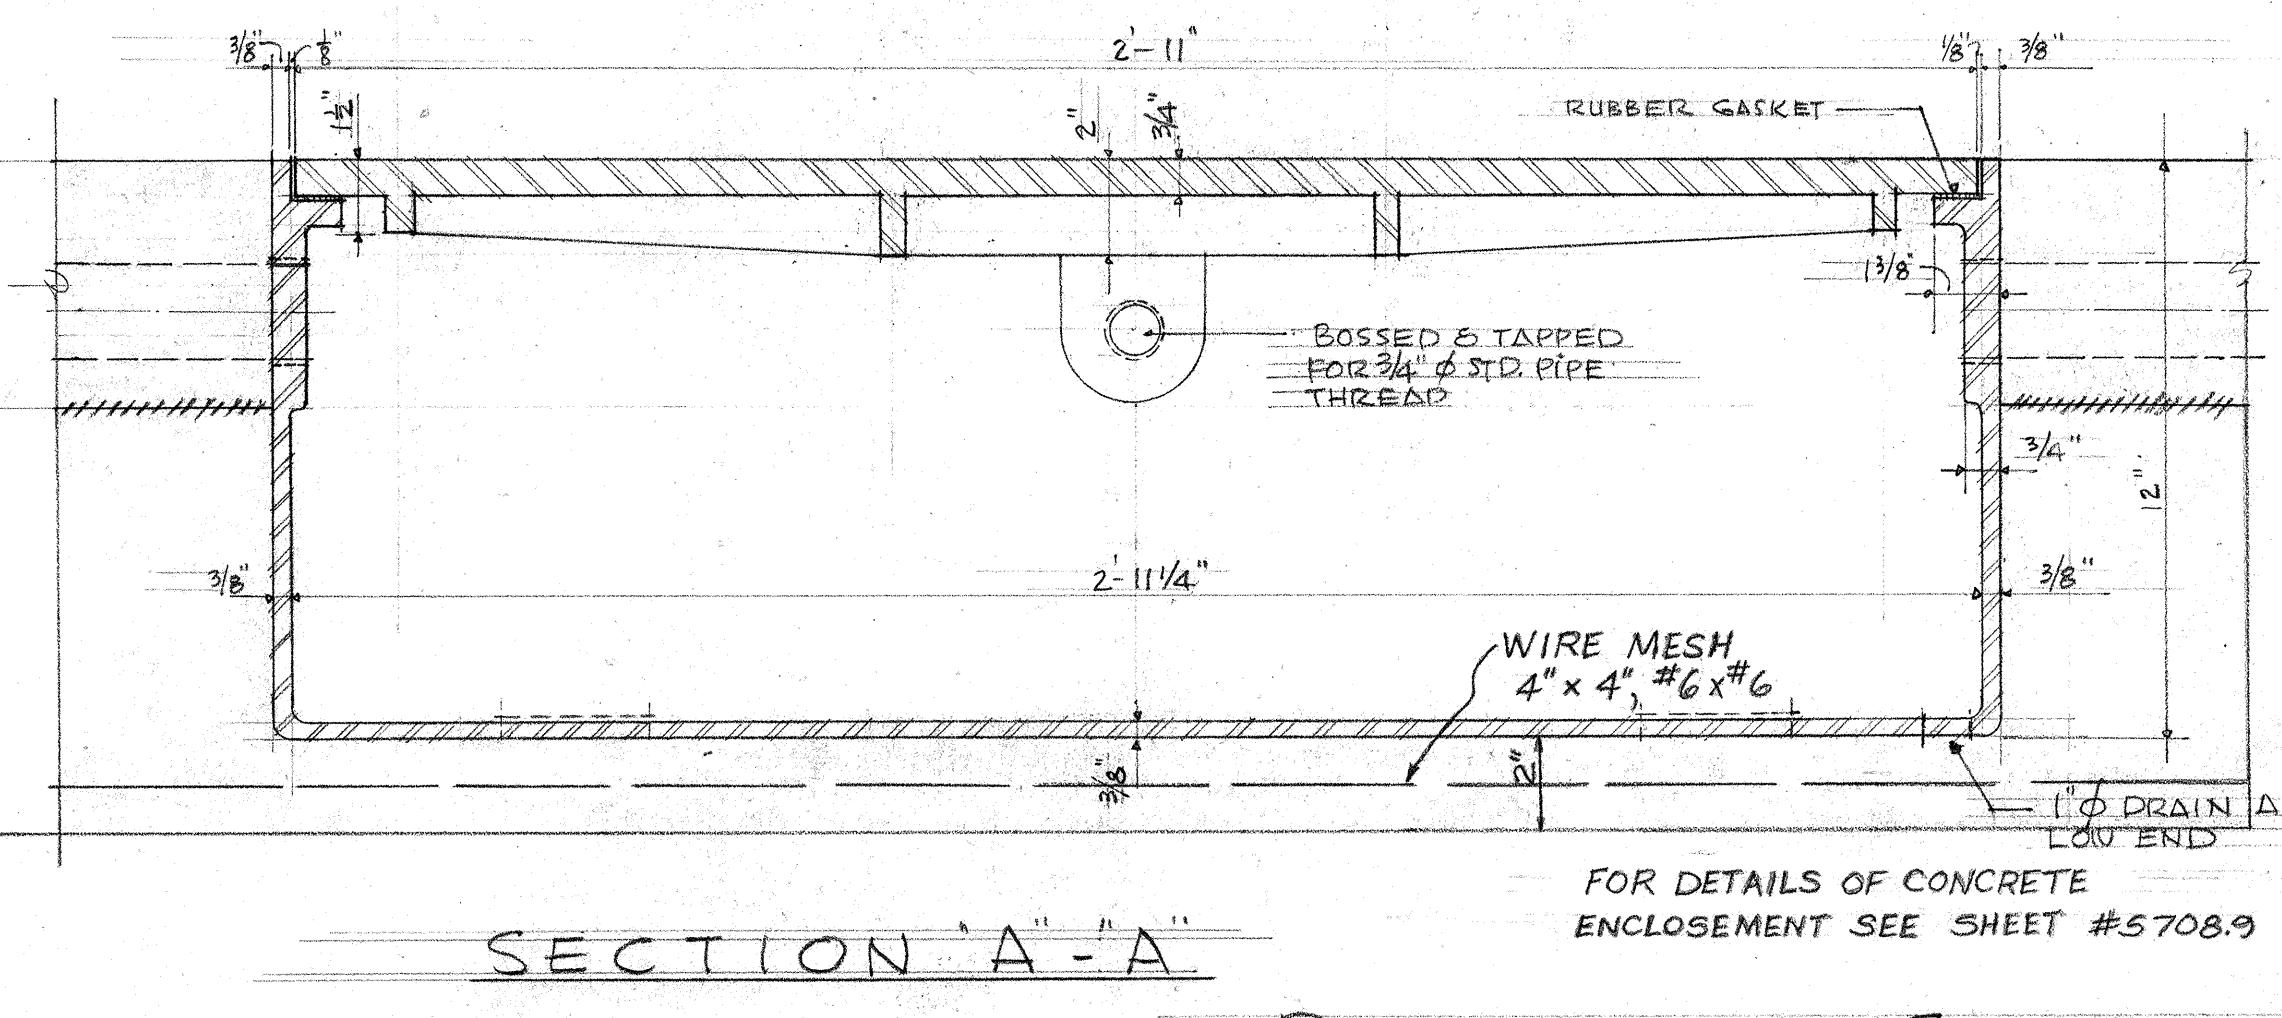

SECTION A-A


DETAILS OF SIDEWALK JUNCTION BOX
SCALE: 3" = 1'-0"

FOR DETAILS OF CONCRETE ENCLOSURE SEE SHEET #5708.9

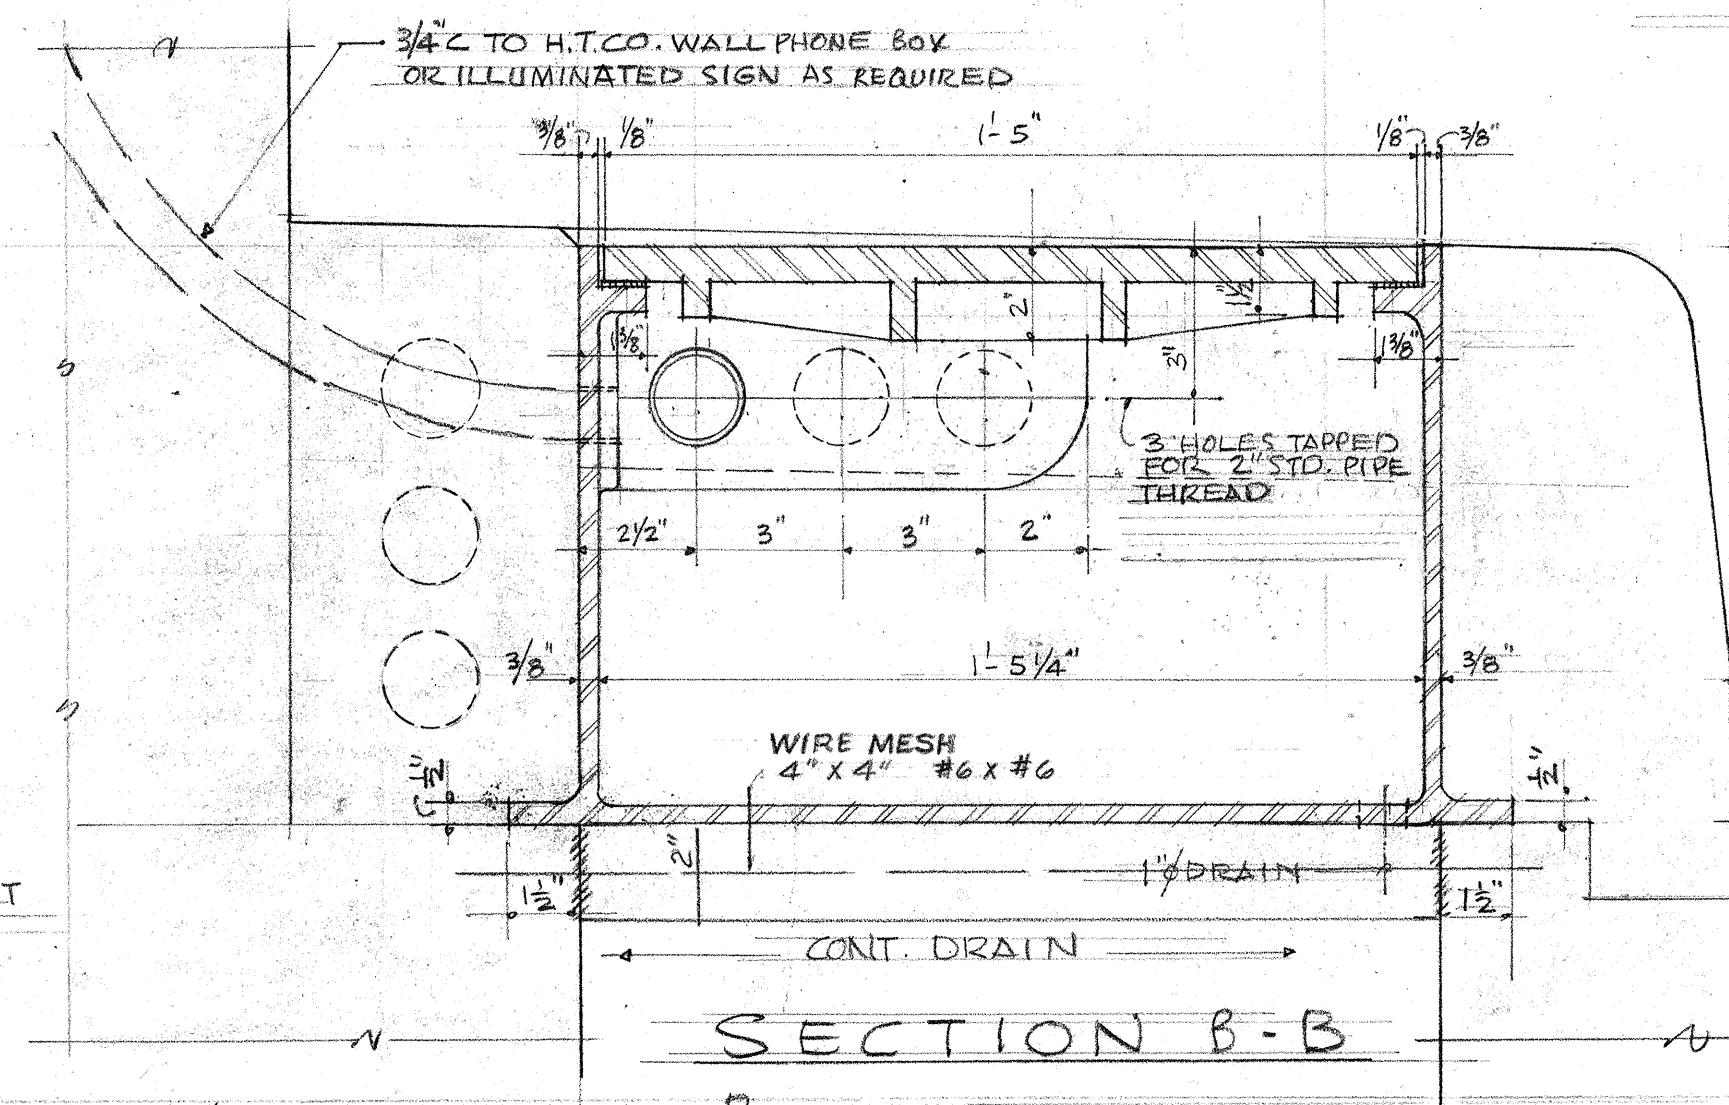

SECTION B-B

NOTE: HAWAIIAN TELEPHONE CO. SIDEWALK JUNCTION BOX SIMILAR

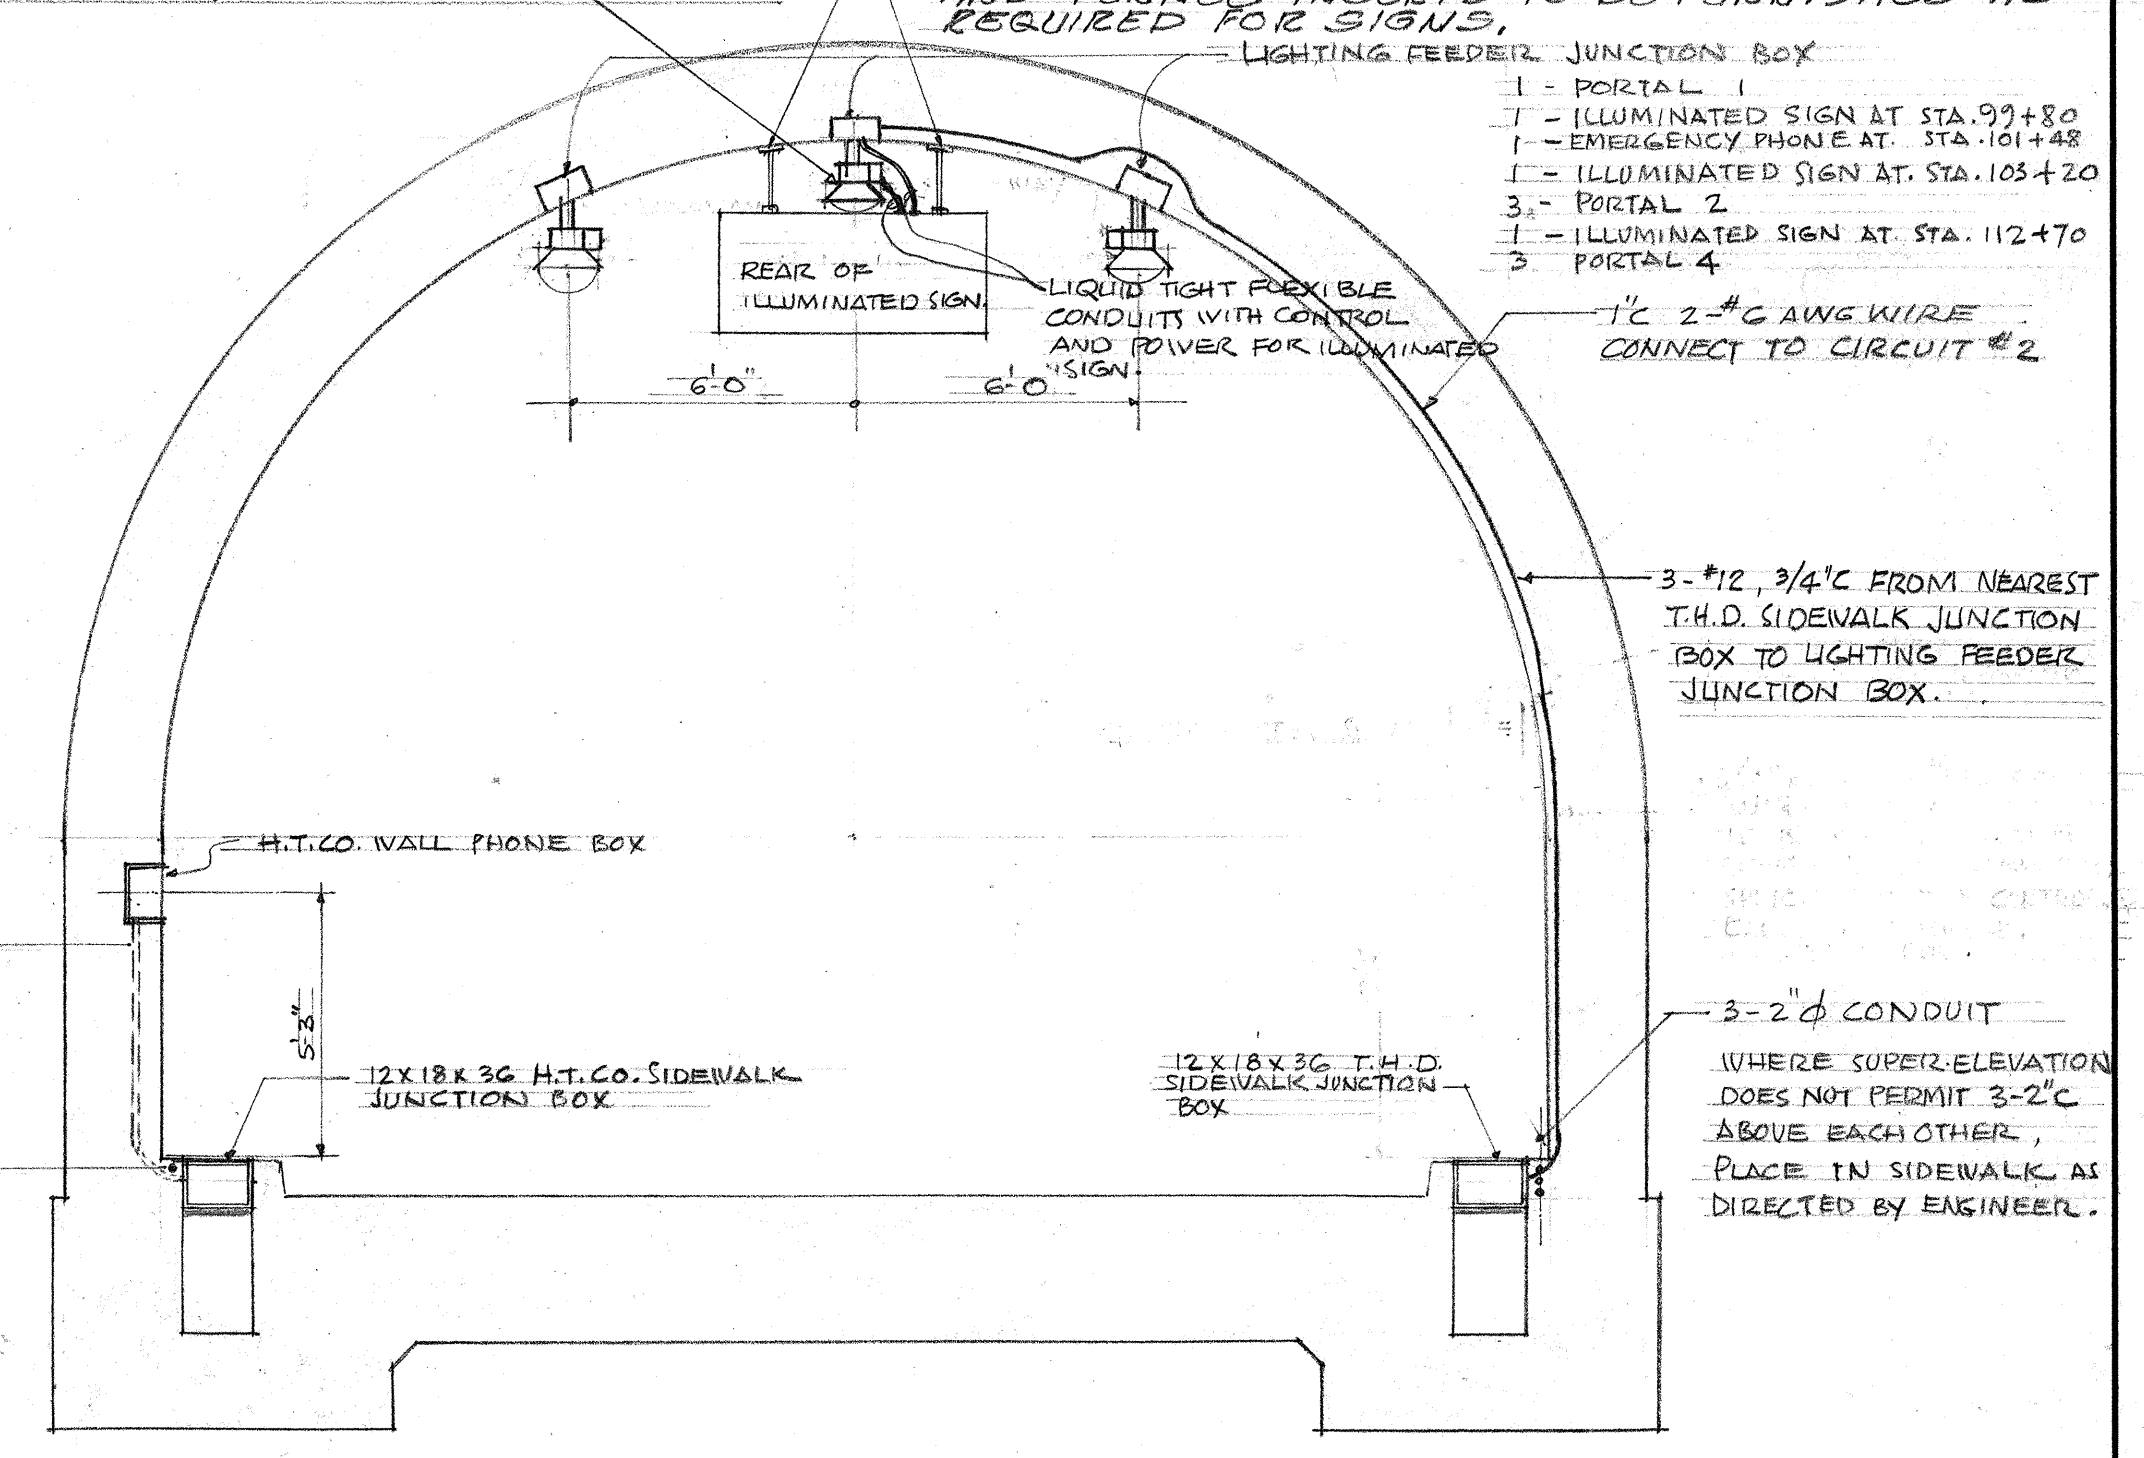

TUNNEL SECTION (COMPOSITE)


SCALE: 1/4" = 1'-0" (LOOKING TOWARD KAILUA)

NOTE: SEE DWG. FIRE EXTINGUISHER BOX FOR LOCATION OF FIRE EXTINGUISHER BOX & EMERGENCY LIGHT.


TERRITORIAL HIGHWAY DEPARTMENT
TERRITORY OF HAWAII
ELECTRICAL
TUNNEL INSERTS
NUUANU PALI TUNNELS
PALI ROAD
PROJ. NO. S 216 (S)
SCALE: AS NOTED DATE: AUG. 27, 1954

JAMES J. OBERHAUSEN
ELECTRICAL ENGINEER


DATE: _____
DESIGNED BY: _____
DRAWN BY: _____
CHECKED BY: _____
NOTED BY: _____
QUANTITIES BY: _____
CHECKED BY: _____
NO. _____

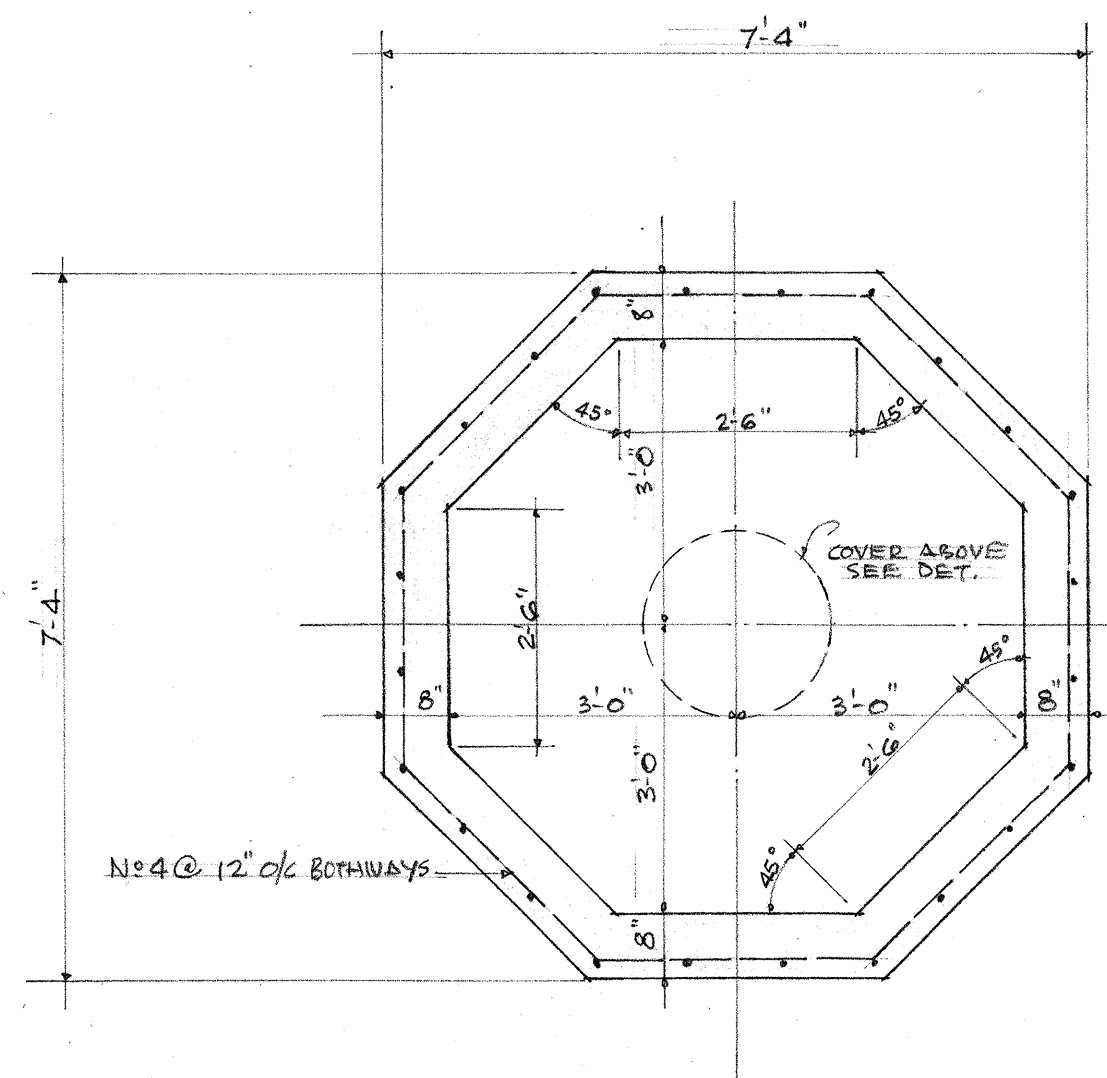

PLAN
SCALE: 1/2" = 1'-0"

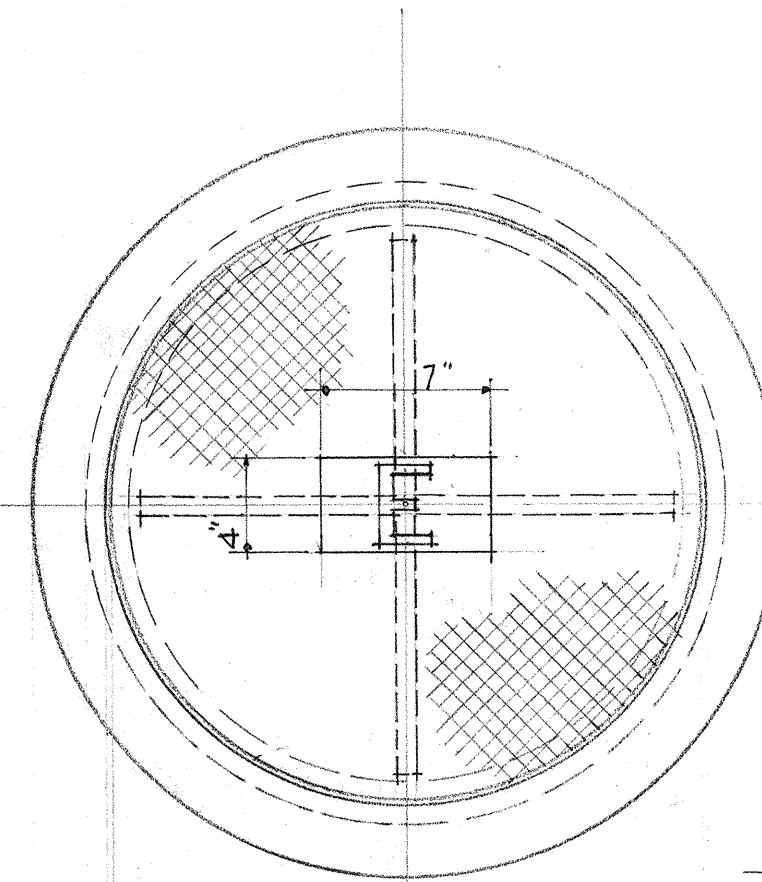


PLAN

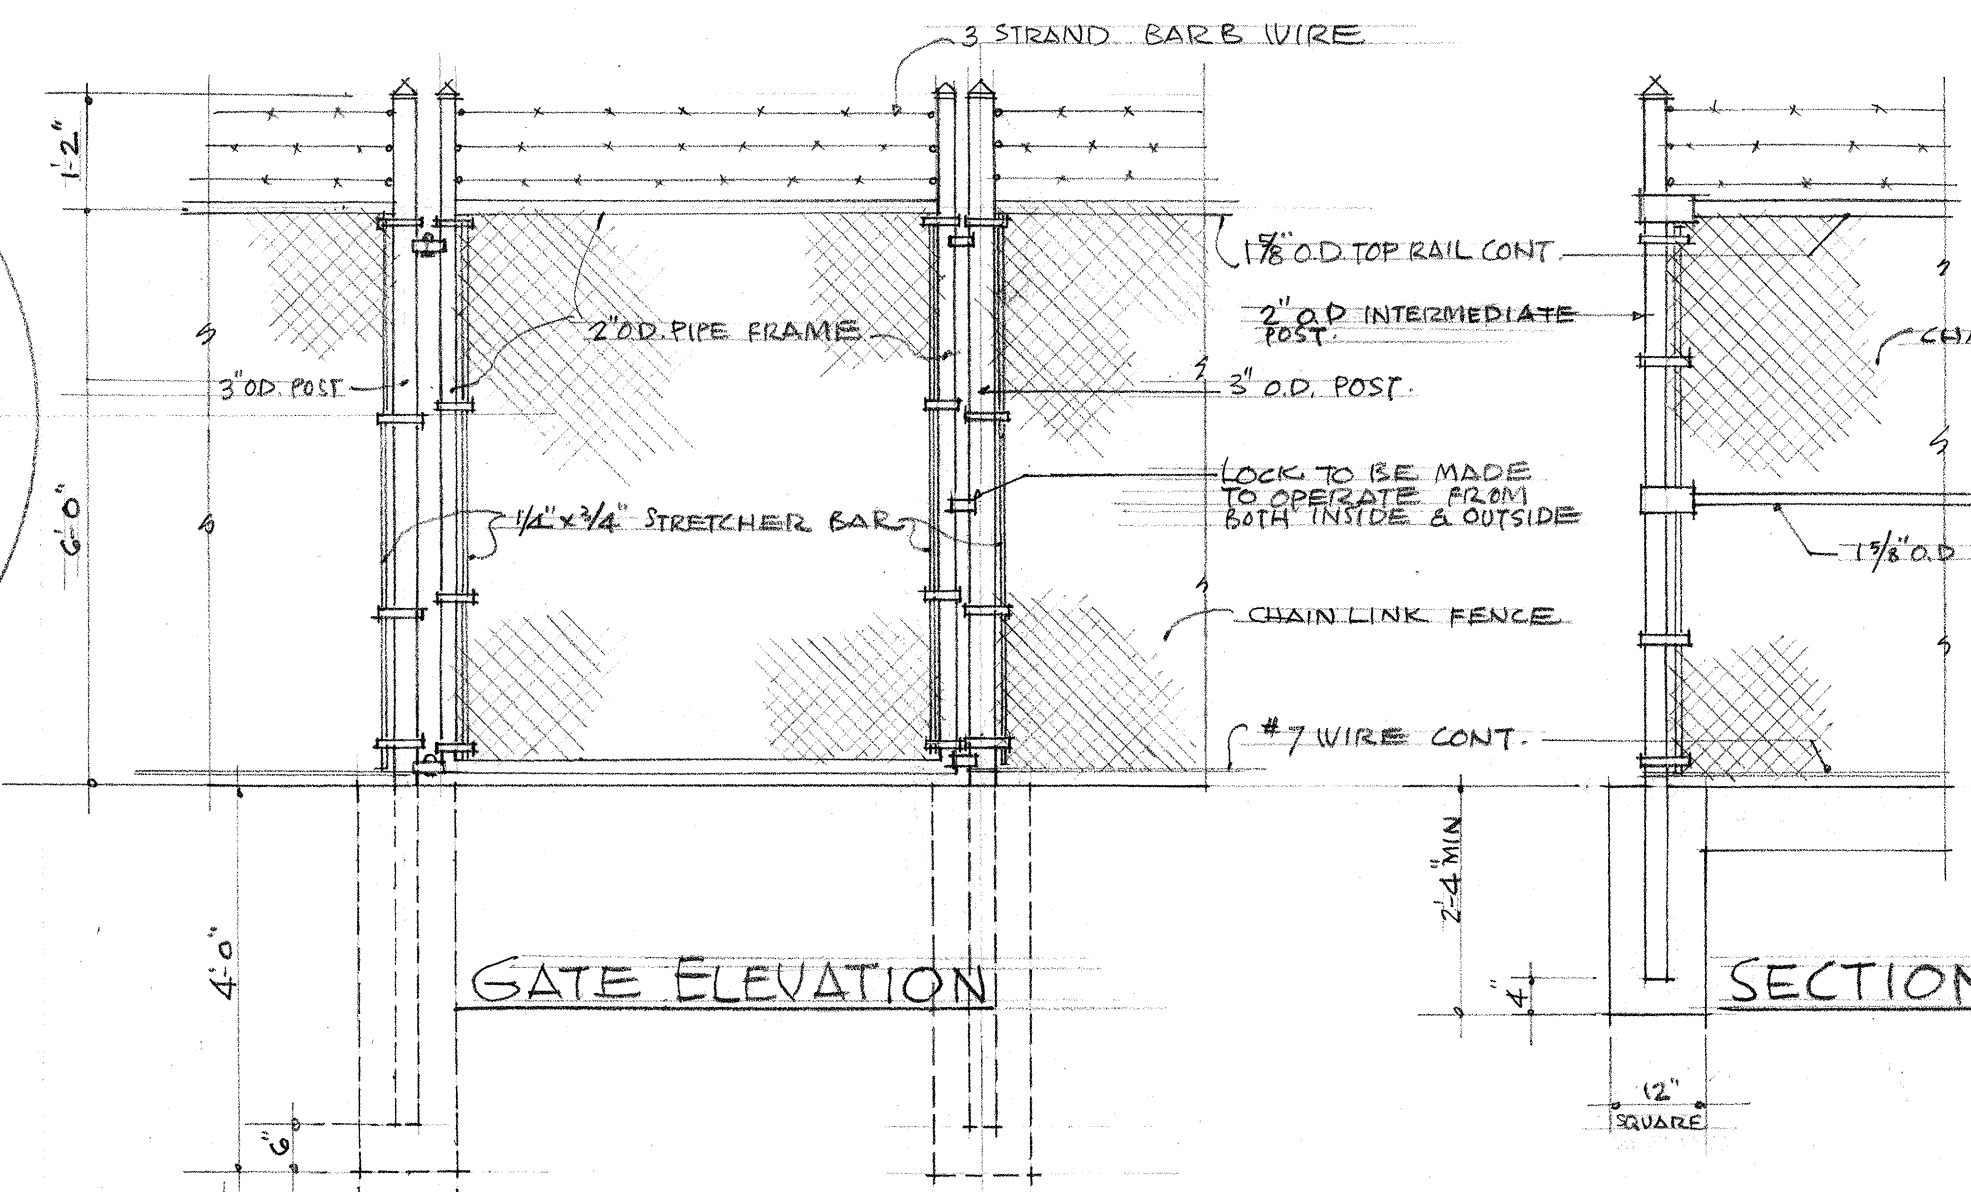

GATE ELEVATION

SECTION

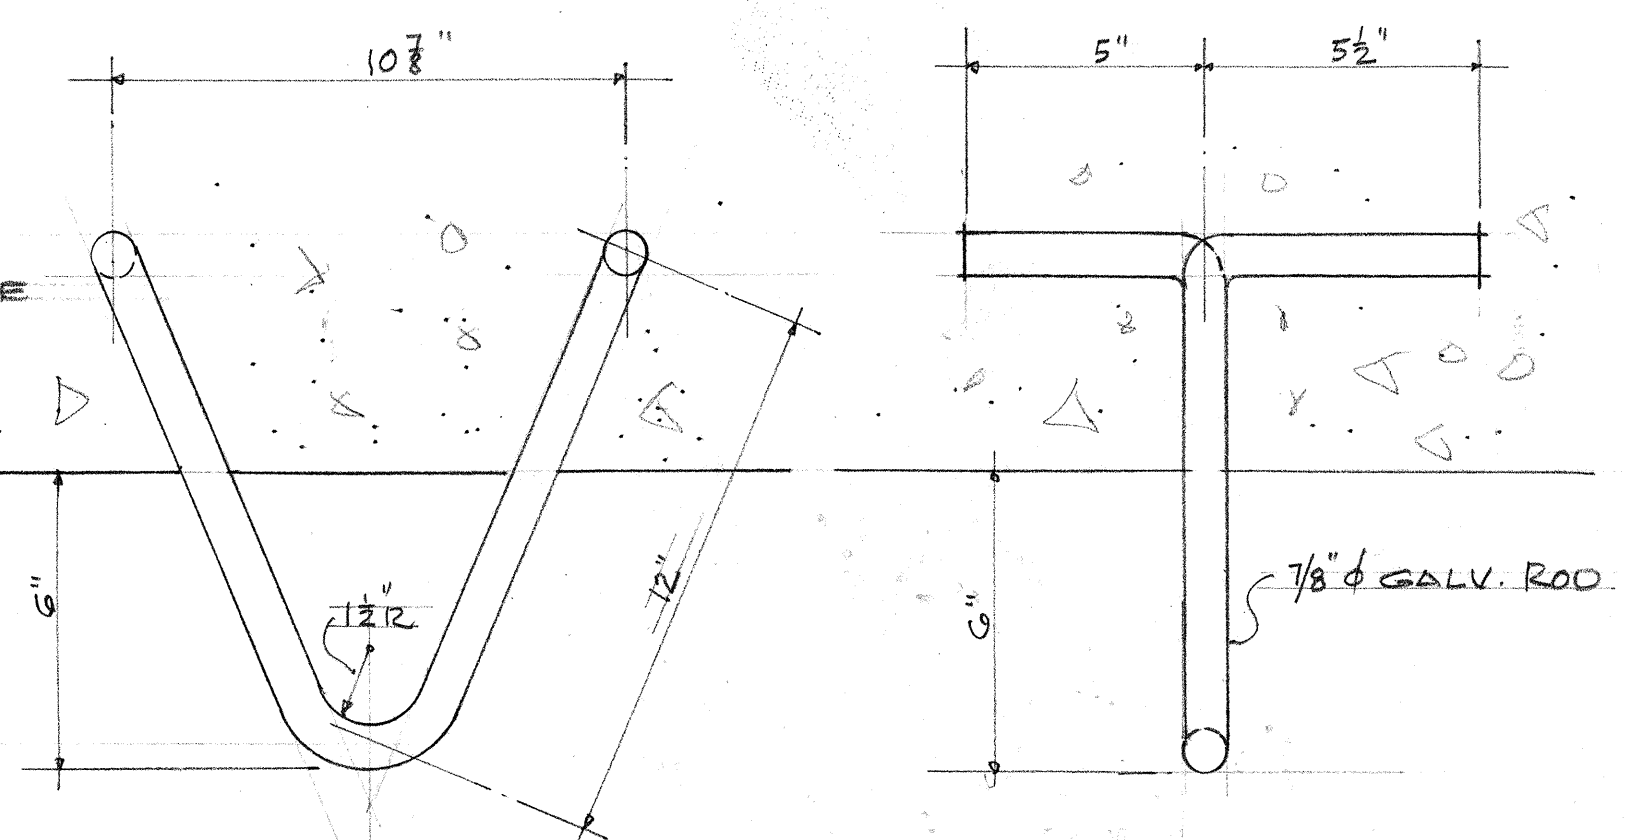


DETAIL OF PULL-IN IRON

SCALE: 3" = 1'-0"
(DIMENSIONS ARE APPROX. MEASUREMENTS.)

GATE & FENCE DETAILS


SCALE: 1/2" = 1'-0"

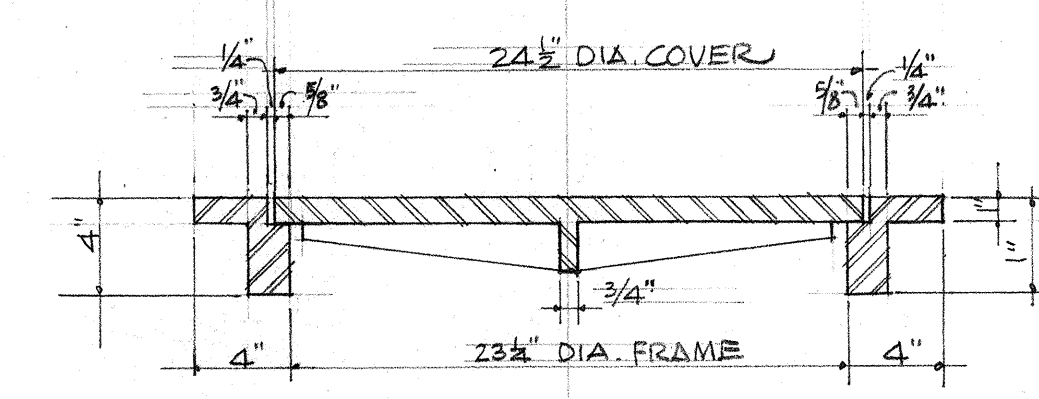

SECTION


MANHOLE FRAME & COVER DETAILS

SCALE: 1/2" = 1'-0"

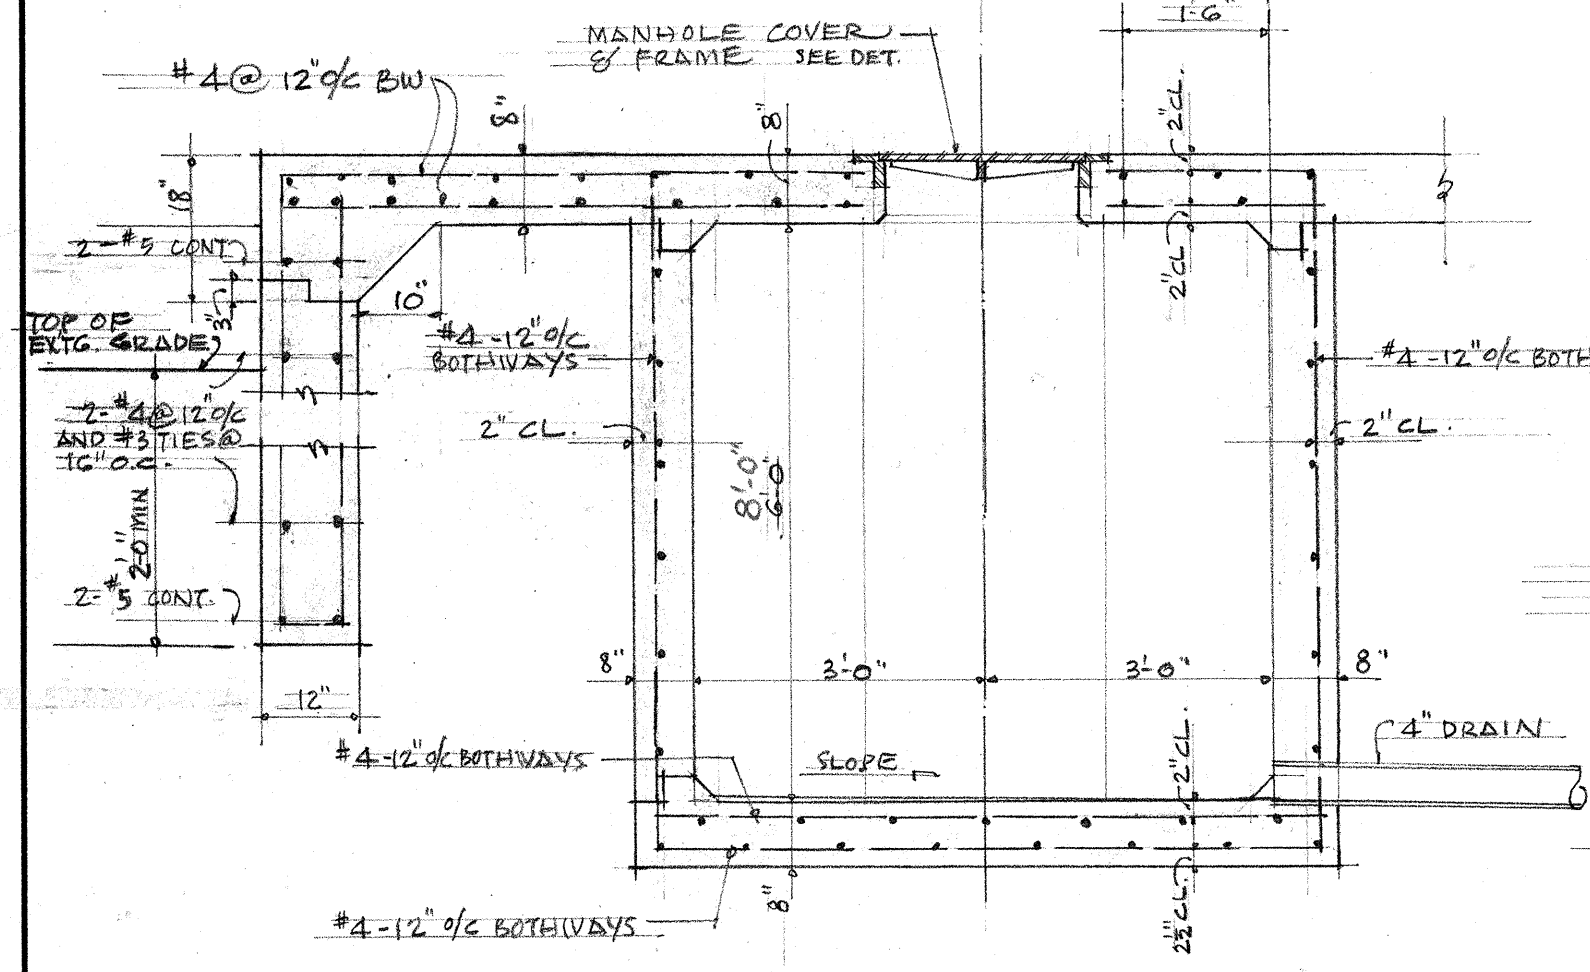

SECTION

SCALE: 1/2" = 1'-0"

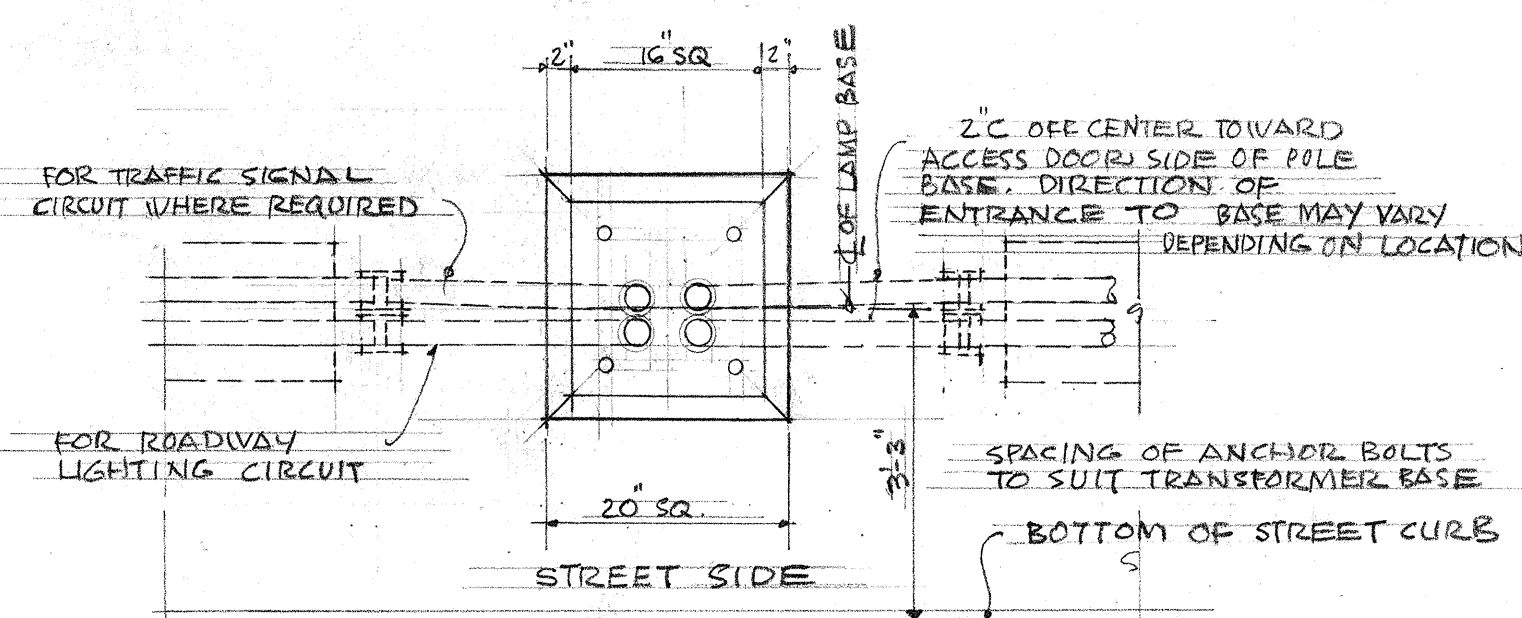


PLAN

HANDHOLE COVER LIFT PLAN

1/2 F.S.S.

HANDHOLE COVER LIFT SECTION

1/2 F.S.S.

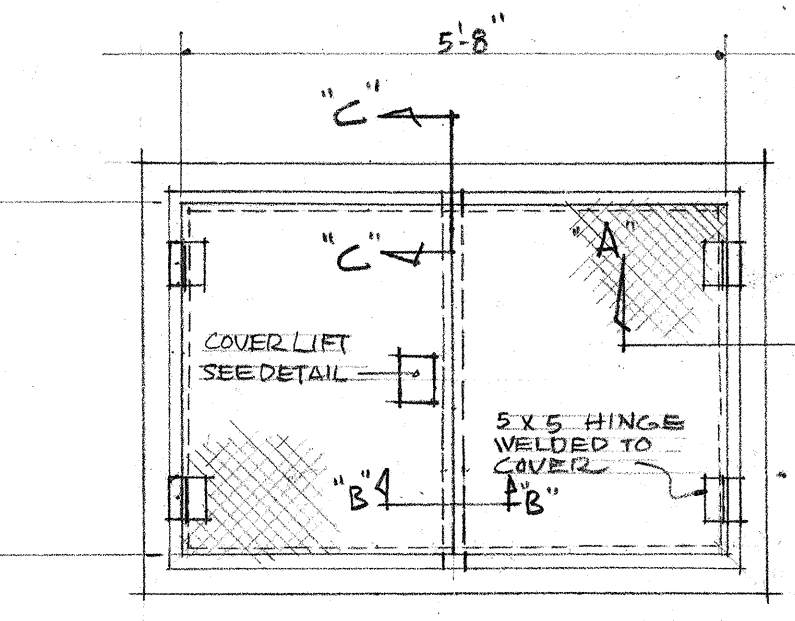

COVER PLAN

HANDHOLE DETAILS

SCALE: 1/2" = 1'-0"

DETAIL A-A


SCALE: 3" = 1'-0"

DETAIL B-B

SCALE: 3" = 1'-0"


DETAIL C-C

SCALE: 3" = 1'-0"

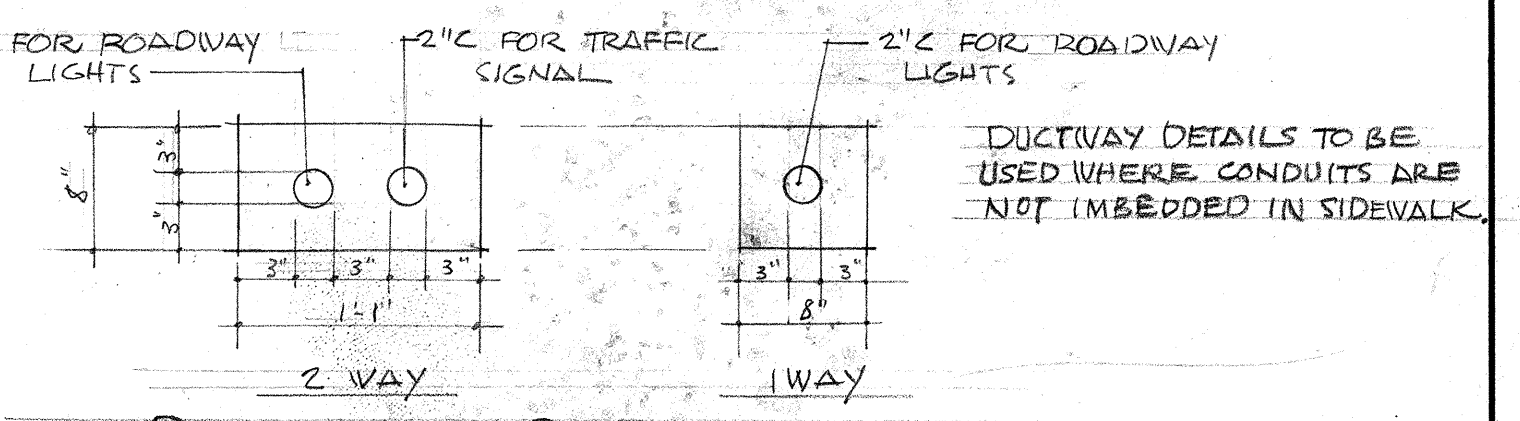

DUCTWAY DETAILS FOR ROADWAY LIGHTING AND TRAFFIC SIGNALS

SCALE: 1" = 1'-0"

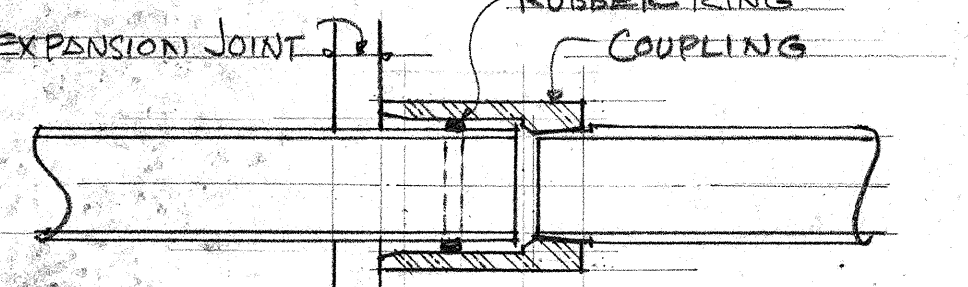


EXPANSION COUPLING FOR ALL 2" CONDUITS AT EACH BRIDGE EXPANSION JOINT.

SCALE: 3" = 1'-0"


DUCTWAY DETAIL - FROM MANHOLE

SCALE: 1" = 1'-0"

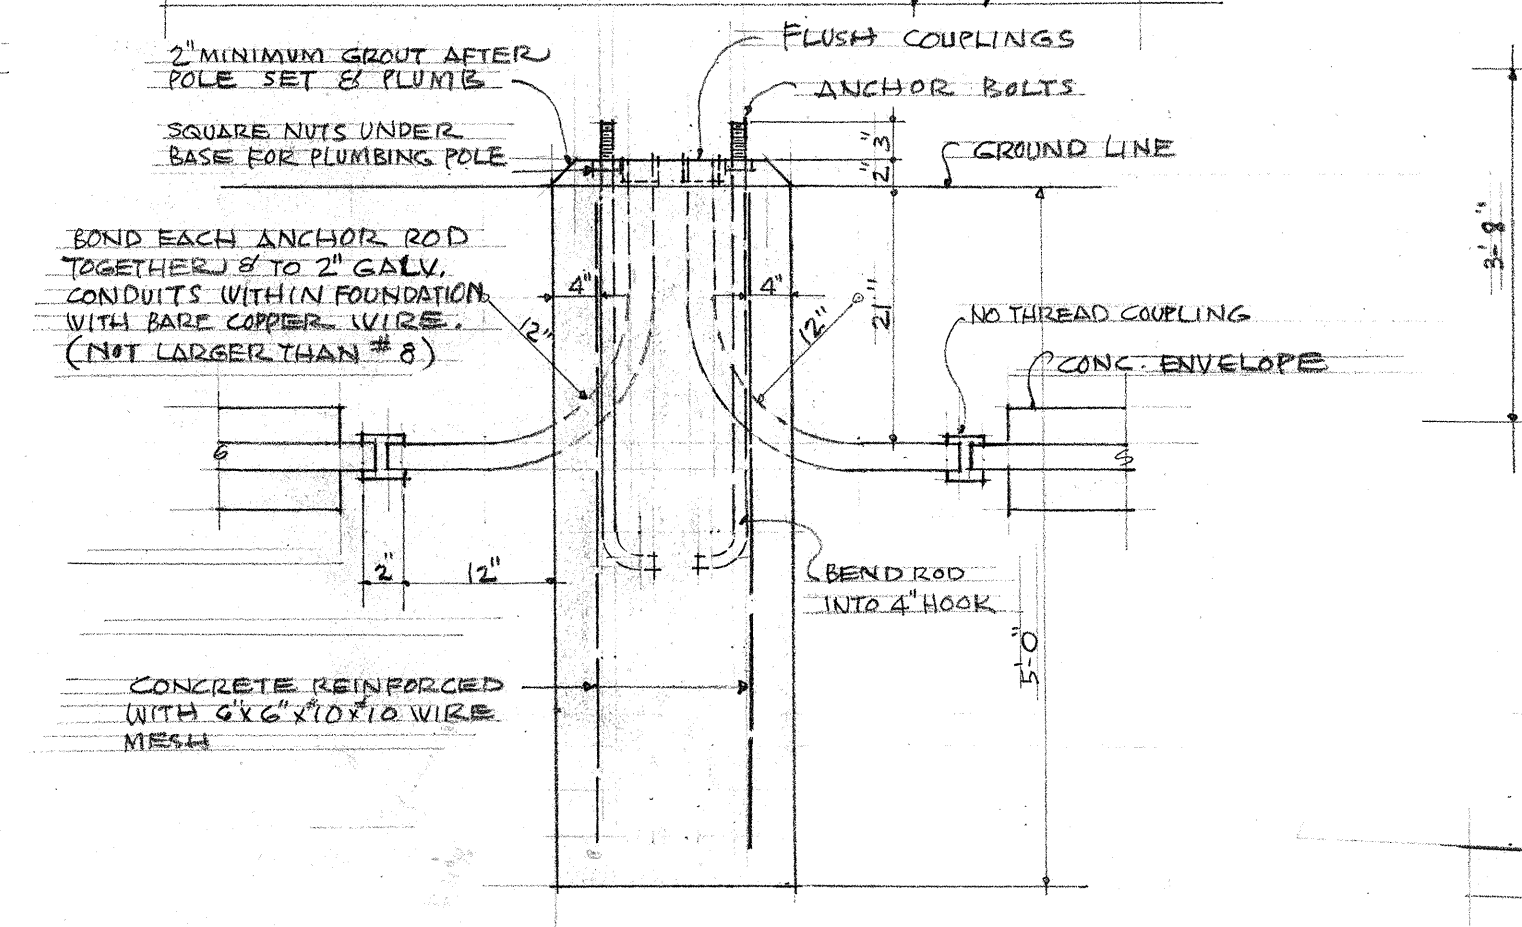

CONCRETE FOUNDATION FOR LAMP POST

SCALE: 3/4" = 1'-0" (FOR FOUNDATION ON BRIDGE, SEE BRIDGE #3 SHEET 11.)

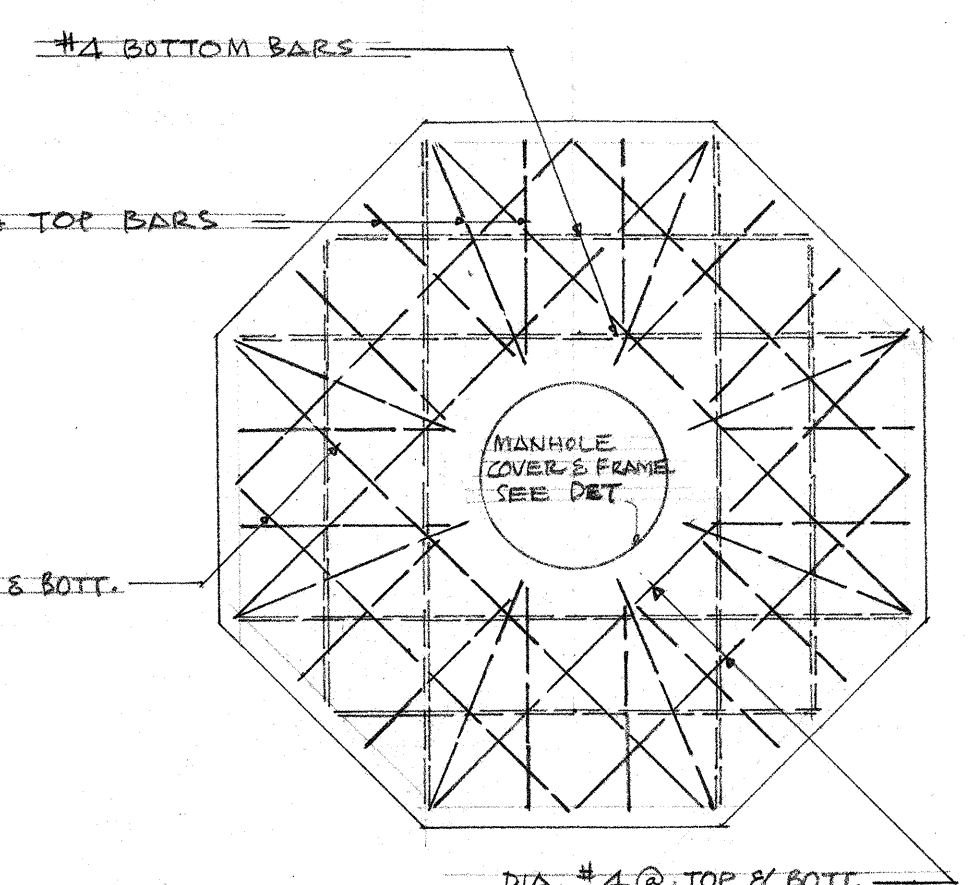

TOP SLAB REINFORCING

SCALE: 1/2" = 1'-0"



MANHOLE DETAILS

TERRITORIAL HIGHWAY DEPARTMENT
TERRITORY OF HAWAII
ELECTRICAL
MISC. ELECTRICAL DETAILS
NUUANU PALI TUNNELS
PALI ROAD
PROJ. NO. S-216(S)
SCALES: AS NOTED DATE: AUG. 27, 1954
JAMES J. OBERHAUSEN
ELECTRICAL ENGINEER

SHEET NO. 8 OF 9 SHEETS


5808.50

DATE: _____
DESIGNED BY: _____
CHECKED BY: _____
QUANTITIES CHECKED BY: _____
NOTE BOOK NO. _____

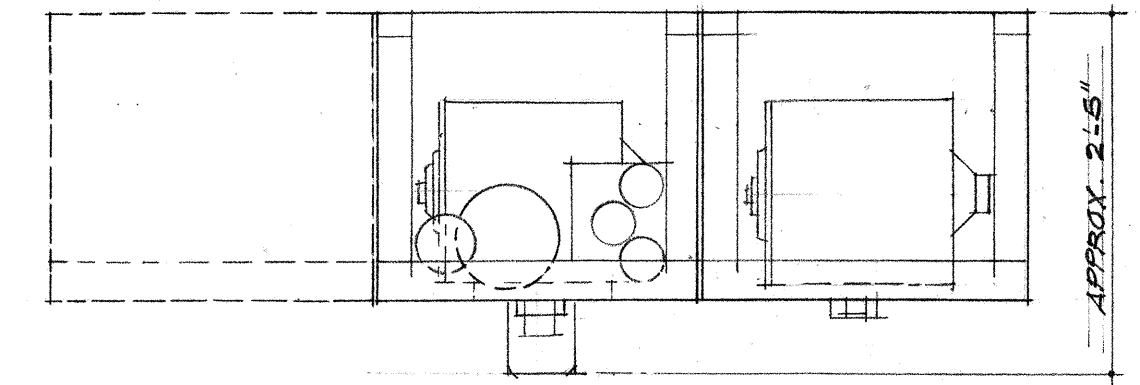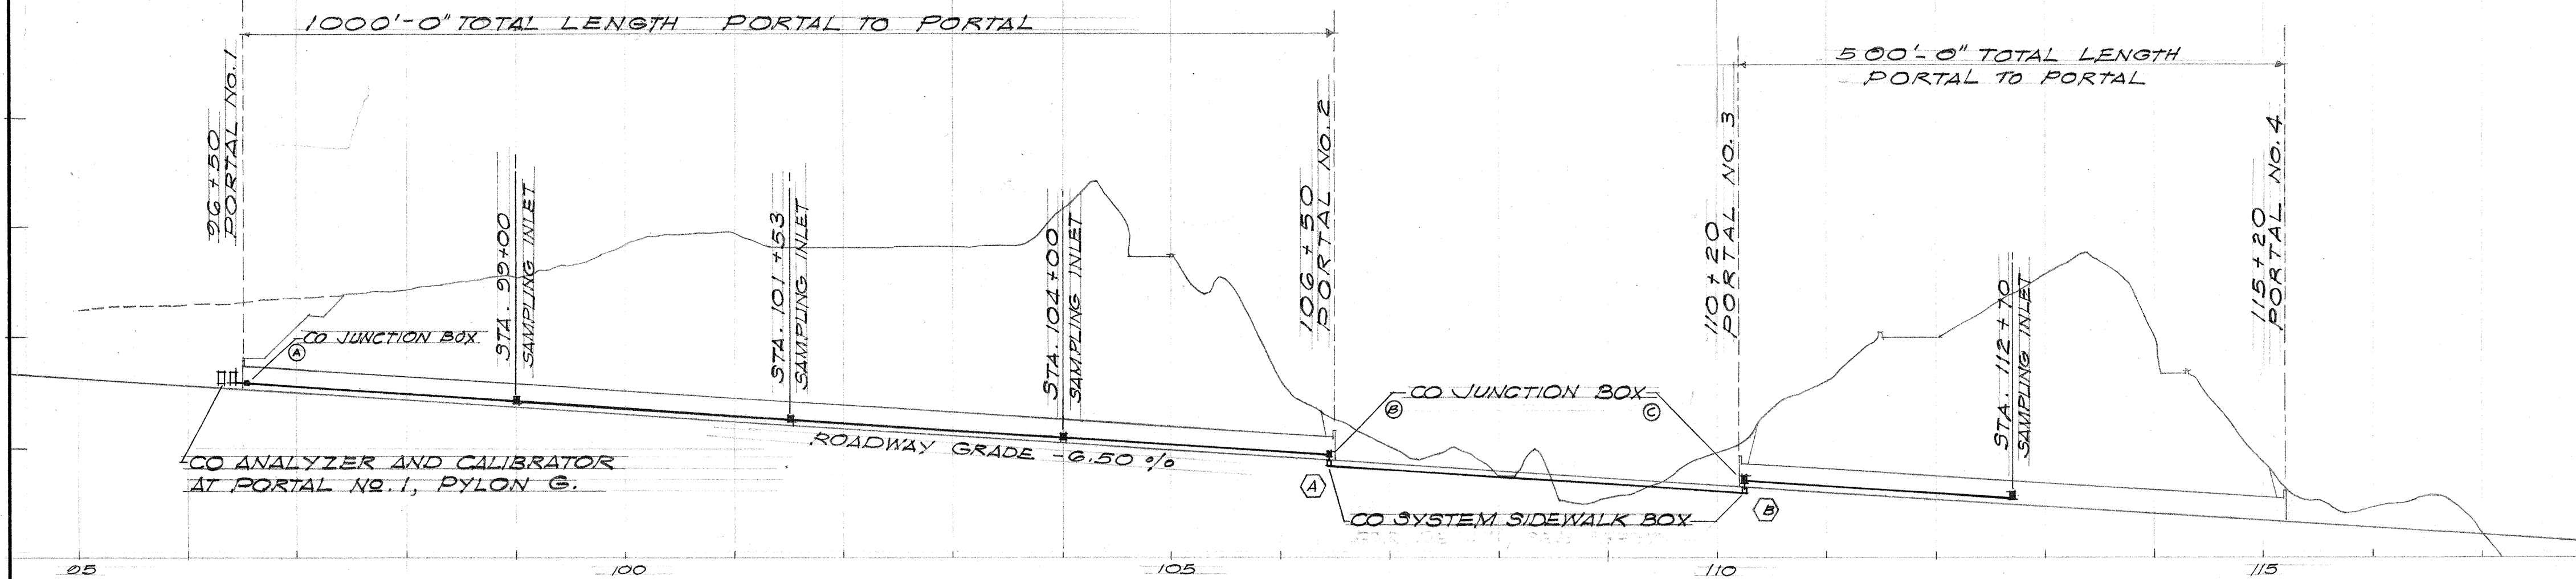


PLAN


TUNNEL NO. 1 SECTION ALONG 4 TUNNEL NO. 2
SHOWING CO SAMPLING SYSTEM & SAMPLING INLET LOCATIONS

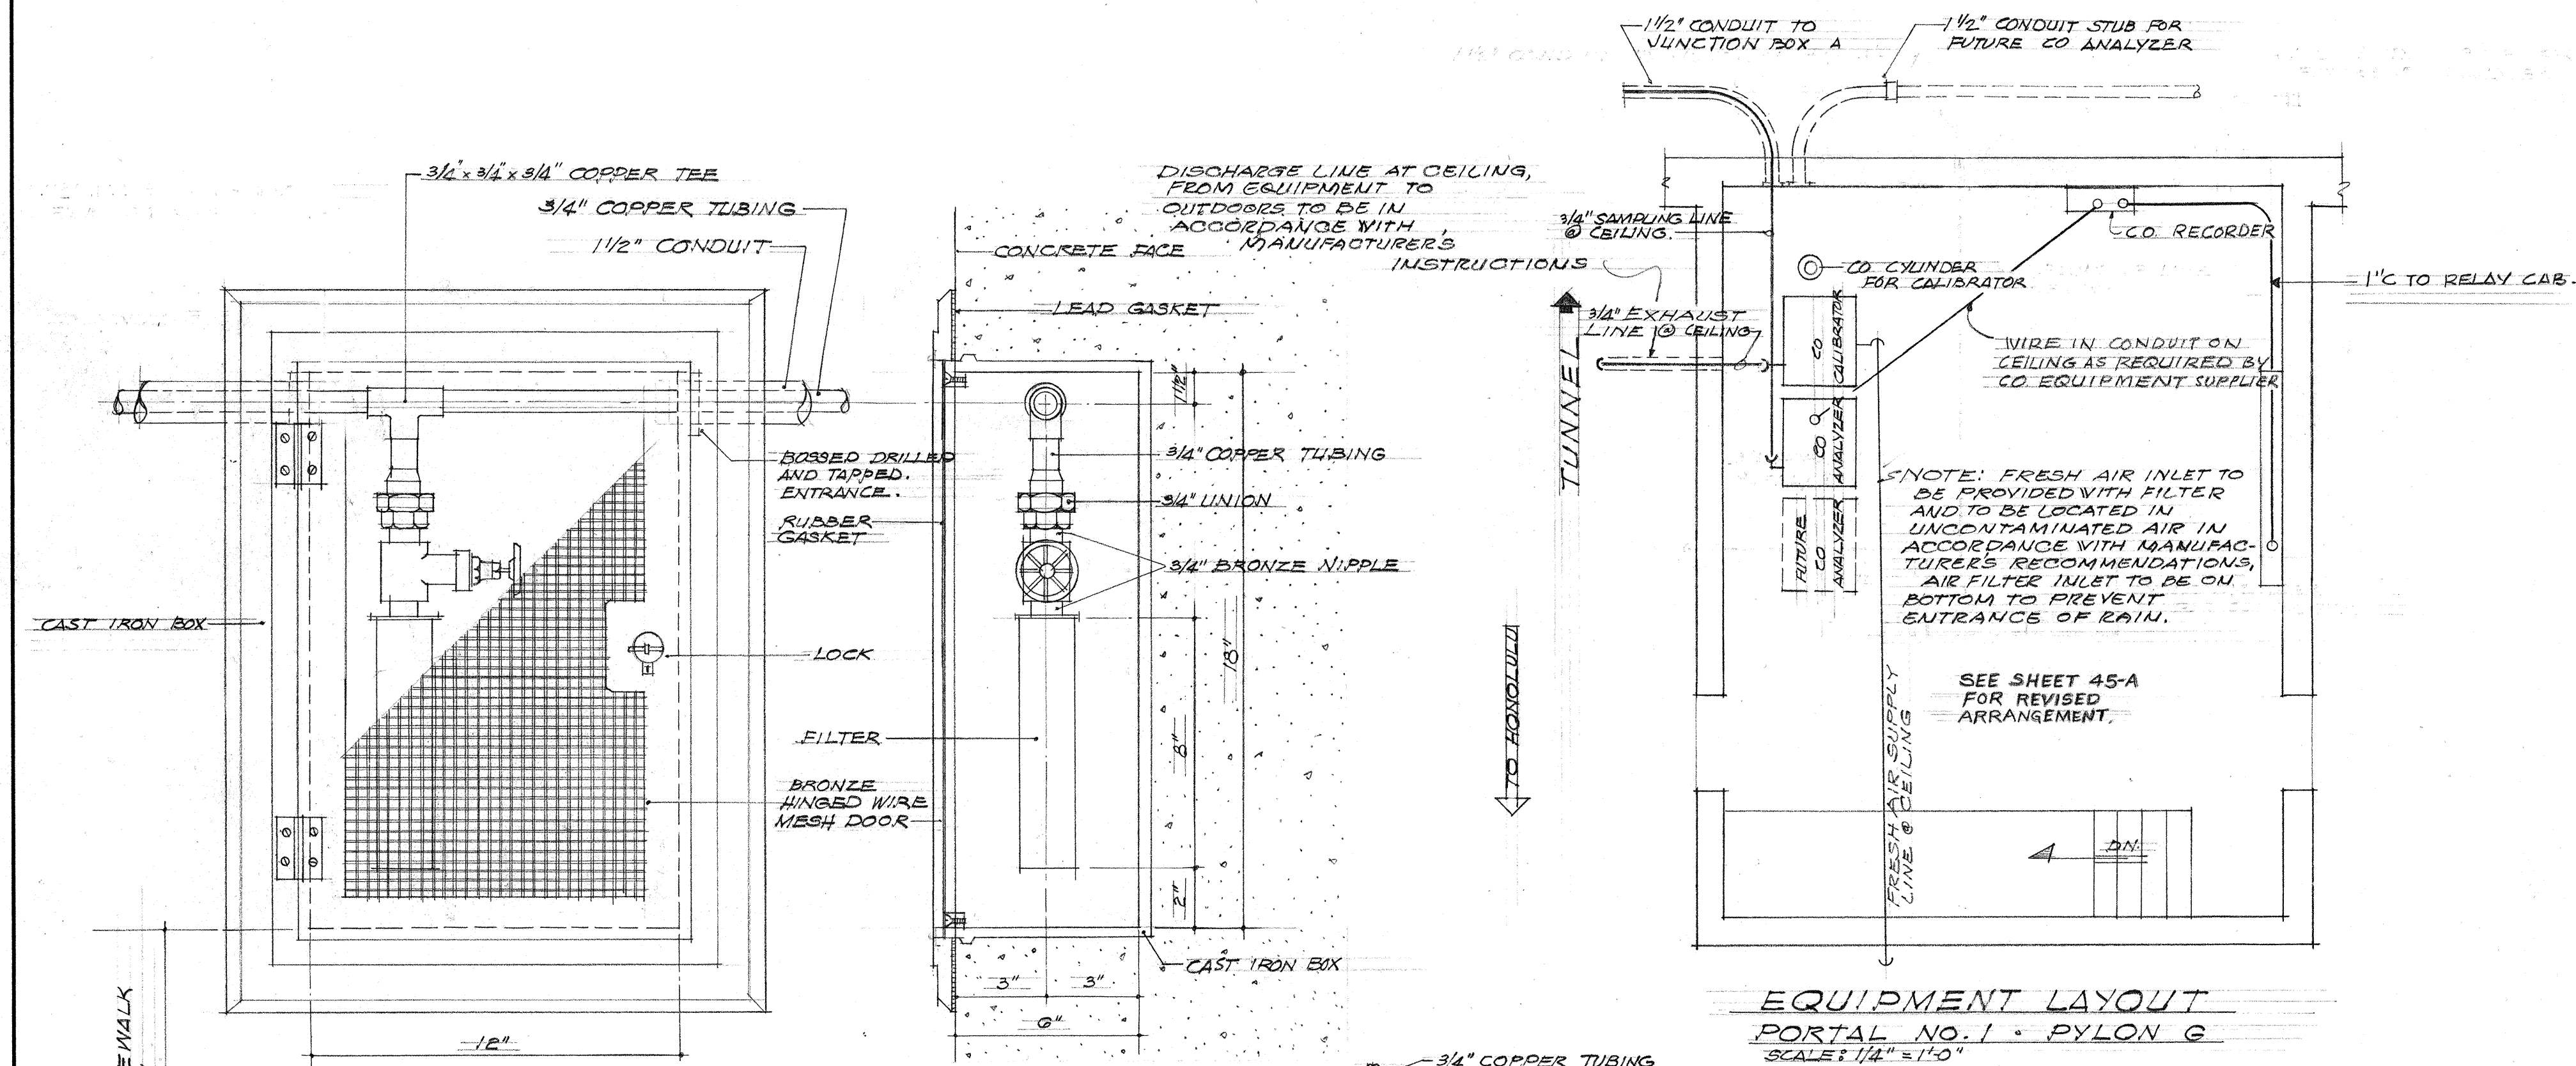


EQUIPMENT LAYOUT
PORTAL NO. 1 - PYLON G
SCALE: 1/4" = 1'-0"

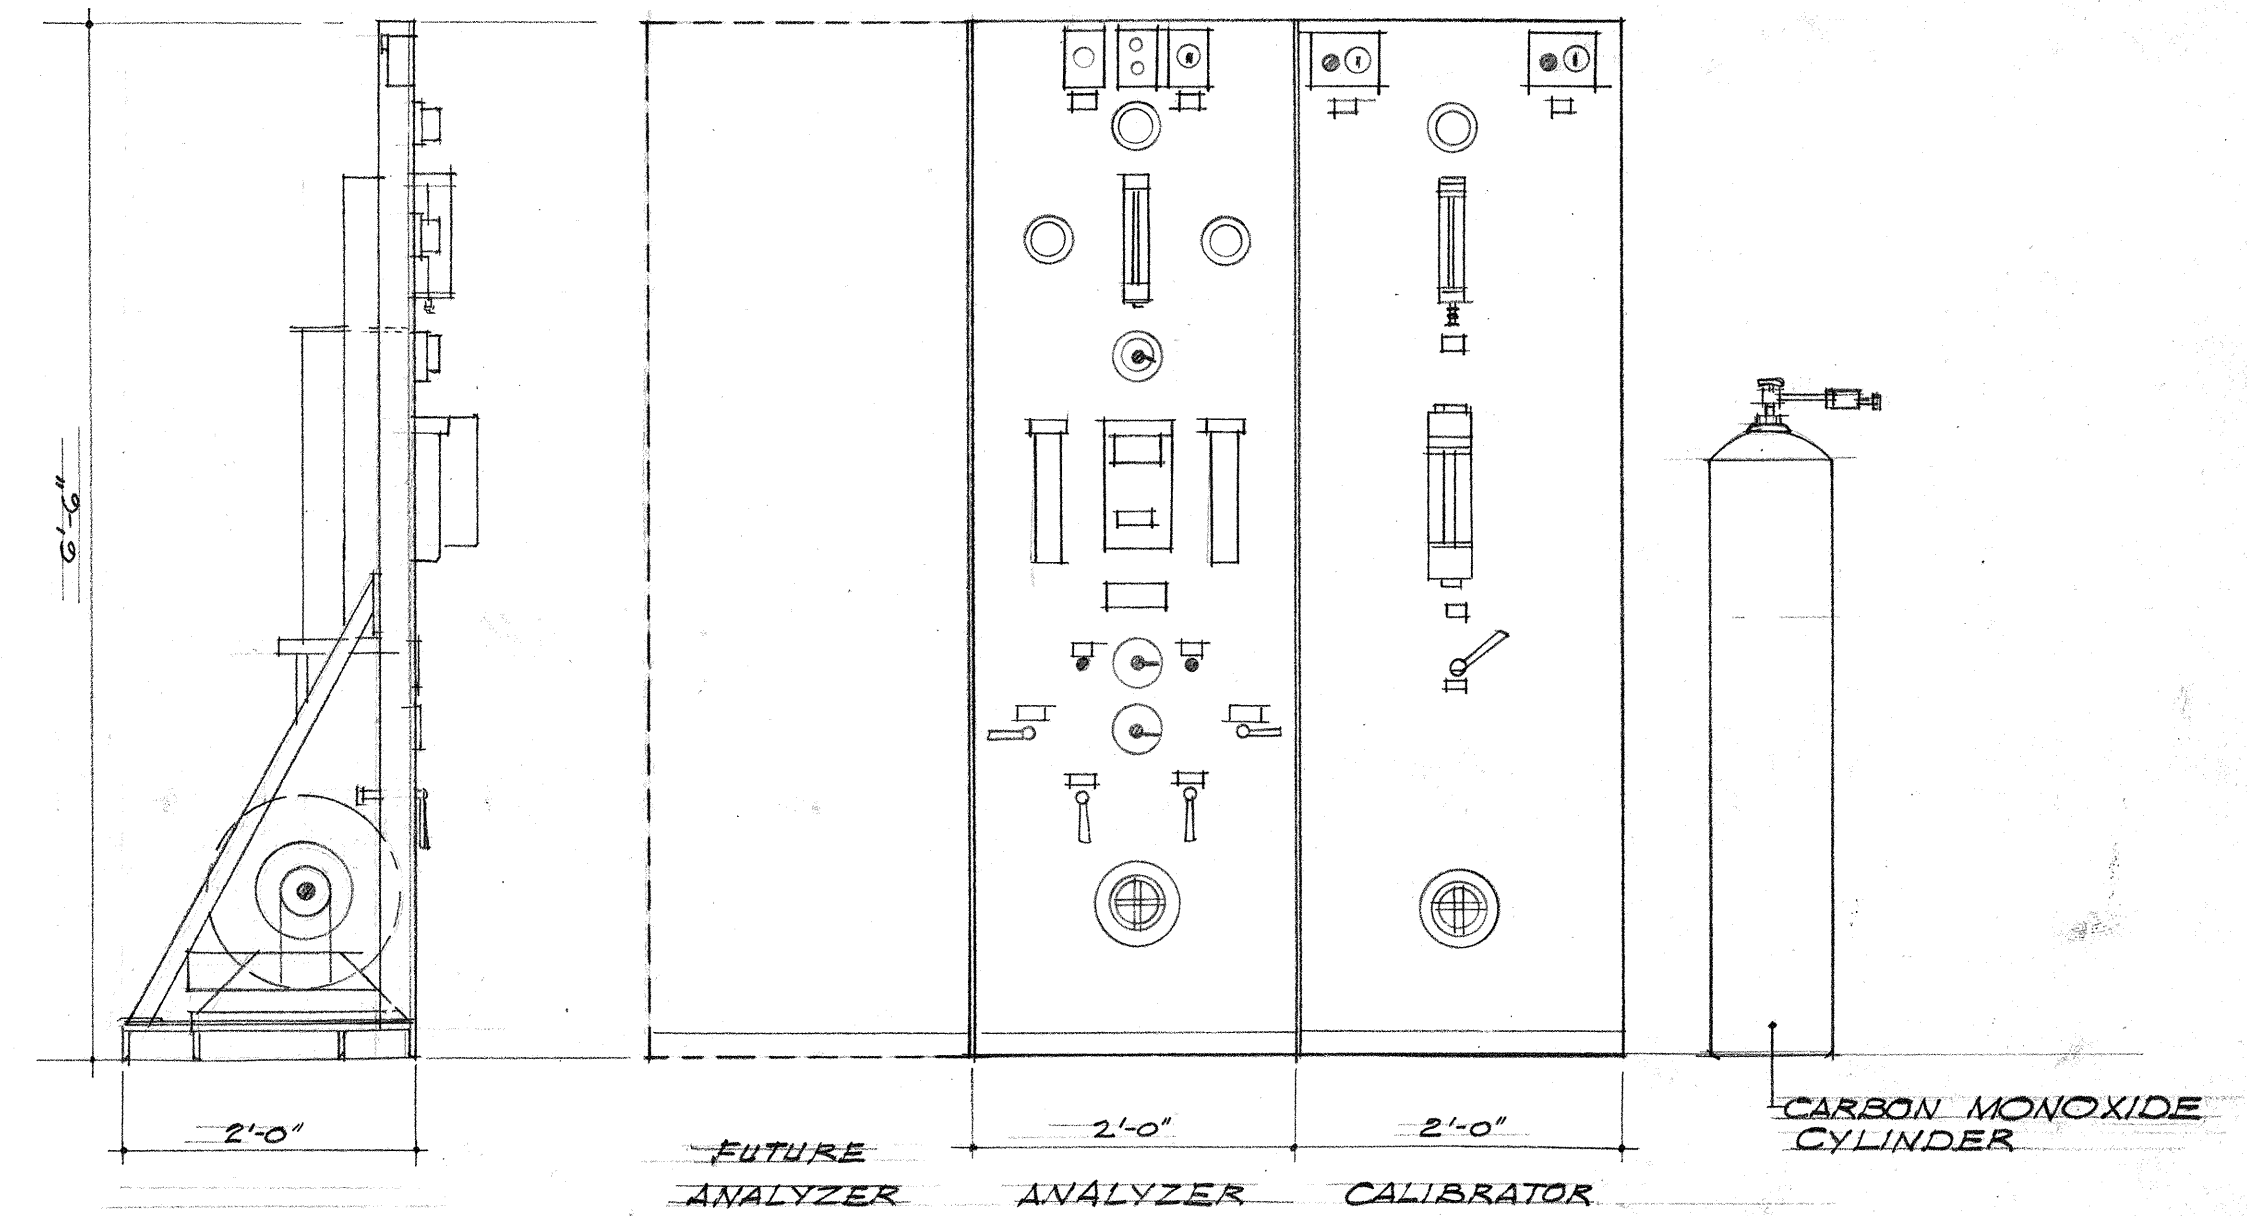


END VIEW FRONT ELEVATION
TYPICAL CO ANALYZER & CALIBRATOR ASSEMBLY
SCALE: 3/4" = 1'-0"

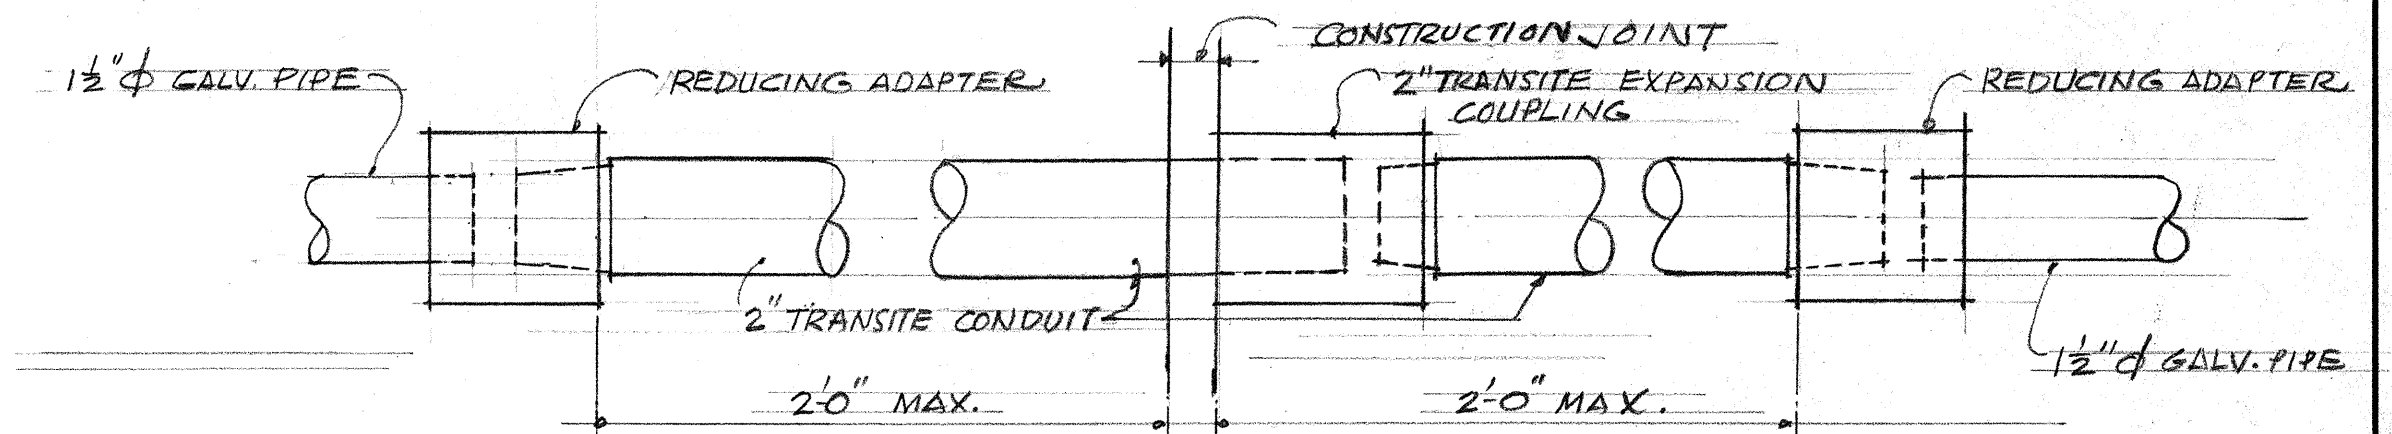

EXPANSION COUPLING AT EACH TUNNEL
CONSTRUCTION JOINT &
BRIDGE EXPANSION JOINT
SCALE: 3" = 1'-0"

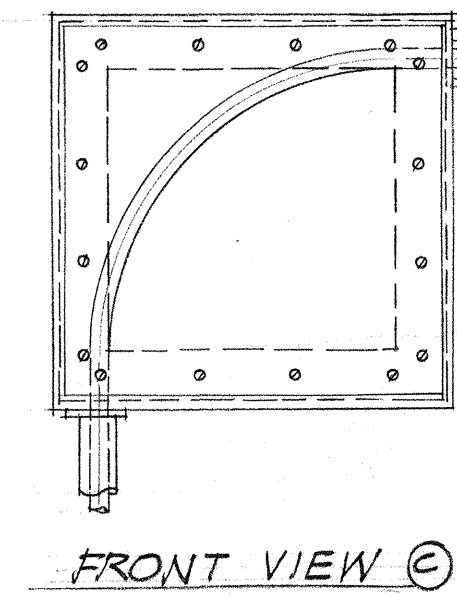

FRONT VIEW SIDE VIEW
TYPICAL CO SAMPLING INLET
SCALE: 3" = 1'-0"

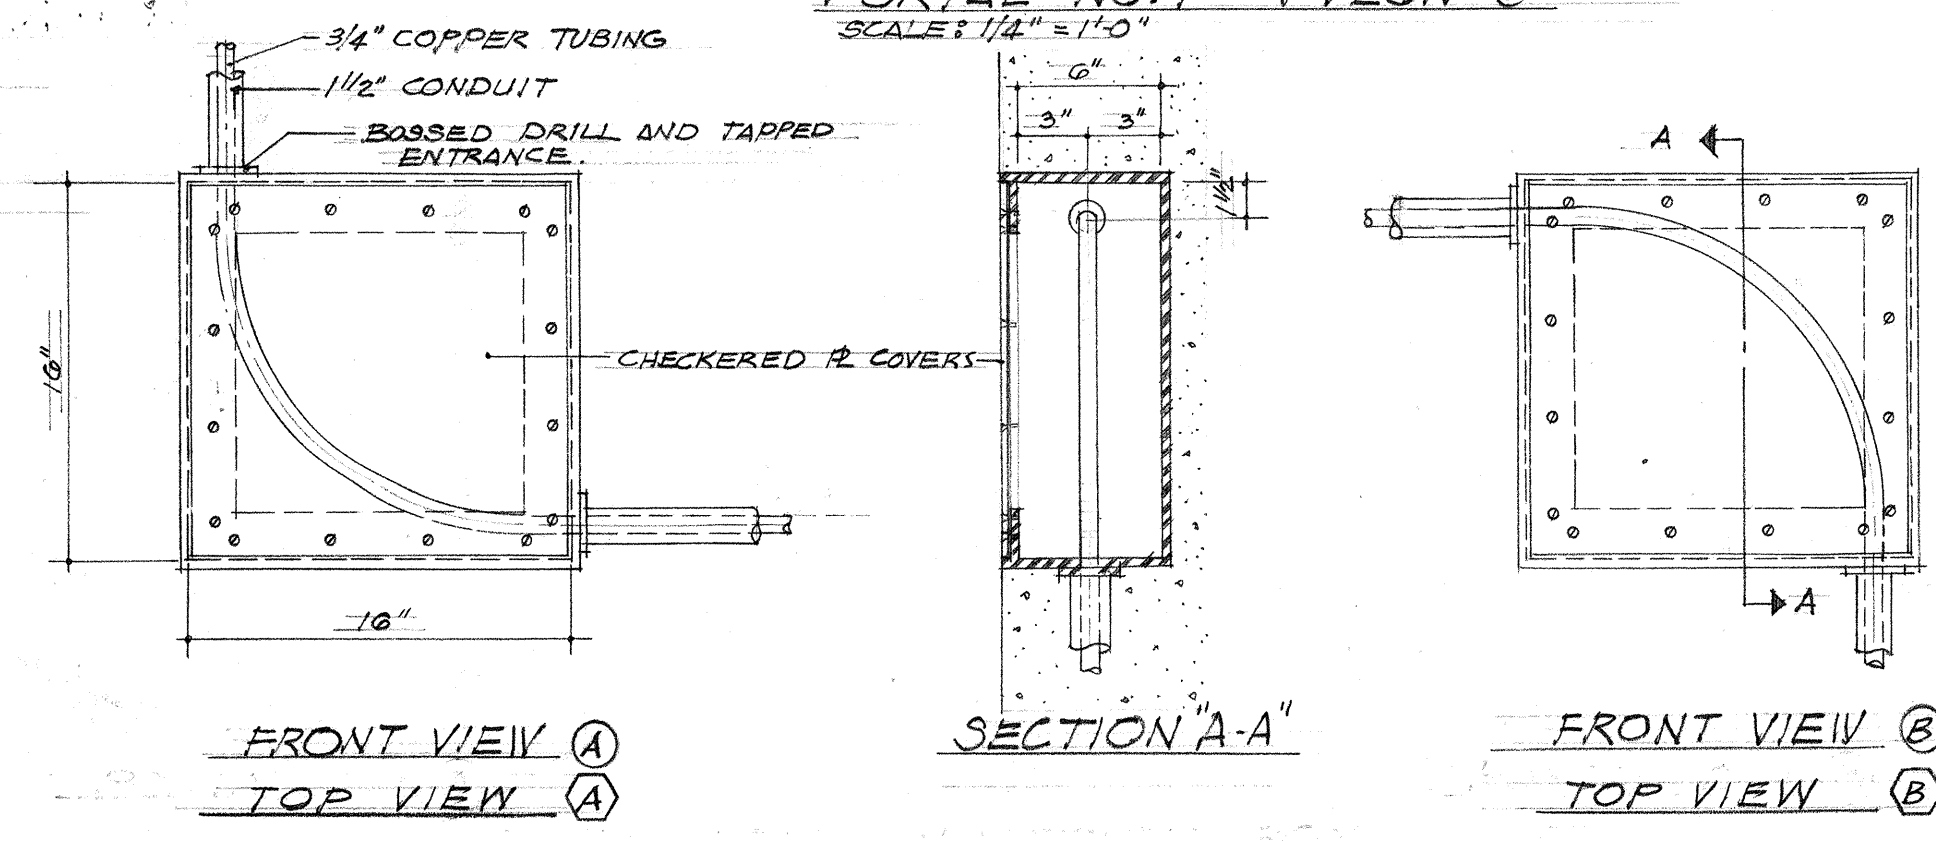

FRONT VIEW (A) TOP VIEW (A)
SECTION A-A
FRONT VIEW (B) TOP VIEW (B)
TYPICAL JUNCTION BOX
SCALE: 1/2" = 1'-0"

TERRITORIAL HIGHWAY DEPARTMENT
TERRITORY OF HAWAII
ELECTRICAL
CARBON MONOXIDE SAMPLING
NUUANU PALI TUNNELS
PALI ROAD
PROJ. NO. S 216 (S)
SCALES: AS NOTED DATE: AUG 27, 1954

JAMES J. OBERHAUSEN
ELECTRICAL ENGINEER

DATE: _____
DESIGNED BY: _____
DRAWN BY: _____
NOTE BOOK NO. _____
QUANTITIES CHECKED BY: _____
CHECKED BY: _____