



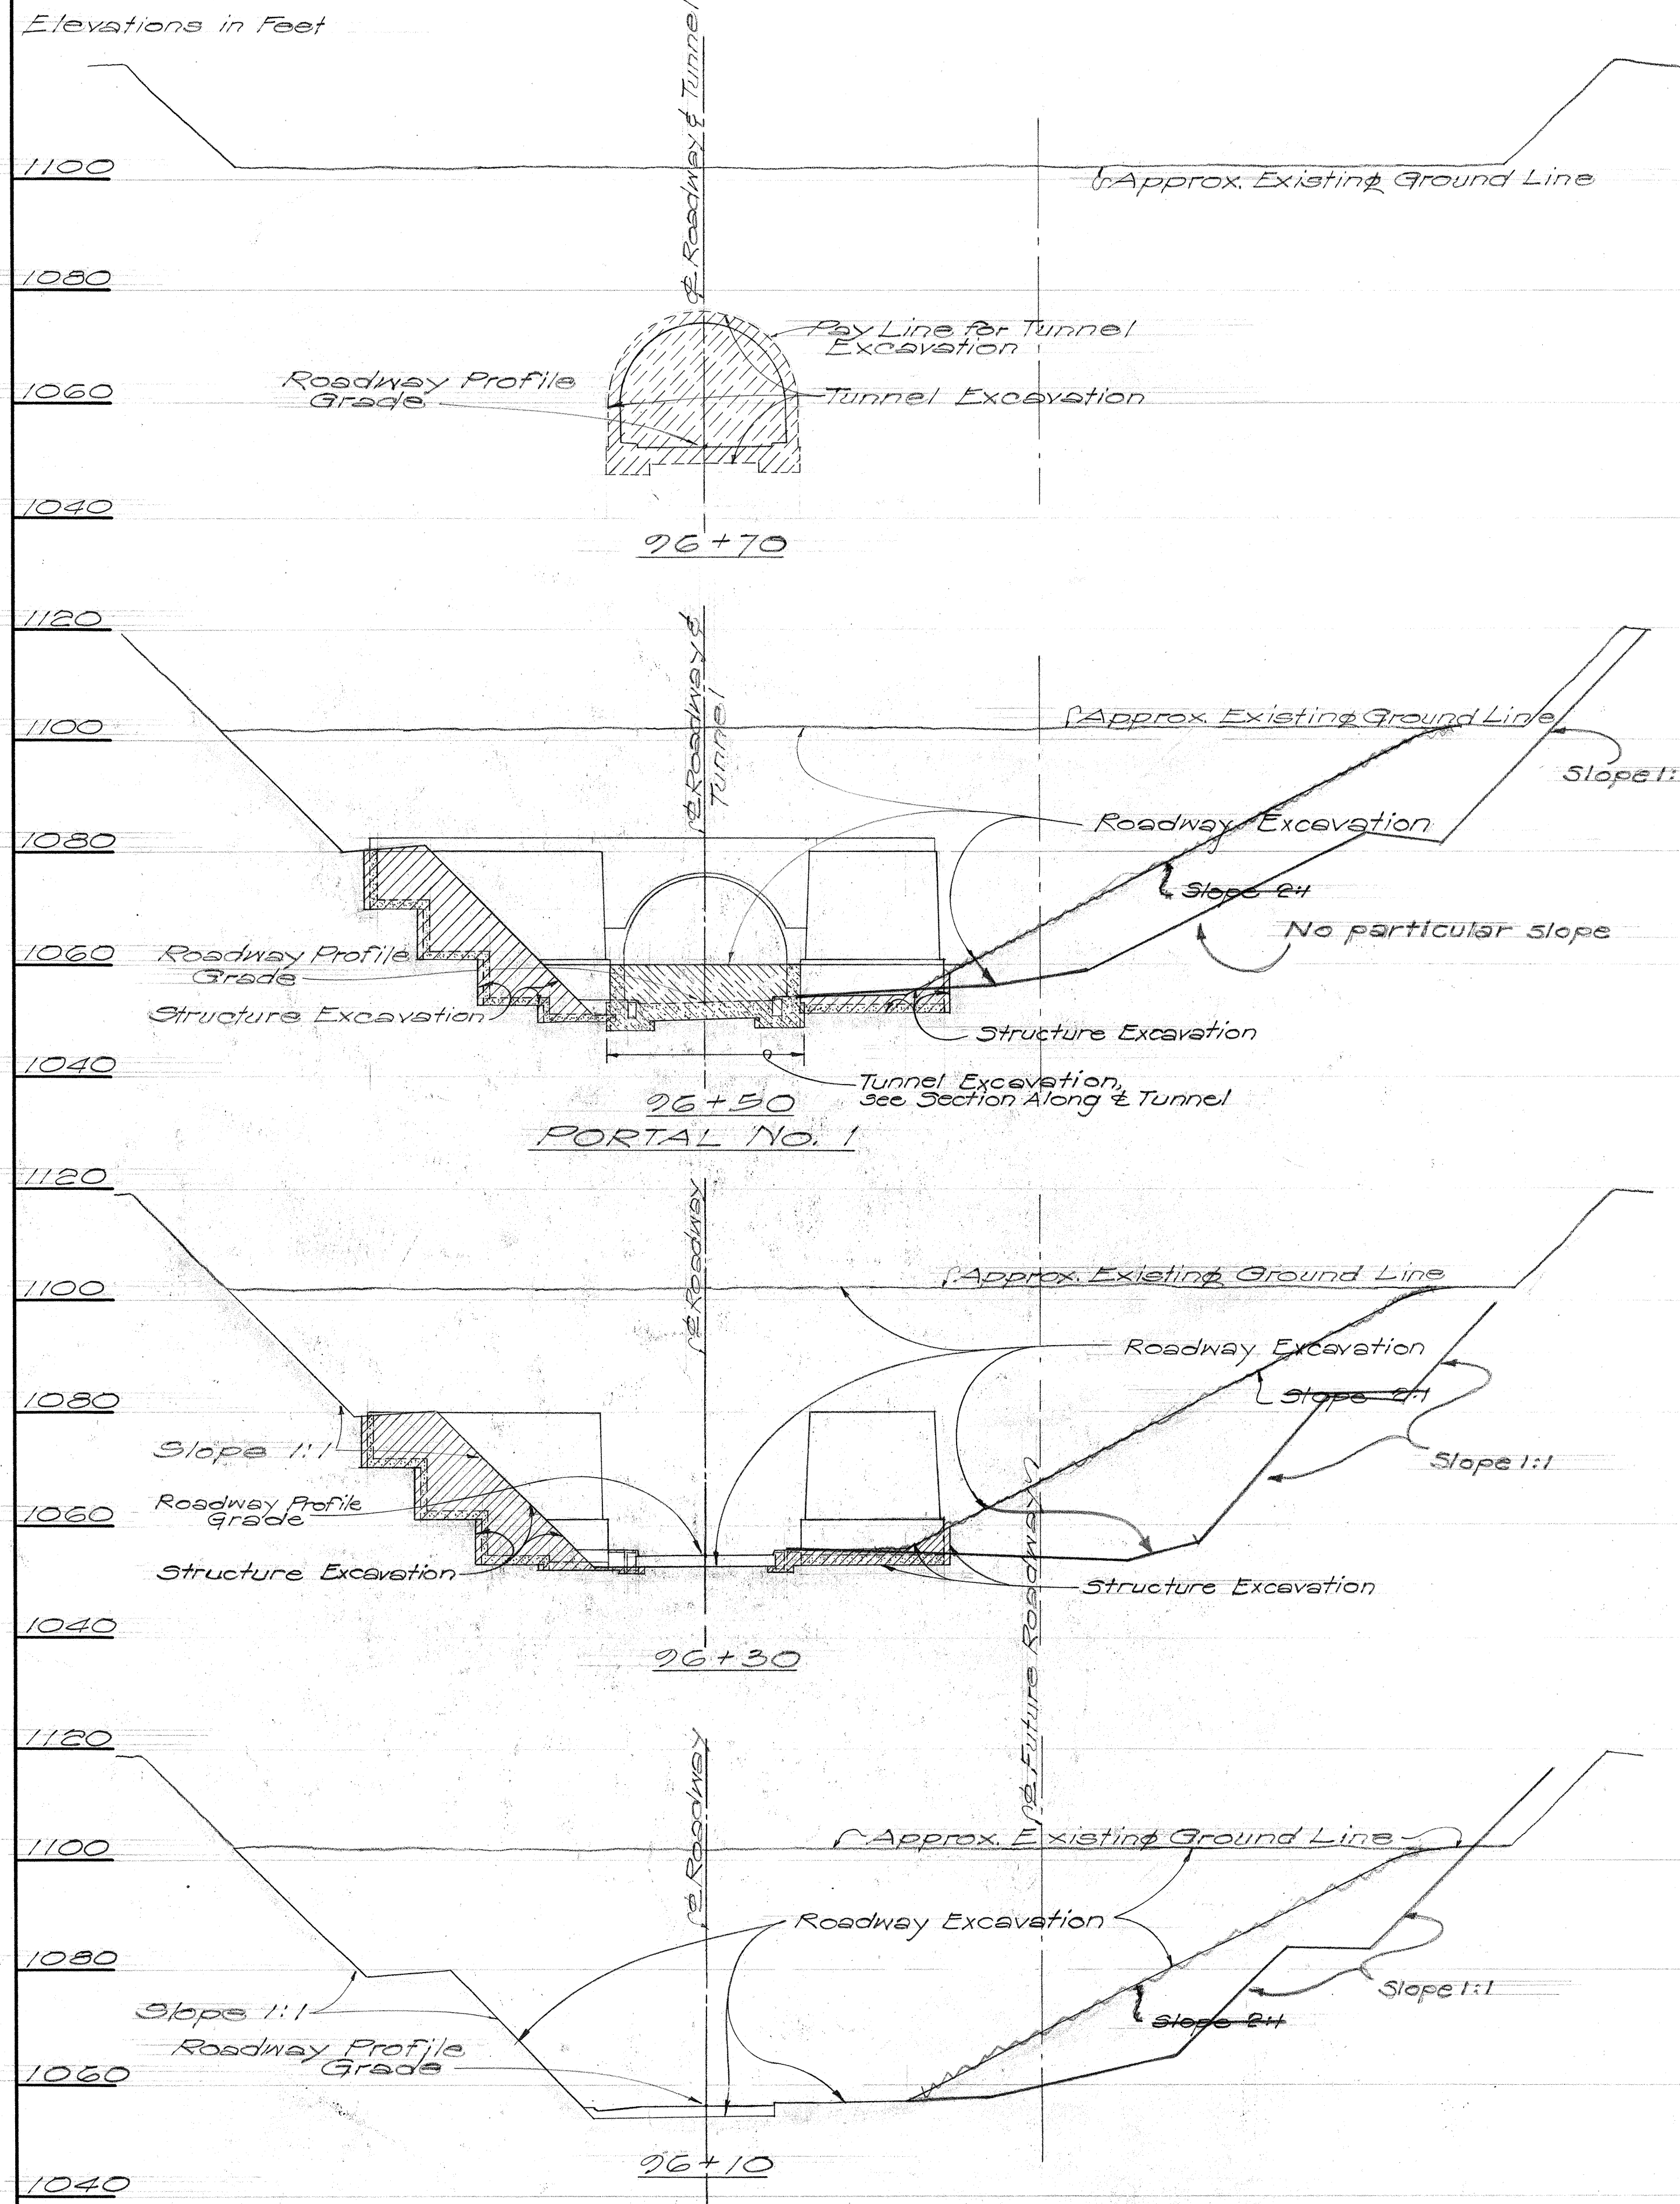

Note: For detail of Roadway Excavation, see Road Plans

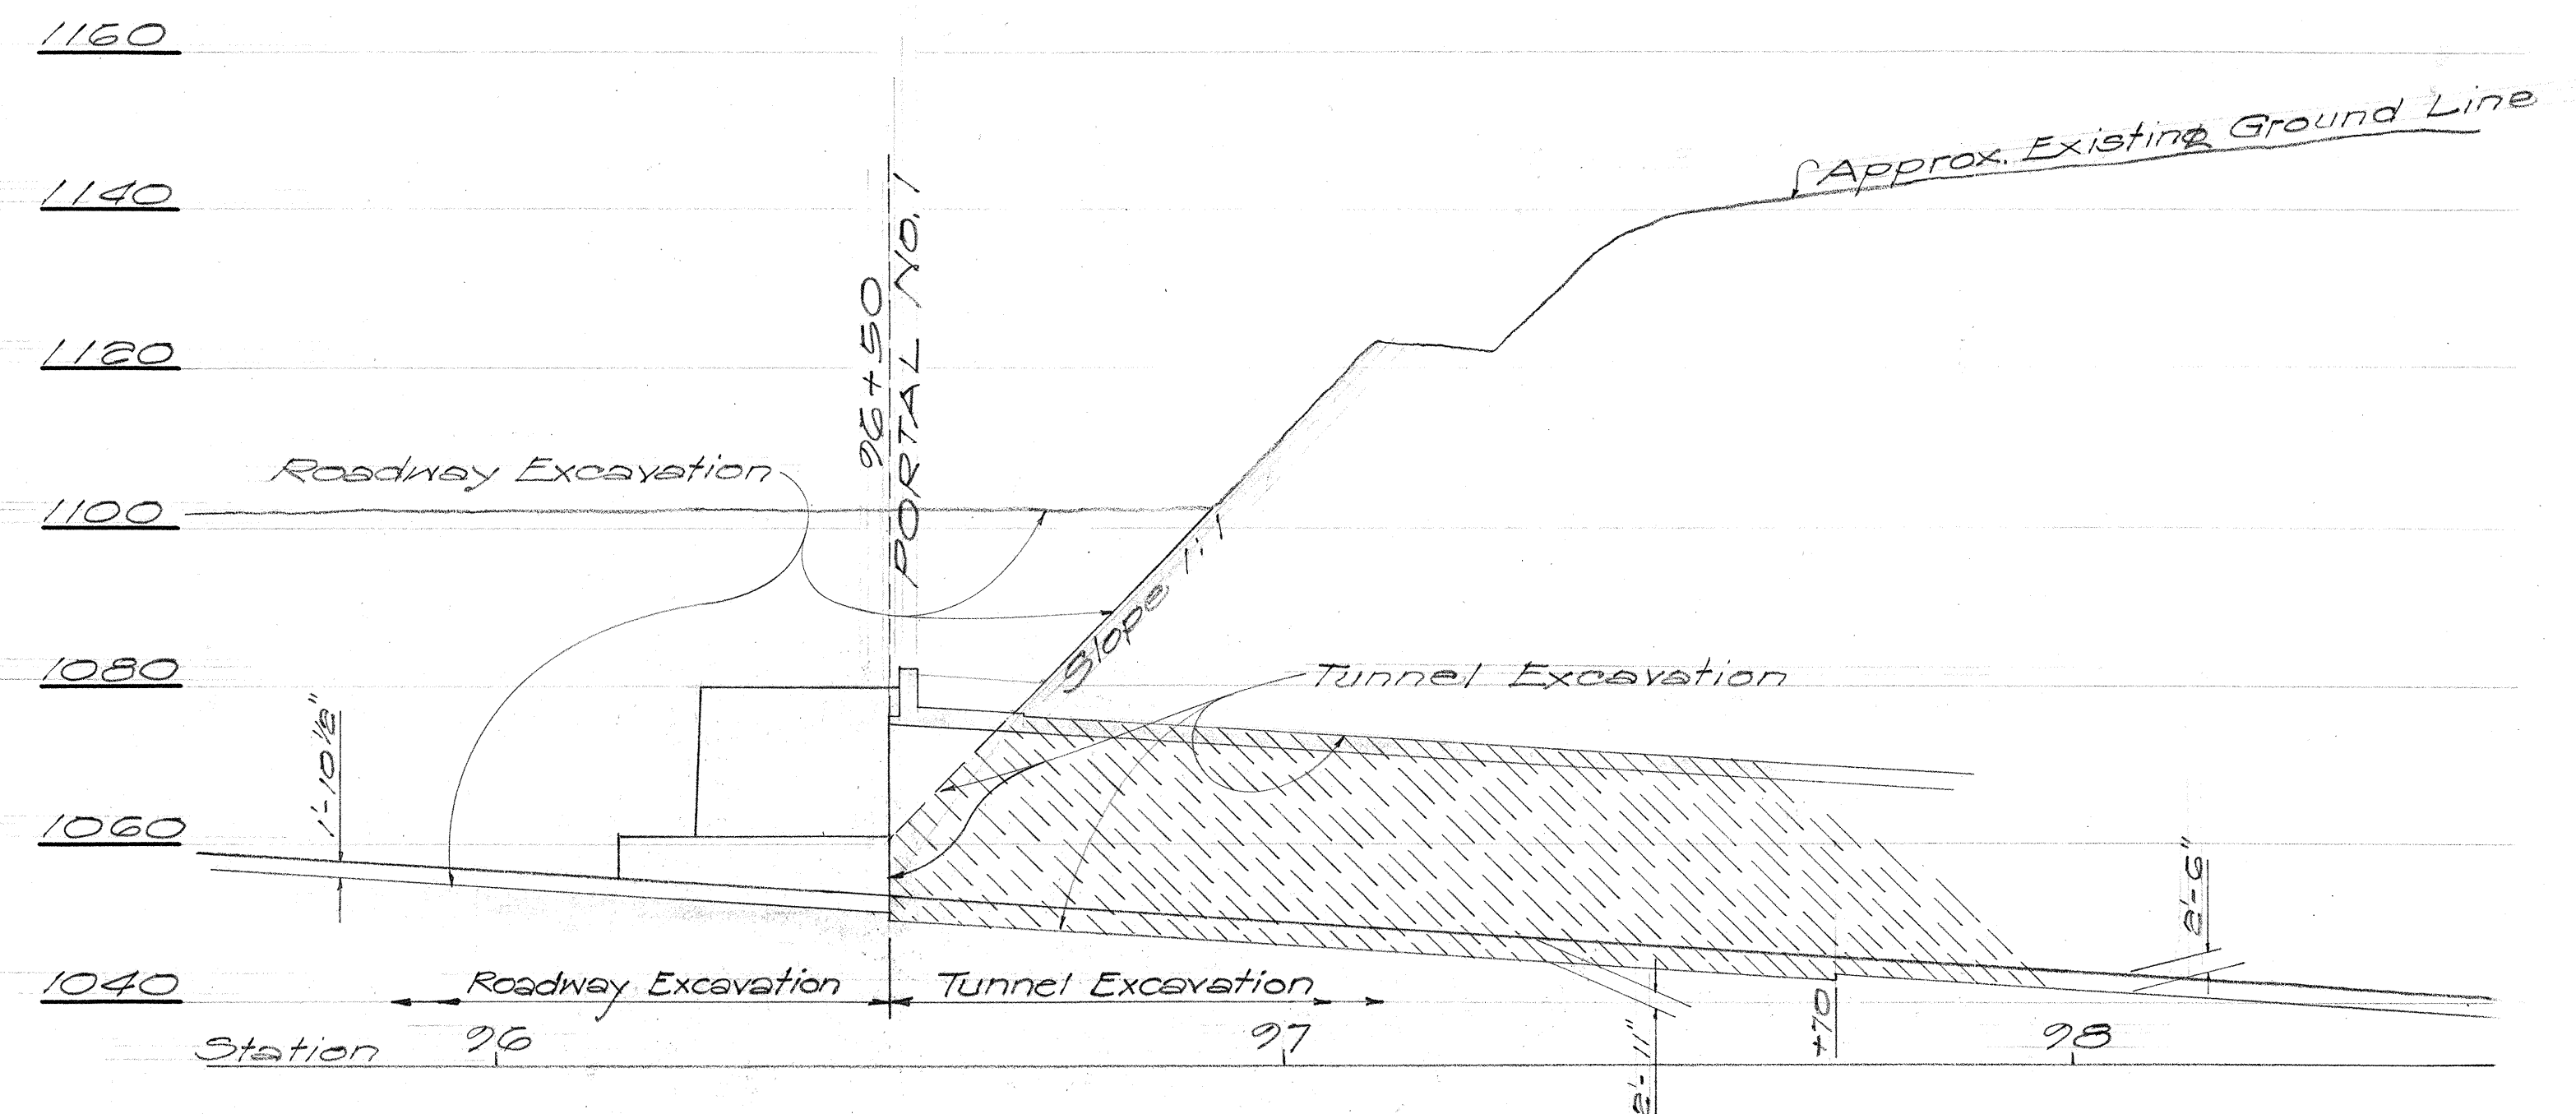

SECTION ALONG & TUNNEL

TERRITORIAL HIGHWAY DEPARTMENT
TERRITORY OF HAWAII

EXCAVATION AT PORTAL 1
NUUANU PALI TUNNELS

PALI ROAD
PROJ. NO. 5216(5)
Scale: 1" = 20'-0" June 1954

SHEET NO. 23 OF 42 SHEETS

5705.23

DATE: 5-54
DESIGNED BY: [Signature]
DRAWN BY: [Signature]
CHECKED BY: [Signature]
NOTE BOOK NO.:

FED. ROAD DIST. No.	STATE	FED. AID PROJ. No.	FISCAL YEAR	SHEET No.	TOTAL SHEETS
Hawaii	Haw.	SA16(5)	1954	24	112

