
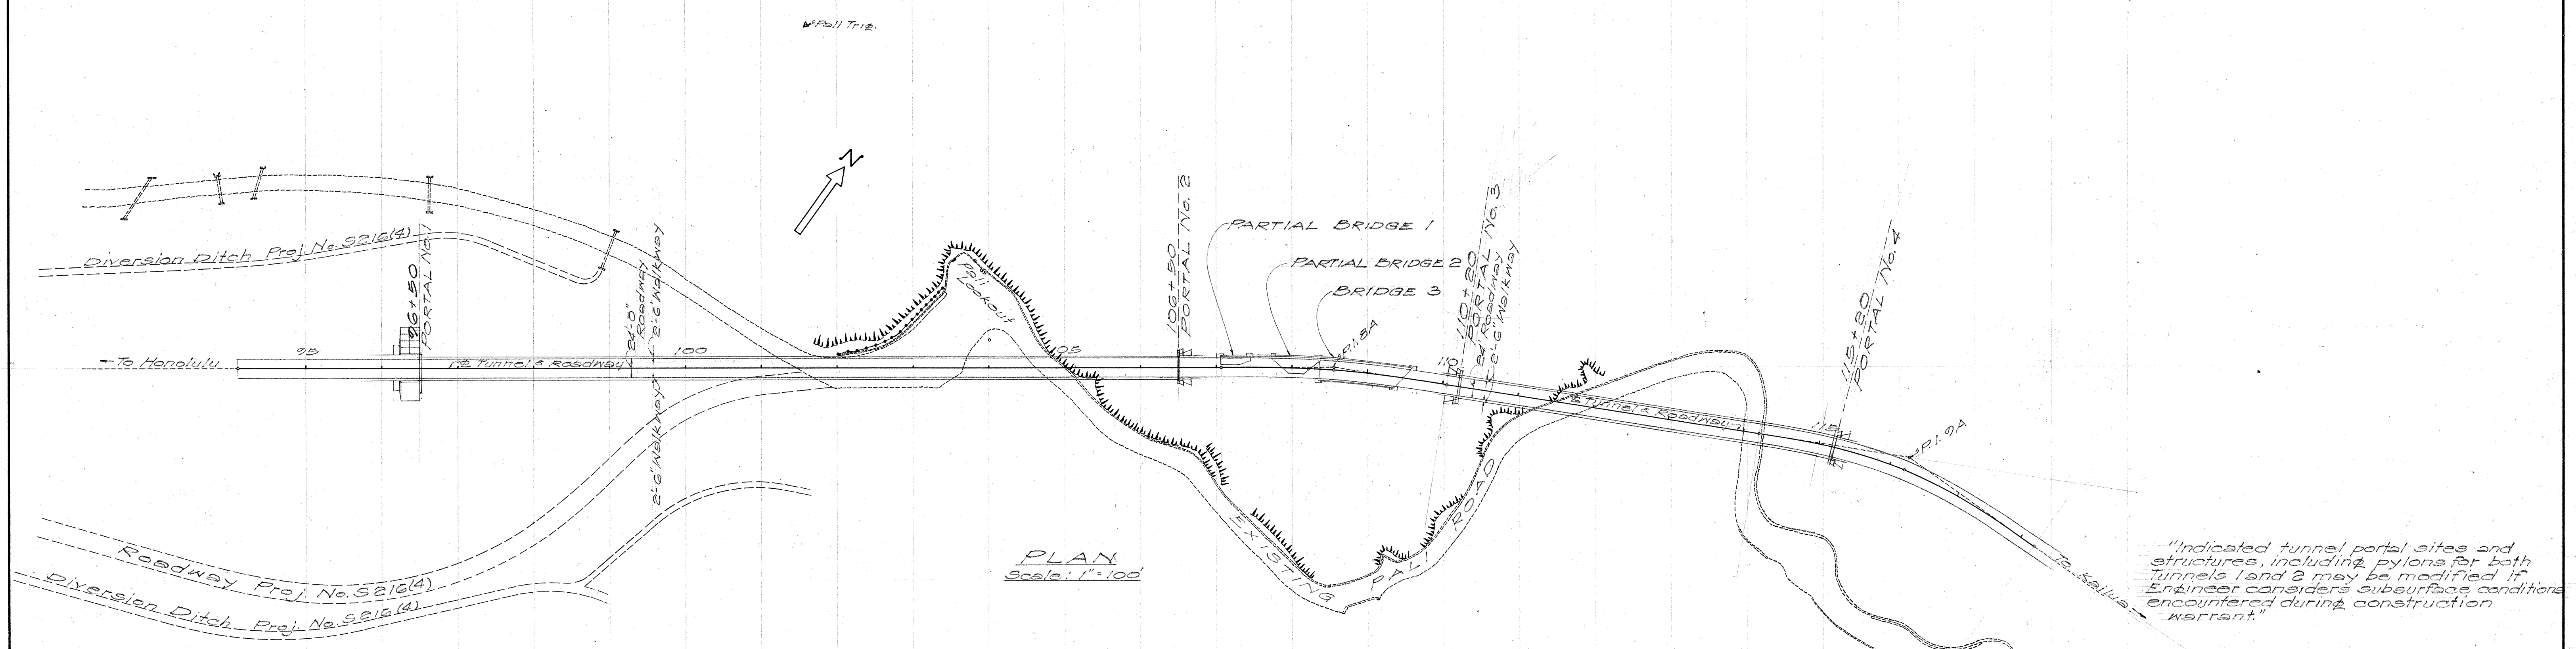


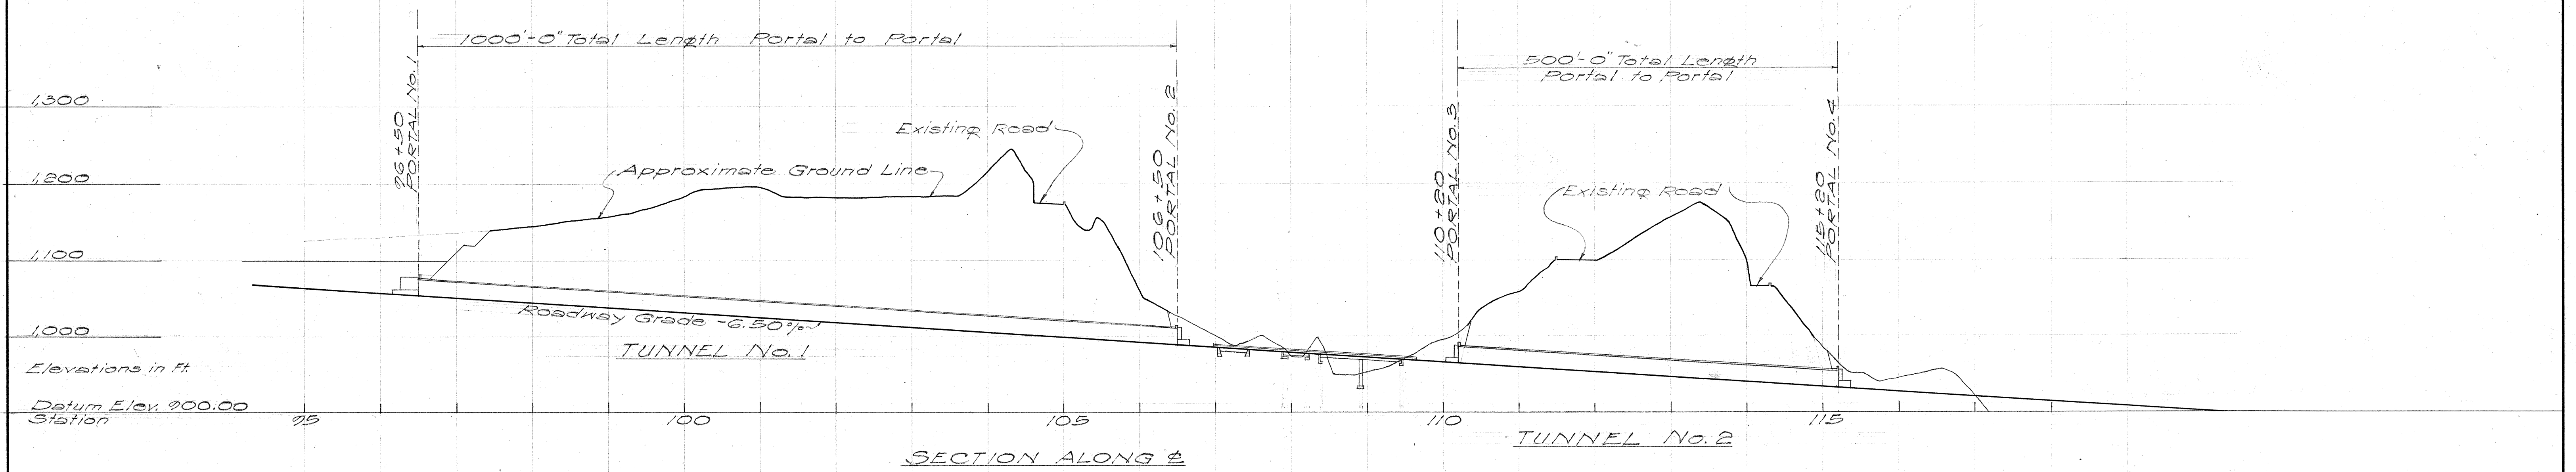

NOTE:
For "General Notes" on this set of plans see "Index of Sheets" sheet 2.
For Details of Lighting see Electrical Plans, sheet 43 to 51.
For Details of Bridges see Bridge Plans, sheet 100 to 112.
For Details of Road see Road Plans, sheet 52 to 99.

"Indicated tunnel portal sites and structures, including pylons for both tunnels 1 and 2 may be modified if Engineer considers subsurface conditions encountered during construction warrant."

TERRITORIAL HIGHWAY DEPARTMENT
TERRITORY OF HAWAII

GENERAL PLANS
NUUANU PALI TUNNELS
Nos. 1 AND 2
PALI ROAD
PROJ. No. 5216(5)
Scale: 1"=100' Apr. 1954

DATE	5/5/54
SURVEY PLOTTED BY	W. J. G. G. G.
DESIGNED BY	W. J. G. G. G.
TRACED BY	W. J. G. G. G.
QUANTITIES CHECKED BY	W. J. G. G. G.
NOTE BOOK	
No.	