



FED. ROAD DIST. NO.	STATE	FED. AID PROJ. NO.	FISCAL YEAR	SHEET NO.	TOTAL SHEETS
HAWAII	HAWAII	S216(5)	1954	108	112

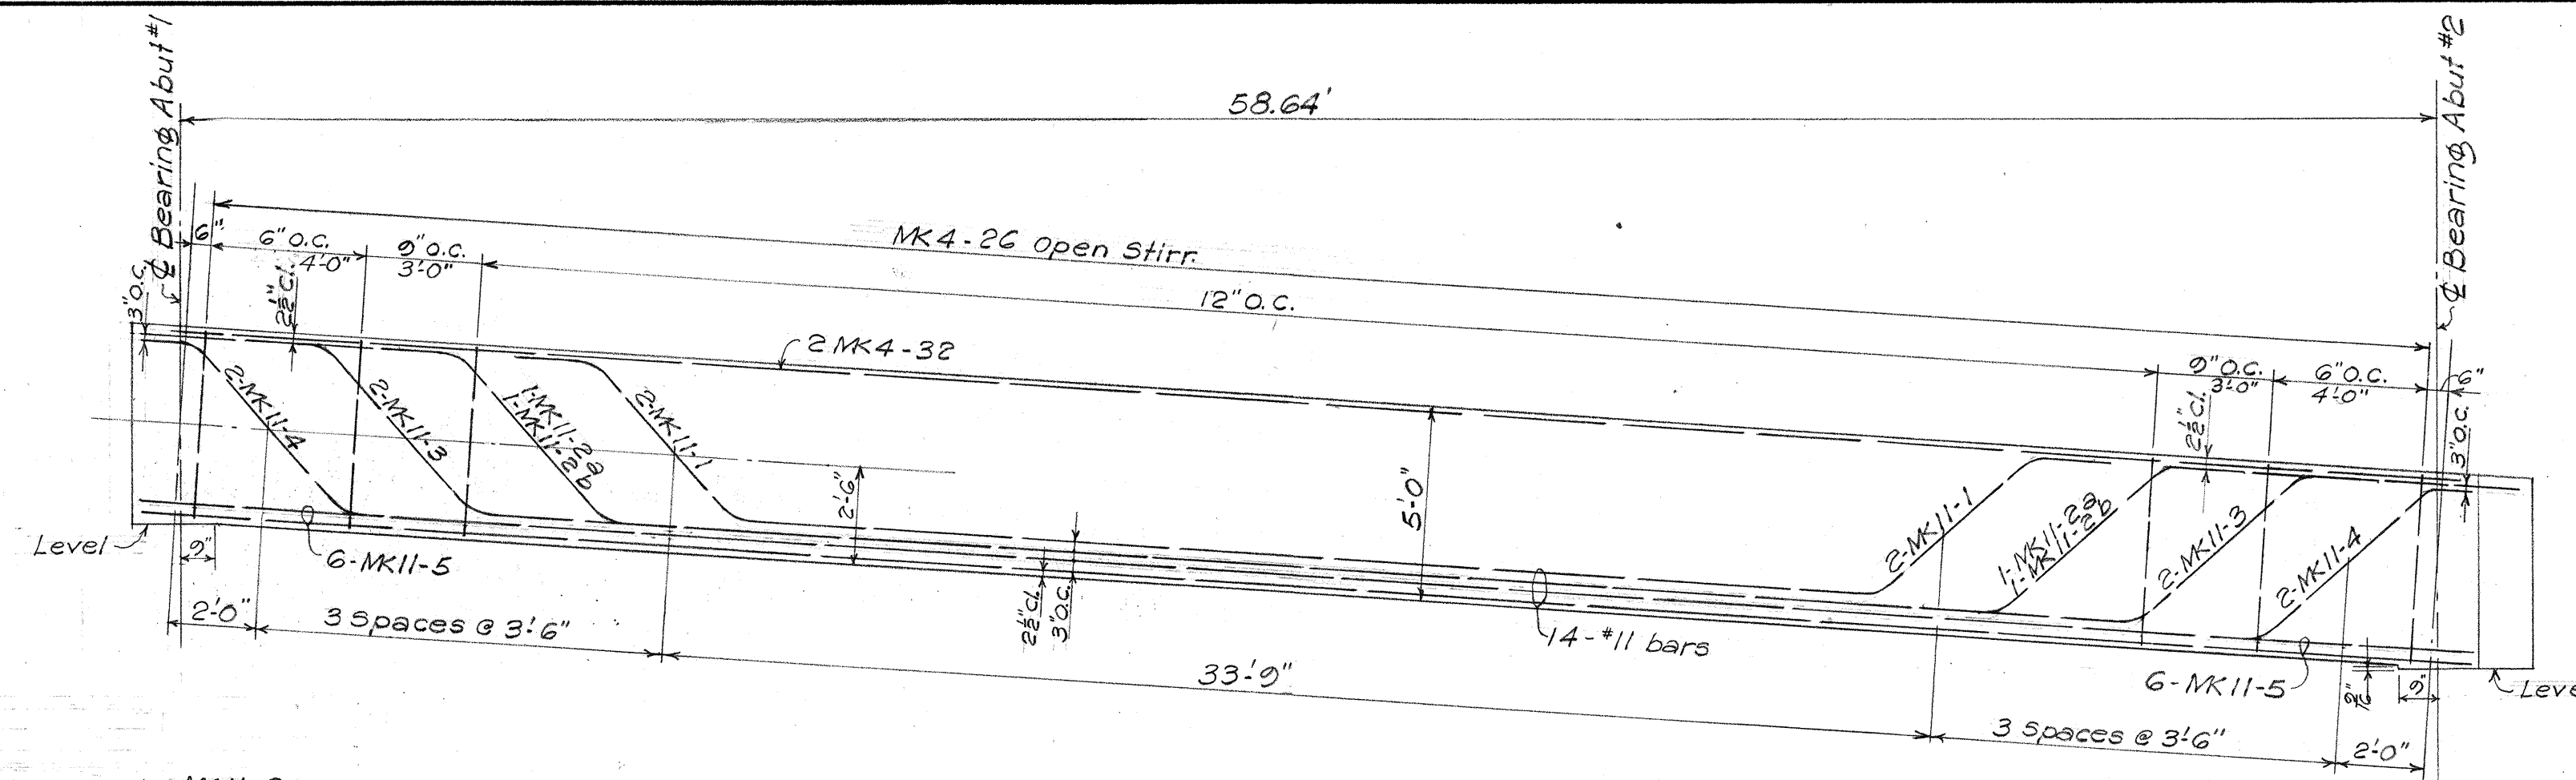


GIRDER G-1
1/4" = 1'-0"

PLAN-TOP LAYER REINF. G-1
3/8" = 1'-0"

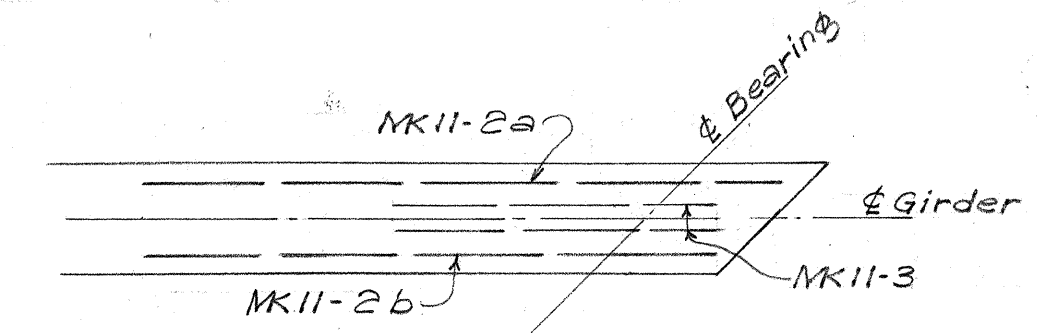


PLAN-TOP LAYER REINF. G-1
3/8" = 1'-0"

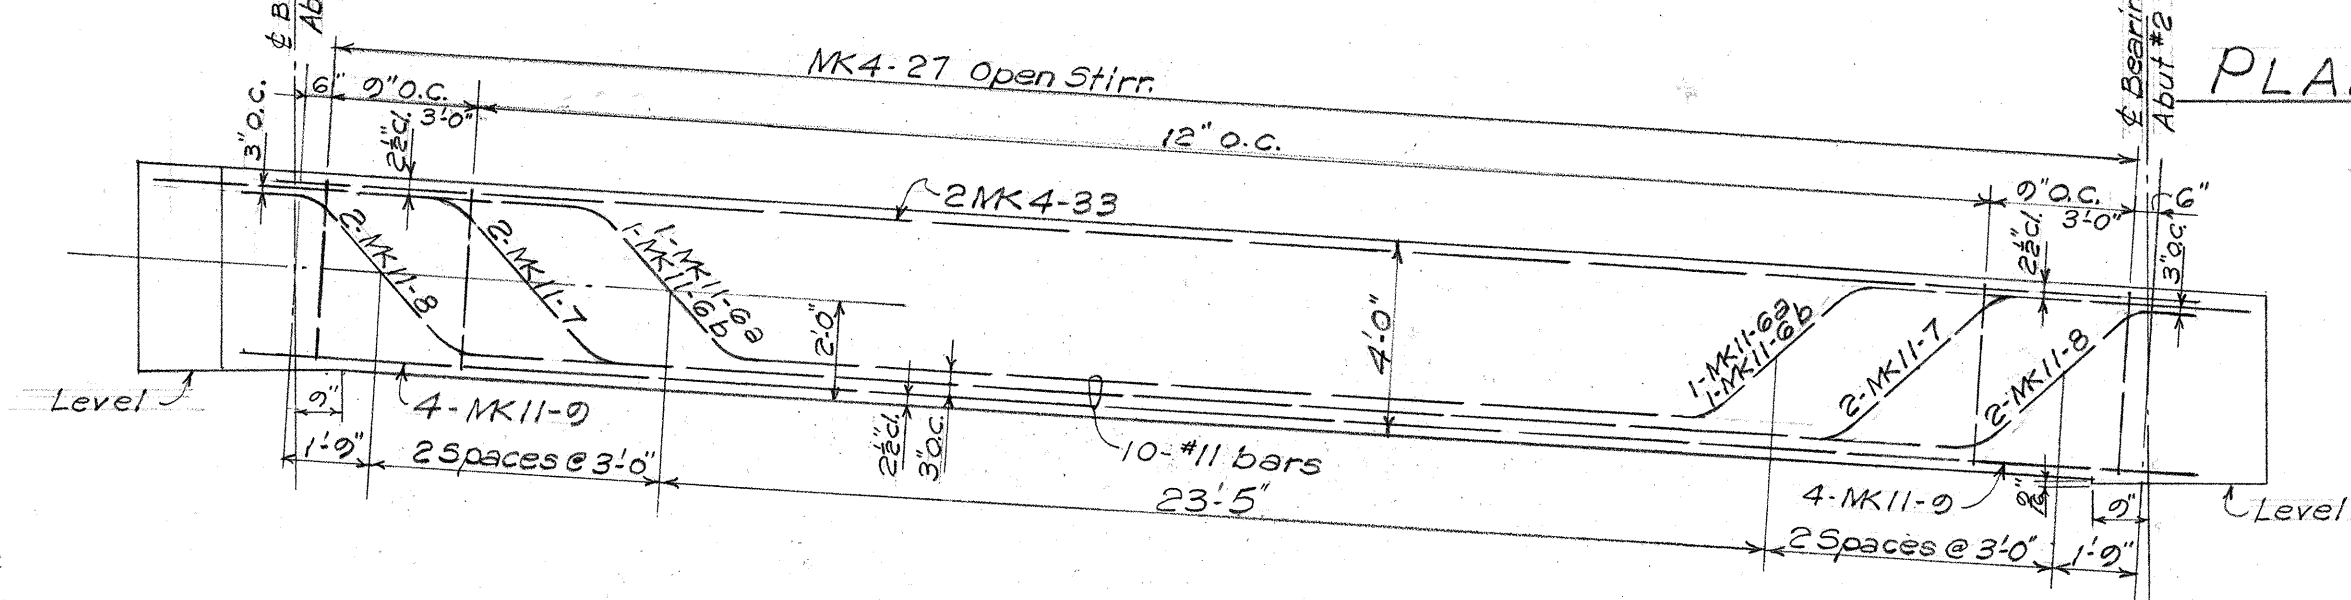


GIRDER G-2
1/4" = 1'-0"


PLAN-TOP LAYER REINF. G-2
3/8" = 1'-0"

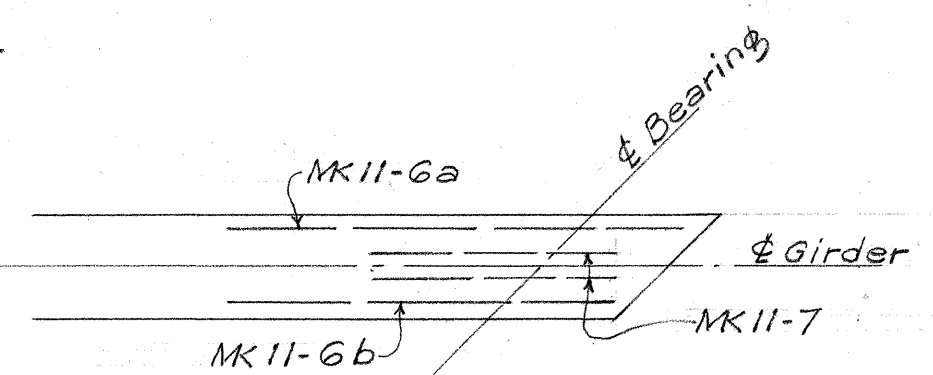

PLAN-TOP LAYER REINF. G-2
3/8" = 1'-0"

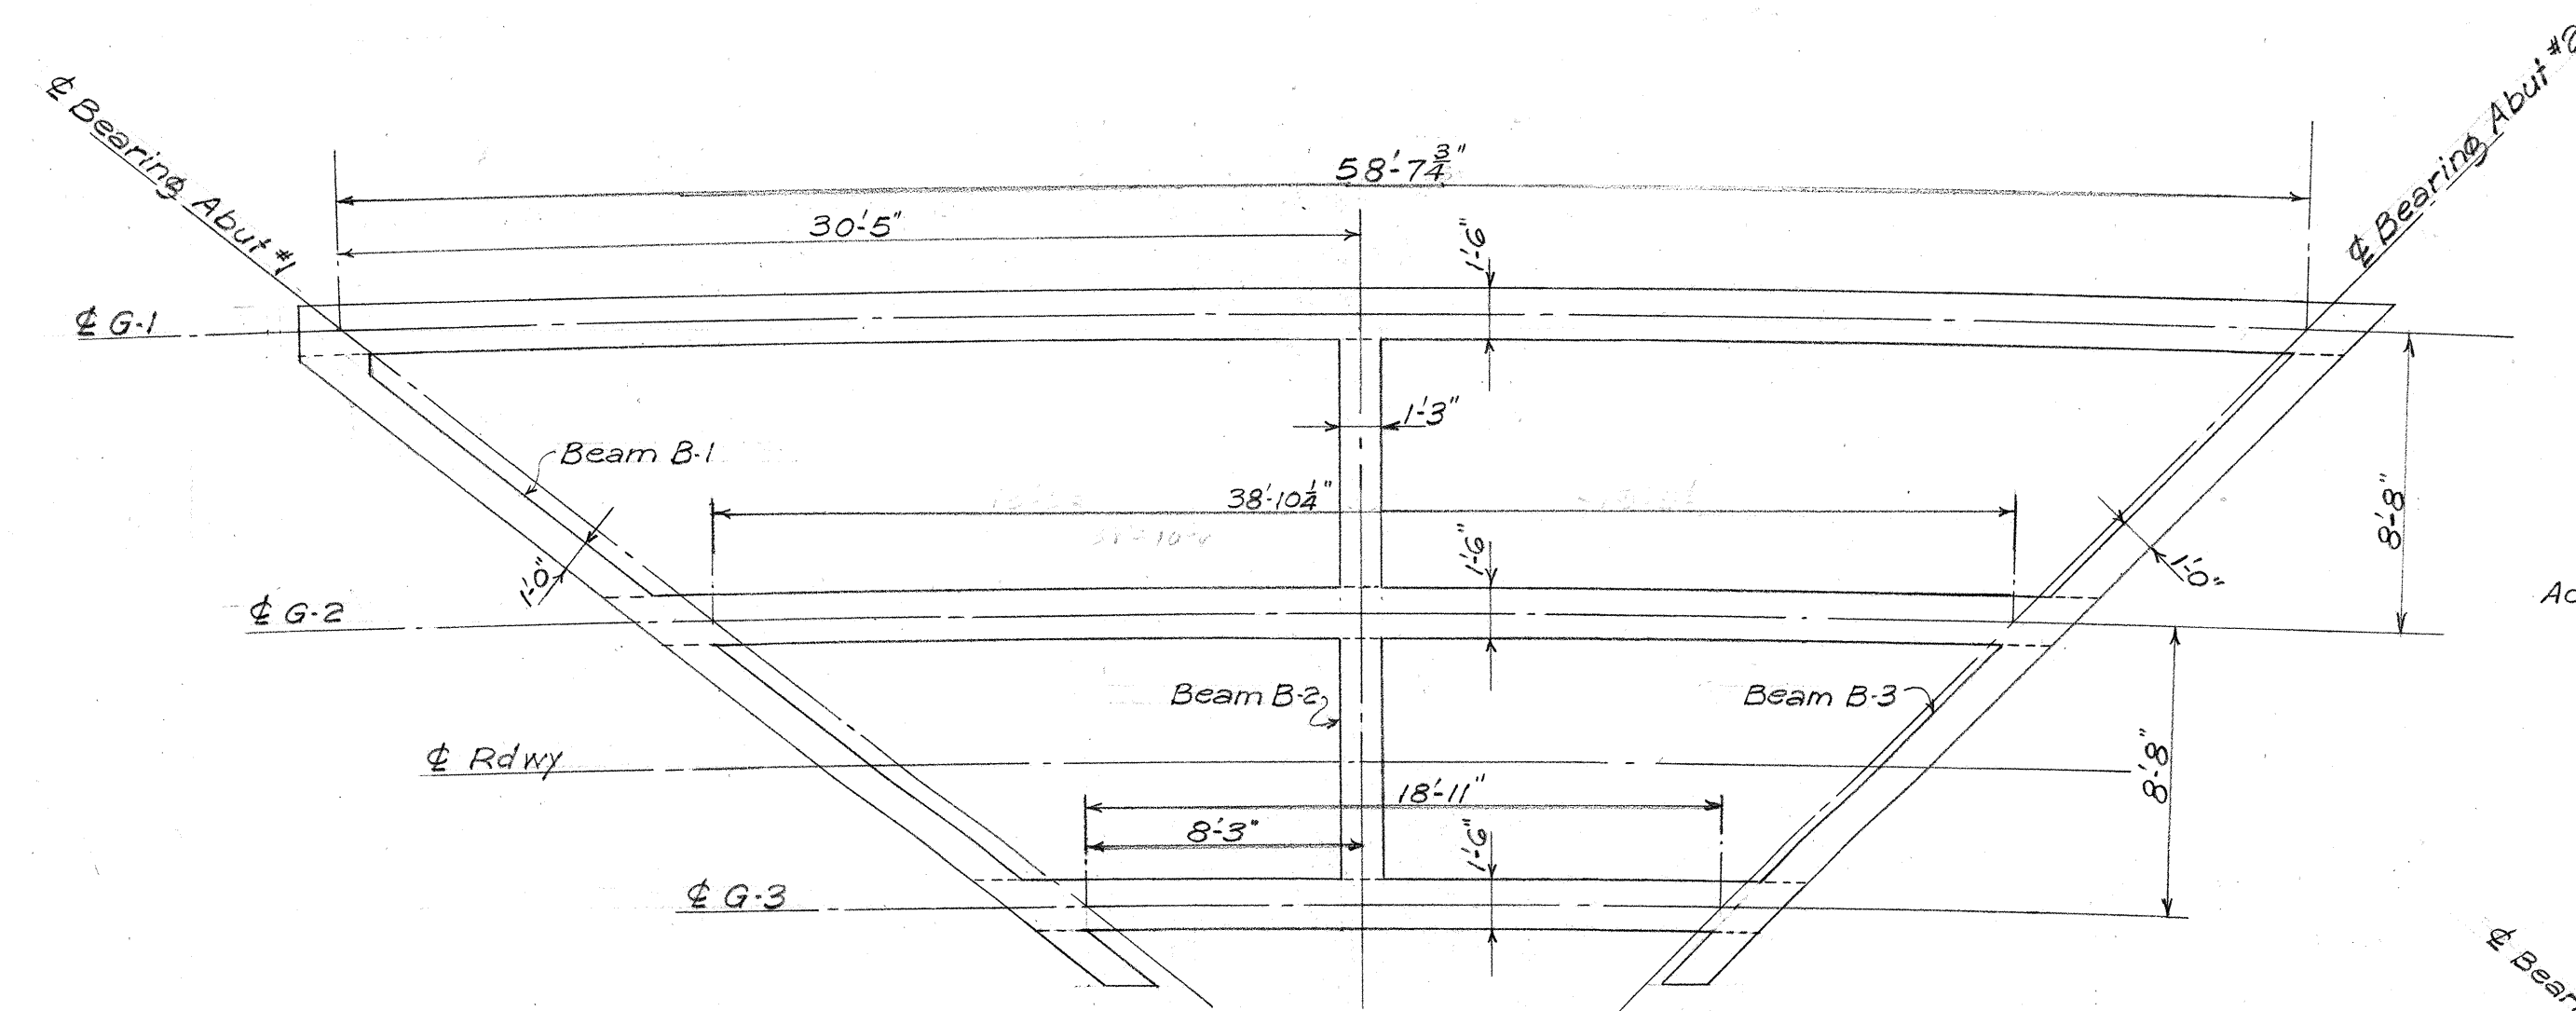





FRAMING PLAN
3/16" = 1'-0"

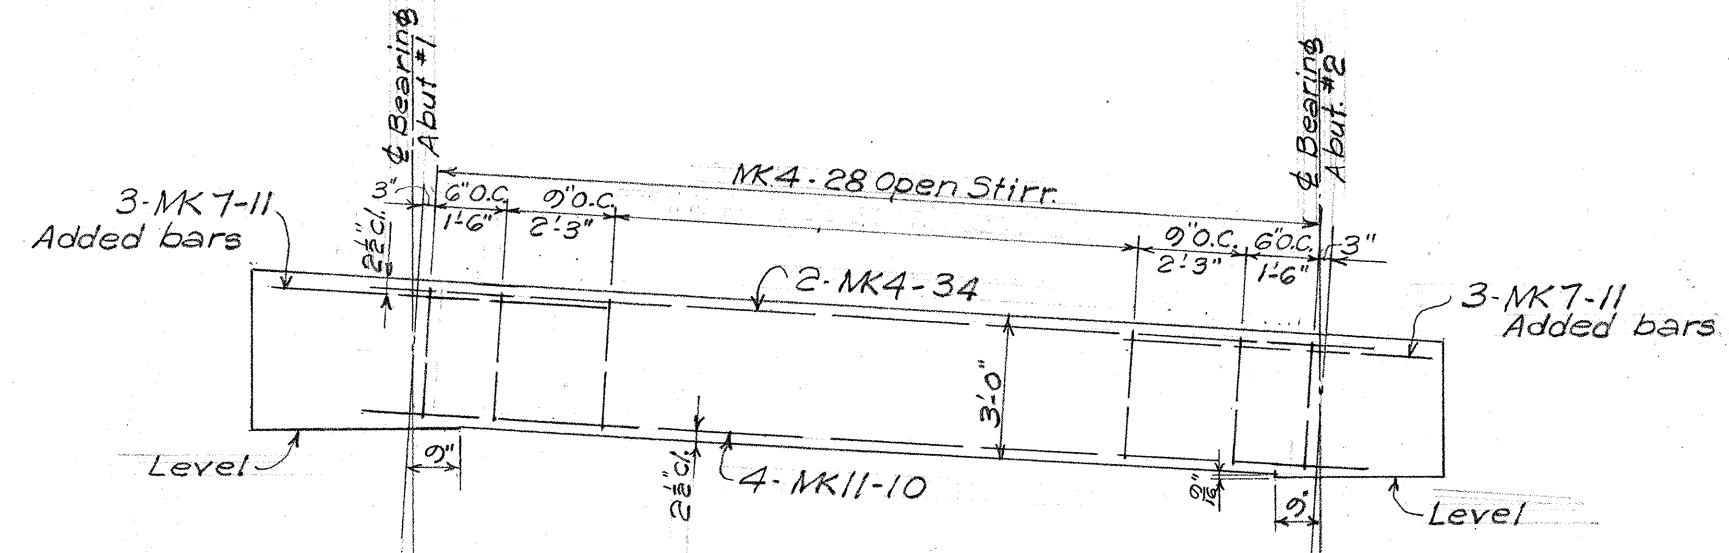


GIRDER G-3
1/4" = 1'-0"

PLAN-TOP LAYER REINF. G-3
3/8" = 1'-0"


PLAN-TOP LAYER REINF. G-3
3/8" = 1'-0"

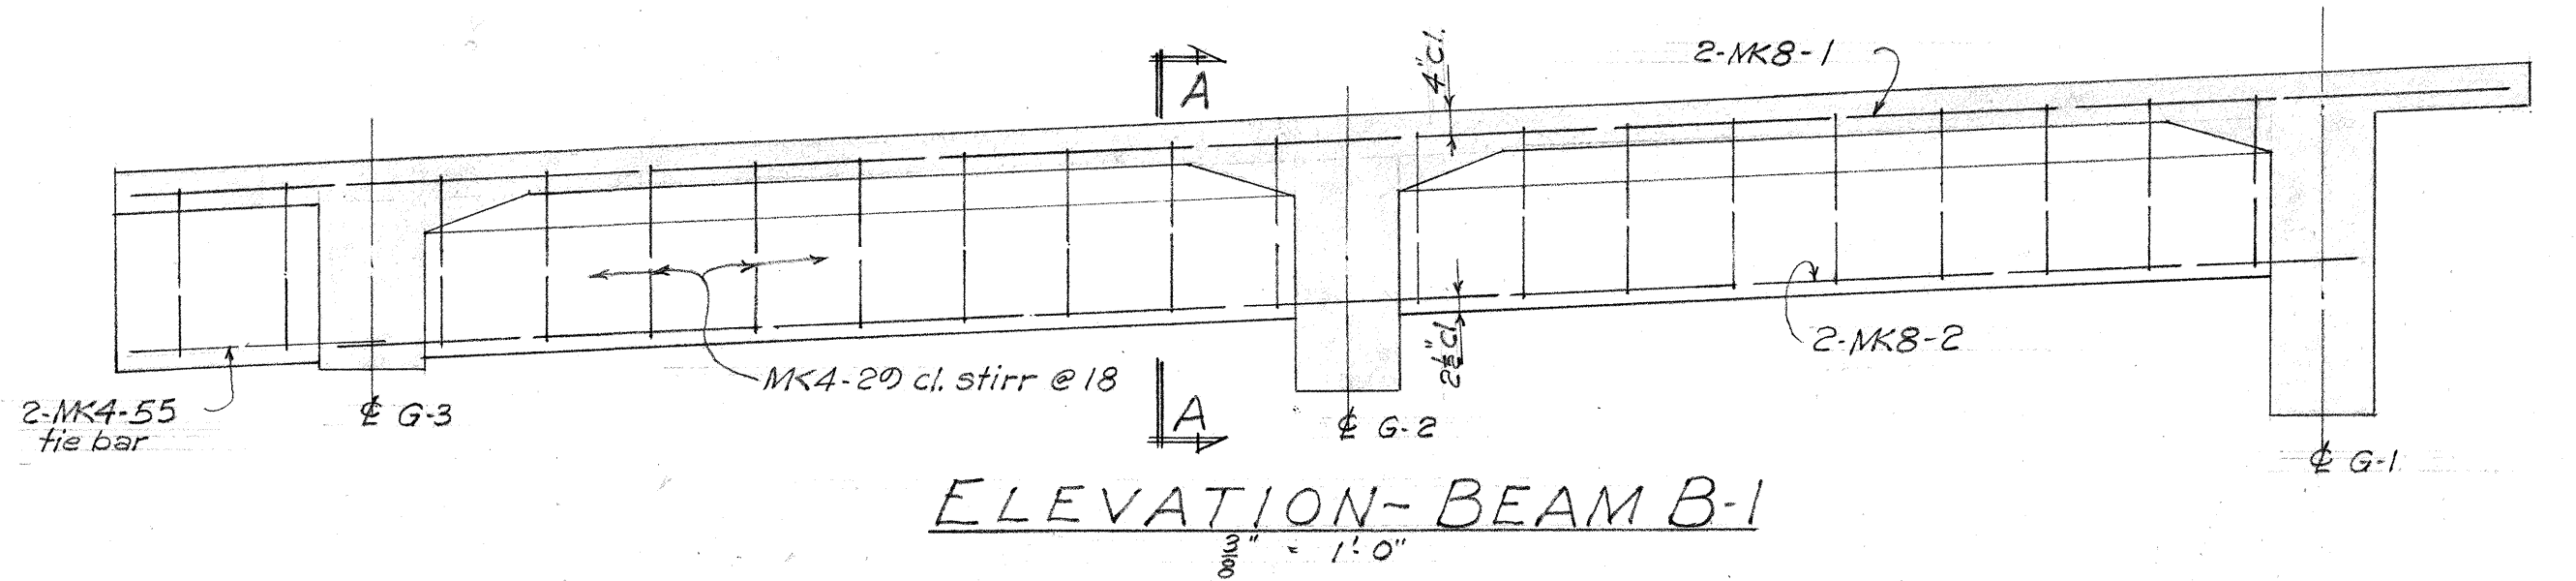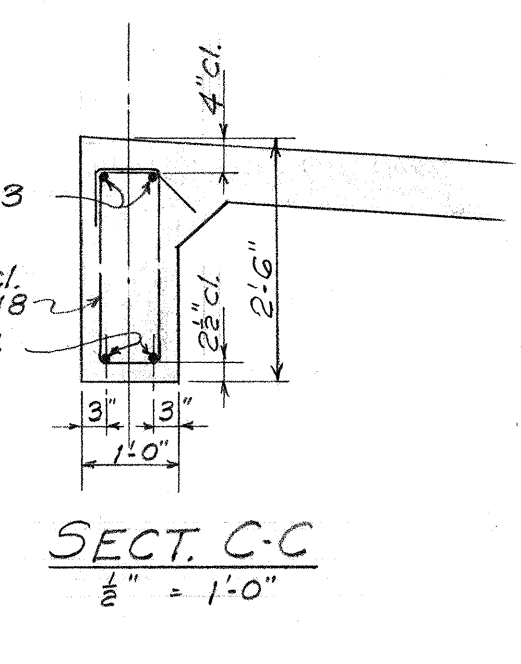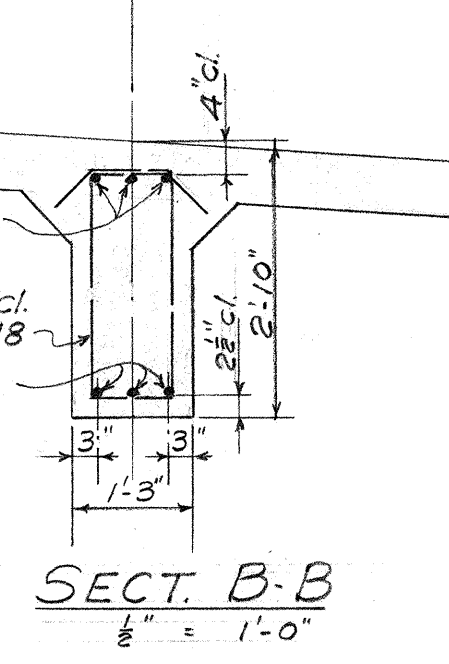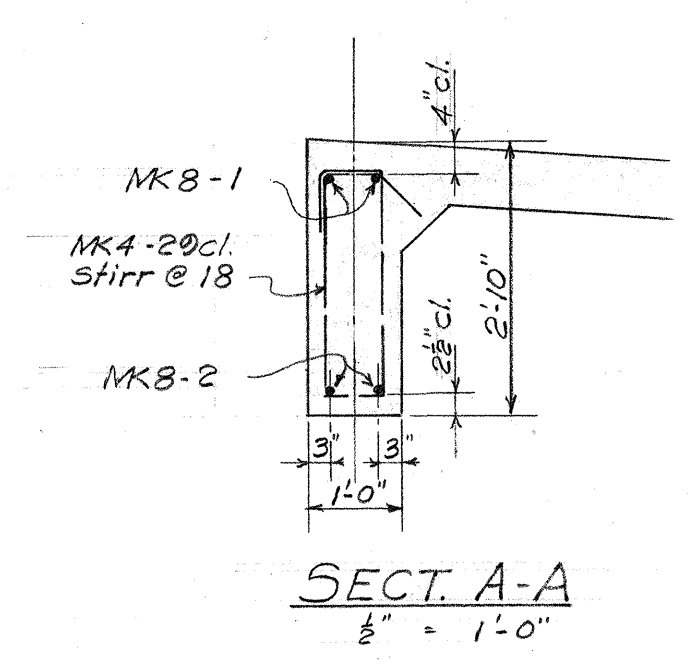

ELEVATION-BEAM B-1
3/8" = 1'-0"

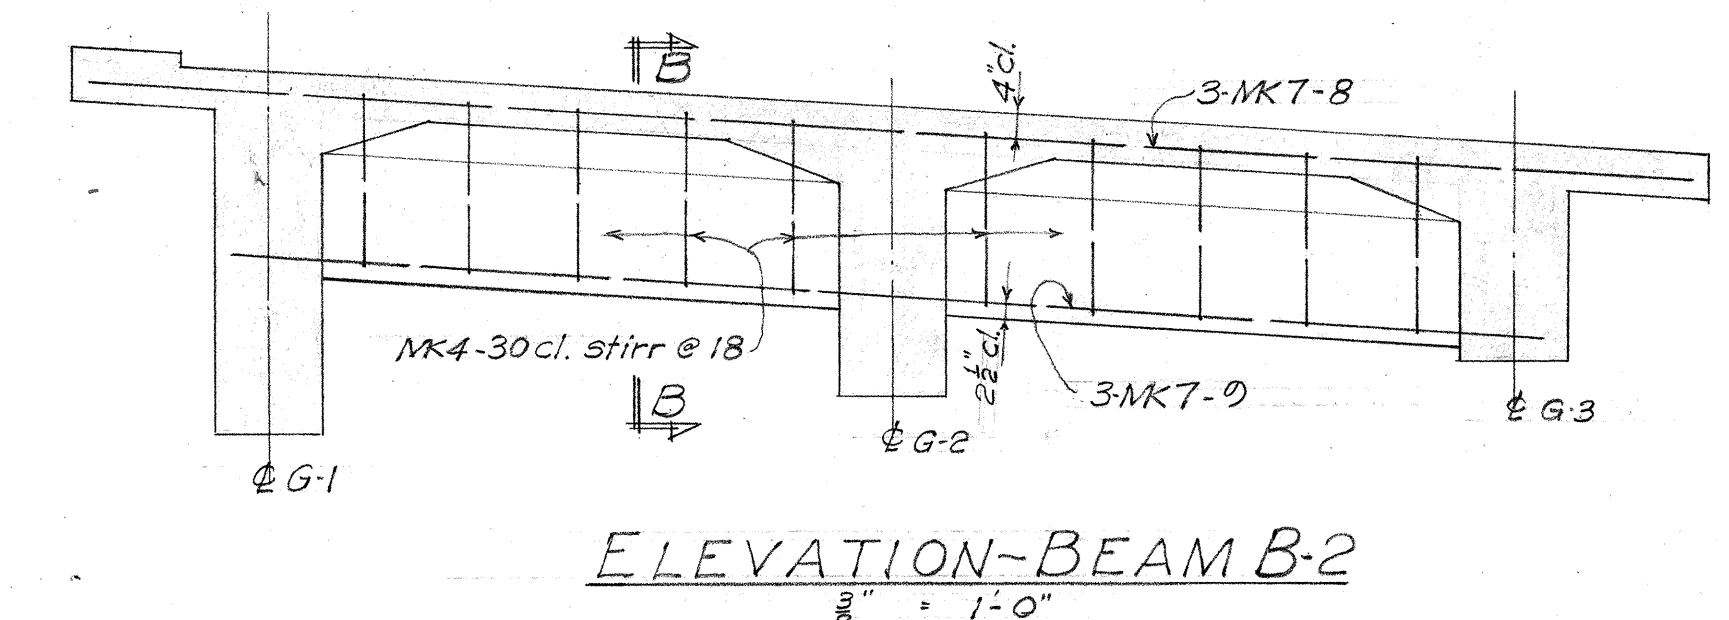

ELEVATION-BEAM B-2
3/8" = 1'-0"

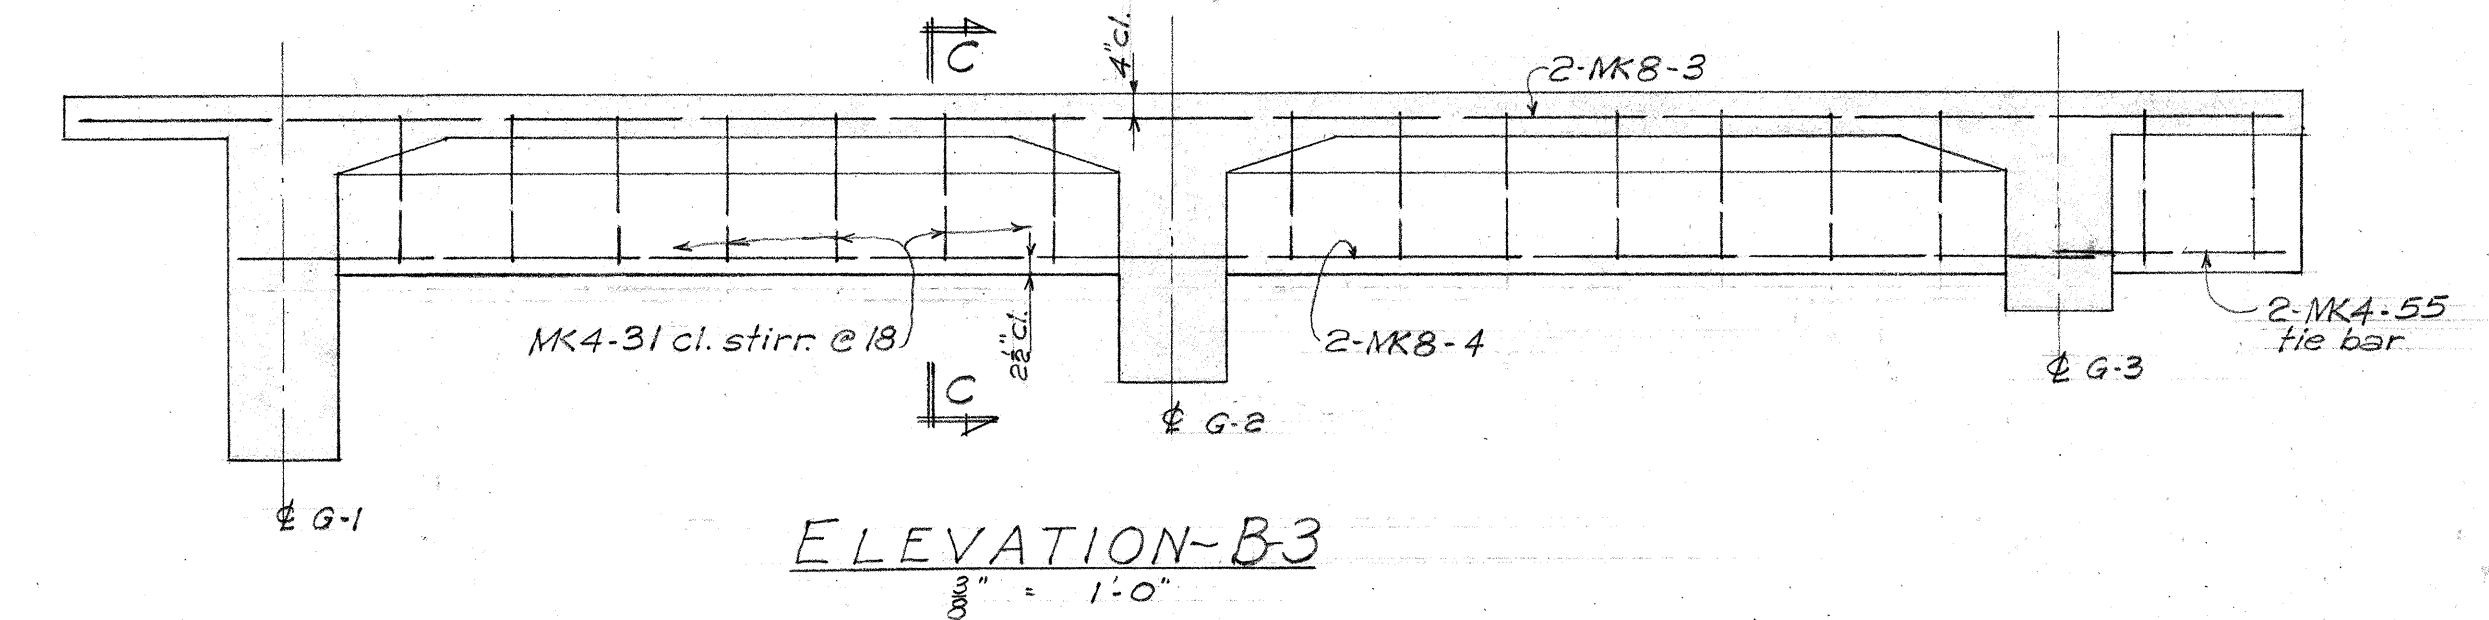

ELEVATION-B-3
3/8" = 1'-0"

TERRITORIAL HIGHWAY DEPARTMENT
TERRITORY OF HAWAII
PARTIAL BRIDGE #2
Sta. 107+72.55 to Sta. 108+35.00
Pali Road (Tunnel Section) Proj. S216(5)
June 1954
SHEET No. 8 OF 12 SHEETS

5708.108