


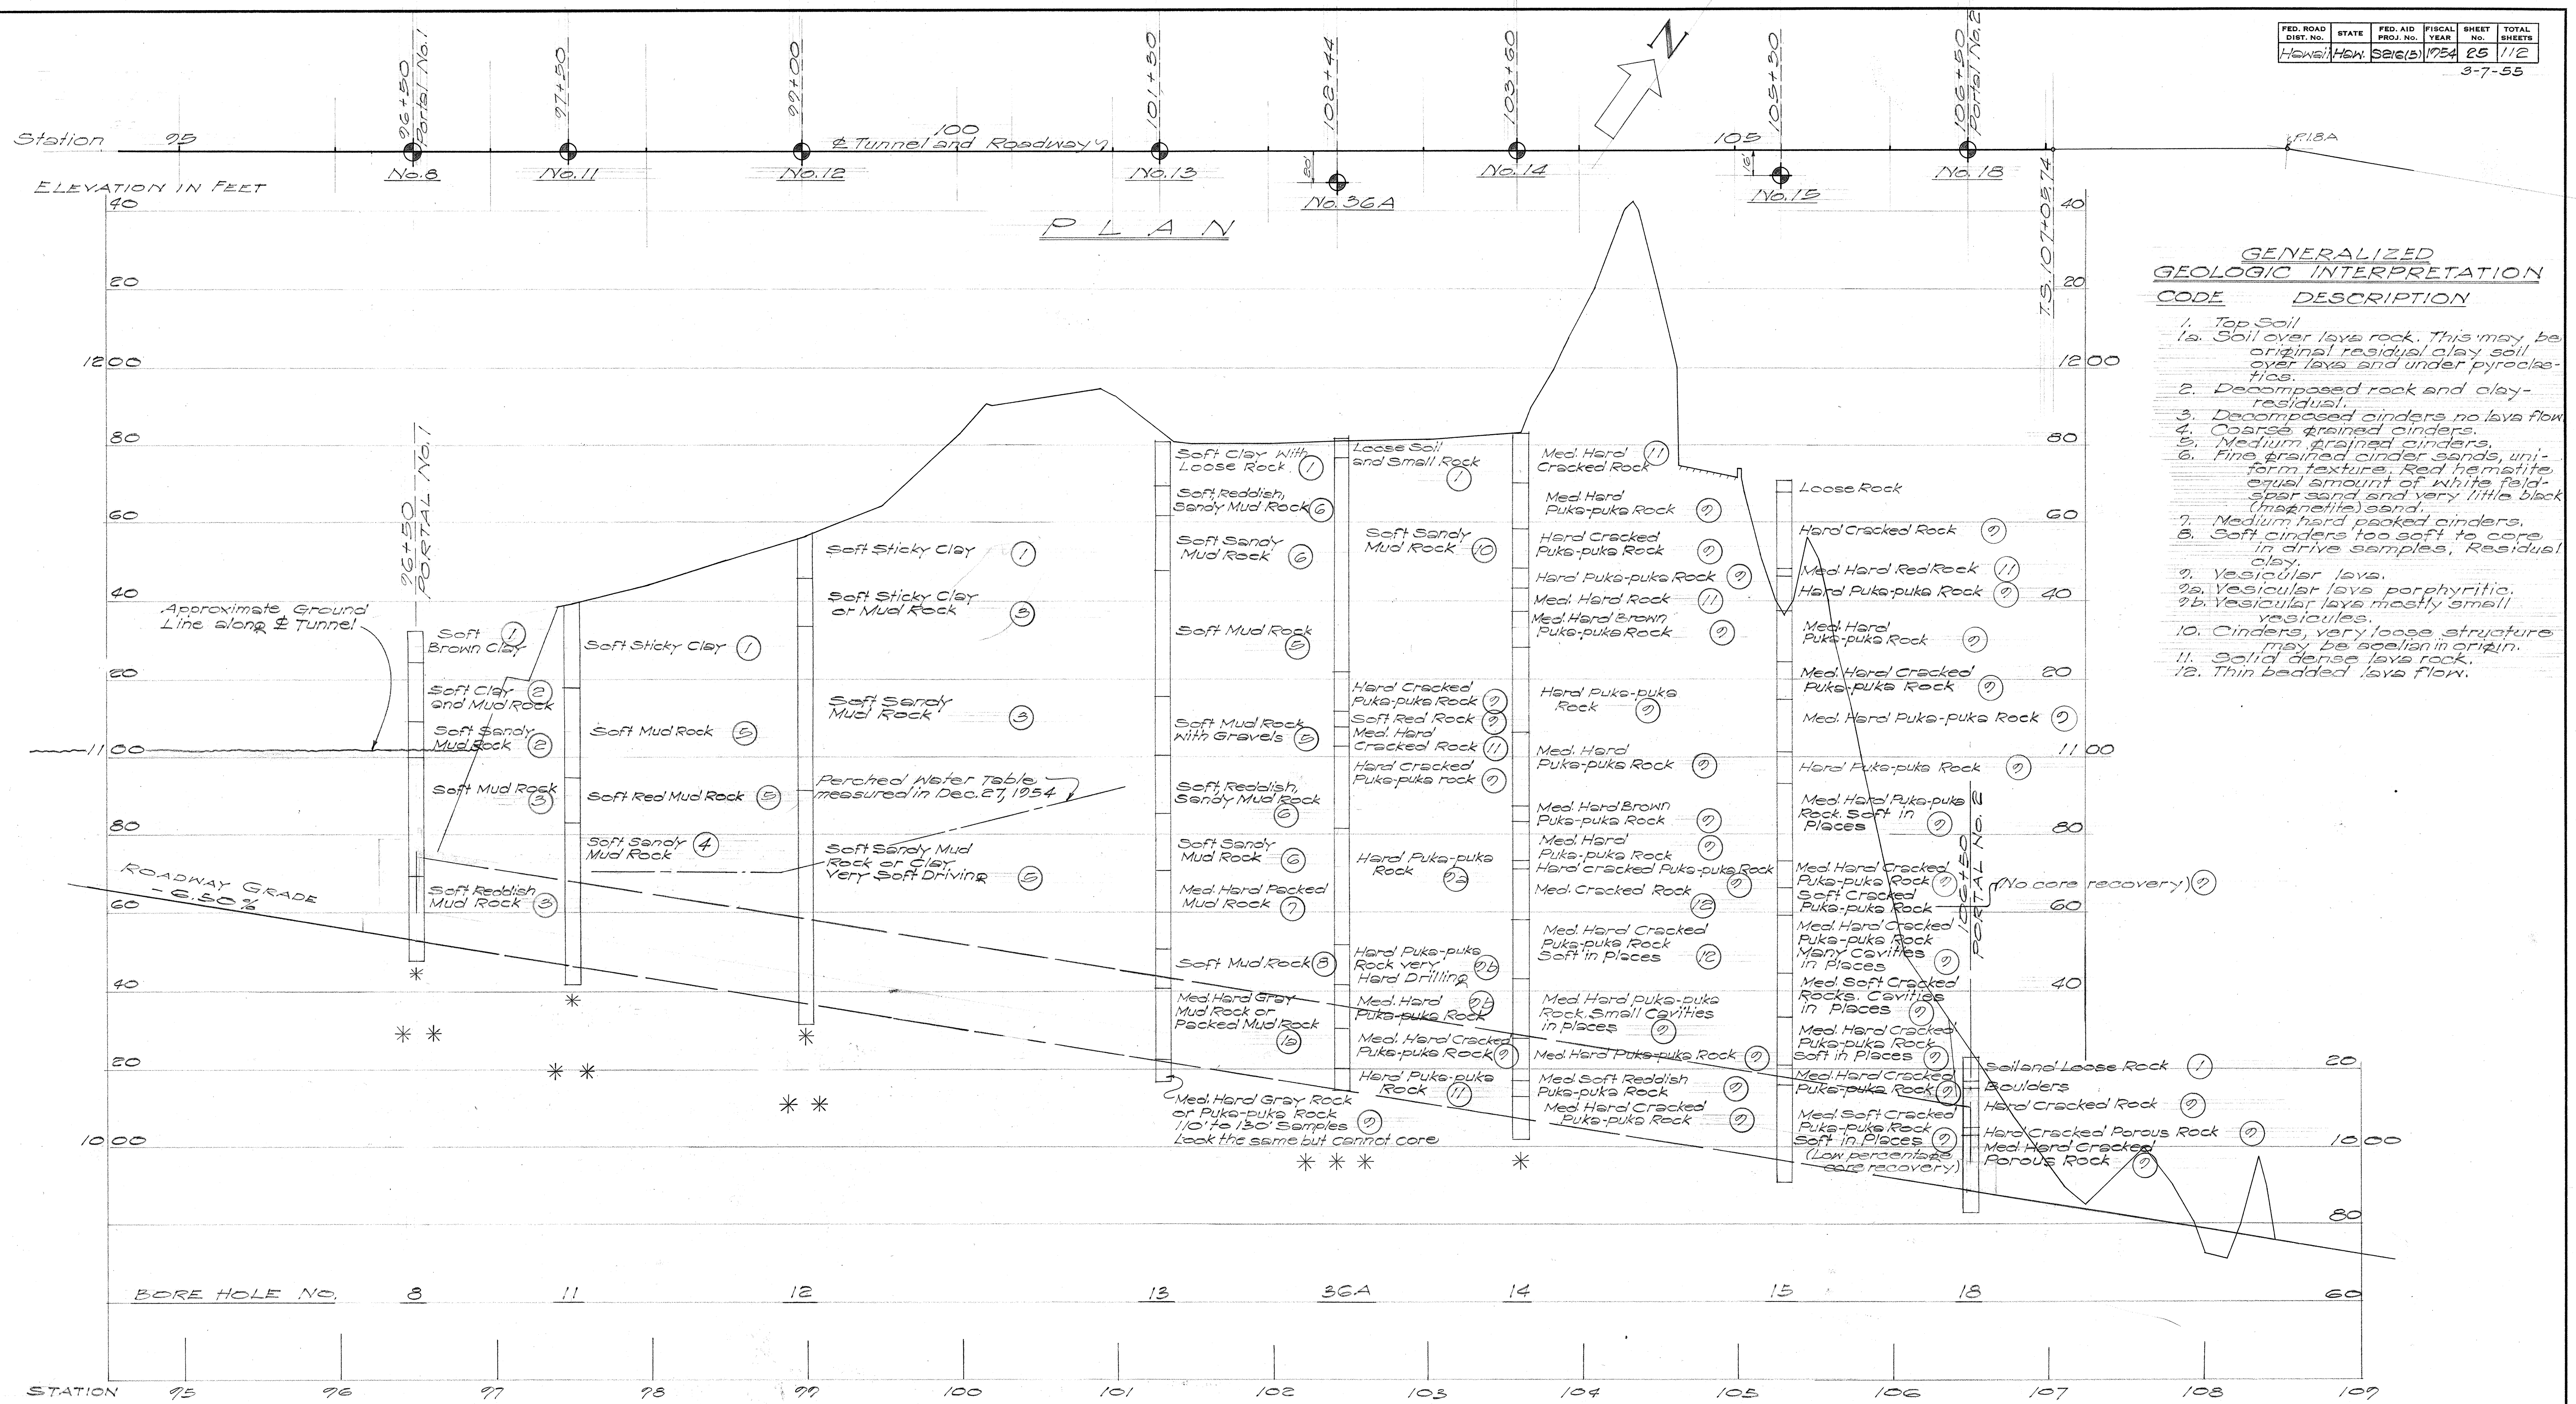

NOTES
Log of Test Borings shown
was obtained in 1953 except
as noted.
The Contractor's attention is directed
to Article 2.2 of the General
Specifications and to the Special
Provisions accompanying this set
of plans.
Classification of earth material as
shown on this sheet is based upon
field inspection and is not construed
to imply mechanical analysis.

GROUND WATER IN TEST BORINGS
 No water standing in hole except for
 drilling water, indicated thus *.
 Water returning and no cave-in entire
 depth, indicated thus **.
 No established water table - free draining,
 water in transit, indicated thus ***.

NOTE:
Test Borings are shown on
the plan thus 
No. 11
Geologic Description Code Numbers,
shown thus (12)

TERRITORIAL HIGHWAY DEPARTMENT
TERRITORY OF HAWAII
LOG OF TEST BORINGS
TUNNEL No. 1
NUUAN PALI TUNNELS
PALI ROAD
PROJ. No. 5216 (5)
Scale: 1" = 50'-0" June 1954