


REVISED : 8-24-55

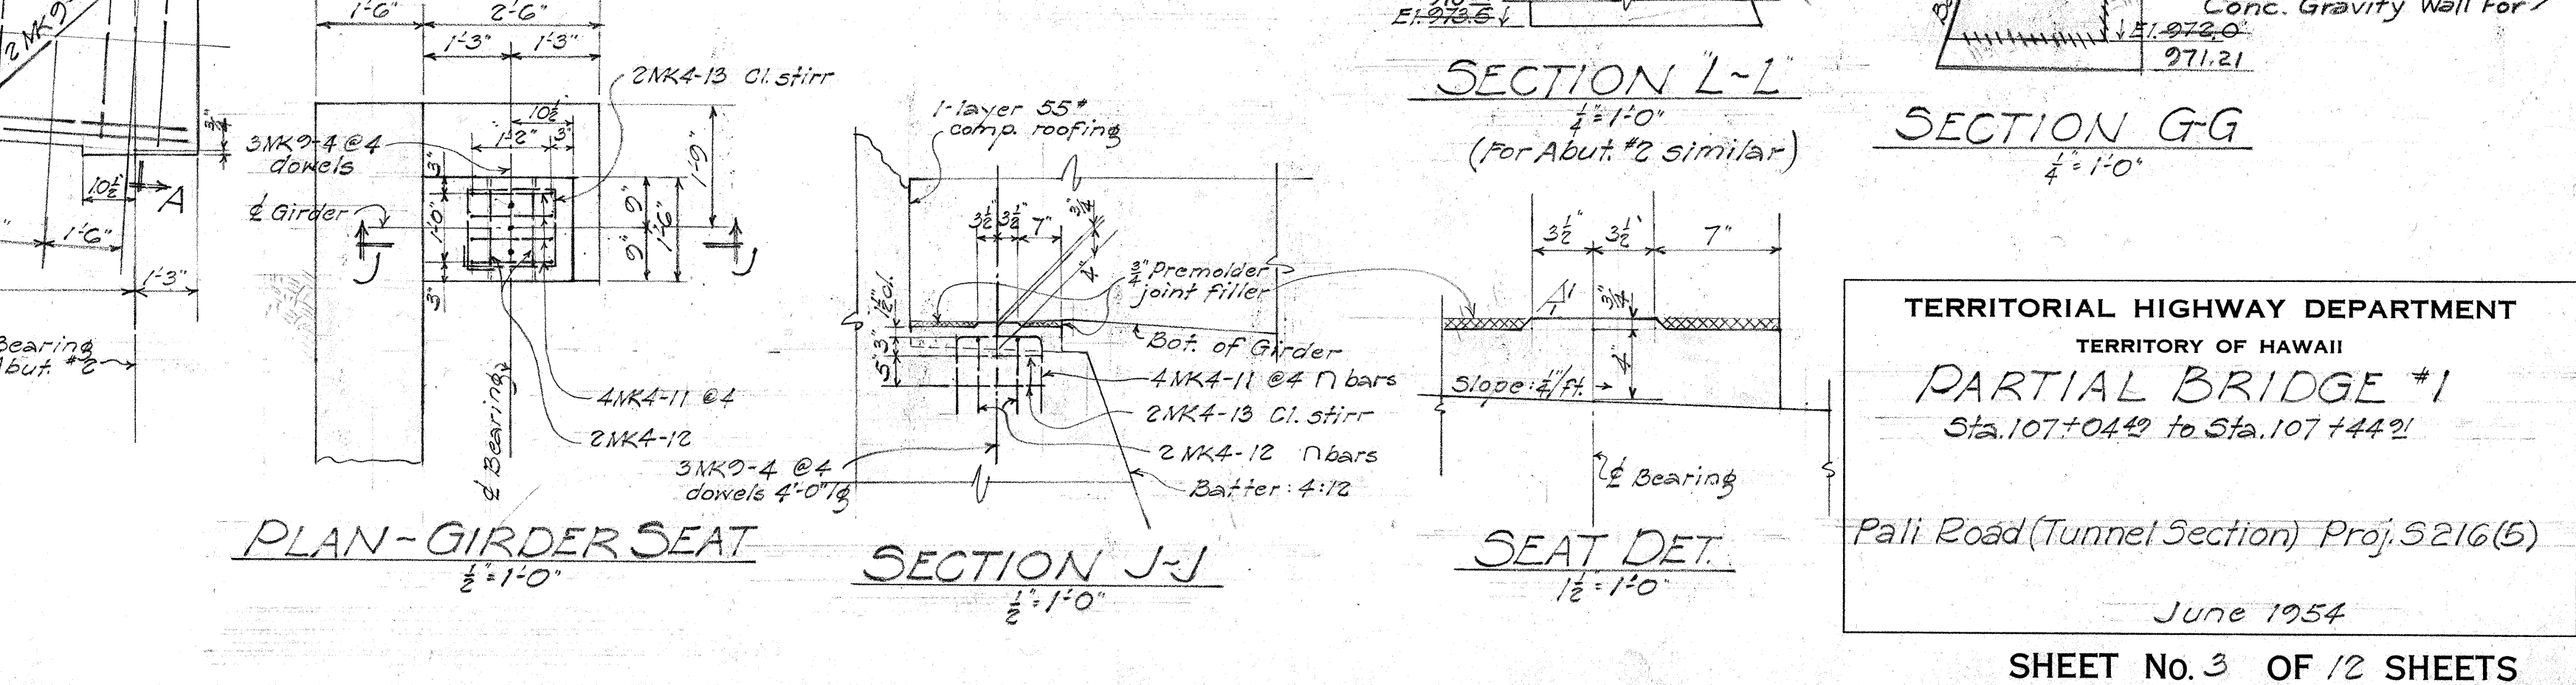

SHEET No. 3 OF 12 SHEETS

570 S. 10