


Note: For details of C.B. "G₁", C.B. "G₂", and drain pipes, see "Drainage Structures" sheet 40.
For details of C.B. "C", conc. Headwall, and drain pipes, see Road Plans.

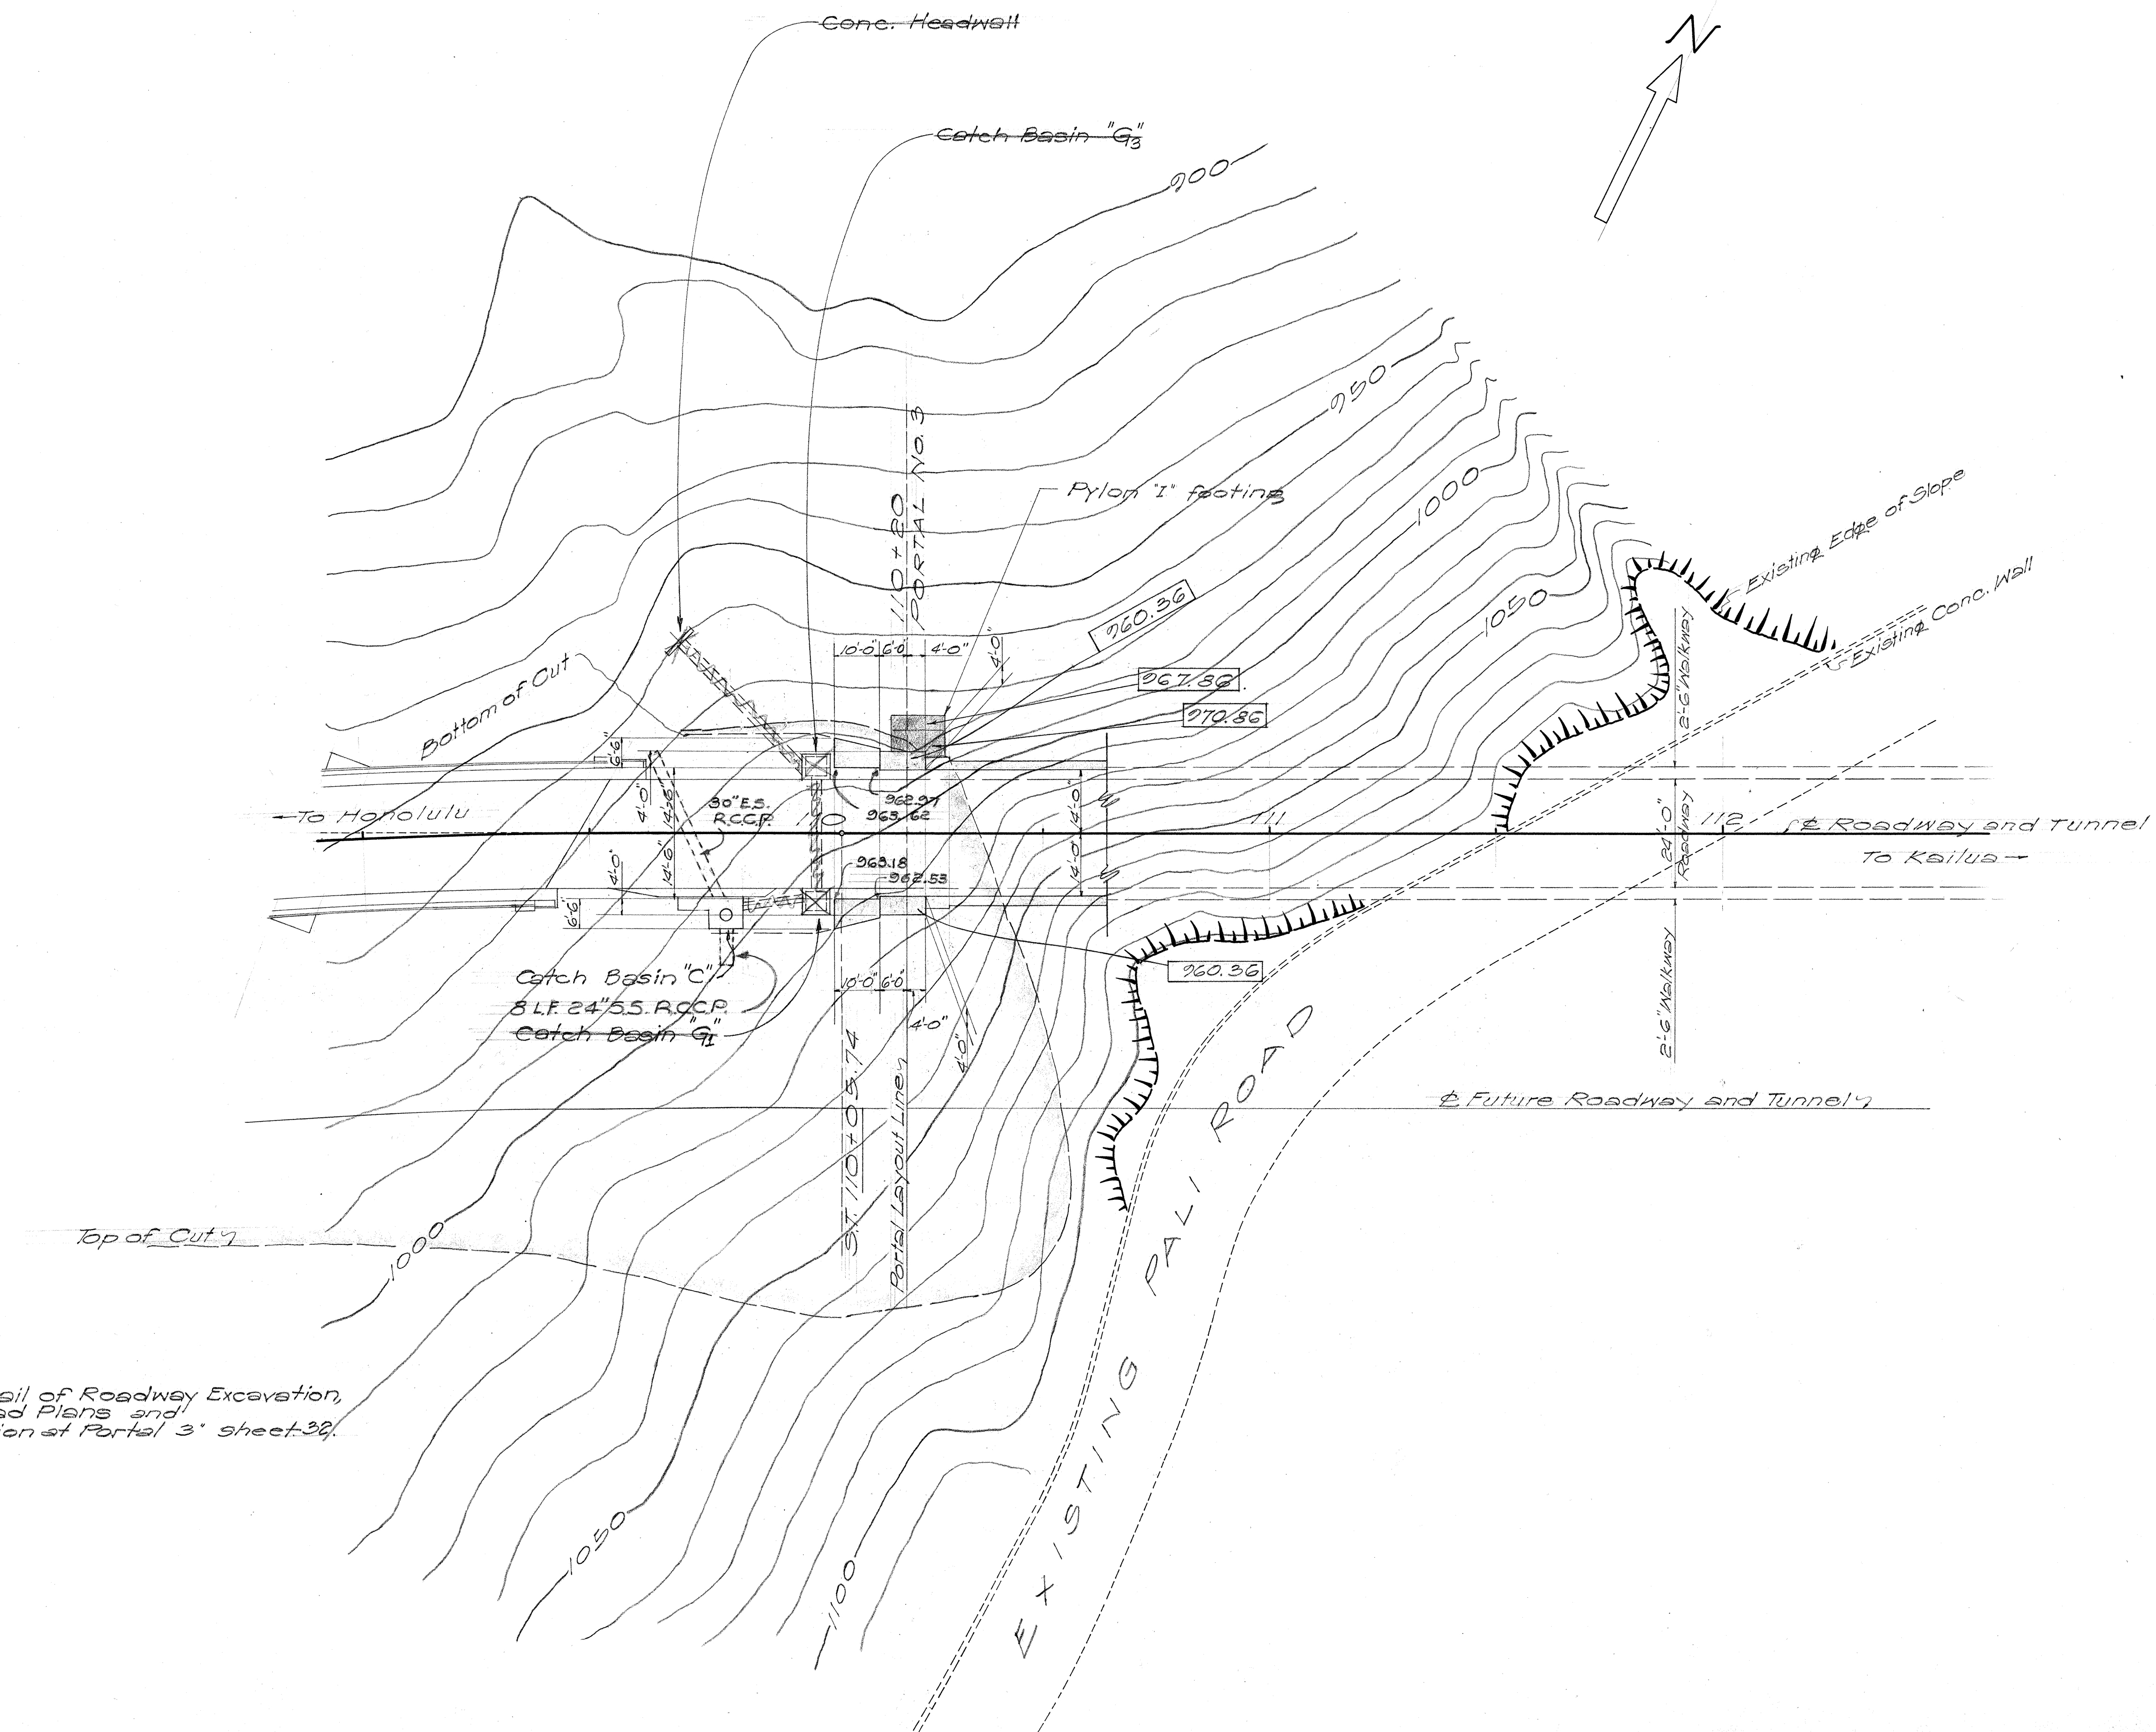

Note: For detail of Roadway Excavation, see Road Plans and Excavation at Portal 3 sheet 38.

NOTE: Footing Elevation indicated thus: 960.36

ORIGINAL PLAN	DESIGNED BY	DATE
NOTE BOOK	TRACED BY	1954
NO.	QUANTITIES BY	
	CHECKED BY	

TERRITORIAL HIGHWAY DEPARTMENT
TERRITORY OF HAWAII
FOUNDATION PLAN AT
PORTAL 3
NUUANU PALI TUNNELS
PALI ROAD
PROJ. No. SE 16 (5)
Scale: 1" = 20'-0" June 1954

SHEET No. 28 OF 42 SHEETS

5705.28

