




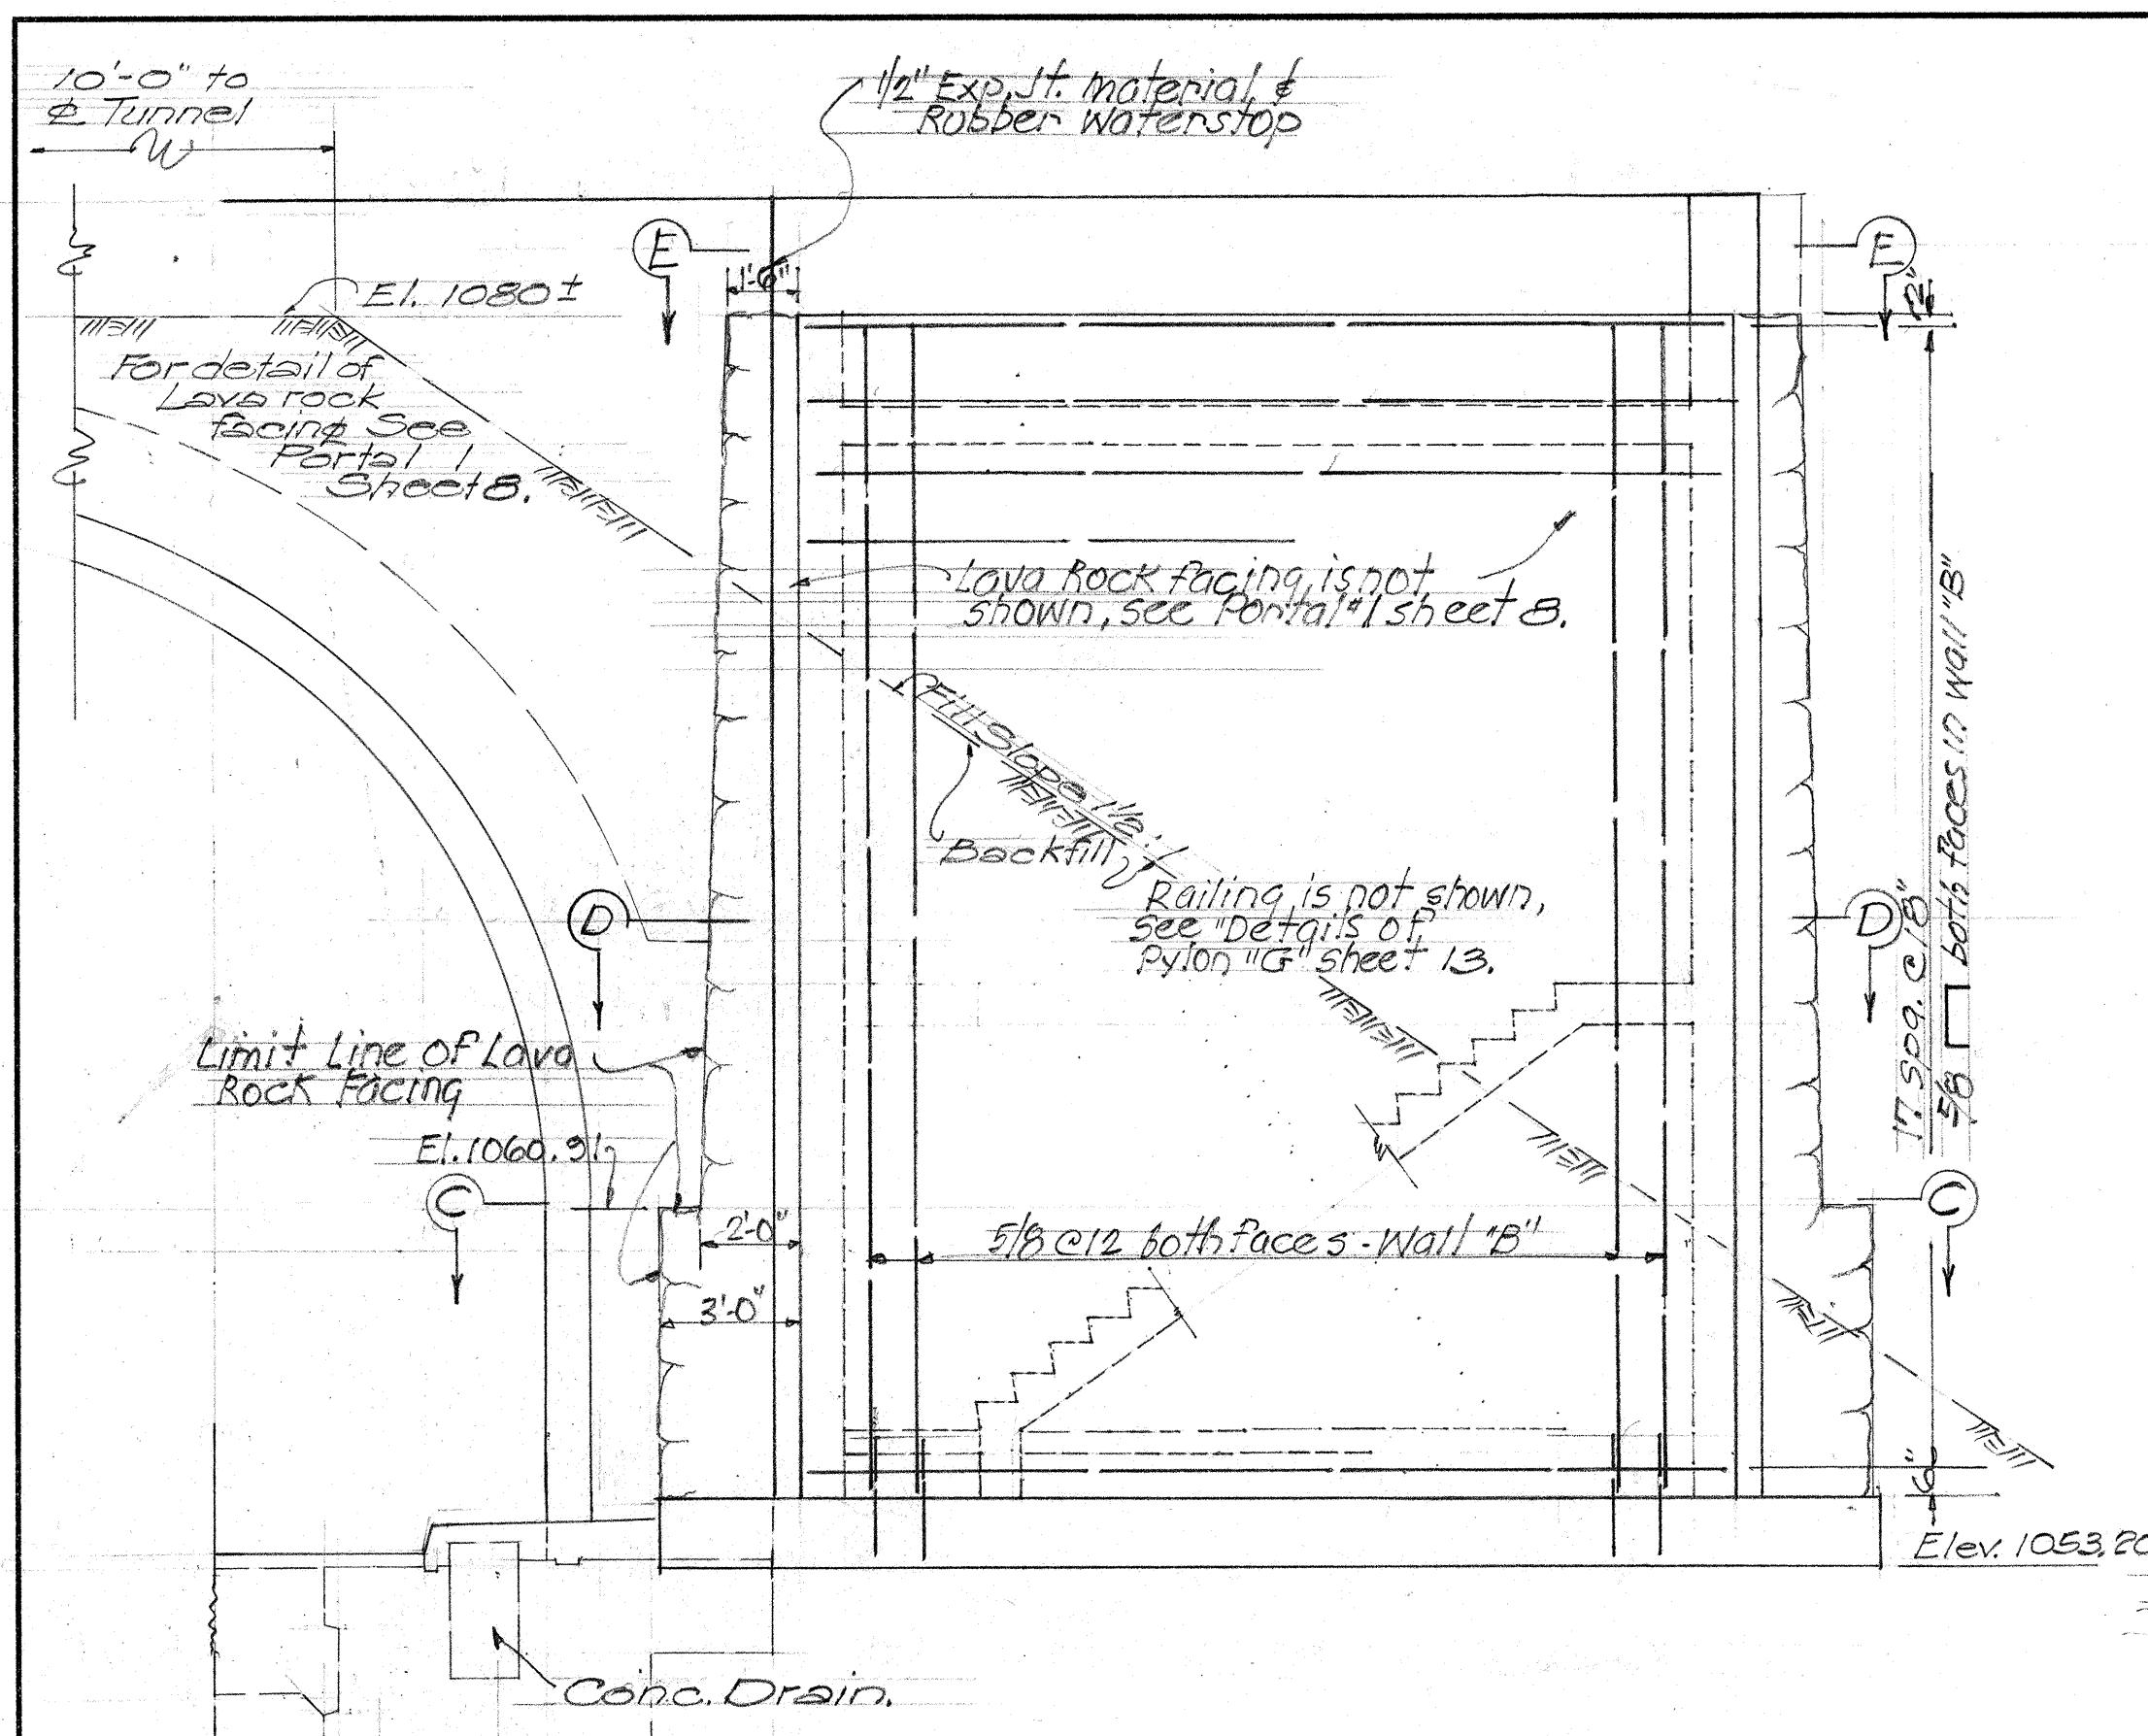


VIEW "A-A"

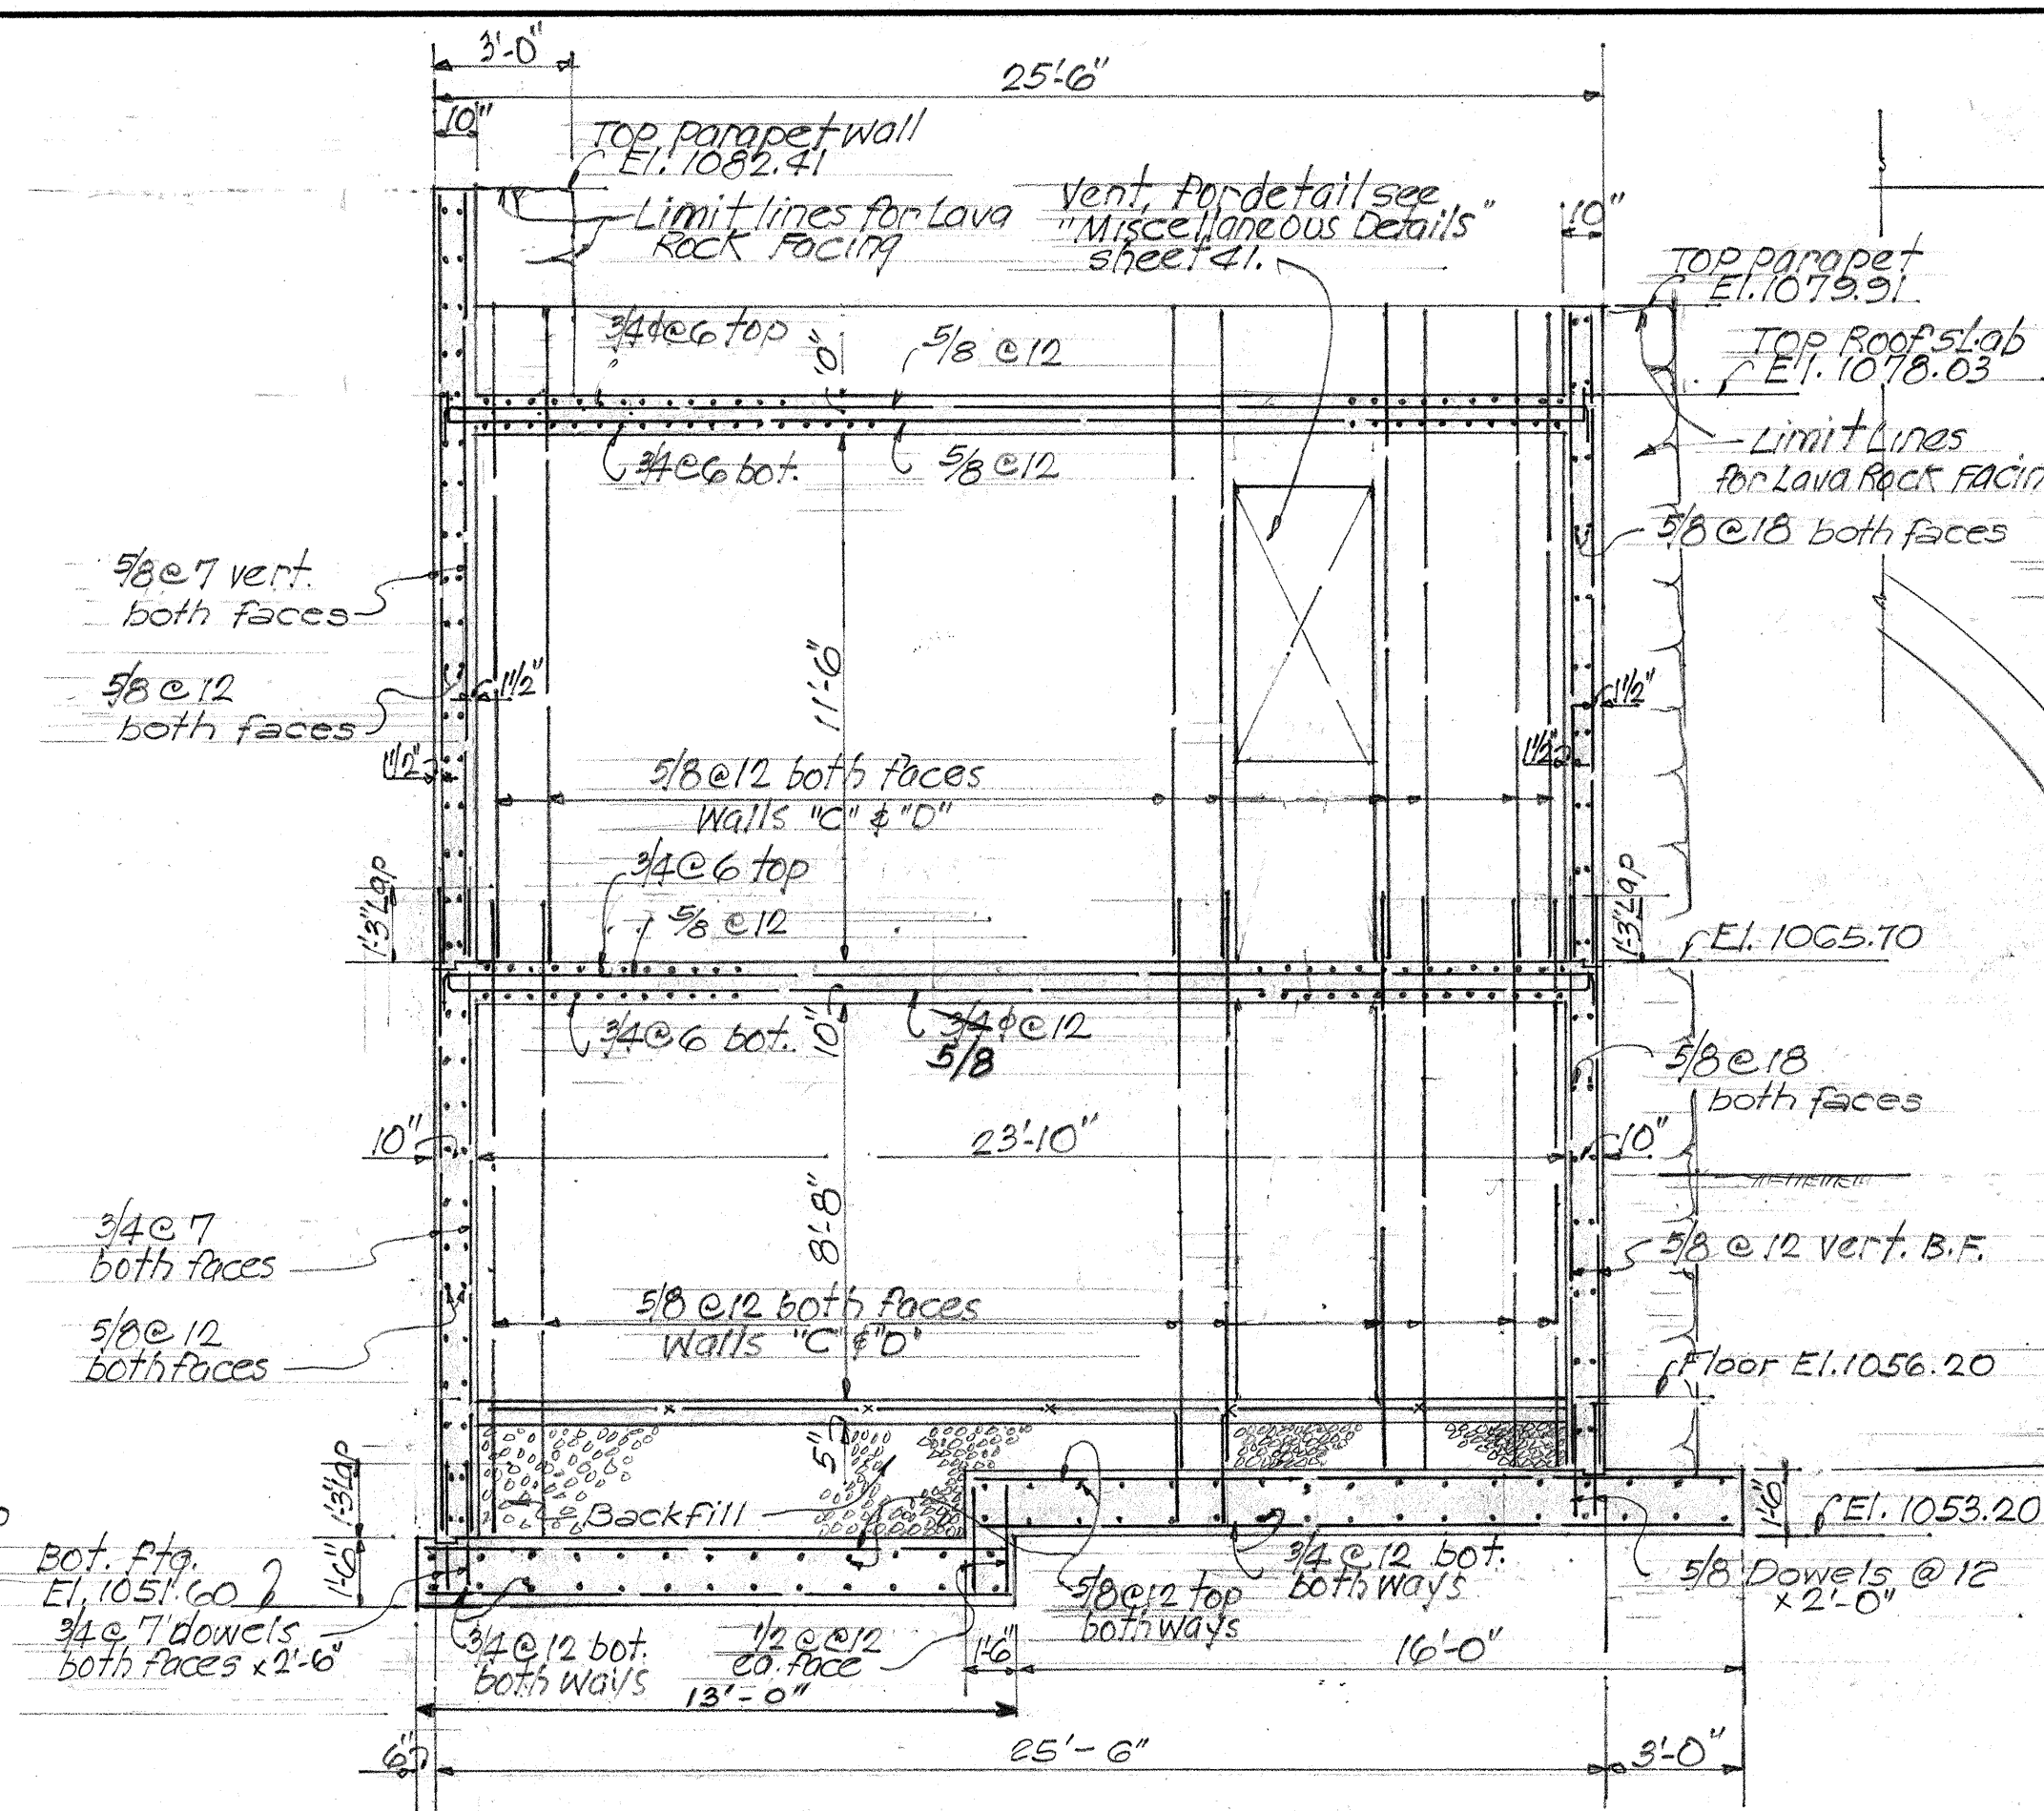


SECTION "B-B"

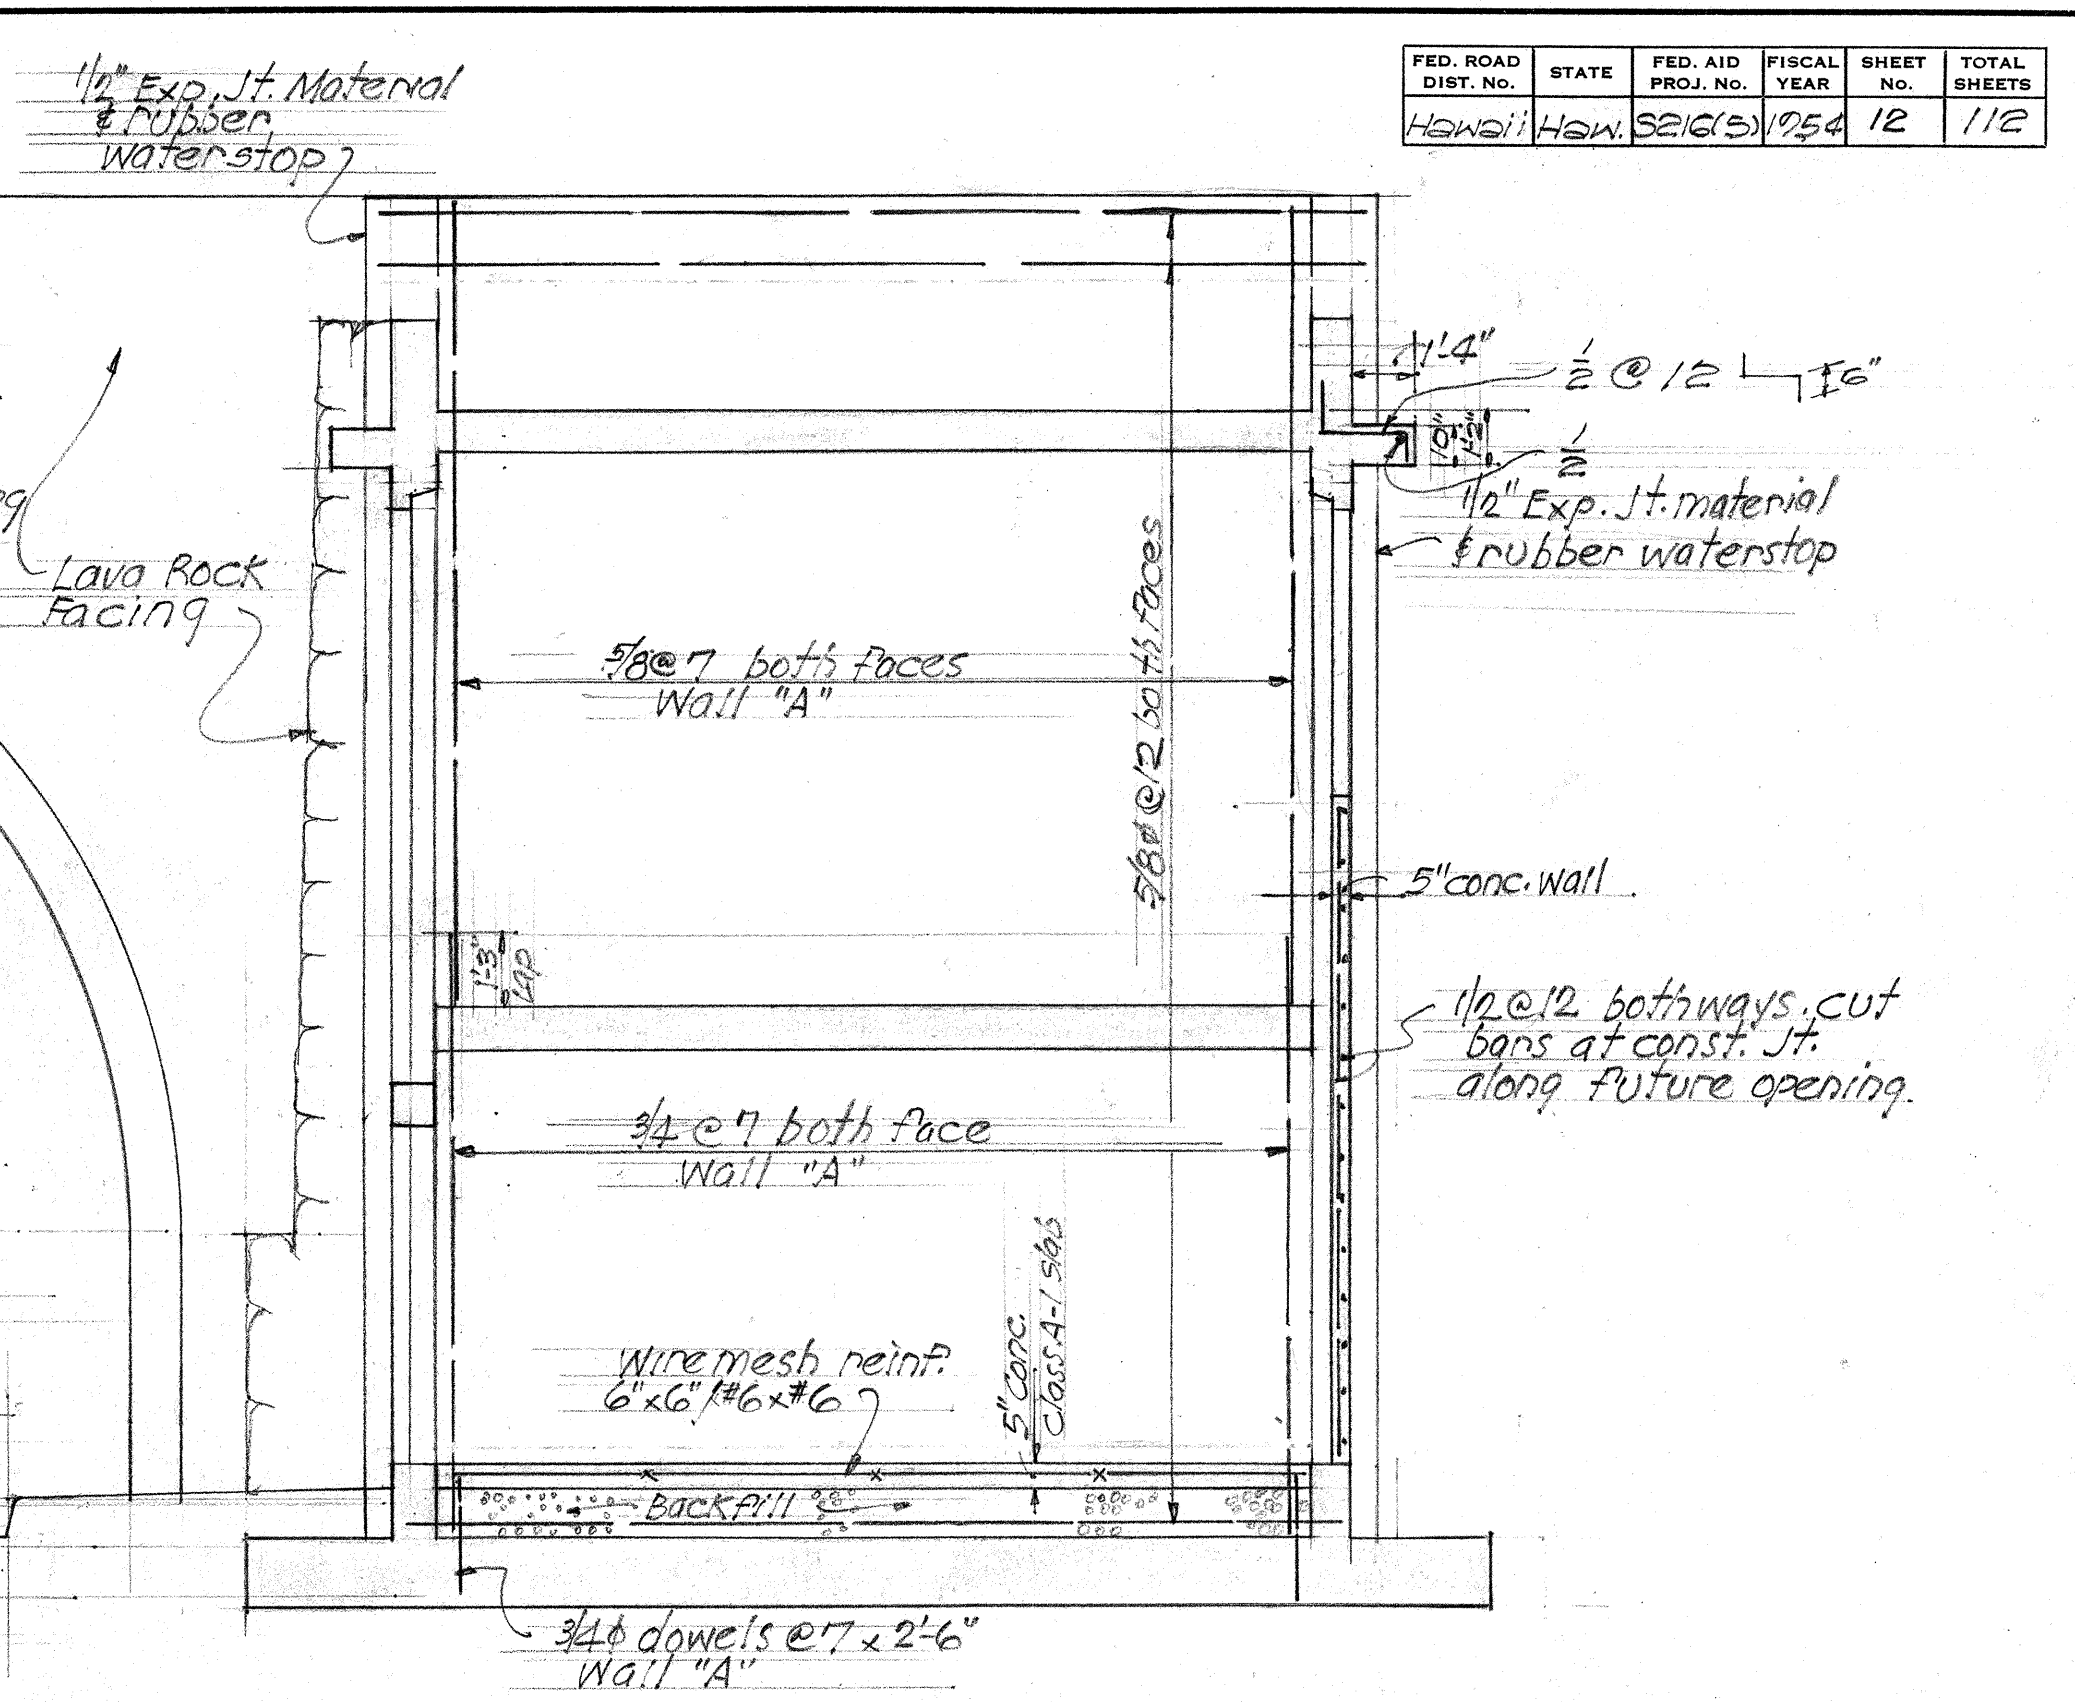


SECTION "F-F"

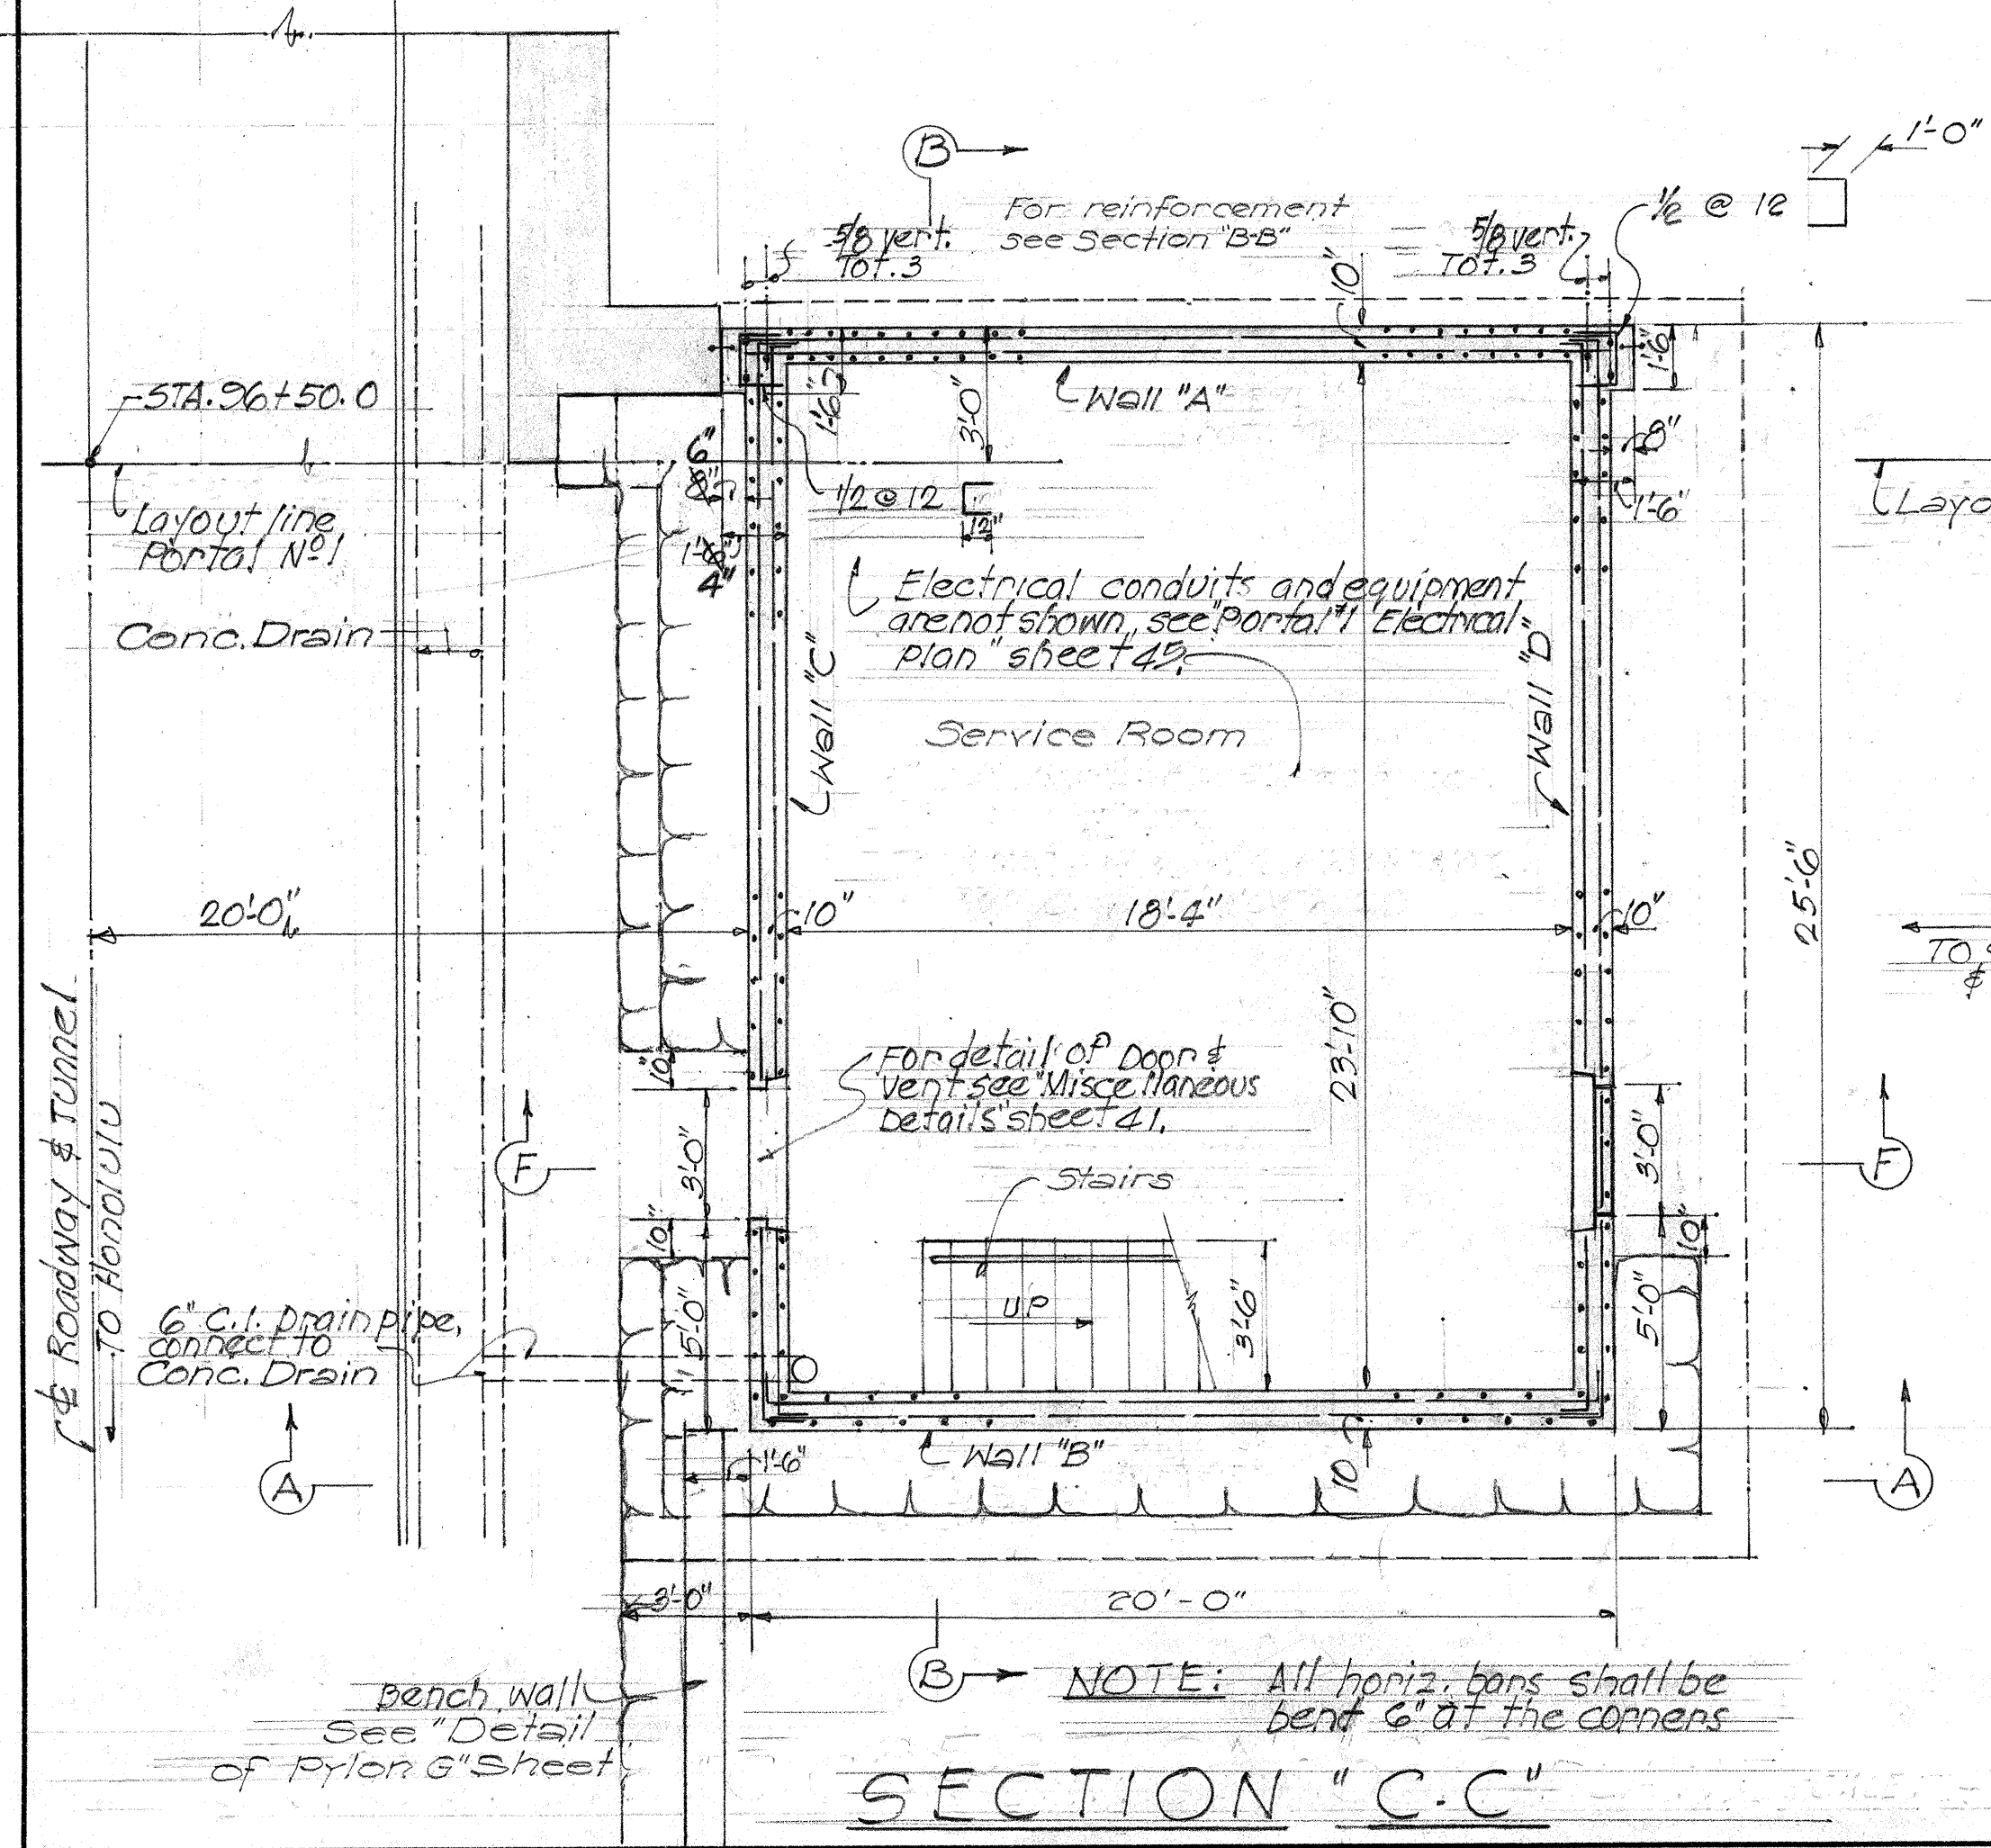

SECTION "C-C"

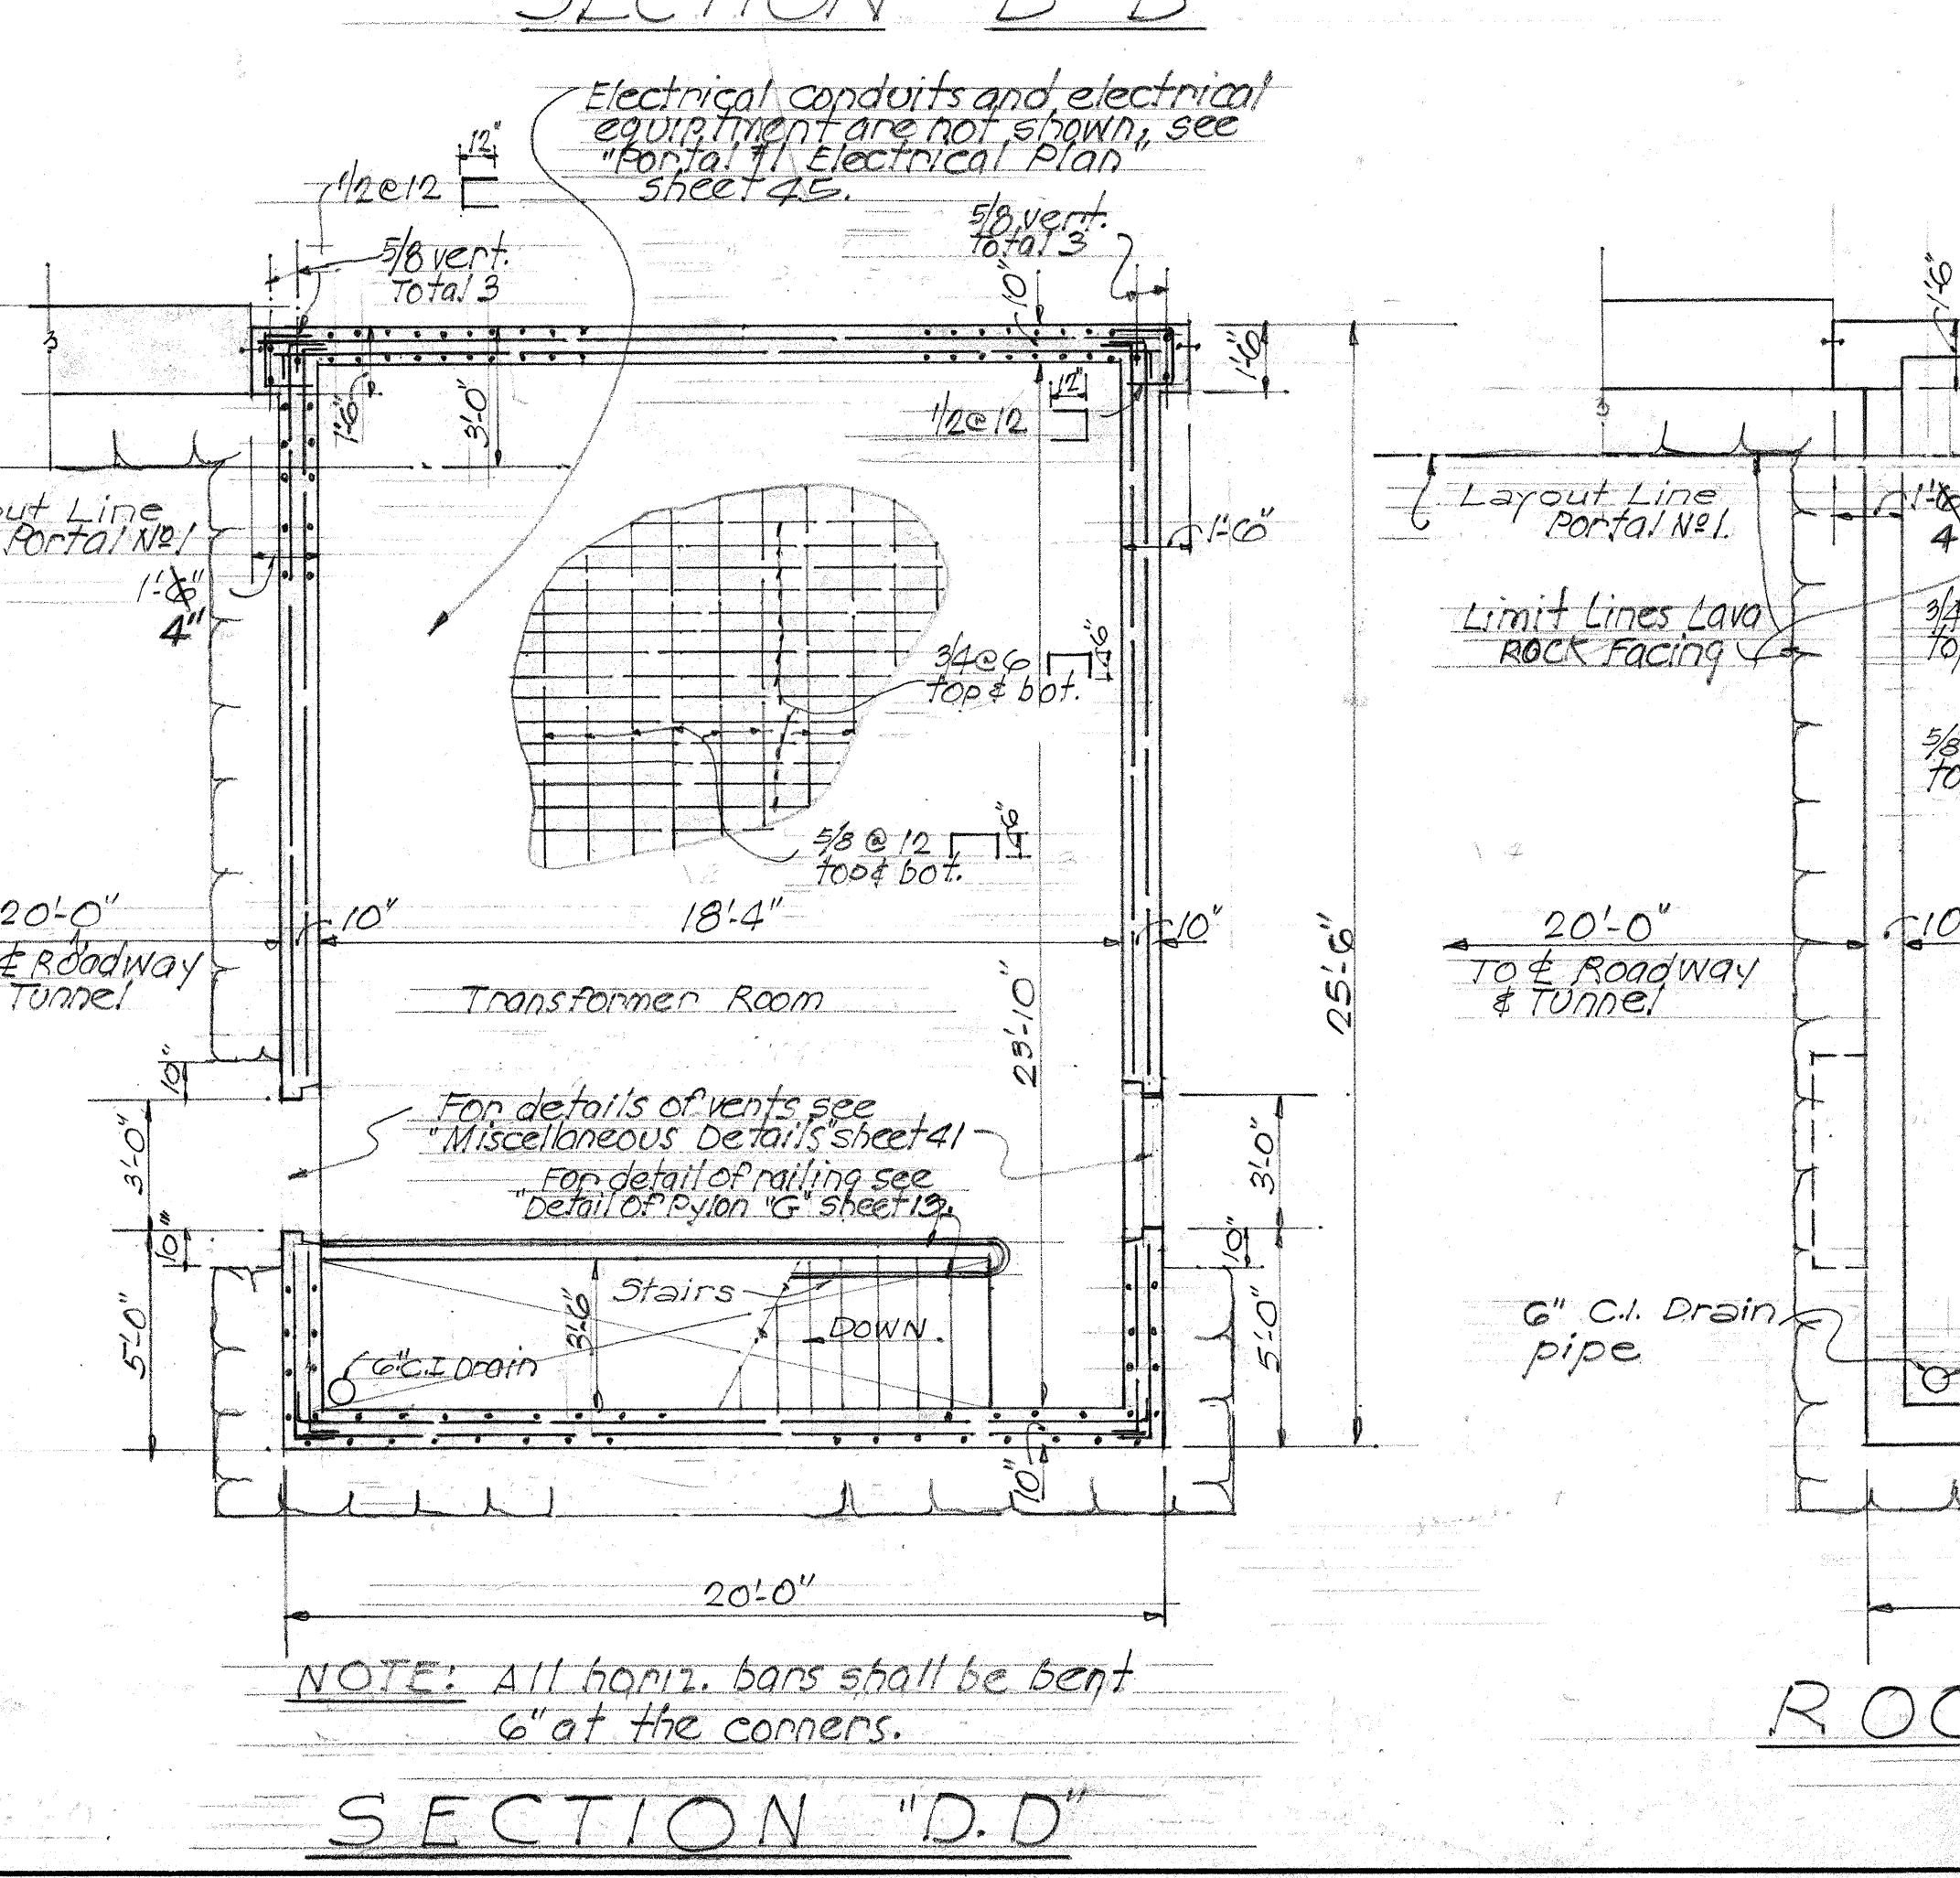

SECTION "D-D"

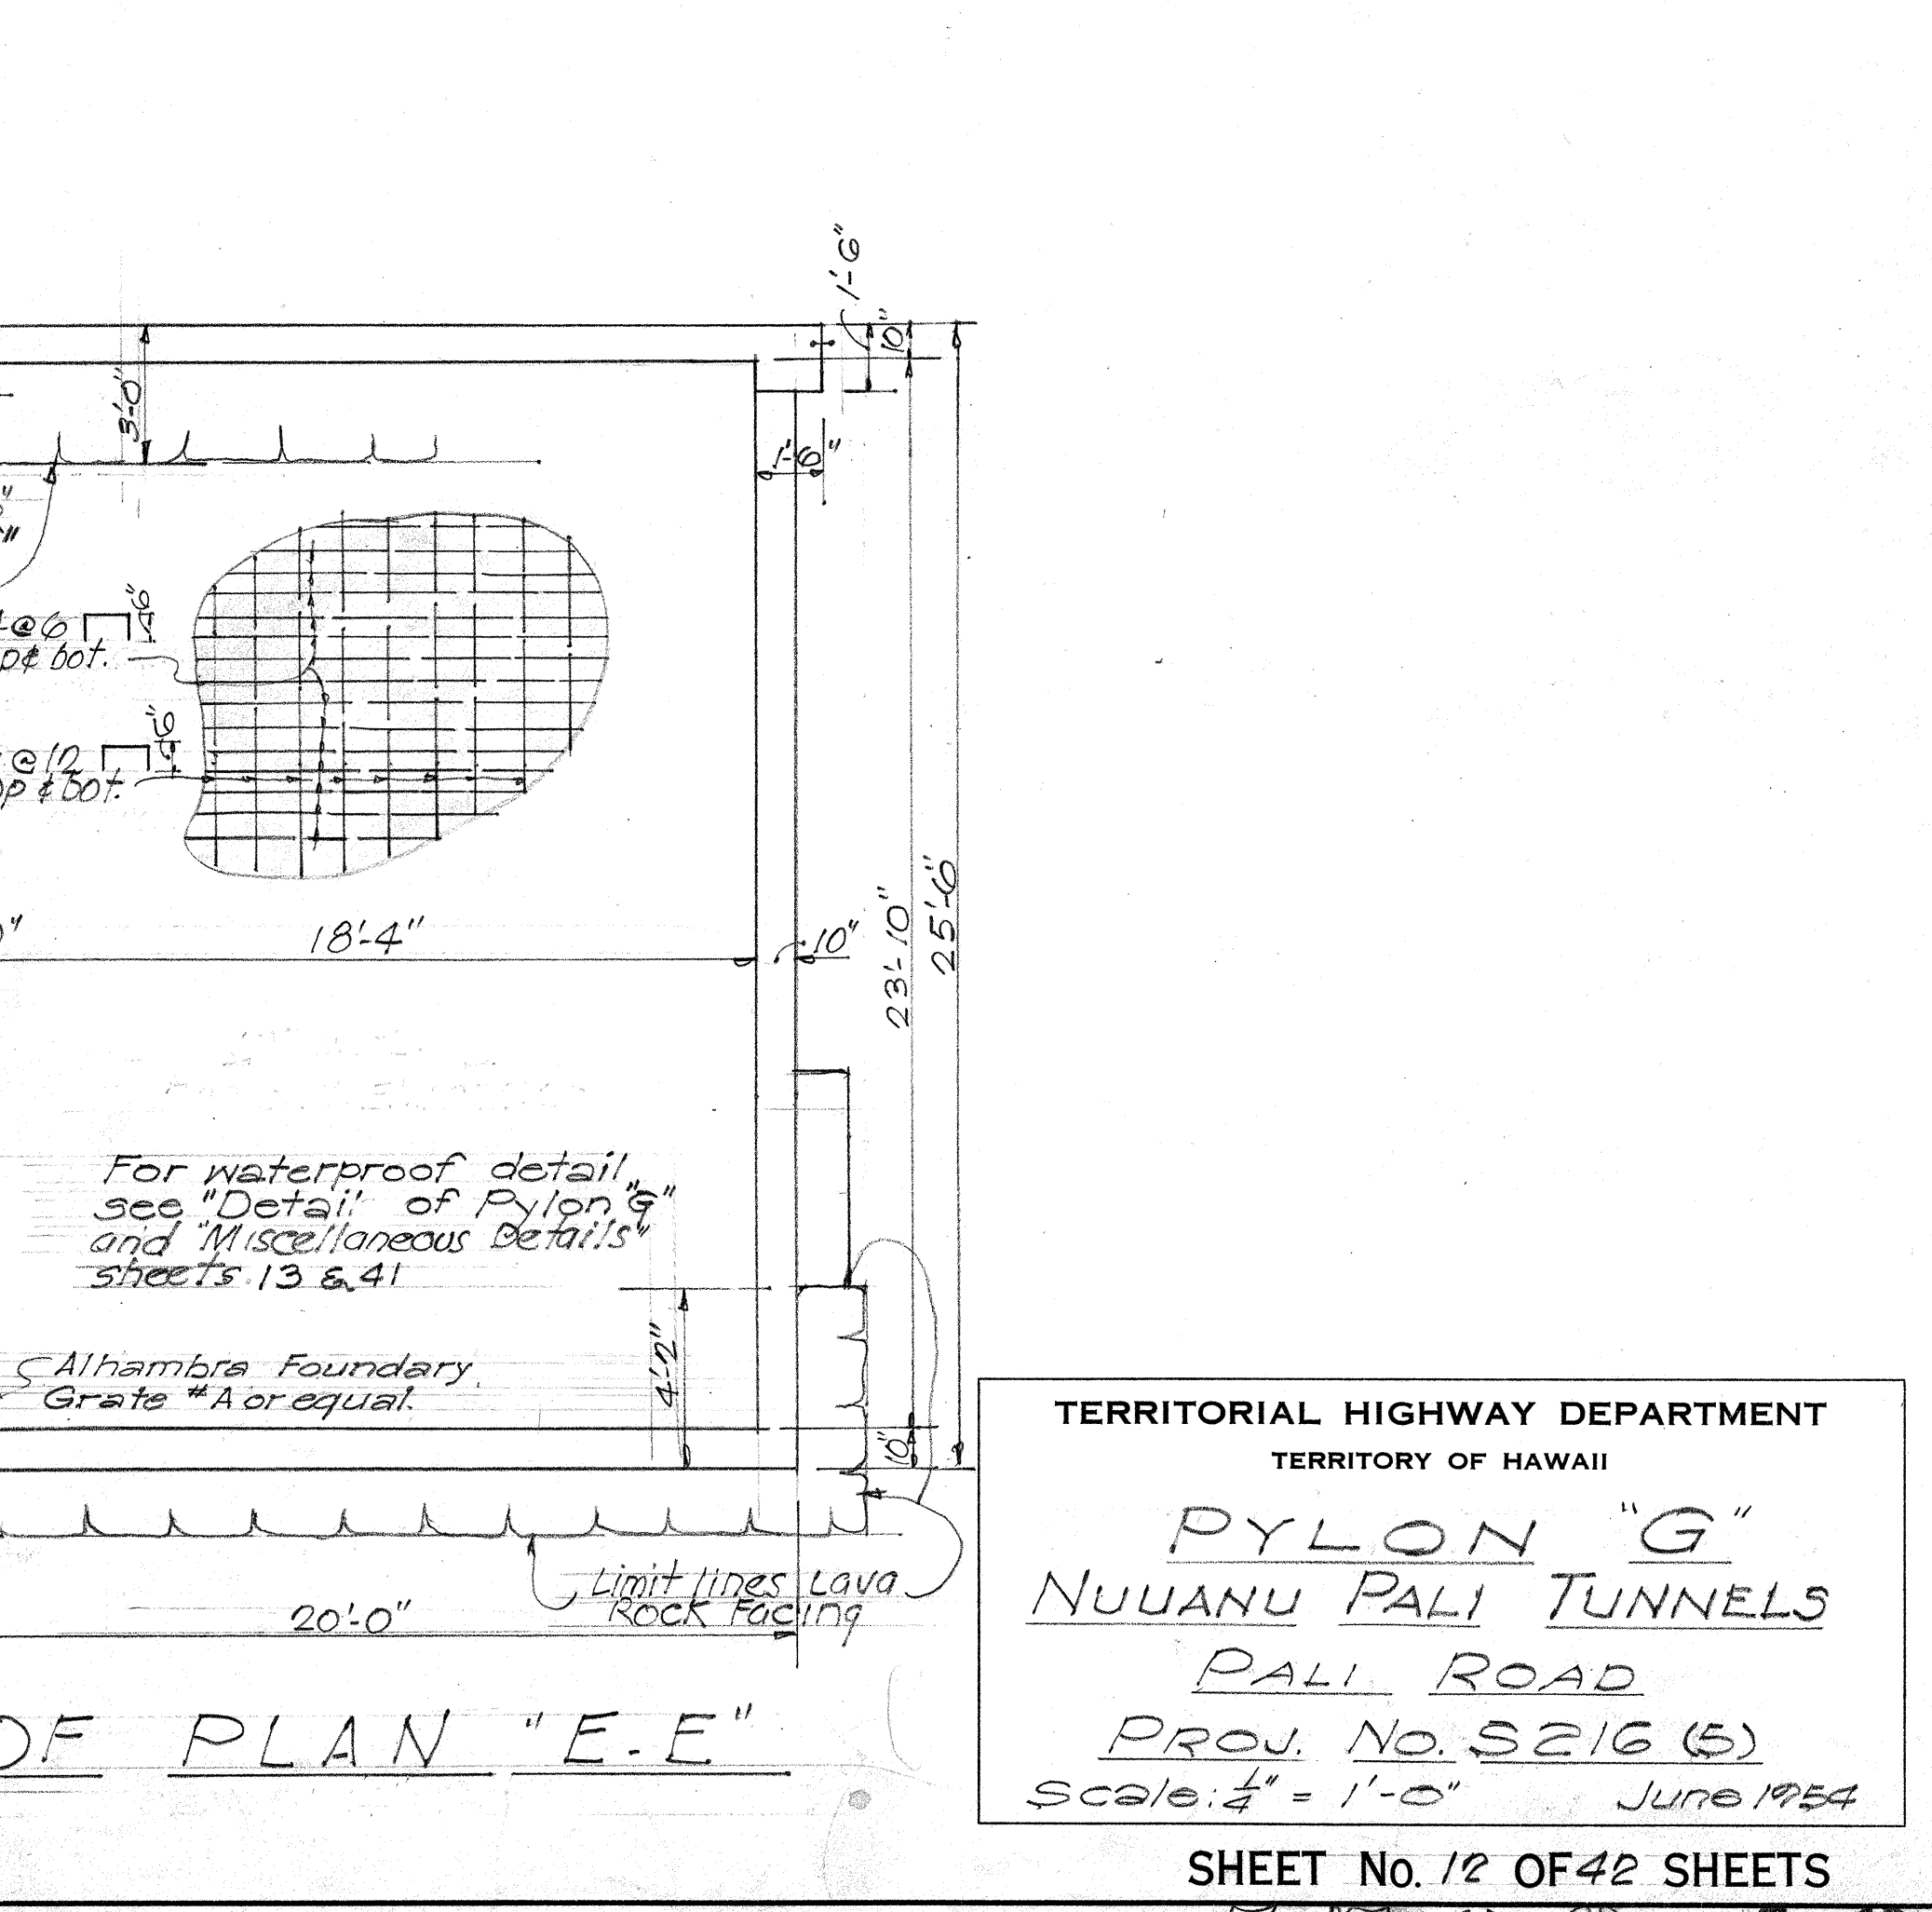

ROOF PLAN "E-E"



DATE: 5/54
DESIGNED BY: [Signature]
CHECKED BY: [Signature]
NOTED BY: [Signature]
ORIGINAL PLAN NO. [Blank]
NOTE BOOK NO. [Blank]

TERRITORIAL HIGHWAY DEPARTMENT
TERRITORY OF HAWAII
PYLON "G"
NUUANU PALI TUNNELS
PALI ROAD
PROJ. NO. S216 (5)
Scale: 1/4" = 1'-0"
June 1954

SHEET No. 12 OF 42 SHEETS

5708.12

FED. ROAD DIST. No.	STATE	FED. AID PROJ. No.	FISCAL YEAR	SHEET No.	TOTAL SHEETS

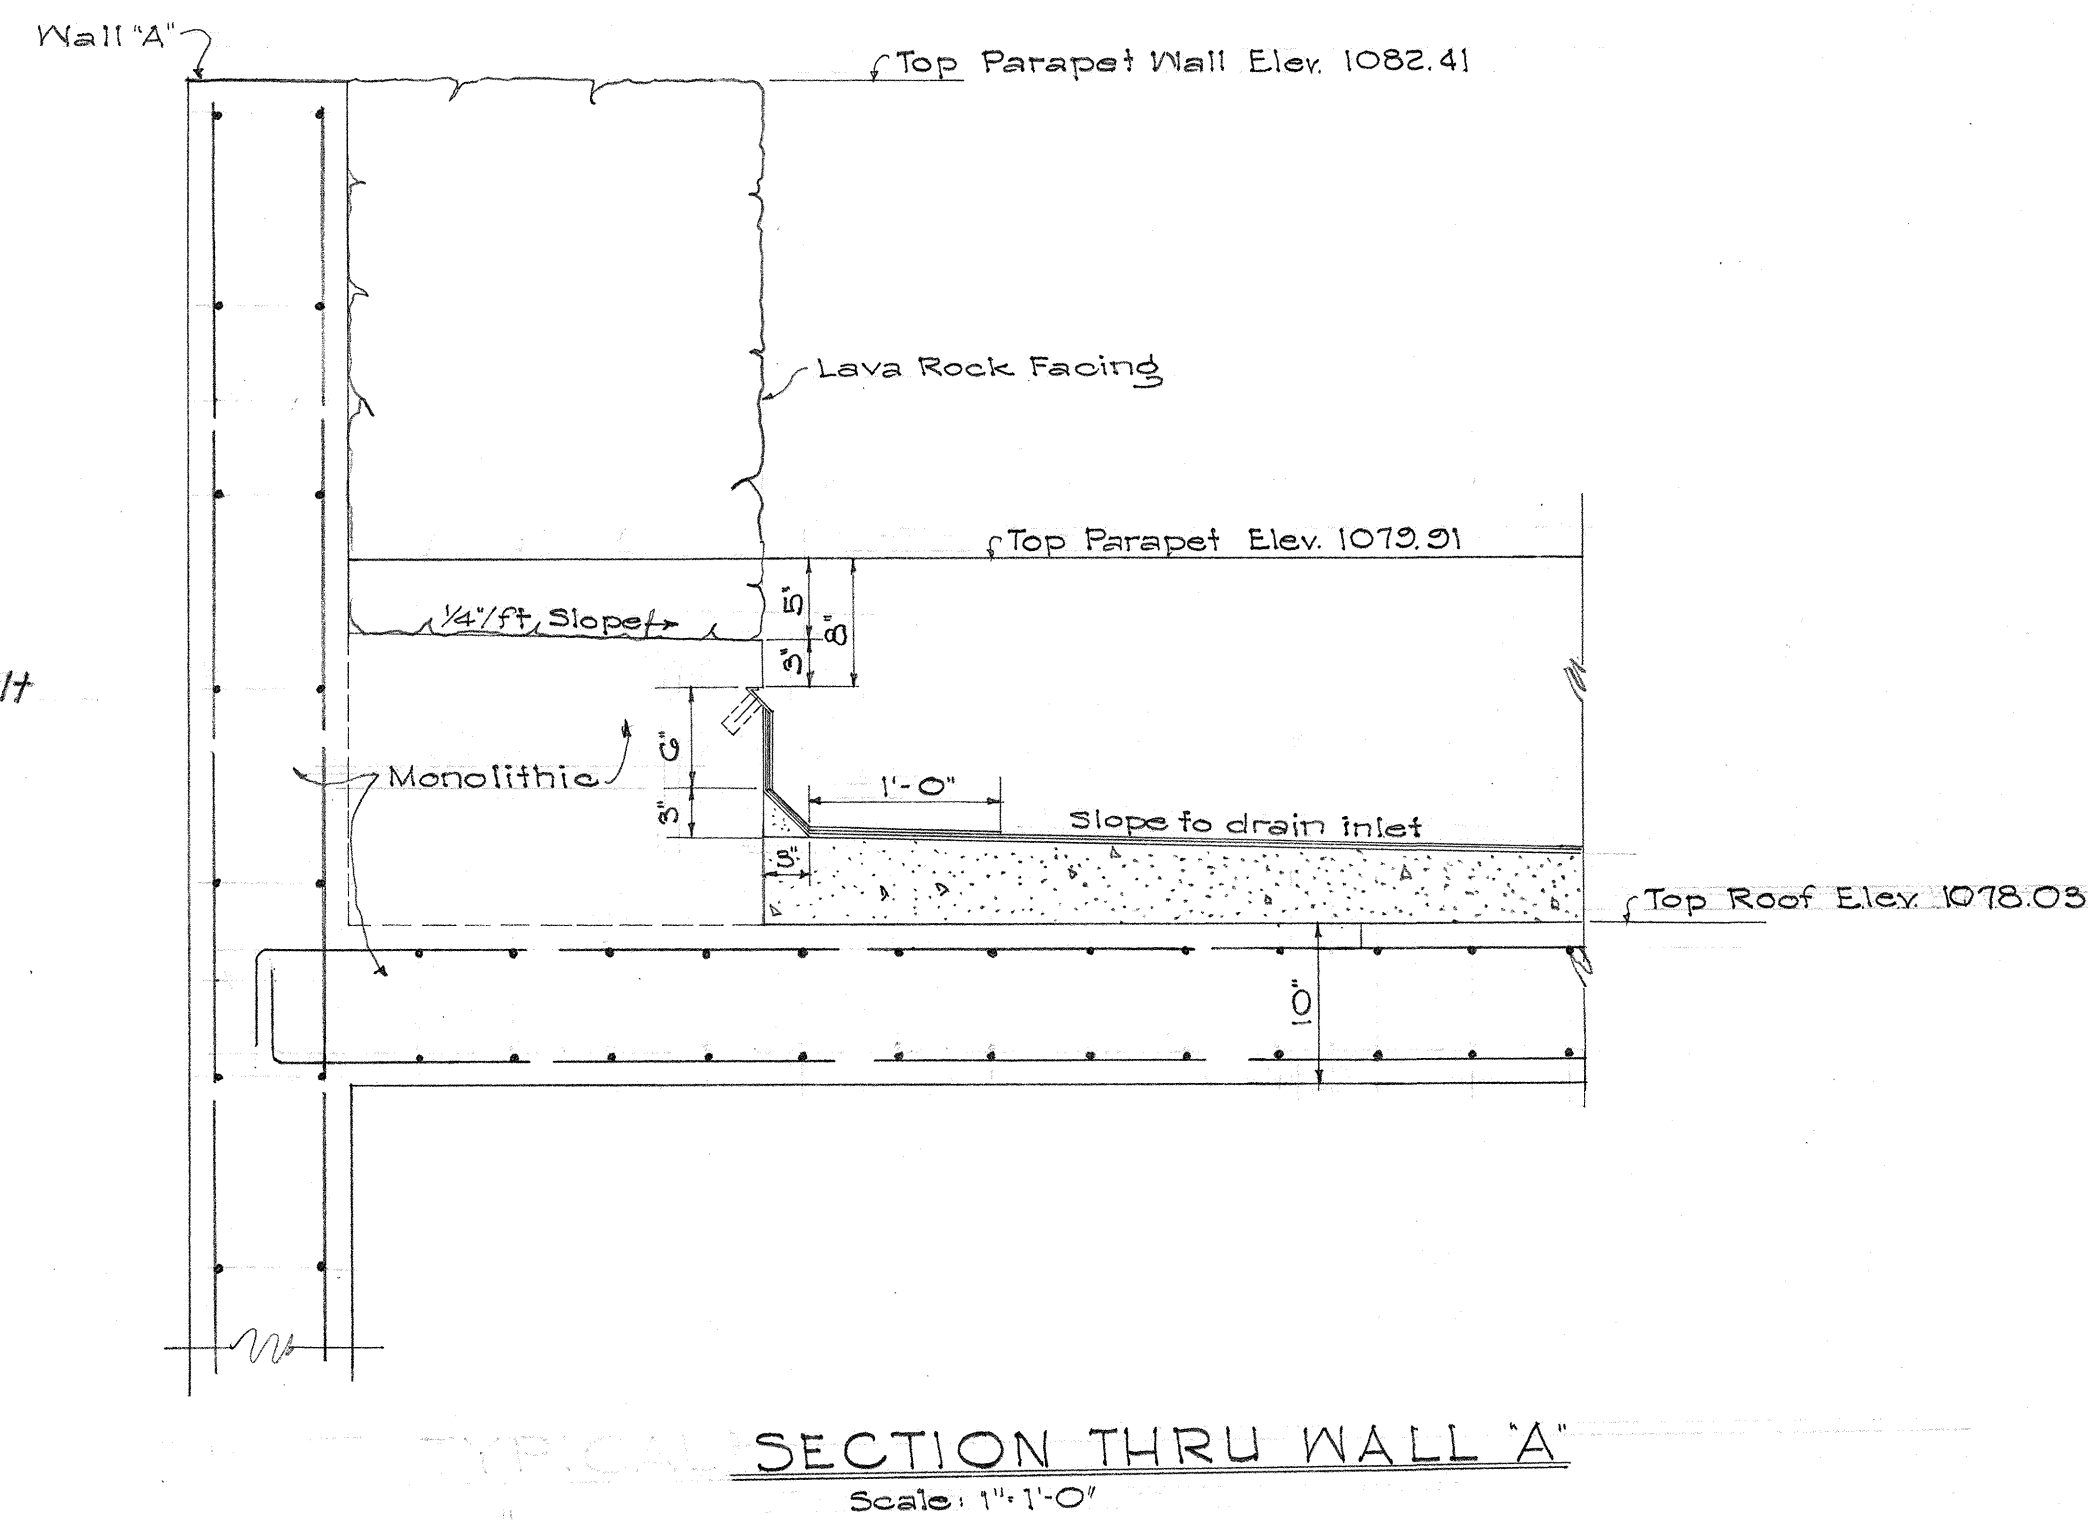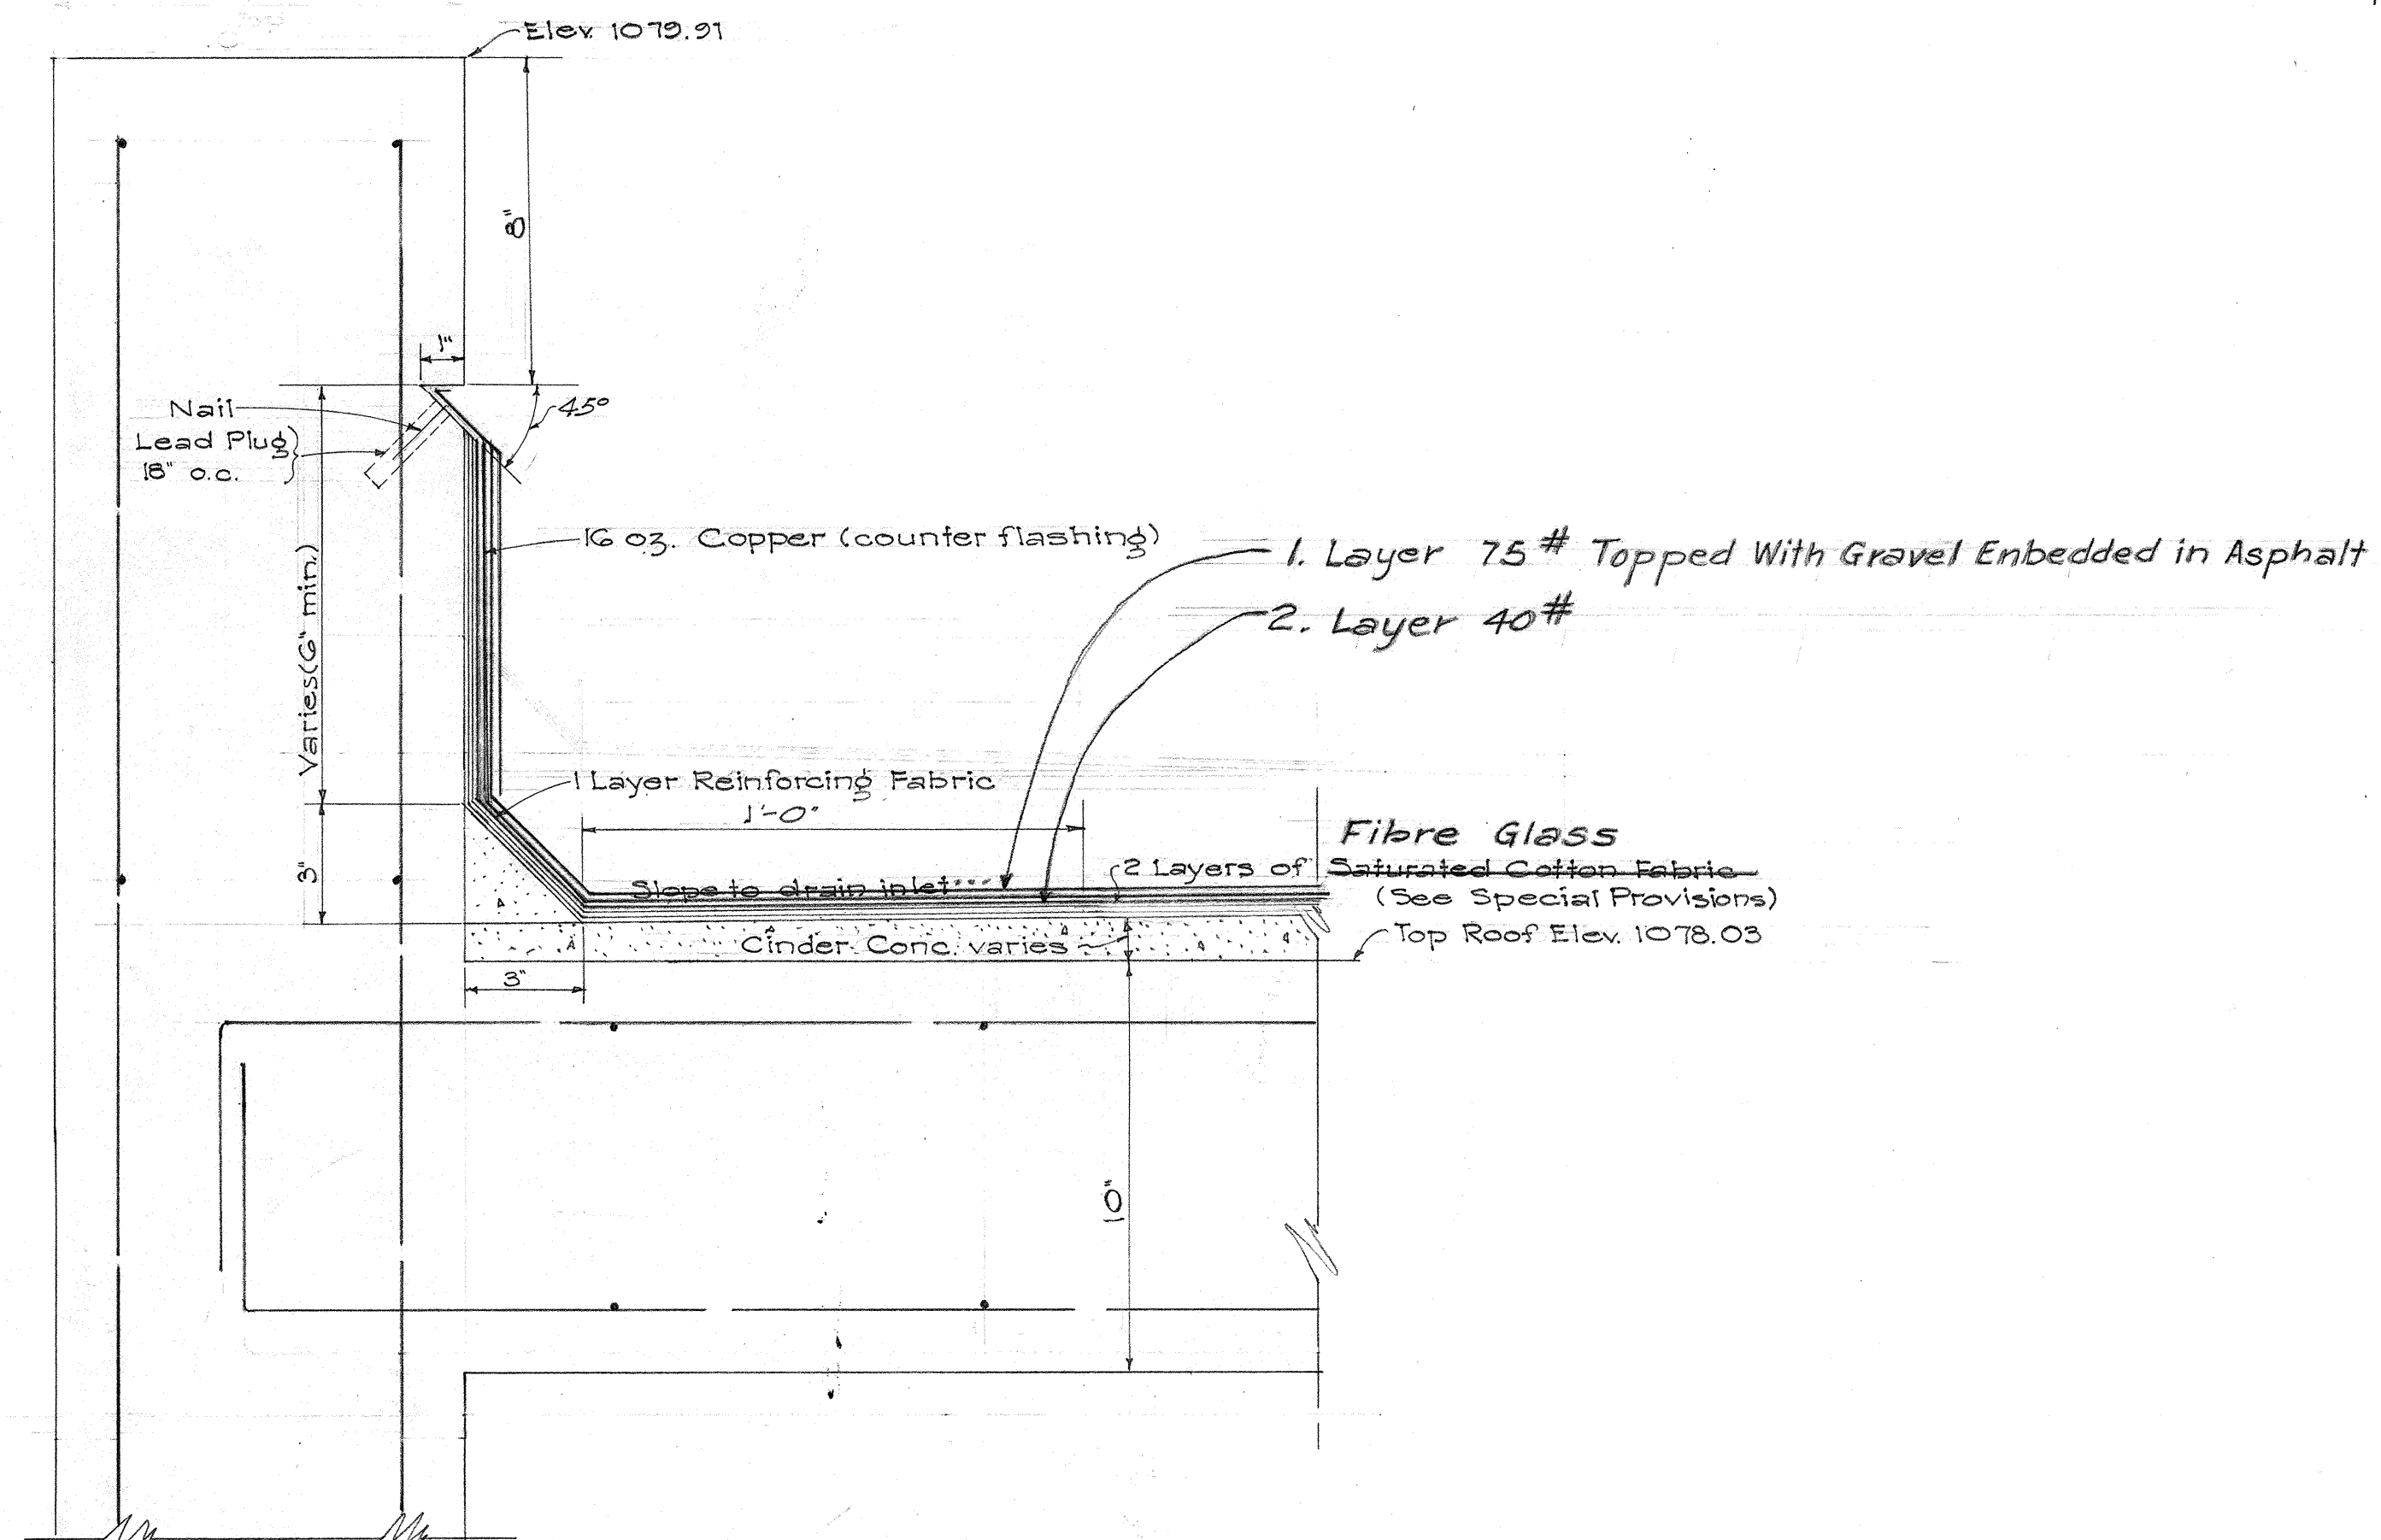

ORIGINAL PLAN	DATE
DESIGNED BY	
TRACED BY	
QUANTITIES BY	
CHECKED BY	
NOTE BOOK No.	

TERRITORIAL HIGHWAY DEPARTMENT
TERRITORY OF HAWAII
FLASHING DETAIL ON
PYLON "G" ROOF
NUUANU PALI TUNNELS
PALI ROAD
PROJ. NO. S-216(5)
Scale: As Noted Nov. 30, 1956

SHEET NO. OF SHEETS

5708.13A

5708.13A