
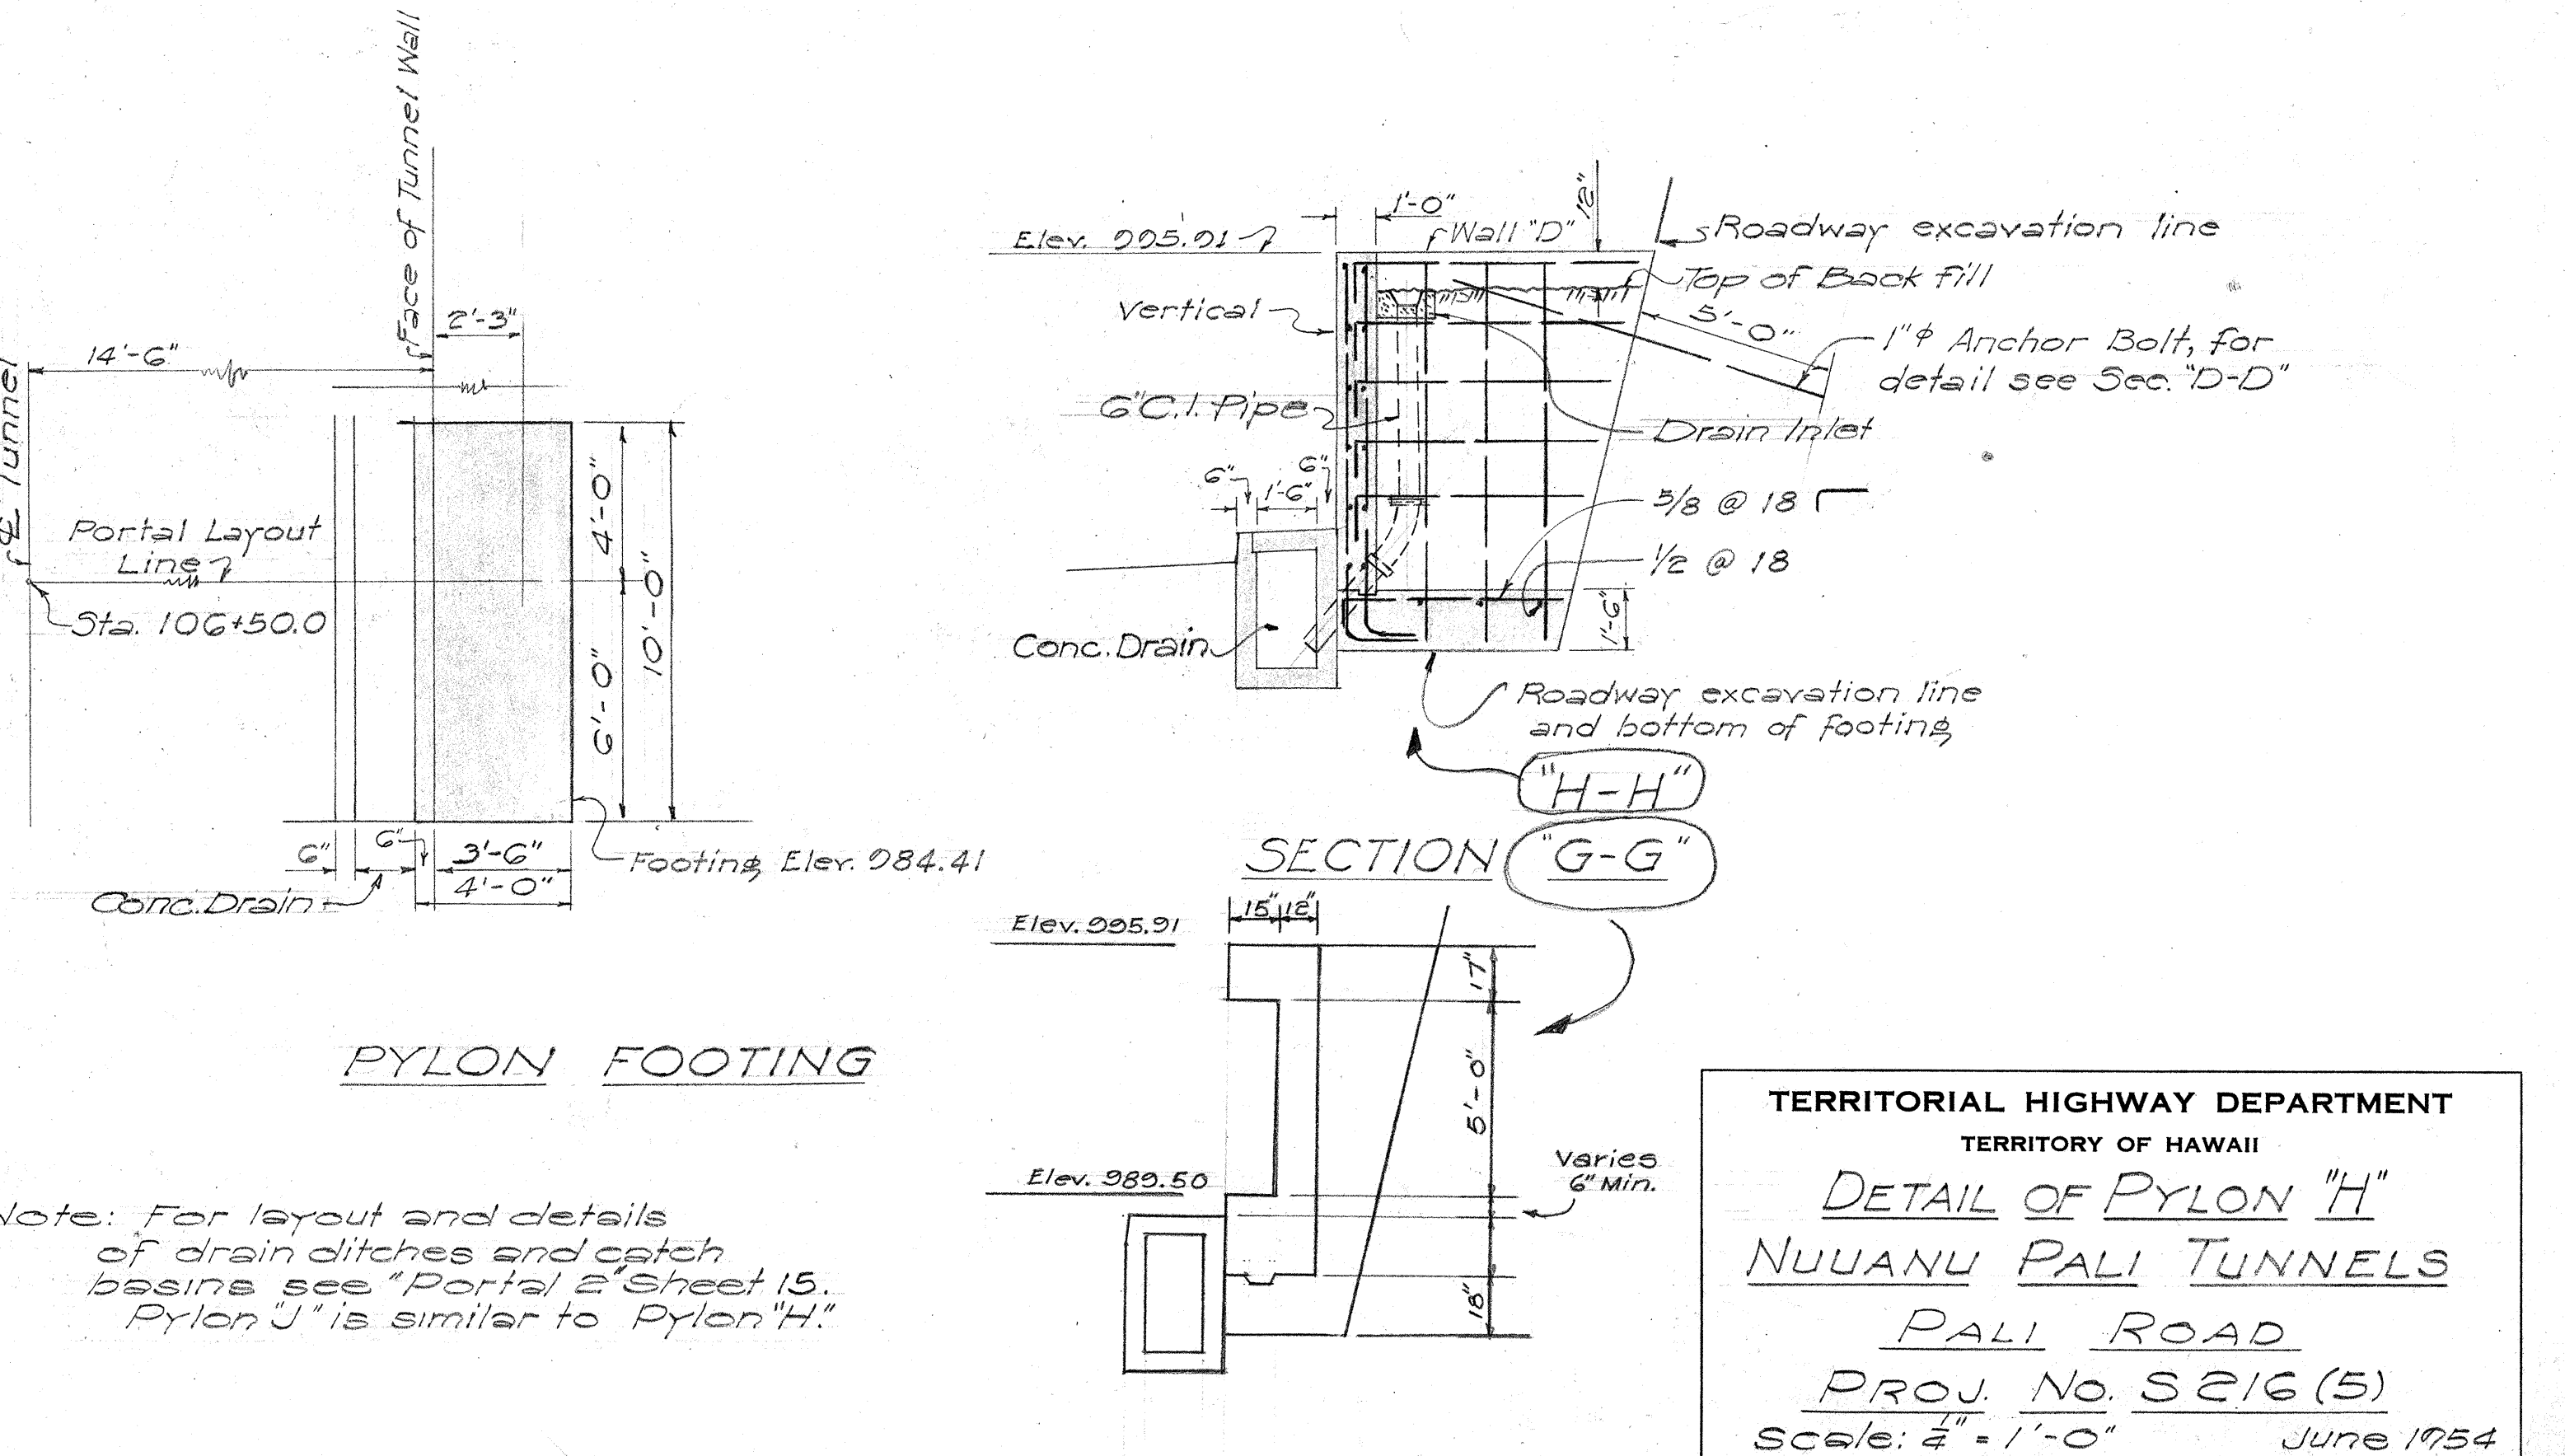
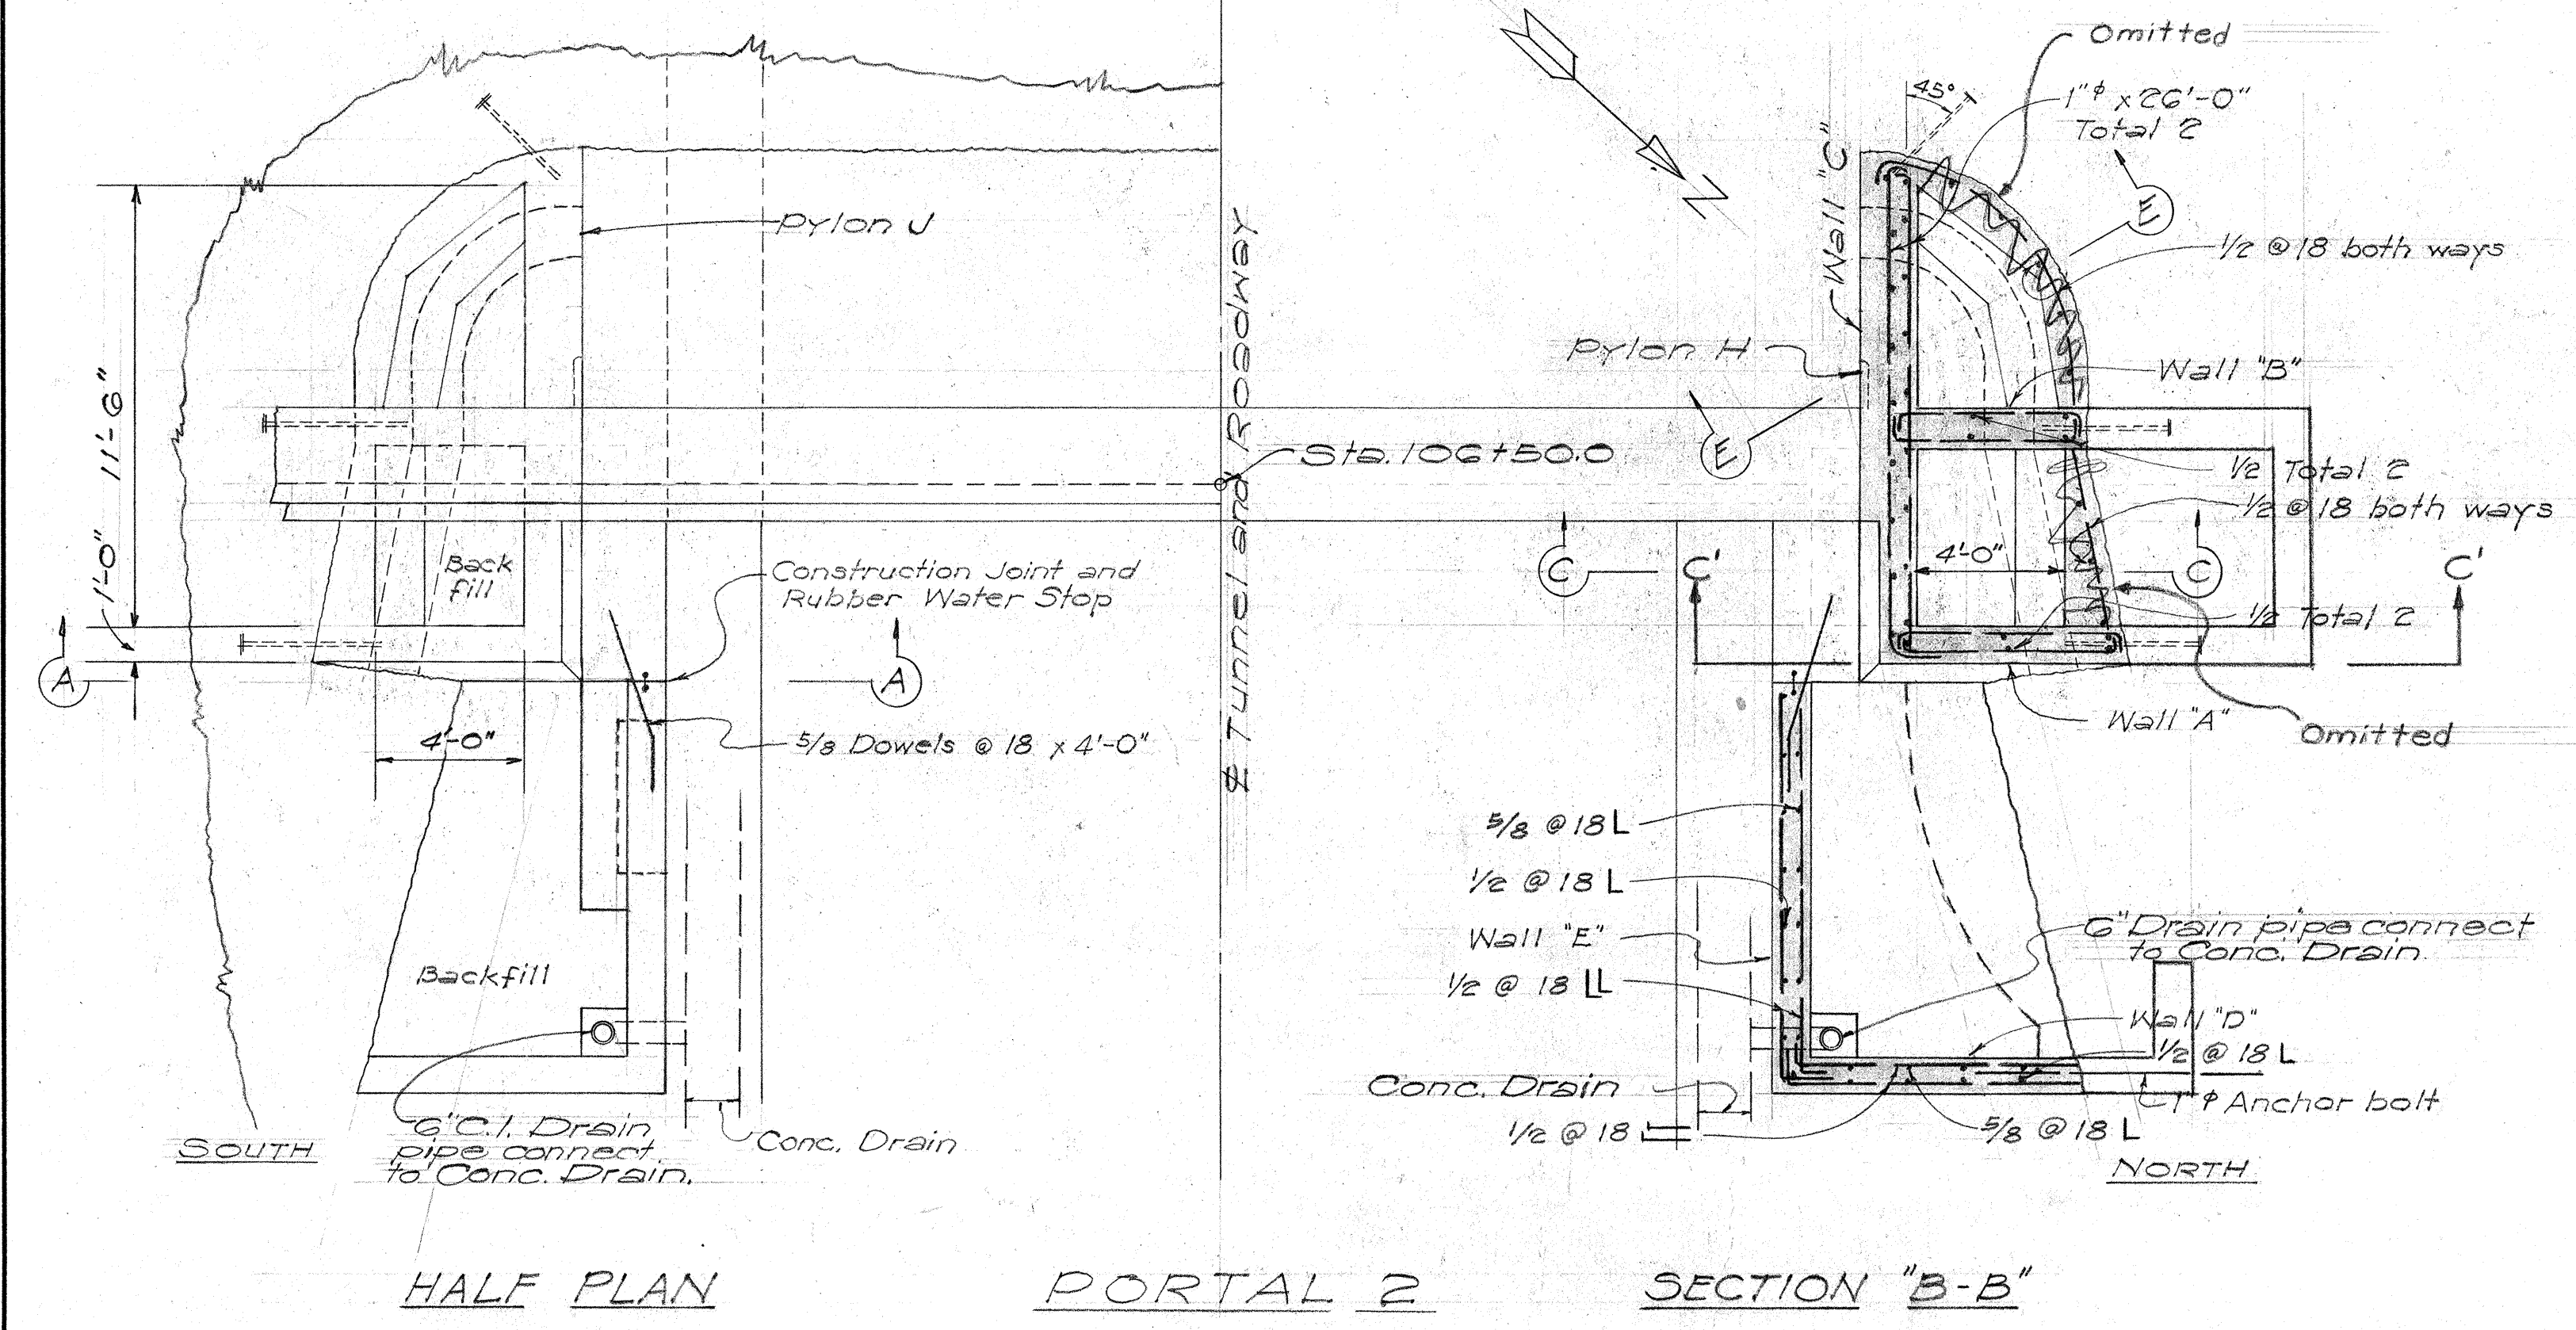


Note:
C.B. "M" Portal #2
Left dropped 3'

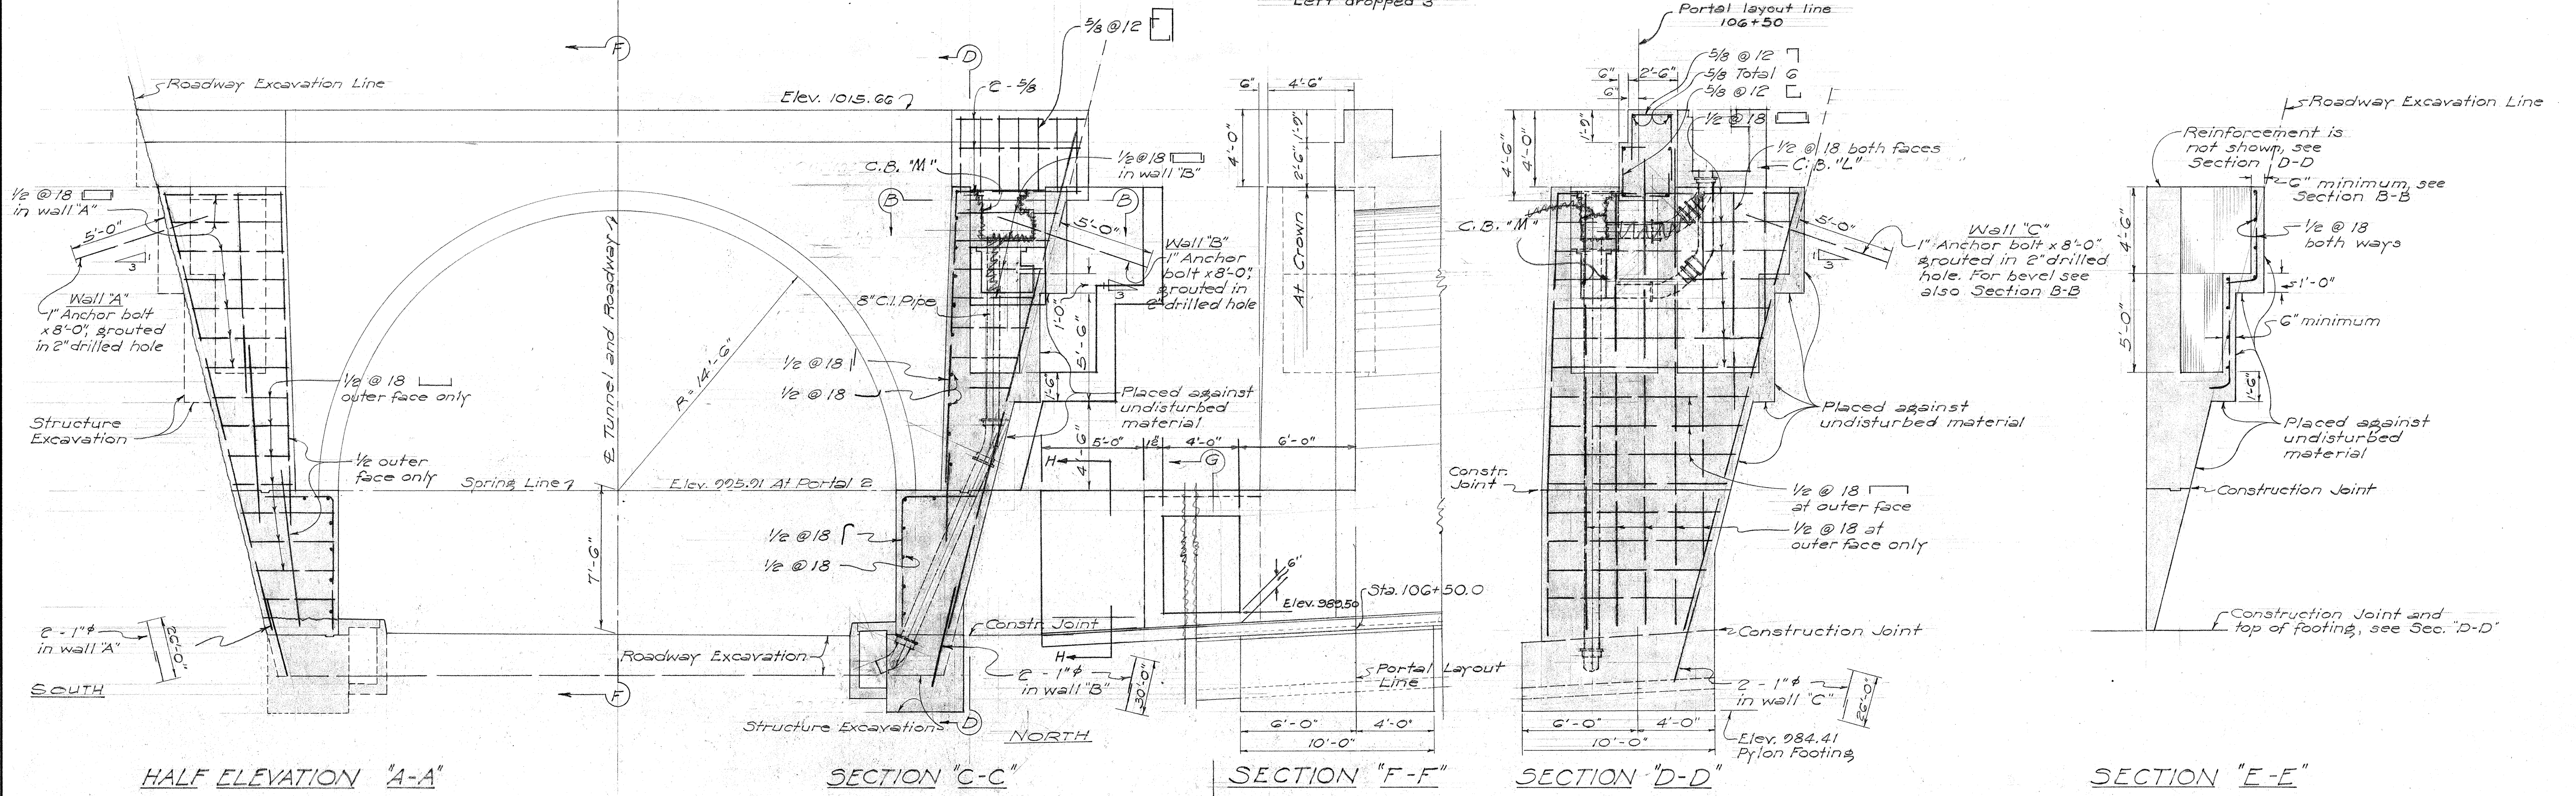

TERRITORIAL HIGHWAY DEPARTMENT
TERRITORY OF HAWAII
DETAIL OF PYLON "H"
NUUANU PALI TUNNELS
PALI ROAD
PROJ. No. SEIG(5)
Scale: 1/4" = 1'-0"
June 1954