

TYPE "D" STA. 110+20.0 to 114+20.0
Scale: 1/2"=1'-0"

TYPE "D" RIGHT SIDE FOOTING
STA. 114+20.0 to 115+20.0


Note: For trim lines and payment lines see "Typical Section D" sheet 21.

TERRITORIAL HIGHWAY DEPARTMENT
TERRITORY OF HAWAII
ROADWAY PAVEMENT 1
NUUANU PALI TUNNELS
PALI ROAD
PROJ. NO. 5216(5)
Scale: As noted June 1954






SHEET NO. 38 OF 42 SHEETS

5708.38

DATE: 5/24/54
DESIGNED BY: [Signature]
DRAWN BY: [Signature]
CHECKED BY: [Signature]
ORIGINAL PLAN NO. 5216(5)
NOTE BOOK NO. 5216(5)

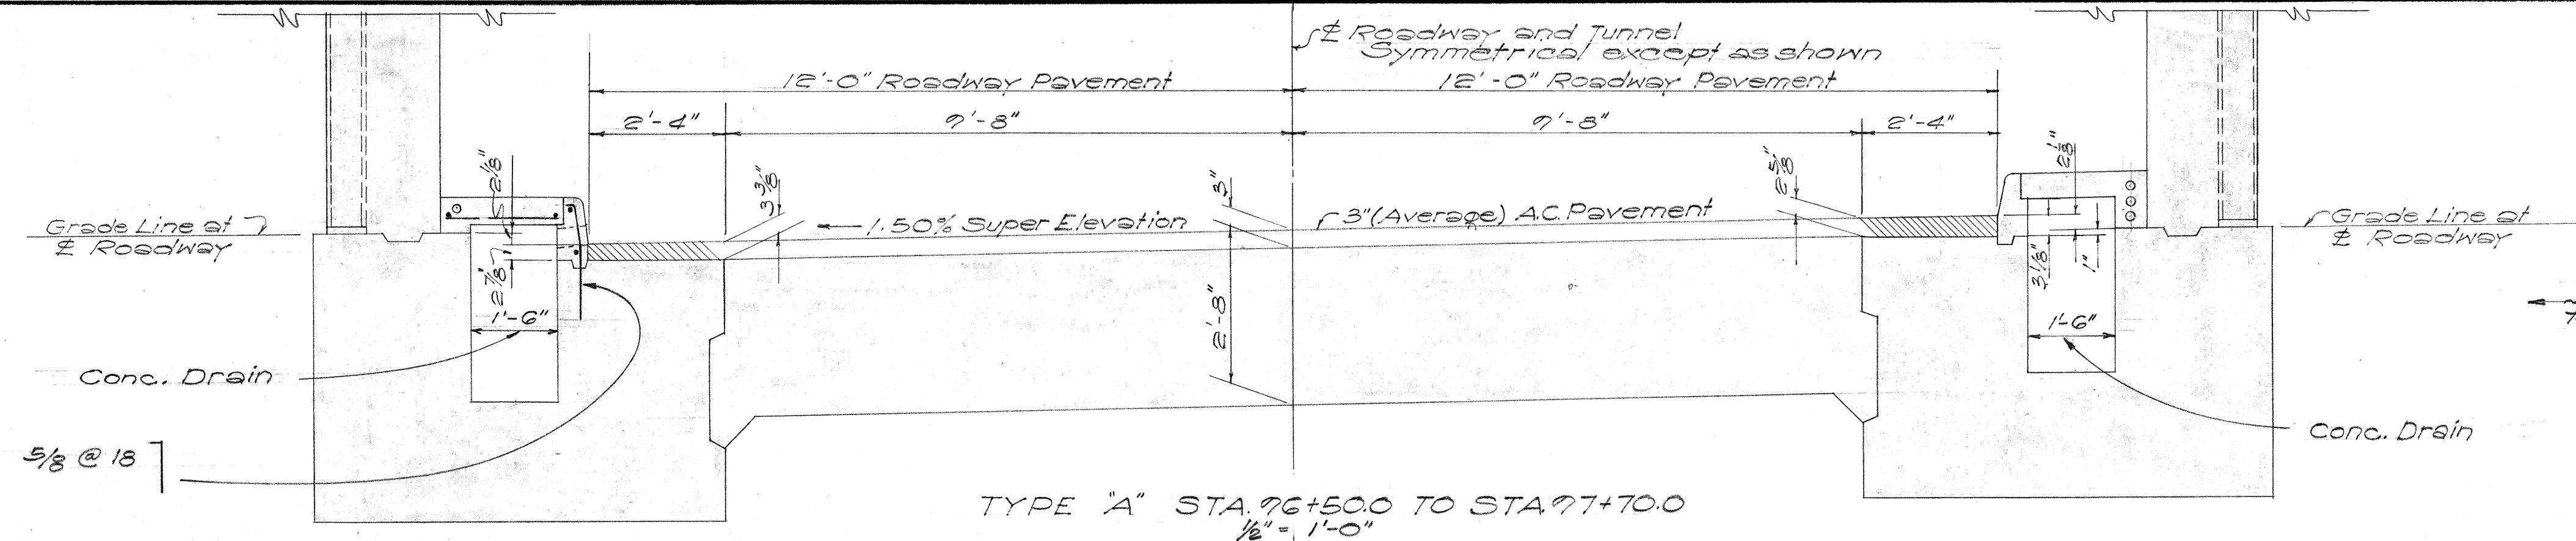

NOTE:
Typical detail of reinforcing bars in curb and walkway slab.

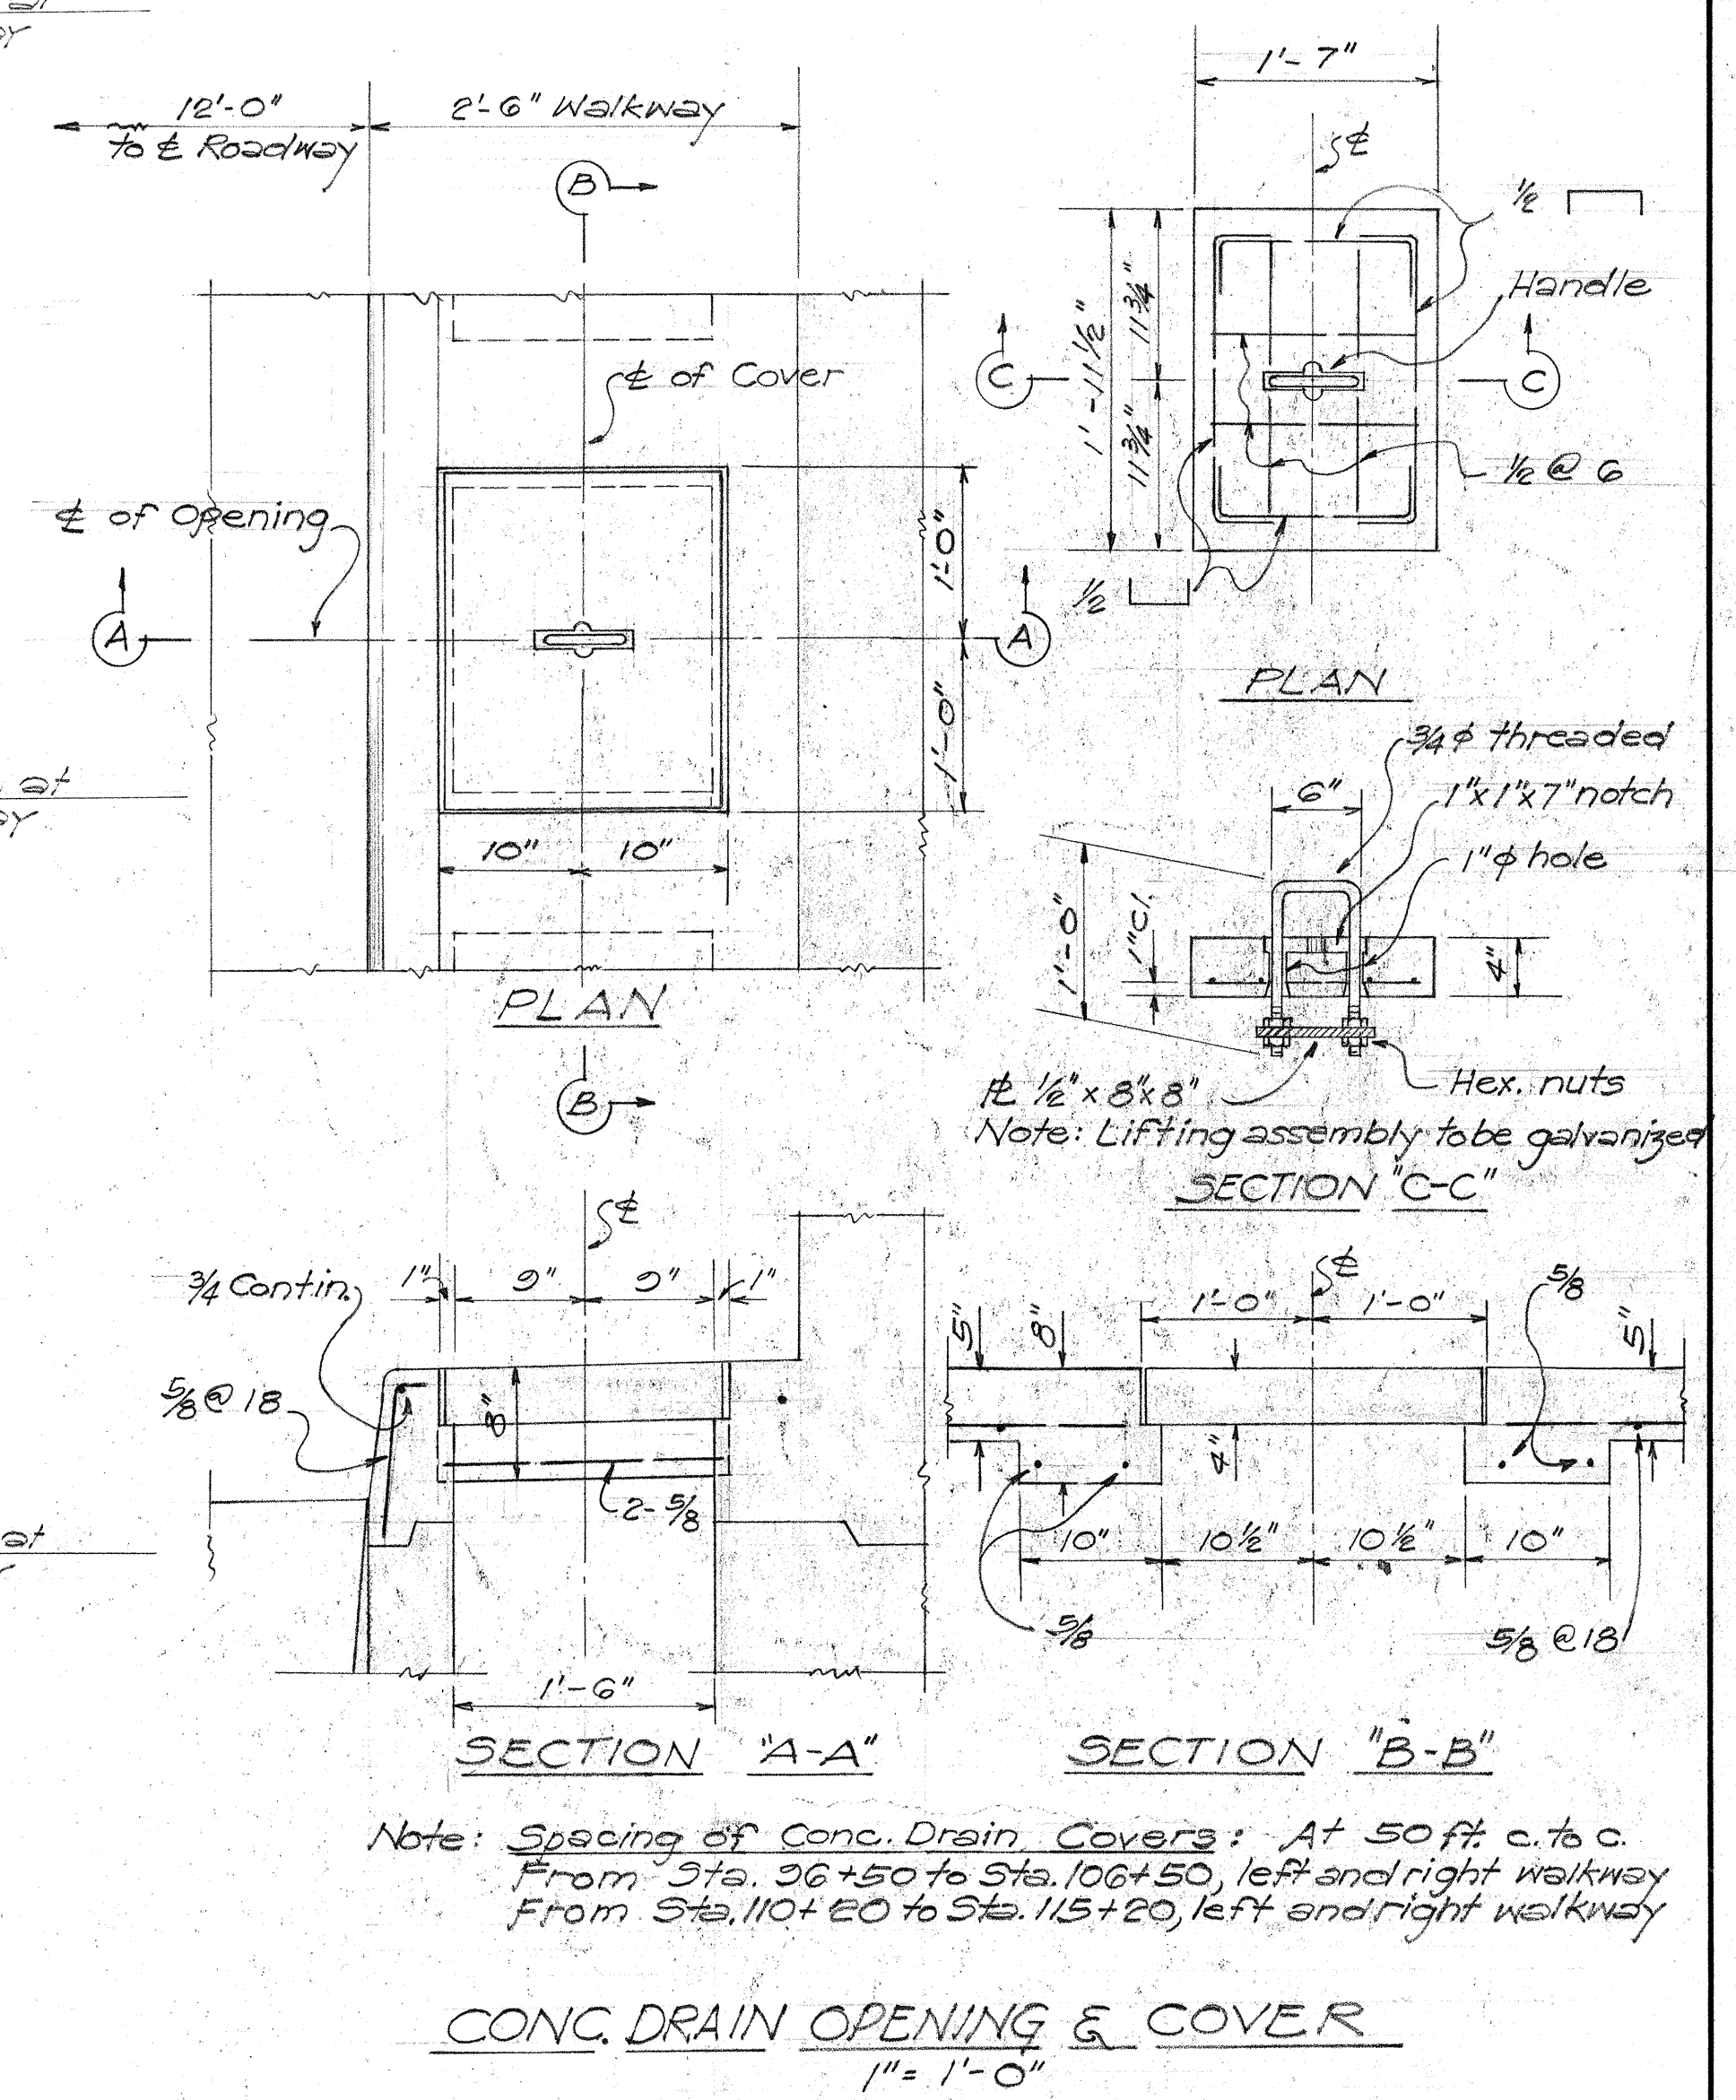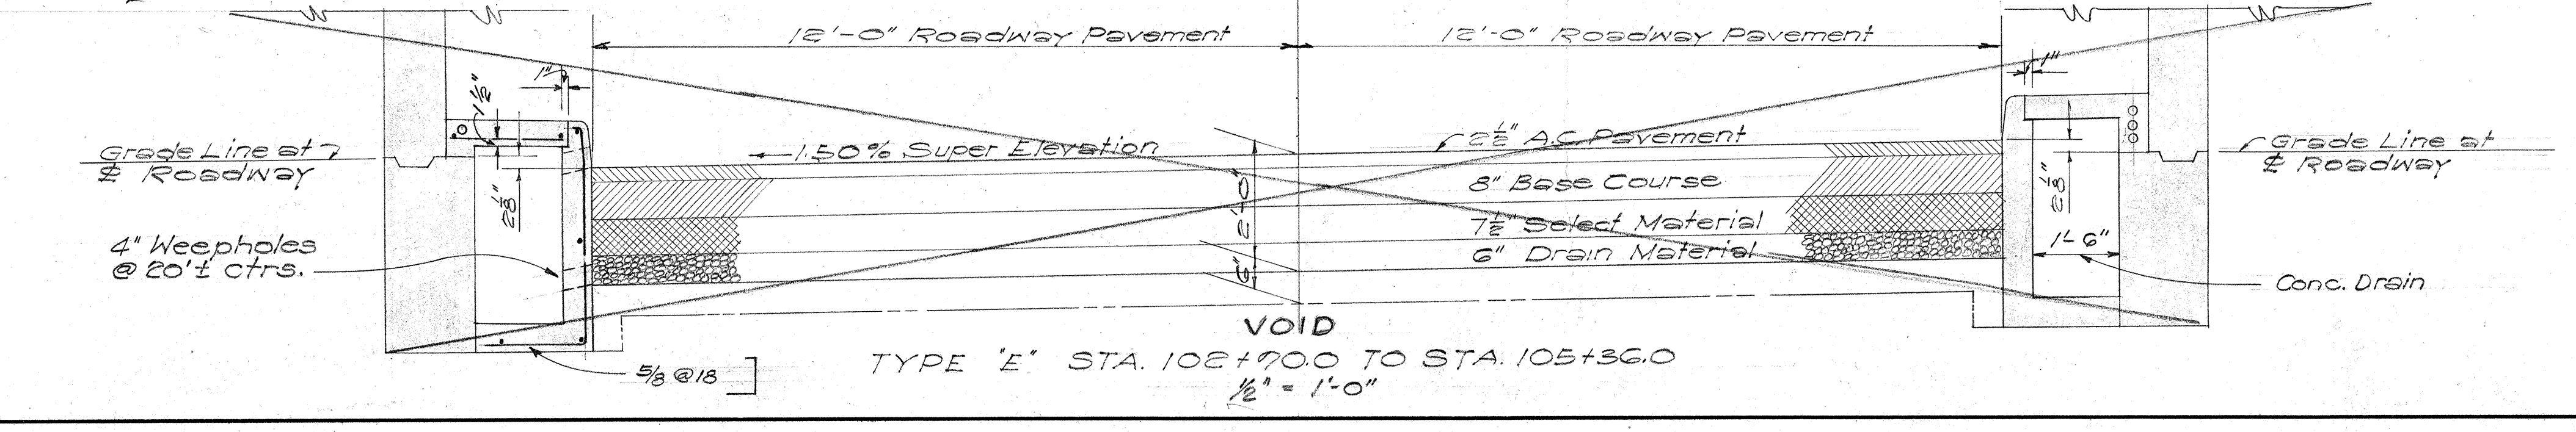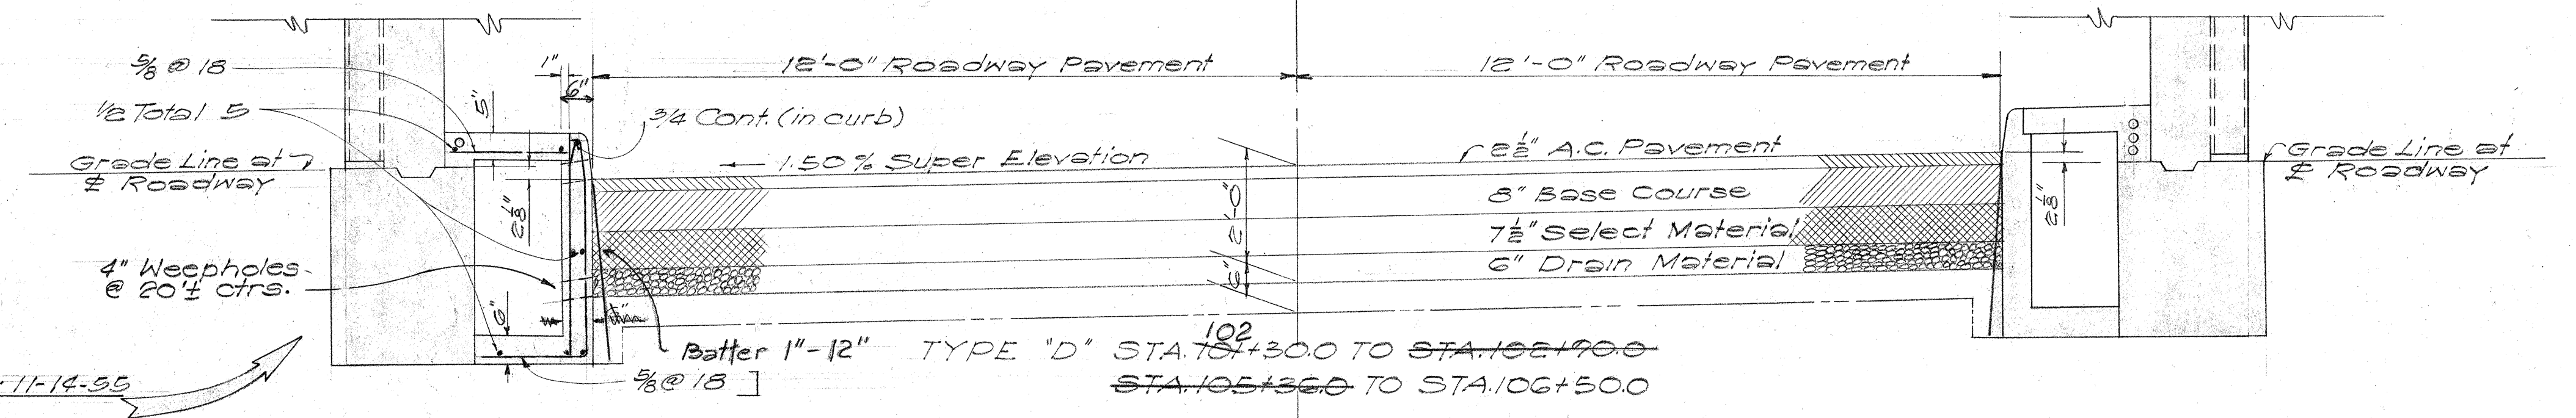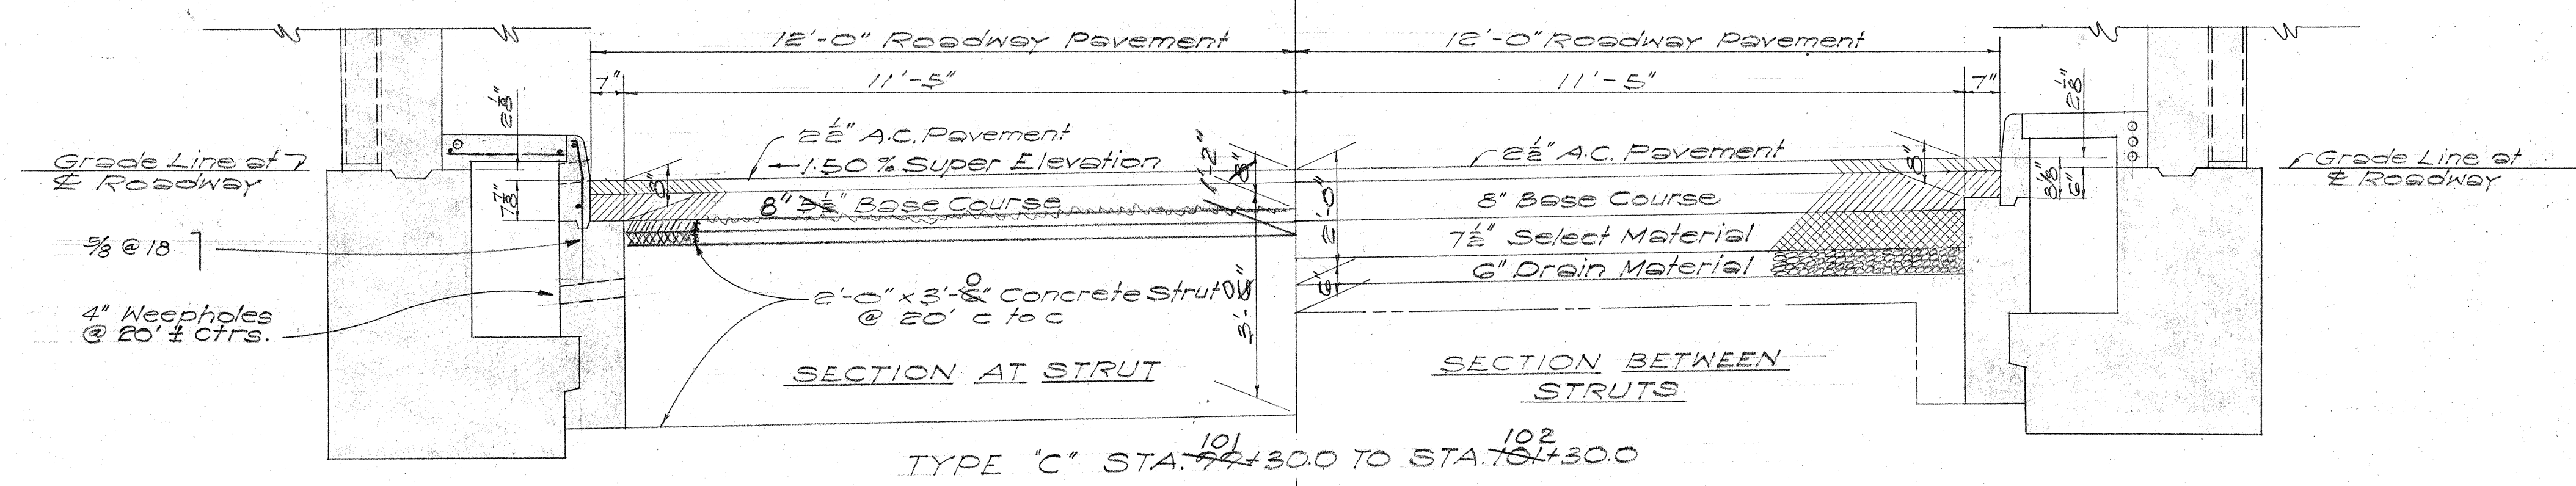
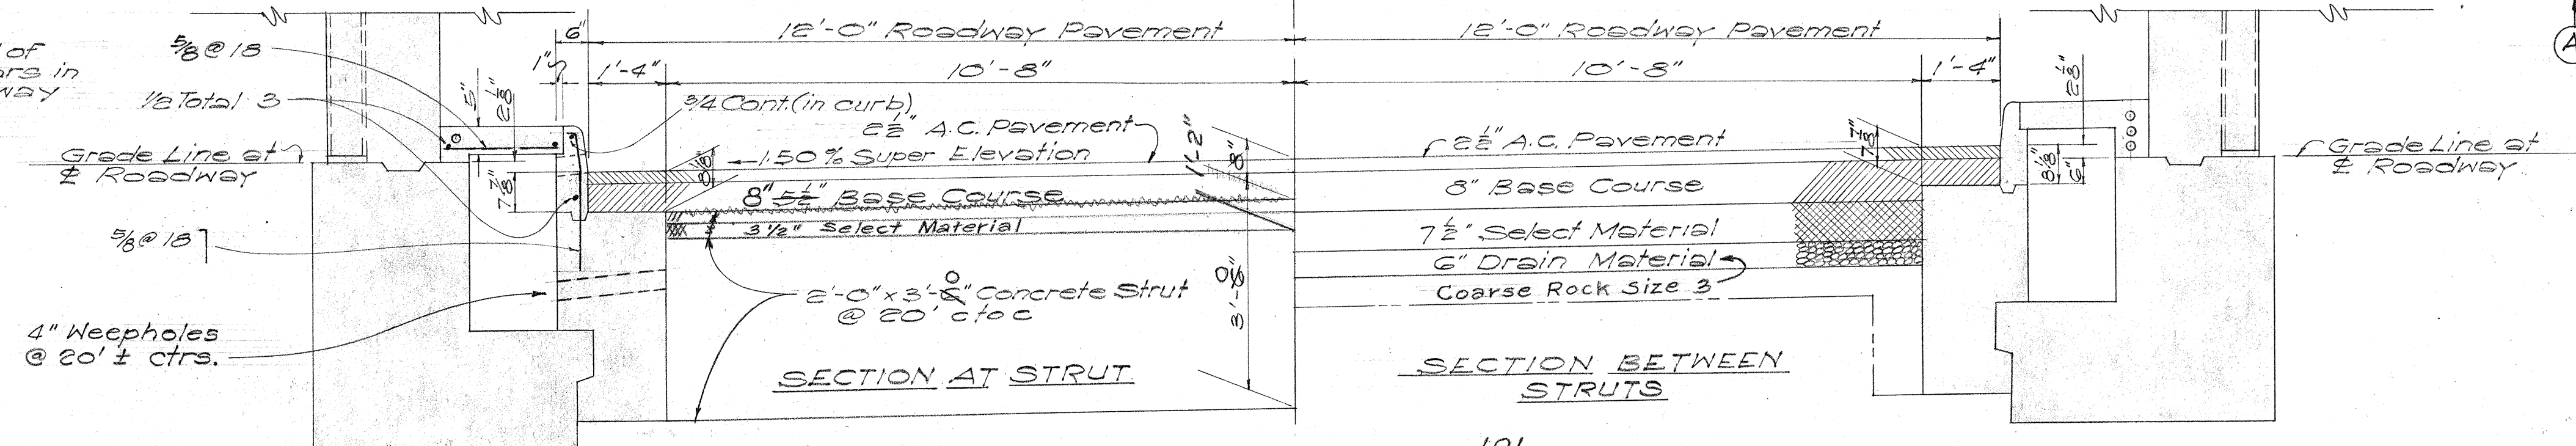


Note: Spacing of Conc. Drain Covers: At 50 ft. c. to c.
From Sta. 96+50 to Sta. 106+50, left and right walkway
From Sta. 110+50 to Sta. 115+20, left and right walkway




NOTE:
For trim lines and payment lines see "Typical Section A, Typical Section B, Typical Section C, Typical Section D and Typical Section E" sheets.

DESIGNED BY: [Signature]
CHECKED BY: [Signature]
DATE: 5/54
ORIGINAL PLAN NO. [Blank]
QUANTITIES BY: [Signature]
QUANTITIES CHECKED BY: [Signature]
CREATED BY: [Signature]

TERRITORIAL HIGHWAY DEPARTMENT
TERRITORY OF HAWAII
ROADWAY PAVEMENT @
NUUANU PALI TUNNELS
PALI ROAD
PROJ. No. SE16(5)
Scale: as noted June 1954
SHEET No. 39 OF 42 SHEETS

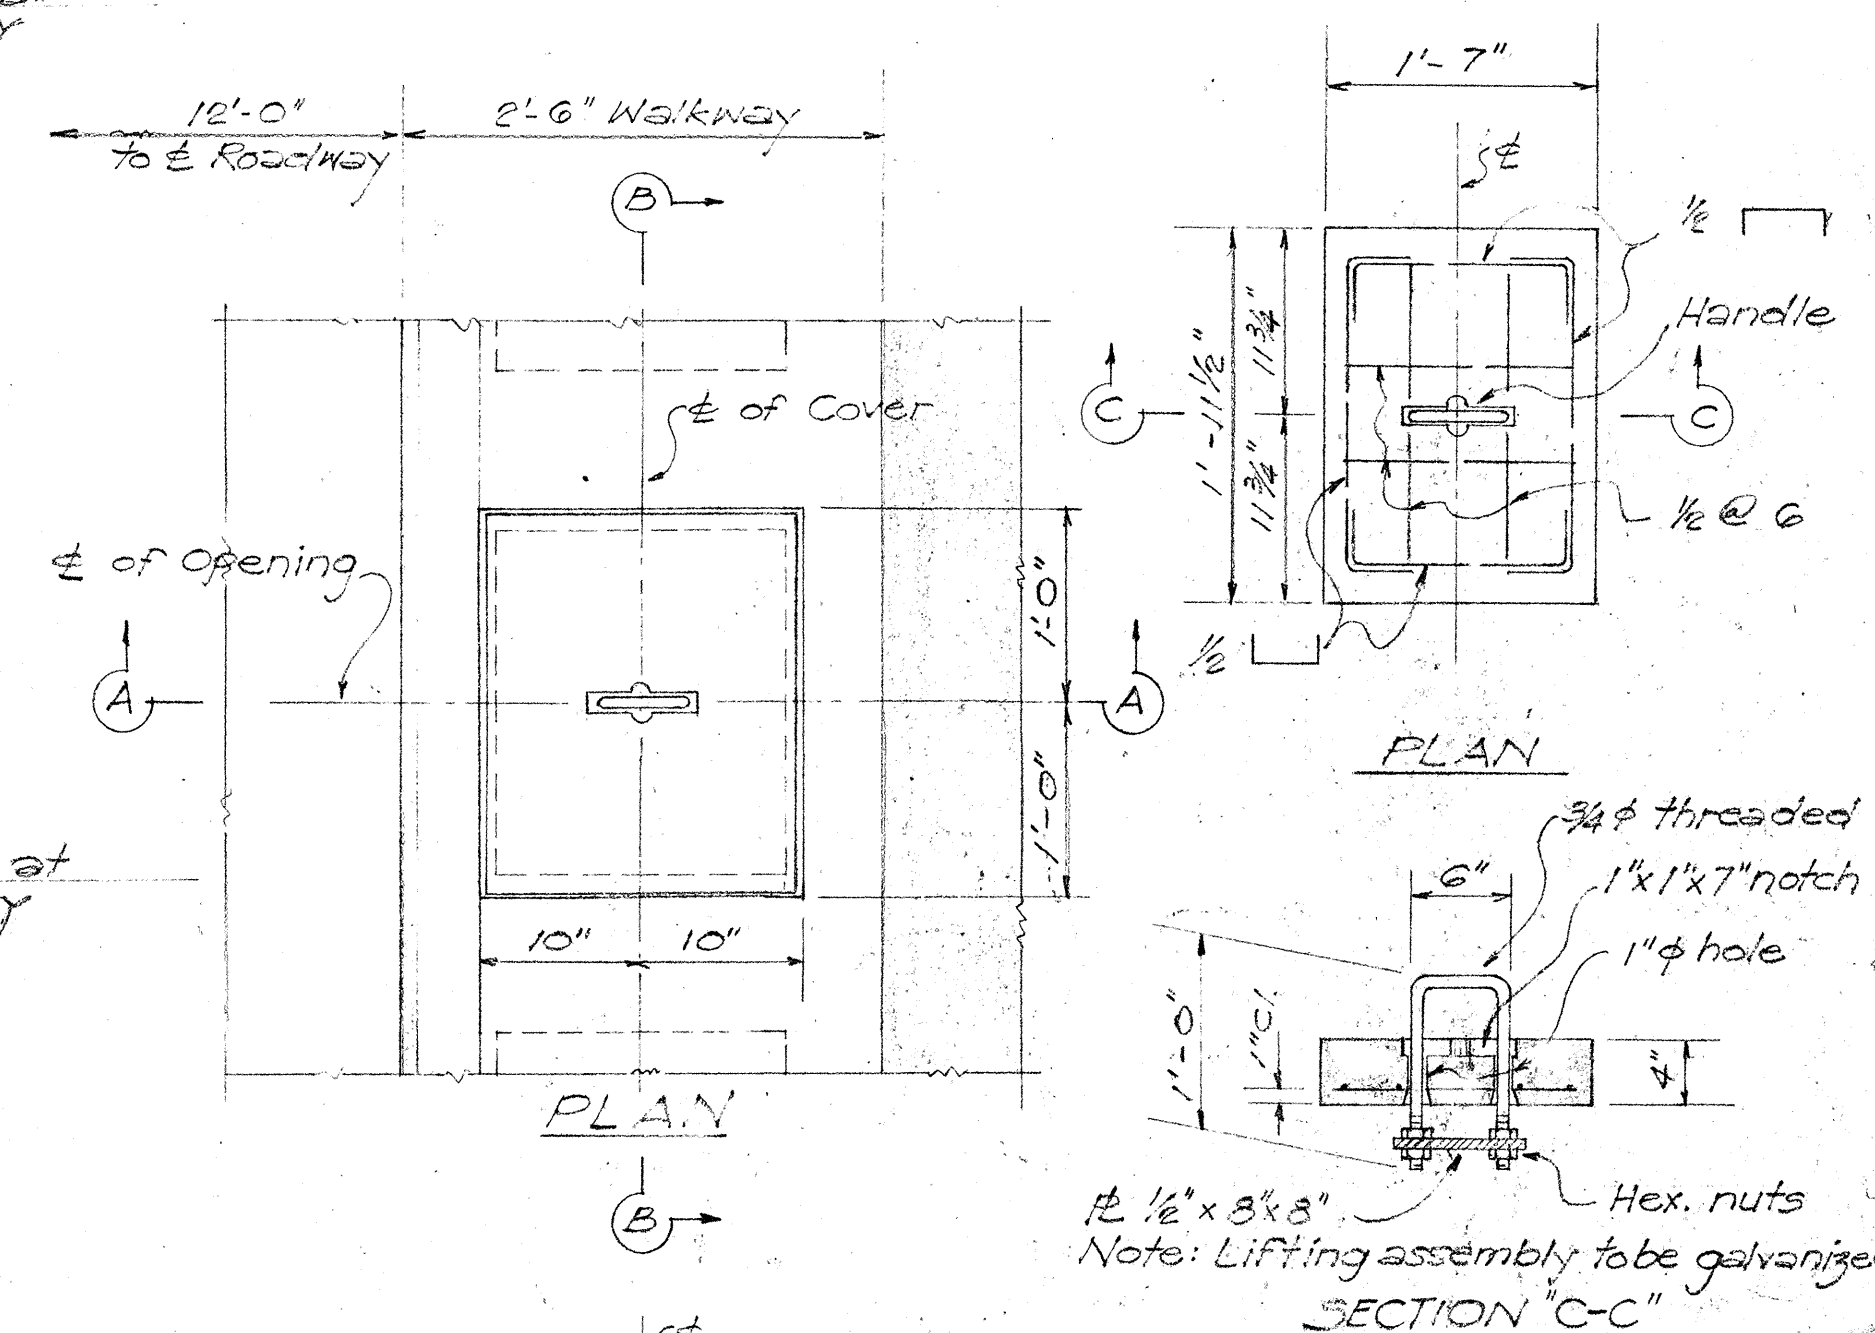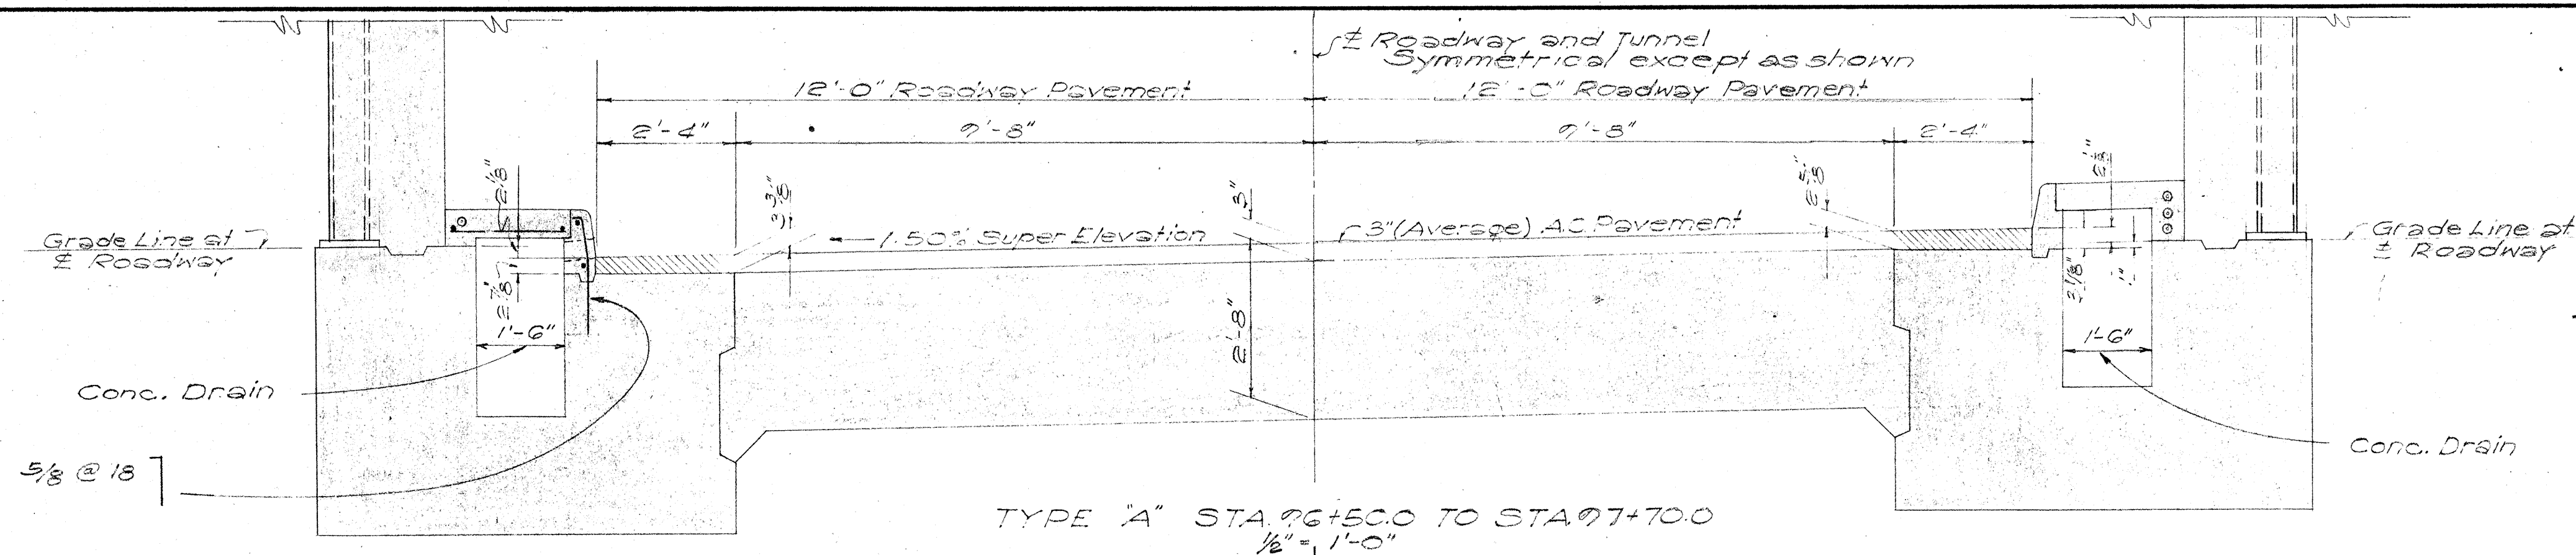



NOTE:
Typical detail of
reinforcing bars in
curb and walkway
slab.

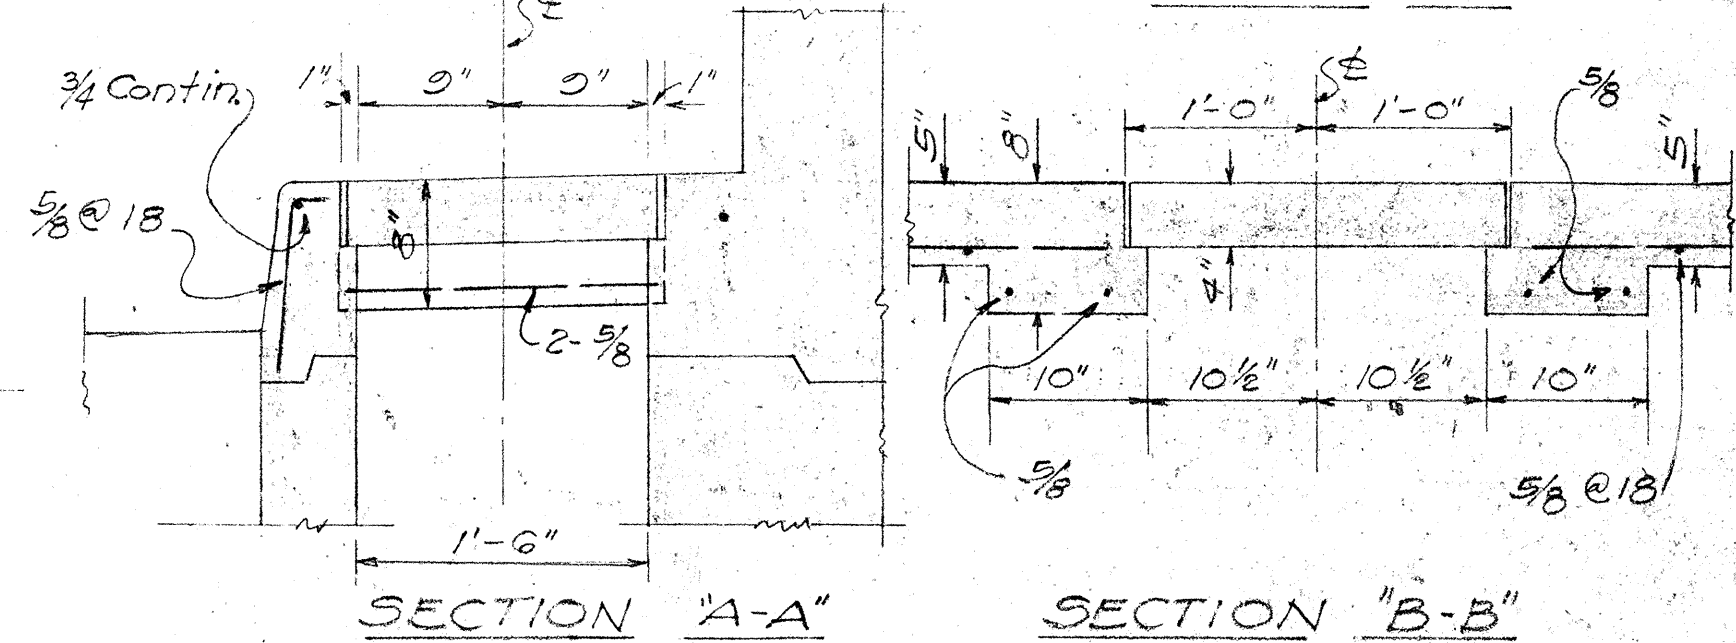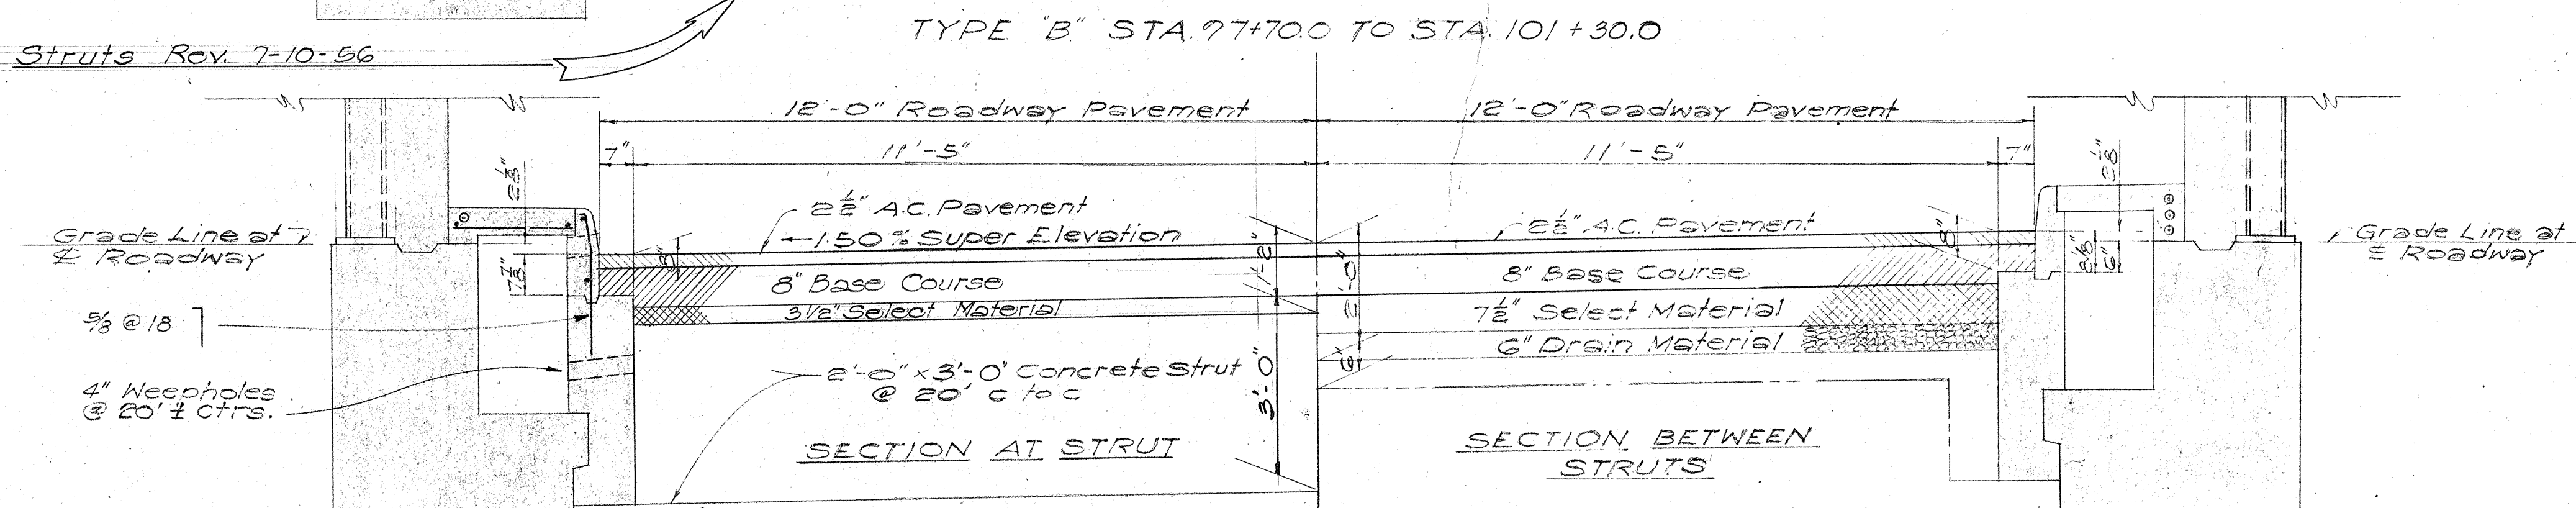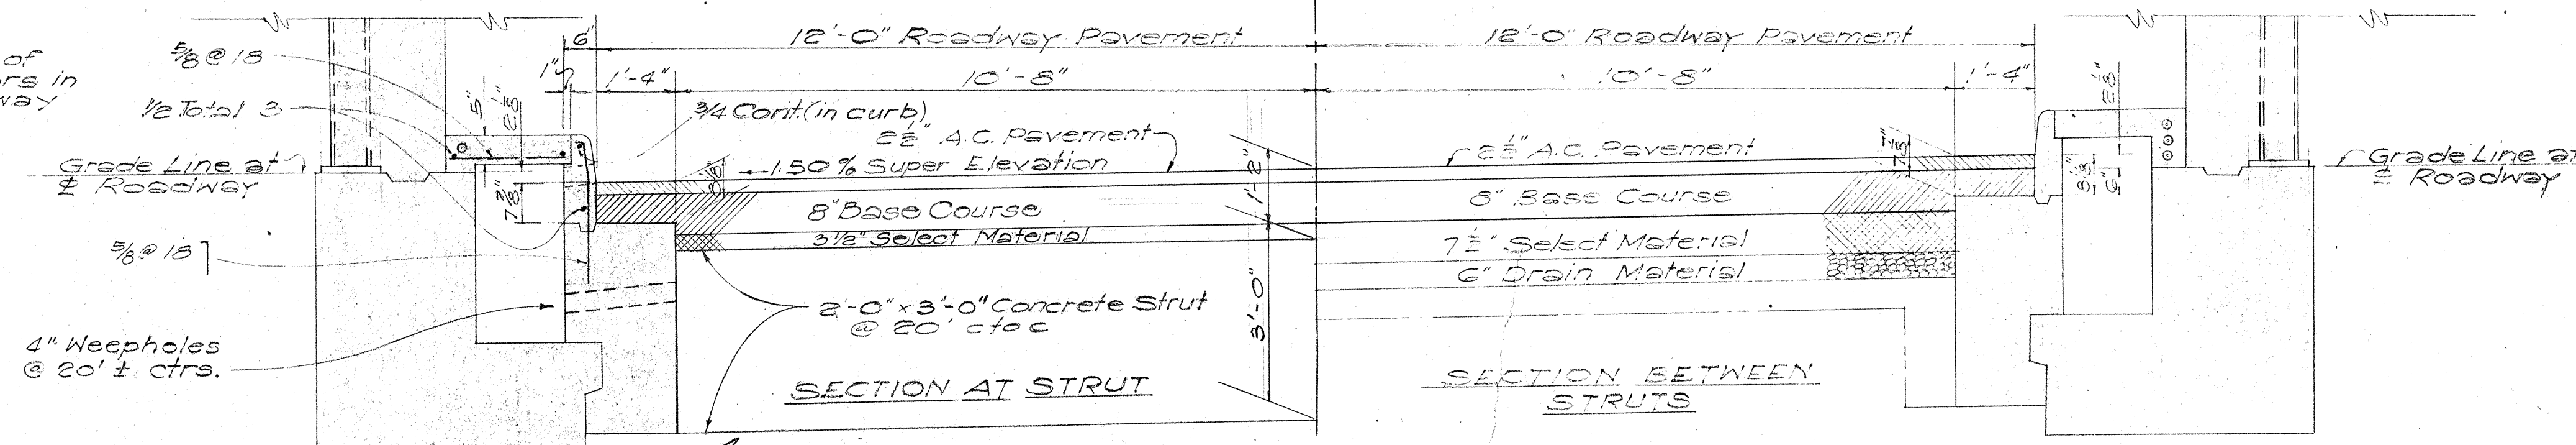

Note: Spacing of Conc. Drain Covers: At 50 ft. c. to c.
From Sta. 96+50 to Sta. 106+50, left and right walkway
From Sta. 110+50 to Sta. 115+20, left and right walkway

CONC. DRAIN OPENING & COVER
1/2" = 1'-0"

NOTE:
For trim lines and payment
lines see Typical Section A,
Typical Section B, Typical
Section C, Typical Section D
and Typical Section E sheets.

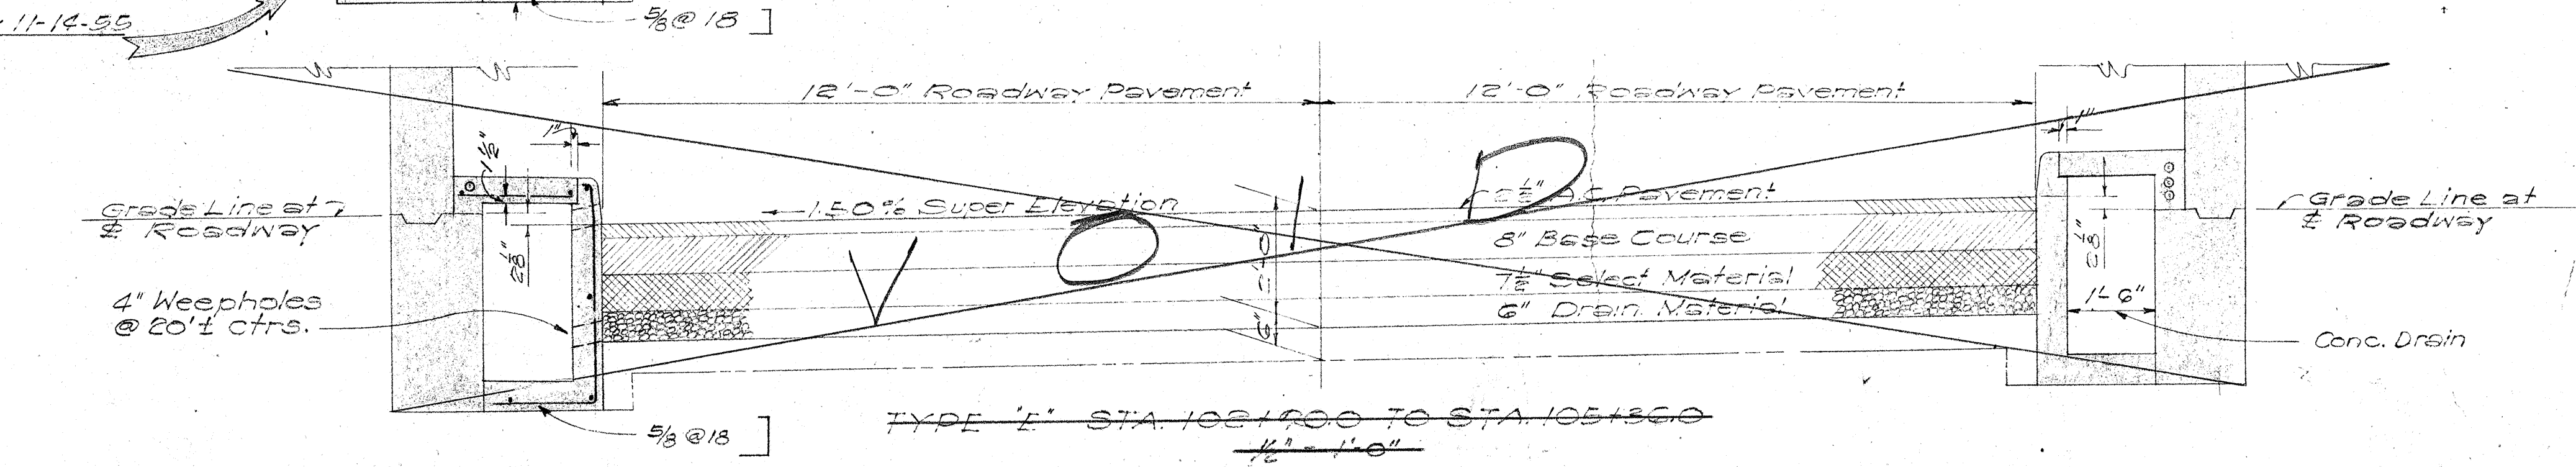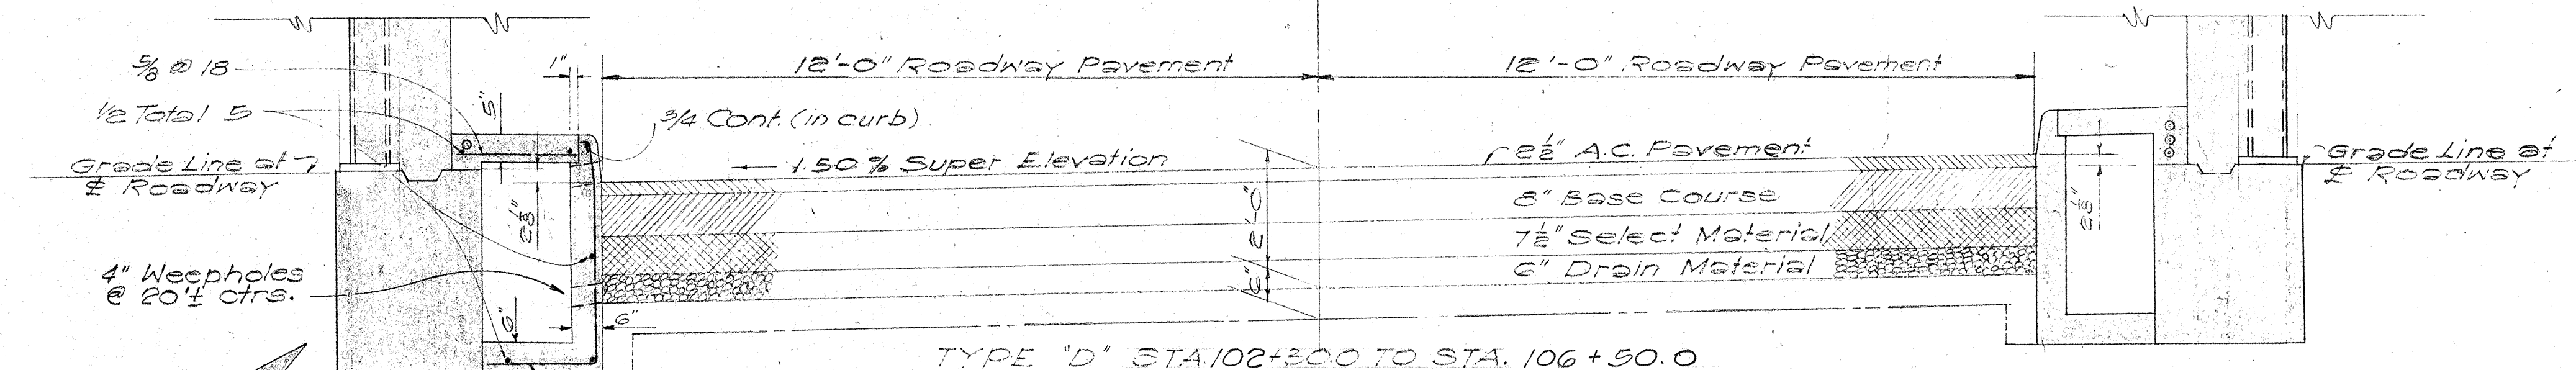

TERRITORIAL HIGHWAY DEPARTMENT
TERRITORY OF HAWAII
ROADWAY PAVEMENT &
NUUANU PALI TUNNELS
PALI ROAD
PROJ. No. SEIG(5)
Scale: as noted June 1954

SHEET No. 39 OF 42 SHEETS

5708.395

DATE: 5/54
DESIGNED BY: J.A. & J. J. J.
DRAWN BY: J.C.
CHECKED BY: J.M. F.
NOTE BOOK NO. 100