


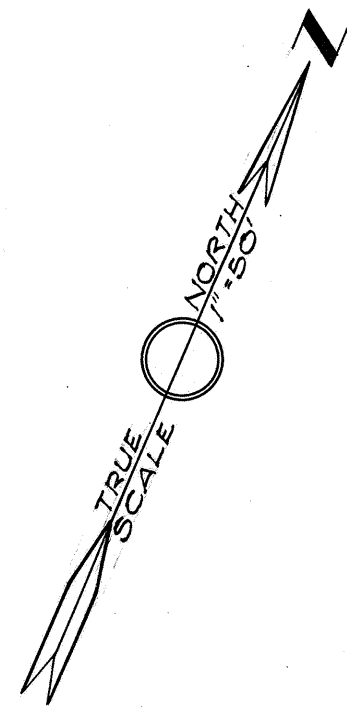



BEG. OF PROJ. S 216(5)
STA. P.C. 78+38.62

Install additional No. plate for F.A. Marker

Note:
Numbers shown thus 3:45 are parabolic flare curves. See Standard Details. (Ratio Curve)

- NOTES:
- The locations and lengths of culverts here shown on these plans are approximate only. The Resident Engineer shall determine the exact locations, invert elevations and grades for each culvert and adjust the quantities for the various items accordingly.
 - All Curbs and Gutters are to be Cast-in-place using Class "A-1" Concrete.
 - All Curbs shall be Type "A" unless otherwise shown.
 - Transitions between various types of curbs and gutters shall be smooth and pleasing to the eye.
 - All Φ and C.C. Standard Street Monuments shall be installed according to the Right-of-Way Maps.
 - All leveling and wearing surfaces shall be of Asphaltic Concrete. See Typical Sections.
 - All Azimuths are referred to Kailua Triangulation Station.
 - Datum - Elevation referred to Mean Sea Level.
 - Payment of Overhaul shall be incidental to each type of excavation.
 - All Culvert pipes are to be of standard strength reinforced concrete unless otherwise noted as extra strength (E.S.).
 - Electrical Details are not shown. See Electrical Plans.
 - All type "G" catch basins, culvert pipes between type "G" catch basins, culvert pipes leading away from type "G" catch basins, and for drains between type "G" catch basins and tunnel portals shall be included as part of the tunnel drainage system. See "Drainage Structures" Sheet 40.

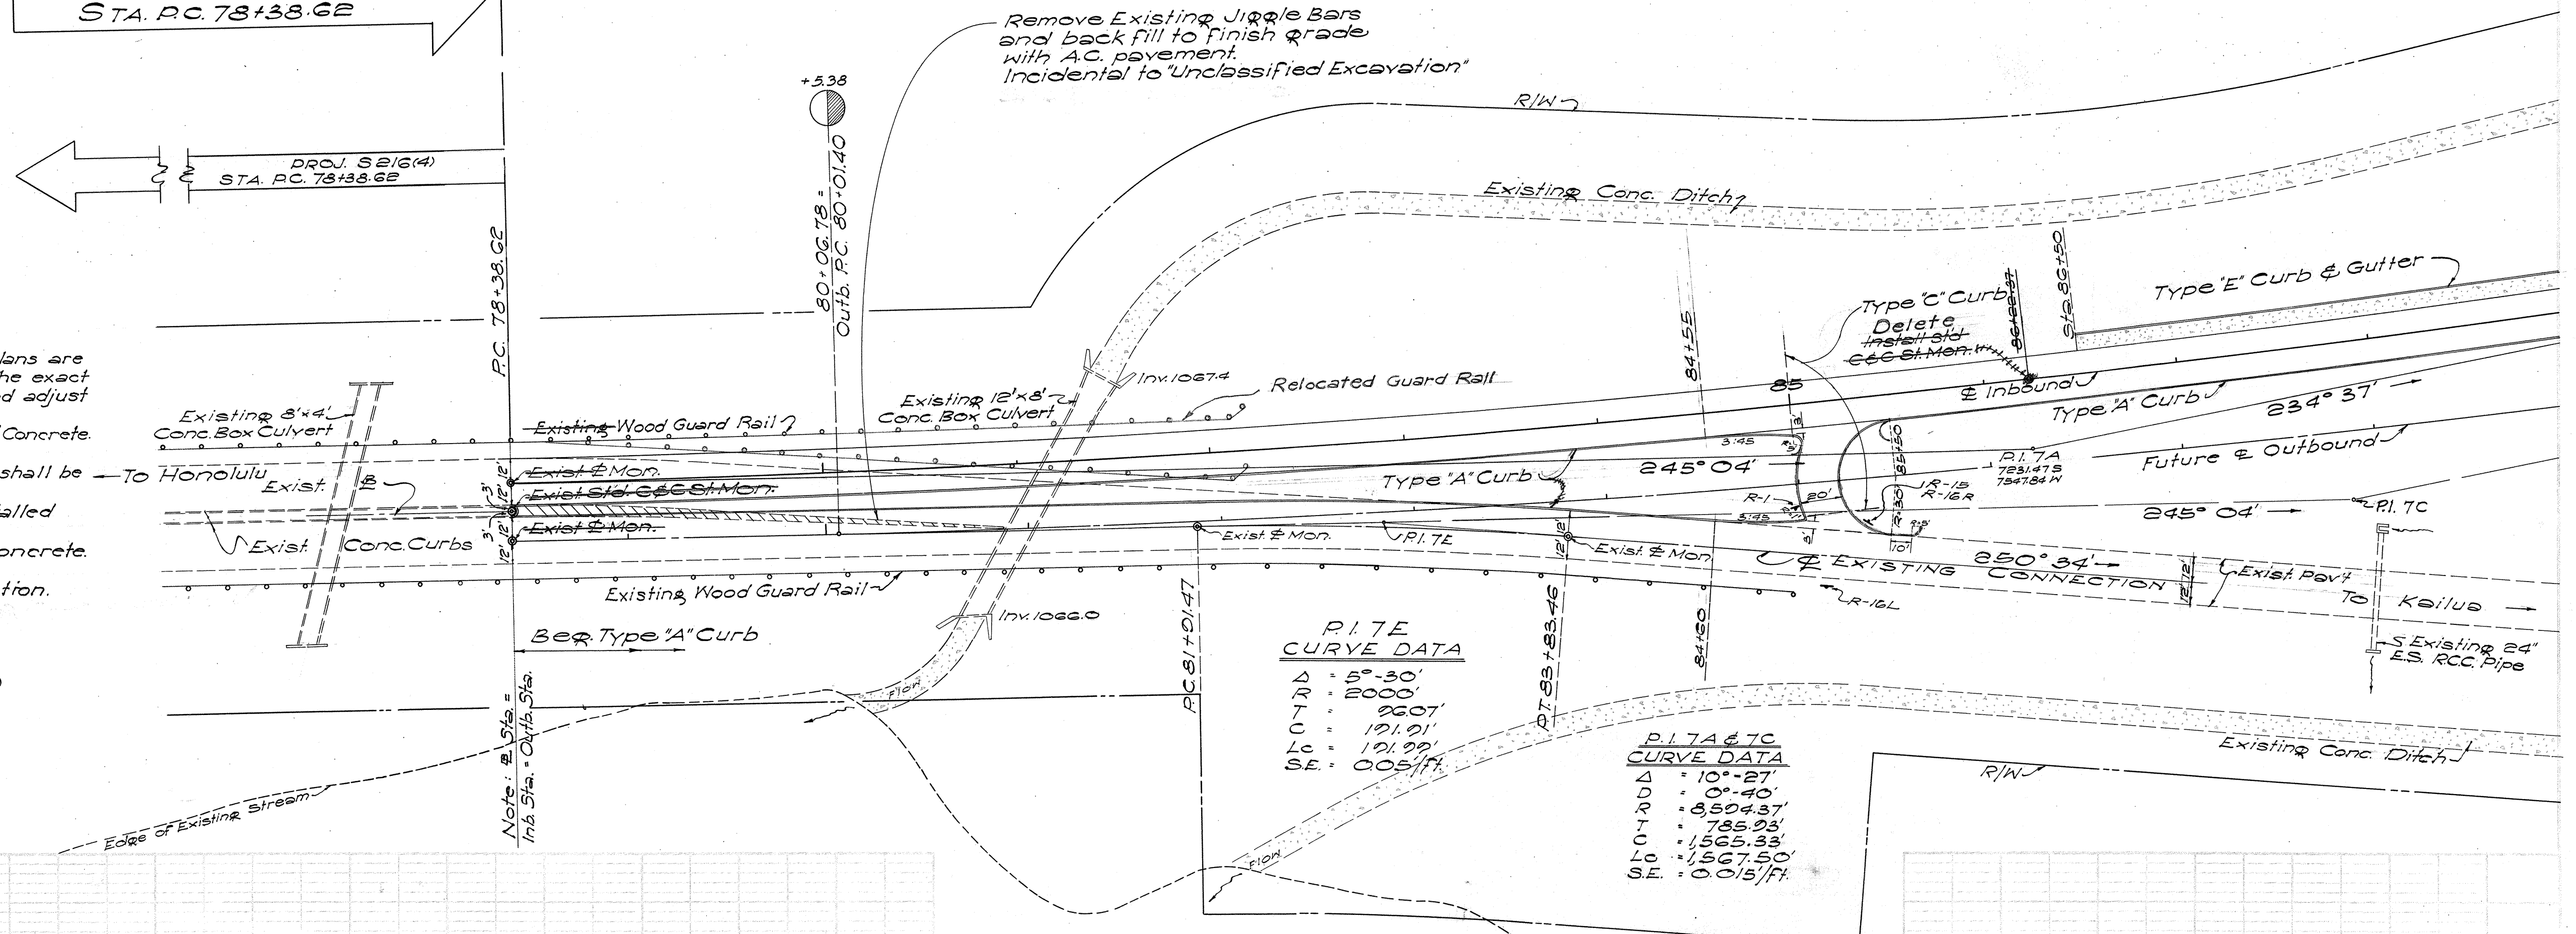


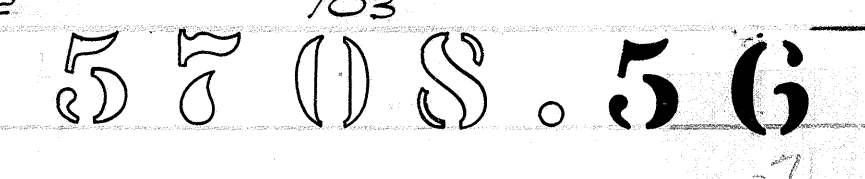


PLAN
 SURVEYED
 NOTE: DATA CHECKED
 DATE: 11-11-54

PROFILE
 SURVEYED
 NOTE: DATA CHECKED
 DATE: 11-11-54

FED. ROAD DIST. No.	STATE	FED. AID PROJ. No.	FISCAL YEAR	SHEET No.	TOTAL SHEETS
HAWAII	HAW.	521(5)	1954	58	112

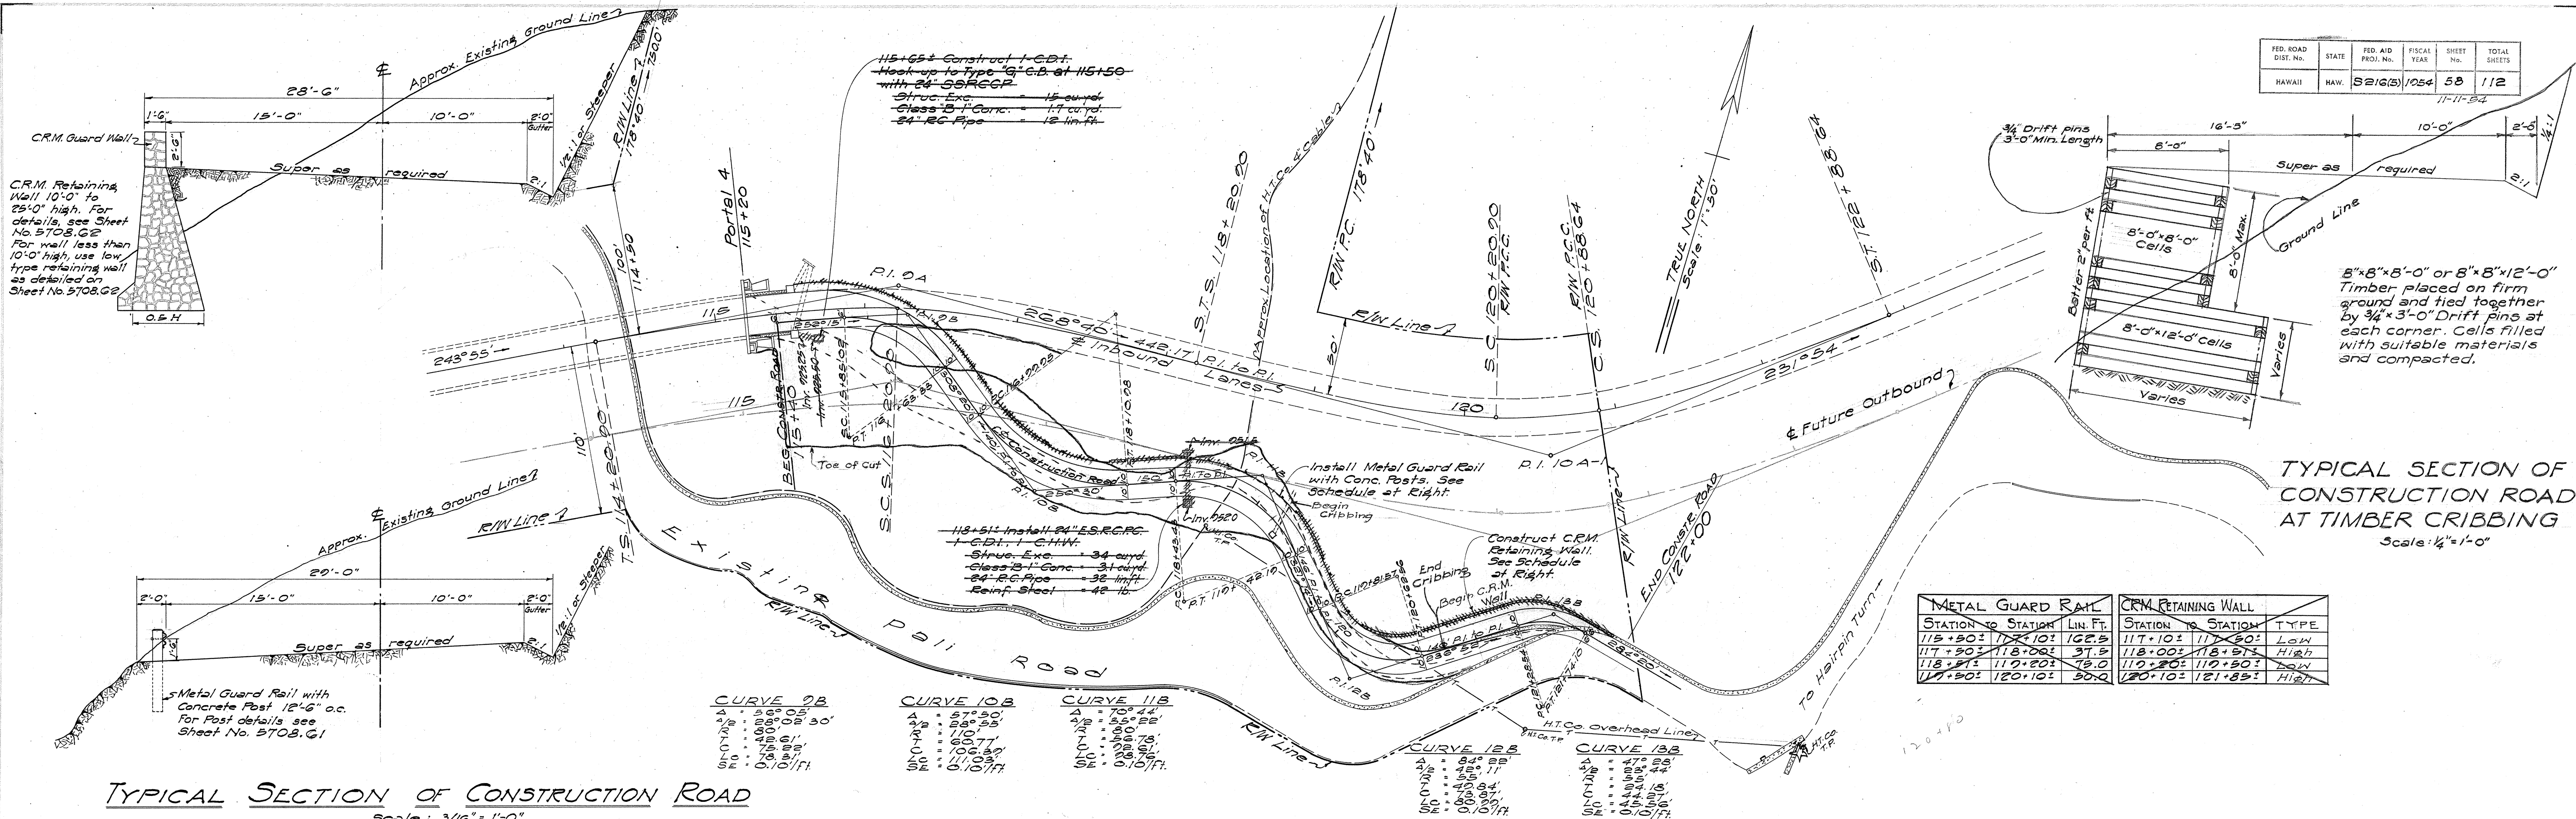

TYPICAL SECTION OF CONSTRUCTION ROAD
 Scale: 3/16" = 1'-0"

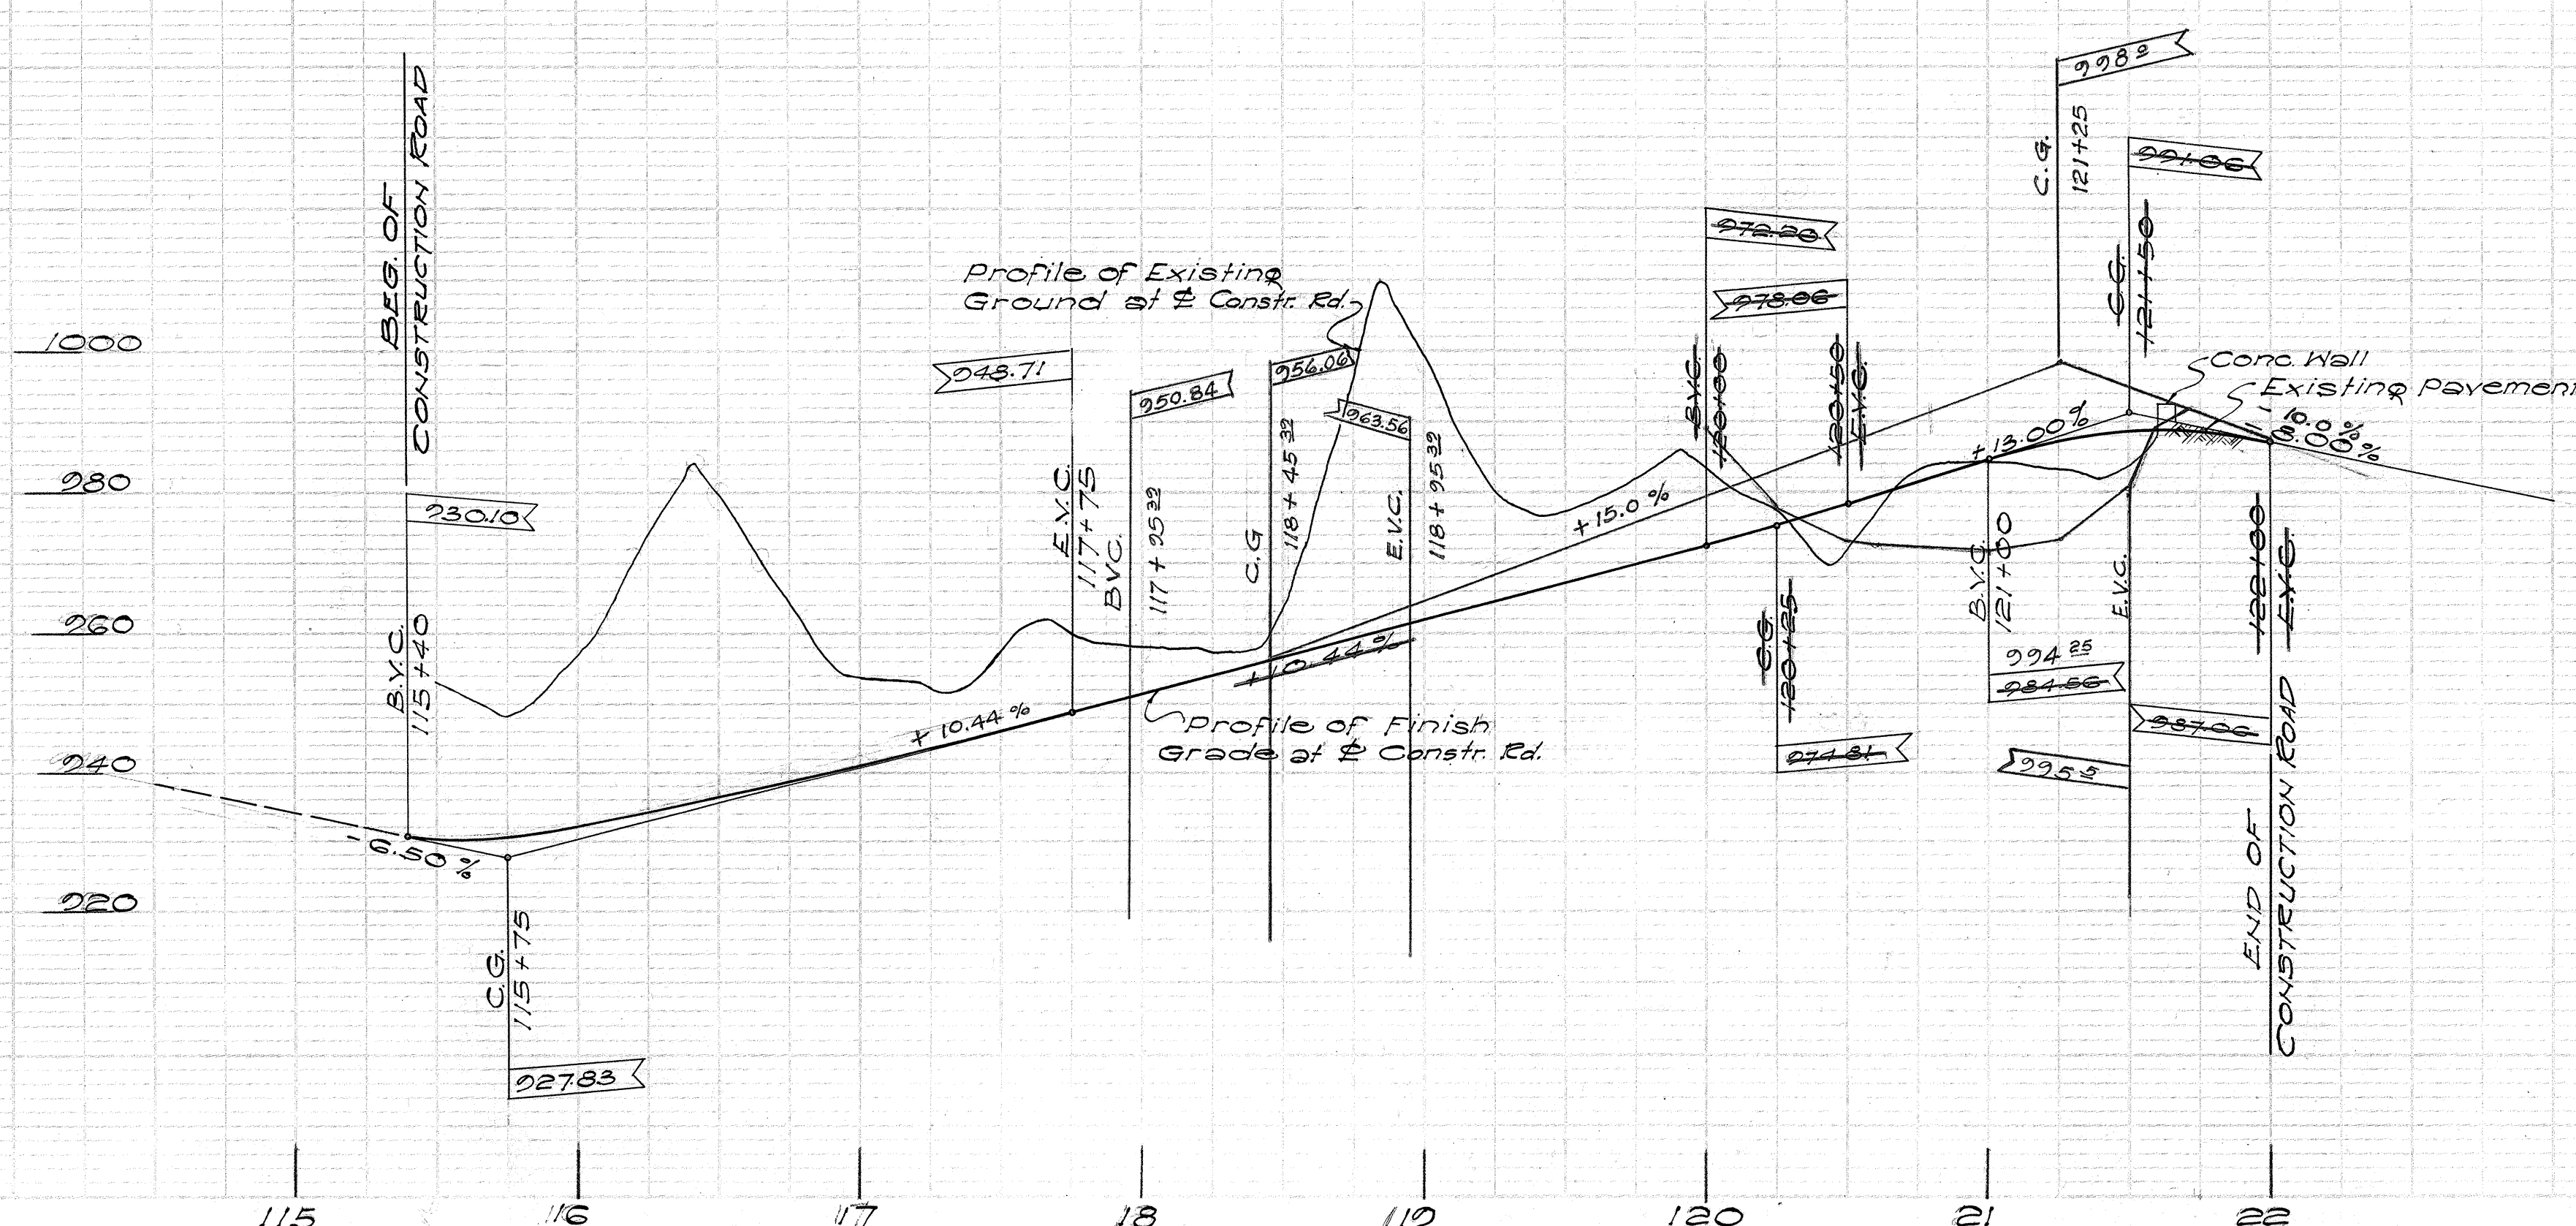

TERRITORIAL HIGHWAY DEPARTMENT
 TERRITORY OF HAWAII
**DETAILS OF
 CONSTRUCTION ROAD**
 PALI ROAD
 PROJ. No. 5 EIG (5)
 Scale as noted Aug. 1954