



FED. ROAD DIST. NO.	STATE	FED. AID PROJ. NO.	FISCAL YEAR	SHEET NO.	TOTAL SHEETS
42-50-54	HAWAII	52125	1954	109	112

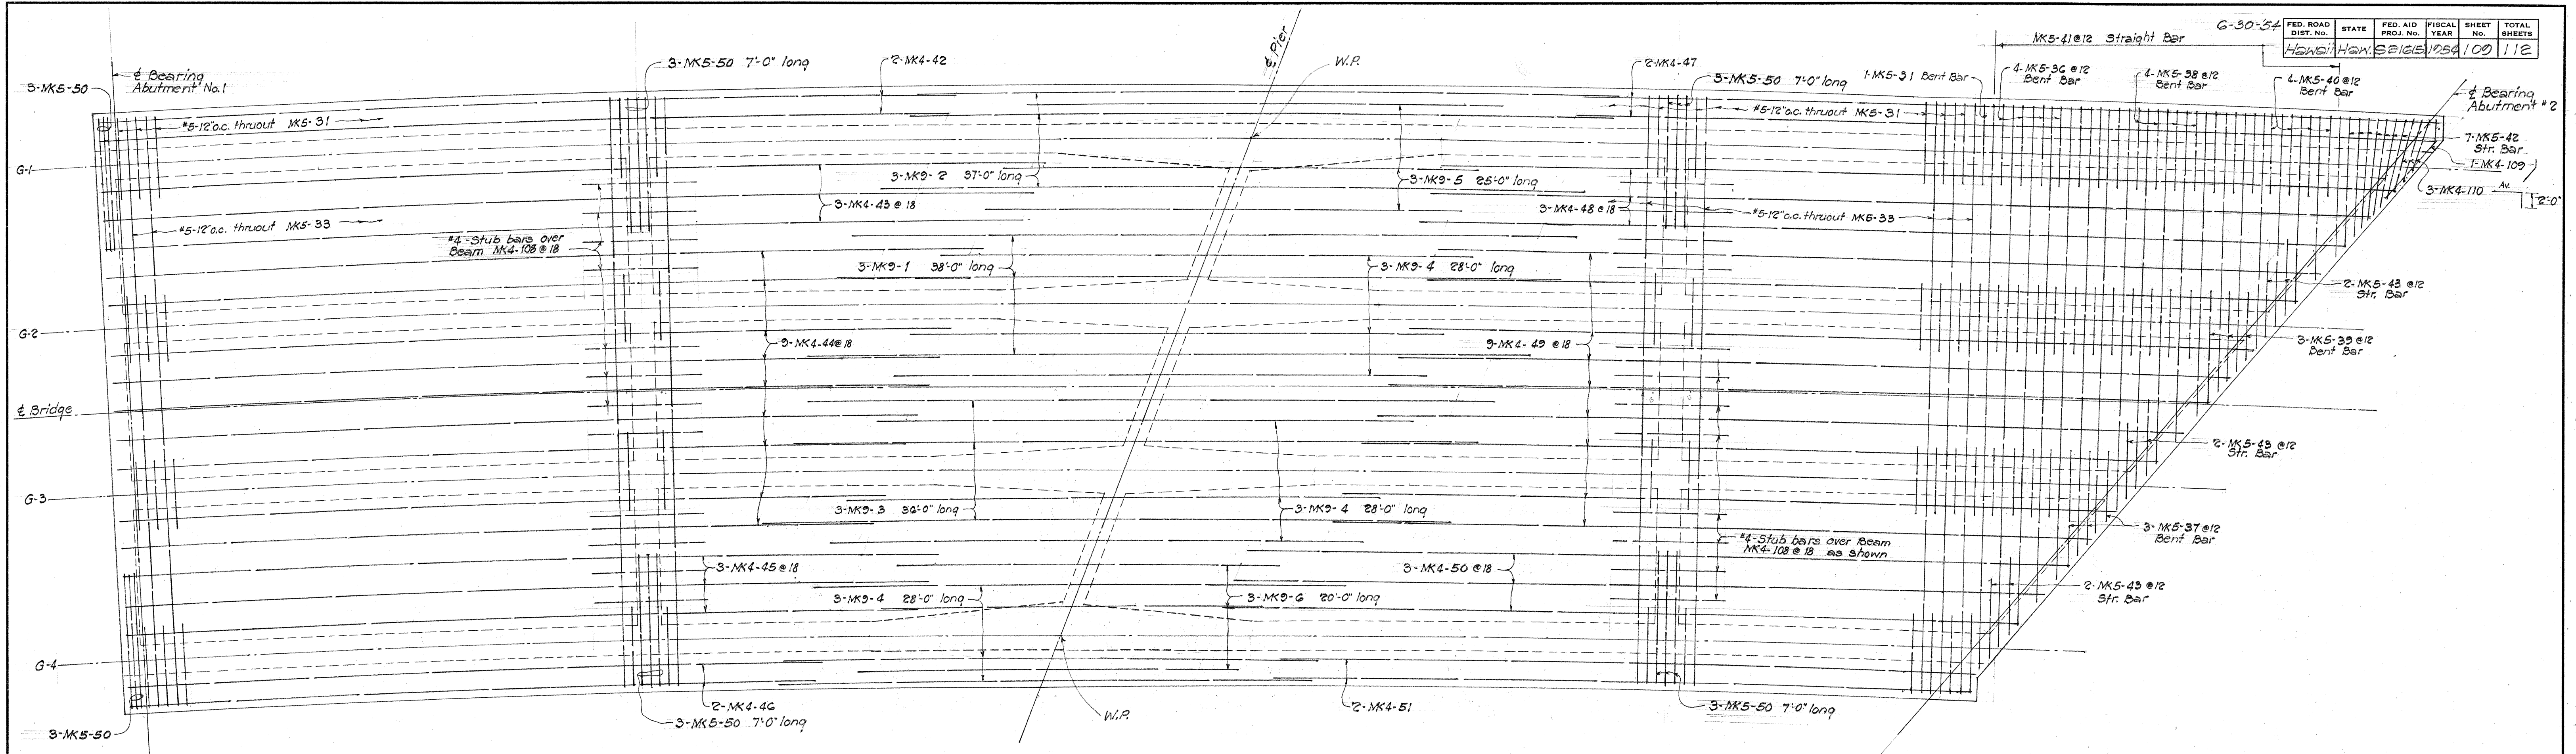


DECK SLAB REINFORCEMENT TOP LAYER
Scale 1/4" = 1'-0"


Note: Transverse reinforcement to be laid radially

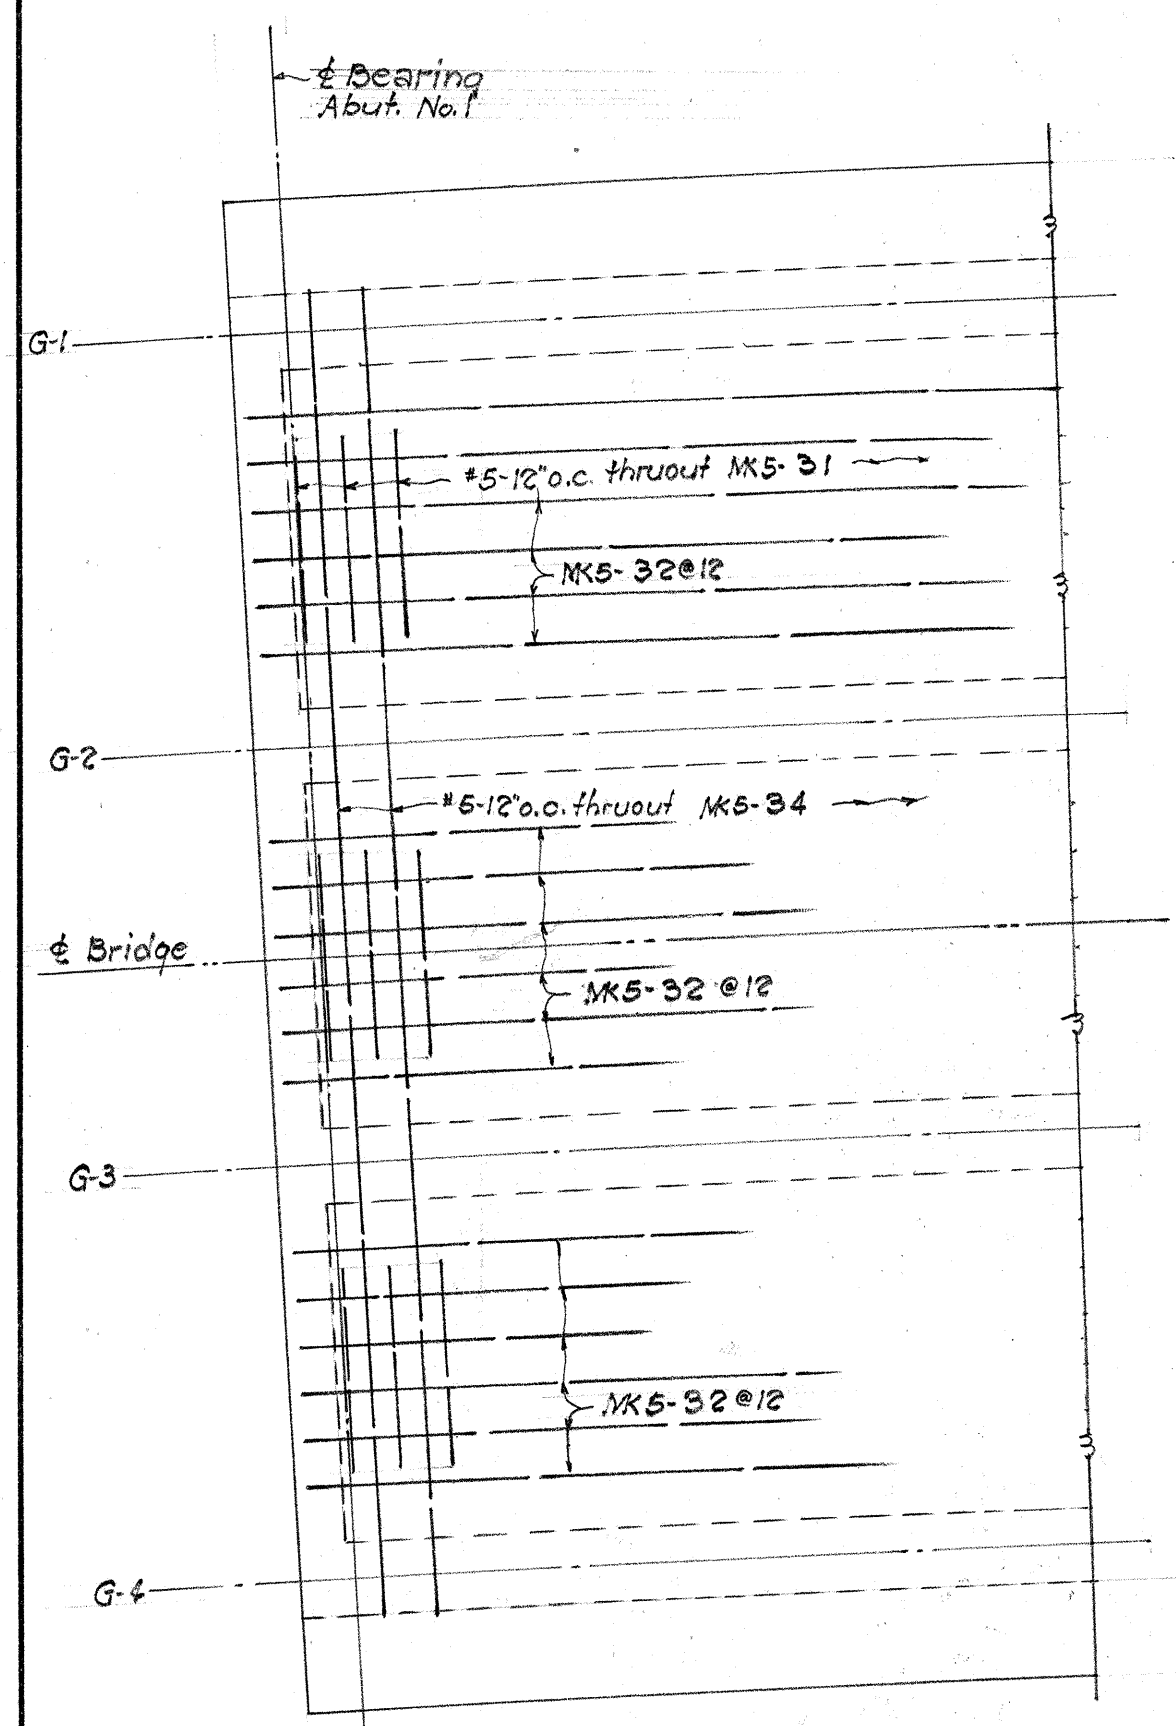

PART-SLAB REINF.
Bottom Layer
Scale 1/4" = 1'-0"

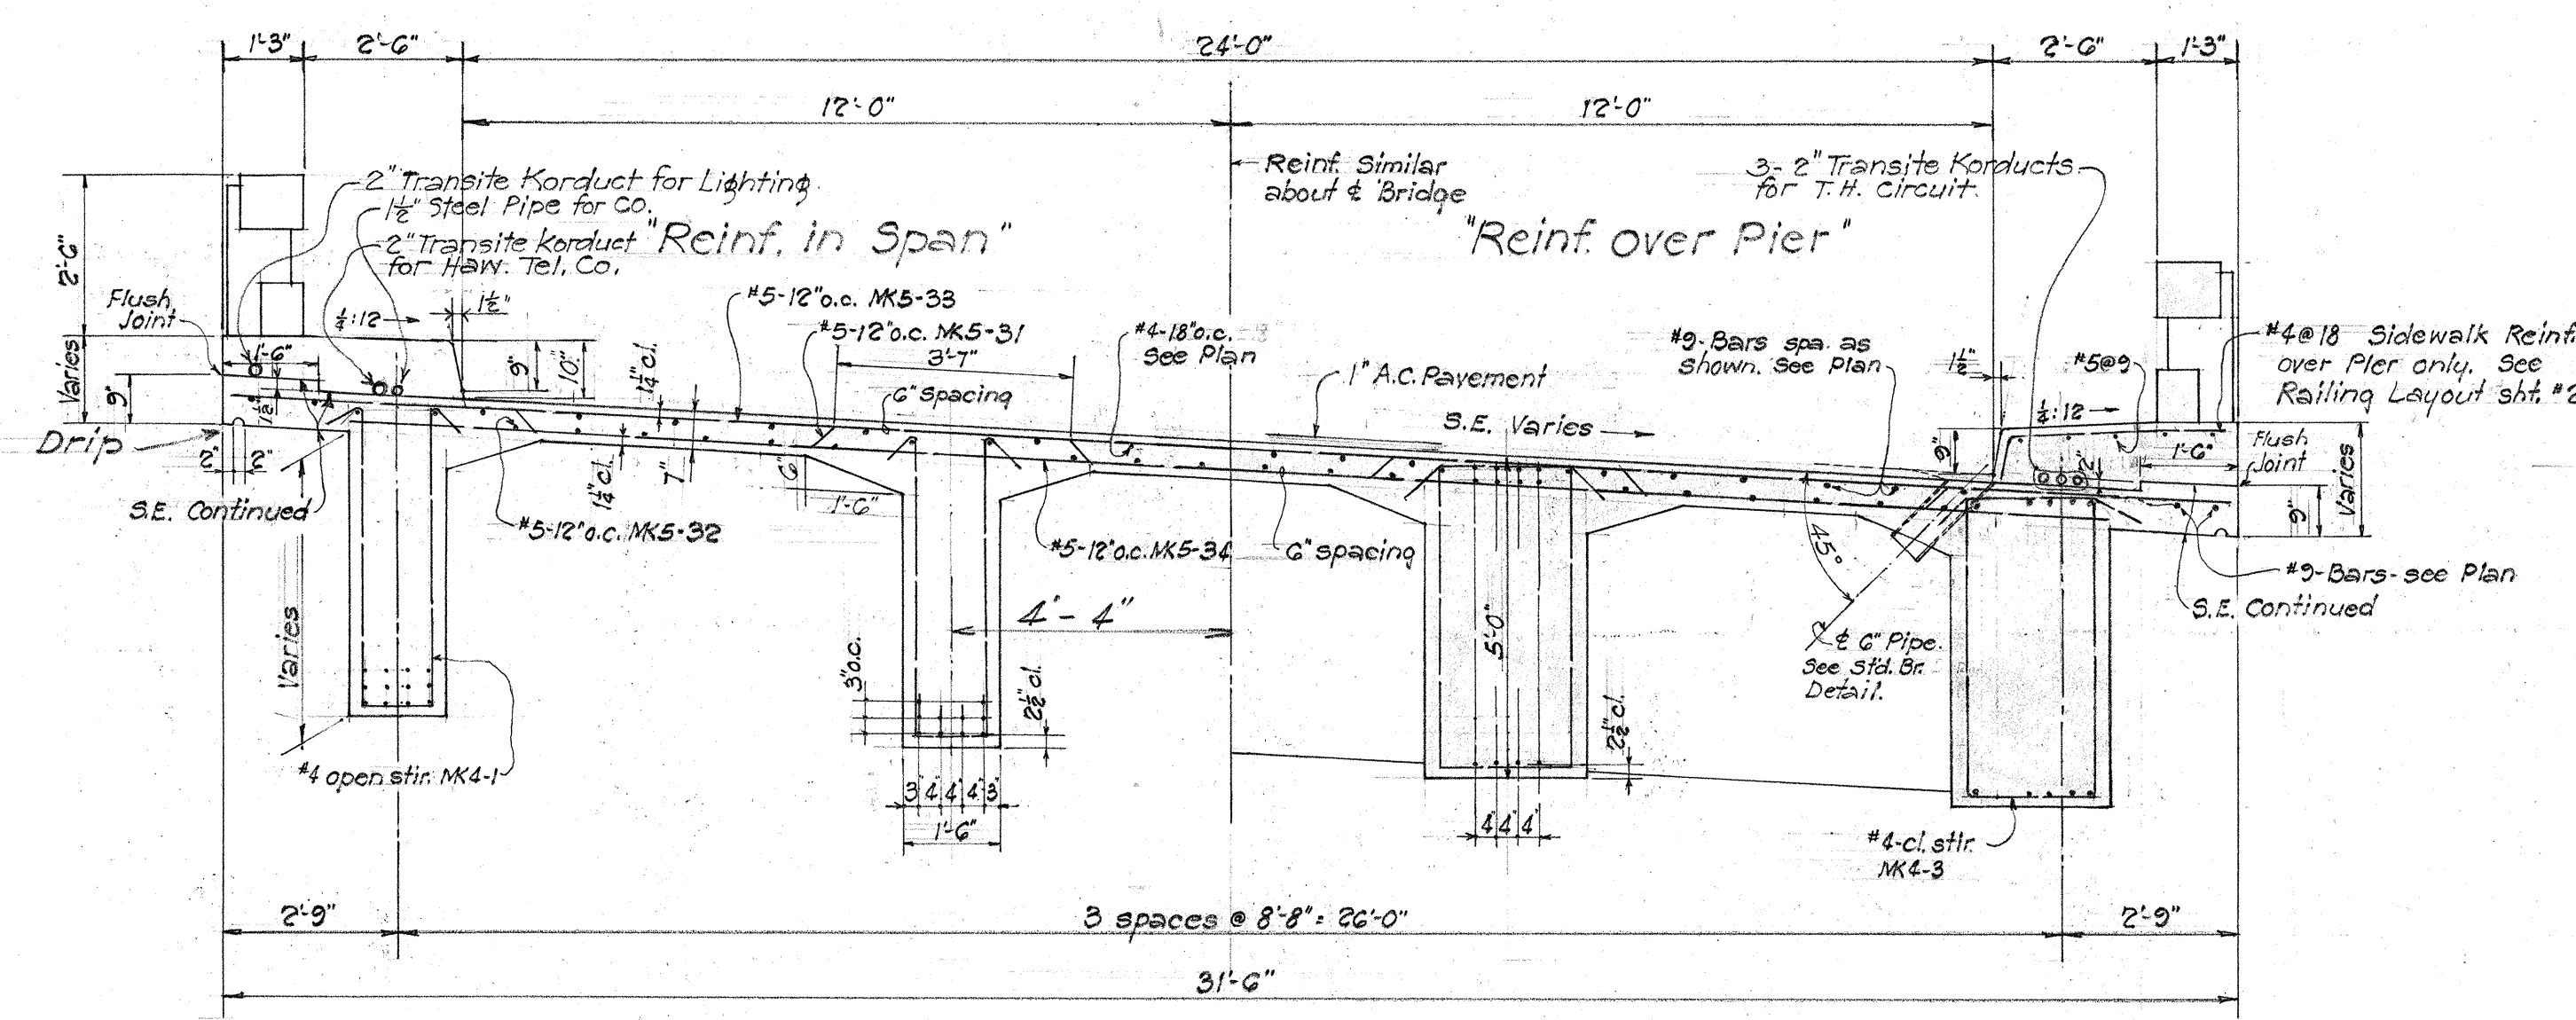

NORMAL SECTION
Scale 3/8" = 1'-0"

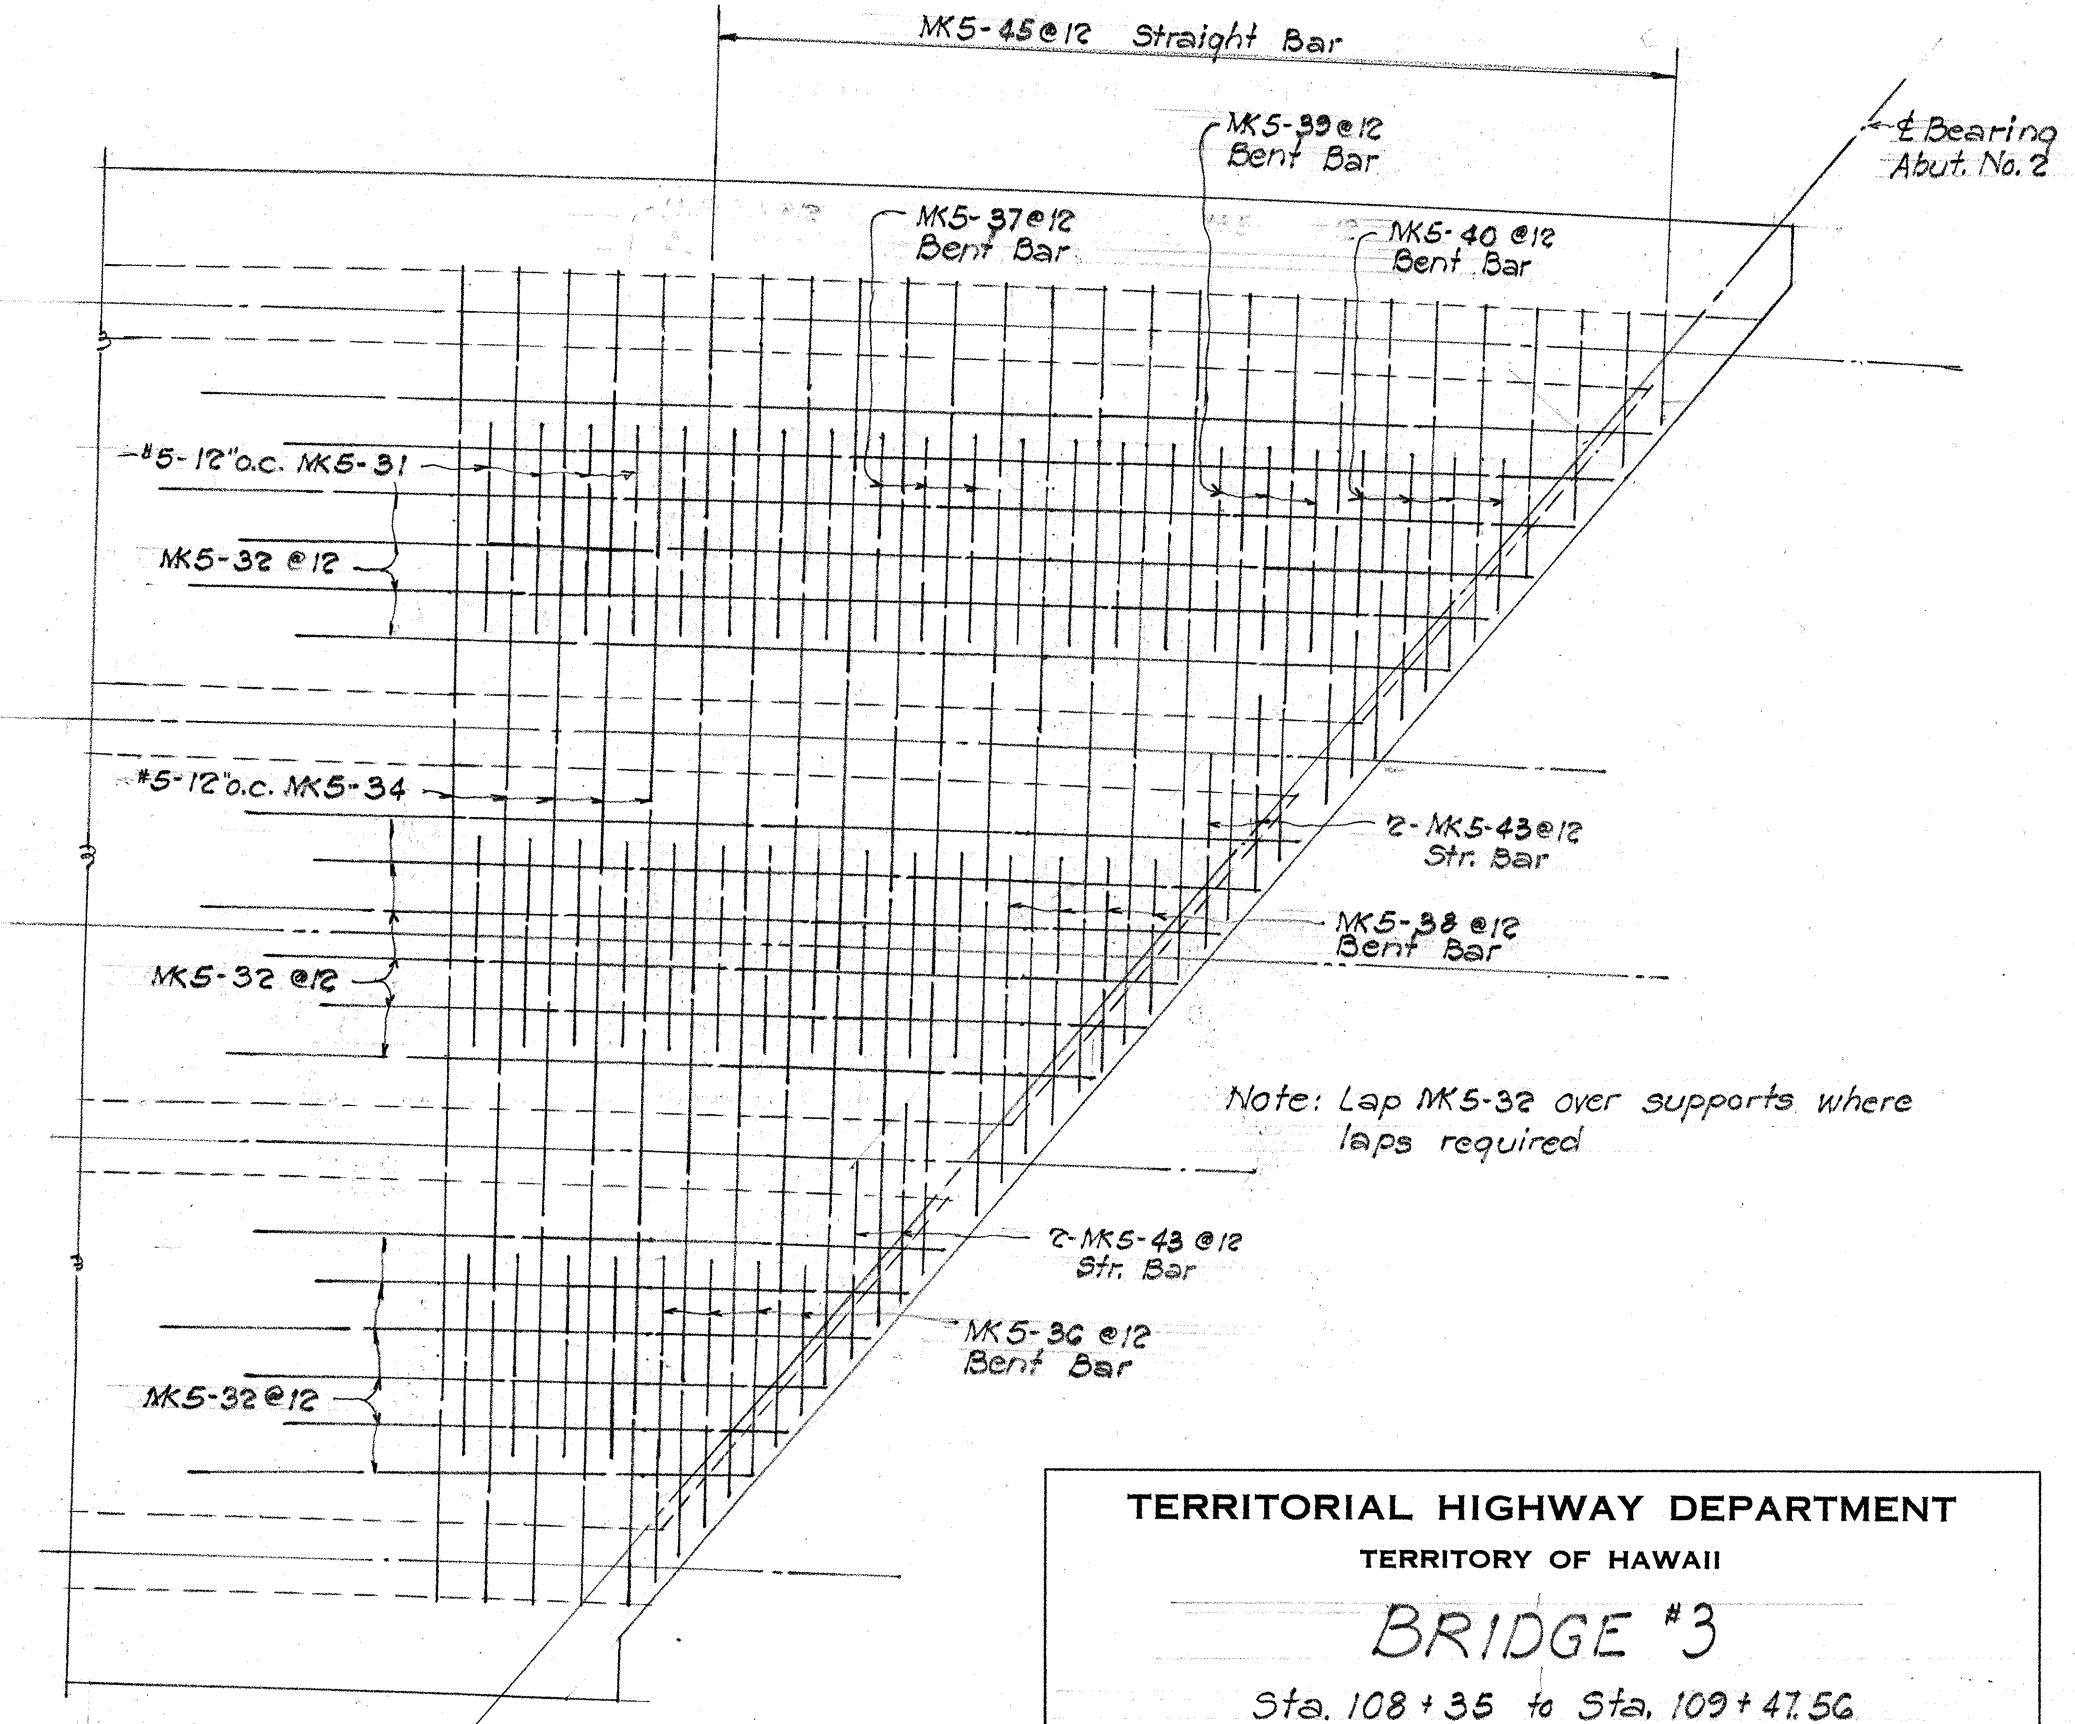

PART-SLAB REINF.
Bottom Layer
Scale 1/4" = 1'-0"

TERRITORIAL HIGHWAY DEPARTMENT
TERRITORY OF HAWAII
BRIDGE #3
Sta. 108+35 to Sta. 109+47.50
Pali Road (Tunnel Section) Proj. 3212(5)
June 1954
SHEET No. 9 OF 12 SHEETS