


DATE	BY
SURVEYED	
PLOTTED	
NOTE BOOK	
AREAS CHECKED	
NO.	

DATE	BY
ORIGINAL SURVEY	
PLOTTED	
NOTE BOOK	
AREAS CHECKED	
NO.	

FED. ROAD DIST. No.	STATE	FED. AID PROJ. No.	FISCAL YEAR	SHEET No.	TOTAL SHEETS
HAWAII	HAW.	9-061001	1955	7	84

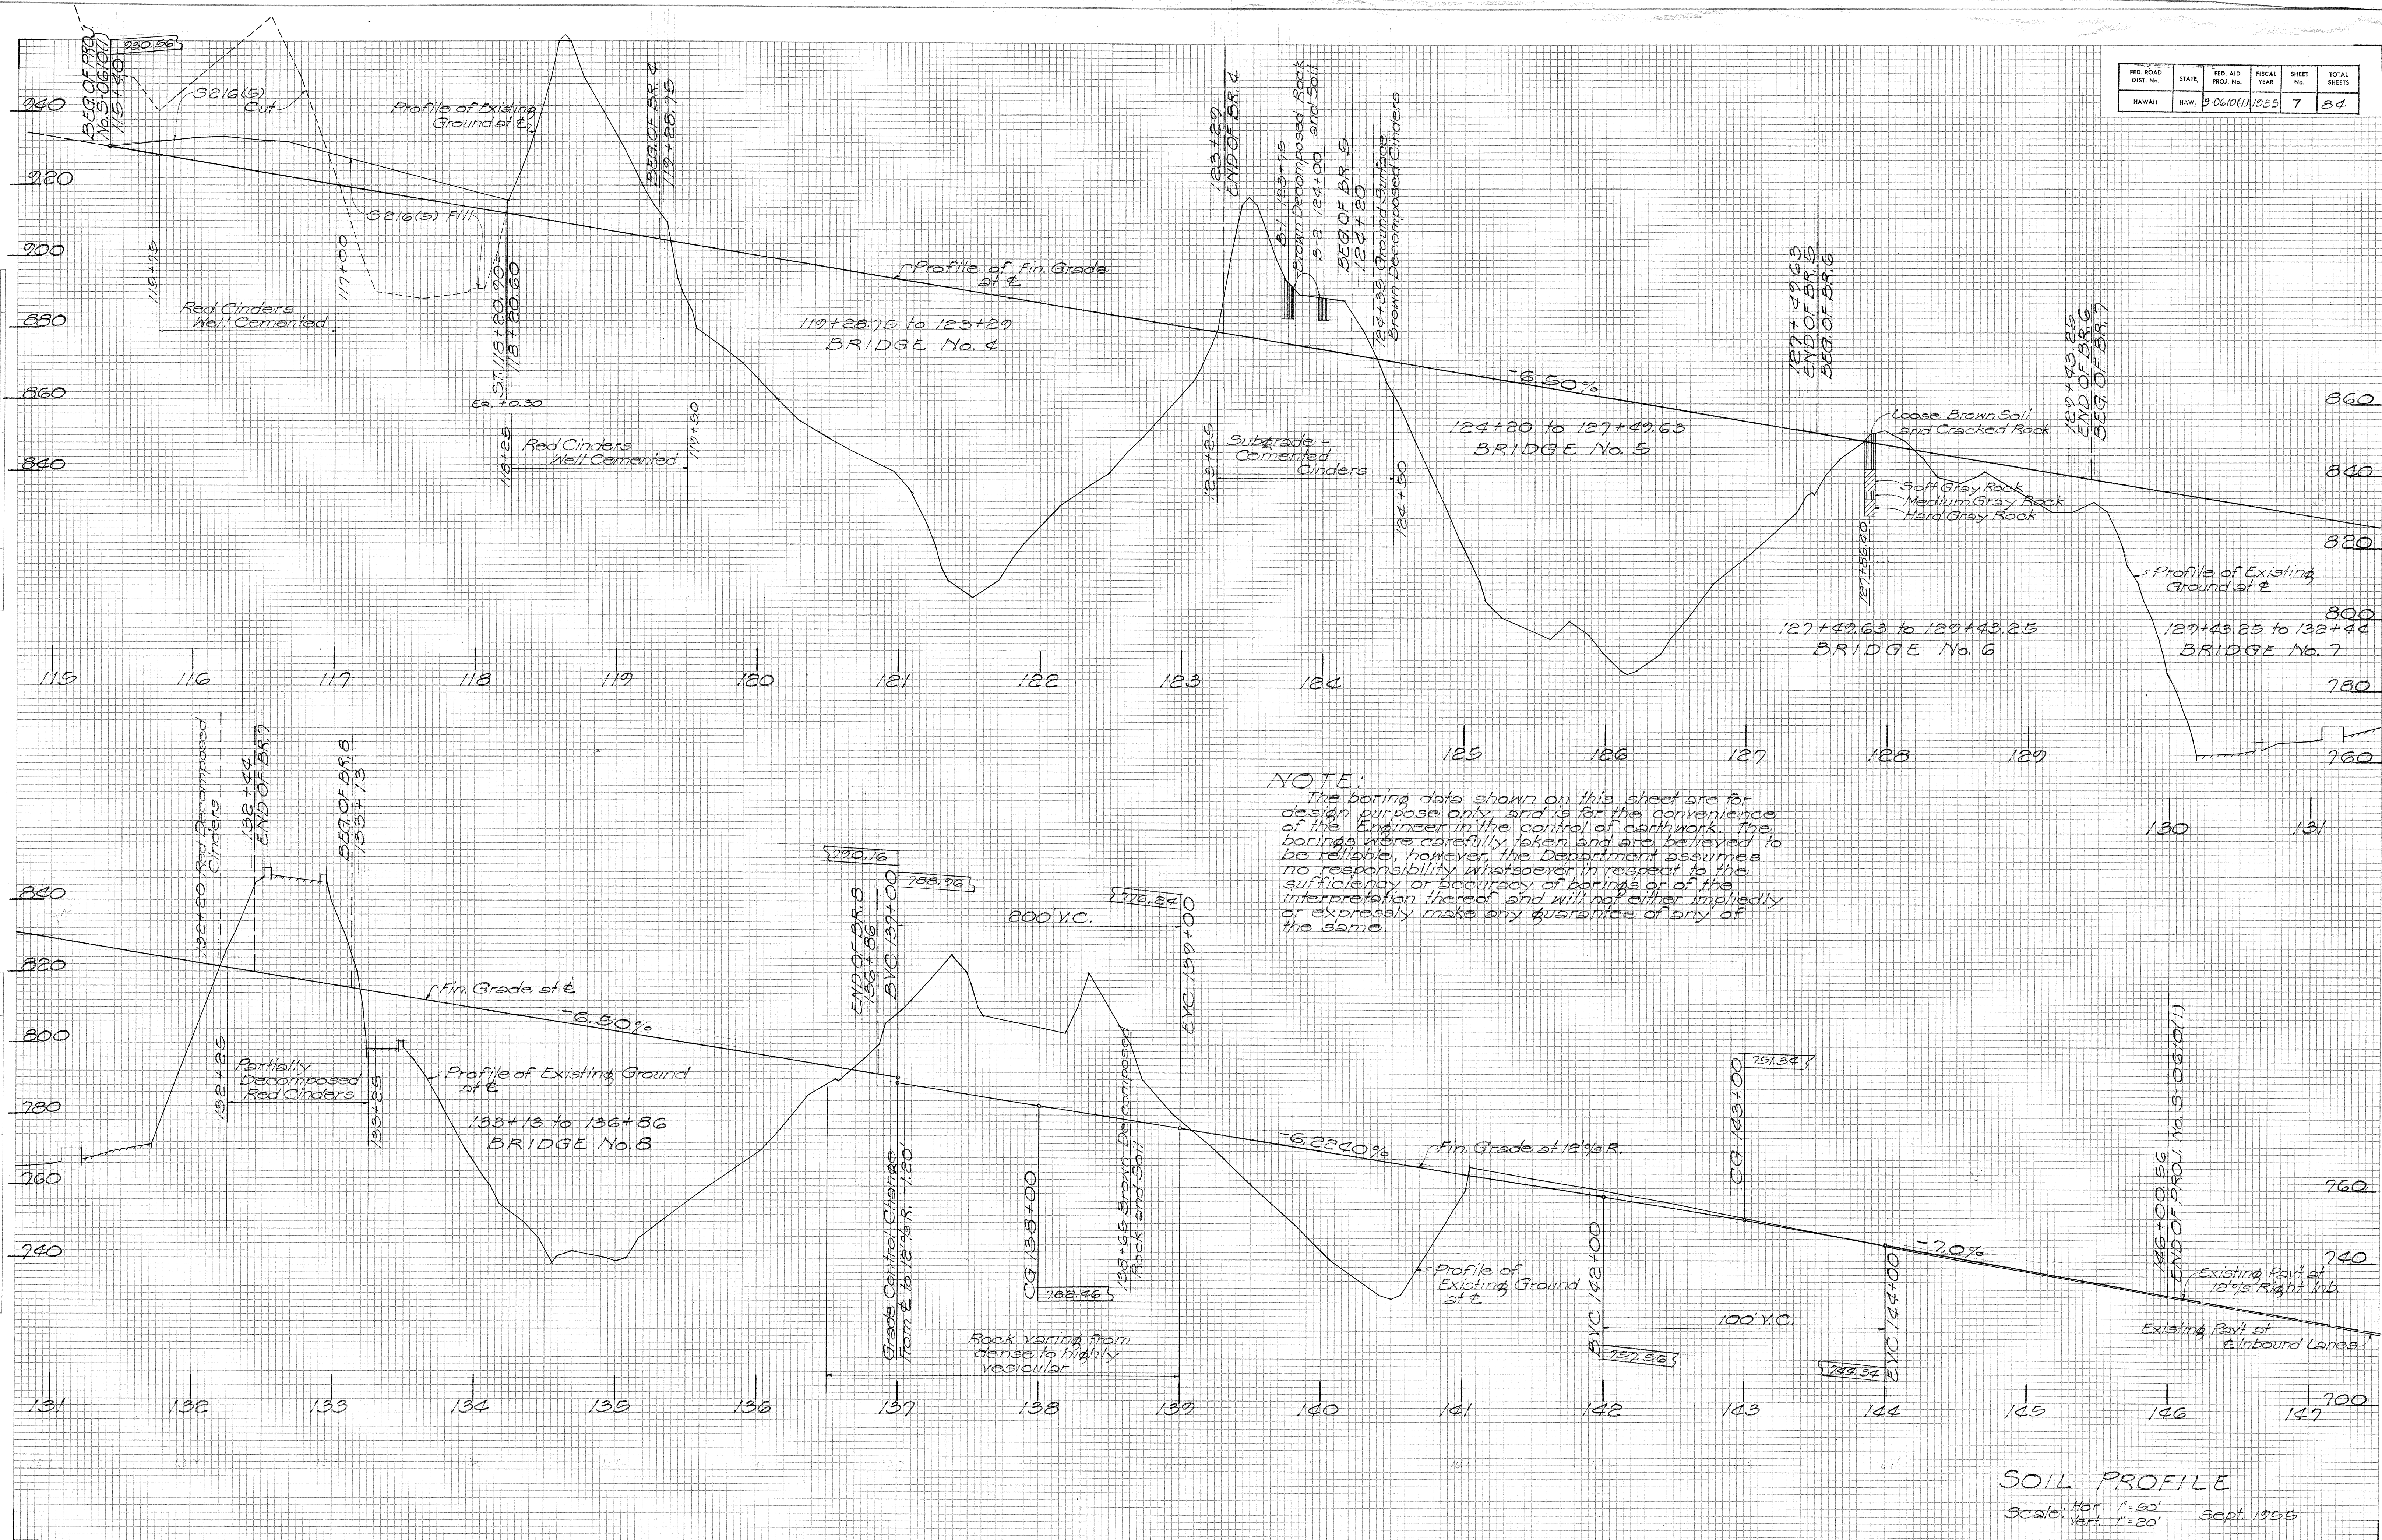

NOTE:
 The boring data shown on this sheet are for design purpose only, and is for the convenience of the Engineer in the control of earthwork. The borings were carefully taken and are believed to be reliable, however, the Department assumes no responsibility whatsoever in respect to the sufficiency or accuracy of borings or of the interpretation thereof and will not either impliedly or expressly make any guarantee of any of the same.

SOIL PROFILE
 Scale: Hor. 1"=50'
 Vert. 1"=20'
 Sept. 1955